
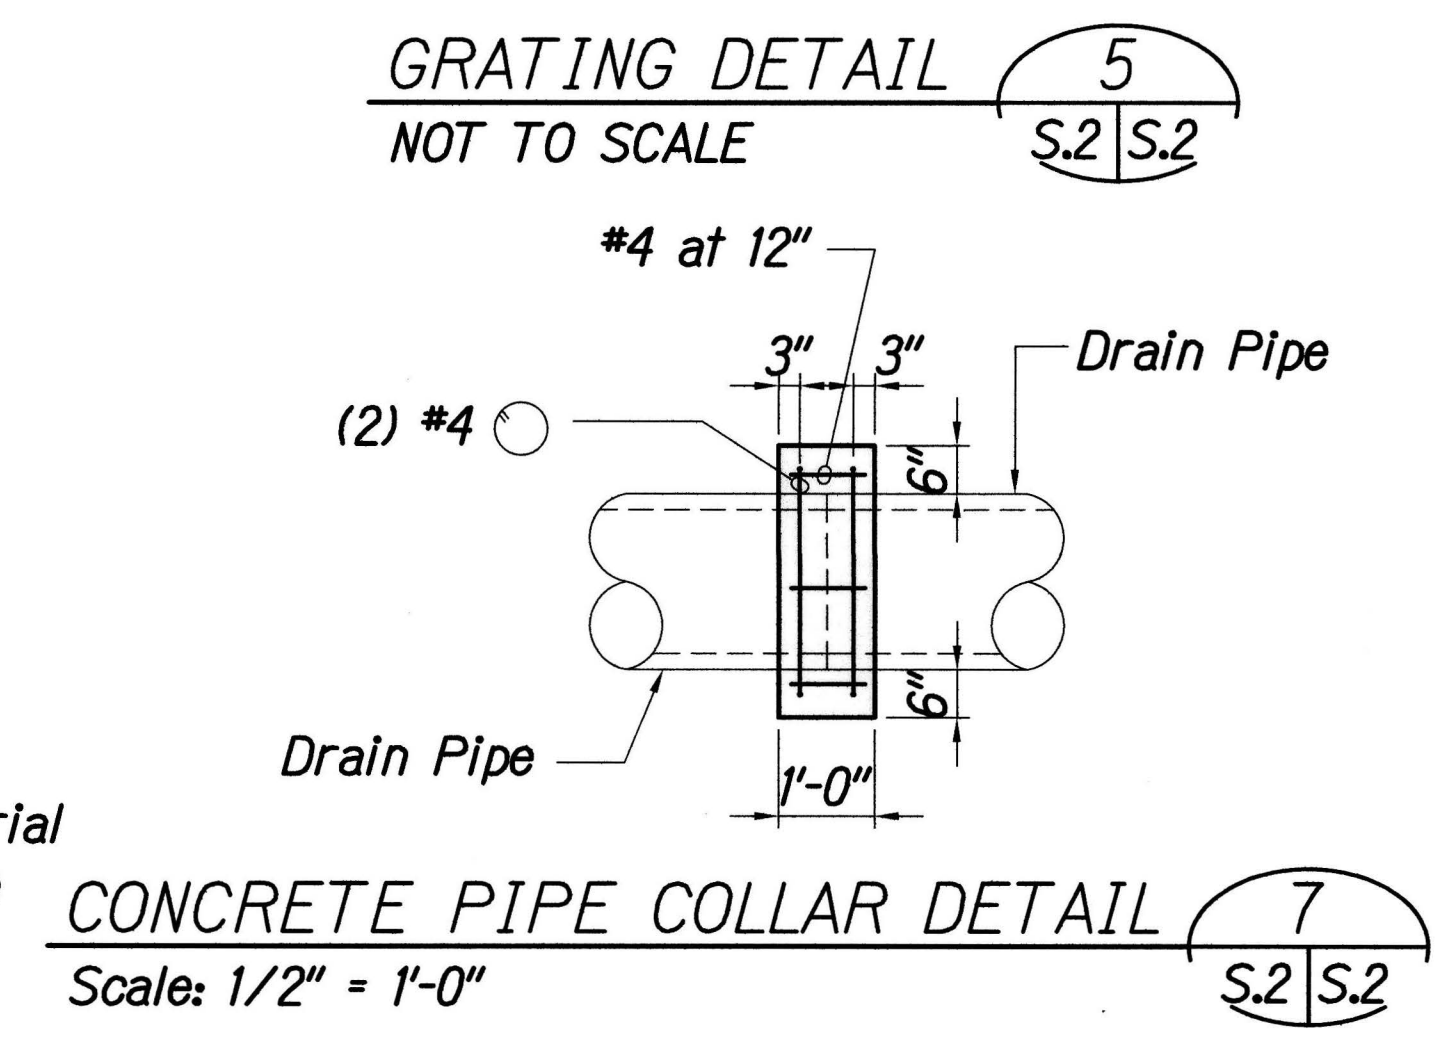
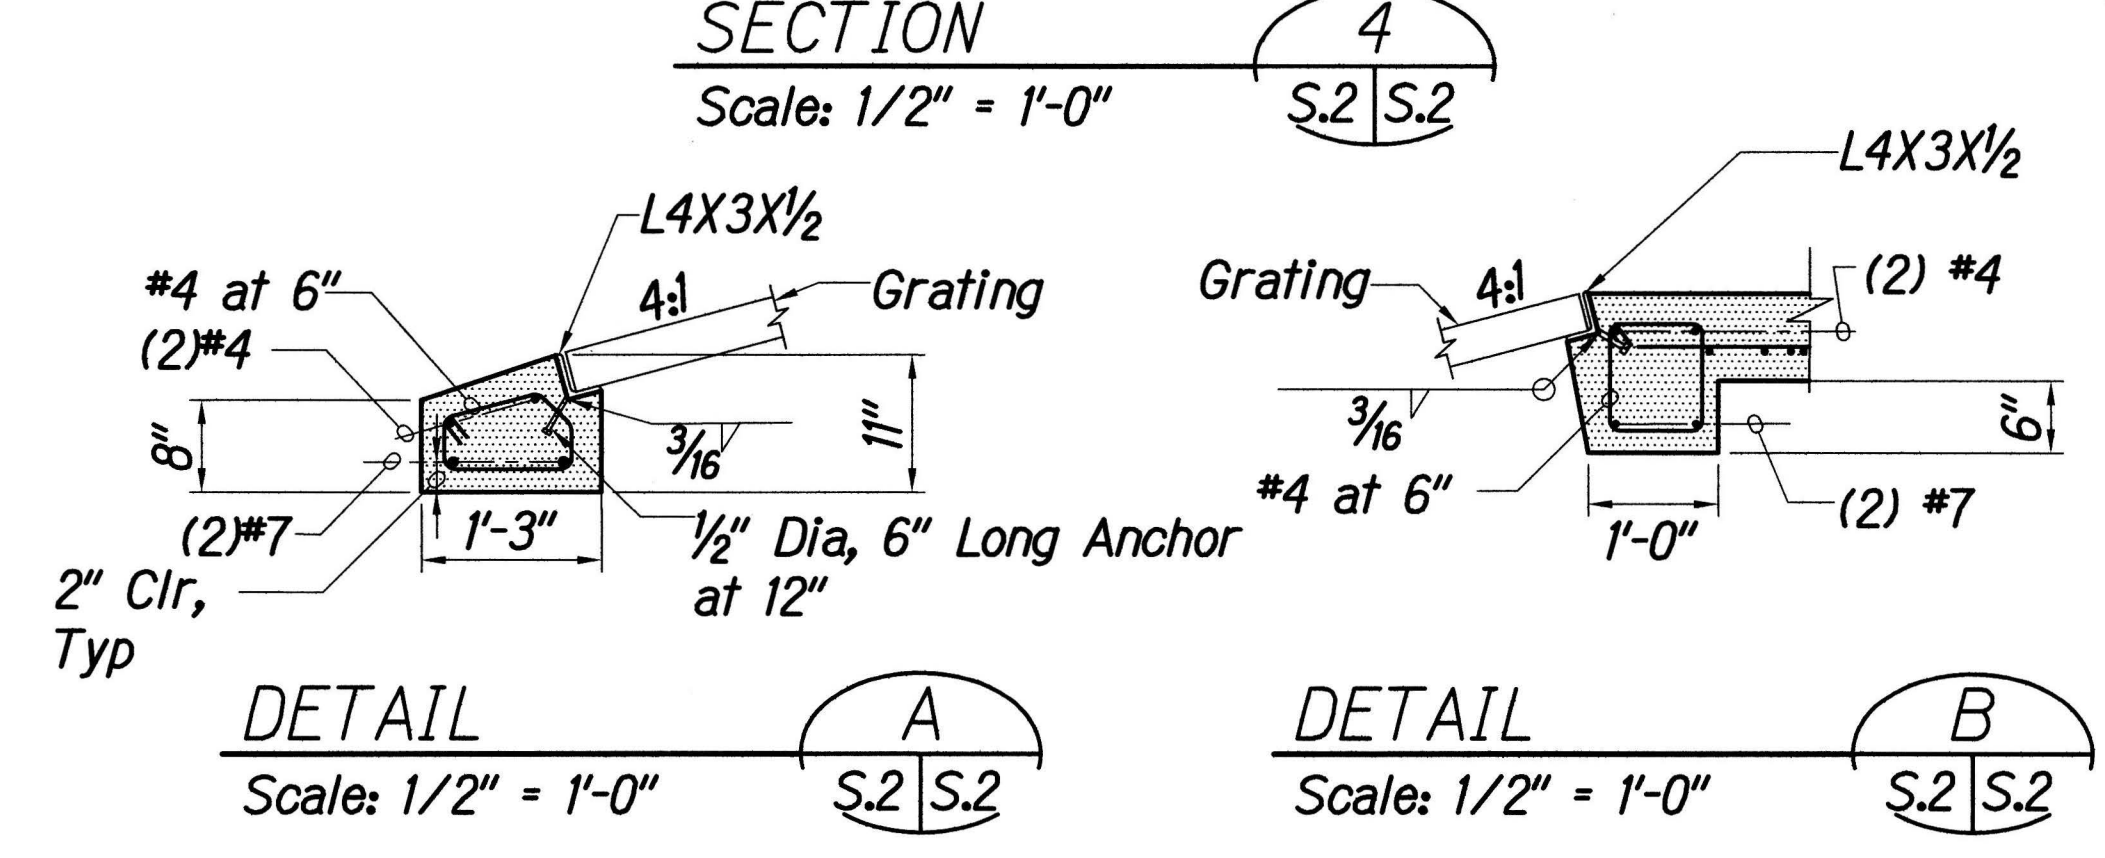
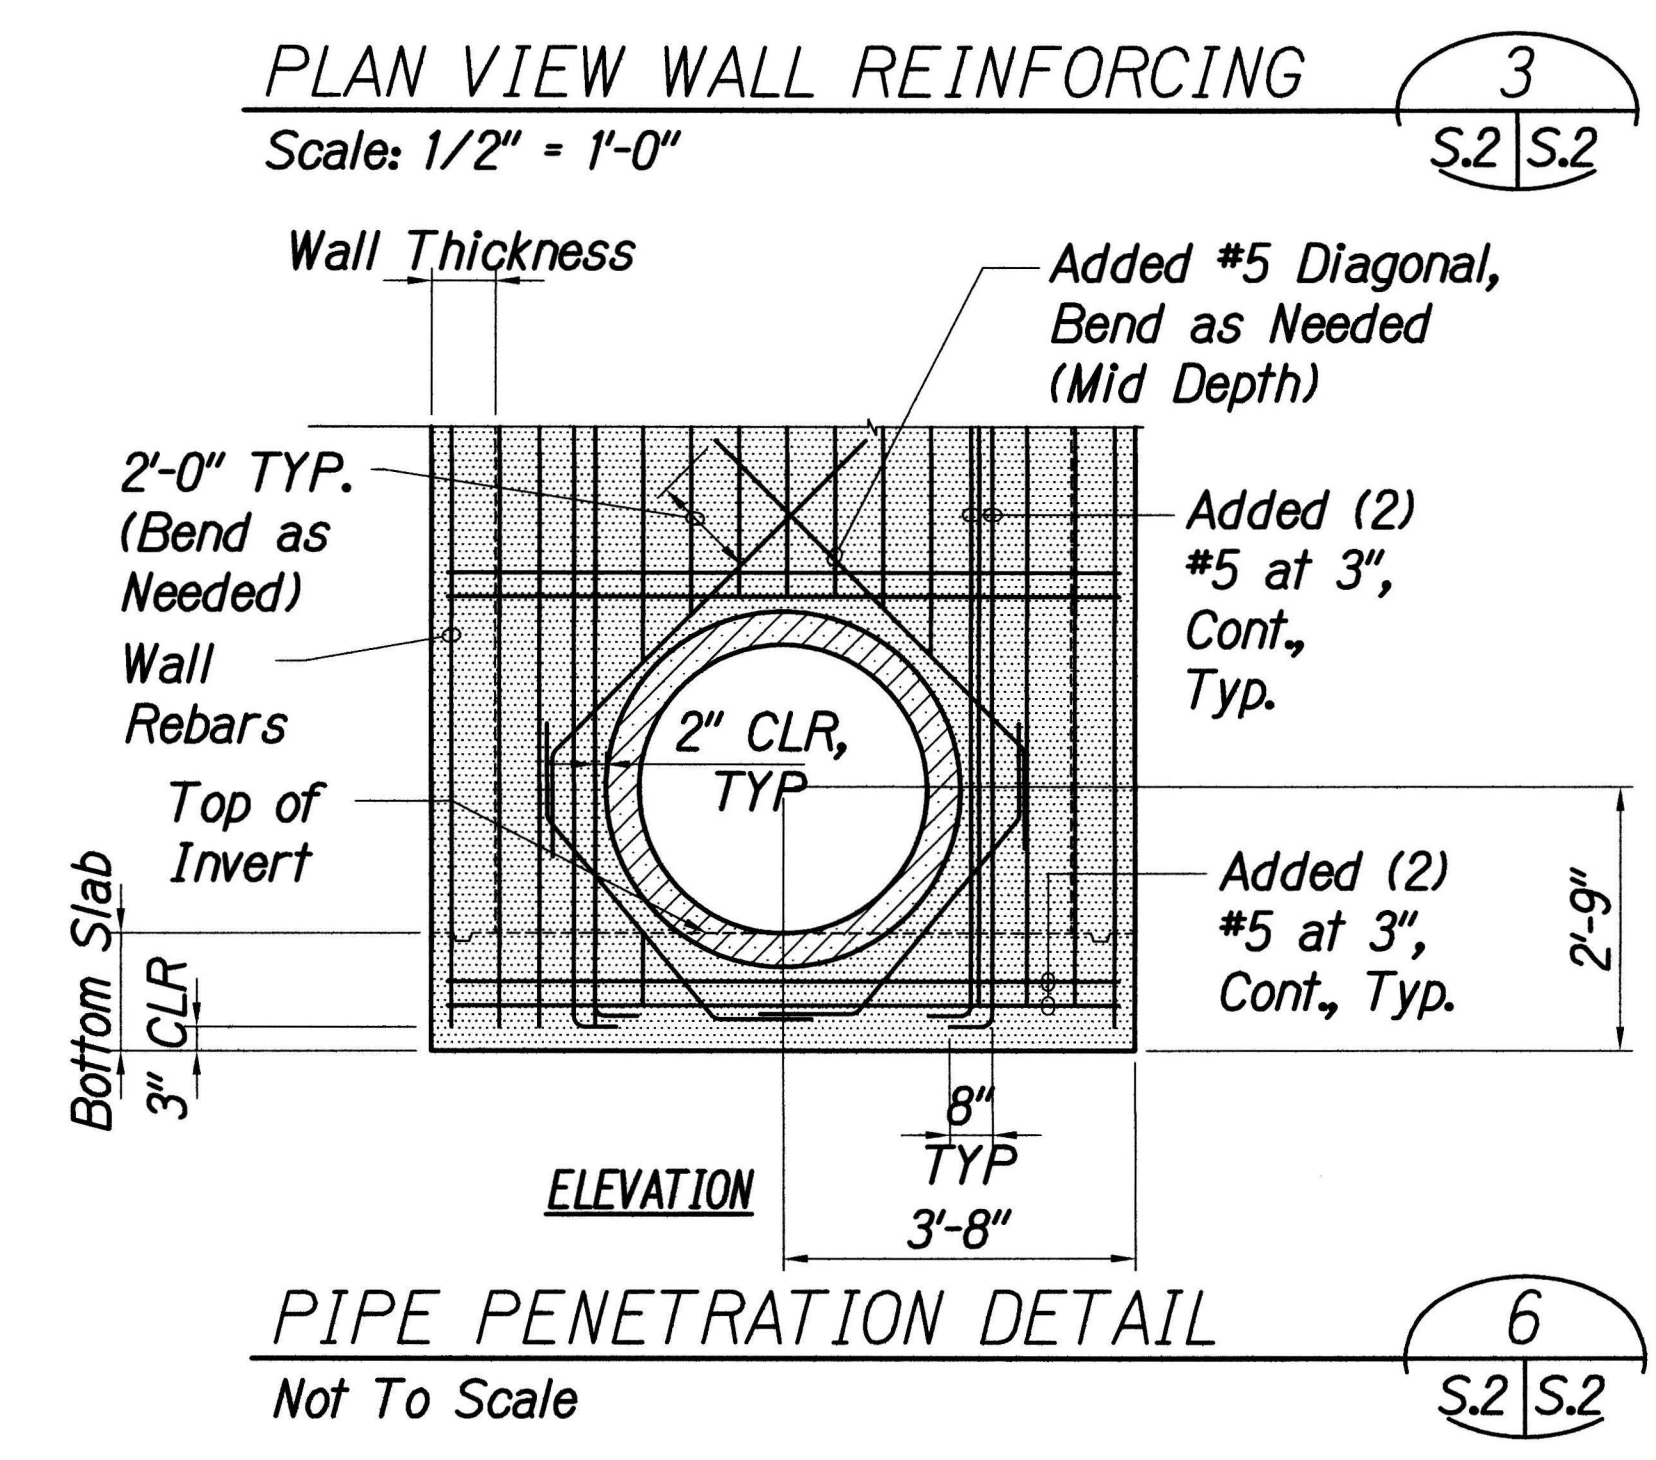
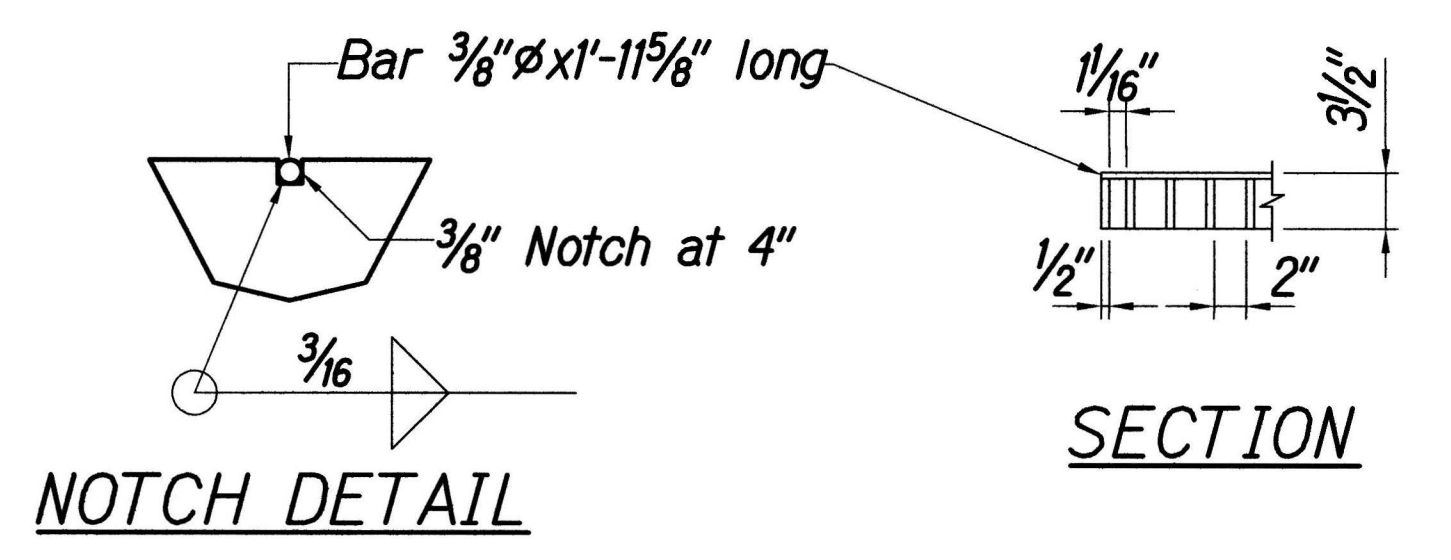
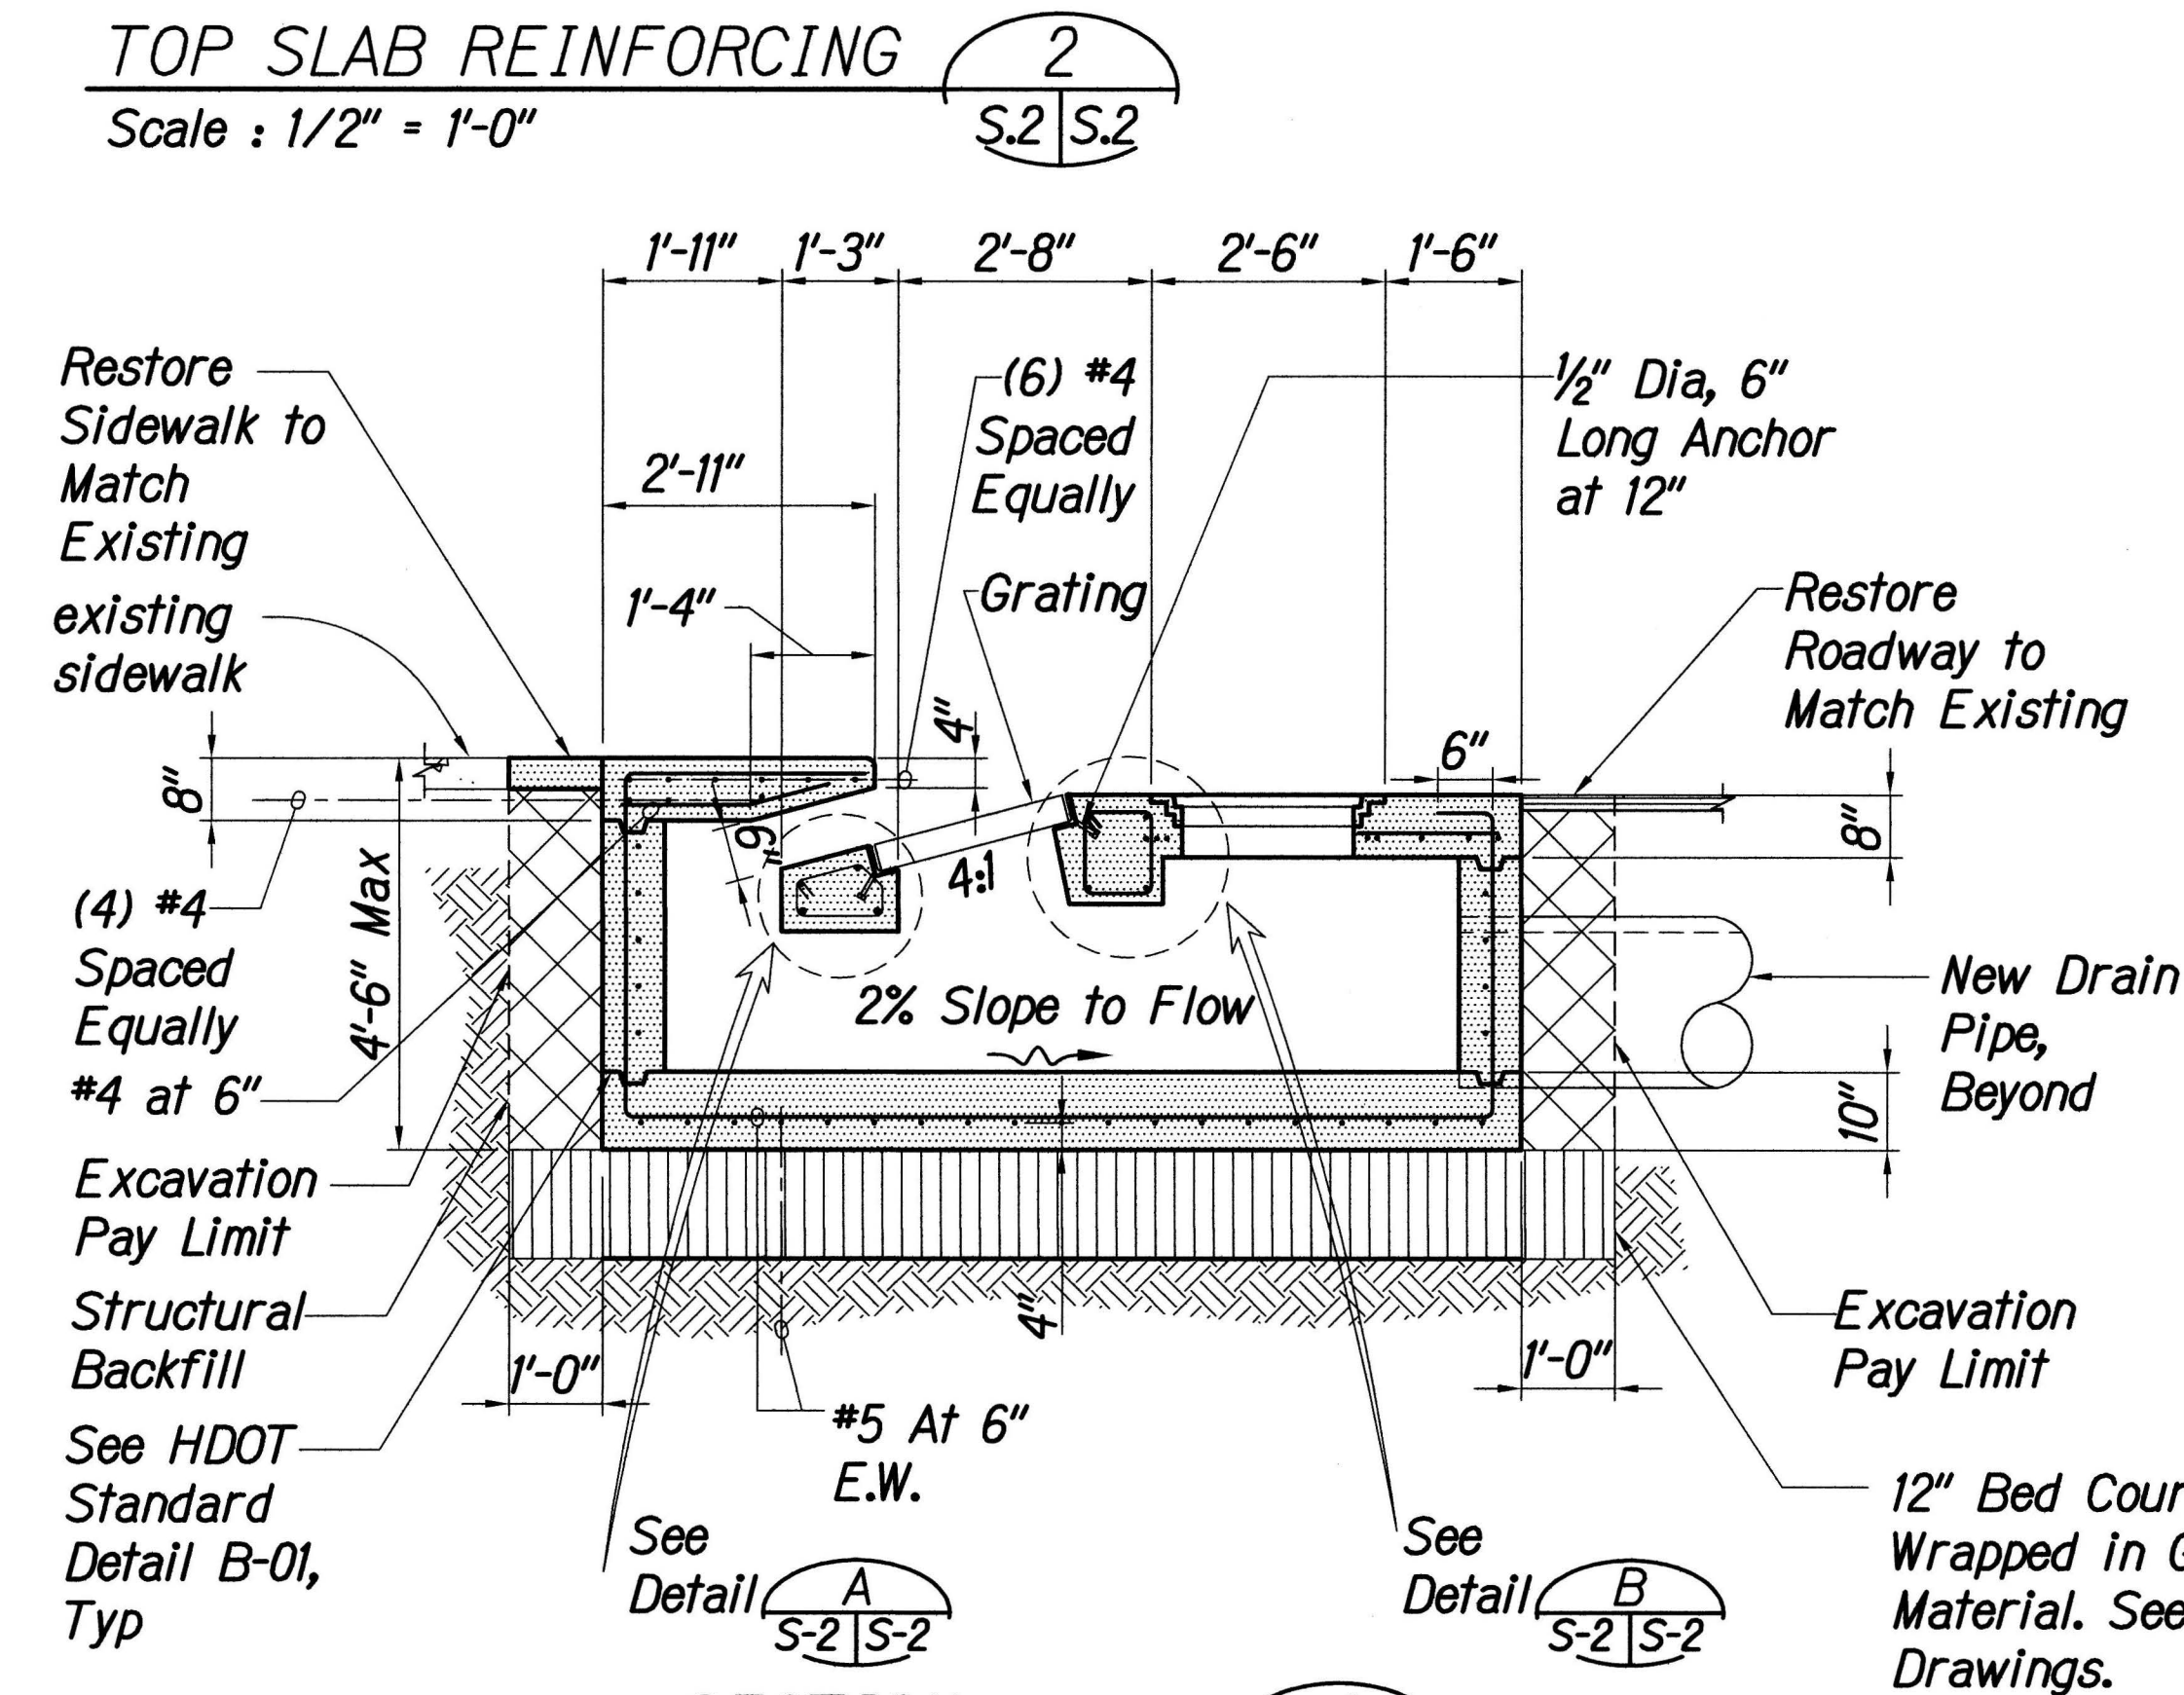
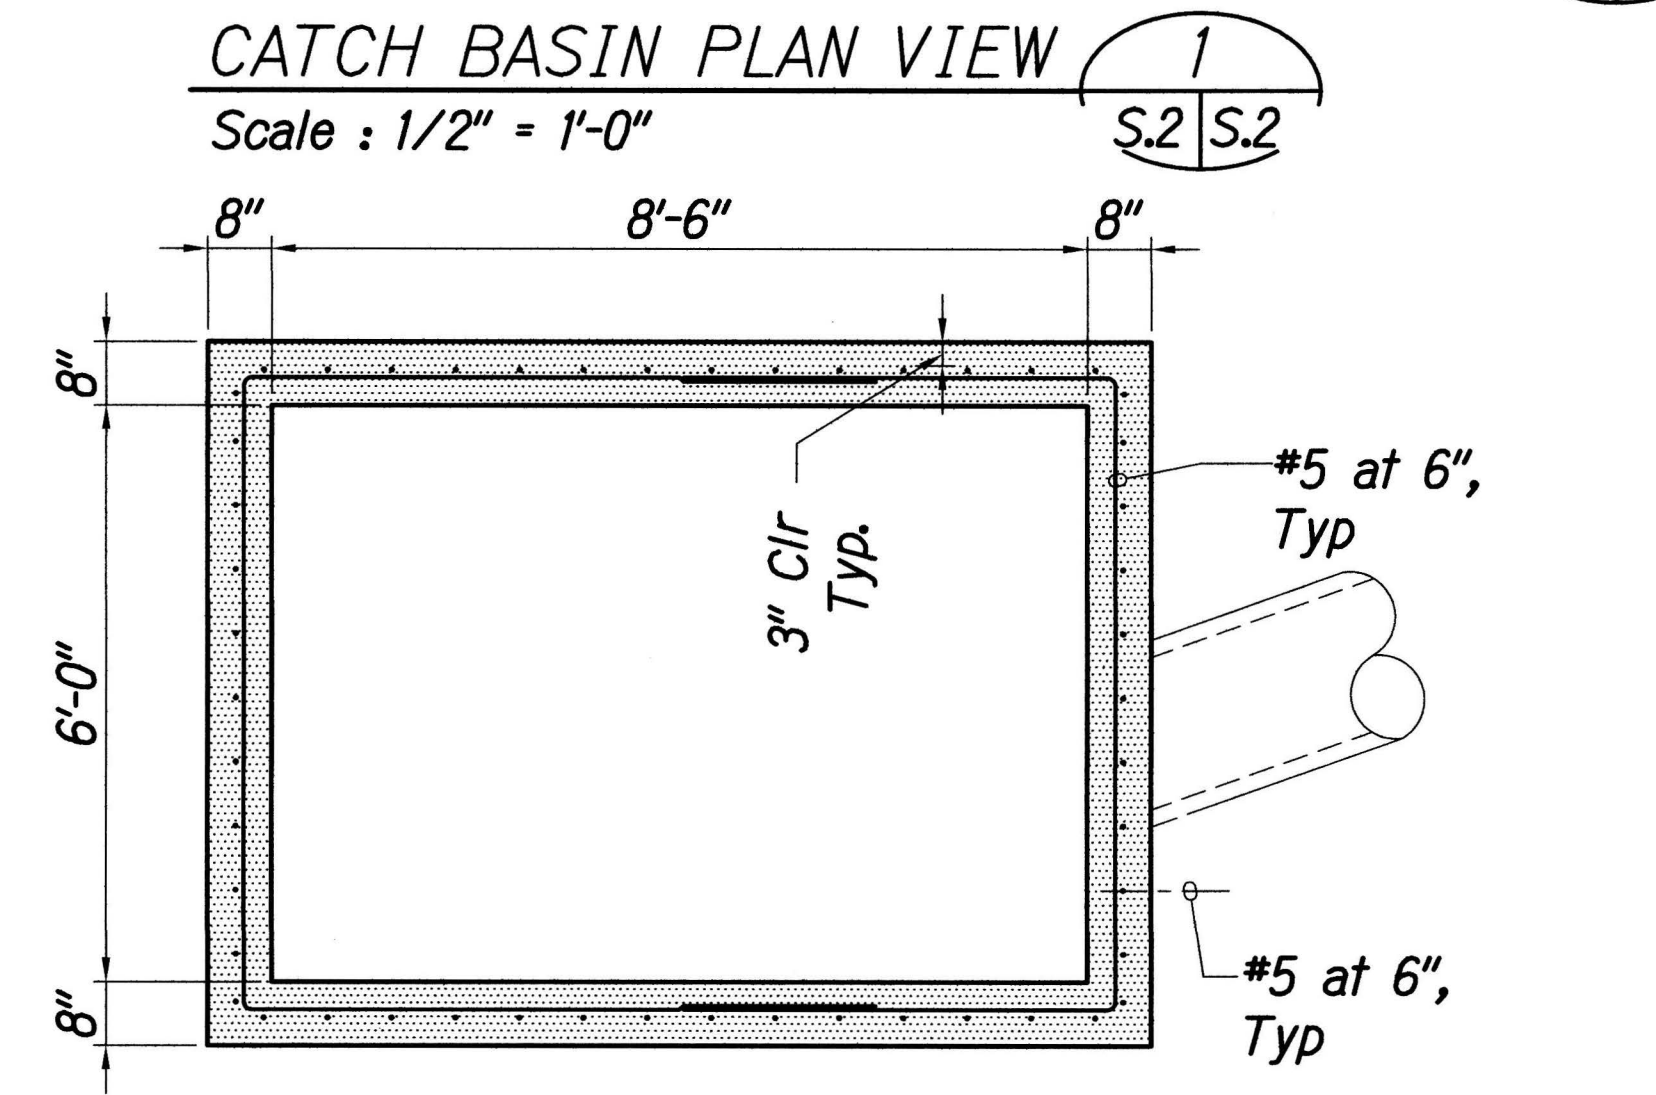
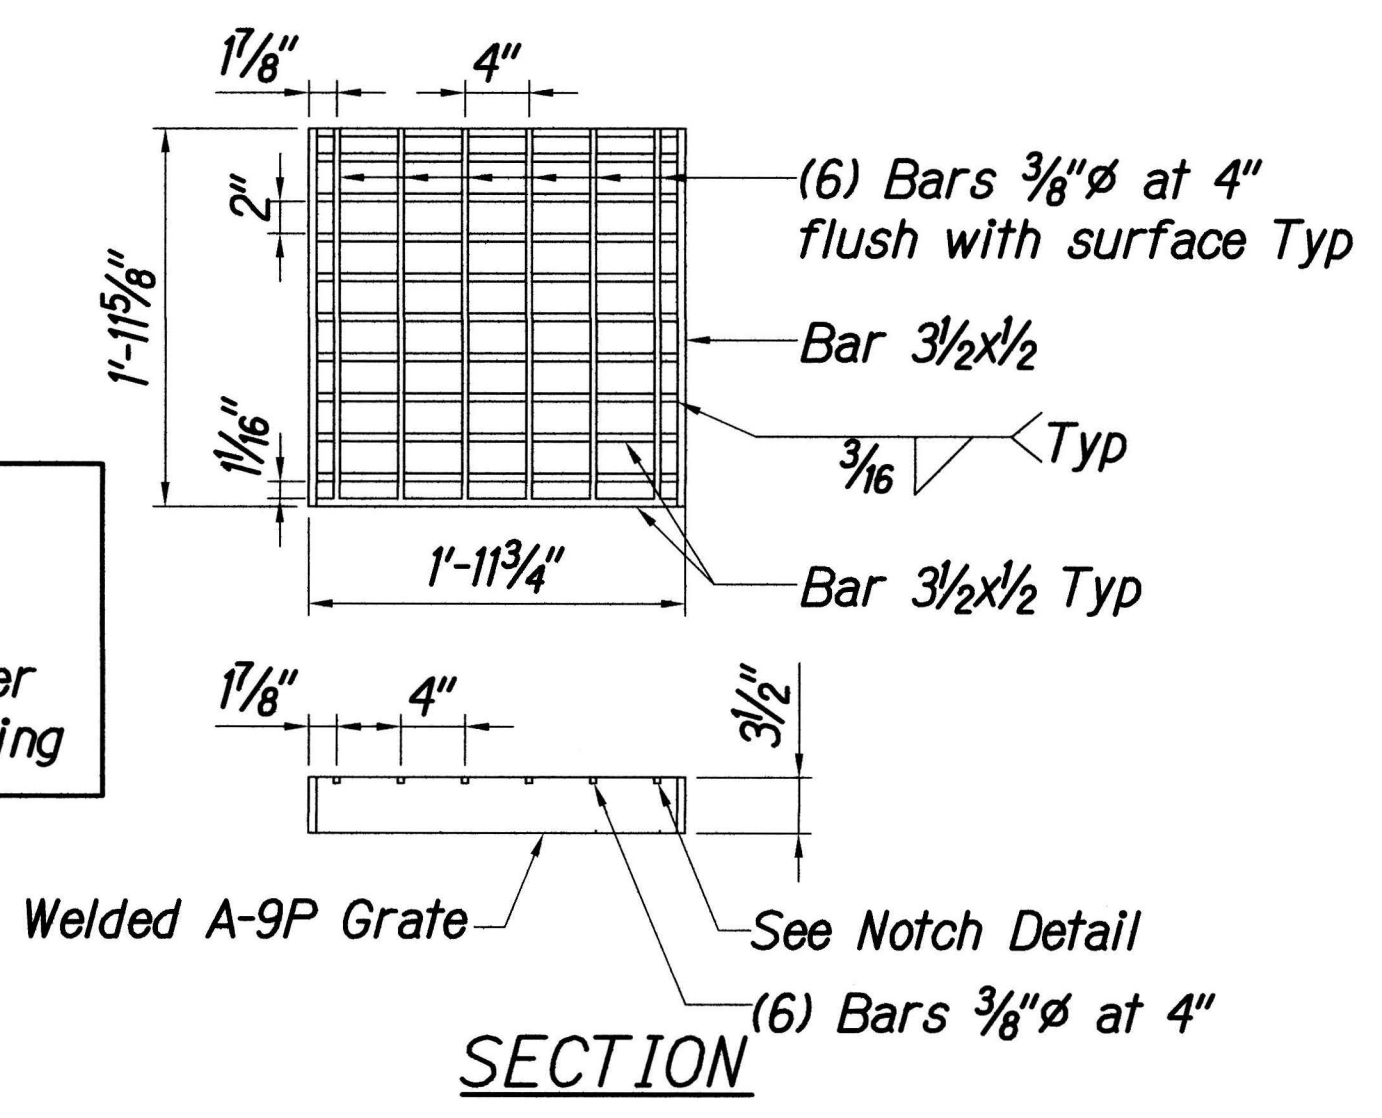
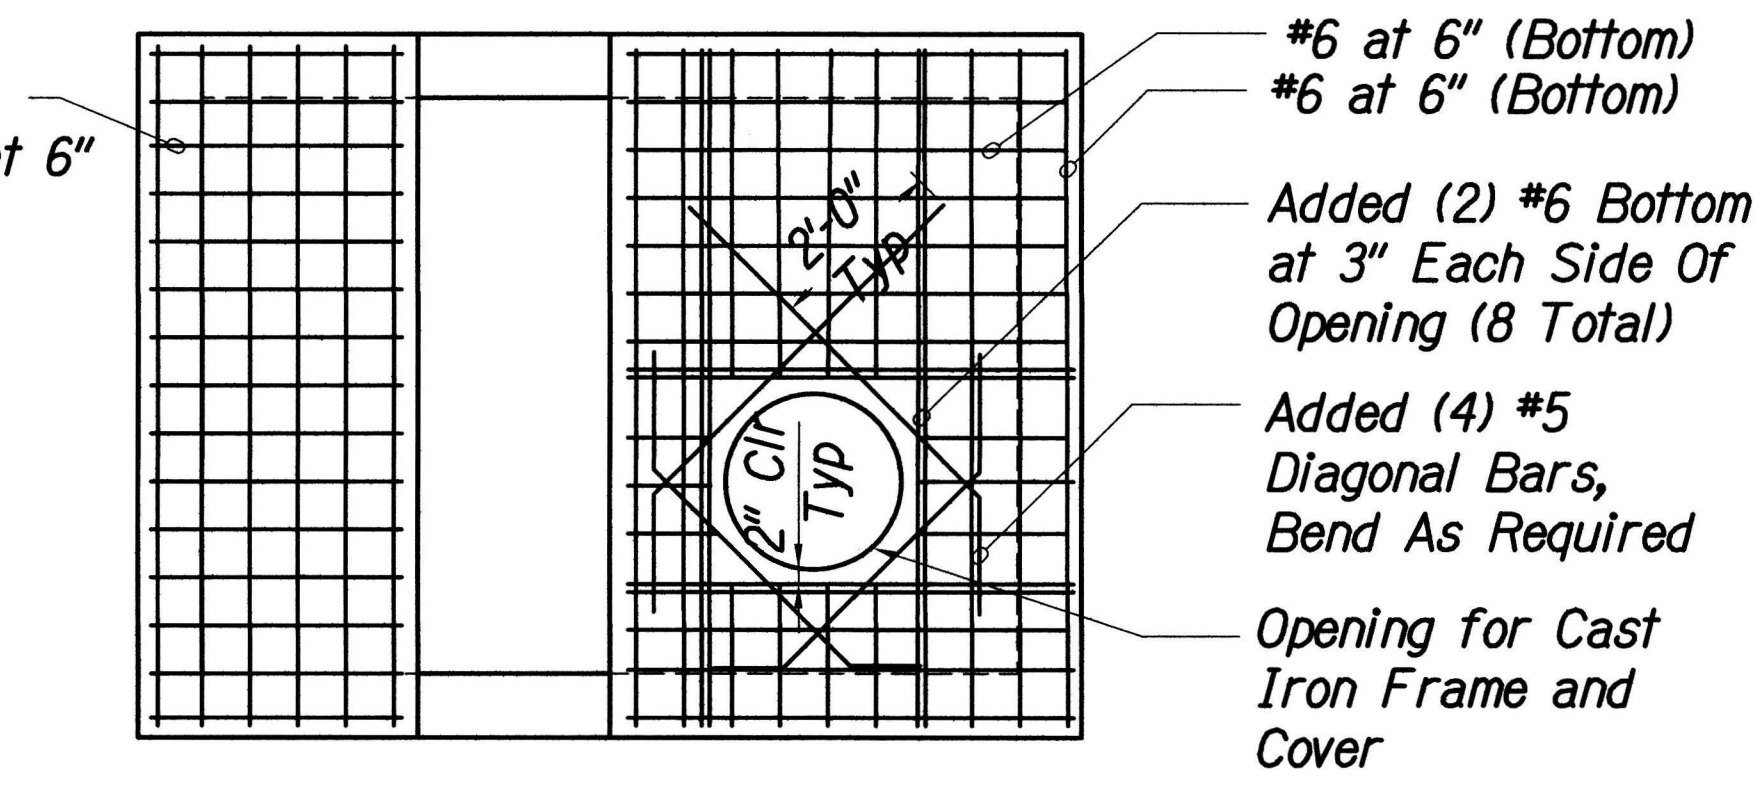


FED. ROAD DIST. NO.	STATE	PROJ. NO.	FISCAL YEAR	SHEET NO.	TOTAL SHEETS
HAWAII	HAW.	72C-01-13	2017	21	21

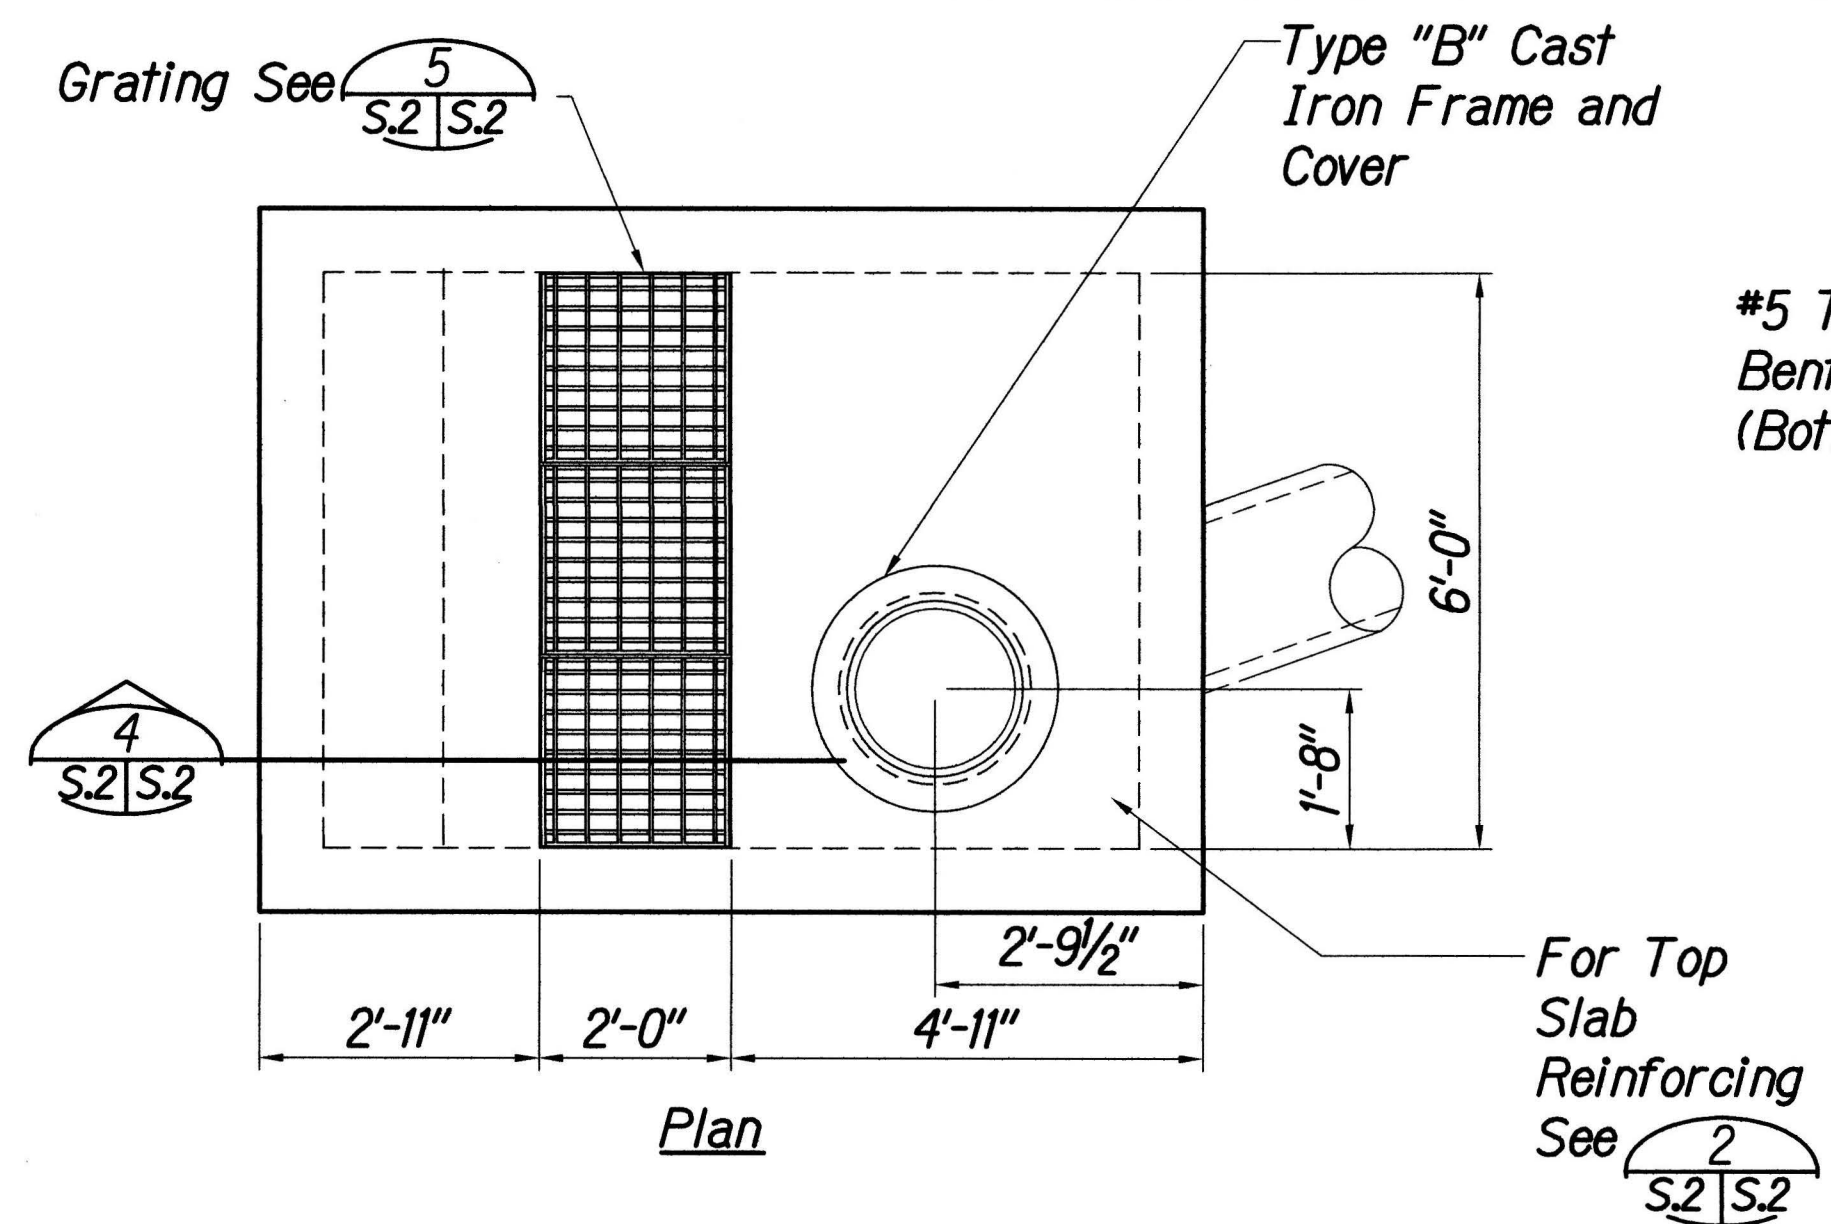

ORIGINAL PLAN	SURVEY PLOTTED BY	DATE
NOTE BOOK	DRAWN BY	
QUANTITIES BY	DESIGNED BY	
CHECKED BY		

STATE OF HAWAII
DEPARTMENT OF TRANSPORTATION
HIGHWAYS DIVISION
CATCH BASIN DETAILS
KALANIANA'OLE HIGHWAY
DRAINAGE IMPROVEMENTS
Vicinity of Wailupe Place
Project No. 72C-01-13
Scale: As Shown
Date: November 2016
SHEET No. 5.2 OF 2 SHEETS