


FED. ROAD DIST. NO.	STATE	PROJ. NO.	FISCAL YEAR	SHEET NO.	TOTAL SHEETS
HAWAII	HAW.	72C-01-13	2017	10	21

- Notes:
- The two HDOT drainage systems affected by this project are shown. Contractor shall plan and manage work to avoid disruptions to his operations and prevent damage to adjacent and downstream properties due to storm runoff.

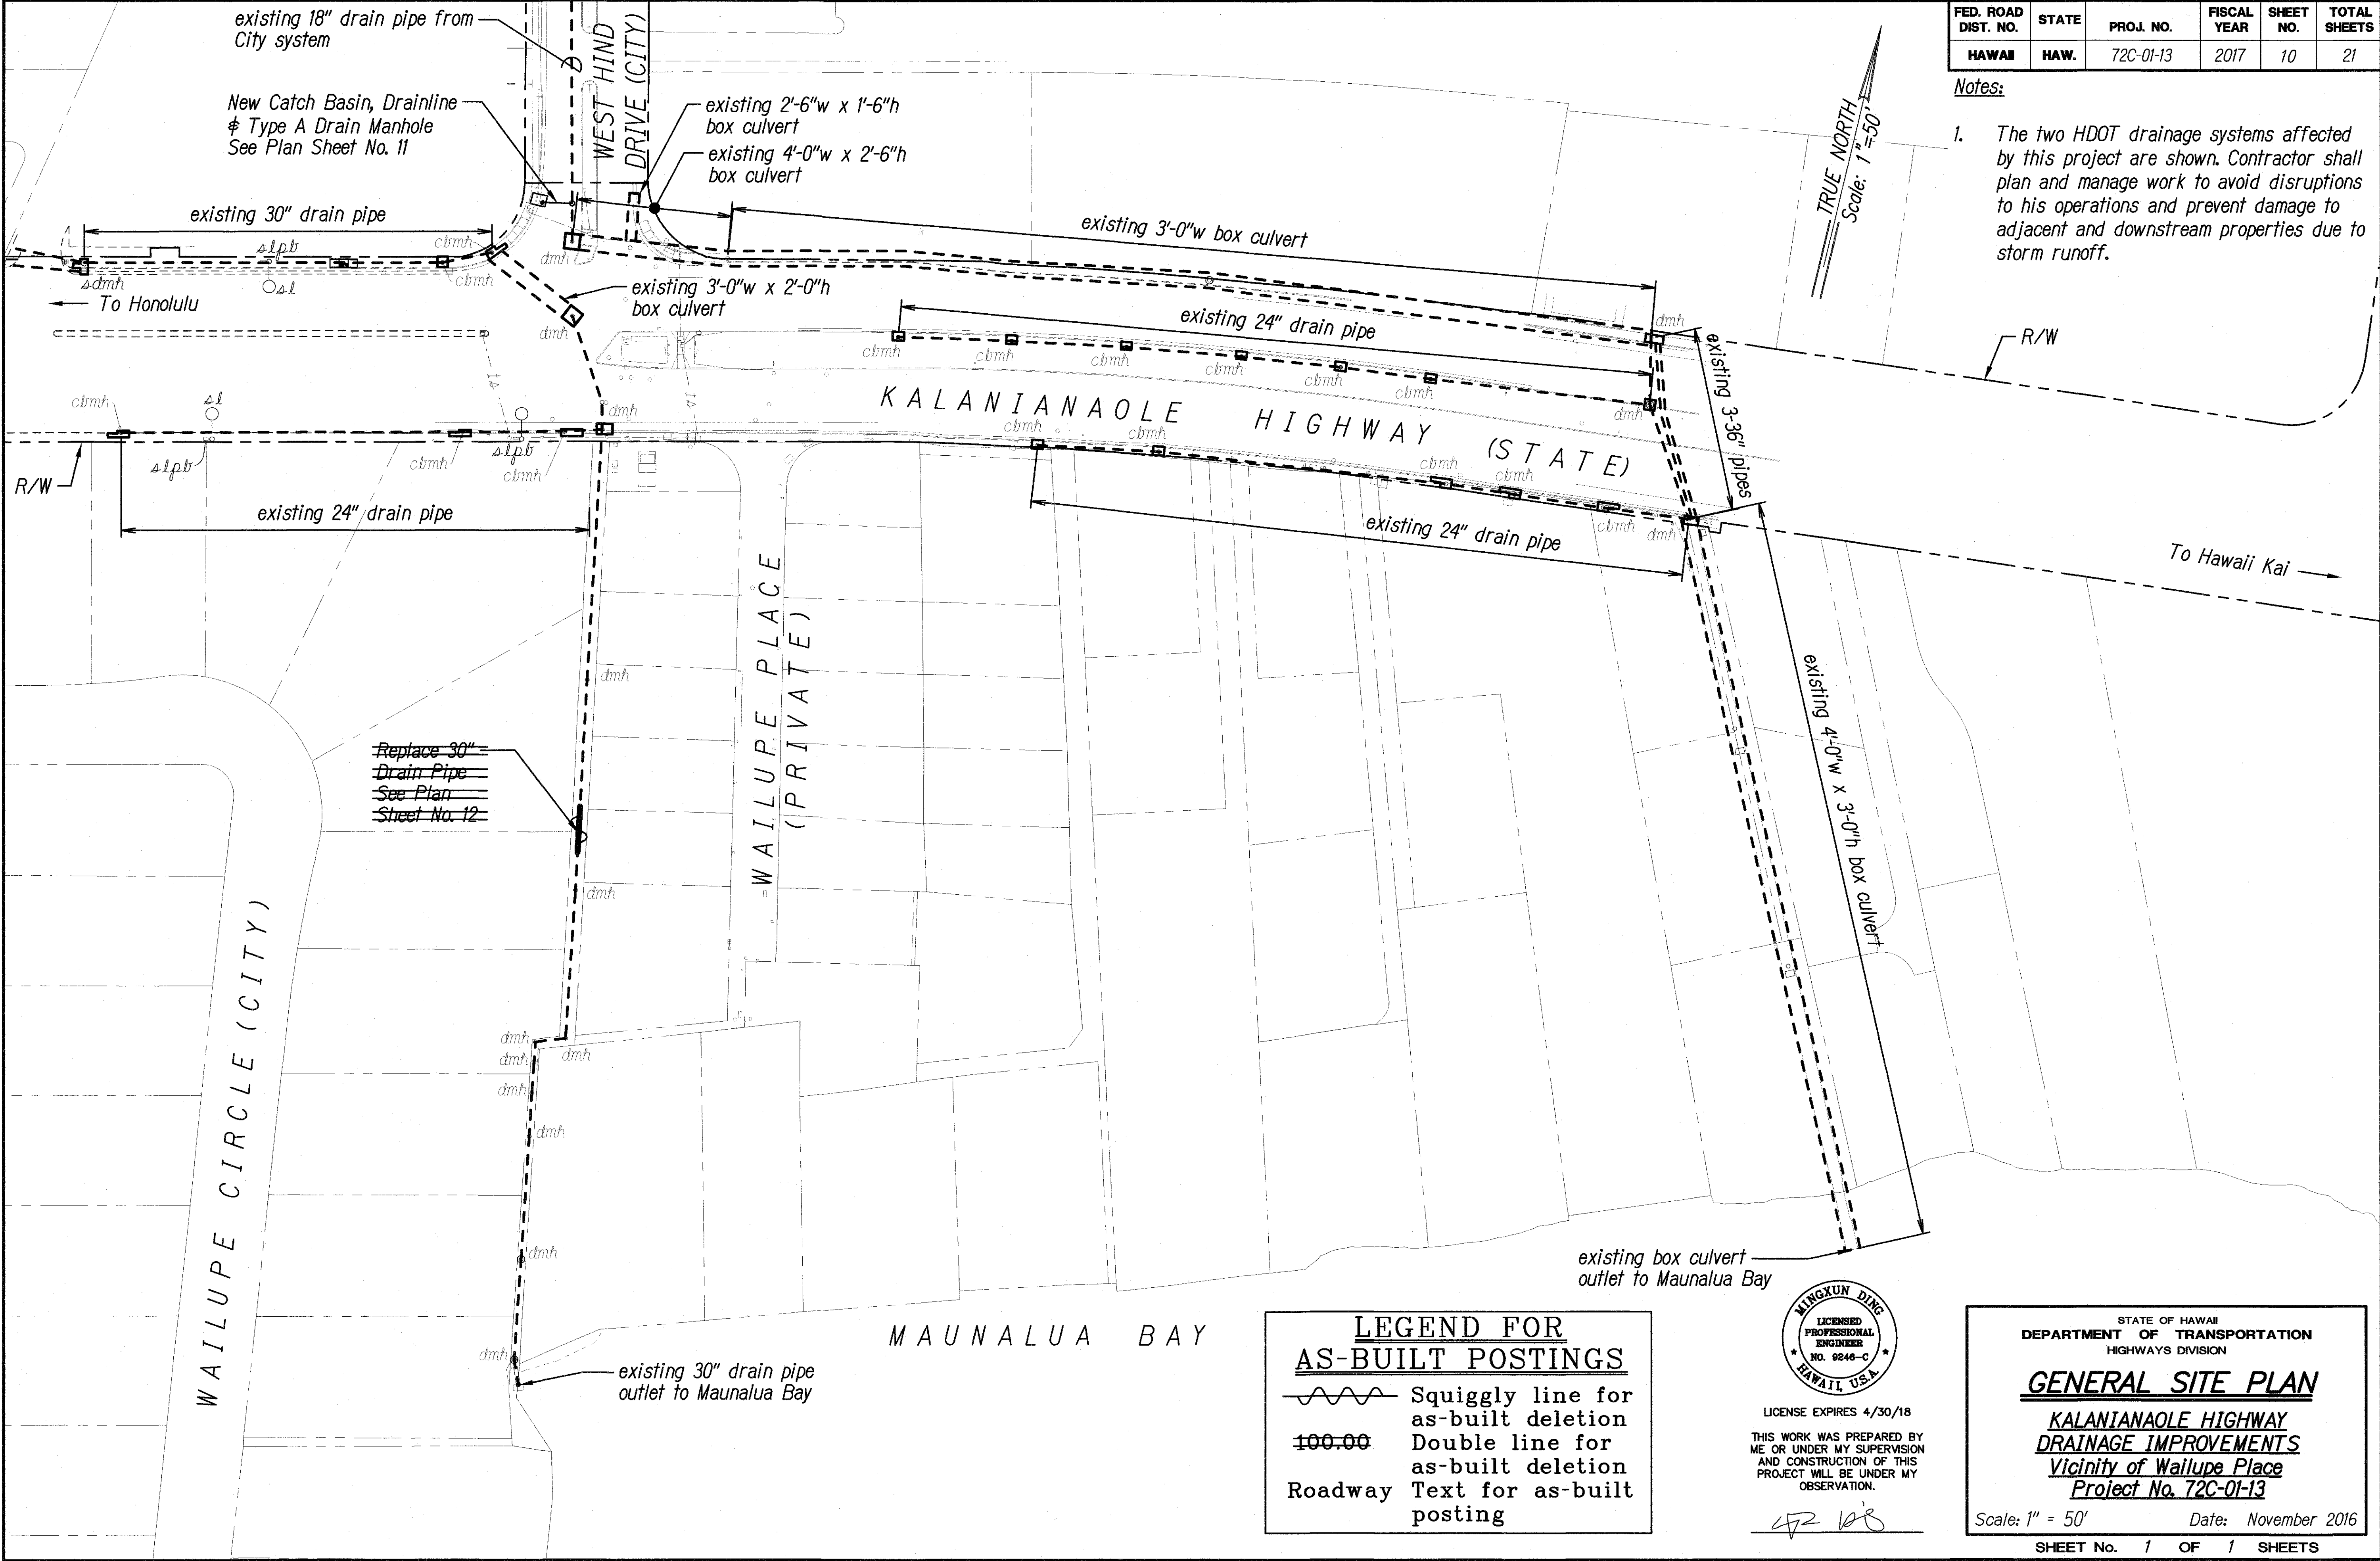

SURVEY PLOTTED BY	DATE
DRAWN BY	
DESIGNED BY	
QUANTITIES BY	
CHECKED BY	
ORIGINAL PLAN	No.
NOTE BOOK	

LEGEND FOR AS-BUILT POSTINGS

— Squiggly line for as-built deletion

100.00 Double line for as-built deletion

Roadway Text for as-built posting

MINGXUN DING
LICENSED PROFESSIONAL ENGINEER
NO. 9246-C
HAWAII, U.S.A.

LICENSE EXPIRES 4/30/18

THIS WORK WAS PREPARED BY ME OR UNDER MY SUPERVISION AND CONSTRUCTION OF THIS PROJECT WILL BE UNDER MY OBSERVATION.

42 108

STATE OF HAWAII
DEPARTMENT OF TRANSPORTATION
HIGHWAYS DIVISION

GENERAL SITE PLAN

KALANIANA'OLE HIGHWAY DRAINAGE IMPROVEMENTS
Vicinity of Waialeale Place
Project No. 72C-01-13

Scale: 1" = 50' Date: November 2016

SHEET No. 1 OF 1 SHEETS

"AS-BUILT"