



FED. ROAD DIST. NO.	STATE	PROJ. NO.	FISCAL YEAR	SHEET NO.	TOTAL SHEETS
HAWAII	HAW.	72C-01-13	2017	15	21

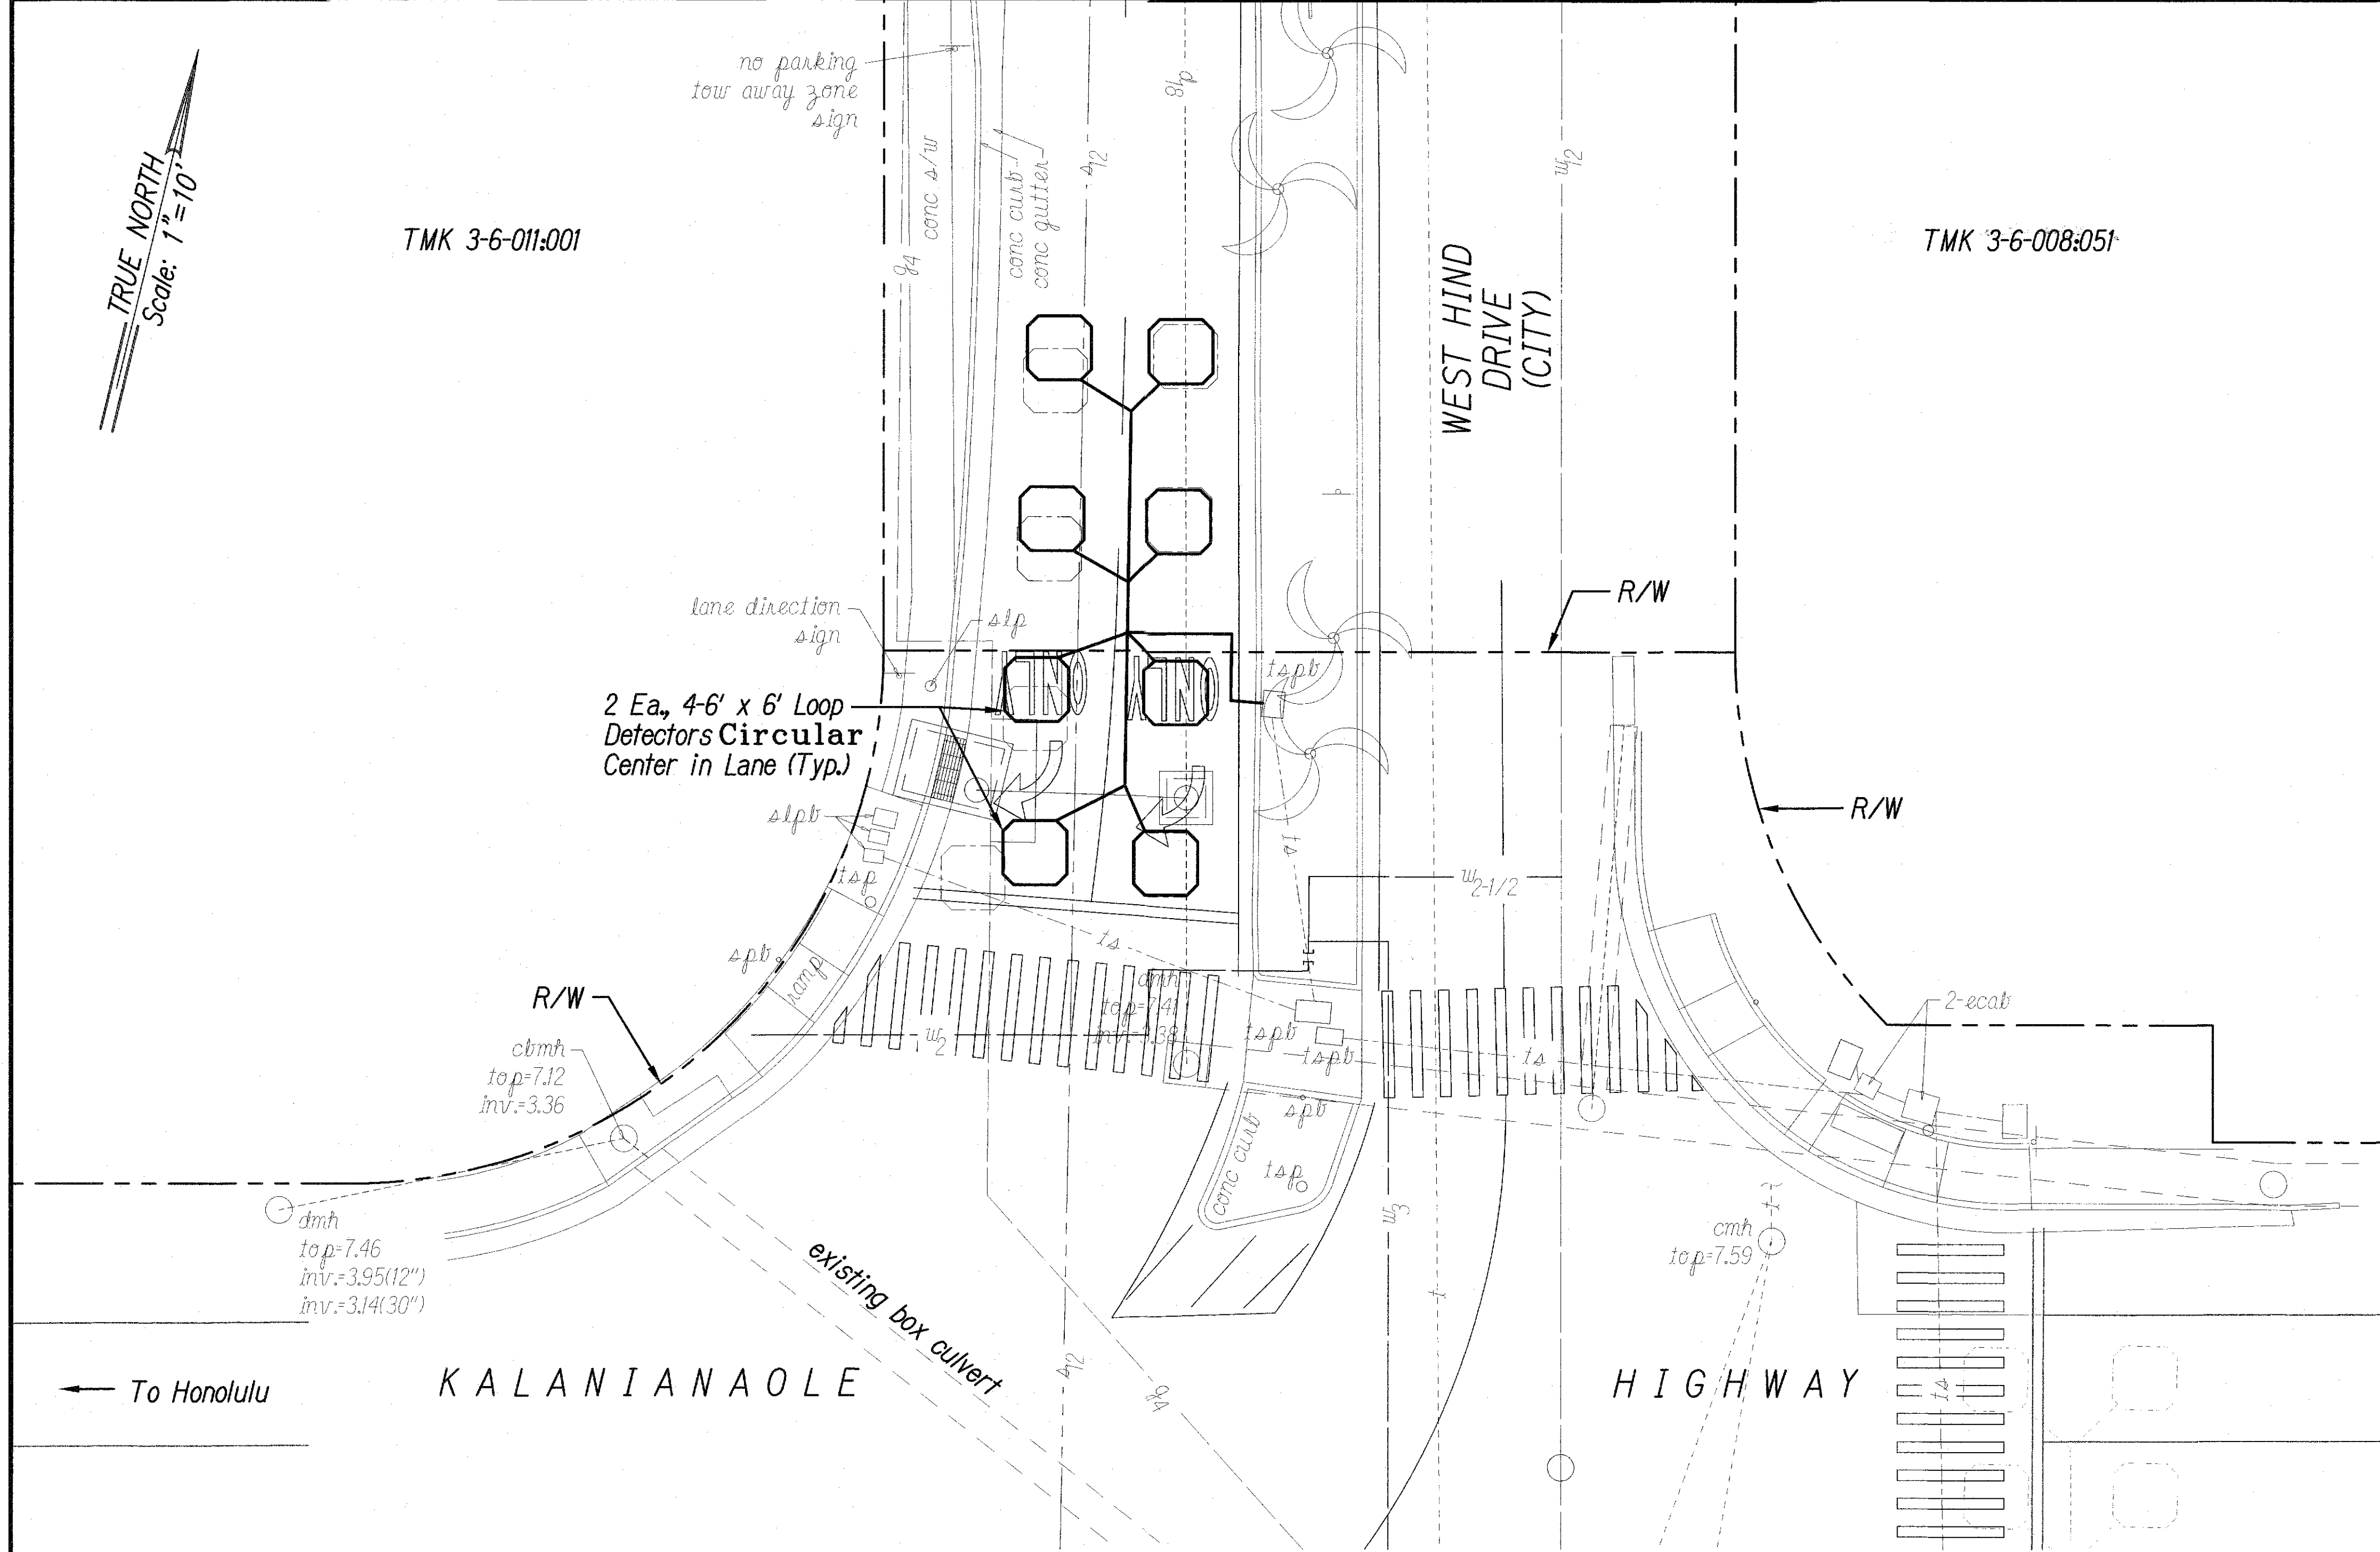

- Note:**
1. Install Temporary Microwave Detectors on existing traffic signal pole. Payment shall be incidental to Item No. 623.0100.
  2. Contractor shall coordinate with City and County of Honolulu Department of Transportation Services (DTS) Signal Shop (Supervisor Wally Nakihiro @ 564-6101) for all traffic signal-related work. Schedule with DTS Signal Shop at least two weeks in advance of the actual work, including pavement cold planing and removing the existing loop detectors.
  3. Contractor shall take the necessary care and precautions to protect the existing detector loops to remain, such that the system is operational to the satisfaction of DTS at the conclusion of the work on the system. The Contractor is responsible for repair and/or replacement of the existing detector loops to remain if damaged by his/her operations, to the satisfaction of DTS.
  4. Contractor shall perform all traffic signal-related work following field instructions from DTS Signal Shop personnel. Such field instructions shall include, but not limited to, the final location and quantity of the temporary microwave sensors and permanent detector loops. DTS Signal Shop personnel will be responsible for traffic signal controller programming at the traffic signal cabinet to accommodate the temporary and permanent operations.
  5. Contractor shall take down the temporary microwave sensors when the permanent detector loops are in place and operational. Contractor shall perform all necessary work to restore the traffic signal system back to a neat appearance of the electrical trade.

### LEGEND FOR AS-BUILT POSTINGS

- Squiggly line for as-built deletion
- Double line for as-built deletion
- Roadway Text for as-built posting

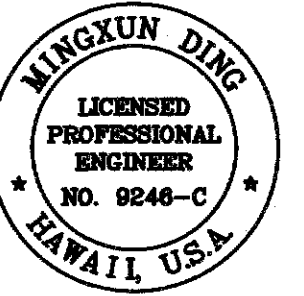

LICENSE EXPIRES 4/30/18  
THIS WORK WAS PREPARED BY ME OR UNDER MY SUPERVISION AND CONSTRUCTION OF THIS PROJECT WILL BE UNDER MY OBSERVATION.

STATE OF HAWAII  
DEPARTMENT OF TRANSPORTATION  
HIGHWAYS DIVISION  
**TRAFFIC SIGNAL PLAN**  
**KALANIANAʻOLE HIGHWAY**  
**DRAINAGE IMPROVEMENTS**  
**Vicinity of Waiupe Place**  
**Project No. 72C-01-13**

Scale: As Shown Date: November 2016  
SHEET No. 2 OF 3 SHEETS

"AS-BUILT"