



1 LONGITUDINAL SECTION - LOOKING MAKAI
S-6, S-9, S-9 Scale: 1/4" = 1'-0"

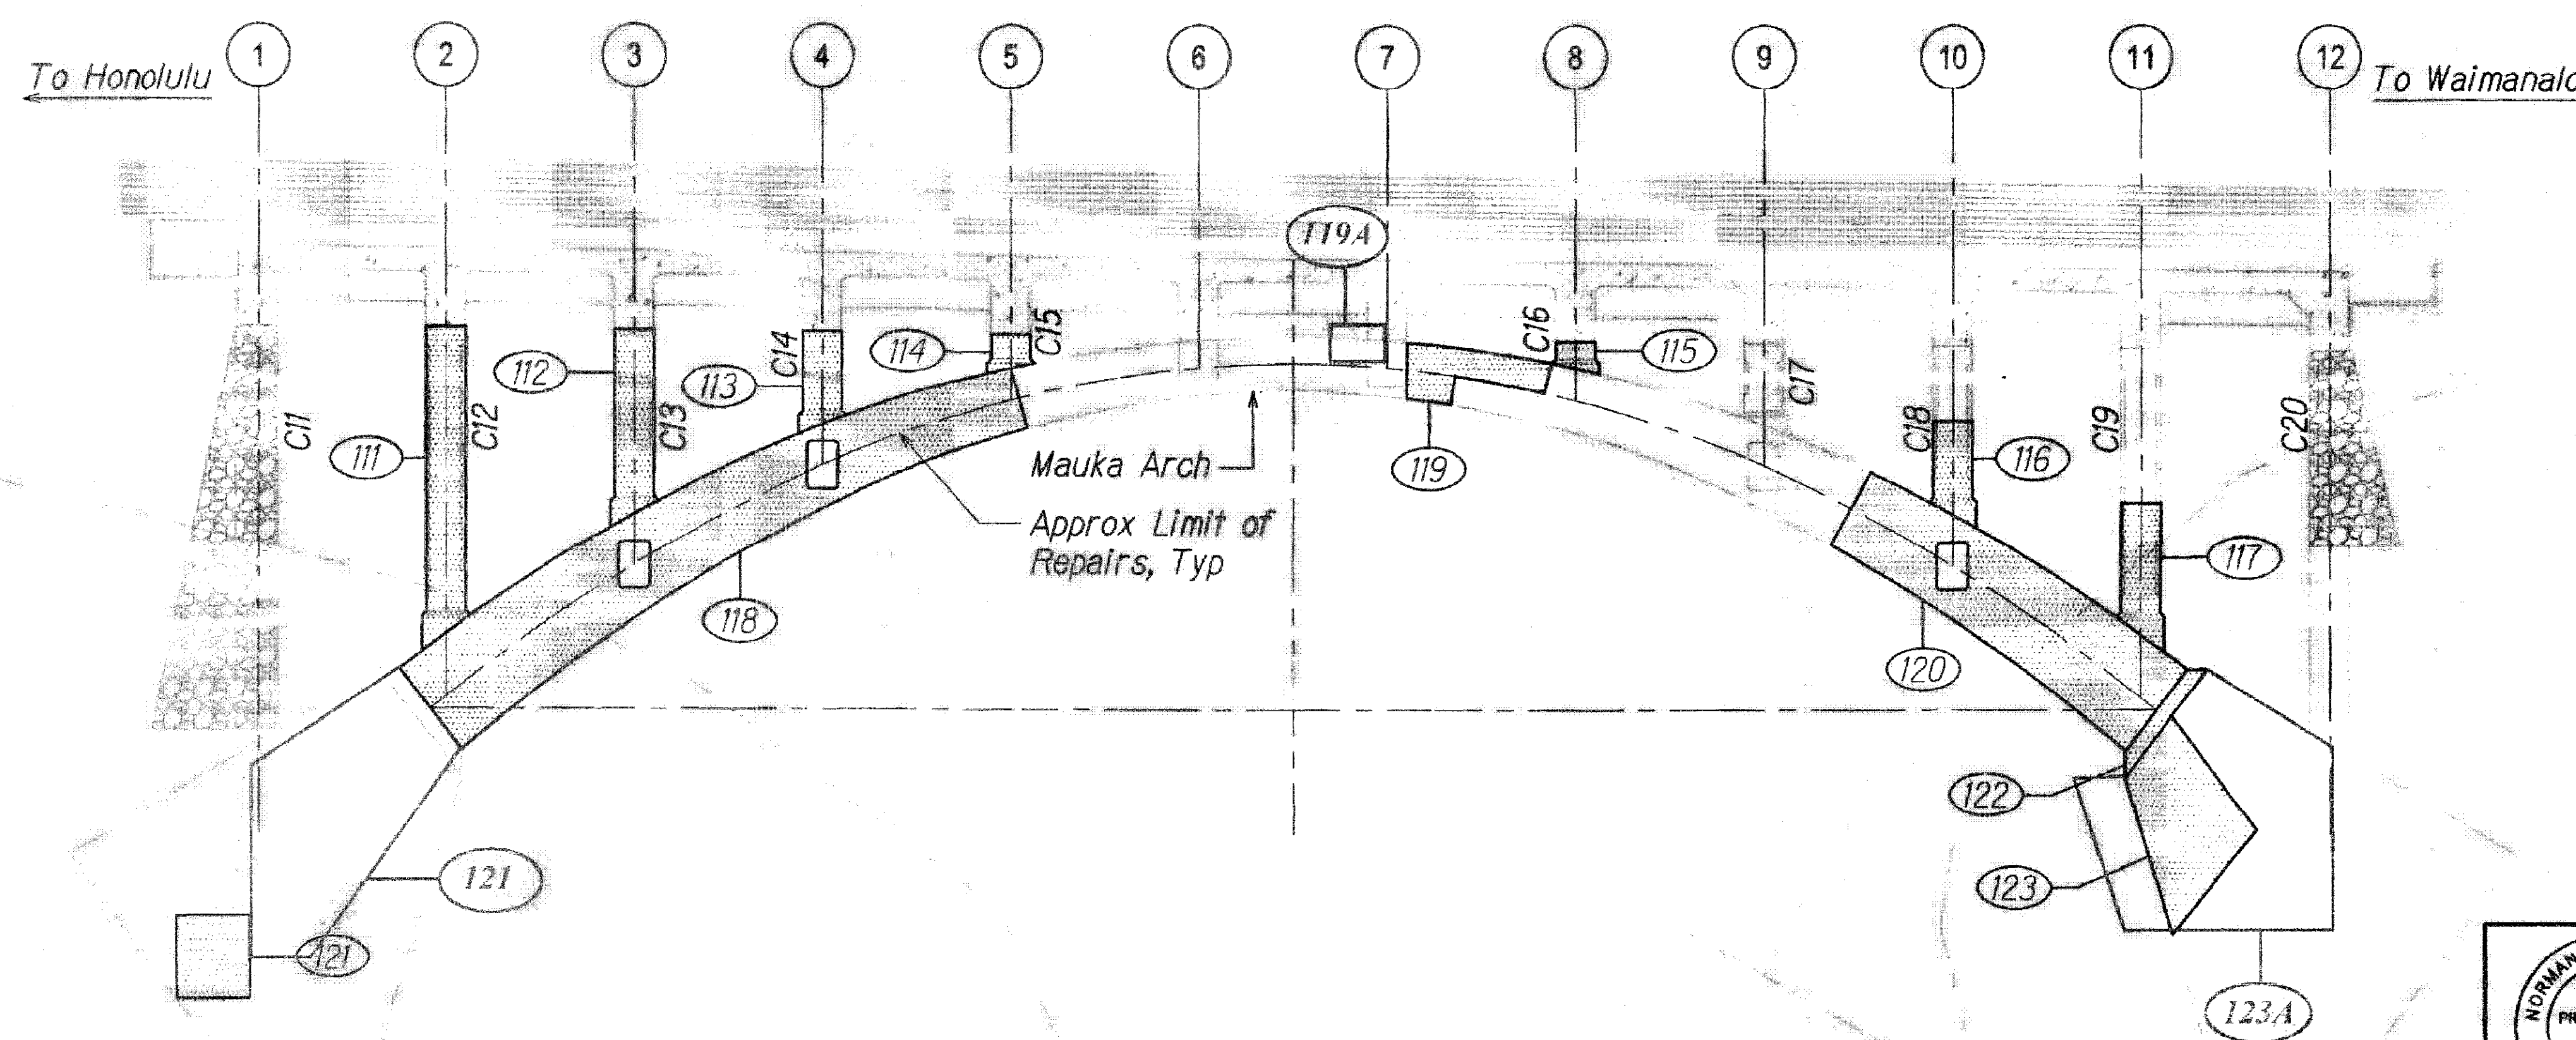

2 LONGITUDINAL SECTION - LOOKING MAUKA
S-6, S-9, S-9 Scale: 1/4" = 1'-0"

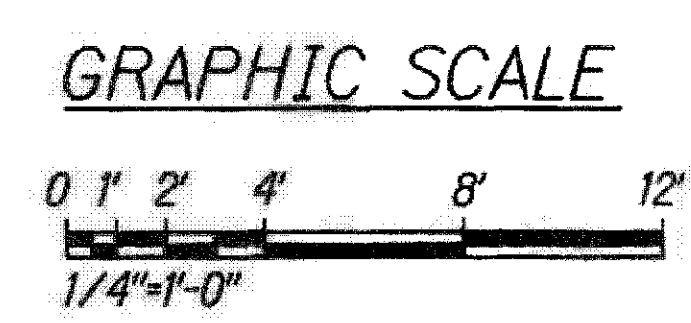

FED. ROAD DIST. NO.	STATE	PROJ. NO.	FISCAL YEAR	SHEET NO.	TOTAL SHEETS
HAWAII	HAW.	72B-01-13M	2013	12	34

REFERENCE DRAWINGS:
1. Bent Elevations, see sheet S-10 to S-13.

AS-BUILT DRAWINGS
This certifies that the dimensions and details on these sheets reflect the dimensions, details, and specifications as constructed in the field.
Certified by: *Shawn G...*
Ideal Construction, Inc.
Signature: *Shawn G...*
Date: _____

LEGEND
[Shaded box] Extent of Repair
[Circle with number] Repair Number, See Schedule on Sheet S-14

LEGEND FOR AS-BUILT POSTINGS
[Wavy line] Squiggly line for as-built deletion
[Double line] Double line for as-built deletion
[Text] Text for as-built posting

STATE OF HAWAII
DEPARTMENT OF TRANSPORTATION
HIGHWAYS DIVISION

LONGITUDINAL SECTIONS

KALANIANA'OLE HIGHWAY
Emergency Repairs of Ihiihilauea Bridge
Project No. 72B-01-13M

Scale: As Shown Date: Jan. 16, 2013

SHEET No. S-9 OF 26 SHEETS

SURVEY ROUTED BY	DATE
DESIGNED BY	
TRACED BY	
NOTED BY	
CHECKED BY	
ORIGINAL PLAN	
NO. _____	

"AS-BUILT"