	INDEX TO DRAWINGS
SHEET NO.	DESCRIPTION
	TITLE SHEET
2	STANDARD PLANS SUMMARY
3	LEGEND & GENERAL NOTES
4	TRAFFIC SIGNAL PLAN
5	STRIPING, SIGNING, &
	MISCELLANEOUS DETAILS
6	TRAFFIC CONTROL
*C.0.6S-I	IMPROVEMENT AT PUU IKENA
	DRIVE AND KALANIANAOLE
	HIGHWAY INTERSECTIONS
•	
• ,	

STATE OF HAWAII


DEPARTMENT OF TRANSPORTATION HIGHWAYS DIVISION HONOLULU, HAWAII "AS-BUILT"


PLANS FOR

WAIALAE AVENUE INTERSECTION IMPROVEMENTS AT KILAUEA AVENUE

Project No. 7801A-01-87

DISTRICT OF HONOLULU ISLAND OF OAHU

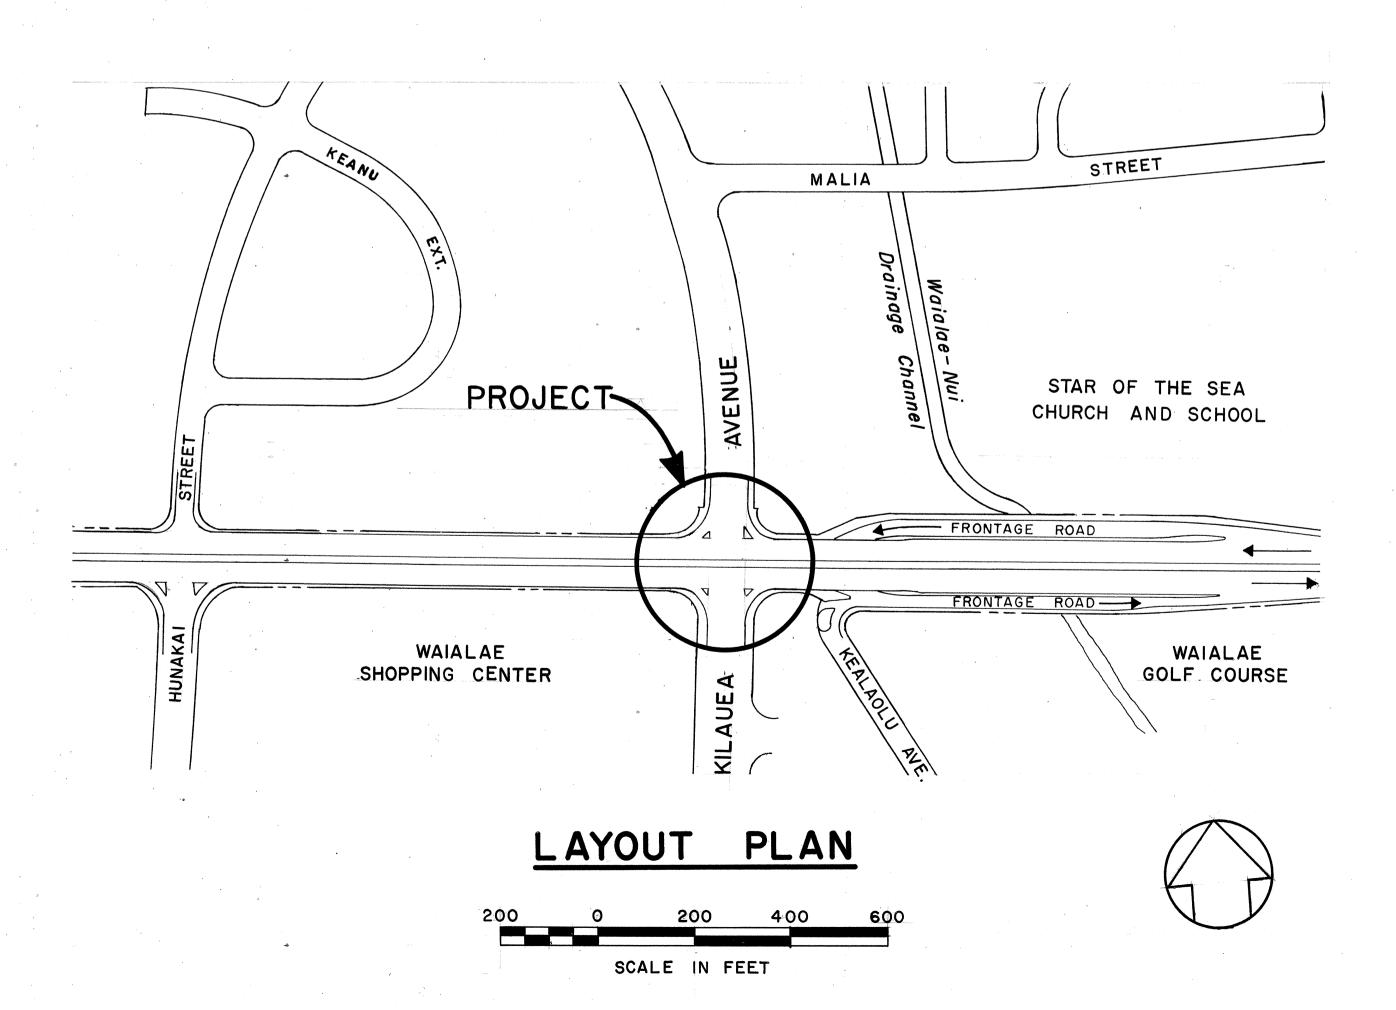

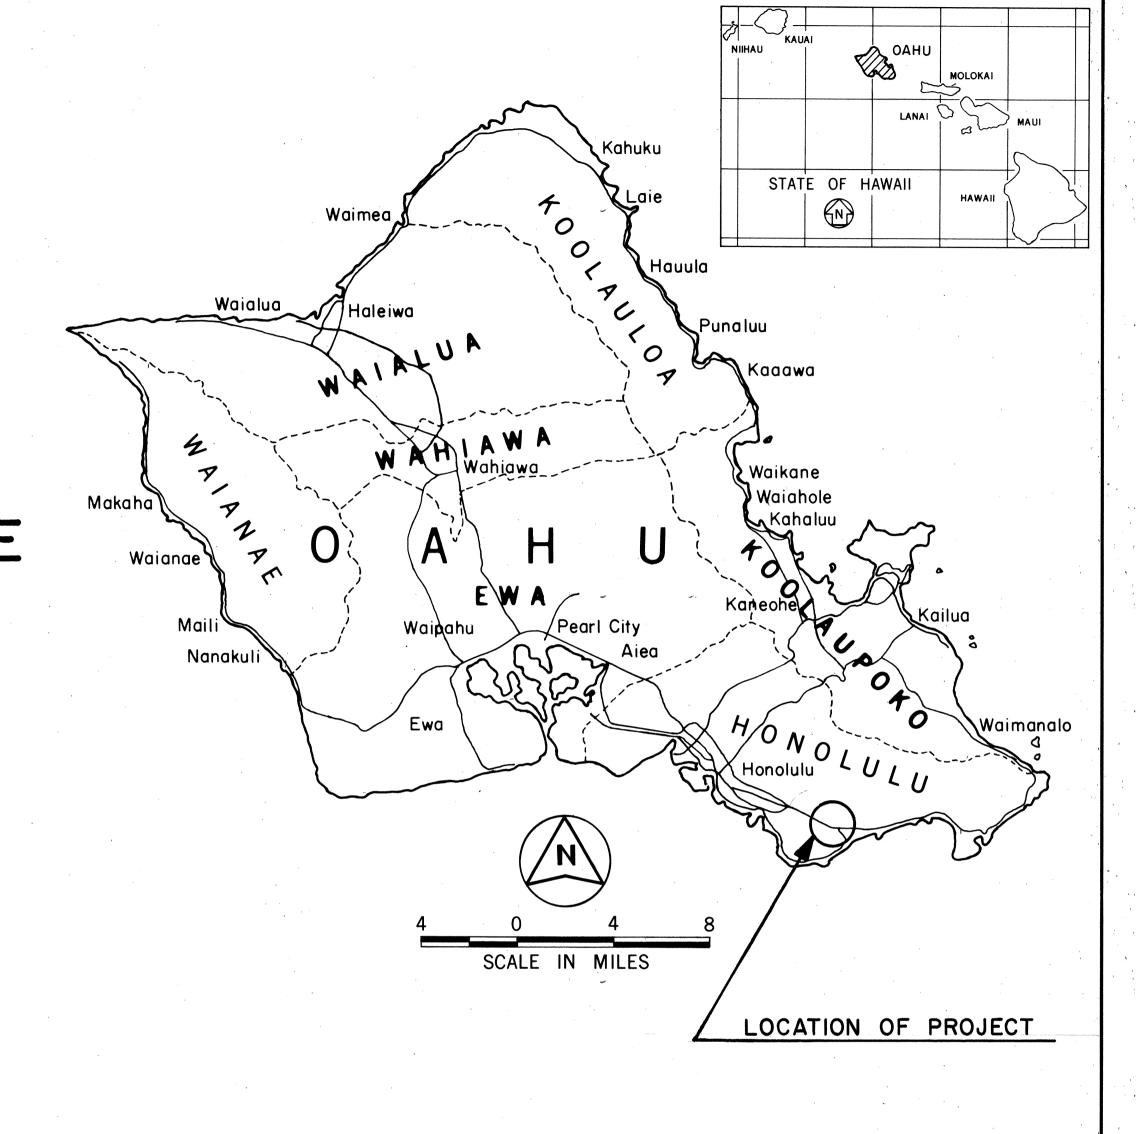

FED. ROAD DIST. NO.

STATE

PROJ. NO.

780IA-0I-87

CHANGES MADE DURING CONSTRUCTION HAVE BEEN INCORPORATED ON THESE PLANS EXCEPT CHANGES IN THE ORIGINAL THEORETICAL QUANTITIES. FOR ACTUAL QUANTITIES, REFER TO PROJECT LEDGER AND/OR COMPUTATION BOOK.





FISCAL SHEET TOTAL YEAR NO. SHEETS

ul.	DEPARTMENT OF TRANSPORTATION STATE OF HAWAII	
	APPROVED:	
7	DEDIR. OF TRANSPORTATION DATE	
	DATE	

(-6-6

548-4042 PHONE

FRED ABESHIMA P. S. & E. BY