




FED. ROAD DIST. NO.	STATE	FED. AID PROJ. NO.	FISCAL YEAR	SHEET NO.	TOTAL SHEETS
HAWAII	HAW.	72B-01-BBM	1988	4	6

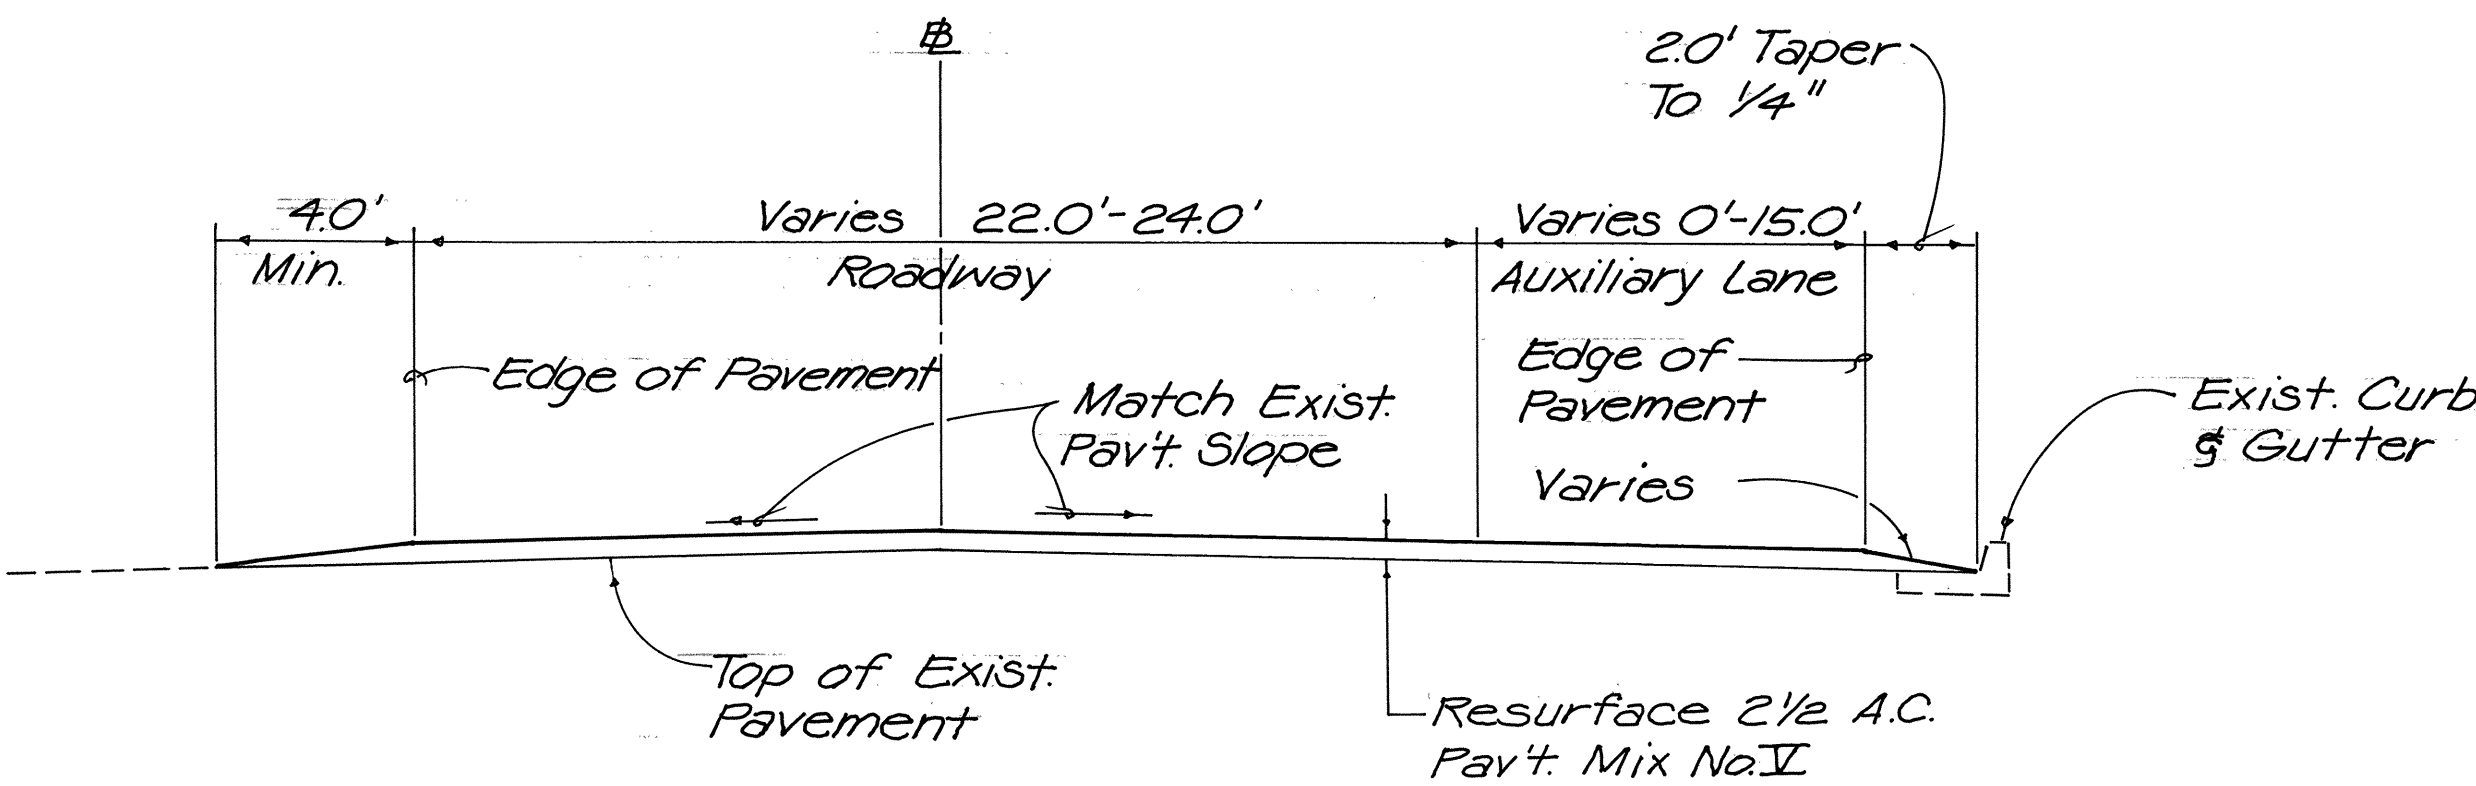


TYPICAL ROADWAY SECTION
Not To Scale

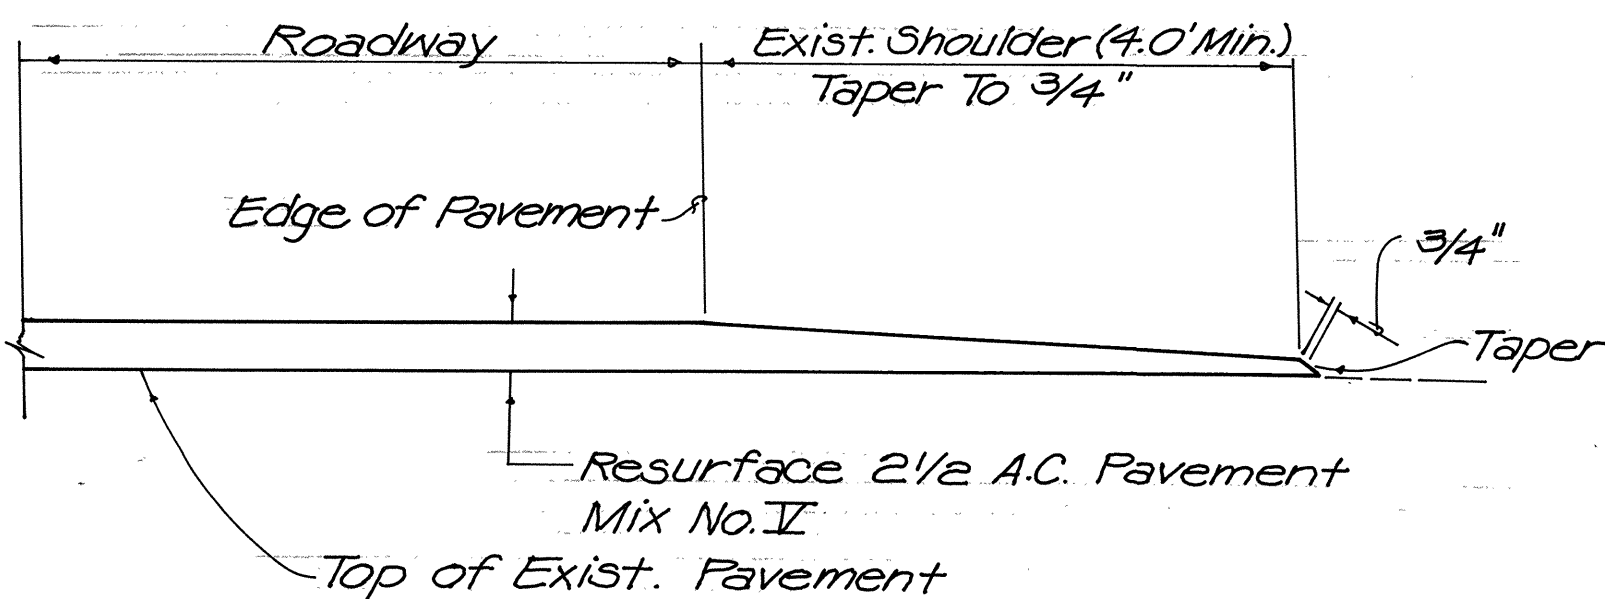


TYPICAL SHOULDER SECTION
Not To Scale

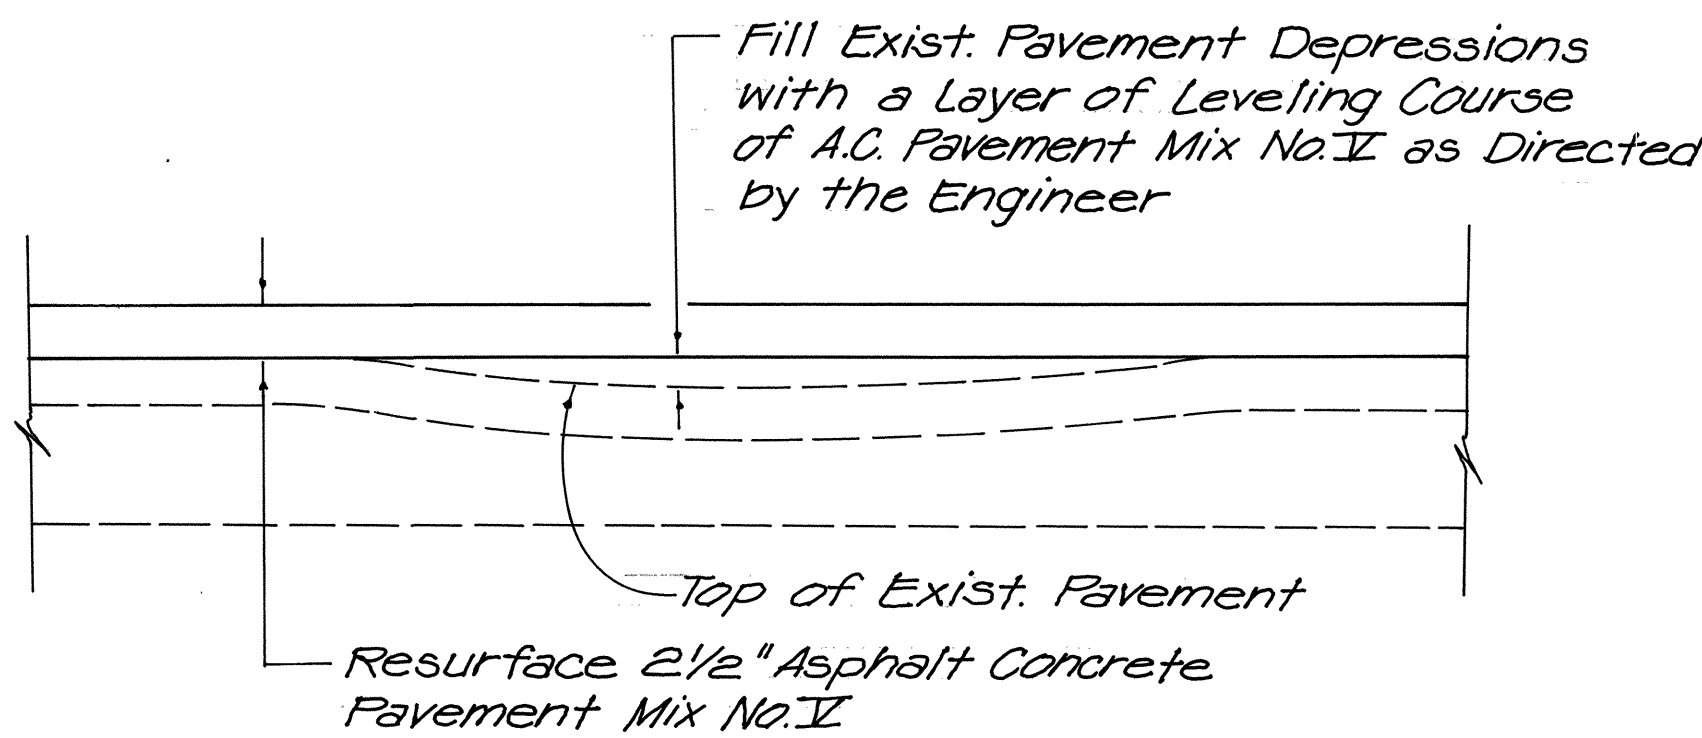

LEVELING COURSE DETAIL
Not To Scale

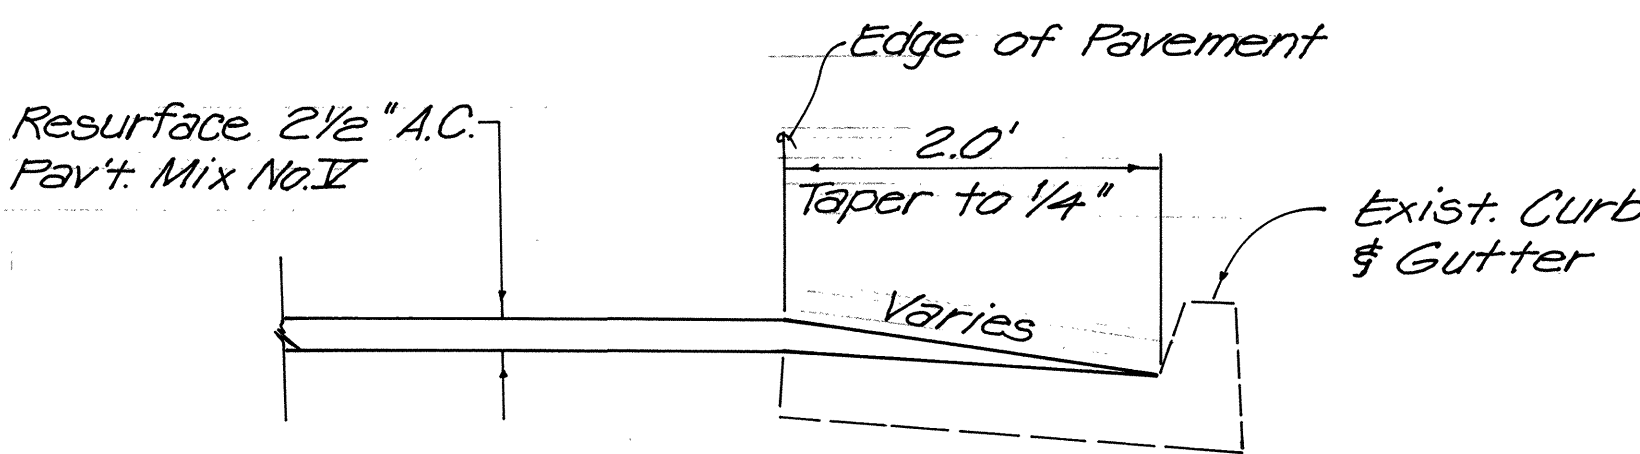

CURB AND GUTTER SECTION
Not To Scale

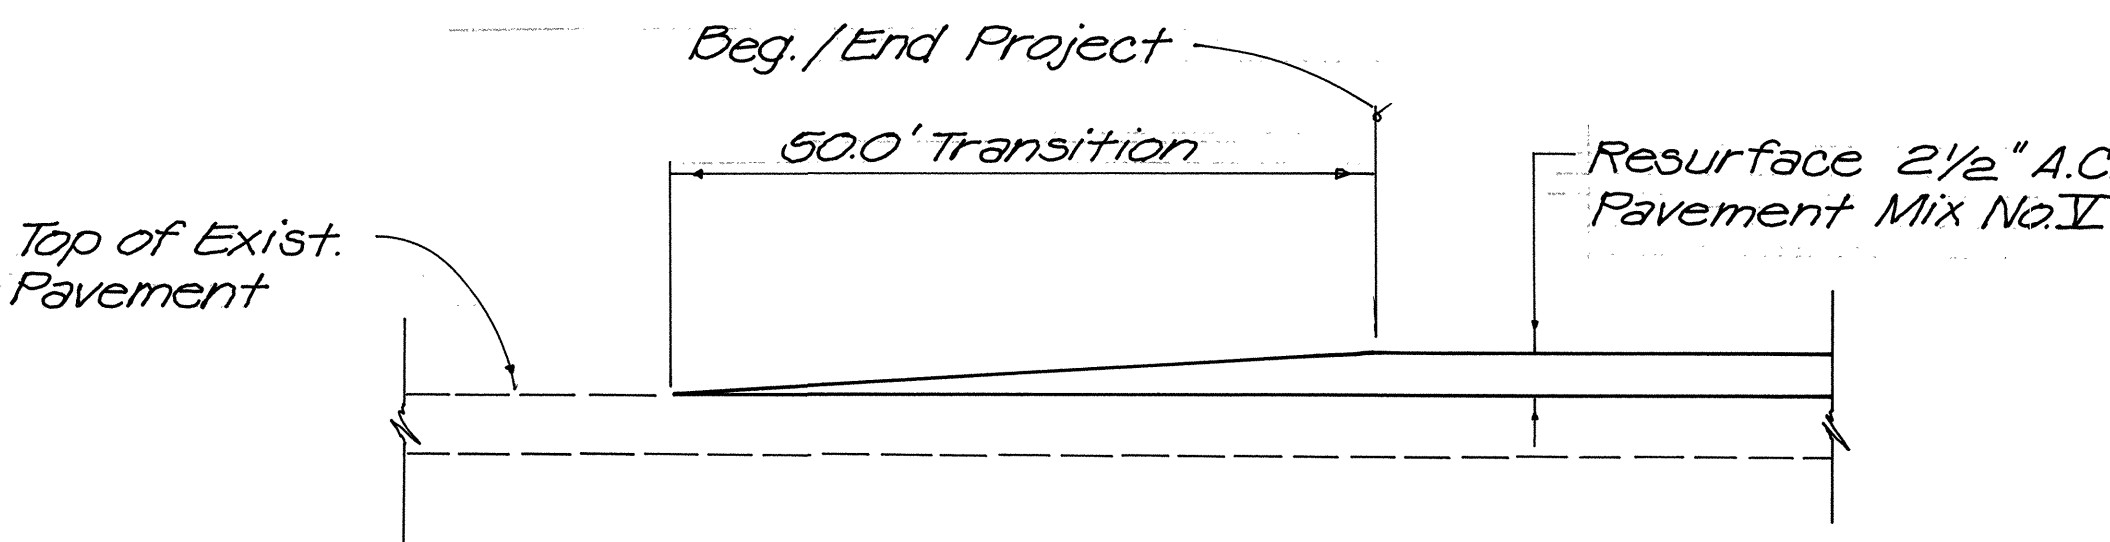

TYPICAL SECTION OF LONGITUDINAL PAVEMENT TRANSITION
Not To Scale

SURVEY PLOTTED BY	DATE
DRAWN BY	
TRACED BY	
NOTED BY	
CHECKED BY	
NO.	

STATE OF HAWAII
DEPARTMENT OF TRANSPORTATION
HIGHWAYS DIVISION

TYPICAL SECTIONS
KALANIANA'OLE HWY. RESURFACING
Lunalilo Home Rd. to Nawiliwili St.
Proj. No. 72B-01-BBM
Scale: As Noted Date: Nov., 1987

SHEET No. 1 OF 1 SHEETS