
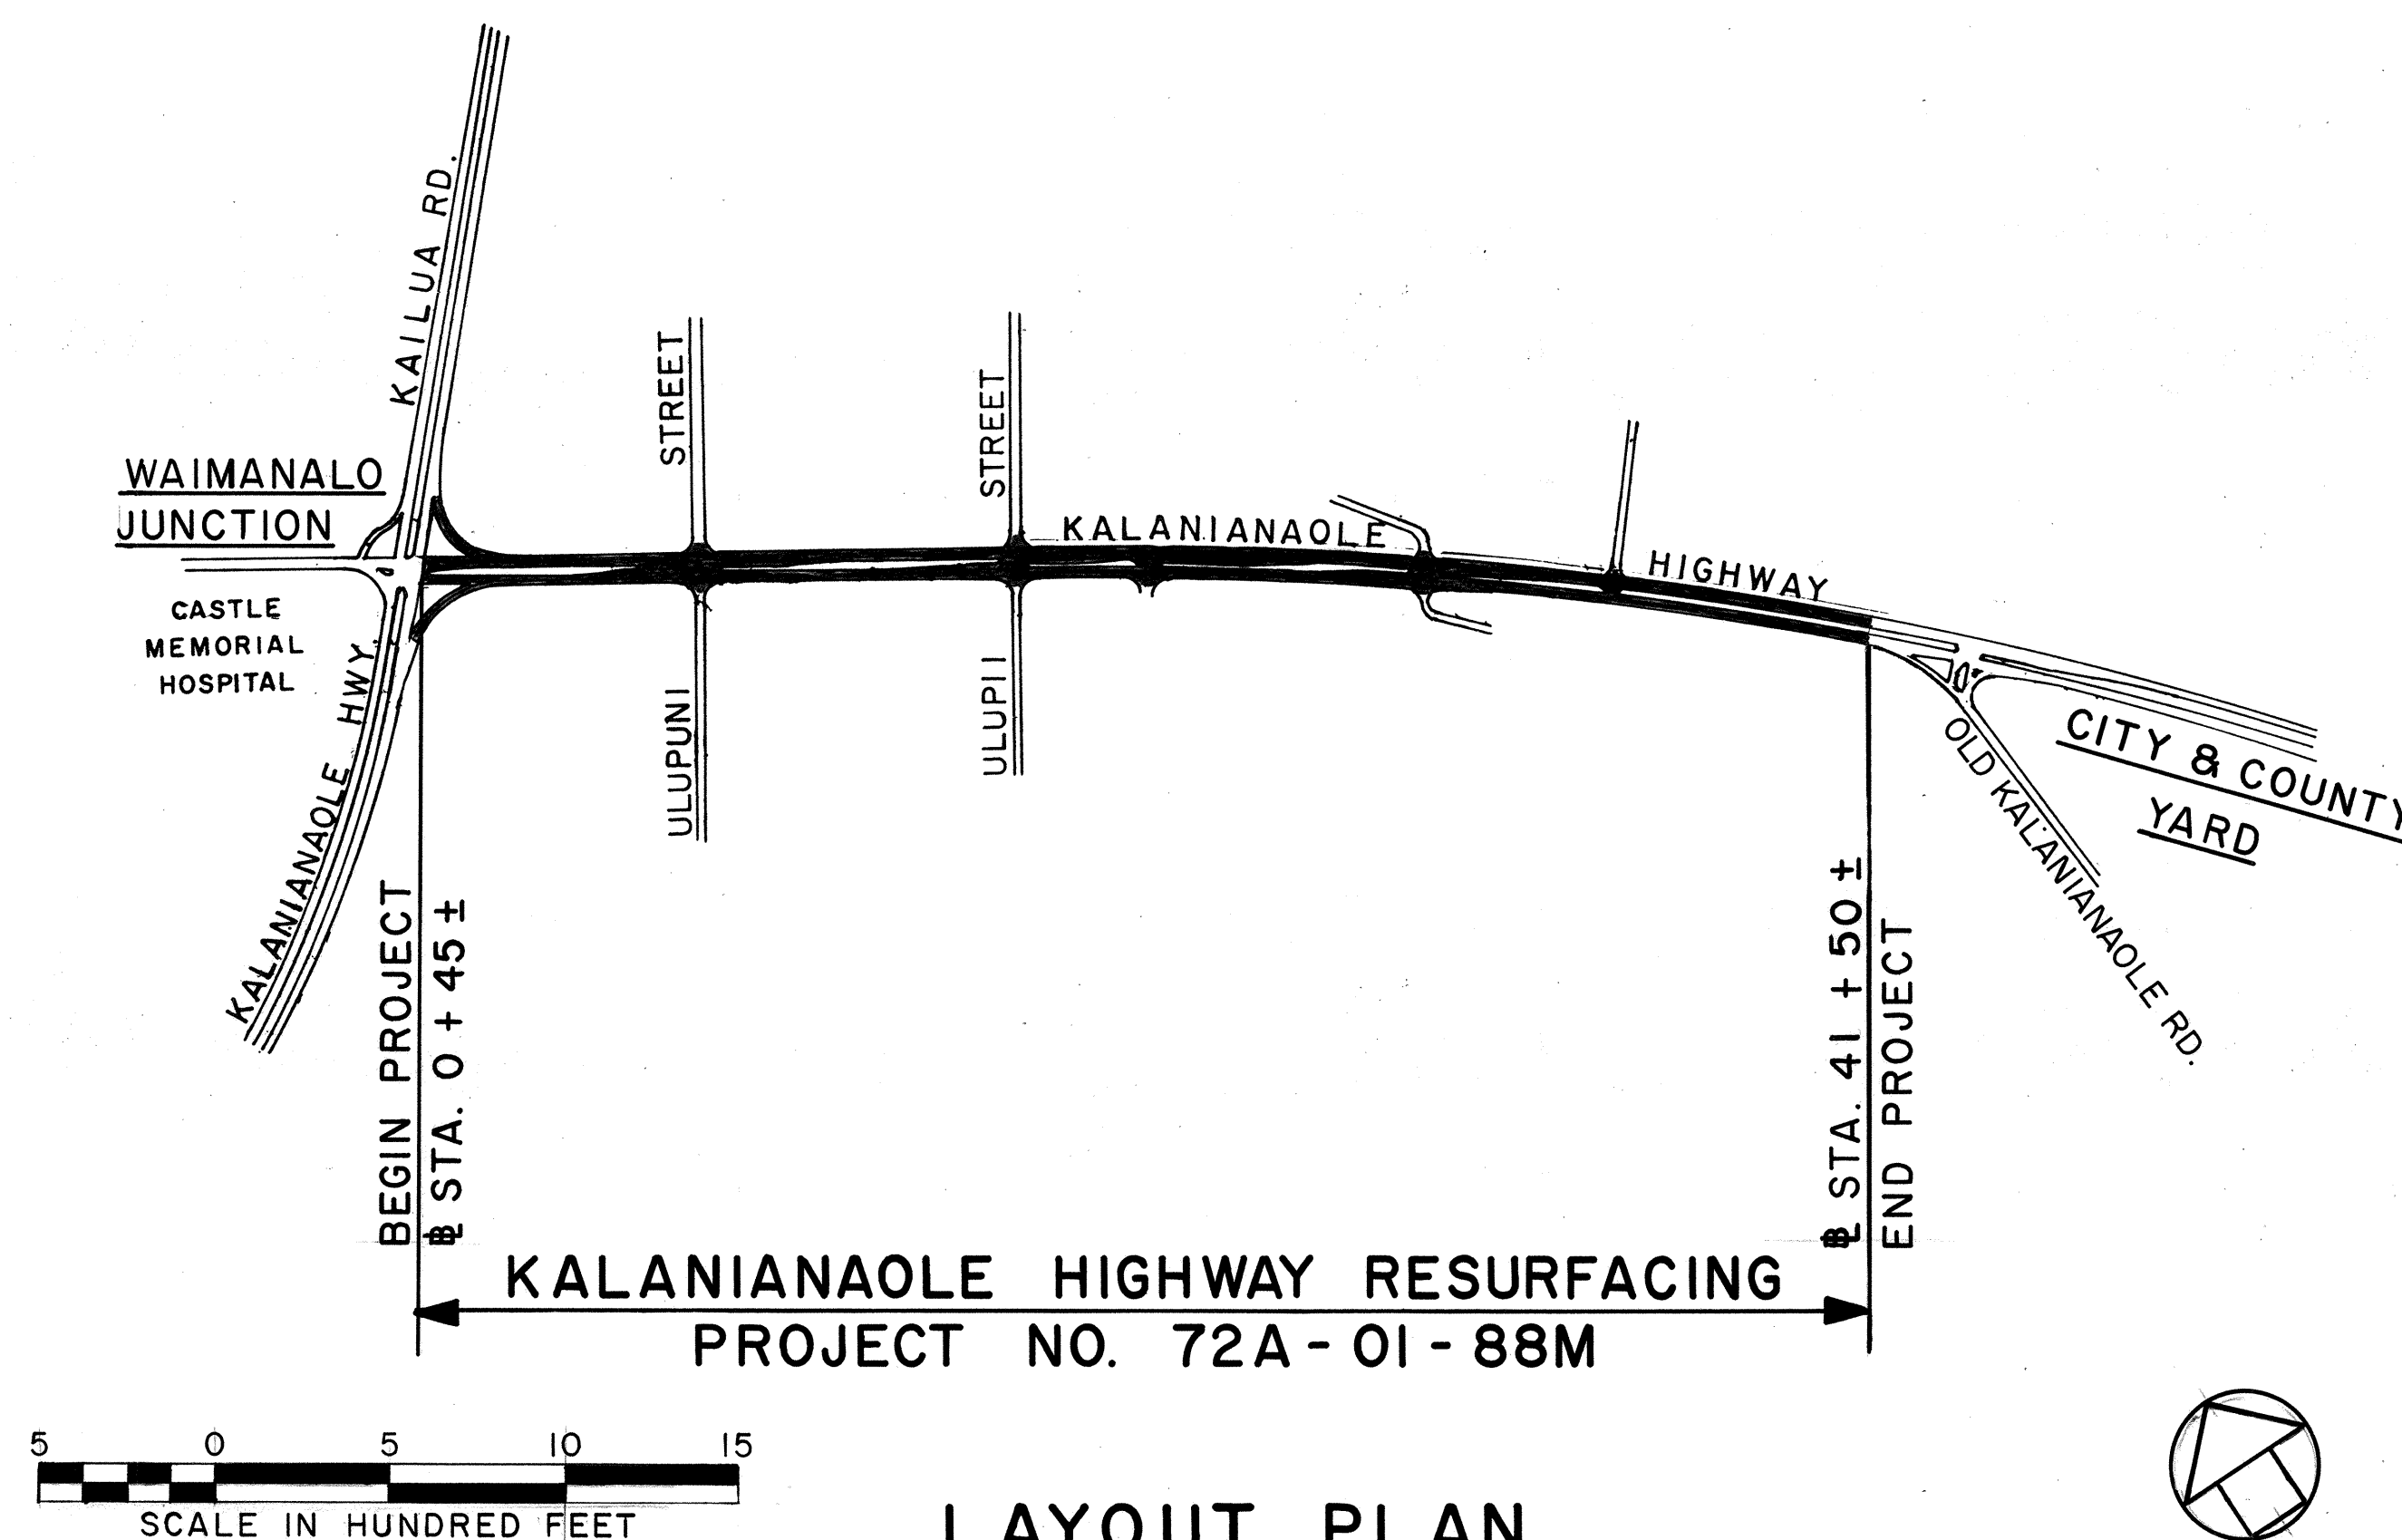


[illegible]

STATE OF HAWAII  
DEPARTMENT OF TRANSPORTATION  
HIGHWAYS DIVISION  
HONOLULU, HAWAII  
"AS-BUILT"  
PLANS FOR  
KALANIANA'OLE HIGHWAY RESURFACING  
WAIMANALO JUNCTION TO CITY & COUNTY YARD  
PROJECT NO. 72A - 01 - 88M

DISTRICT OF KOOLAUPOKO  
ISLAND OF OAHU

FED. ROAD DIST. NO.	STATE	PROJ. NO.	FISCAL YEAR	SHEET NO.	TOTAL SHEETS
HAWAII	HAW.	72A-01-88M	1988	1	9

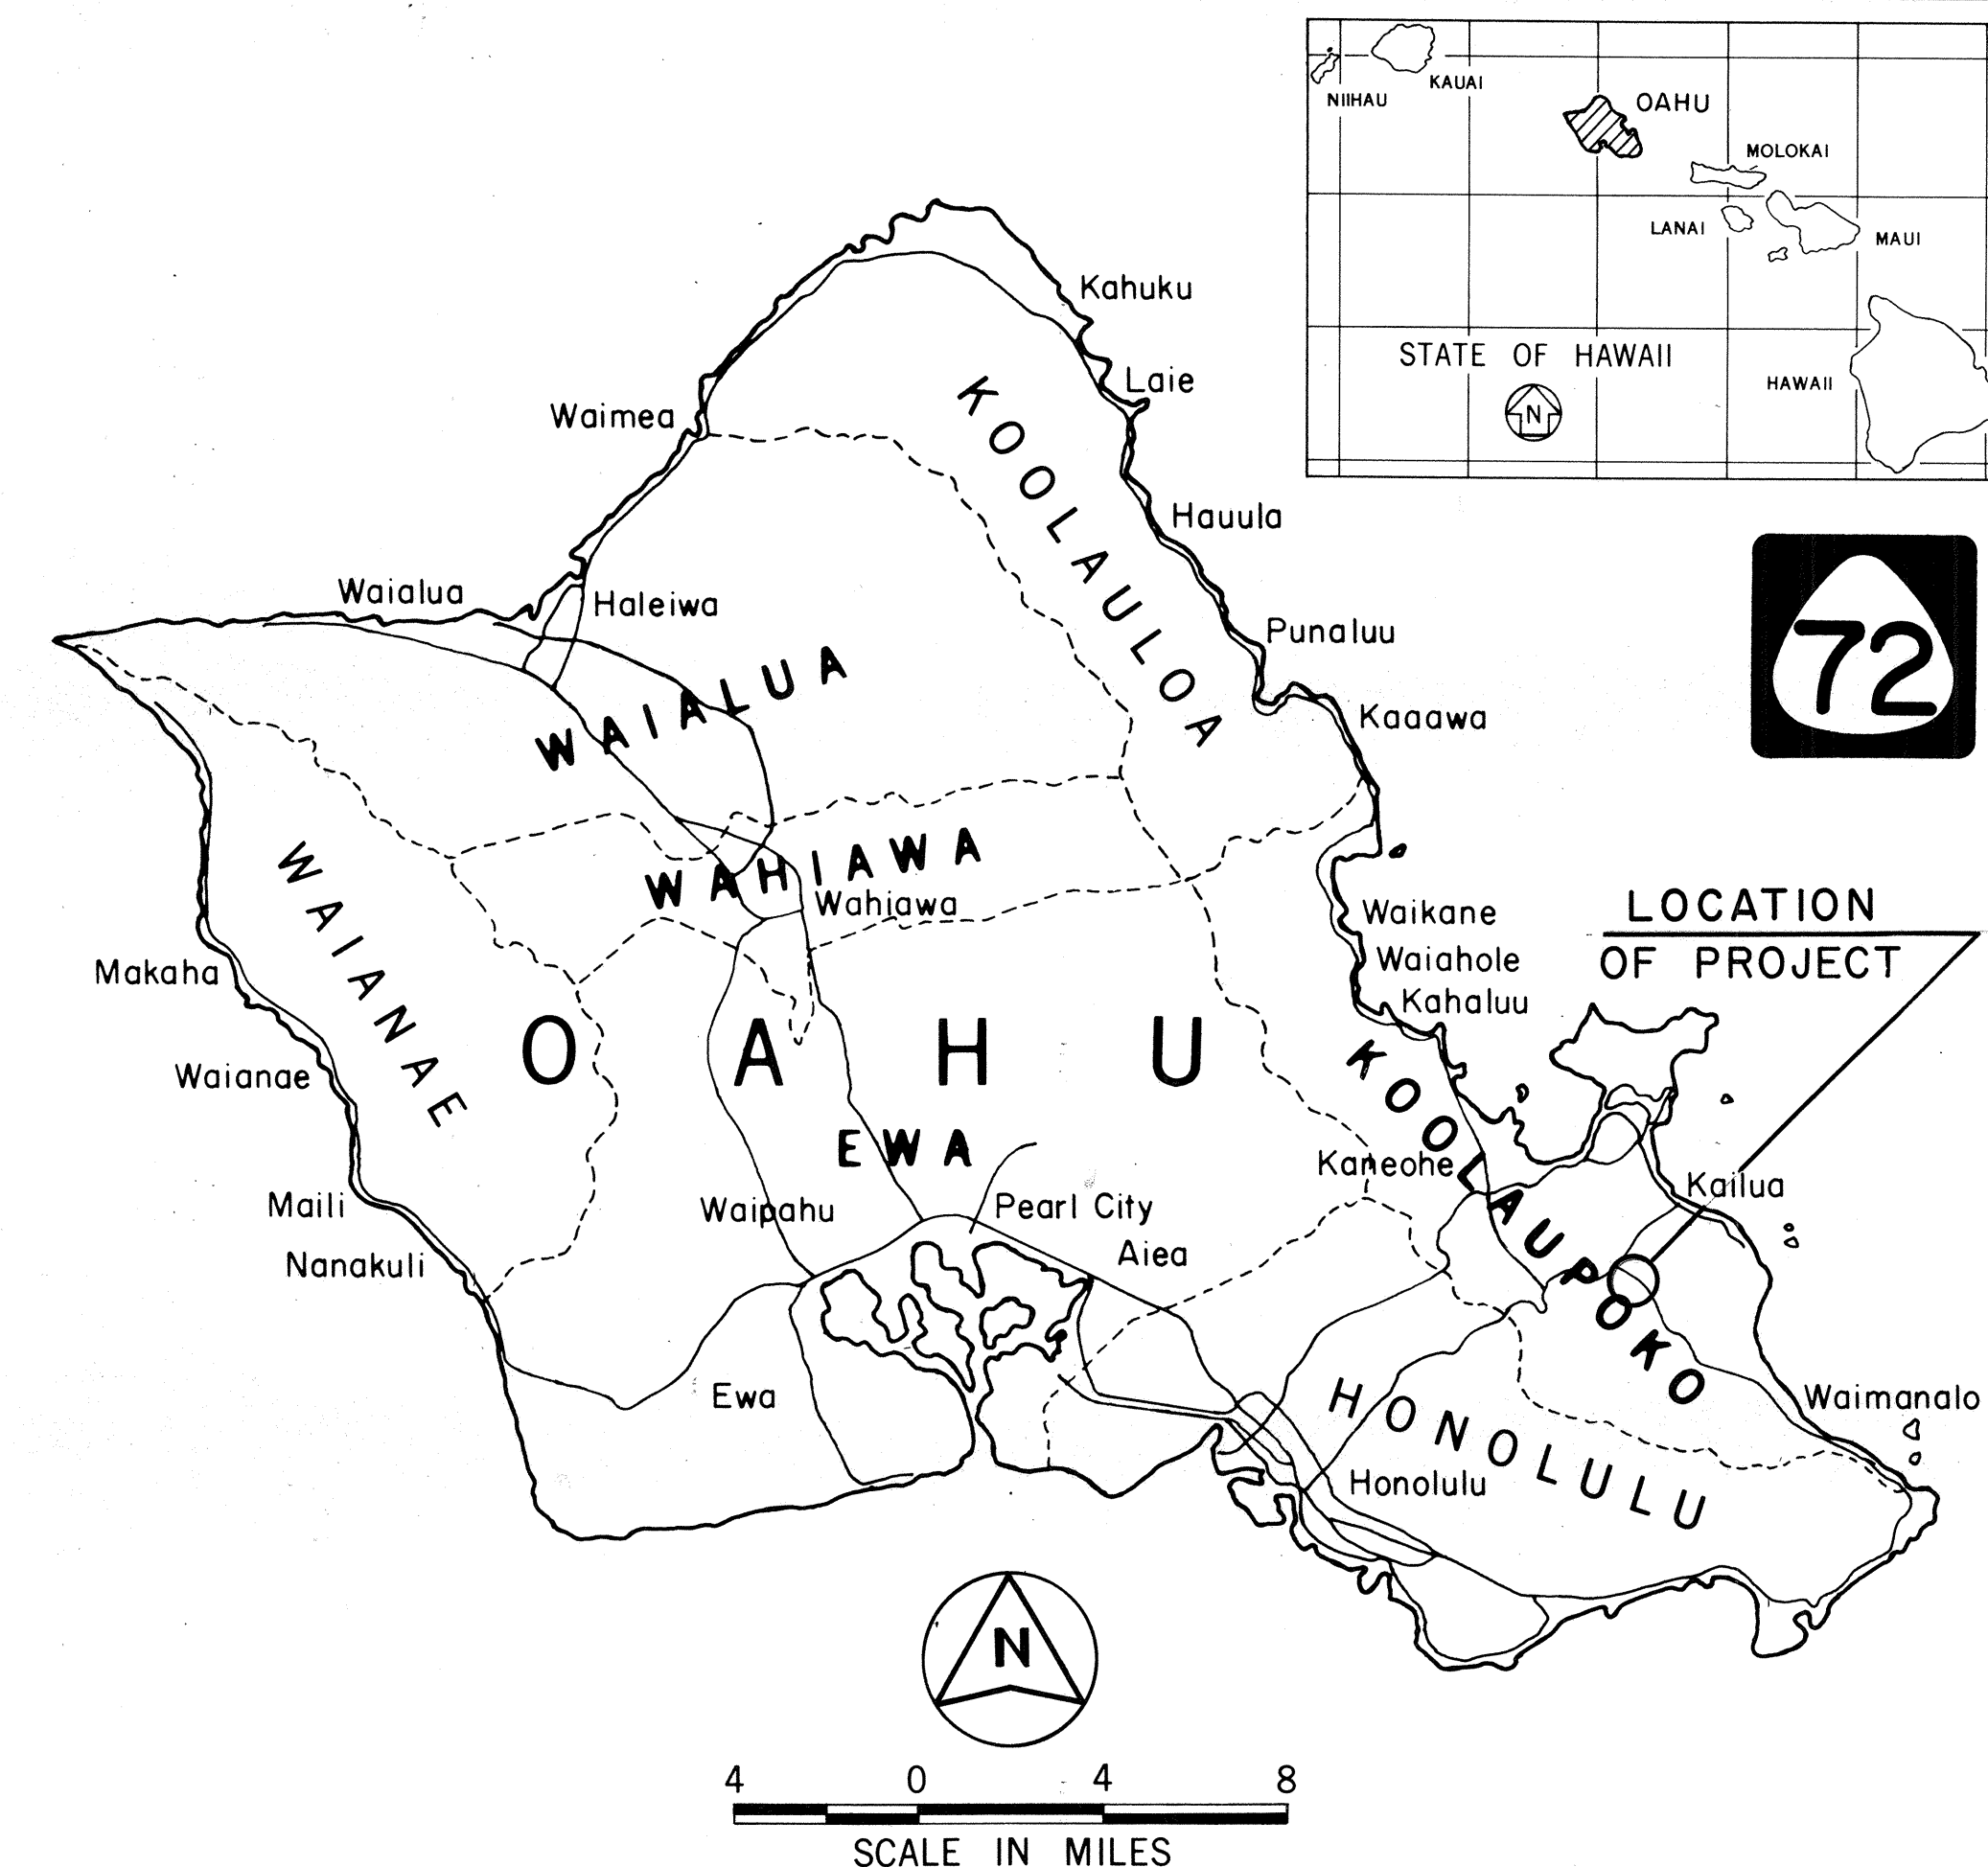

NO SIGNIFICANT CHANGES WERE MADE DURING CONSTRUCTION ON THESE PLANS EXCEPT CHANGES IN THE ORIGINAL THEORETICAL QUANTITIES. FOR ACTUAL QUANTITIES, REFER TO PROJECT LEDGER AND/OR COMPUTATION BOOK.

Dennis E. Hays  
RESIDENT ENGINEER

4/4/89  
DATE

DEPARTMENT OF TRANSPORTATION  
STATE OF HAWAII

APPROVED:

Edward J. Mote 4/6/88  
DIR. OF TRANSPORTATION DATE

ROY T. NAGASAKO  
DESIGNED BY P. S. & E. BY 548-2456 PHONE Mar., 1988 DATE

## LAYOUT PLAN

LENGTH OF PROJECT.....0.778 MILE

M.P. 0.01 TO M.P. 0.80