

PBDD INC. &
 VTN PACIFIC, INC.
 DESIGNED BY
 FRED ABESHIMA 548-4042 9-26-90
 P. S. & E. BY PHONE DATE

INDEX TO DRAWINGS	
SHEET NO.	DESCRIPTION
1	KALANIANAOLE HIGHWAY WEST HIND DRIVE TO EAST HALEMAUMAU STREET PROJECT NO. F-072-1(34)
I-S-1A-186 ① ②	KALANIANAOLE HIGHWAY WEST HIND DRIVE TO EAST HIND DRIVE PROJECT NO. F-072-1(34)A
I-S-1B-193	KALANIANAOLE HIGHWAY EAST HIND DRIVE TO EAST HALEMAUMAU STREET PROJECT NO. F-072-1(34)B

Plan Sht. Nos. ① 121 S-1 ② 173 S-1 & 173 S-2
 are supplementary sheets to this project.
 TOTAL SHEET COUNT after "AS BUILT" postings.
 189 Sheets.

STATE OF HAWAII
 DEPARTMENT OF TRANSPORTATION
 HIGHWAYS DIVISION
 HONOLULU, HAWAII

"AS-BUILT"
 PLANS FOR
 CONSTRUCTION OF A PORTION OF
KALANIANAOLE HIGHWAY
 WEST HIND DRIVE TO EAST HALEMAUMAU STREET
 FEDERAL AID PROJECT NO. F-072-1(34)-A



DISTRICT OF HONOLULU
 ISLAND OF OAHU

ALL CHANGES MADE DURING CONSTRUCTION HAVE
 BEEN NOTED IN RED ON THESE TRACINGS AND
 CHECKED BY:
Sidney S. C. Lee
 RESIDENT ENGINEER
 DATE 9/3/96

DEPARTMENT OF TRANSPORTATION
 FEDERAL HIGHWAY ADMINISTRATION
 APPROVED:
W. Arthur
 DIVISION ADMINISTRATOR
 DATE 10/3/90

DEPARTMENT OF TRANSPORTATION
 STATE OF HAWAII
 APPROVED:
Edmund J. Jones
 DIR. OF TRANSPORTATION
 DATE 10/3/90

FED. ROAD DIST. NO.	STATE	FED. AID PROJ. NO.	FISCAL YEAR	SHEET NO.	TOTAL SHEETS
HAWAII	HAW.	F-072-1(34)-A	1991	1	186
				1	193

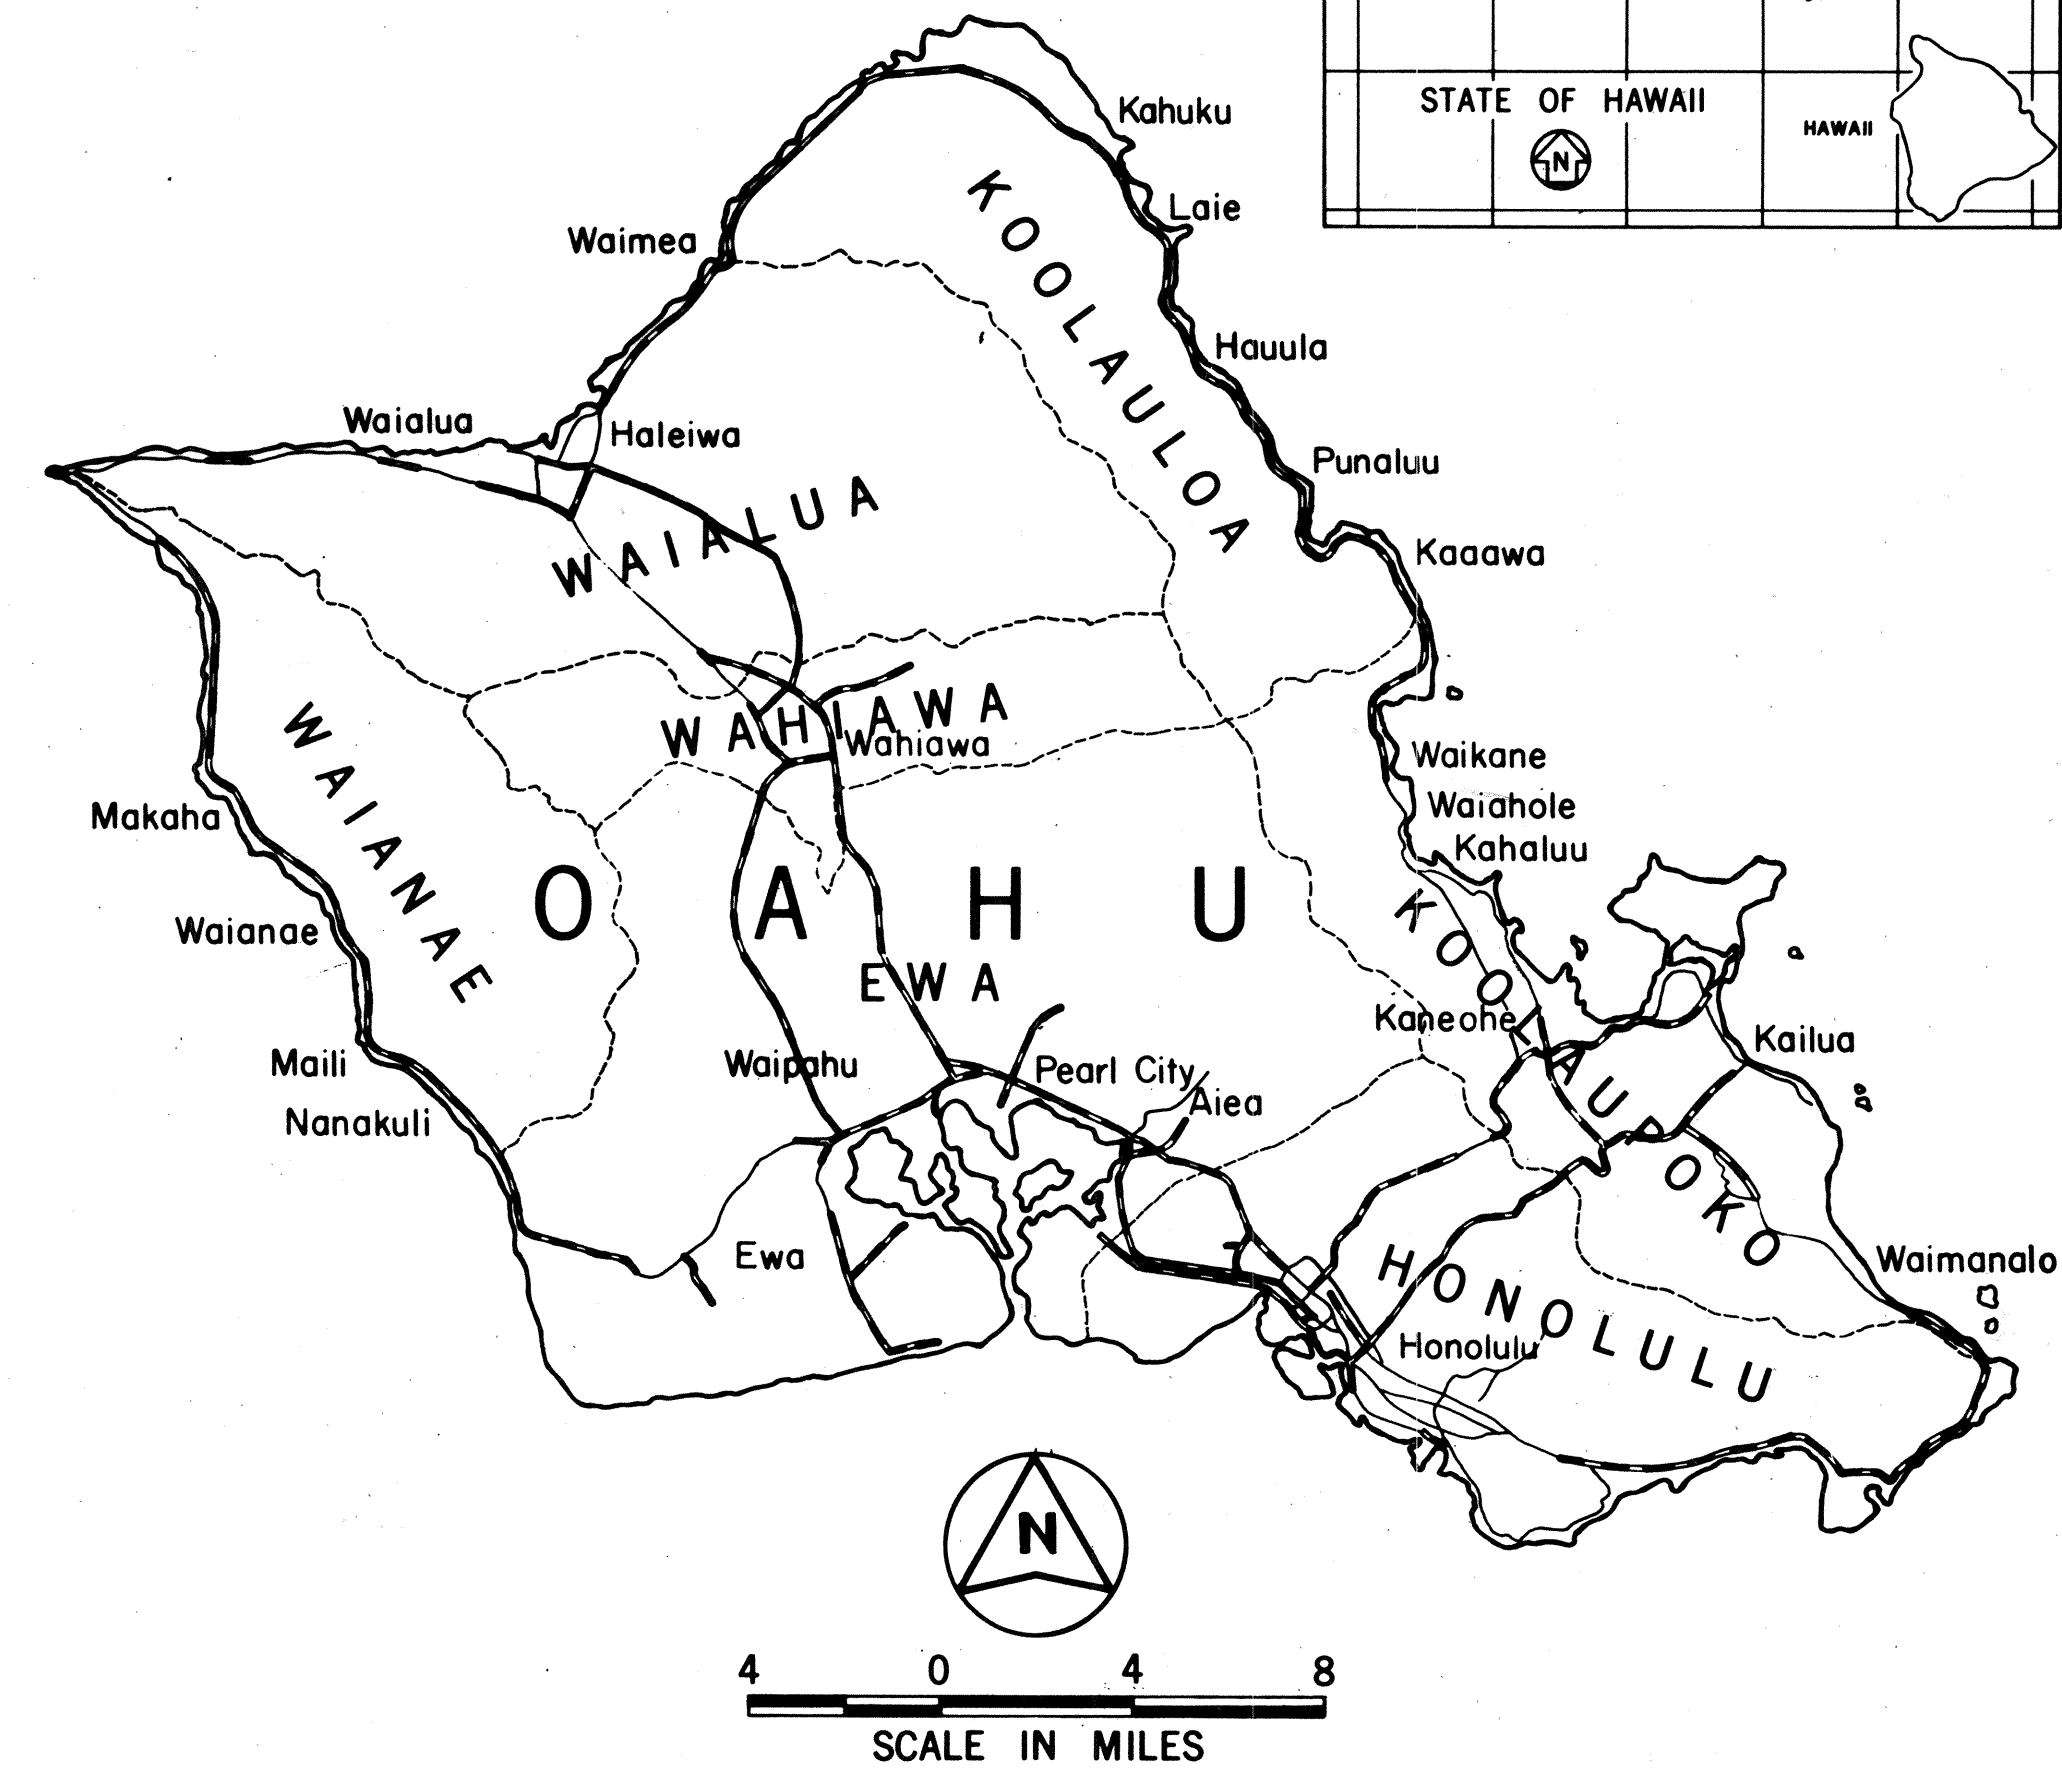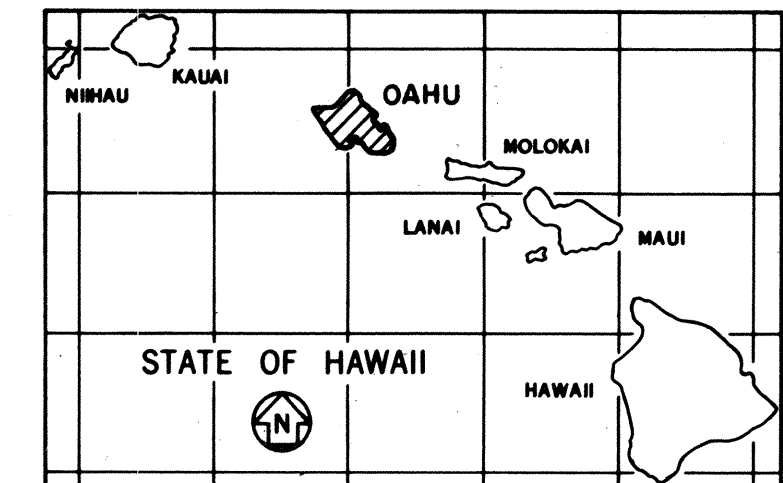

FEDERAL AID PROJECTS PREVIOUSLY CONSTRUCTED
 OR UNDER CONSTRUCTION
 MILE POST 16.99 TO MILE POST 15.48

LAYOUT PLANS &
 DESIGN DESIGNATIONS
 SEE SHEETS I-S-1A &
 I-S-1B