



INDEX TO DRAWINGS	
SHEET NO.	DESCRIPTION
1	TITLE SHEET
2	STANDARD PLAN SUMMARY
3	CONSTRUCTION PHASING
4	TYPICAL SECTIONS
5-9	ALIGNMENT
10-12	PHASE I DETOUR CONSTRUCTION
13-29	ROADWAY CONSTRUCTION
30-66	DRAINAGE
67-78	SIGNING & PAVEMENT MARKINGS
79-84	TRAFFIC SIGNAL SYSTEM
85-125	UTILITIES
126-140	STREET LIGHTING & CONTROLLER INTERCONNECTION
141-155	LANDSCAPING & IRRIGATION
156-174	WAILUPE STREAM BRIDGE WIDENING
175-179	EXISTING CONDITION
180-186	CROSS SECTIONS

STATE OF HAWAII
DEPARTMENT OF TRANSPORTATION
HIGHWAYS DIVISION
HONOLULU, HAWAII

PLANS FOR
CONSTRUCTION OF A PORTION OF
KALANIANA'OLE HIGHWAY
WEST HIND DRIVE TO EAST HIND DRIVE
FEDERAL AID PROJECT NO. F-072-1(34)-A

DISTRICT OF HONOLULU
ISLAND OF OAHU


FED. ROAD DIST. NO.	STATE	FED. AID PROJ. NO.	FISCAL YEAR	SHEET NO.	TOTAL SHEETS
HAWAII	HAW.	F-072-1(34)-A	1991	IS-1A	186

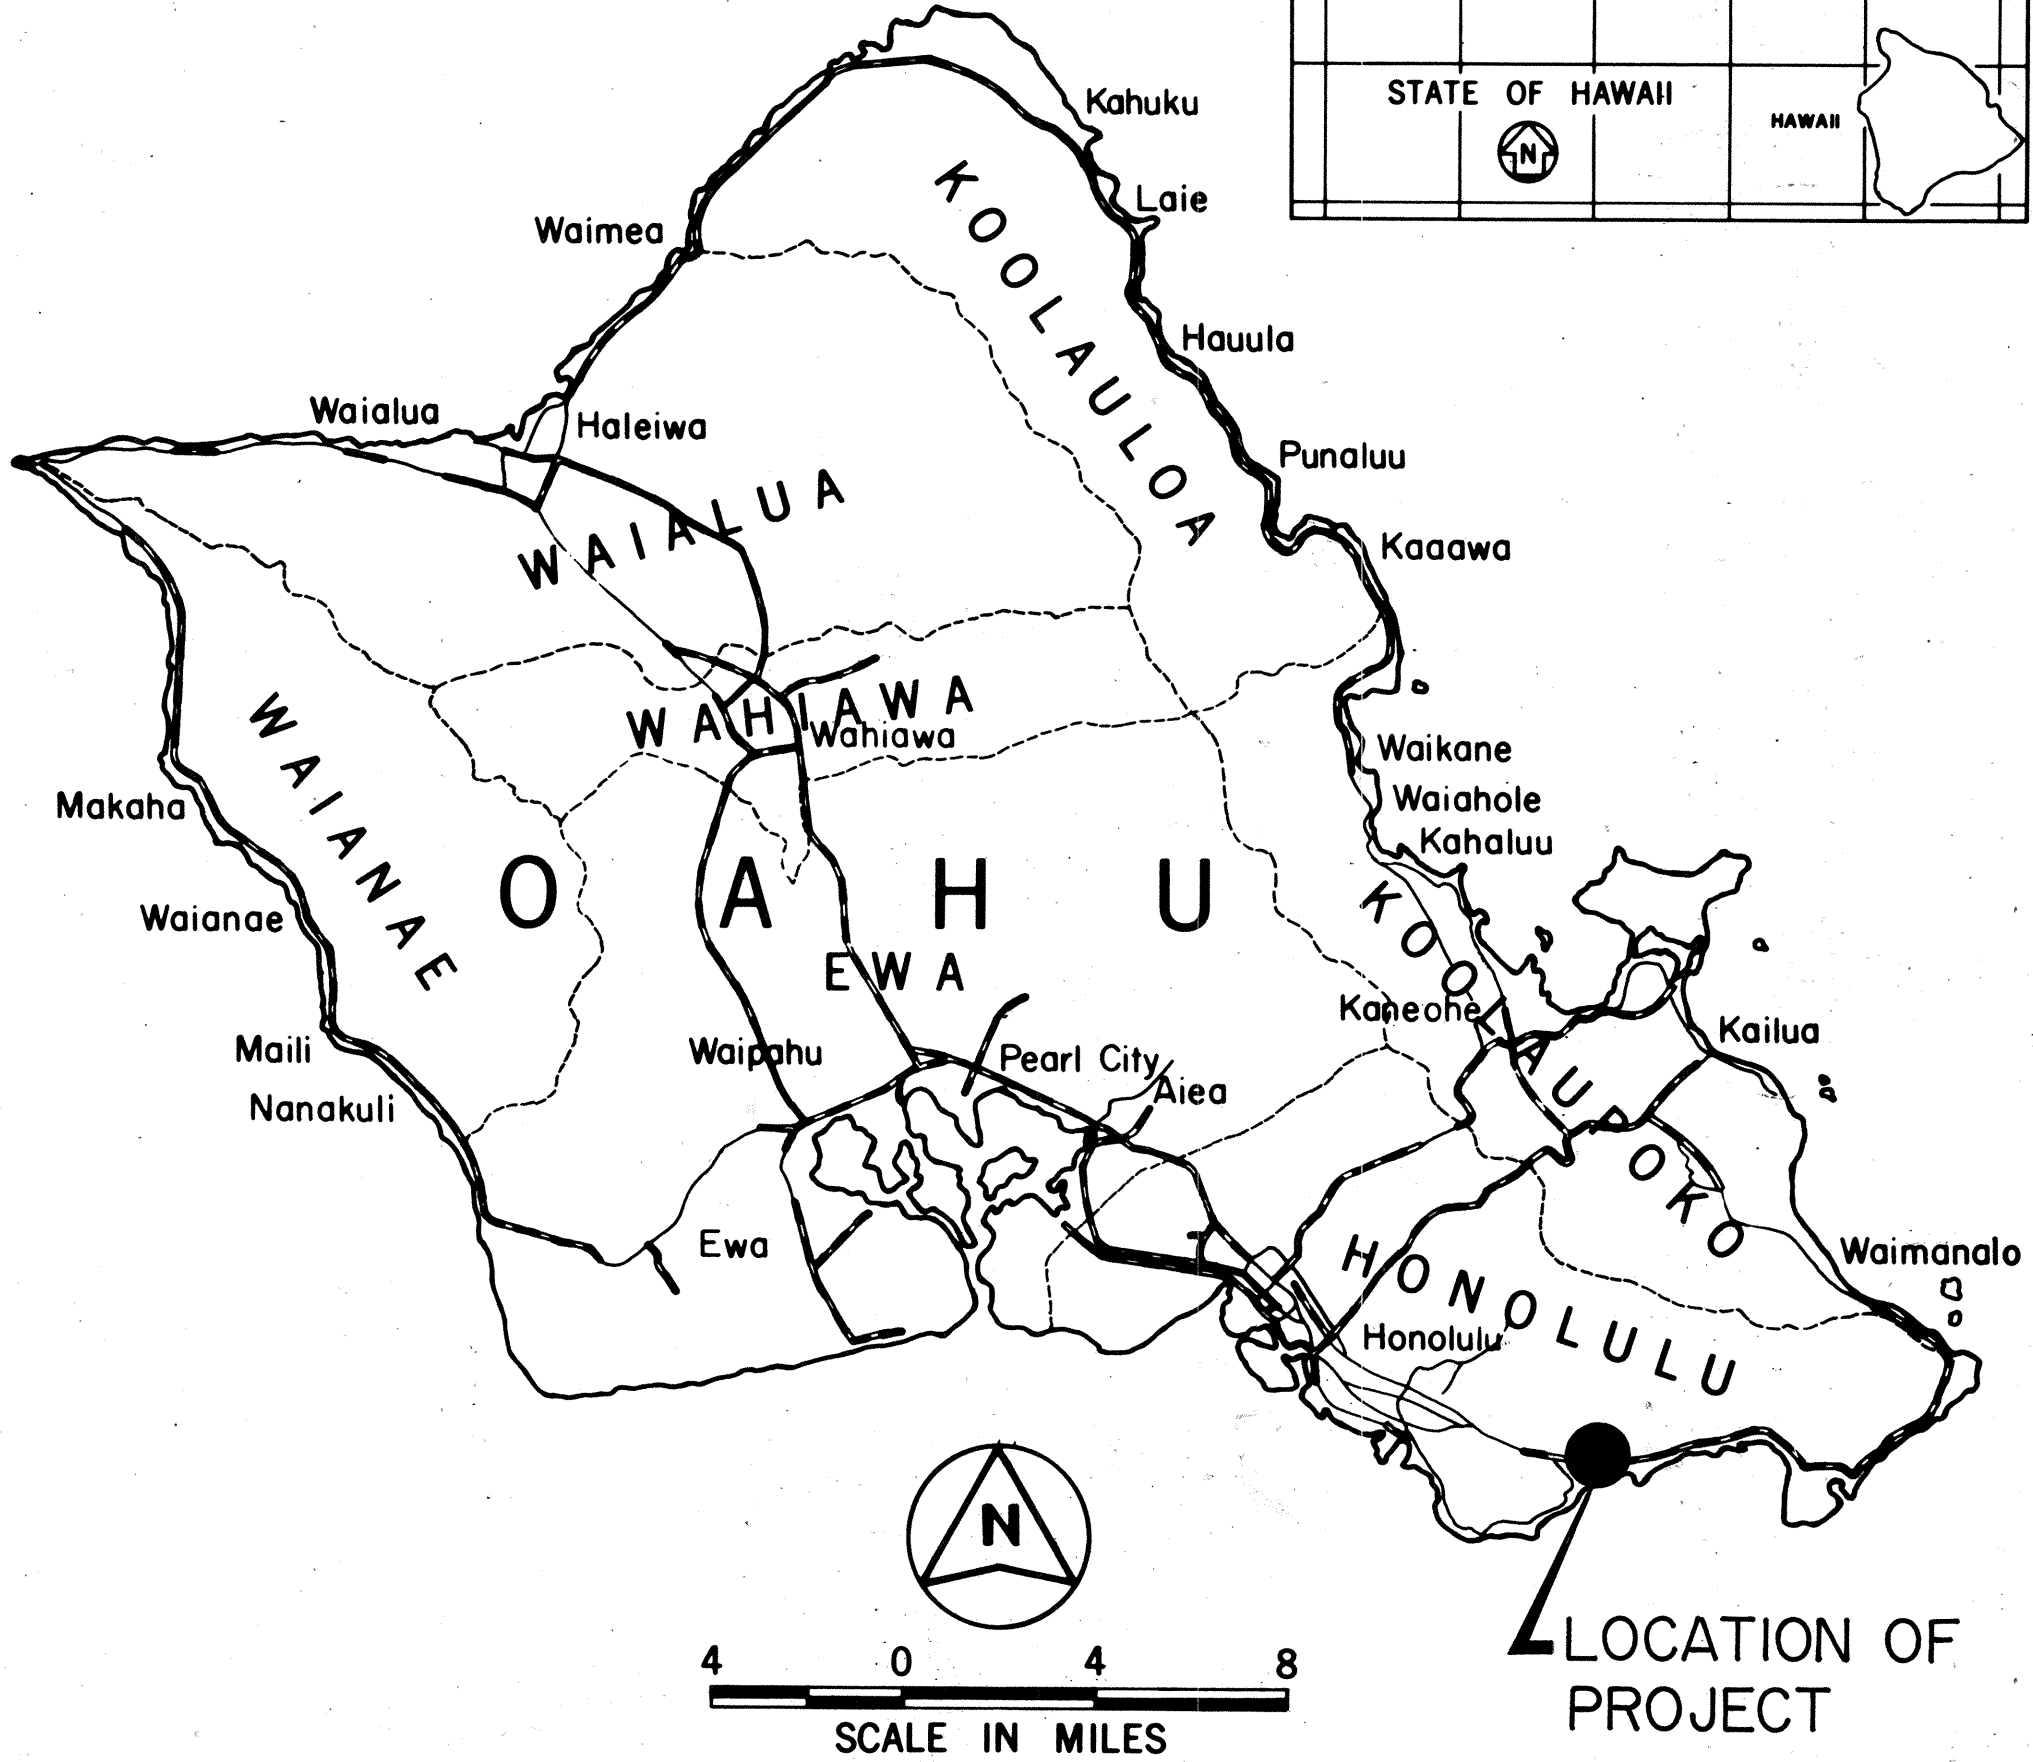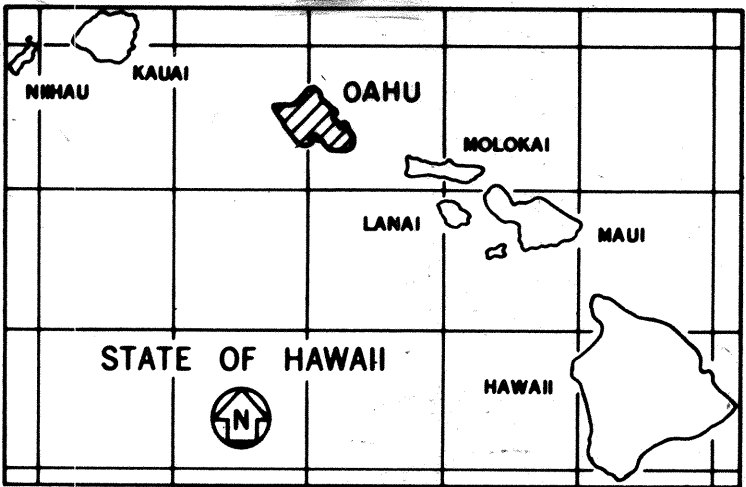

FEDERAL AID PROJECTS PREVIOUSLY CONSTRUCTED
OR UNDER CONSTRUCTION
MILEPOST 16.99 TO MILEPOST 16.47


DESIGN CLASSIFICATION

DESIGN ADT (2011) 82,730 VPD
DHV 6,600
DAM 75/25%
DPM 65/35%
TAM 2.5%
TPM 2.0%
V 40 MPH

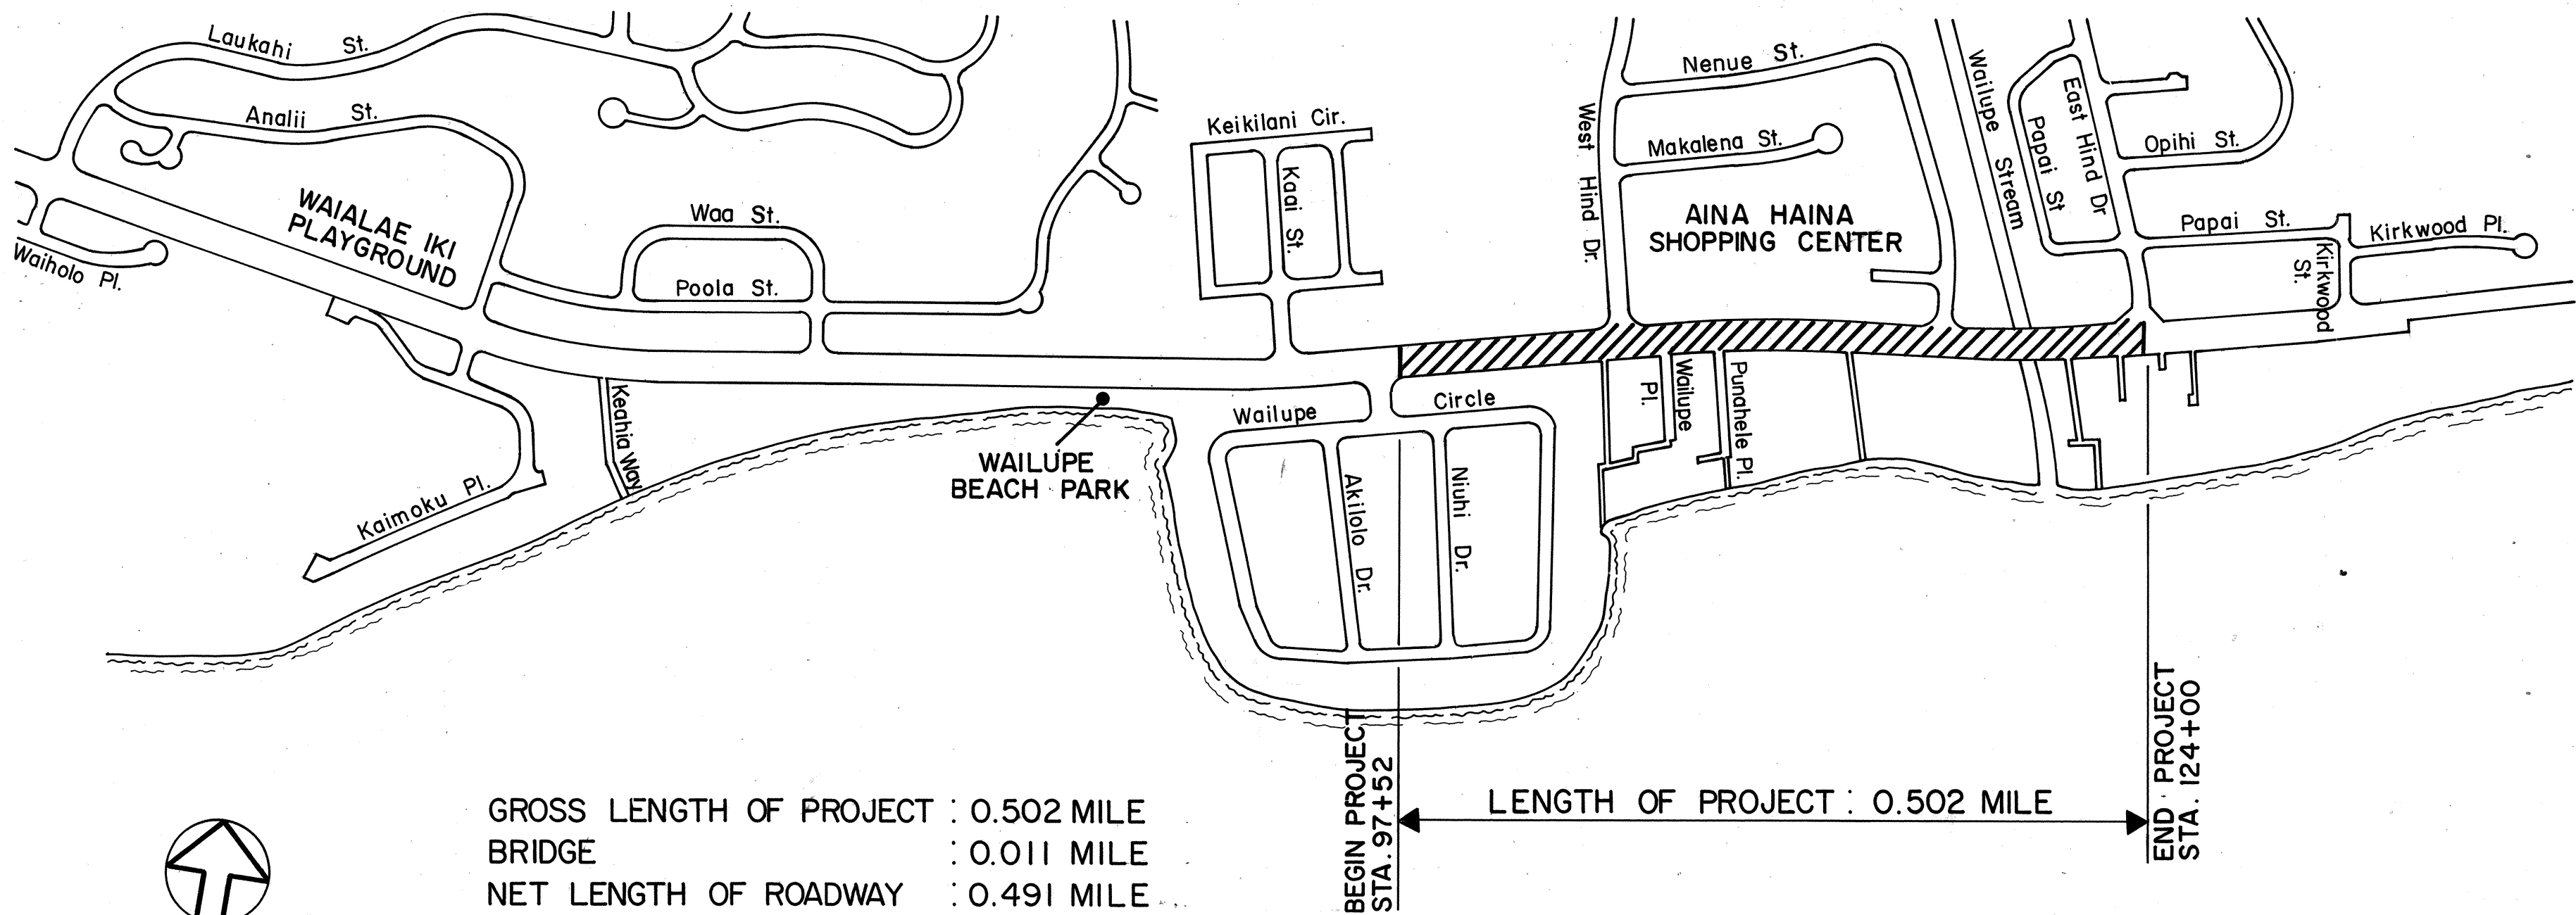

GROSS LENGTH OF PROJECT : 0.502 MILE
BRIDGE : 0.011 MILE
NET LENGTH OF ROADWAY : 0.491 MILE

LAYOUT PLAN

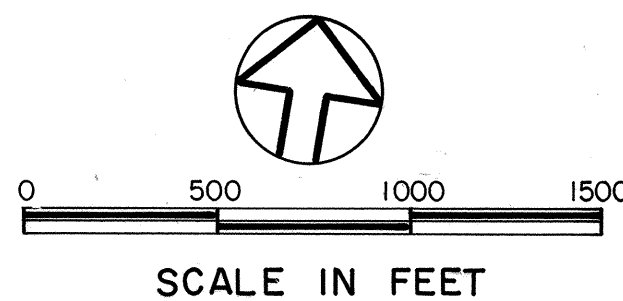

DEPARTMENT OF TRANSPORTATION FEDERAL HIGHWAY ADMINISTRATION	
APPROVED:	
DIVISION ADMINISTRATOR	DATE

DEPARTMENT OF TRANSPORTATION STATE OF HAWAII	
APPROVED:	
DIR. OF TRANSPORTATION	DATE

PARSONS BRINCKERHOFF
QUADE & DOUGLAS, INC.
DESIGNED BY
P. S. & E. BY
FREDERIC ABESHIMA
548-4042
PHONE
JUNE 30, 1990
DATE