

GENERAL NOTES


1. GENERAL SPECIFICATIONS: HAWAII DEPARTMENT OF TRANSPORTATION, STANDARD SPECIFICATIONS FOR ROAD AND BRIDGE CONSTRUCTION, 1985, TOGETHER WITH SPECIAL PROVISIONS PREPARED FOR THIS CONTRACT.
2. DESIGN SPECIFICATIONS: THE 14TH EDITION OF A.A.S.H.T.O. STANDARD SPECIFICATIONS FOR HIGHWAY BRIDGES.
3. LOADS:
(A) DEAD LOAD: AN ALLOWANCE OF 18 P.S.F. FOR FUTURE WEARING SURFACE OF ASPHALT CONCRETE HAS BEEN PROVIDED FOR IN THE DESIGN.
(B) LIVE LOAD: HS20-44 OR INTERSTATE LOADING.
4. MATERIALS:
(A) CONCRETE FOR DECK SLAB SHALL BE CLASS BD.
(B) OTHER CONCRETE SHALL BE CLASS A UNLESS OTHERWISE NOTED.
(C) ALL REINFORCING STEEL SHALL BE A.S.T.M. A615, GRADE 40 UNLESS OTHERWISE NOTED.
(D) ALL STRUCTURAL STEEL SHALL BE A.S.T.M. A-36 HOT DIP GALVANIZED, UNLESS OTHERWISE NOTED.
(E) FOR MATERIALS OF PRESTRESSED CONCRETE BEAM, SEE SHEET S-13.
5. DESIGN STRESSES: SHALL FOLLOW A.A.S.H.T.O. STANDARD SPECIFICATIONS FOR HIGHWAY BRIDGES IN ADDITION TO THOSE LISTED BELOW.
- | CONCRETE | CLASS A | CLASS BD |
|----------------|-------------|-------------|
| f _c | 3000 P.S.I. | 3750 P.S.I. |
| f _c | 1200 P.S.I. | 1500 P.S.I. |
| n | 9 | 9 |
- FOR PRESTRESSED CONCRETE BEAMS, SEE SHEET S-13
6. REINFORCEMENT: FOR REINFORCEMENT NOTES, SEE GENERAL NOTES ON STANDARD PLAN NO. B-01.
7. ELASTOMERIC PADS: TO PREVENT DISPLACEMENT, BOTTOM OF BRIDGE BEARING PADS SHALL BE SECURED TO THE CONCRETE SEATS WITH ADHESIVES APPROVED BY THE ENGINEER.
8. CONSTRUCTION METHODS:
(A) SEE STANDARD SPECIFICATIONS AND SPECIAL PROVISIONS.
(B) GIRDER CONCRETE SEATS RECEIVING ELASTOMERIC PADS SHALL BE POURED MONOLITHICALLY WITH SUPPORTING STRUCTURE. TOP OF CONCRETE SEATS SHALL BE FINISHED WITH A STEEL TROWEL TO A SMOOTH AND TRUE TO GRADE FINISH WITH A DEVIATION FROM A LEVEL PLANE NOT EXCEEDING 1/16 INCH.
(C) EXCEPT AS OTHERWISE NOTED, ALL VERTICAL DIMENSIONS ARE MEASURED PLUMB.
(D) THE CONTRACTOR SHALL VERIFY THE LOCATIONS OF ALL EXISTING ABUTMENTS, PIERS, UTILITIES AND APPURTENANCES PRIOR TO THE COMMENCEMENT OF WORK. SHOULD THESE FIELD VERIFICATIONS OF DIMENSIONS INDICATE 6" OR MORE DIFFERENT FROM THAT SHOWN ON THE PLANS, THE CONTRACTOR SHALL NOTIFY THE ENGINEER TO DETERMINE WHETHER A REDESIGN IS REQUIRED.
(E) ALL CUT-OFF REINFORCEMENT IN EXISTING STRUCTURES SHALL BE BURNED TO 3/8" DEEP INTO EXISTING CONCRETE AND PATCHED WITH EPOXY GROUT.
(F) THE EXACT LOCATIONS OF THE EXISTING SEWER SIPHON CONCRETE JACKET AND 24" WATER MAIN CONCRETE JACKET SHALL BE DETERMINED BY PROBING AND EXPOSING THE TOP OF CONCRETE JACKETS PRIOR TO AUGERING HOLES. THE METHOD OF PROBING SHALL BE APPROVED BY THE OWNERS OF THE UTILITIES.
(G) THE PILES WHICH STRADDLE THE SEWER SIPHON CONCRETE JACKET OR 24" WATER MAIN CONCRETE JACKET SHALL BE DRIVEN THROUGH PRE-AUGERED HOLES WITH SLEEVES. THE TIP ELEVATION OF SLEEVED HOLES IS (-)11.0. THE CONTRACTOR HAS THE OPTION OF EITHER PULLING OUT THE SLEEVE OR LEAVING IT IN PLACE. IF THE SLEEVE IS LEFT IN PLACE, THE CONTRACTOR SHALL CUT-OFF THE SLEEVE 1'-0" BELOW THE BOTTOM OF THE FOOTING OR CURTAIN WALL. THE ANNULAR SPACE AROUND THE PILE SHALL BE FILLED WITH FINE AGGREGATE. THE COST OF FURNISHING AND INSTALLING FINE AGGREGATE SHALL BE INCIDENTAL TO PRE-AUGERED SLEEVED HOLE.
(H) THE CONTRACTOR SHALL DRIVE PILES ON BOTH SIDES OF THE SIPHON CONCRETE JACKET OR 24" WATER MAIN CONCRETE JACKET ALTERNATELY SO AS TO BALANCE ANY POSSIBLE PIPE DISPLACEMENT.
(I) THE EXISTING PIPES TO REMAIN ON EXISTING STRUCTURES SHALL BE PROTECTED BY THE CONTRACTOR DURING CONSTRUCTION OF THIS PROJECT. ANY DAMAGES TO THESE PIPES DURING CONSTRUCTION SHALL BE REPAIRED AND RE-INSTALLED TO THE ORIGINAL CONDITION BY THE CONTRACTOR AT HIS OWN EXPENSE.
(J) APPLY BITUMINOUS TACK COAT TO BRIDGE DECK PRIOR TO INSTALLATION OF AC OVERLAY. AC OVERLAY SHALL CONSIST OF AC PAVEMENT MIX NO. V.
(K) CONTRACTOR MAY DRIVE PILES FROM EXISTING BRIDGES, SUBJECT TO THE FOLLOWING CONDITIONS:
o A WORKING PLATFORM SPANNING FROM ABUTMENT TO CENTER PIER SHALL BE INSTALLED SUCH THAT NO LOAD FROM THE PILE DRIVER WILL BE TRANSFERRED ONTO THE BRIDGE SPAN.
o CONTRACTOR SHALL SUBMIT WORKING DRAWINGS AND DESIGN CALCULATIONS FOR THE WORKING PLATFORM TO THE ENGINEER FOR APPROVAL. DRAWINGS AND CALCULATIONS SHALL BE STAMPED BY A STRUCTURAL ENGINEER REGISTERED IN THE STATE OF HAWAII.

9. GENERAL:
(A) ALL ITEMS NOTED INCIDENTAL WILL NOT BE PAID FOR SEPARATELY.
(B) THE CONTRACTOR SHALL VERIFY THE LOCATION OF ALL UTILITY LINES AND NOTIFY THE RESPECTIVE OWNERS BEFORE COMMENCING THE WORK OF EXCAVATION OR THE DRIVING OF PILES, INCLUDING ANY TEMPORARY PILING OR SHEETING.
(C) HECO WILL DEENERGIZE AERIAL ELECTRIC LINES IN CLOSE PROXIMITY OF THE PILE DRIVING RIG DURING PILE DRIVING OPERATIONS. DURING NON-WORKING HOURS AND WHEN PILE DRIVING CEASES FOR MORE THAN 1 HOUR, THE CONTRACTOR SHALL MOVE ALL EQUIPMENT SUCH THAT A MINIMUM CLEARANCE OF 10' FROM THE AERIAL LINES IS MAINTAINED. CONTRACTOR SHALL PROVIDE PILE DRIVING SCHEDULE TO HAWAIIAN ELECTRIC COMPANY, HAWAIIAN TELEPHONE COMPANY AND OCEANIC CABLEVISION NOT LESS THAN 60 DAYS PRIOR TO BEGIN OF PILE DRIVING OPERATIONS.
(D) CONSTRUCTION JOINTS MAY BE RELOCATED OR ADDED SUBJECT TO THE APPROVAL OF THE ENGINEER.
(E) UNLESS OTHERWISE NOTED, ALL EXPOSED CONCRETE EDGES SHALL BE CHAMFERED 3/4" X 3/4".
10. FOUNDATION NOTES:
(A) DESIGN LOAD FOR ALL PILES = 75 TONS (AASHTO GROUP I).
(B) TEST PILES INDICATED IN FOUNDATION PLAN SHALL BE FURNISHED 15' LONGER THAN REGULAR PILES.
(C) IN DRIVING EACH GROUP OF PILES, THE CONTRACTOR SHALL START FROM THE CENTER OF THE GROUP AND PROCEED OUTWARD.
(D) THE PILE TIP ELEVATIONS SHOWN ON PLANS ARE BASED ON BORING DATA.
(E) FOR 16 1/2" OCTAGONAL PILE DETAILS, SEE SHEET NOS. S-18A AND S-18B.
11. SYMBOLS AND ABBREVIATIONS:
- | | | | |
|------------|-------------------------|------------|----------------------------|
| E OR EXP. | - EXPANSION | JT. | - JOINT |
| H | - HINGE | N.T.S. | - NOT TO SCALE |
| ALT. | - ALTERNATE | O.C. | - ON CENTER |
| AZ. | - AZIMUTH | O/S | - OFF SET |
| ℄ | - CENTERLINE | APPROX. | - APPROXIMATE |
| ℄ | - BASELINE | STIRR. | - STIRRUP |
| E.F. | - EACH FACE | TYP. | - TYPICAL |
| B.F. | - BOTH FACES | T. | - TOP |
| F.F. | - FRONT FACE | B. OR BOT. | - BOTTOM |
| R.F. | - REAR FACE | BRG. | - BEARING |
| C.J. | - CONSTRUCTION JOINT | A.C. | - ASPHALT CONCRETE |
| CL. | - CLEAR | STL. | - STEEL |
| EL., ELEV. | - ELEVATION | W.P. | - WORKING POINT |
| E.P. | - EDGE OF PAVEMENT | ⊙ | - AT |
| I.B. | - INBOUND | ∅ OR DIA. | - DIAMETER |
| FIN. GR. | - FINISH GRADE | ℄ | - PROPERTY LINE OR PLATE |
| O.B. | - OUT BOUND | G.R.P. | - GROUTED RUBBLE PAVING |
| C.R.M. | - CEMENT RUBBLE MASONRY | P.C.C. | - PORTLAND CEMENT CONCRETE |
| | | R/W | - RIGHT OF WAY |
12. REFERENCE:
THE PLANS OF THE EXISTING BRIDGES (F.A.P. NO. 6B AND PROJECT NO. F6(18)) ARE AVAILABLE FOR PERUSAL AT THE DEPARTMENT OF TRANSPORTATION, TECHNICAL DESIGN SERVICES OFFICE, 869 PUNCHBOWL STREET, HONOLULU (MR. FRED ABESHIMA, 548-4042).

FED. ROAD DIST. NO.	STATE	FED. AID PROJ. NO.	FISCAL YEAR	SHEET NO.	TOTAL SHEETS
HAWAII	HAW.	F-072-1(34)-A	1990	156	186

INDEX TO BRIDGE DRAWINGS

SHEET NO.	DESCRIPTION
S-1	GENERAL NOTES
S-2	GENERAL PLAN INBOUND BRIDGE
S-3	GENERAL PLAN OUTBOUND BRIDGE
S-4	LONGITUDINAL SECTIONS
S-5	FOUNDATION PLAN
S-6	PIER #1 DETAILS
S-7	PIER #2 DETAILS
S-8	ABUTMENTS #1 AND #2 DETAILS
S-9	ABUTMENTS #3 AND #4 DETAILS
S-10	ABUTMENT SECTIONS SHEET 1 OF 2
S-11	ABUTMENT SECTIONS SHEET 2 OF 2
S-12	FRAMING PLAN
S-13	PRESTRESS BEAM DETAILS
S-14	DECK REINFORCING PLANS AND SECTIONS
S-15	MISCELLANEOUS DETAILS SHEET 1 OF 3
S-16	MISCELLANEOUS DETAILS SHEET 2 OF 3
S-17	MISCELLANEOUS DETAILS SHEET 3 OF 3
S-18	METAL RAILING DETAILS
S-18A	PRESTRESSED CONCRETE PILES SHEET 1 OF 2
S-18B	PRESTRESSED CONCRETE PILES SHEET 2 OF 2
S-19	BORING LOGS

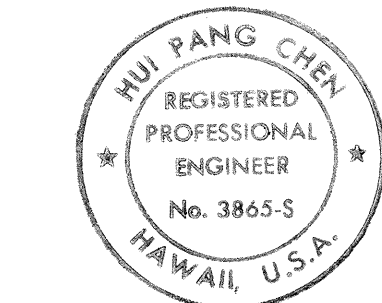

THIS WORK WAS PREPARED BY ME
OR UNDER MY SUPERVISION.
Hui Pang Chen

STATE OF HAWAII
DEPARTMENT OF TRANSPORTATION
HIGHWAYS DIVISION

WAILUPE STREAM BRIDGE WIDENING

GENERAL NOTES


KALANIANA'OLE HIGHWAY
Wailupe Circle to East Hind Drive
F.A. PROJECT NO. F-072-1(34)-A

SCALE: DATE: June 30, 1990
SHEET No. S-1 OF 19 SHEETS


ORIGINAL PLAN	SURVEY PLOTTED BY _____	DATE _____
NOTE BOOK	DRAWN BY _____	_____
	TRACED BY _____	_____
	DESIGNED BY _____	_____
	QUANTITIES BY _____	_____
No. _____	CHECKED BY _____	_____




FED. ROAD DIST. NO.	STATE	FED. AID PROJ. NO.	FISCAL YEAR	SHEET NO.	TOTAL SHEETS
HAWAII	HAW.	F-072 -I(34)-A	1990	159	186

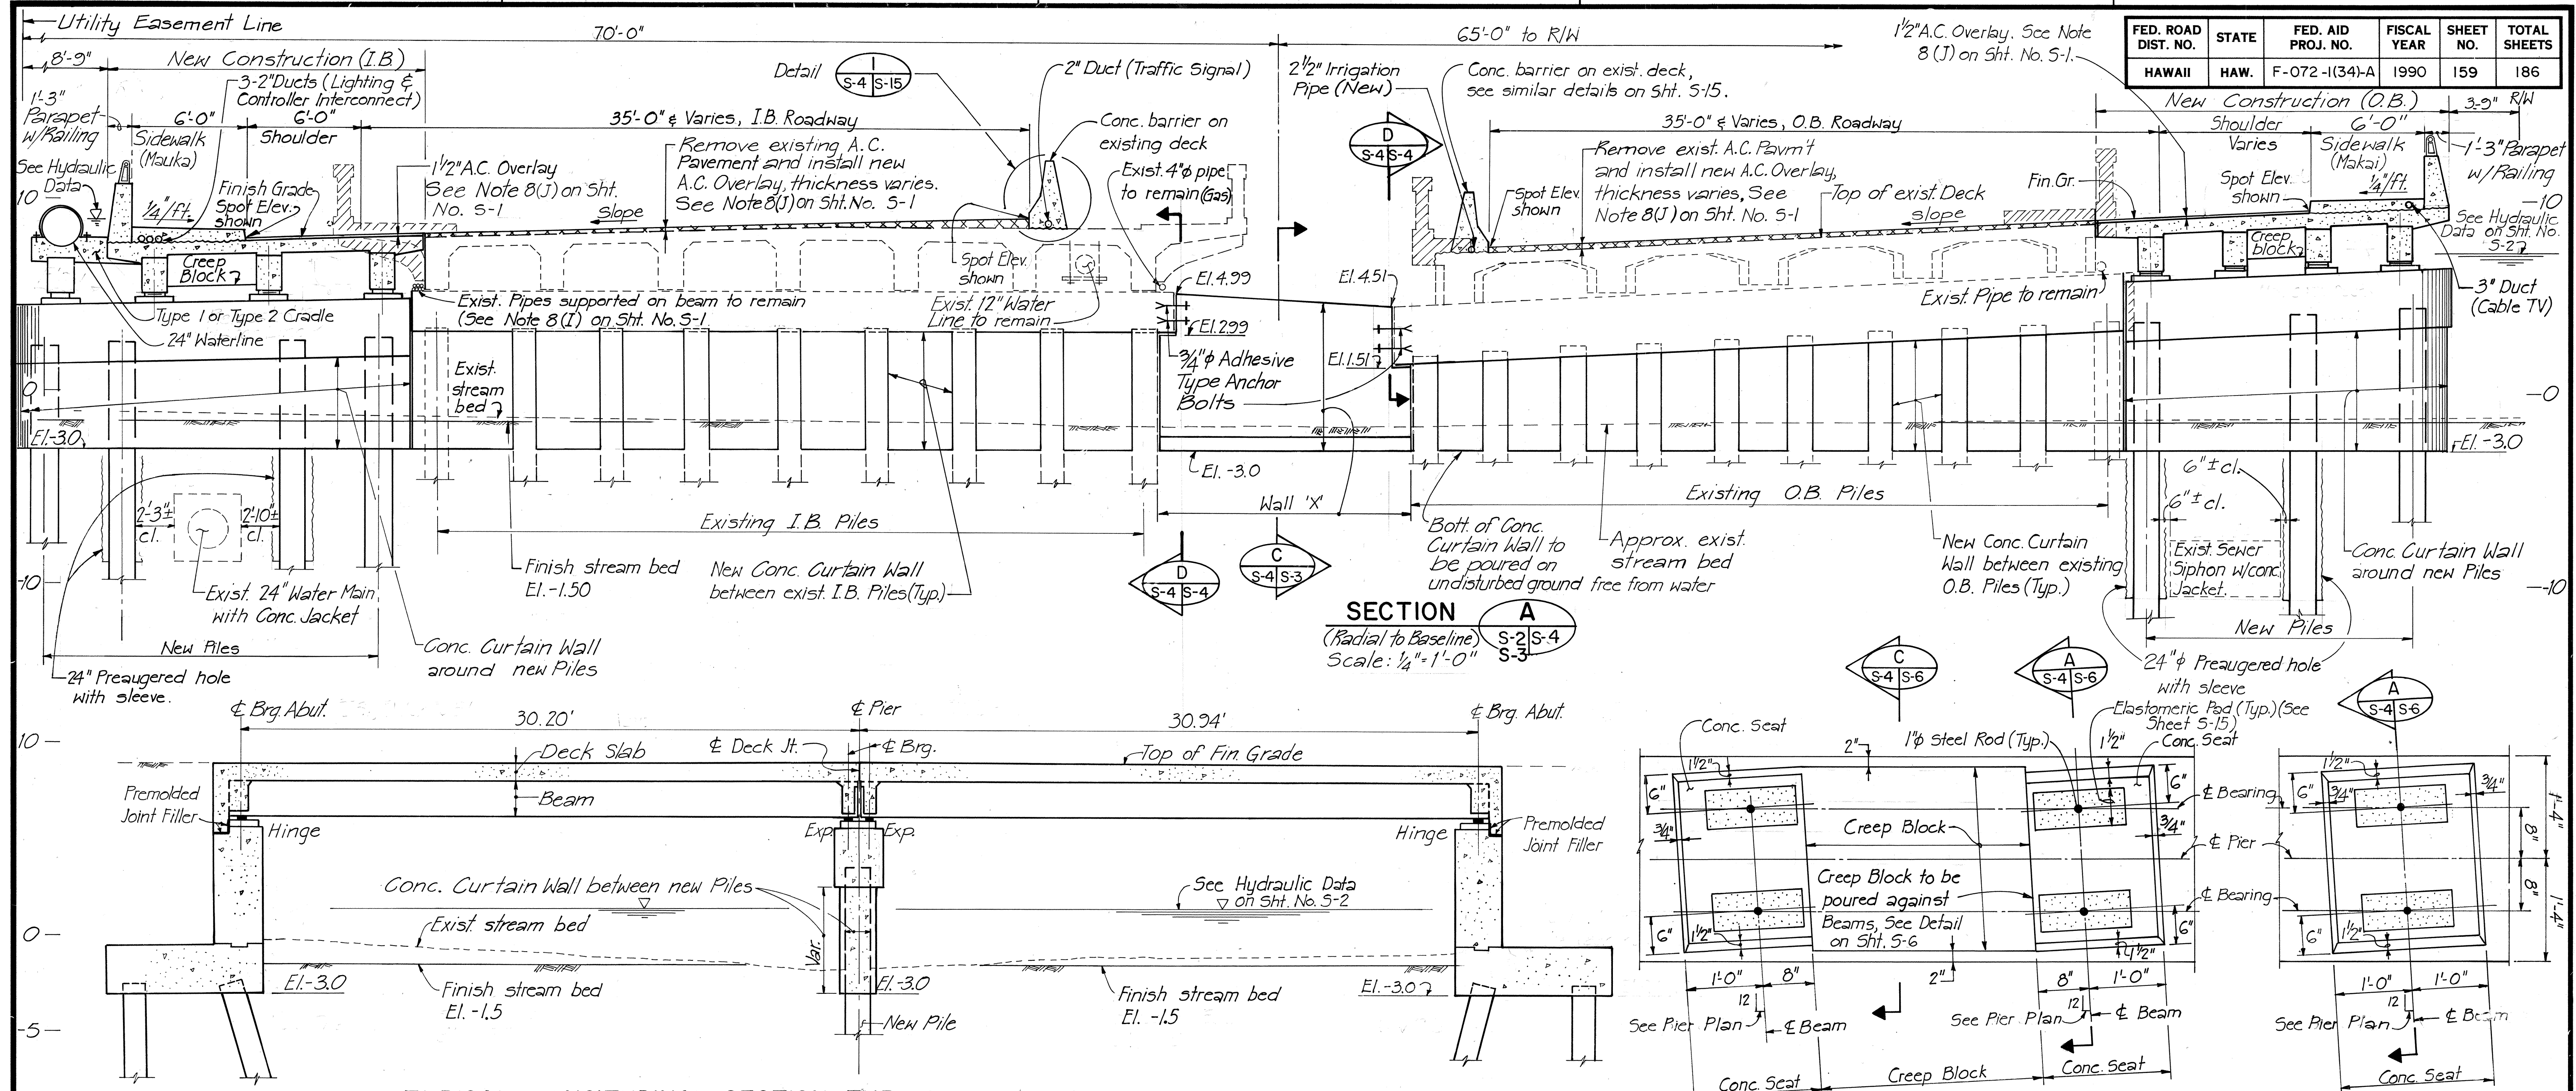

TYPICAL LONGITUDINAL SECTION THRU NEW STRUCTURES
Scale: $\frac{1}{4}" = 1'-0"$

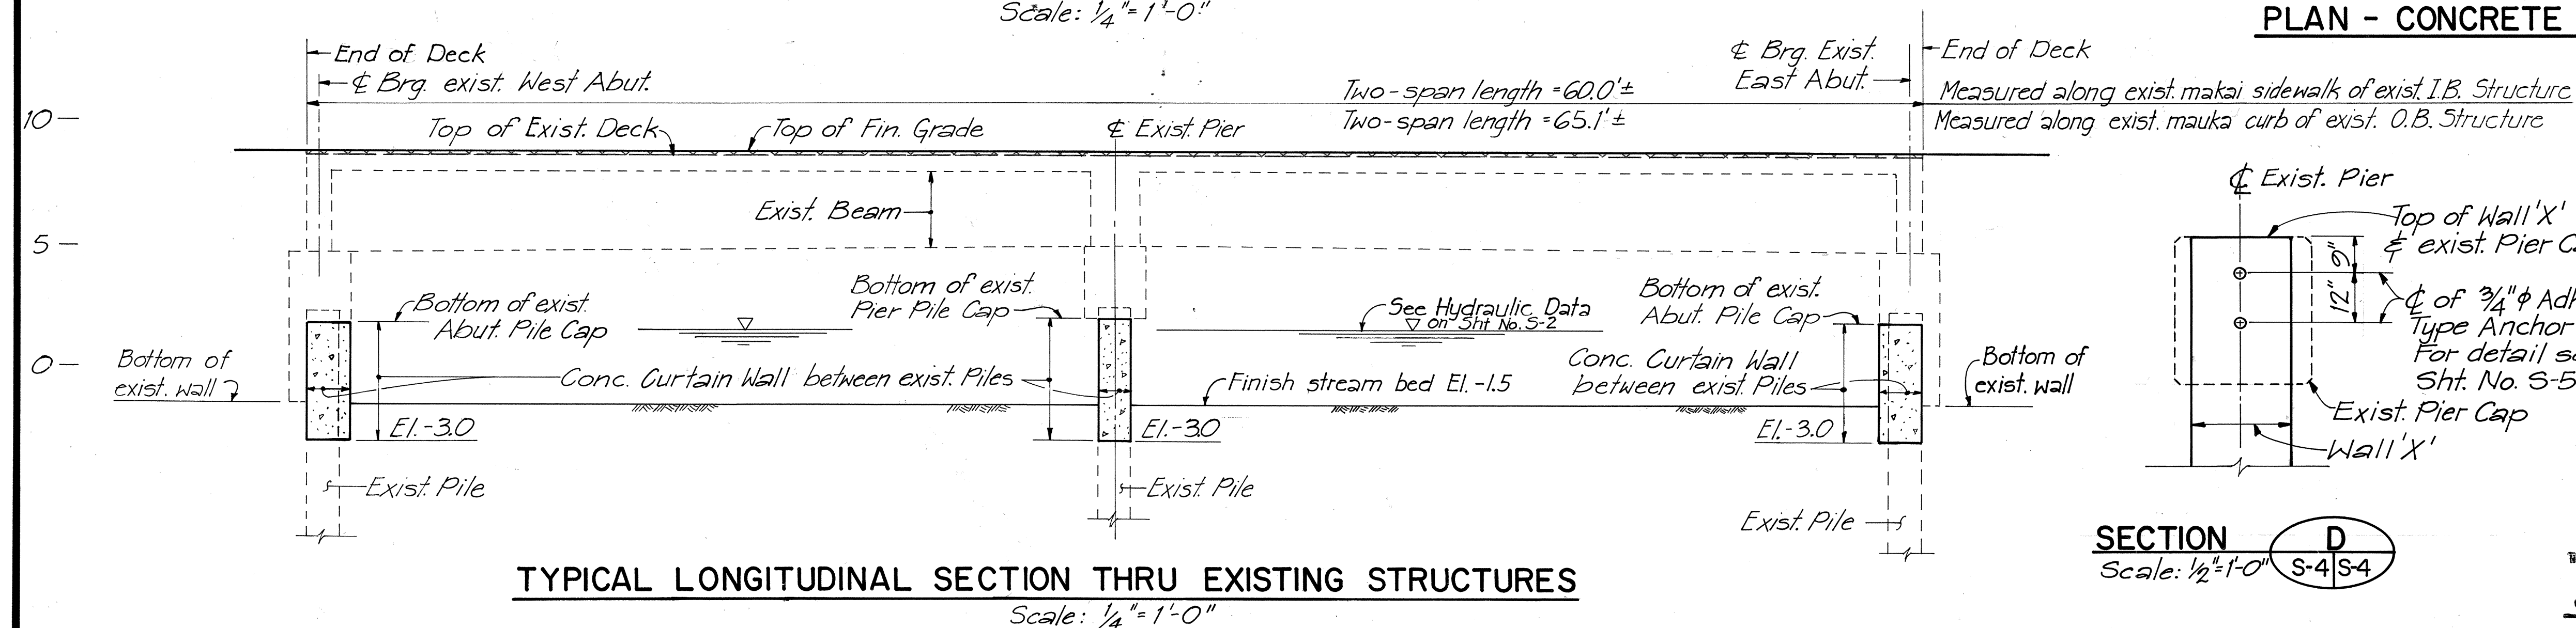

TYPICAL LONGITUDINAL SECTION THRU EXISTING STRUCTURES
Scale: $\frac{1}{4}" = 1'-0"$

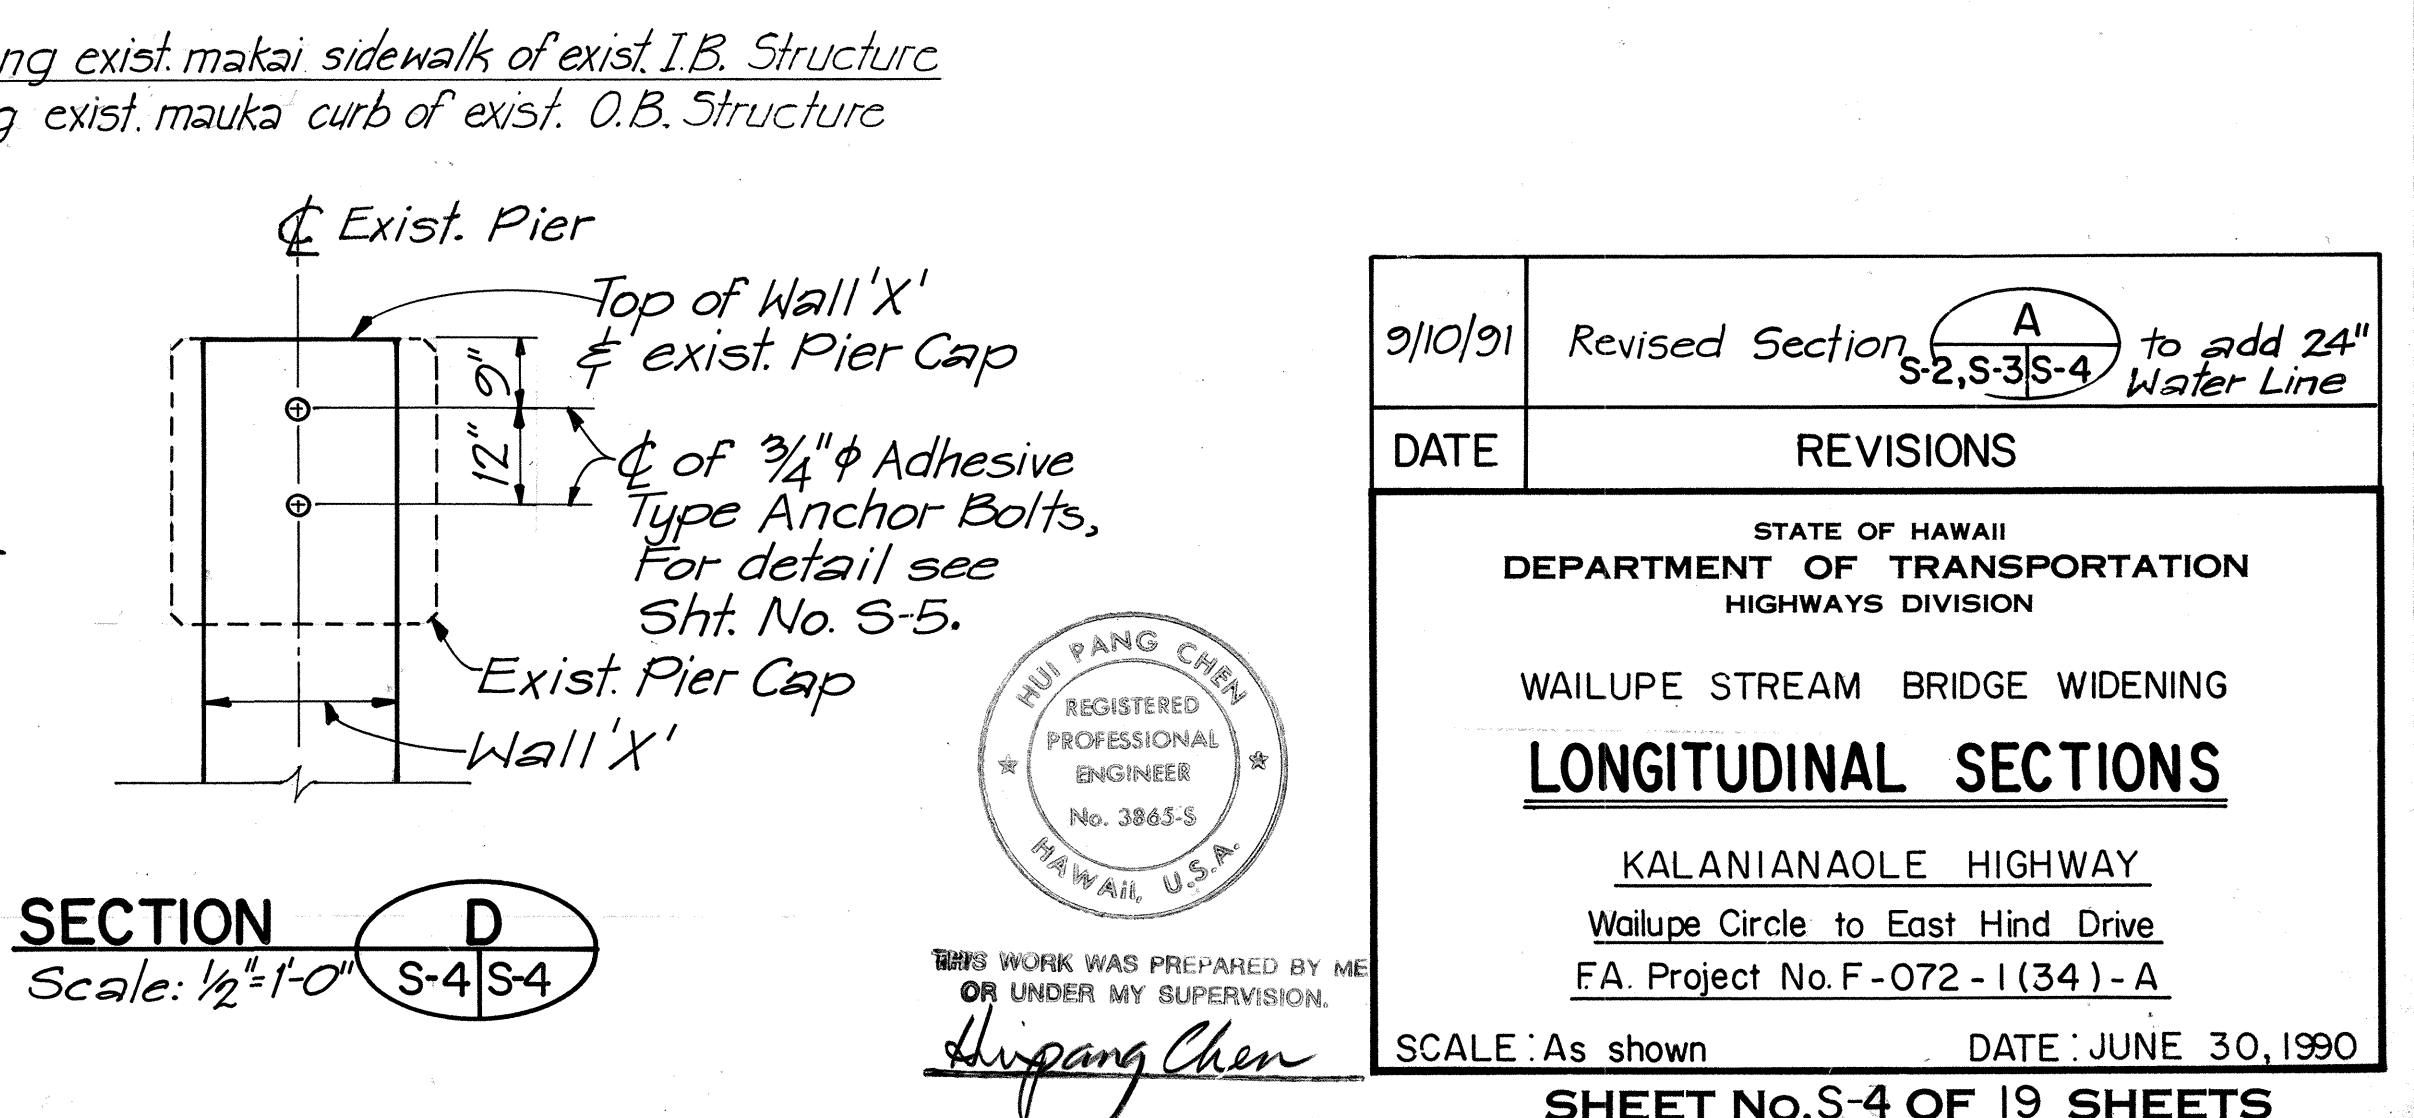

-5.



A circular professional engineer seal for Hui Pang Chen. The outer ring contains the name "HUI PANG CHEN" at the top and "HAWAII, U.S.A." at the bottom, separated by two stars. The inner circle contains the text "REGISTERED PROFESSIONAL ENGINEER" and "No. 3863-S".

THIS WORK WAS PREPARED BY ME
OR UNDER MY SUPERVISION.
Hipang Chen




9/10/91	Revised Section A S-2, S-3 S-4 to add 24" Water Line
DATE	REVISIONS
STATE OF HAWAII DEPARTMENT OF TRANSPORTATION HIGHWAYS DIVISION WAILUPE STREAM BRIDGE WIDENING LONGITUDINAL SECTIONS <u>KALANIANA'OLE HIGHWAY</u> <u>Wailupe Circle to East Hind Drive</u> <u>F.A. Project No. F-072 - I (34) - A</u>	
SCALE: As shown	DATE: JUNE 30, 1990

FED. ROAD DIST. NO.	STATE	FED. AID PROJ. NO.	FISCAL YEAR	SHEET NO.	TOTAL SHEETS
HAWAII	HAW.	F-072-1(34)-A	1990	160	186


- NOTE 'A': Construct new Conc. Curtain Walls between existing piles of the existing bridges.
- NOTE 'B': For spacings of piles, see individual pier & abutment details on Sht. Nos. 5-6, to 5-9.
- NOTE 'C': The interface between existing pile & curtain wall shall be cleaned by sandblasting (free of dirt, oil & laitance). Epoxy Bonding Material shall be coated on the surface of exist. pile immediately prior to pouring curtain wall concrete.
- NOTE 'D': The temporary sheeting shown is incomplete. Provide temporary sheeting as required during construction of footings & walls.
- NOTE 'E': If an existing rebar is encountered during drilling of an adhesive type anchor bolt hole, the hole shall be abandoned and filled with epoxy grout. A replacement hole shall be drilled so that the spacing of bolts is maintained.
- NOTE 'F': For additional requirements for pile driving adjacent to 24" Water Line, See Sht. No. S-2.

PILE ELEVATIONS

	Abut. #1	Pier #1	Abut. #2	Abut. #3	Pier #2	Abut. #4	Remarks
Upstream Piles	Pile Cut-off Elev. -2.00 Pile Tip Elev. -30.00	Pile Cut-off Elev. 2.56 Pile Tip Elev. -30.00	Pile Cut-off Elev. -2.00 Pile Tip Elev. -30.00	Pile Cut-off Elev. -2.00 Pile Tip Elev. -30.00	Pile Cut-off Elev. 3.62 Pile Tip Elev. -30.00	Pile Cut-off Elev. -2.00 Pile Tip Elev. -30.00	Added Pile Upstream
Middle Piles		2.80			4.19		Middle Piles
DN Stream Piles	-2.00 -30.00	2.91 -30.00	-2.00 -30.00	-2.00 -30.00	4.45 -30.00	-2.00 -30.00	DN Stream Piles
Added Pile		2.46 -30.00					Pier Cap or Abut. Footing

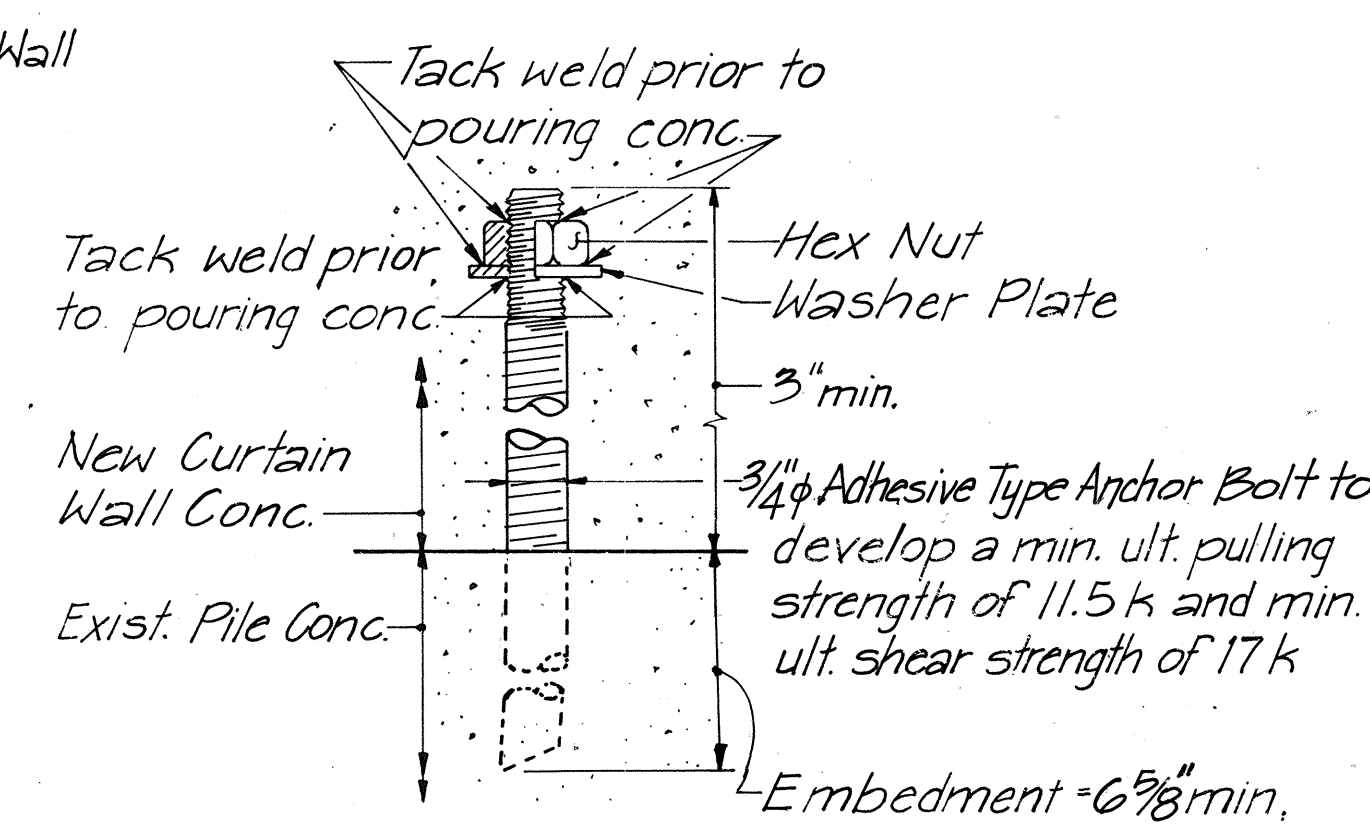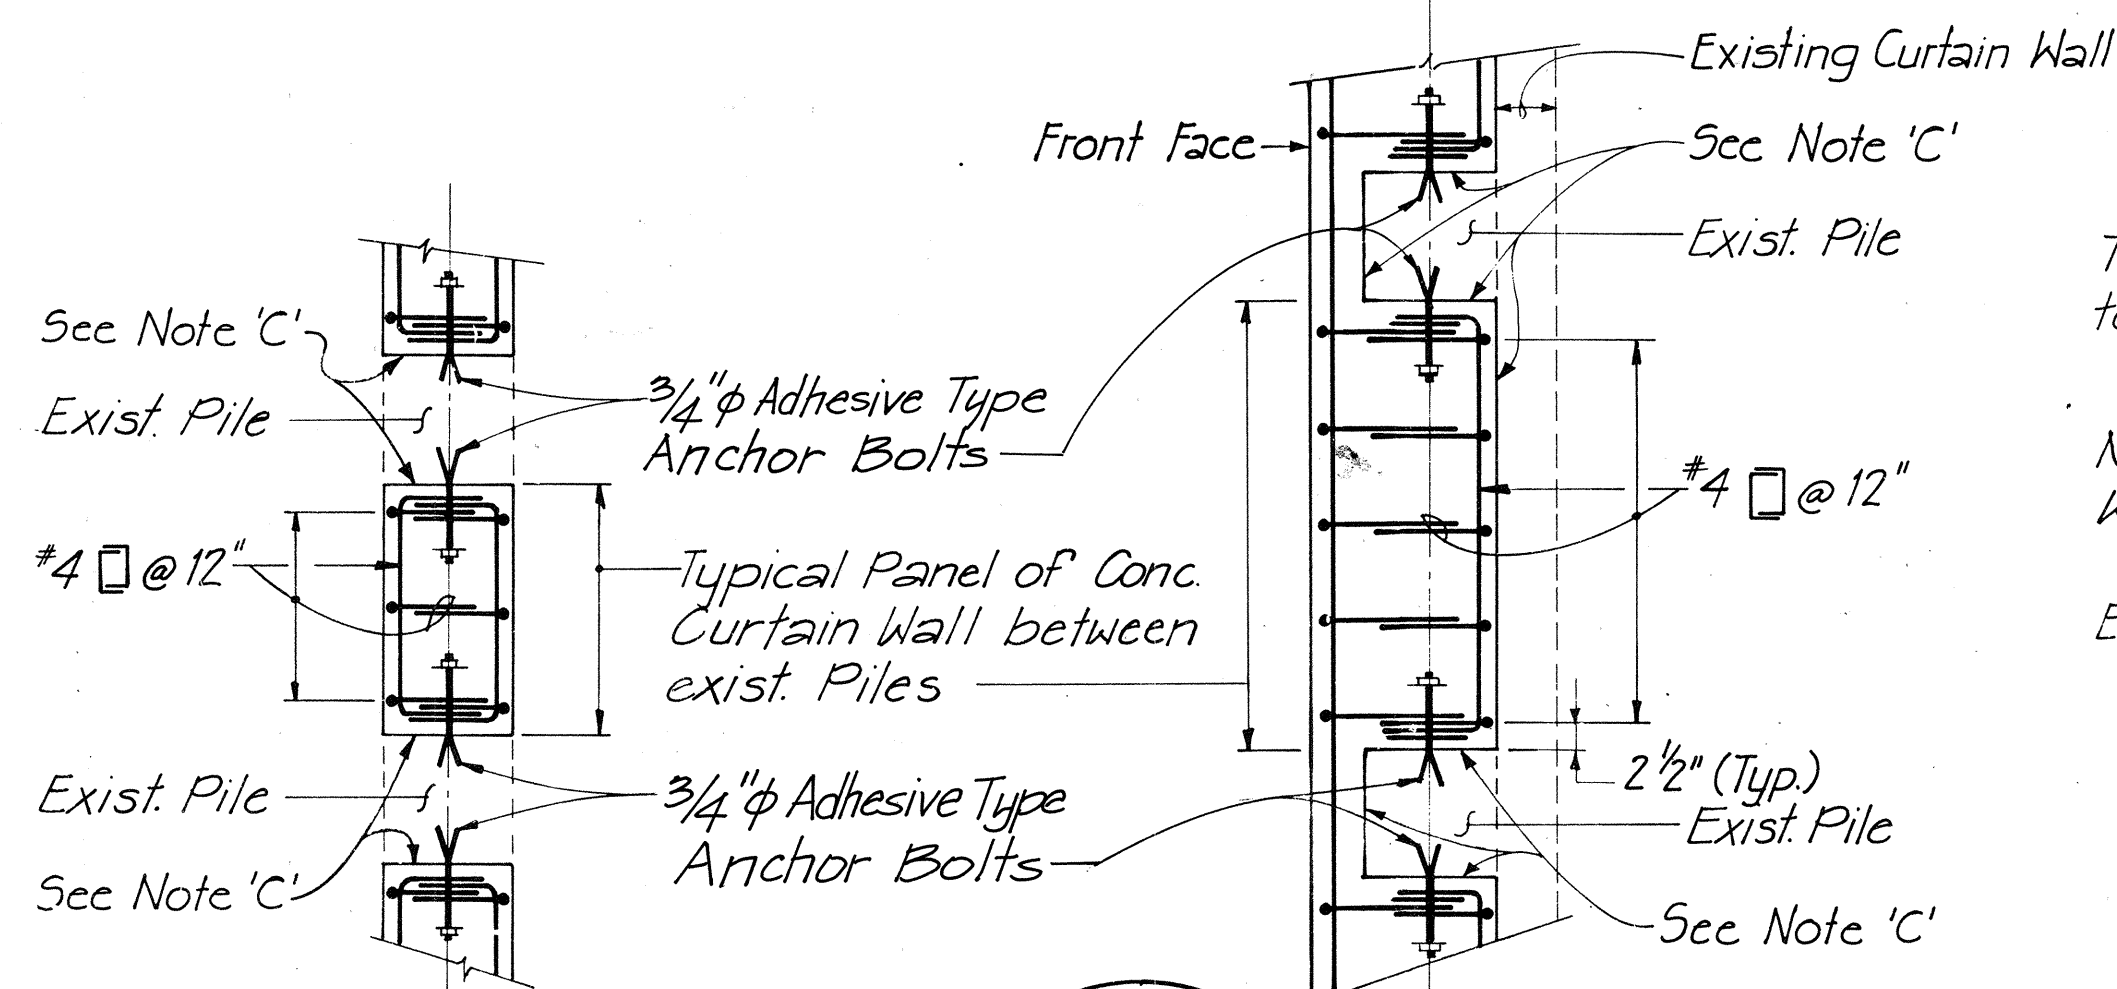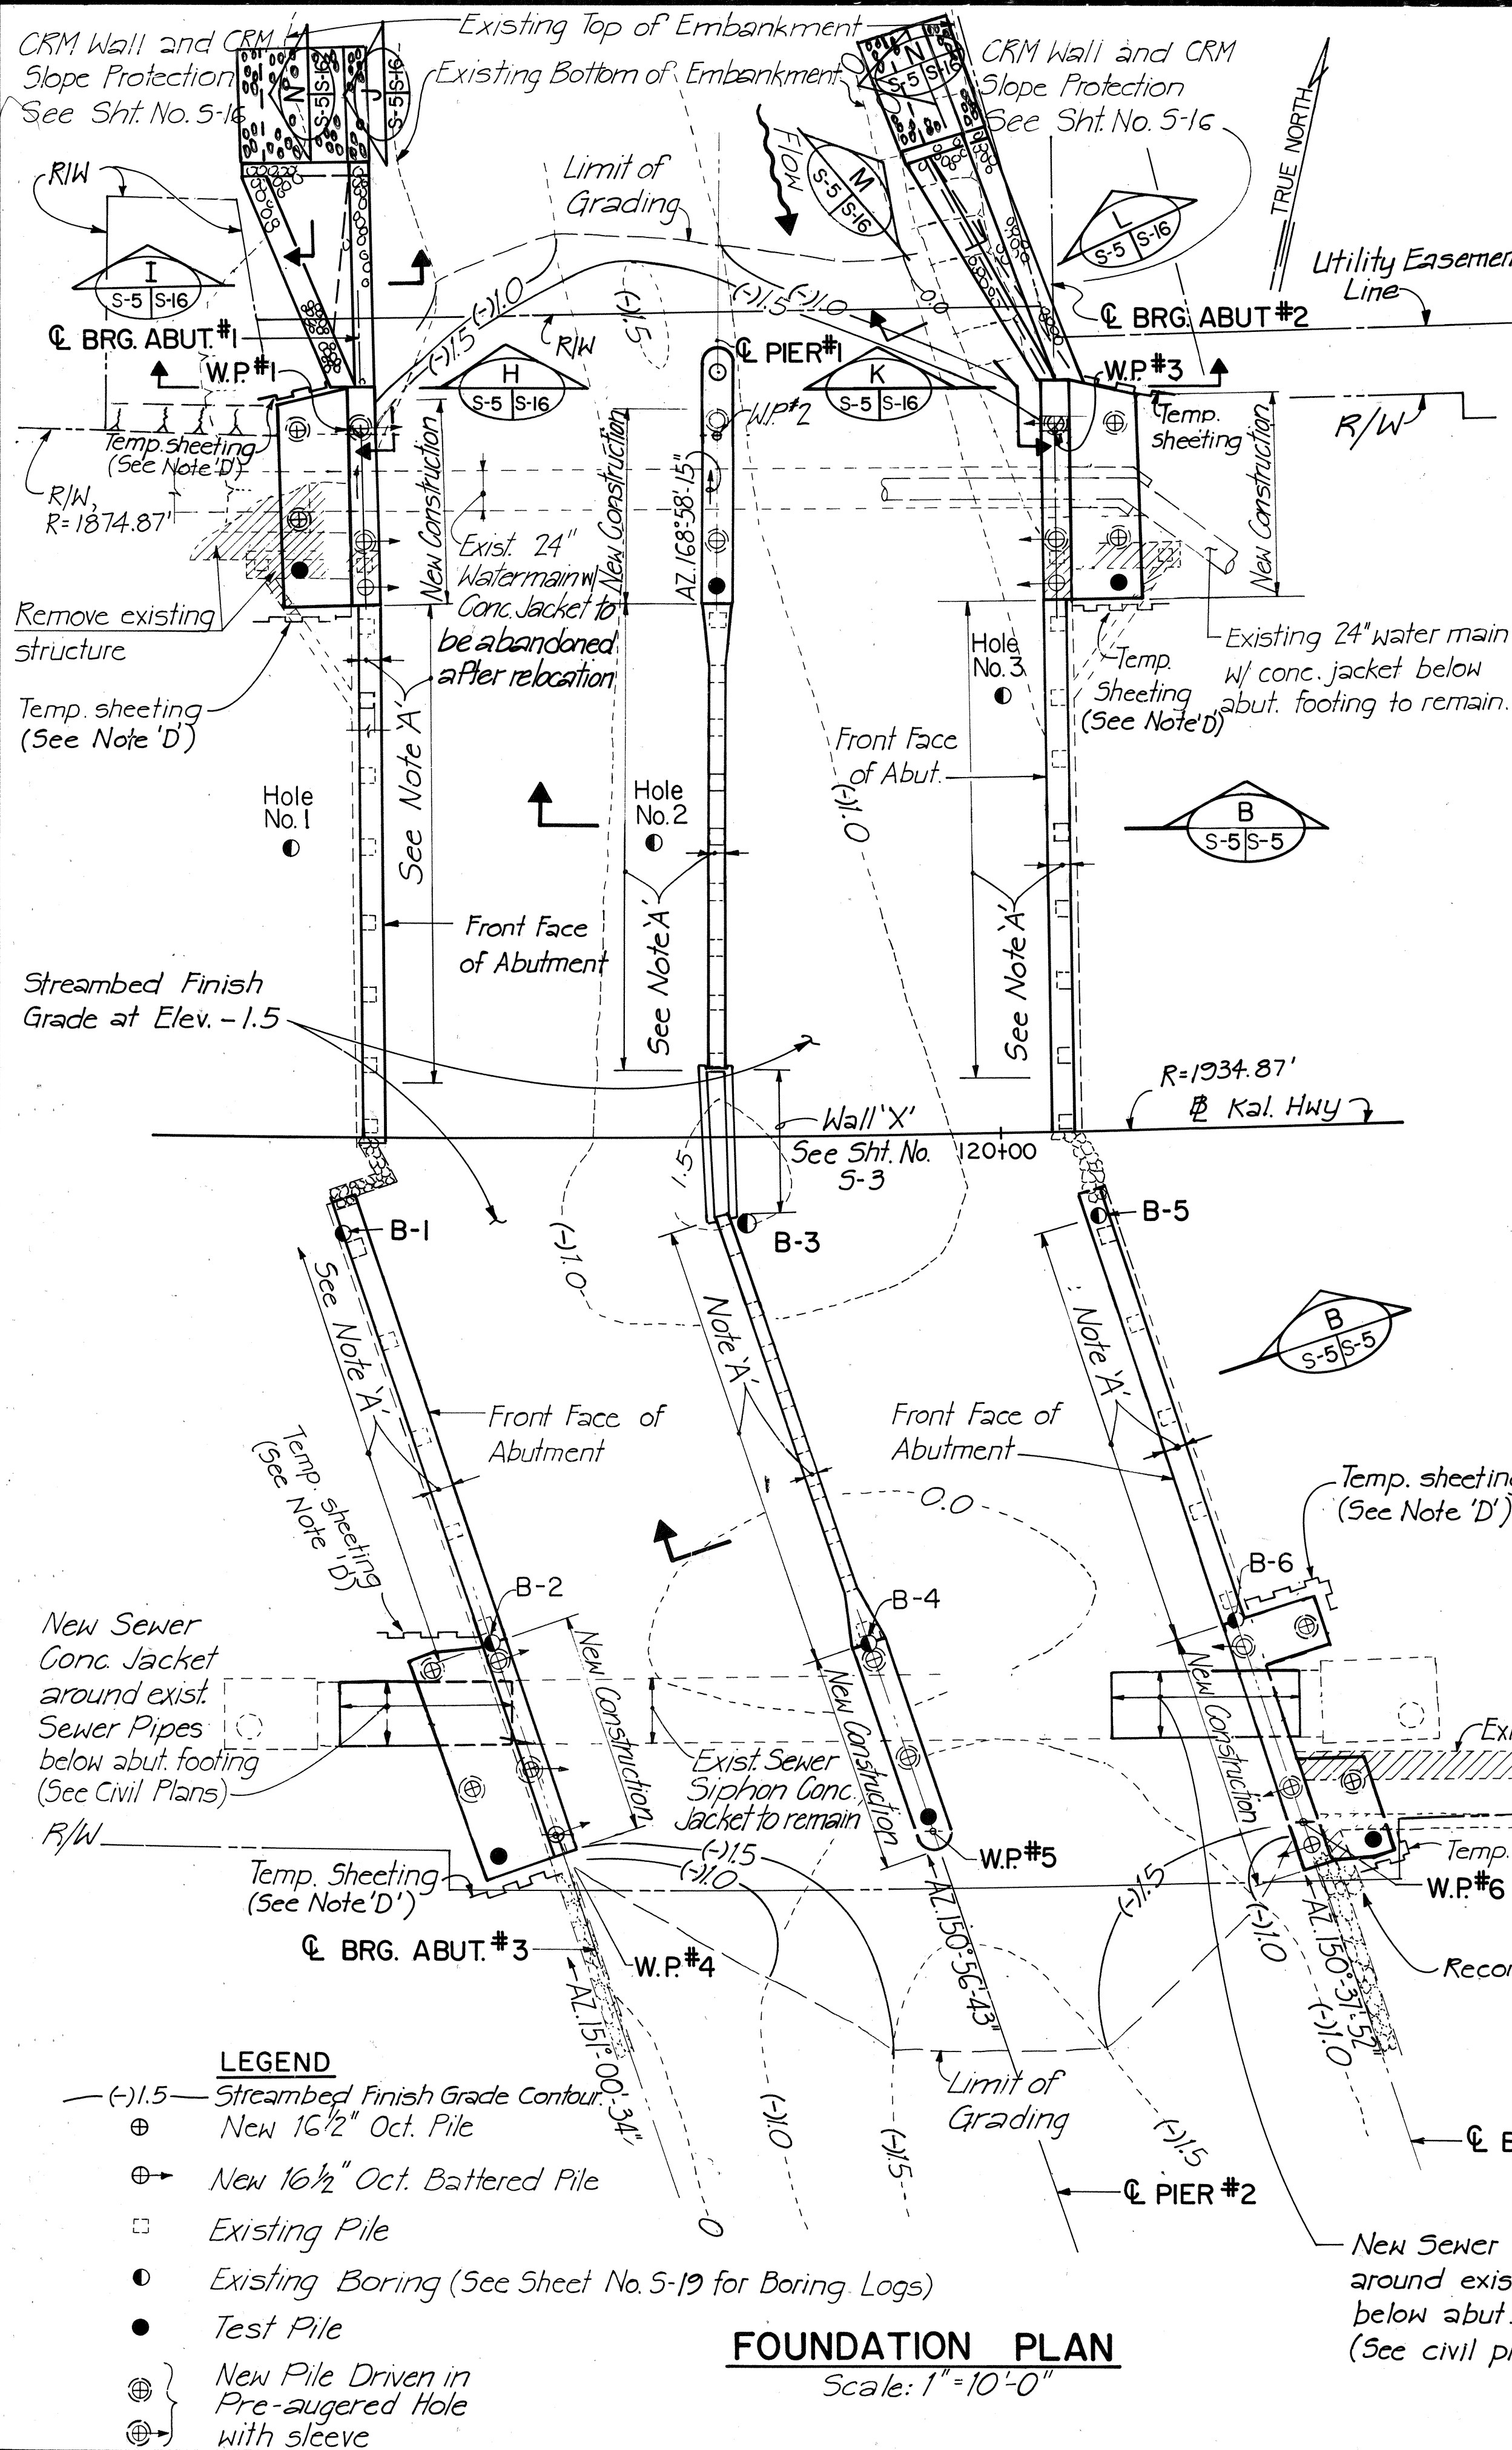

(NOTE: All Adhesive Type Anchor Bolts, Nuts & Washers shall be stainless steel. See Note 'E').

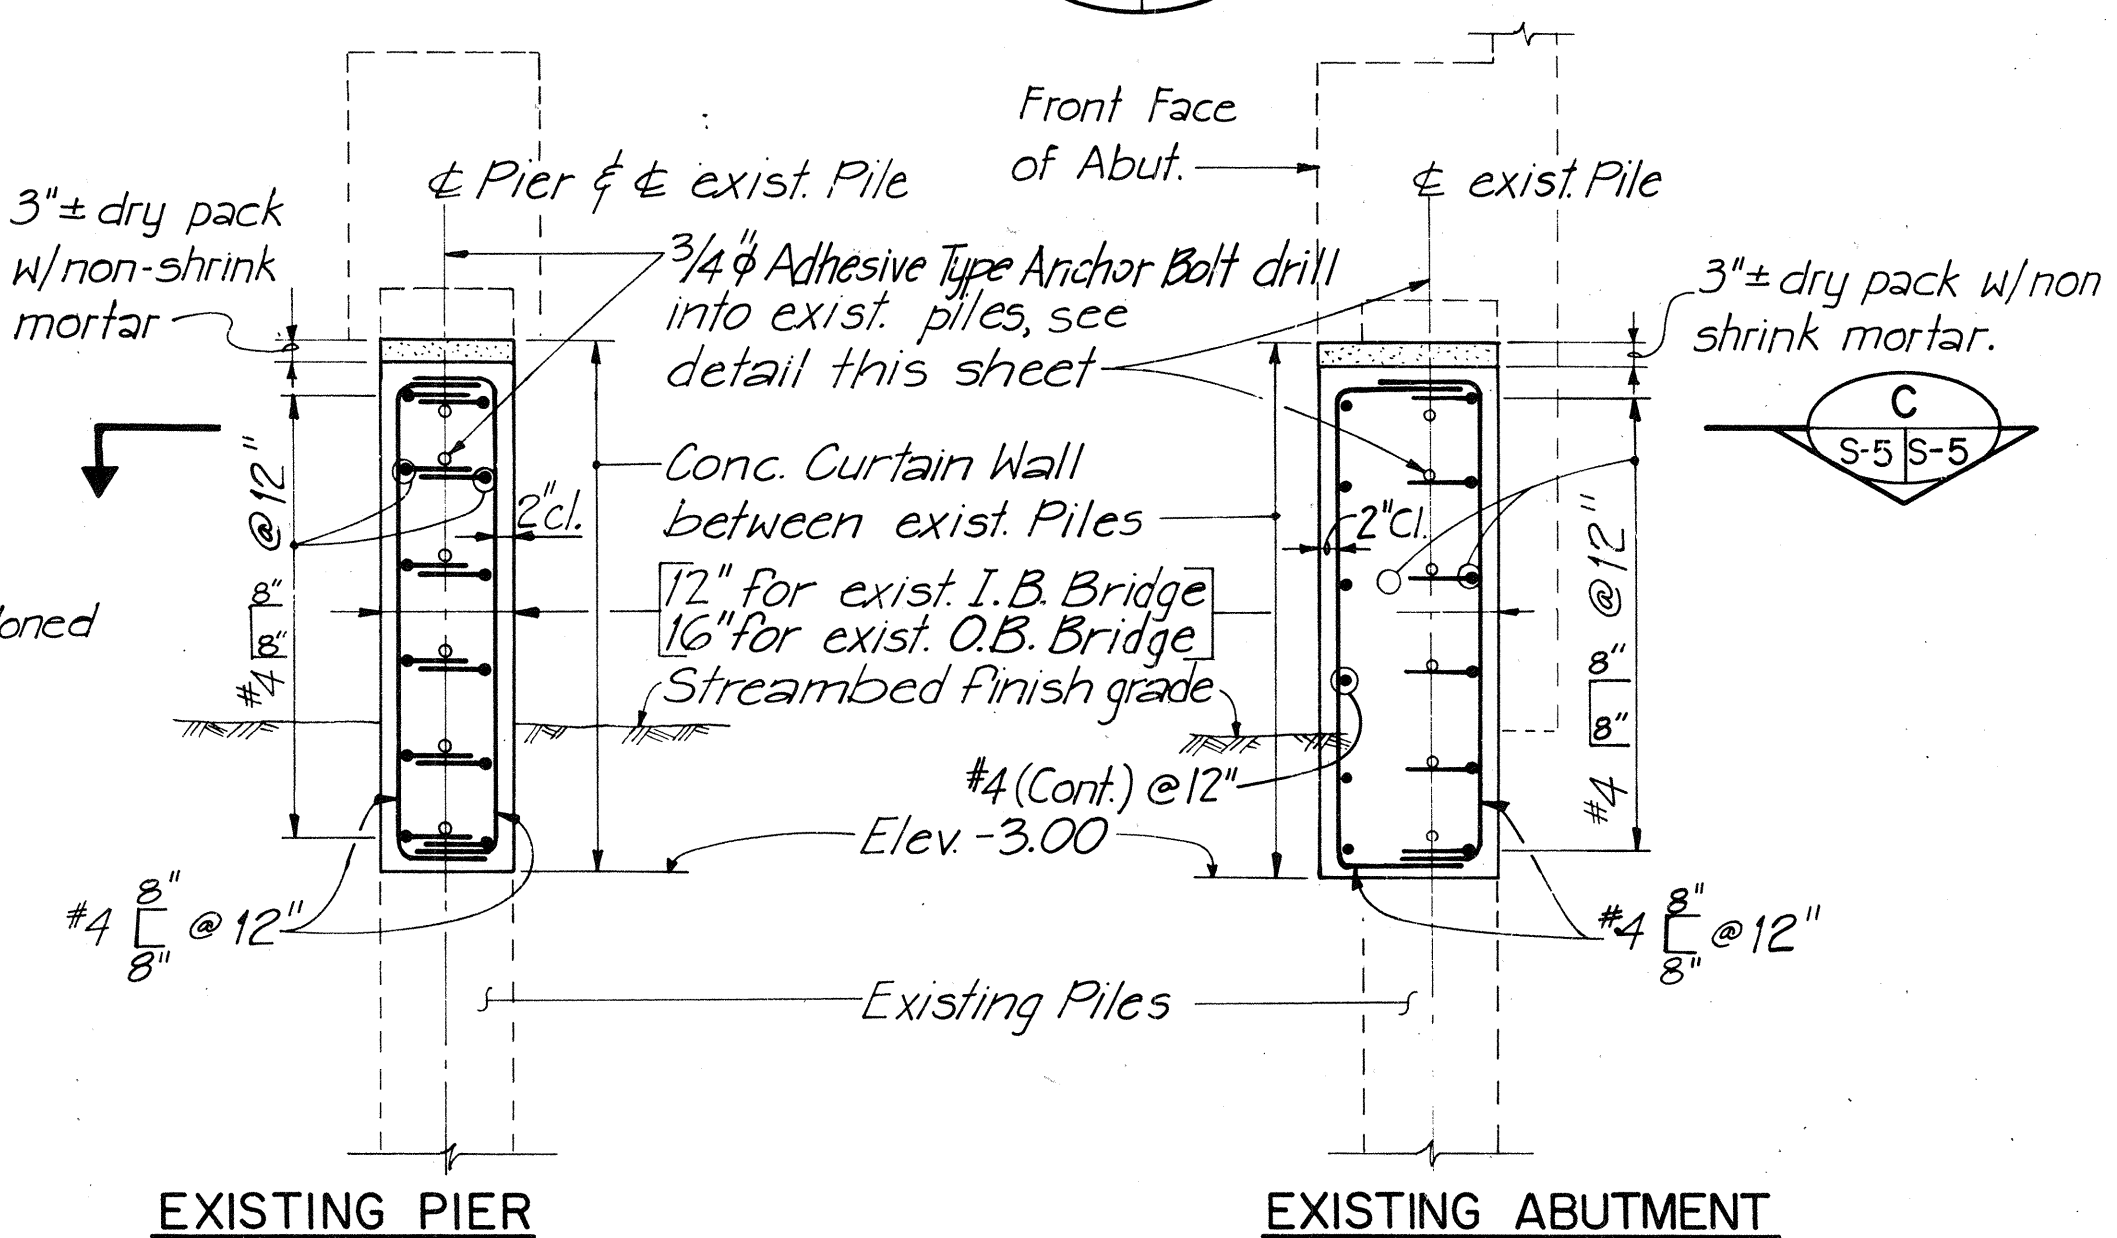

TYPICAL CONCRETE CURTAIN WALL BETWEEN EXIST. PILES

Scale: 1/2"=1'-0"

NOTE: For details of transition panel between exist. piles & new curtain wall, see Sht. Nos. 5-6 & 5-7.

Chief, Png. & Engr., B.W.S.

DATE: JUNE 30, 1990

9/10/91 Revised Foundation Plan to add 24" Water Line. Added pile data to pile schedule. Added Note 'F'.

DATE REVISIONS

STATE OF HAWAII
DEPARTMENT OF TRANSPORTATION
HIGHWAYS DIVISION

WAILUPE STREAM BRIDGE WIDENING

FOUNDATION PLAN

KALANIANA'OLE HIGHWAY

Wailupe Circle to East Hind Drive


FA. Project No. F-072-1(34)-A

SCALE: As shown DATE: JUNE 30, 1990






SHEET No. S-5 OF 19 SHEETS


C.O.160

FED. ROAD DIST. NO.	STATE	FED. AID PROJ. NO.	FISCAL YEAR	SHEET NO.	TOTAL SHEETS
HAWAII	HAW.	F-072-1(34)-A	1990	161	186

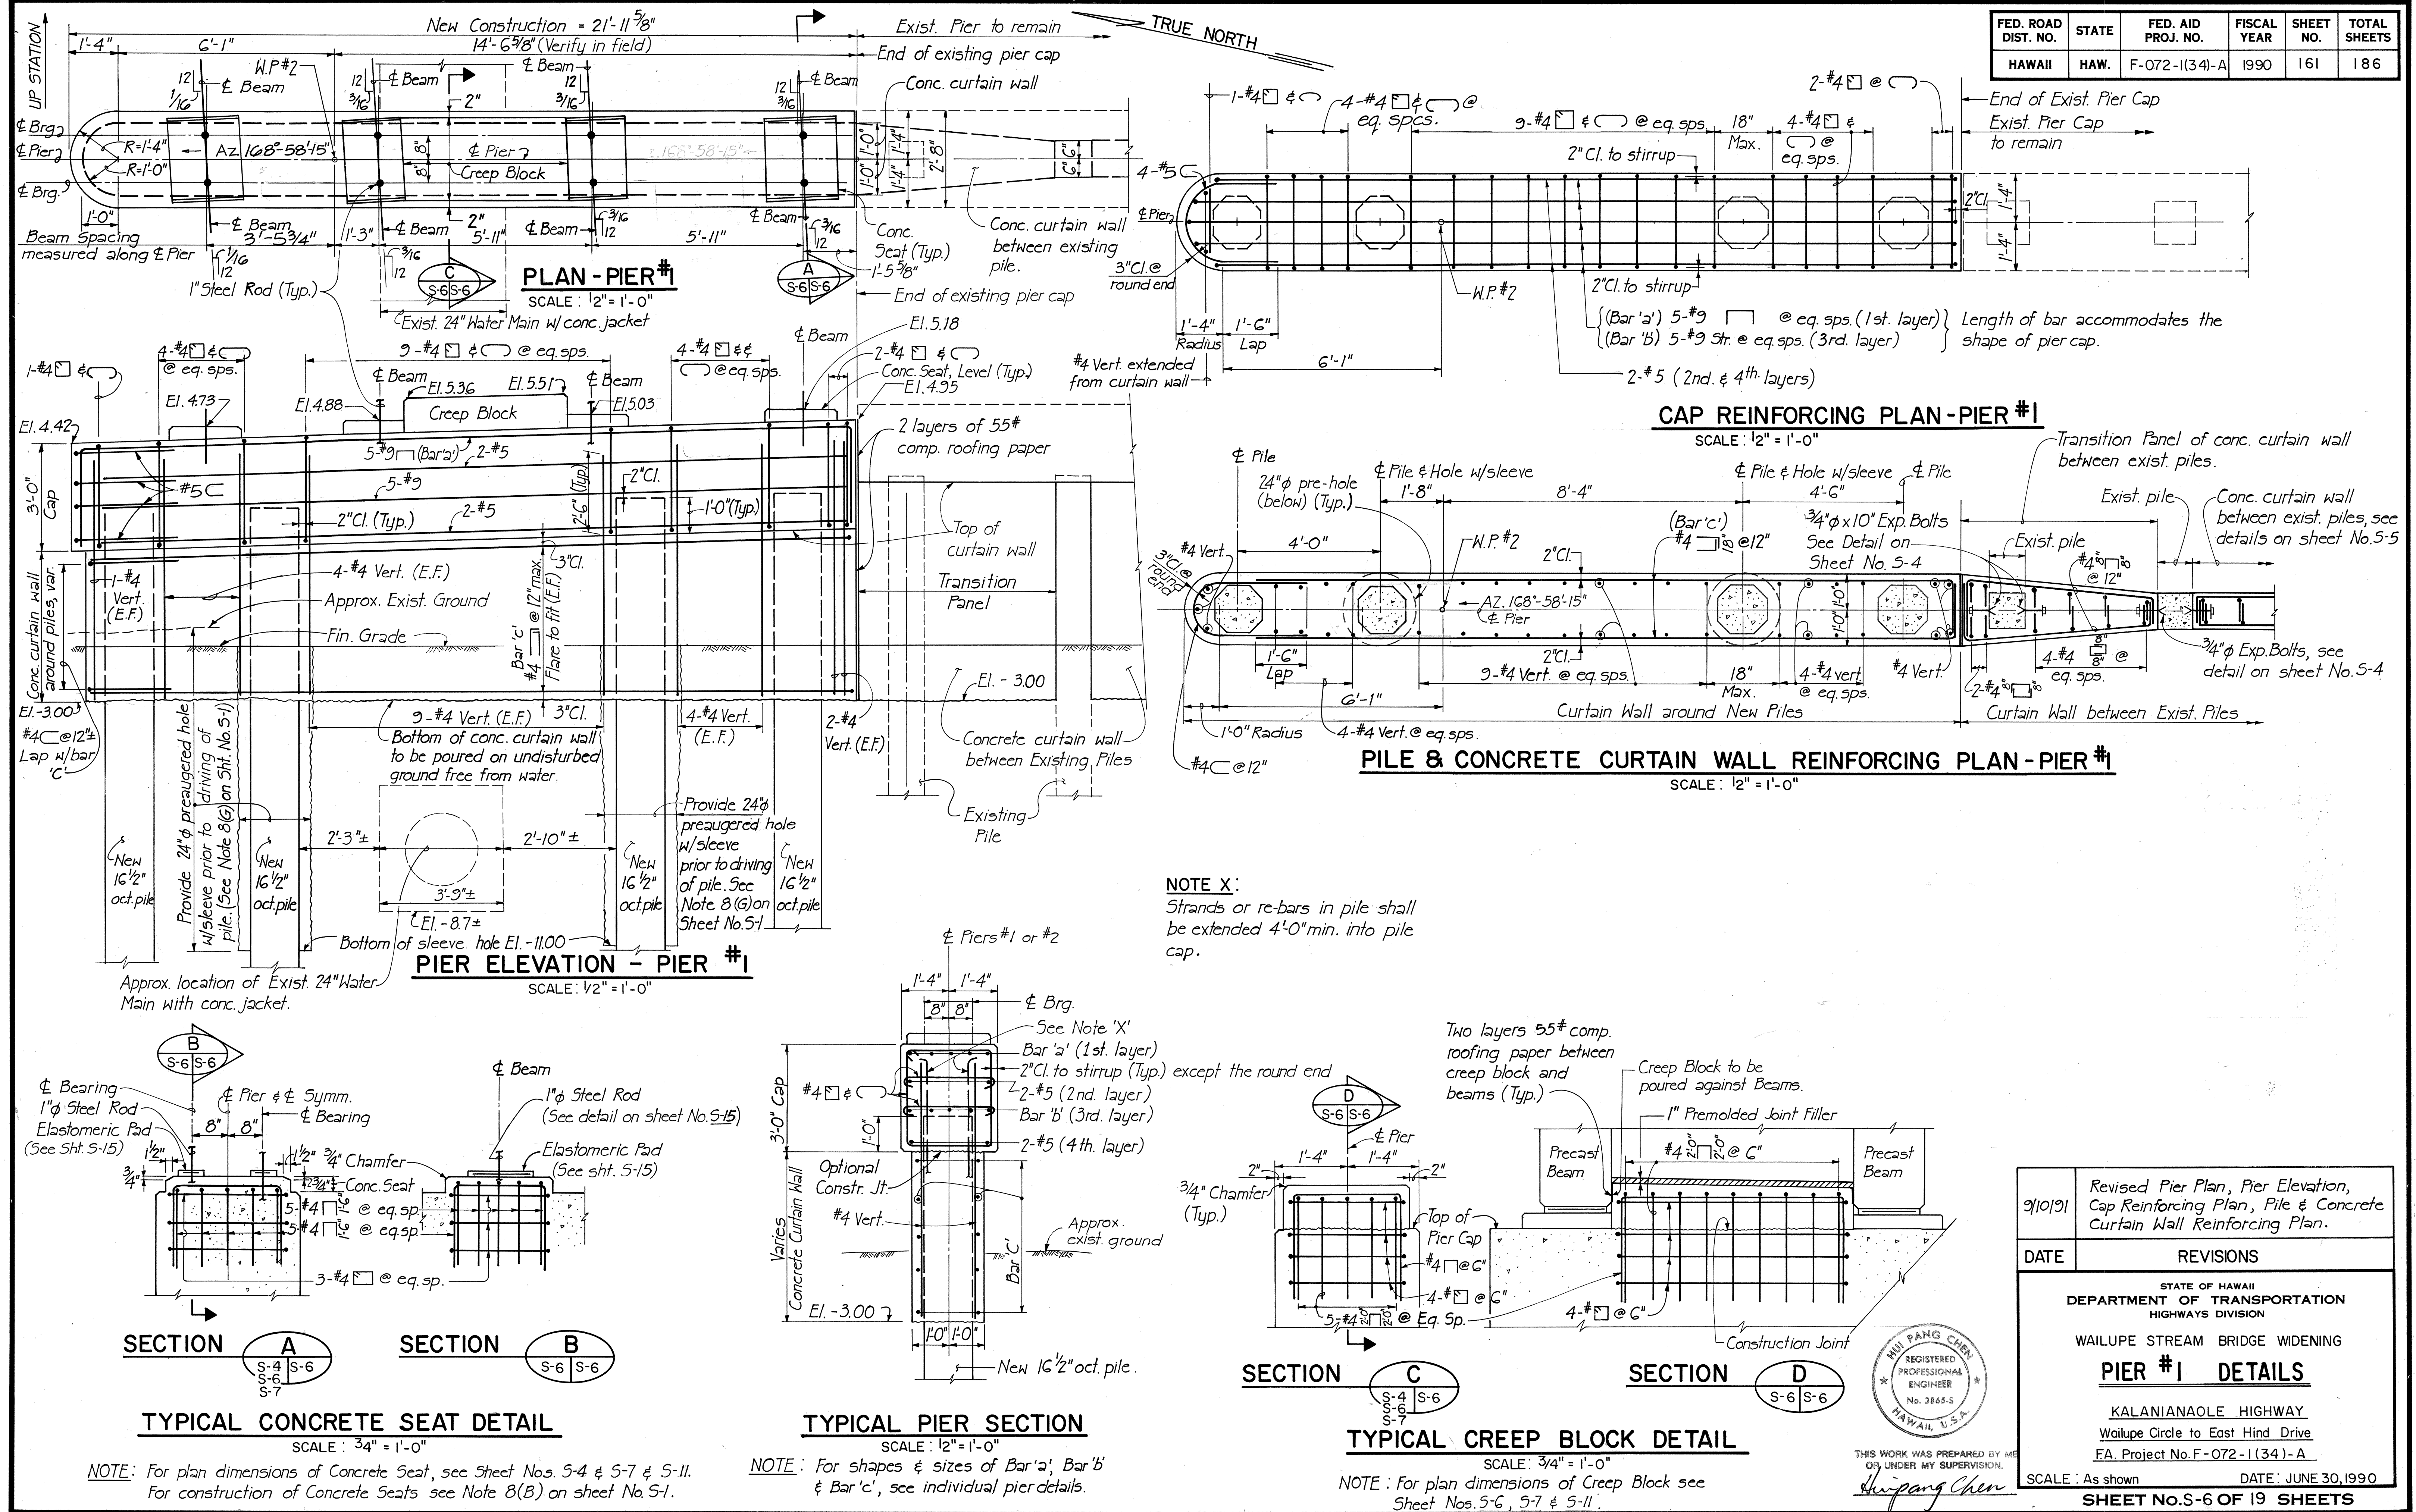

FED. ROAD DIST. NO.	STATE	FED. AID PROJ. NO.	FISCAL YEAR	SHEET NO.	TOTAL SHEETS
HAWAII	HAW.	F-072-1(34)-A	1990	162	186

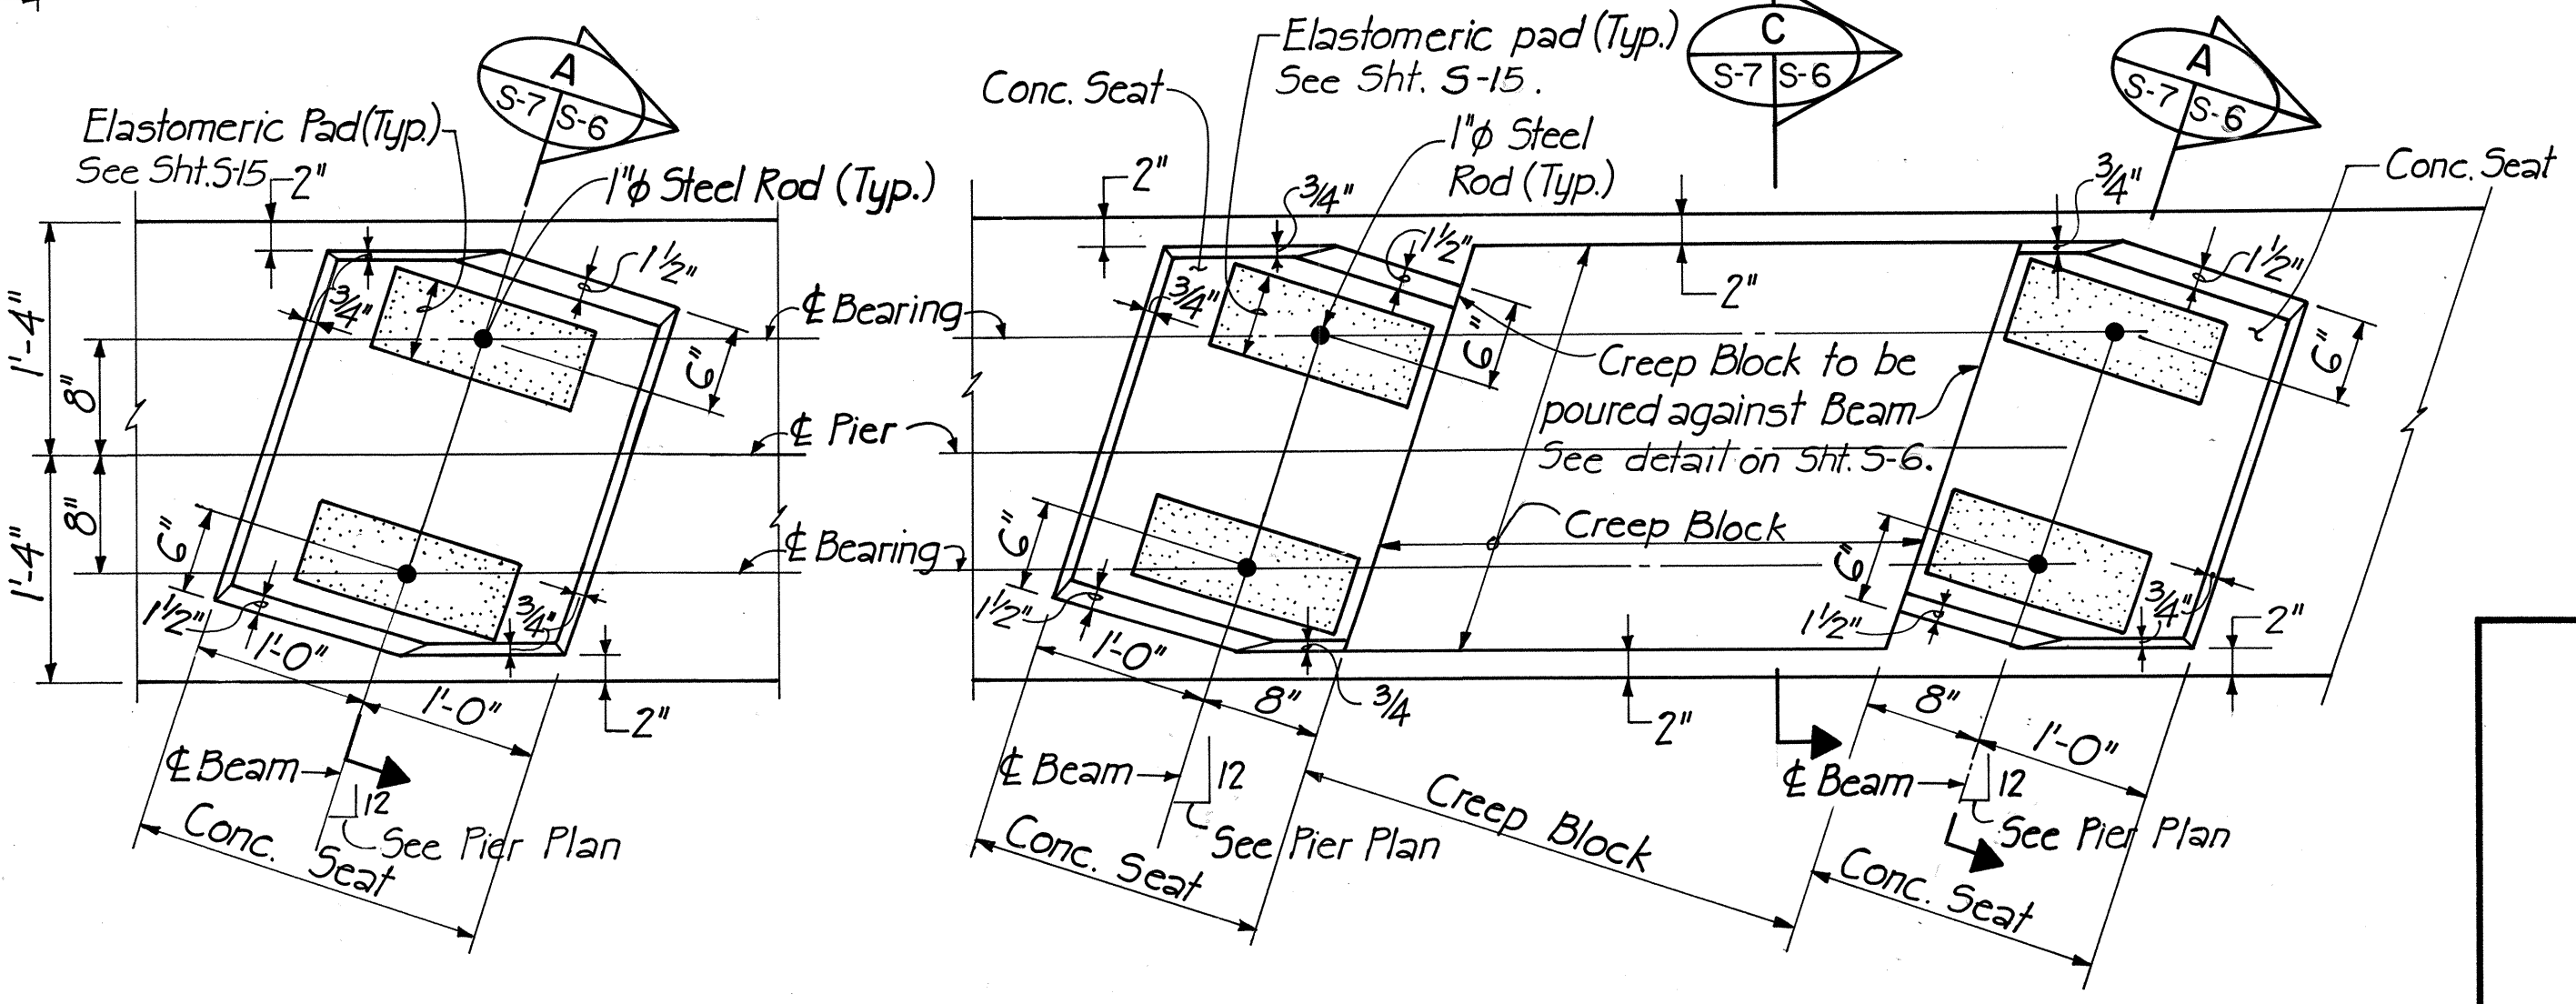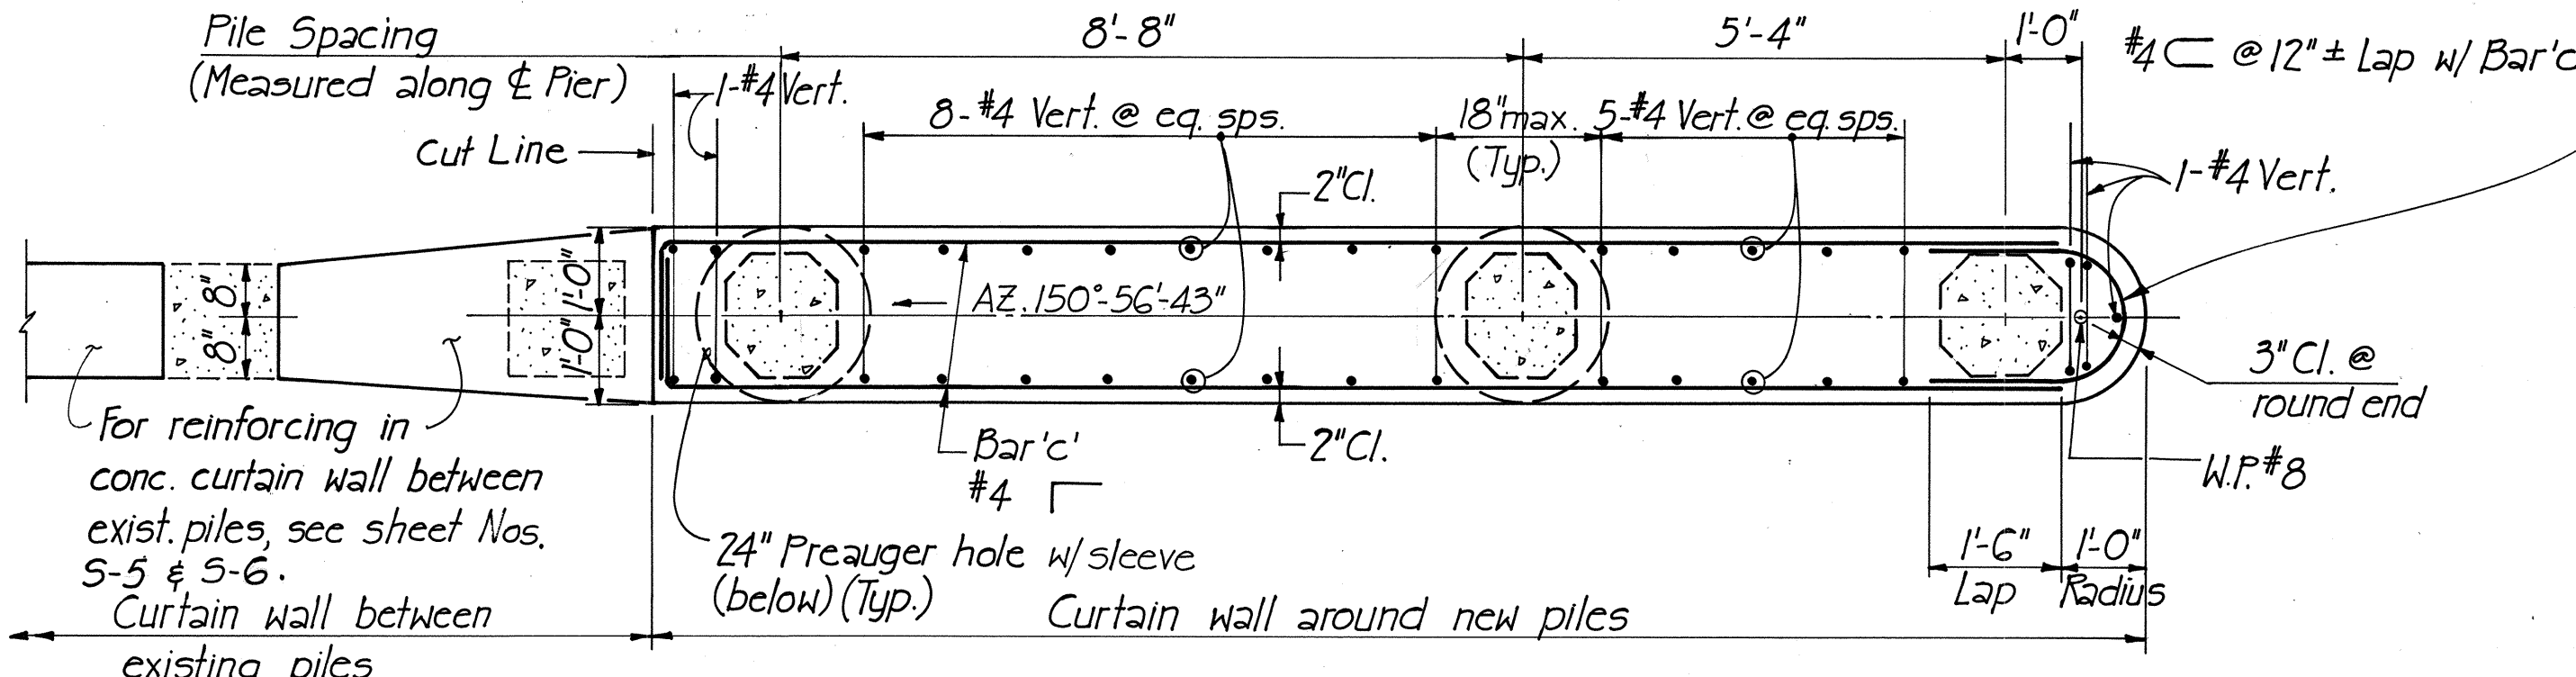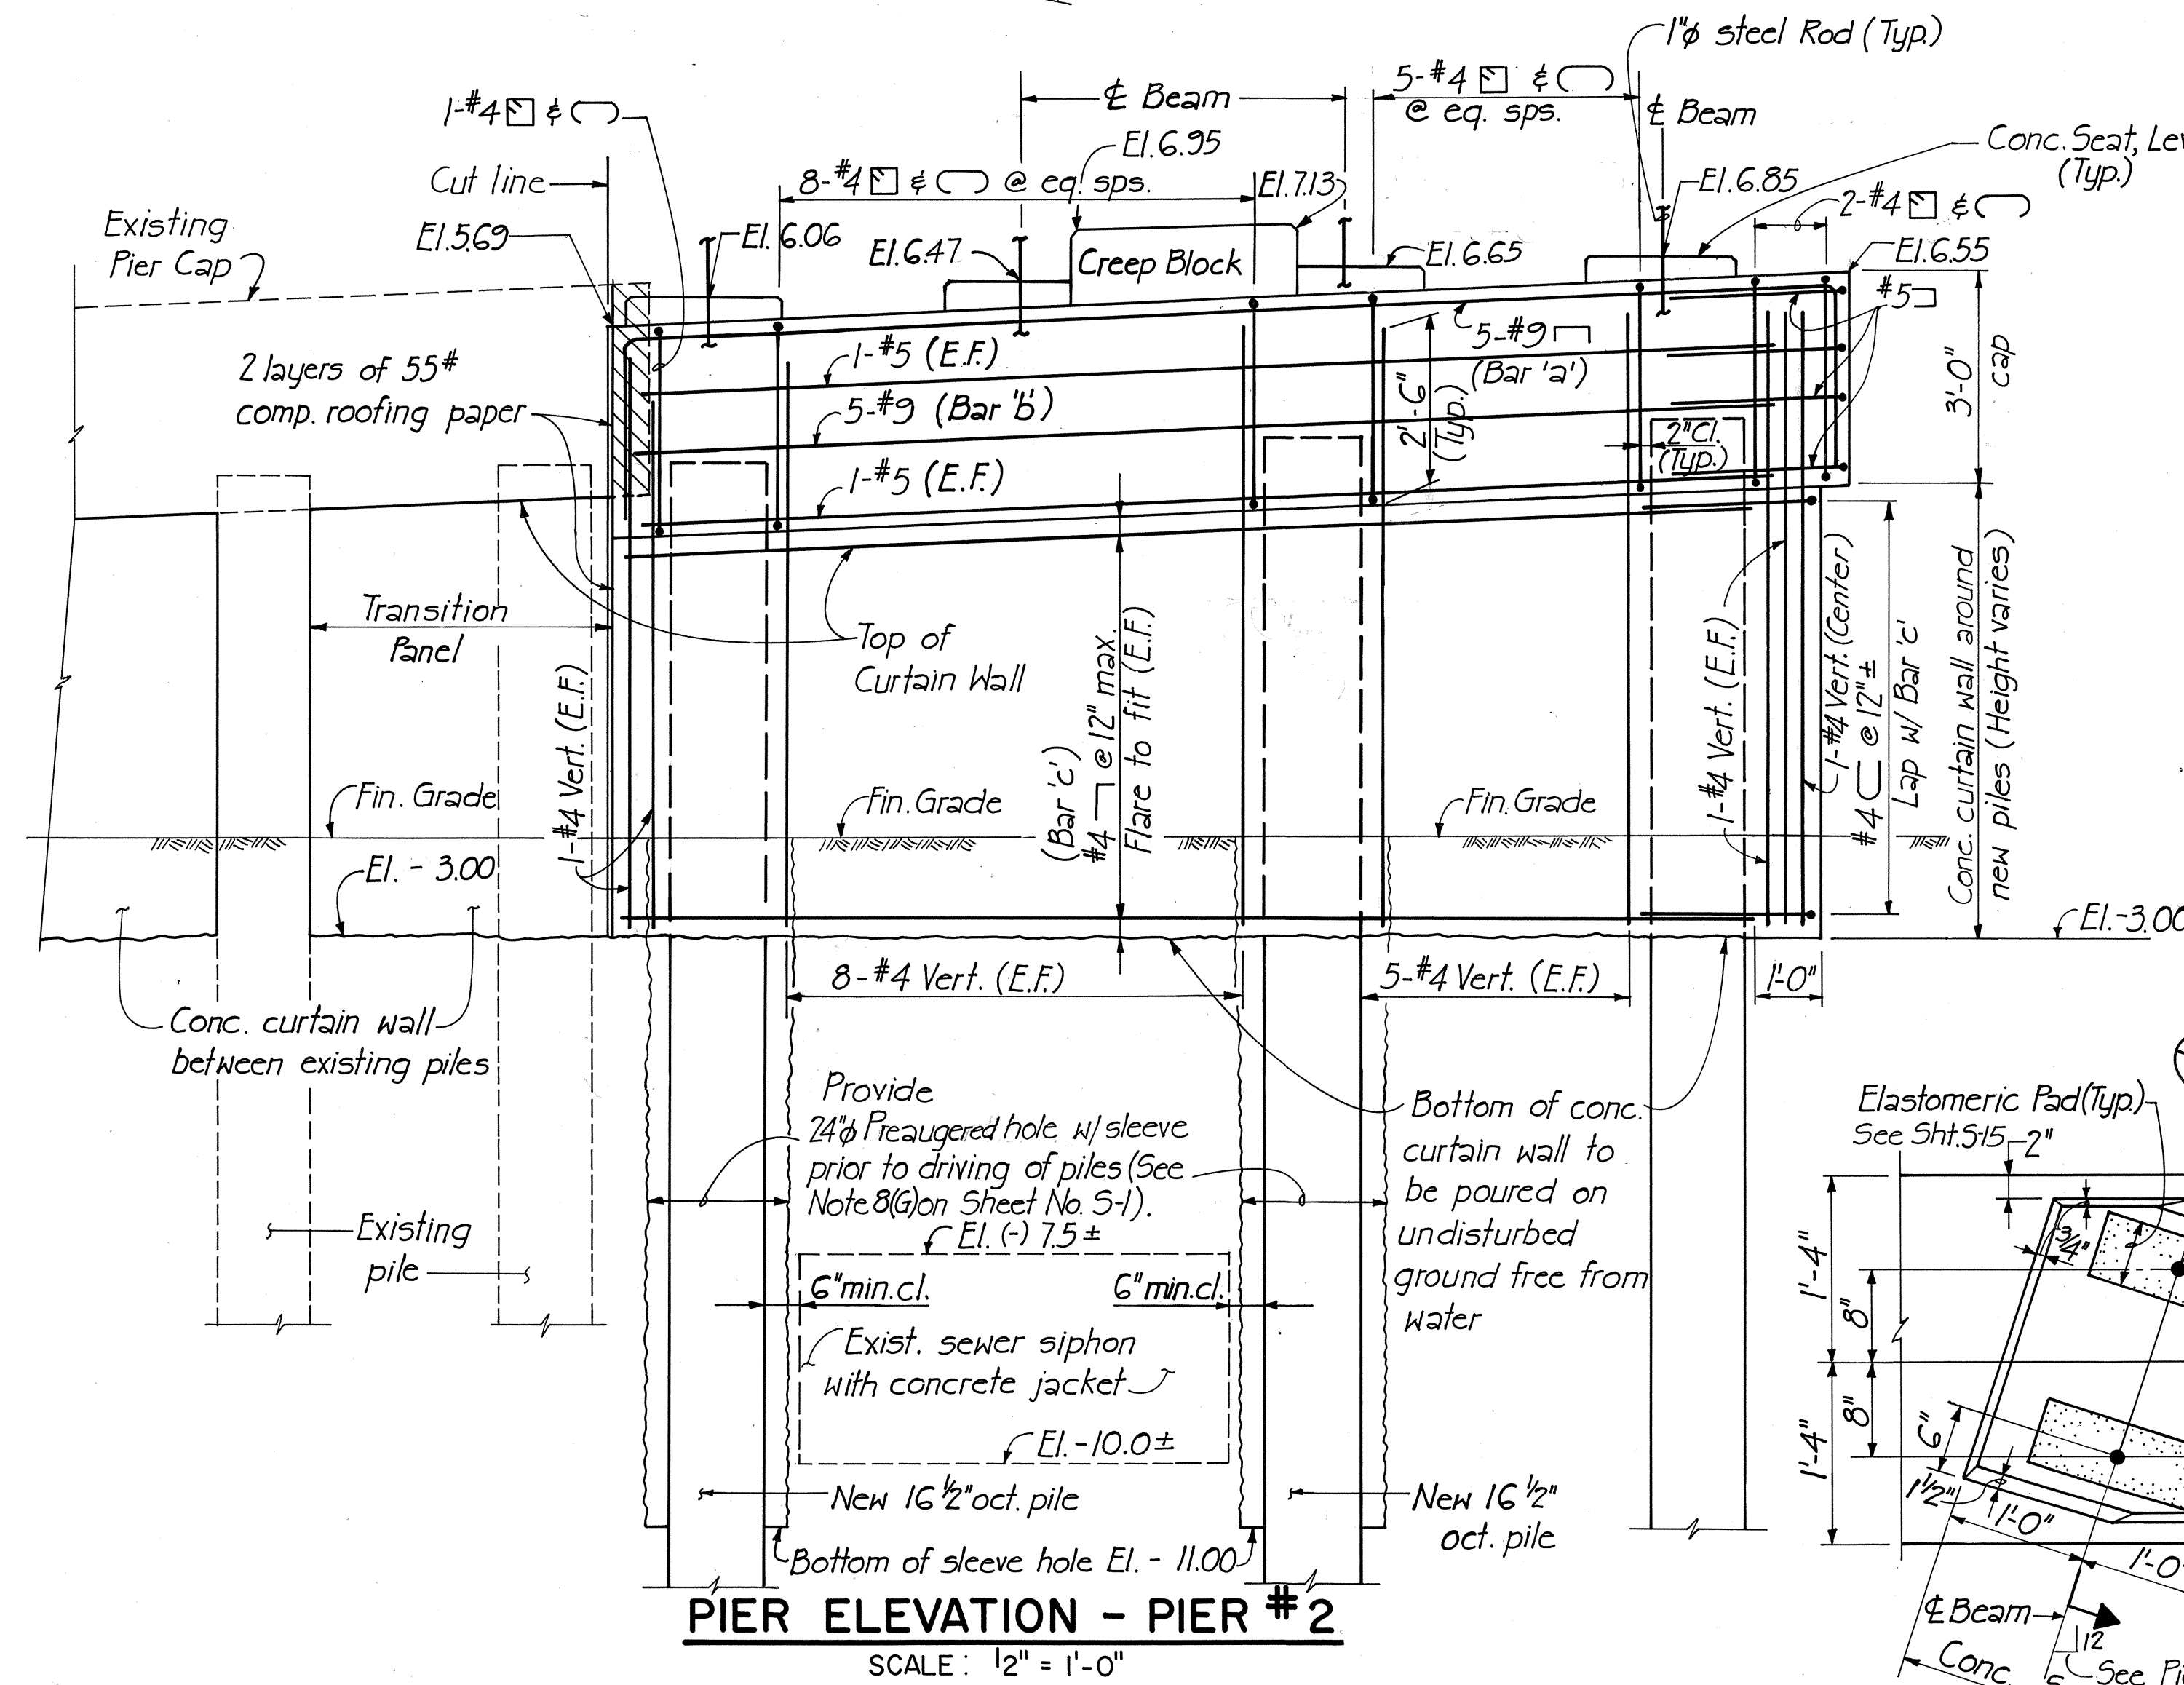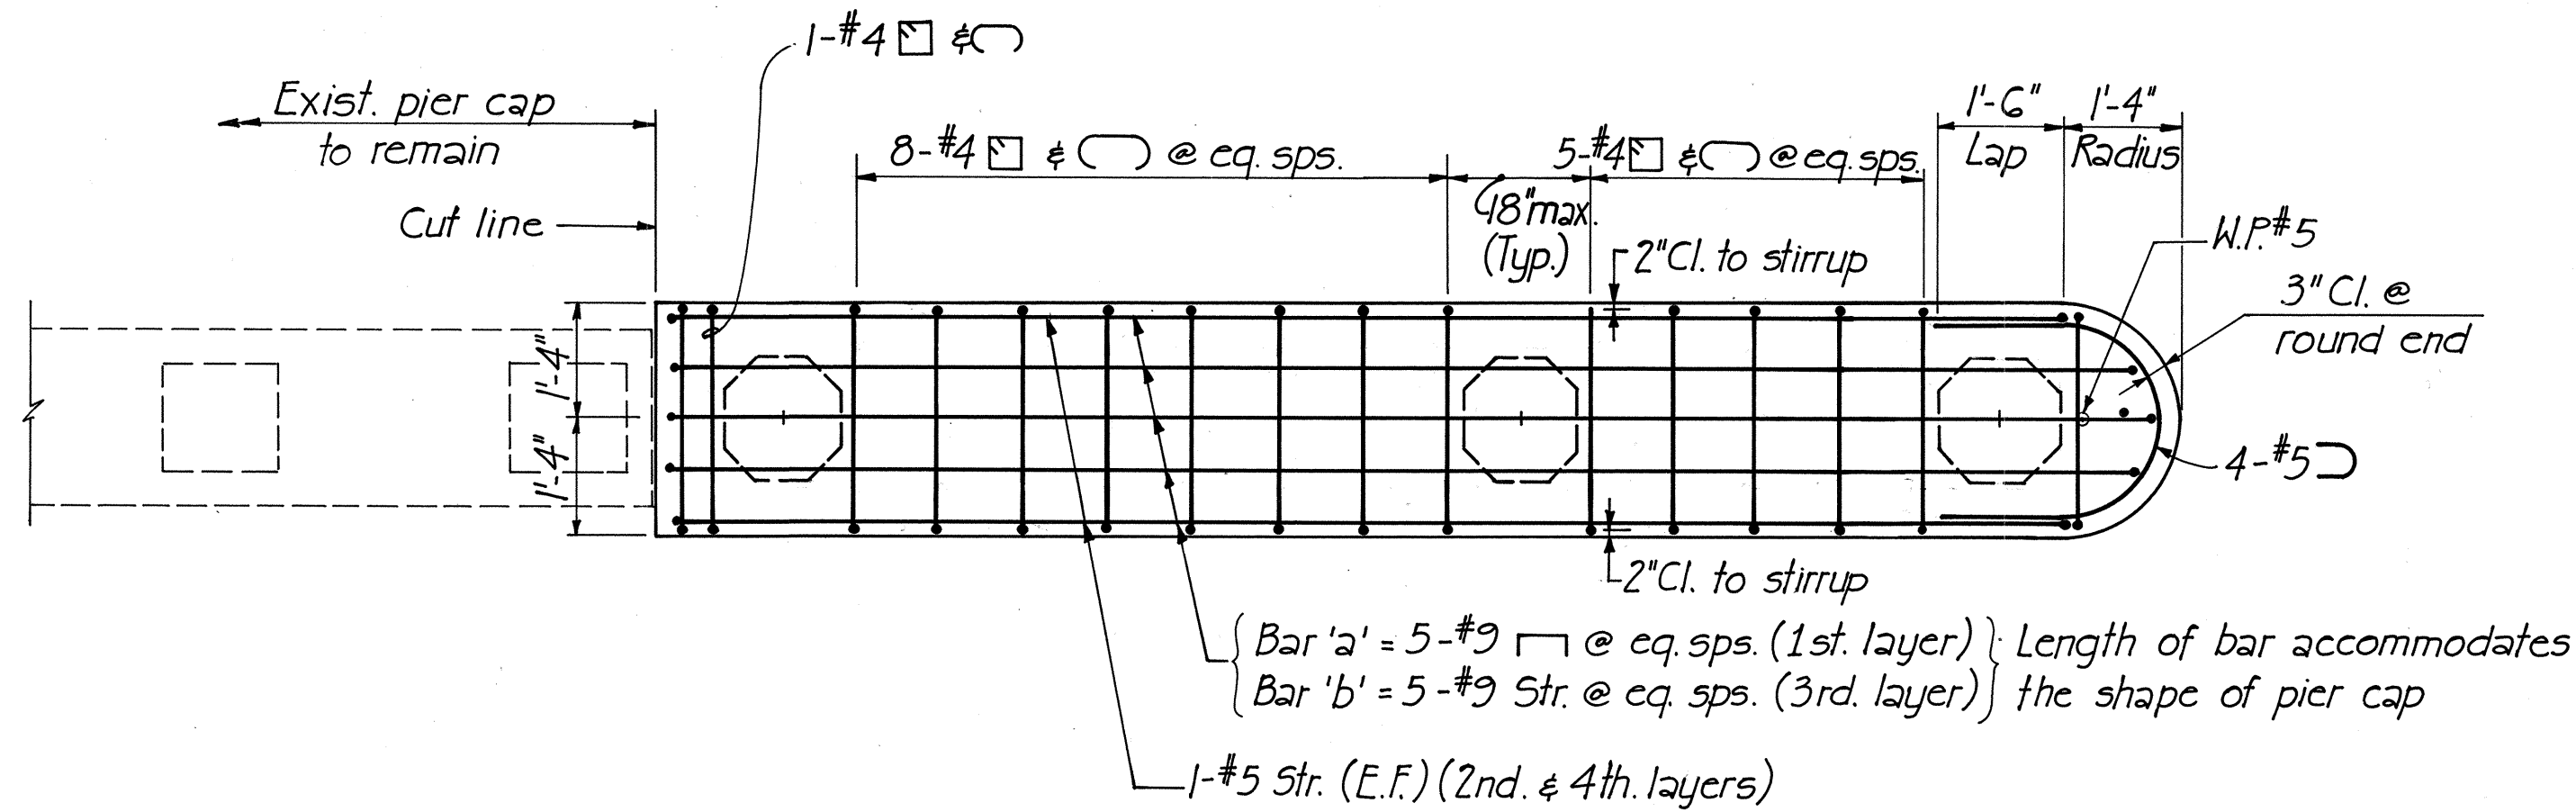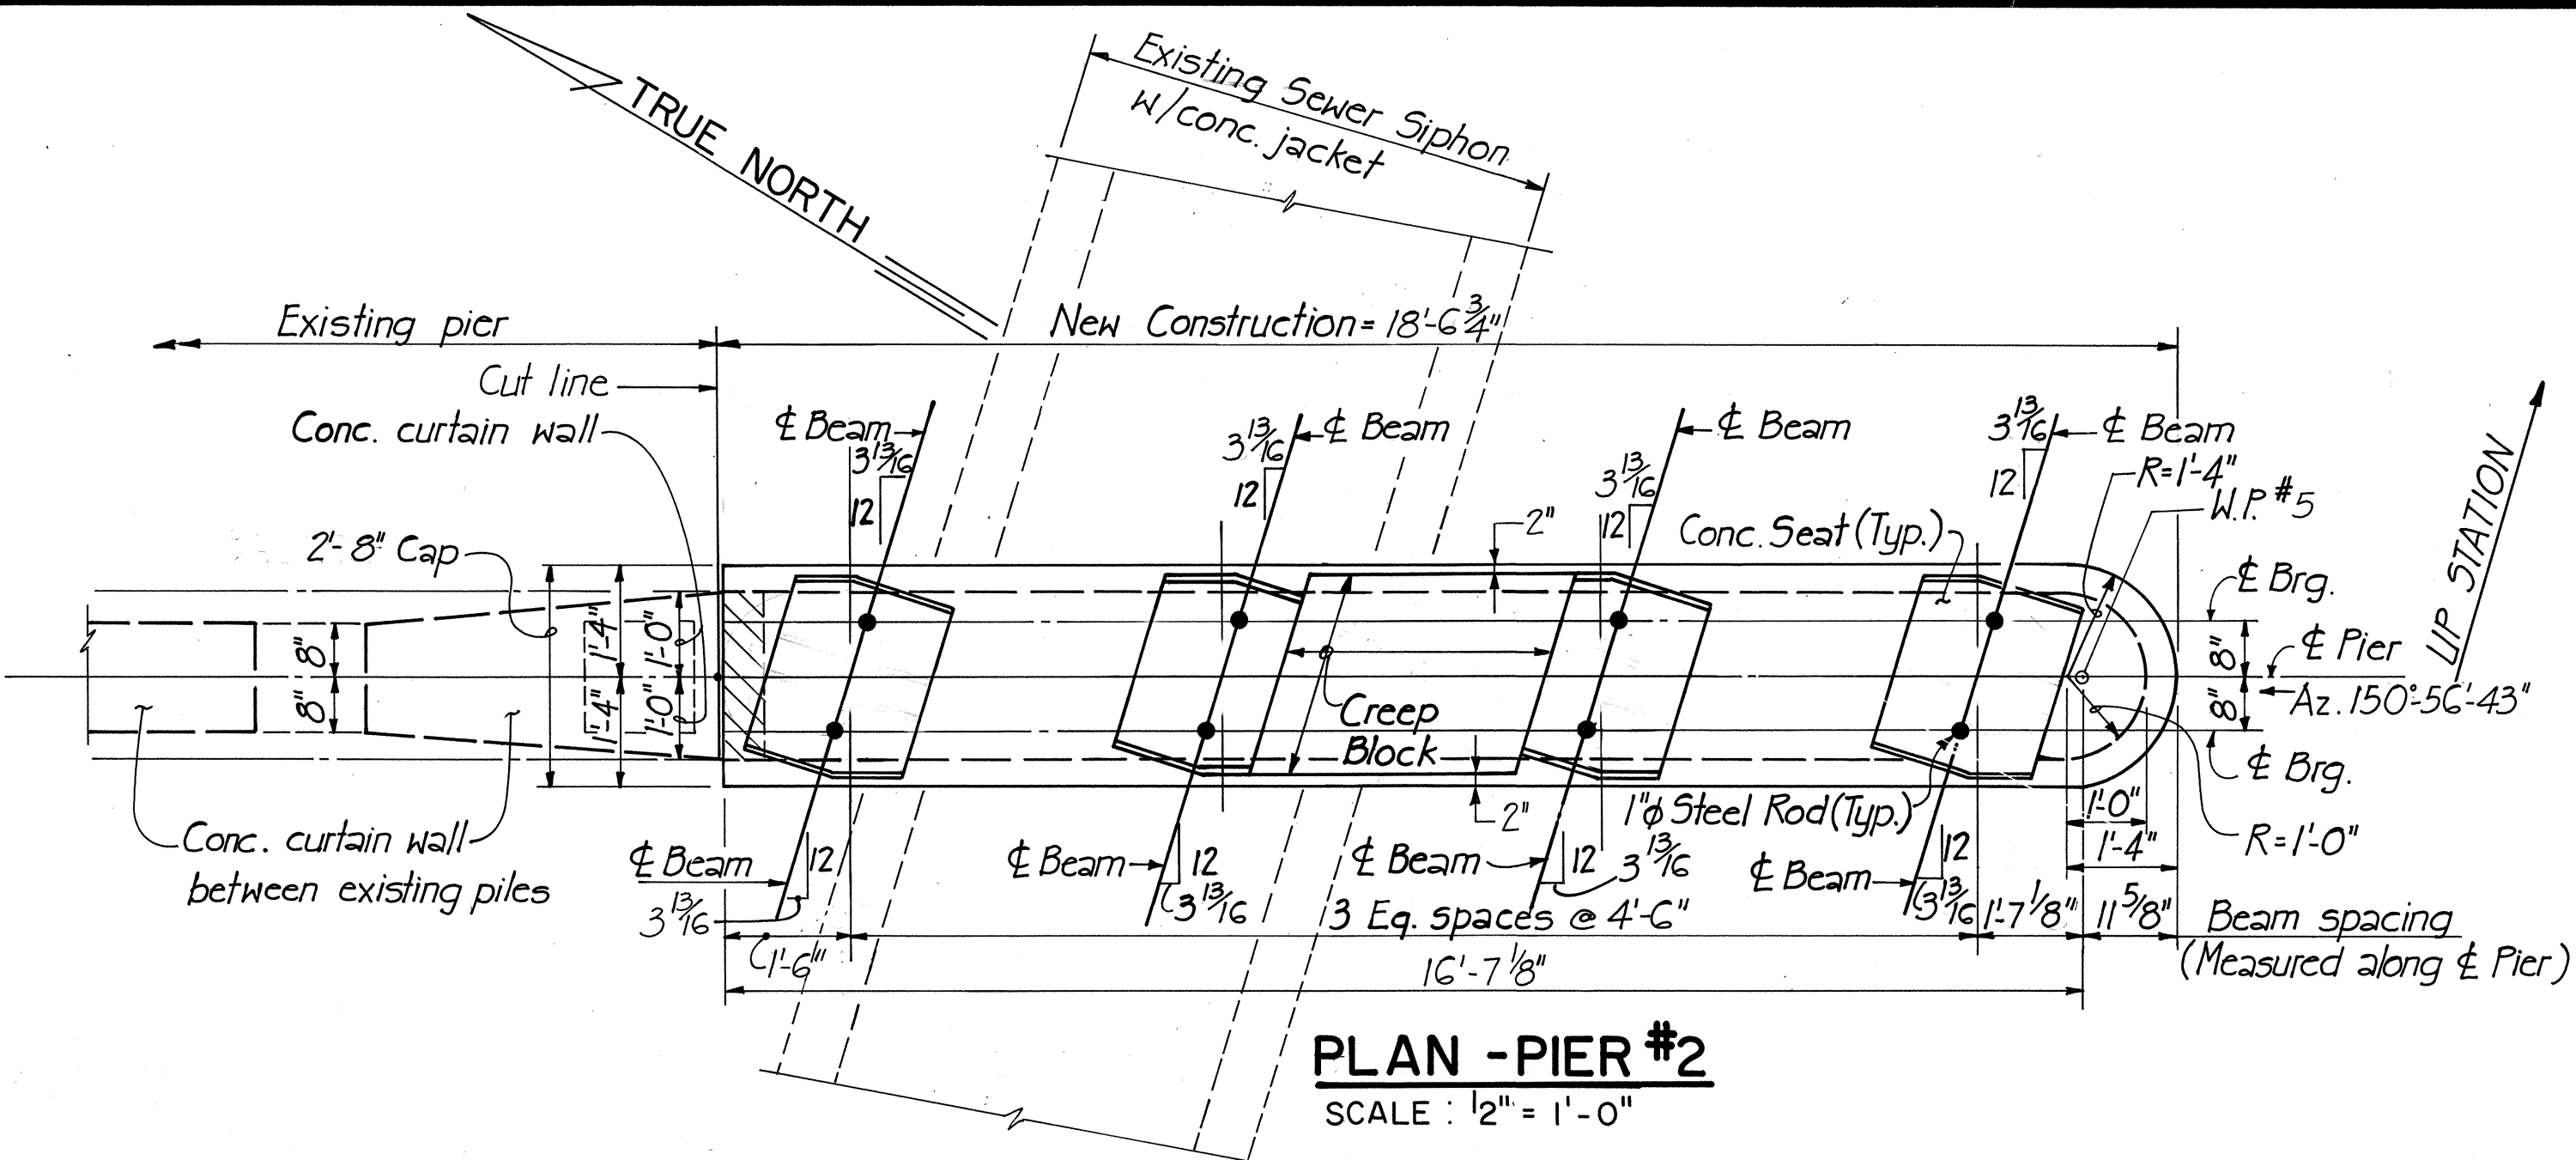

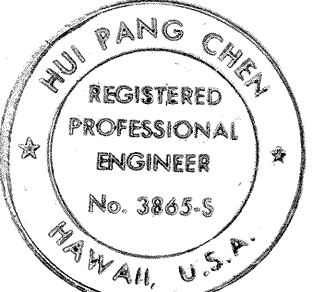

THIS WORK WAS PREPARED BY ME
OR UNDER MY SUPERVISION.
Hui Pang Chen

STATE OF HAWAII
DEPARTMENT OF TRANSPORTATION
HIGHWAYS DIVISION

WAILUPE STREAM BRIDGE WIDENING

PIER #2 DETAILS

KALANIANA'OLE HIGHWAY
Wailupe Circle to East Hind Drive
F.A. Project No. F-072-1(34)-A


SCALE: As shown DATE: JUNE 30, 1990
SHEET No. S-7 OF 19 SHEETS

SURVEY PLOTTED BY	DATE
DRAWN BY	
DESIGNED BY	
QUANTITIES BY	
CHECKED BY	
ORIGINAL PLAN	
NOTE BOOK	
No.	

FED. ROAD DIST. NO.	STATE	FED. AID PROJ. NO.	FISCAL YEAR	SHEET NO.	TOTAL SHEETS
HAWAII	HAW.	F-072-1(34)-A	1990	163	186

NOTES:

1. The Contractor shall verify the location and size of notch in footing to clear the new and the existing concrete jacket. In case the dimensions are different from that shown on the plans, the Contractor shall notify the Engineer immediately.
2. For concrete seat and creep block details see sheet No. S-11.
3. For 1" ϕ Steel Rod detail see Sheet No. S-15.

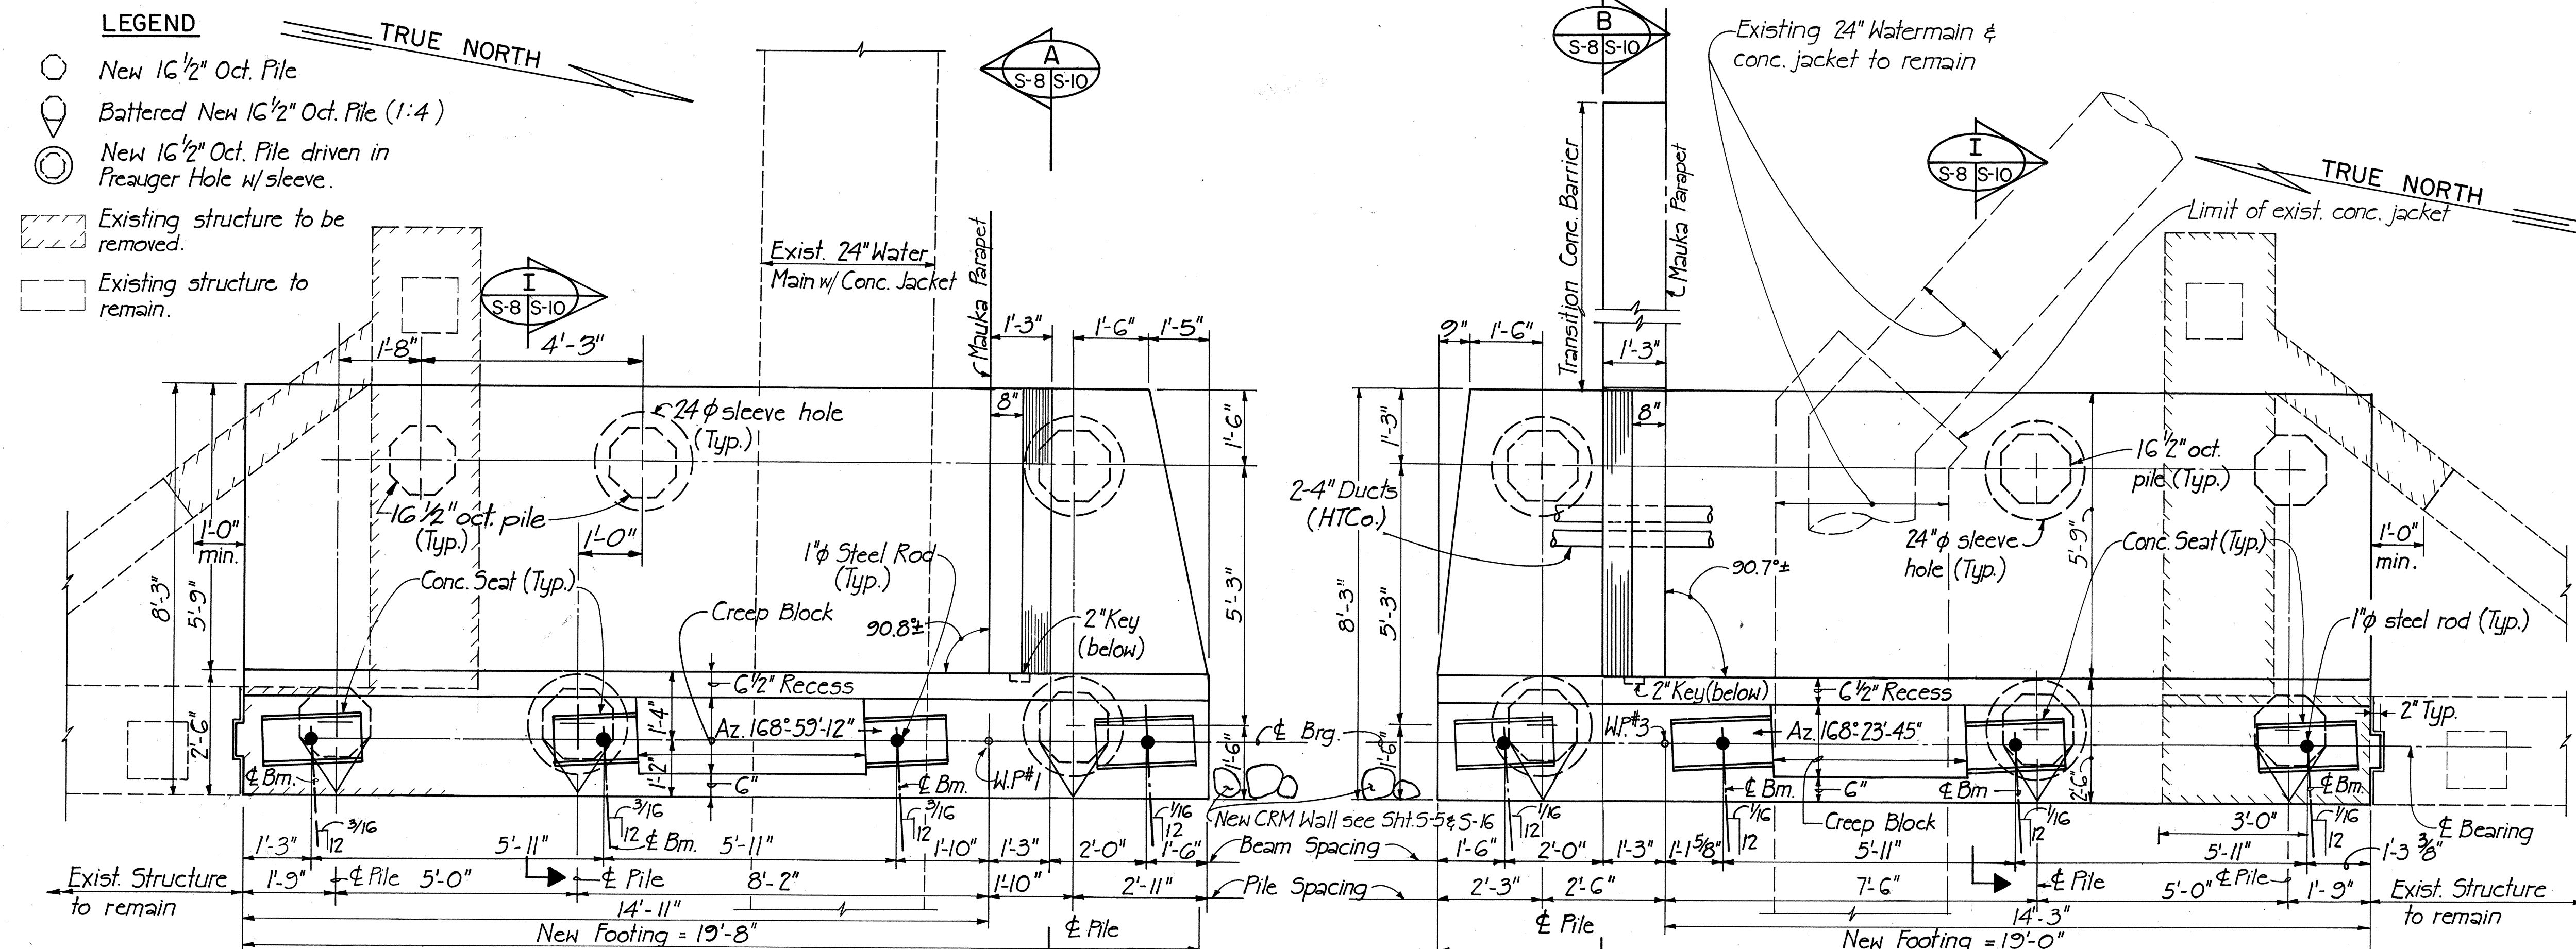

PLAN - ABUTMENT #1


SCALE: 1/2" = 1'-0"

PLAN - ABUTMENT #2

SCALE: 1/2" = 1'-0"

NOTE 'A':

Two layers of 55# comp. roofing paper between structures.

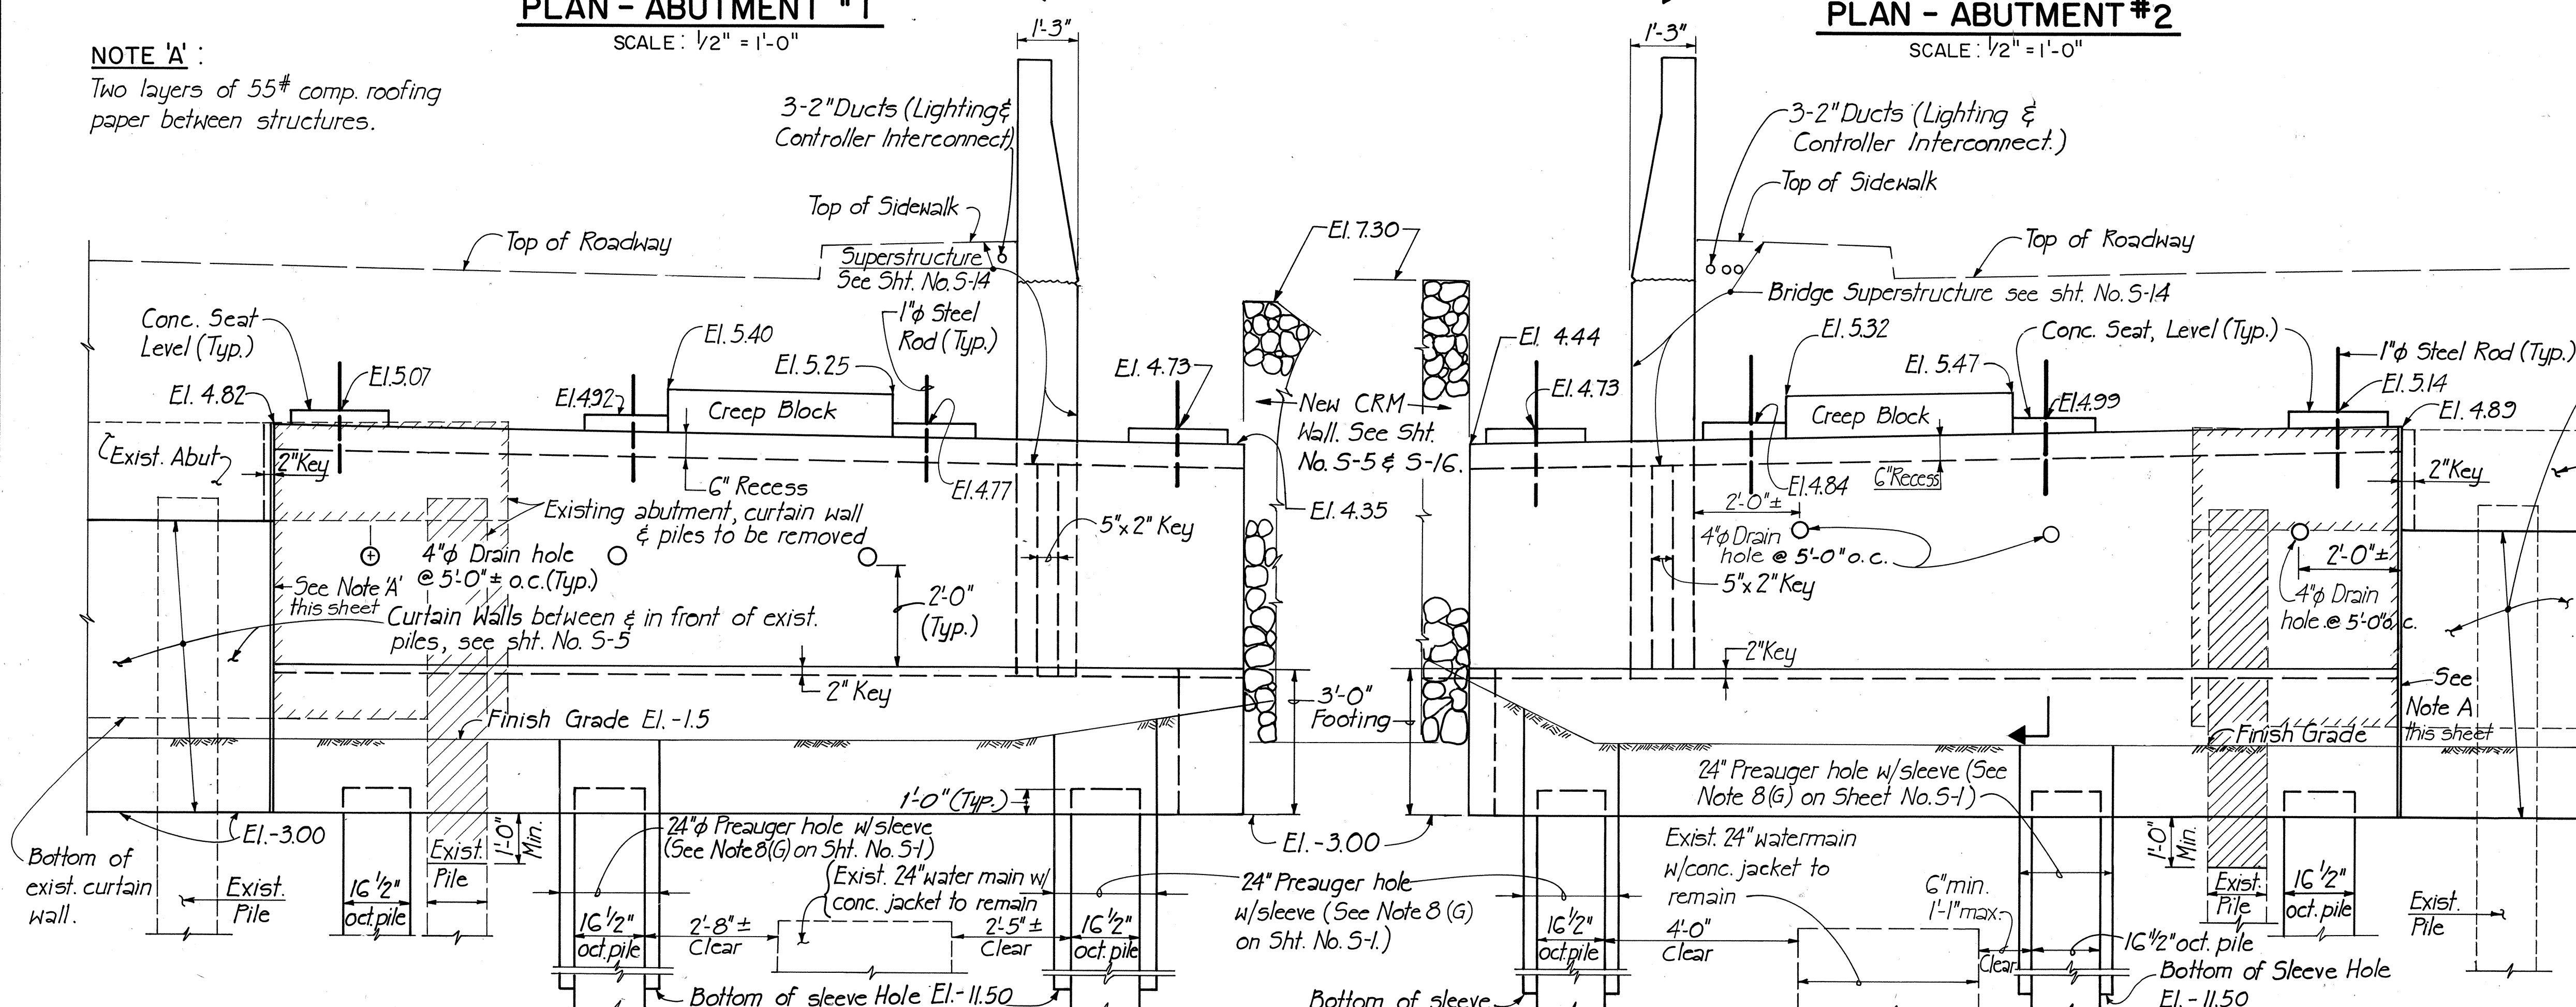

ELEVATION - ABUTMENT #1

SCALE: 1/2" = 1'-0"

ELEVATION - ABUTMENT #2

SCALE: 1/2" = 1'-0"

2/10/91 Revised Legend of Battered Pile. Revised Plans and Elevations of Abut. #1 & Abut. #2 to add 24" Water Line.

DATE REVISIONS

STATE OF HAWAII
DEPARTMENT OF TRANSPORTATION
HIGHWAYS DIVISION
WAILUPE STREAM BRIDGE WIDENING

ABUTMENTS #1 AND #2
DETAILS


KALANIANA'OLE HIGHWAY
Wailupe Circle to East Hind Drive
FA Project No. F-072-1(34)-A

SCALE: As shown DATE: JUNE 30, 1990

SHEET No. S-8 OF 19 SHEETS


C.O.163

FED. ROAD DIST. NO.	STATE	FED. AID PROJ. NO.	FISCAL YEAR	SHEET NO.	TOTAL SHEETS
HAWAII	HAW.	F-072-1(34)-A	1990	164	186

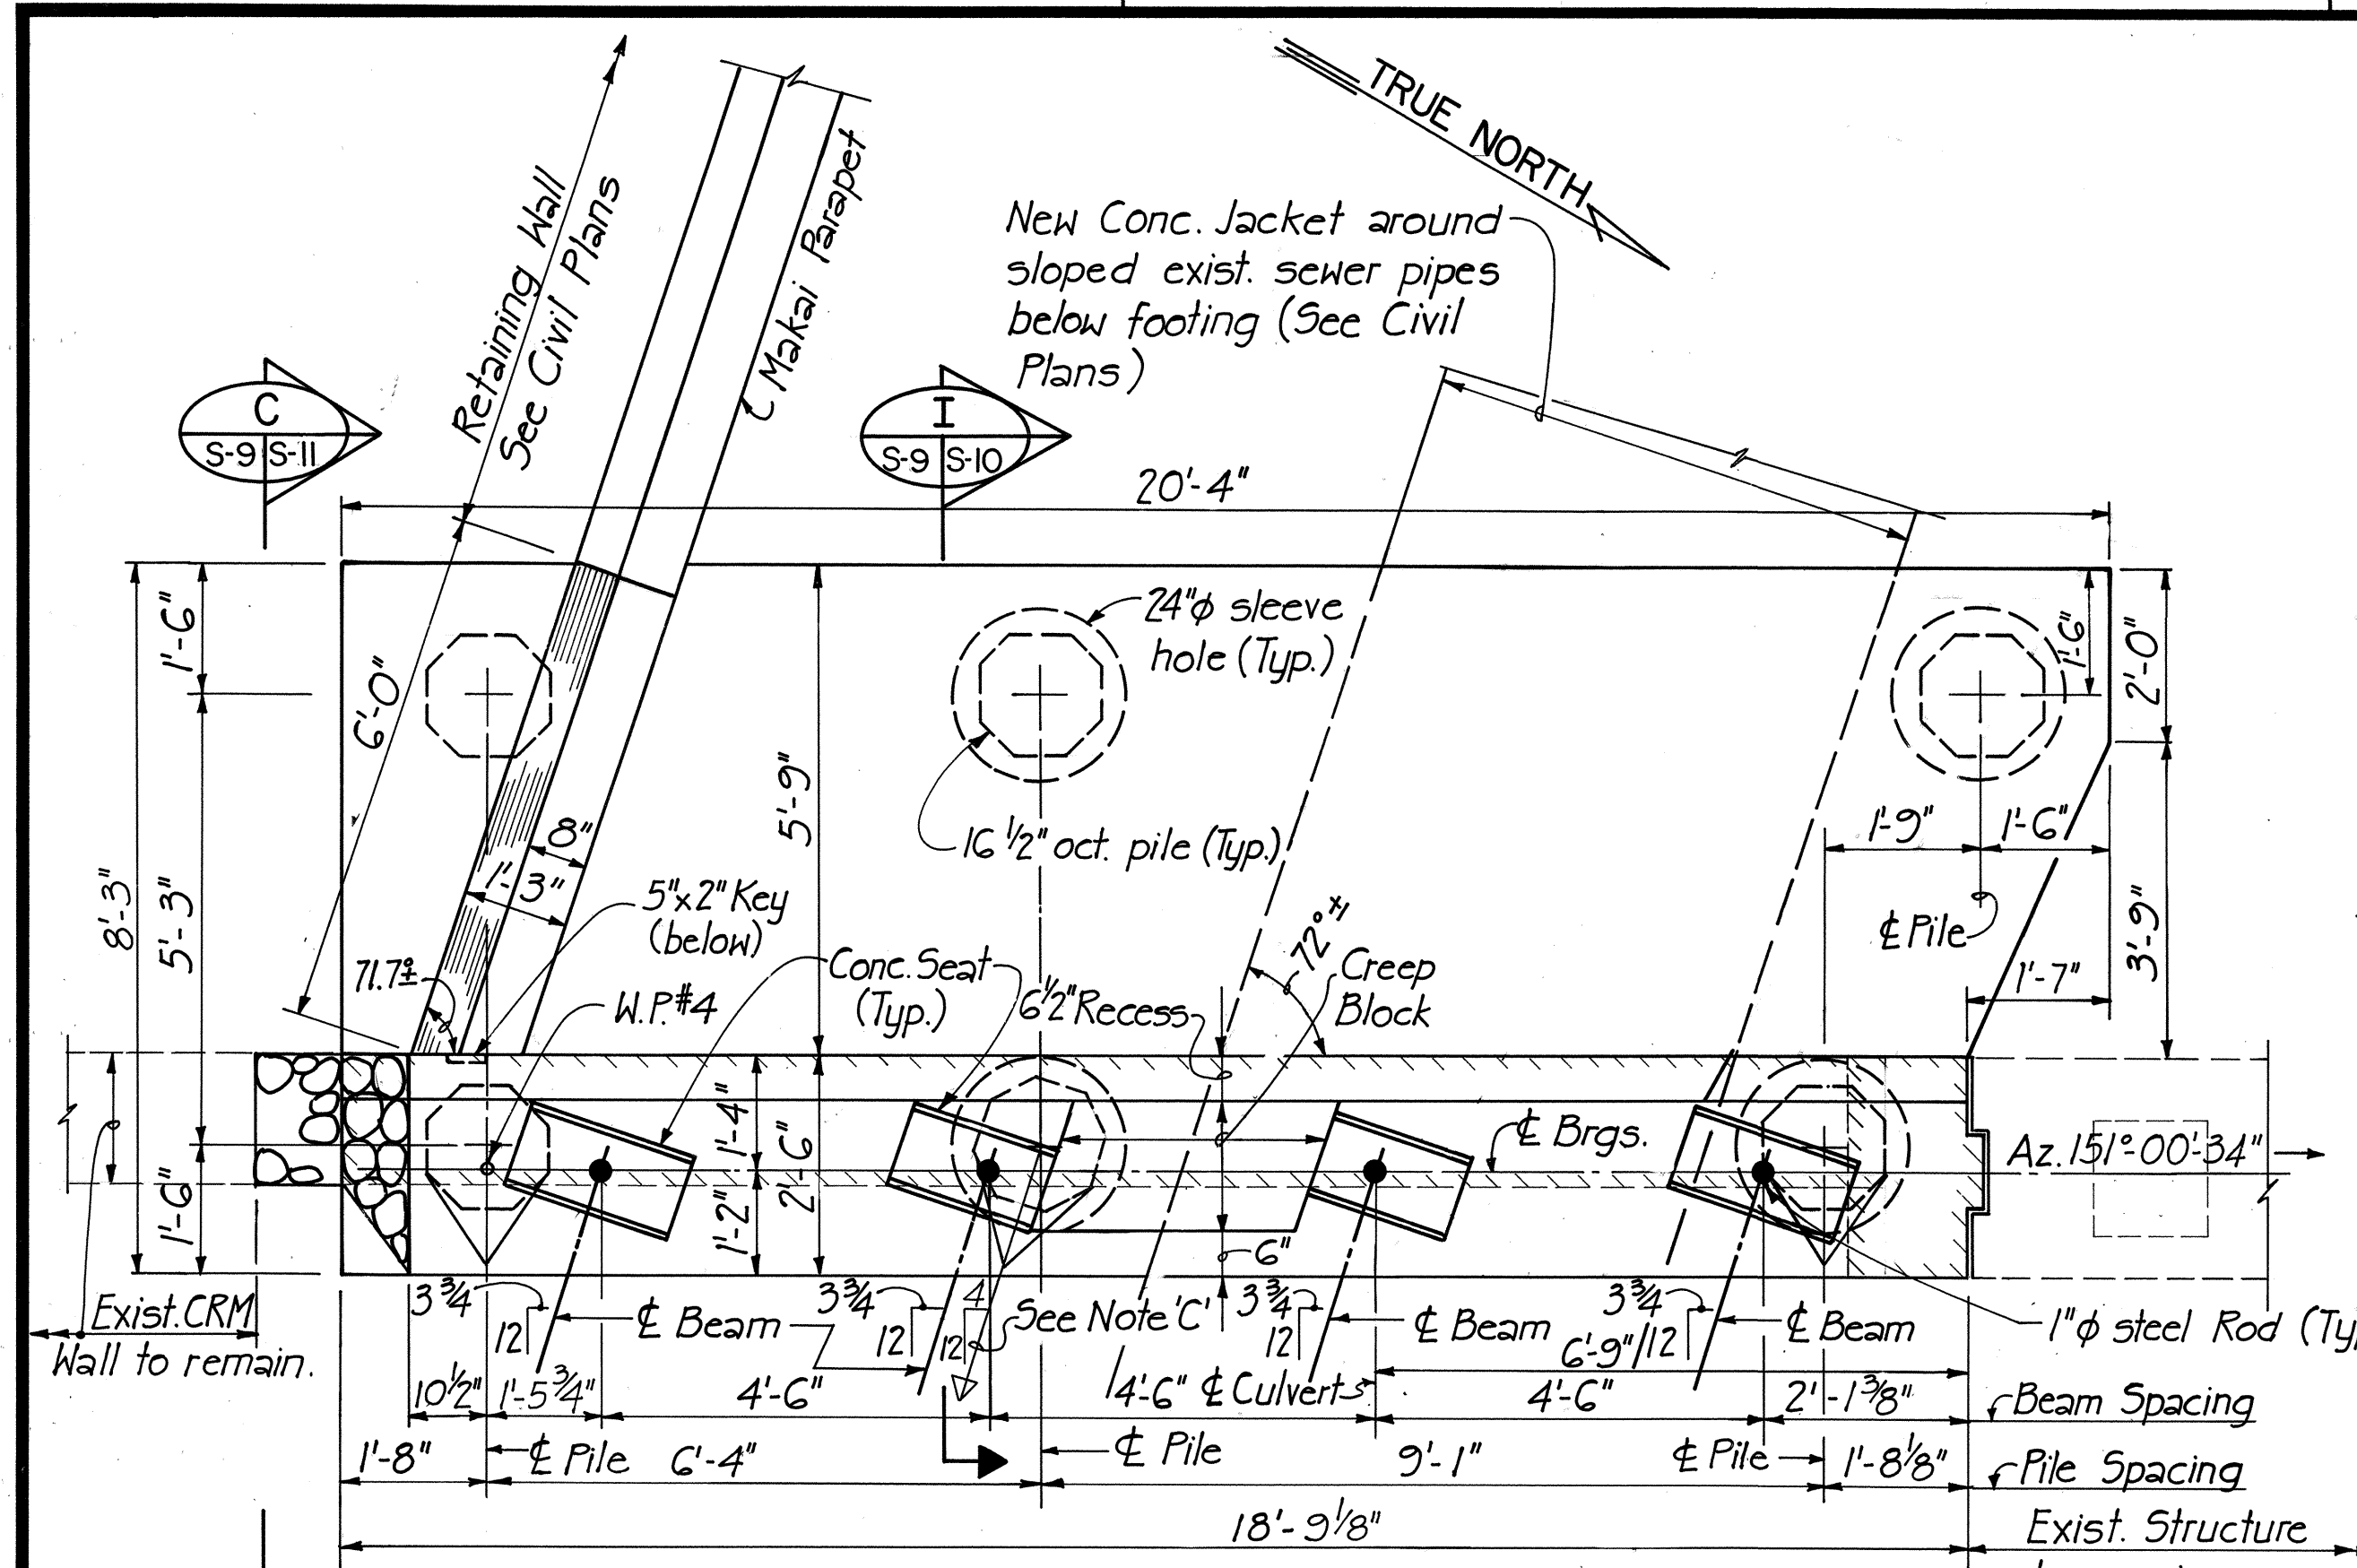

PLAN - ABUTMENT #3
SCALE: 1/2" = 1'-0"

NOTE 'C':
This pile to be driven in a sleeve on a batter of 1 horizontal to 4 vertical. Battered piles shall be aligned parallel to sewer pipes.

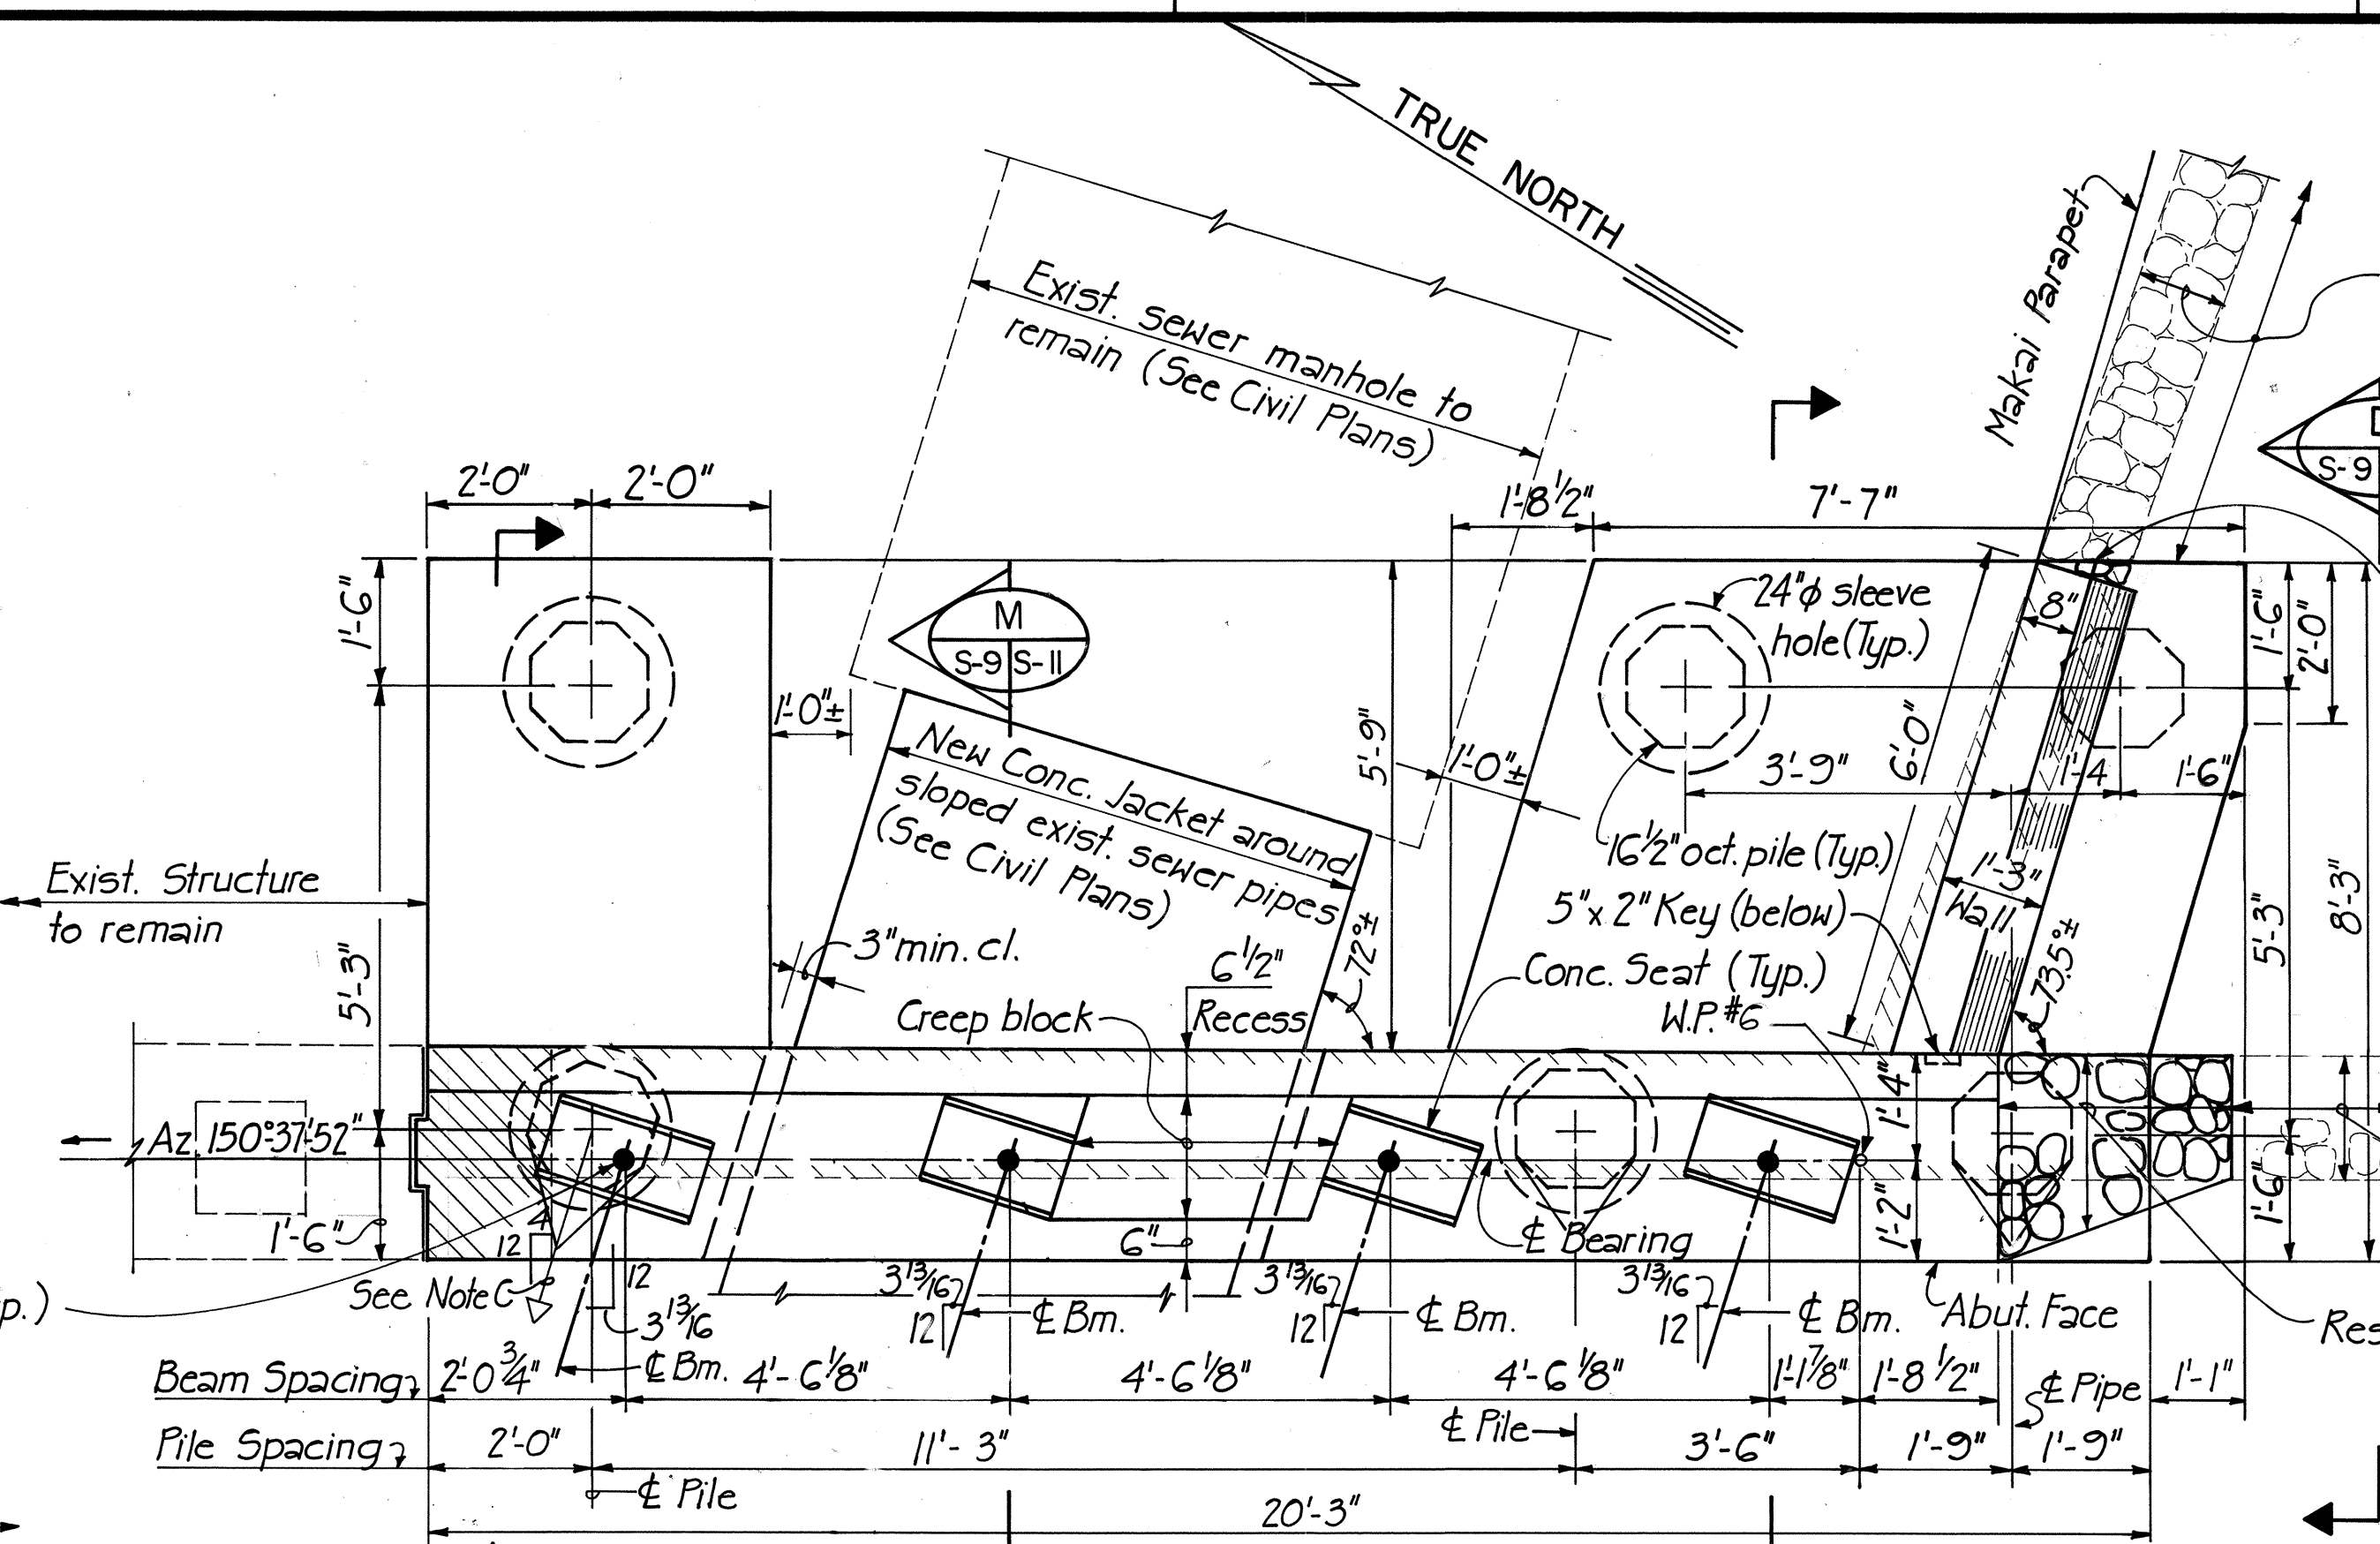


PLAN - ABUTMENT #4
SCALE: 1/2" = 1'-0"

NOTE 'B':
Where the existing wall needs to be removed for new footing or wall construction, the contractor shall restore the removed portion to match the existing wall. Payment will be made under "Cement Rubble Masonry".


Restore Stone Wall to match existing (Payment incidental to various contract items)

Restore CRM wall to match existing.

Exist. CRM and stone walls to remain (See Note 'B' this sheet)

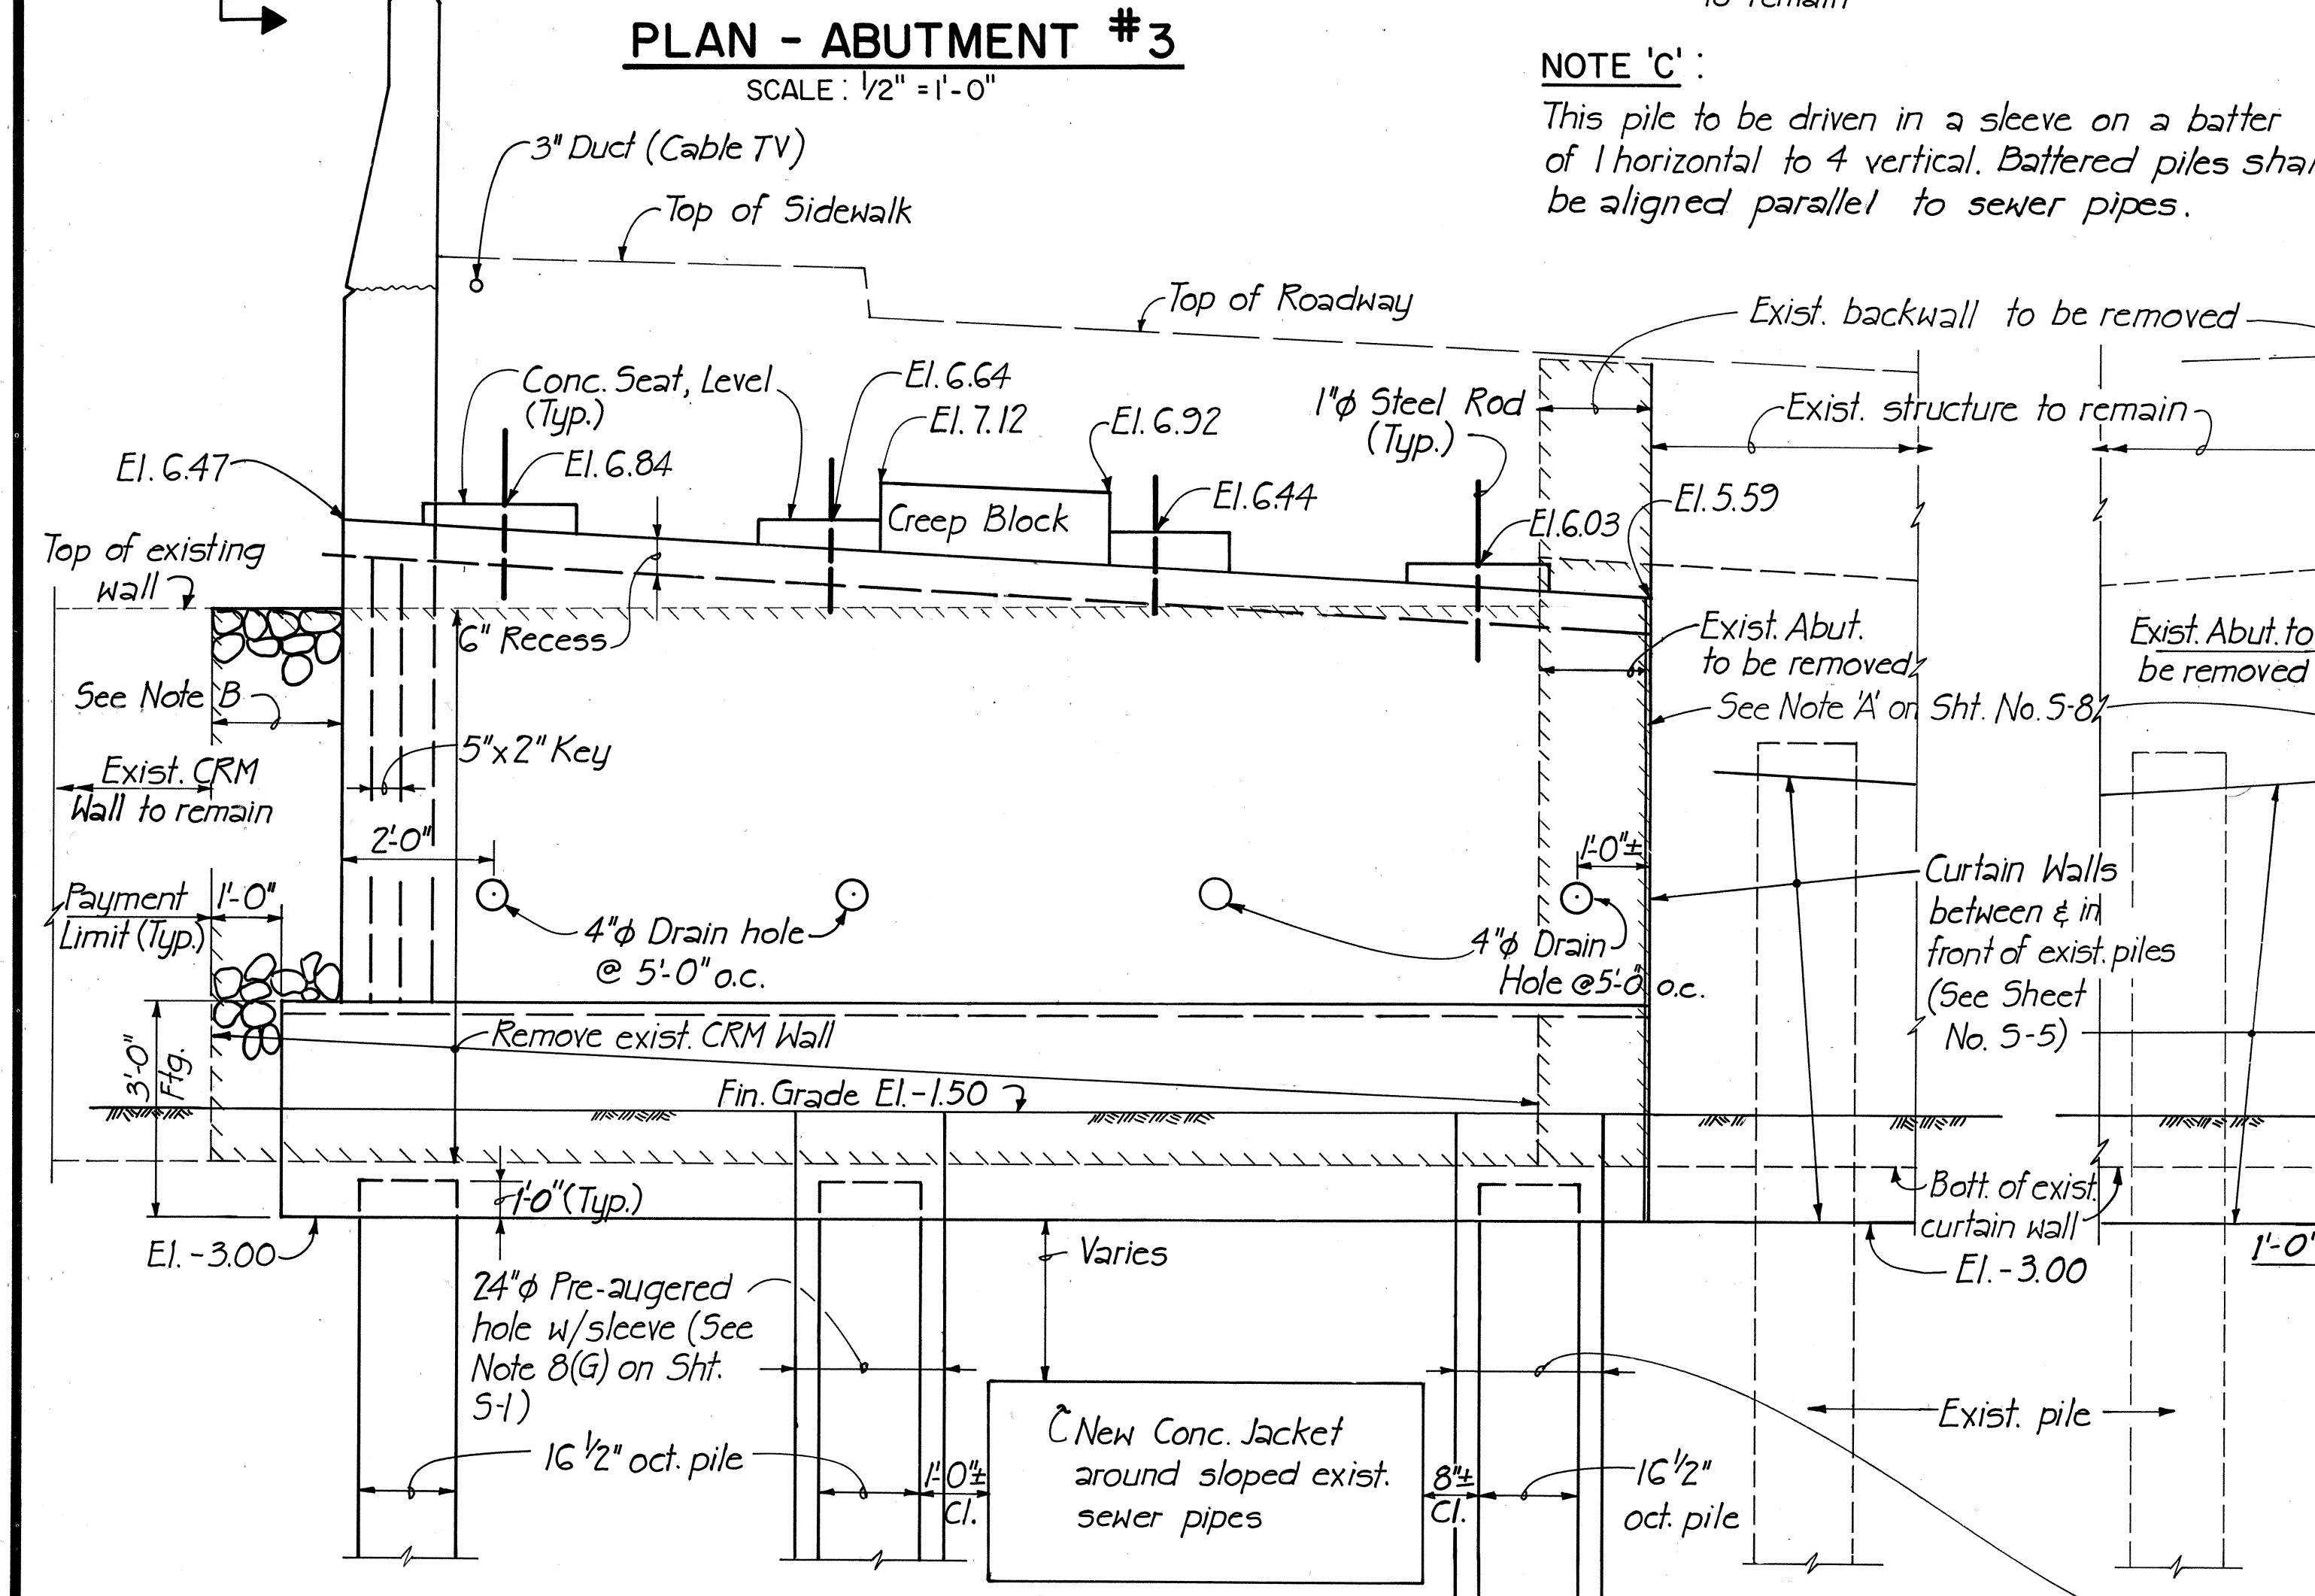


ELEVATION - ABUTMENT #3
SCALE: 1/2" = 1'-0"

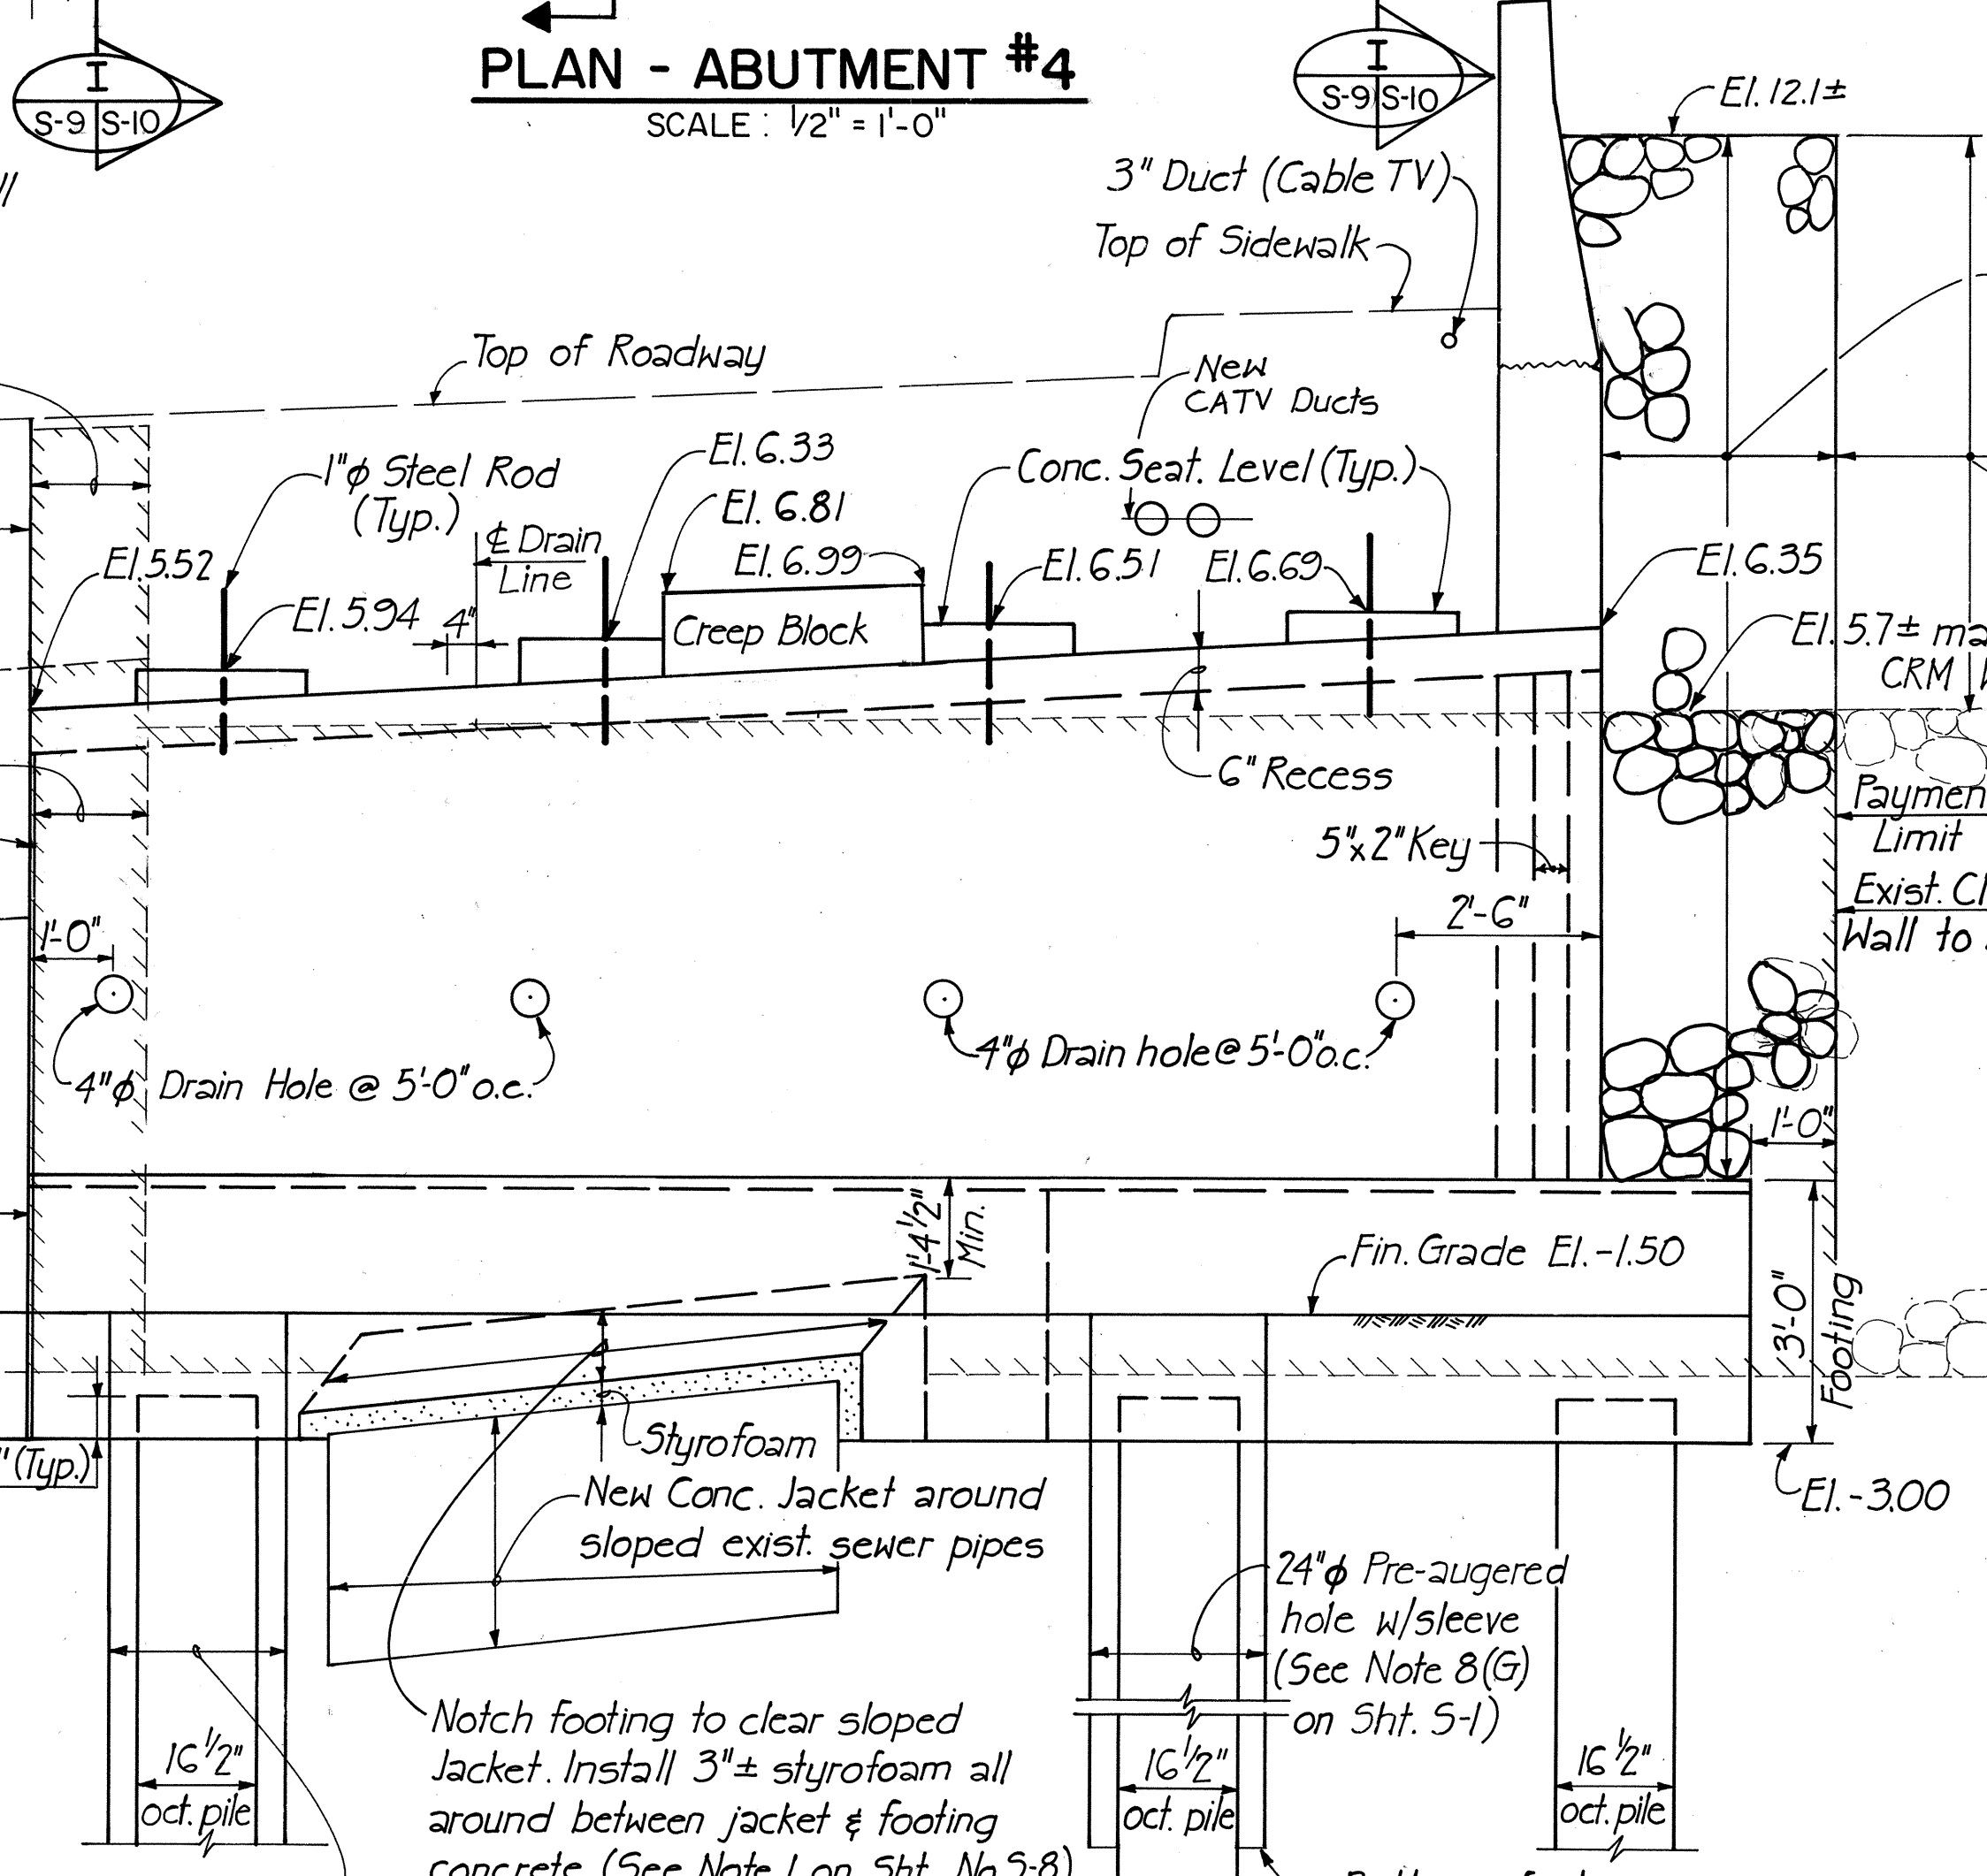

ELEVATION - ABUTMENT #4
SCALE: 1/2" = 1'-0"

- NOTES:**
- See Notes 1, 2 & 3 on Sheet No. 5-8
 - See Legend on Sheet No. 5-8

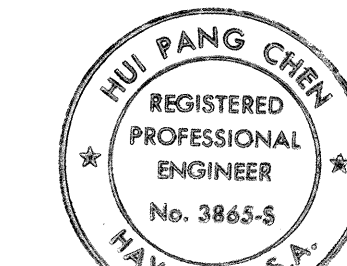


THIS WORK WAS PREPARED BY ME OR UNDER MY SUPERVISION.

Hui Pang Chen



STATE OF HAWAII
DEPARTMENT OF TRANSPORTATION
HIGHWAYS DIVISION
WAILUPE STREAM BRIDGE WIDENING
ABUTMENTS
#3 AND #4 DETAILS
KALANIANA'OLE HIGHWAY
Wailupe Circle to East Hind Drive
FA Project No. F-072-1(34)-A
SCALE: As shown DATE: JUNE 30, 1990
SHEET No. S-9 OF 19 SHEETS

FED. ROAD DIST. NO.	STATE	FED. AID PROJ. NO.	FISCAL YEAR	SHEET NO.	TOTAL SHEETS
HAWAII	HAW.	F-072-1(34)-A	1990	166	186

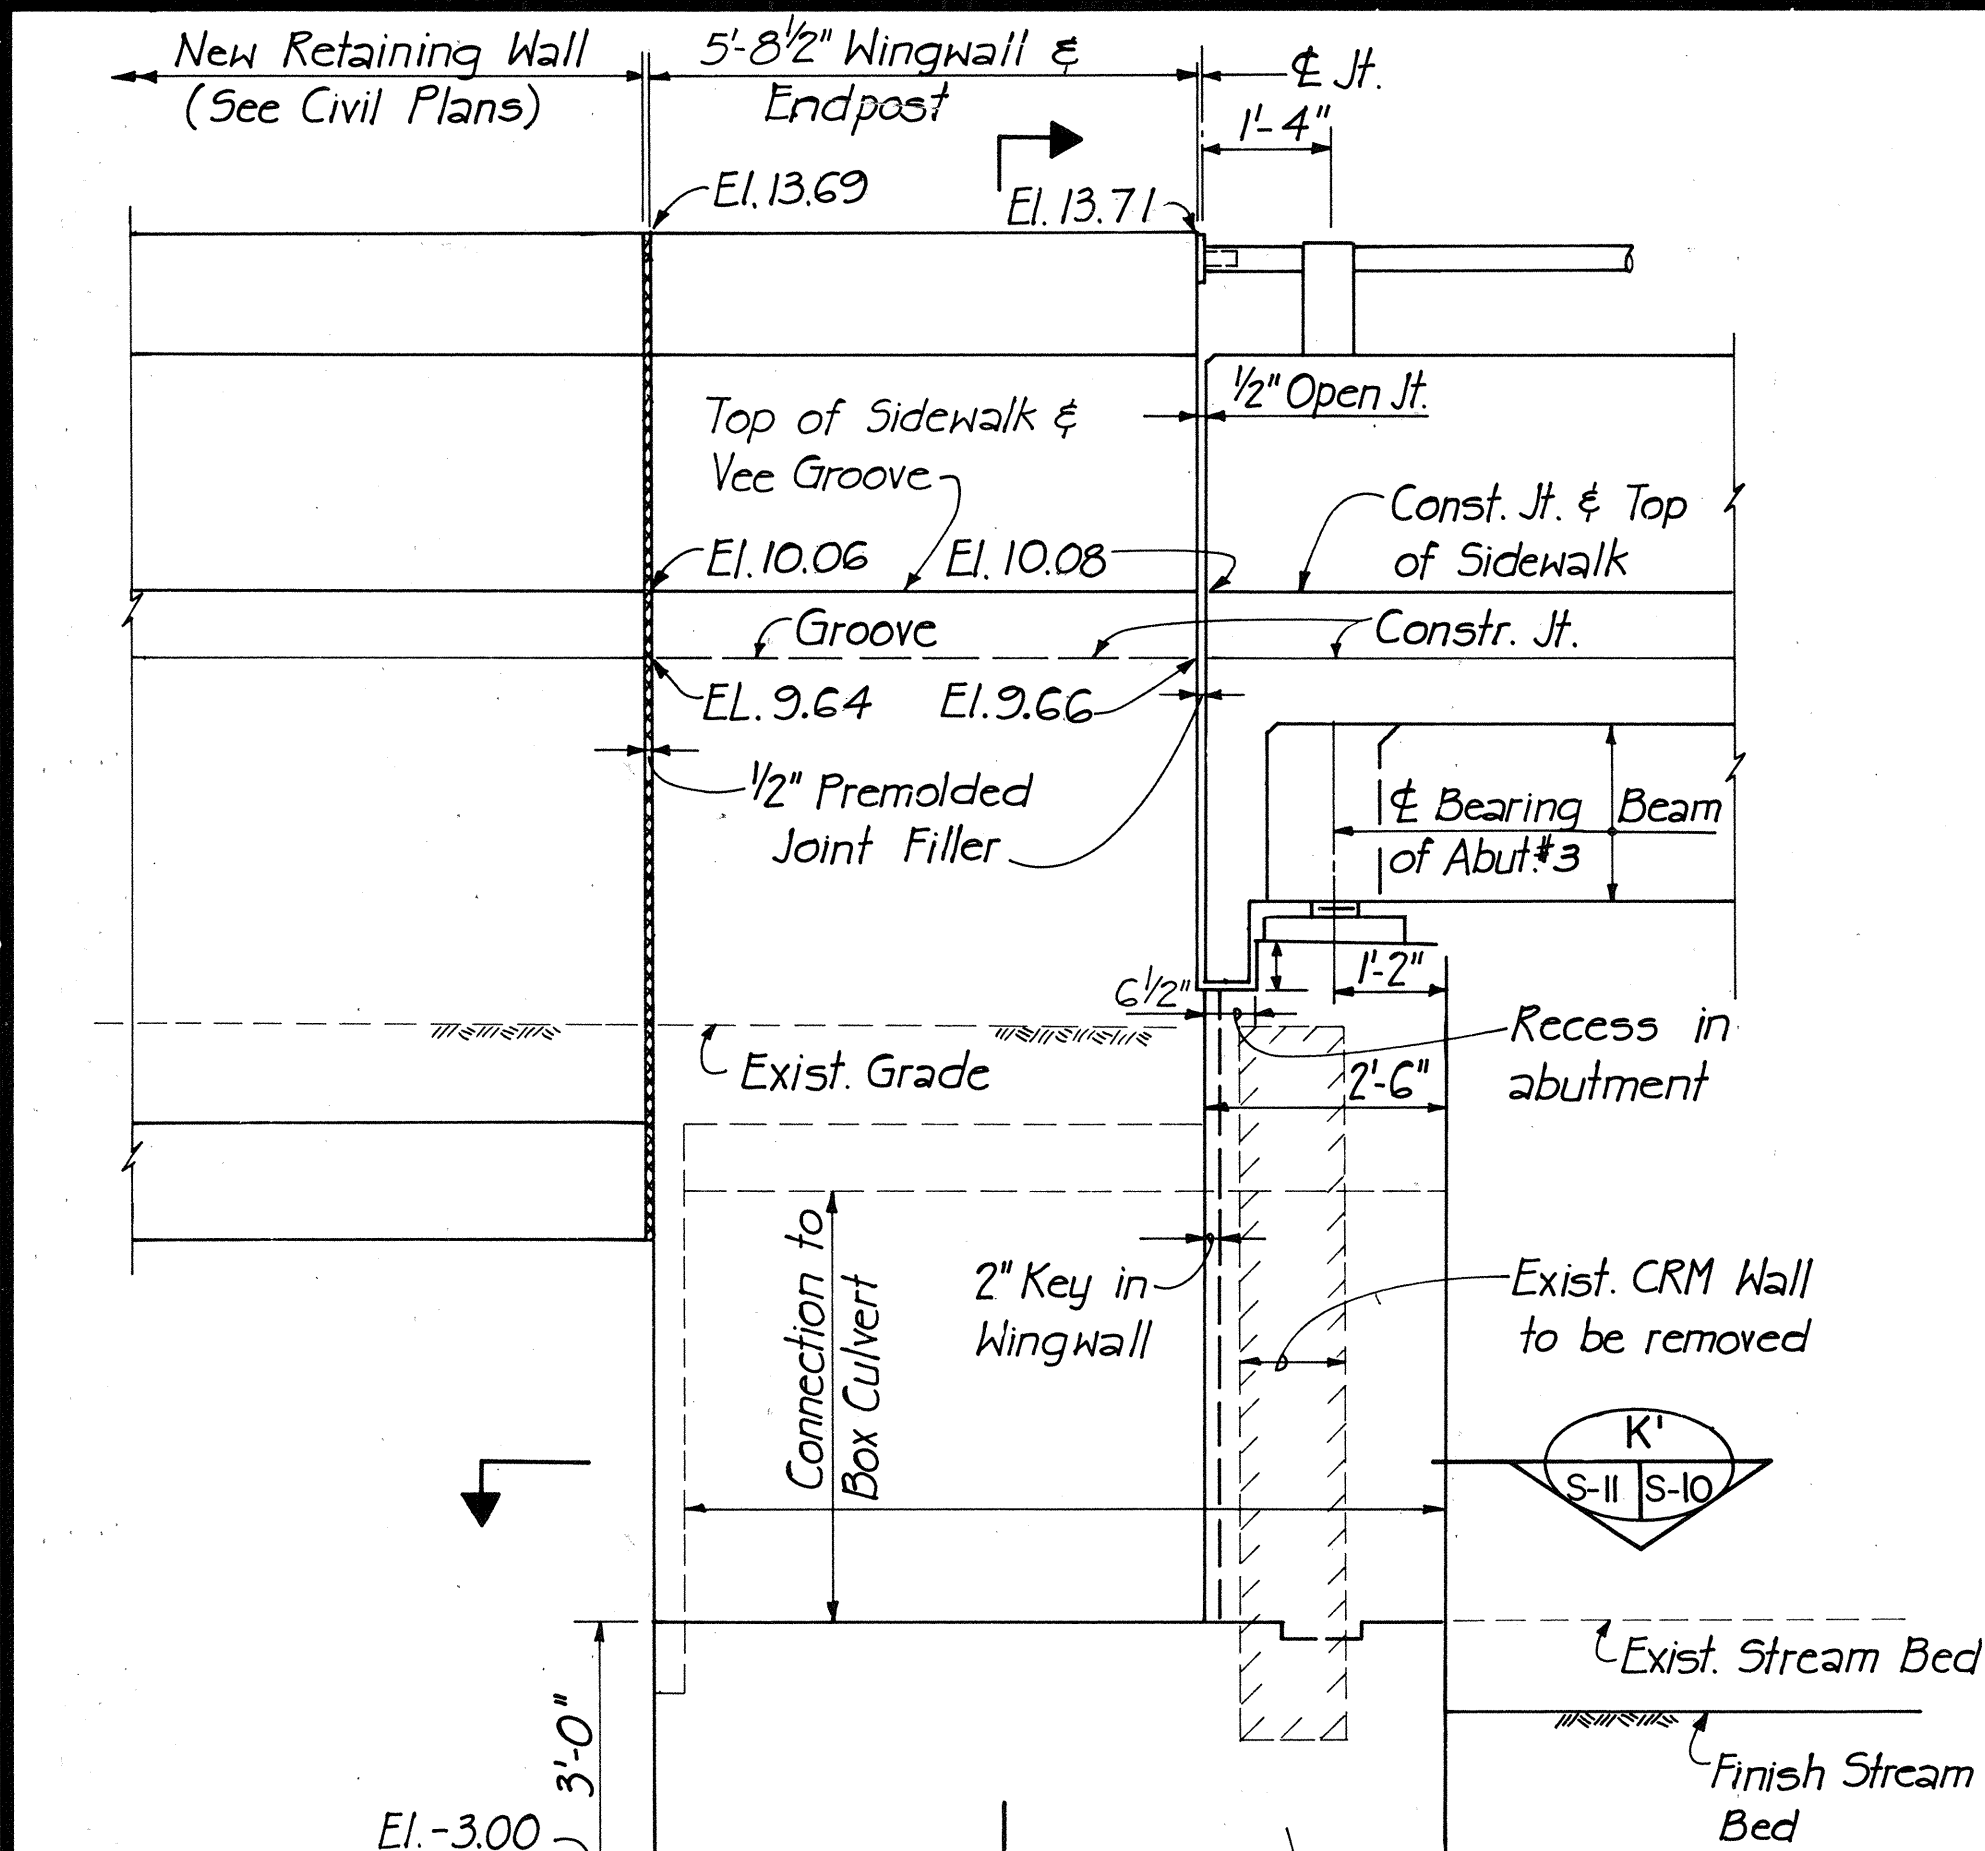


NOTE 'A'
The cross hatch areas denote the payment limits of structure excavation.


NOTE 'B'
Impervious material as selected by the Engineer shall be incidental to structure backfill. The subgrade upon which filter material is to be placed shall be made impervious as possible by pneumatic tamping or other approved methods.

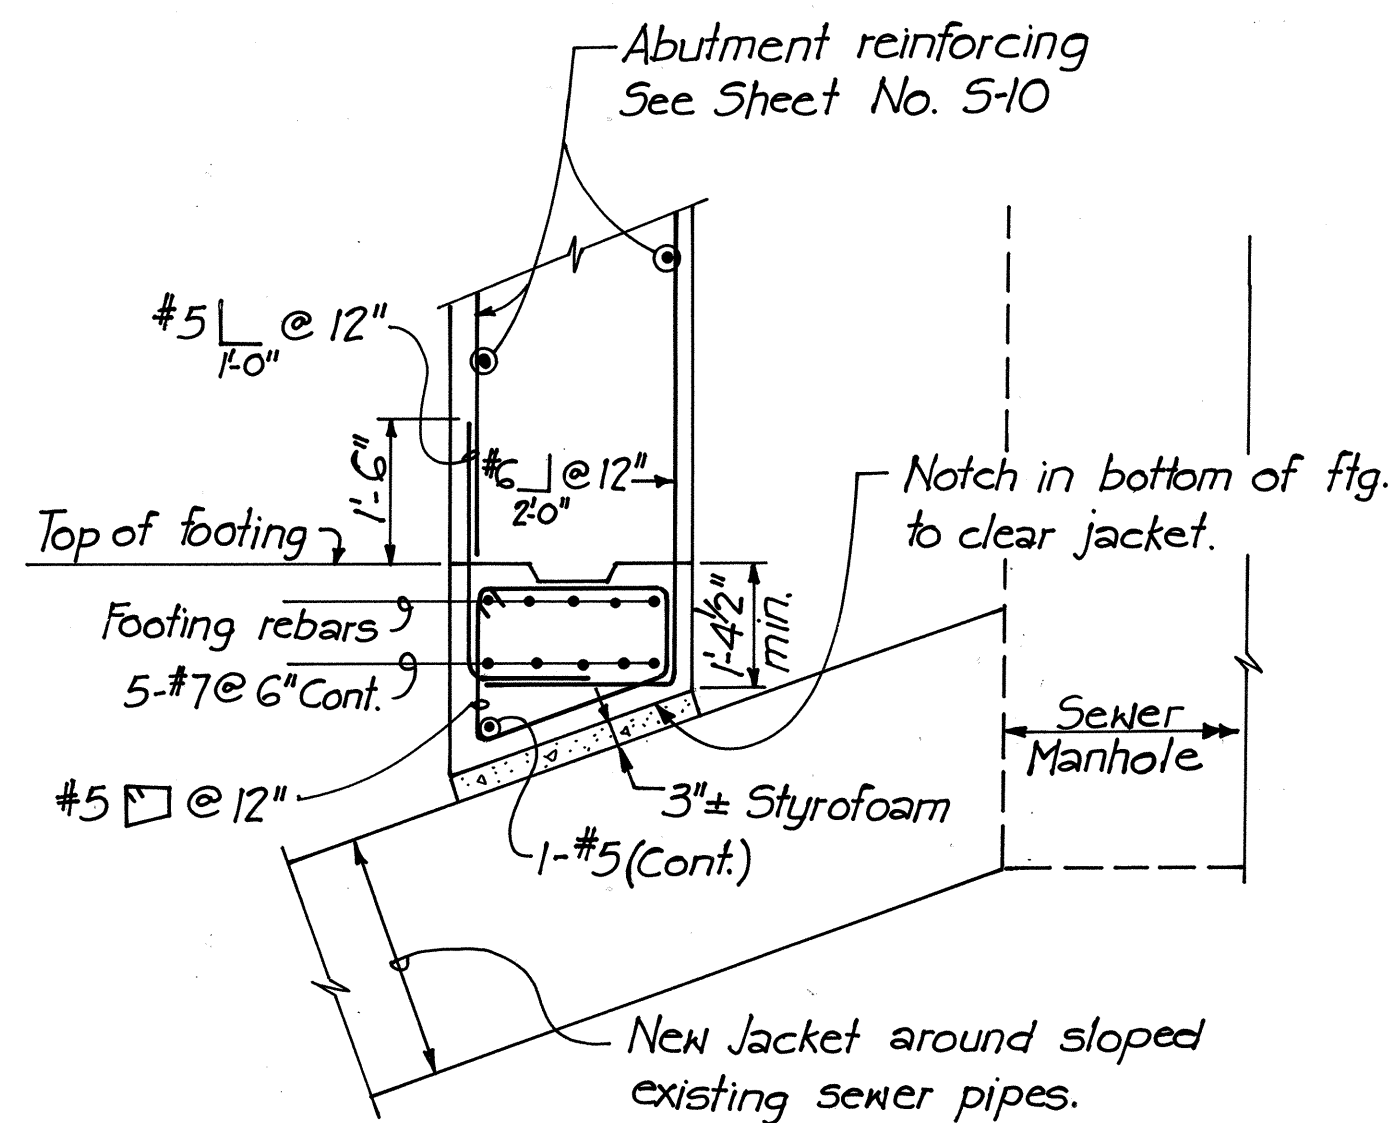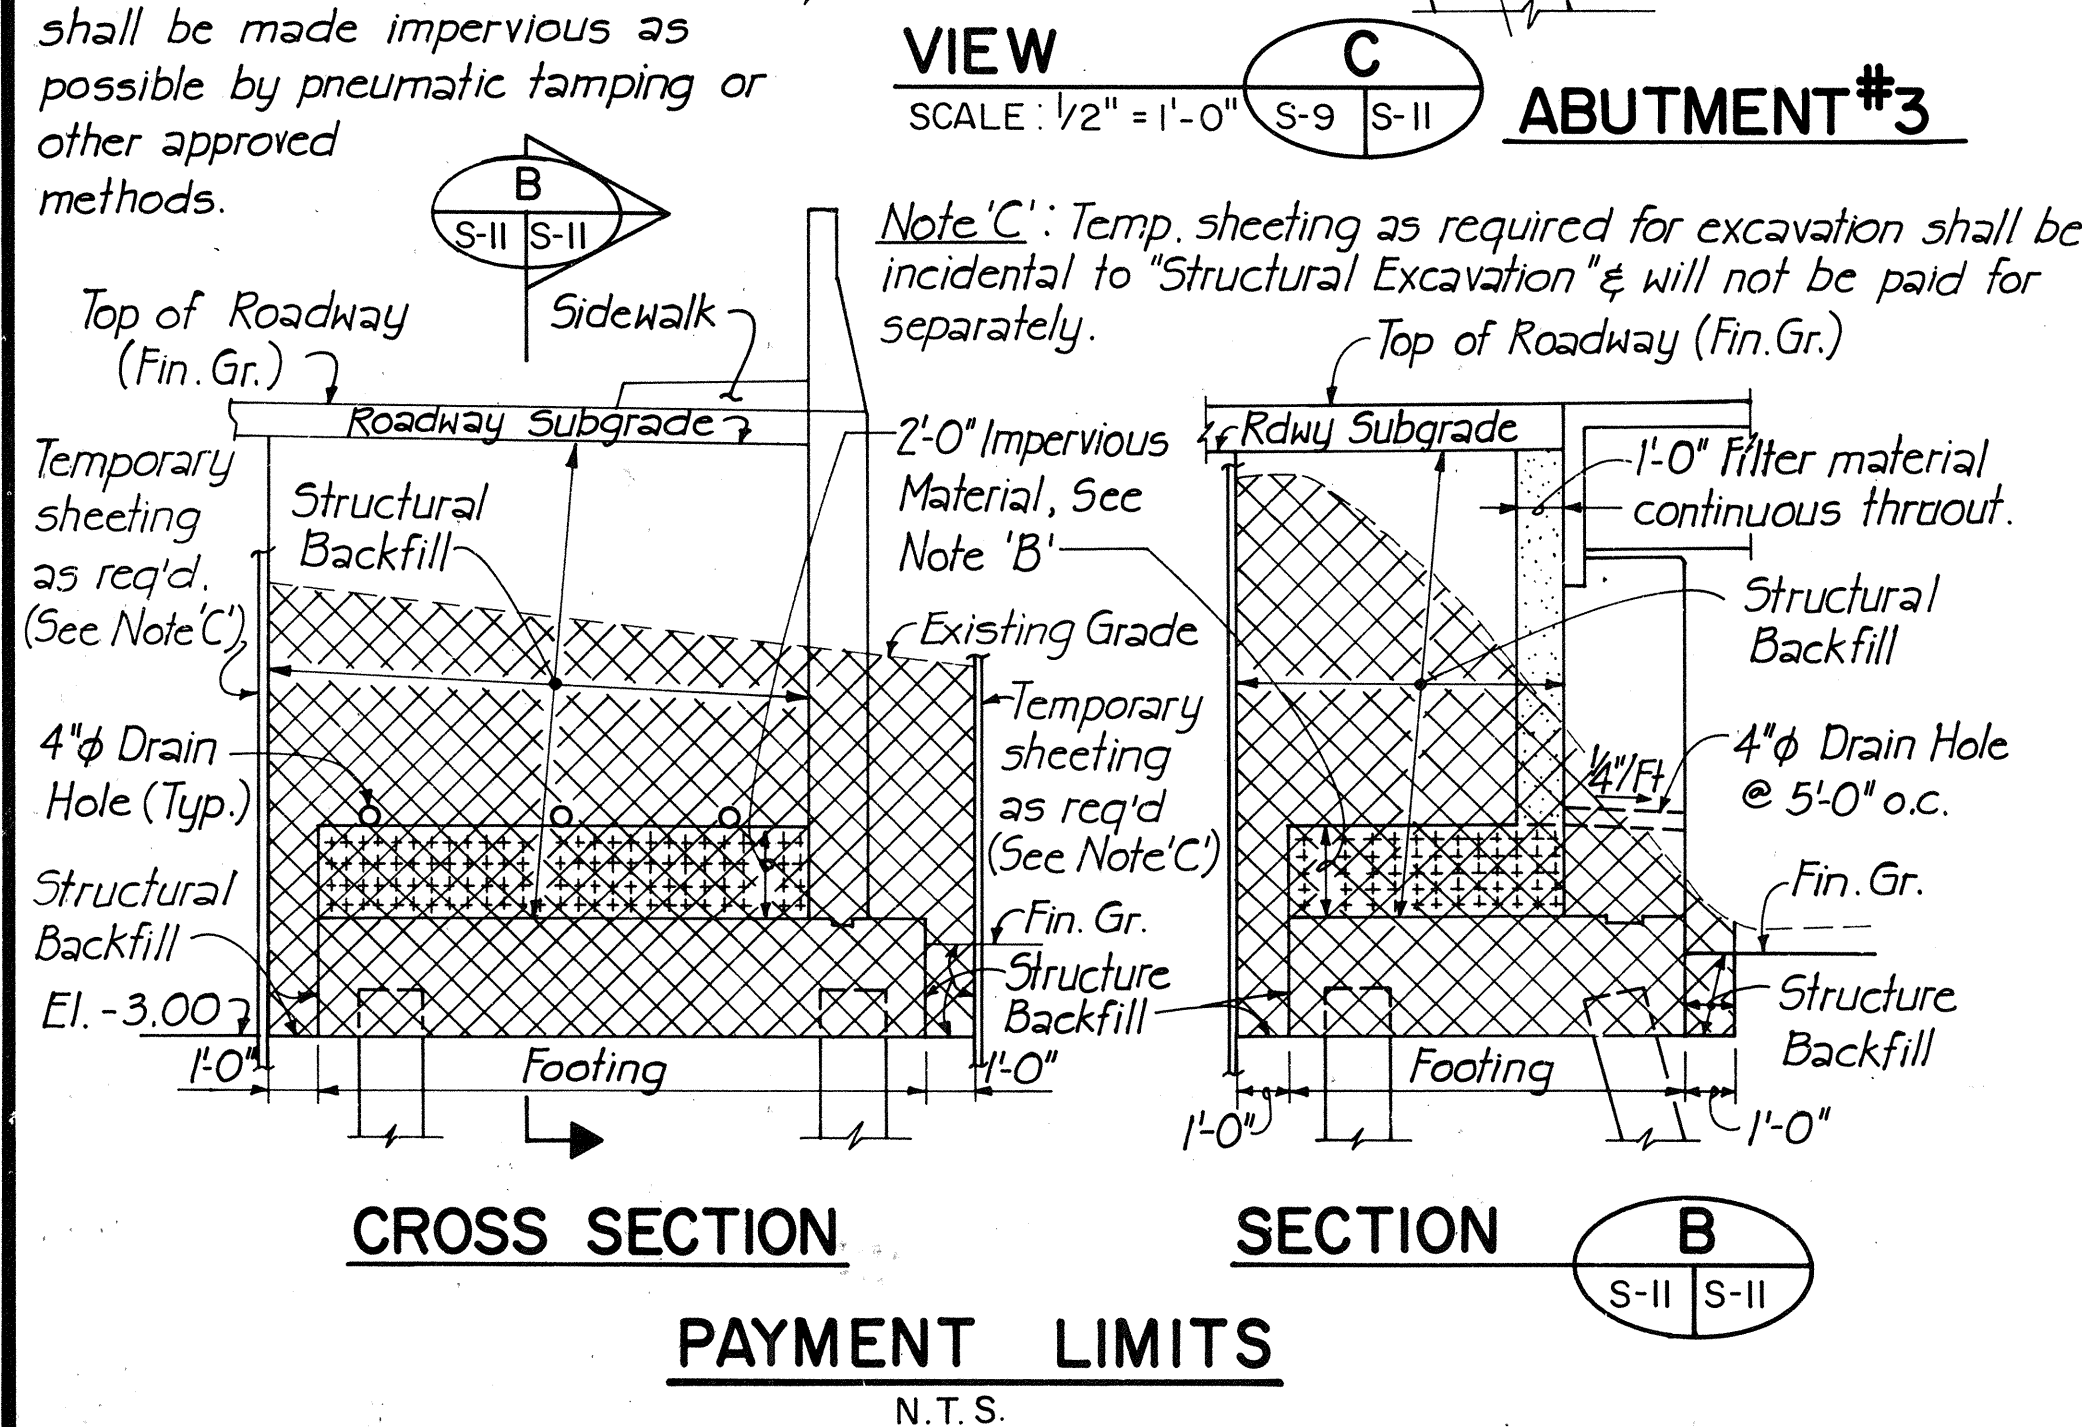

SECTION M
SCALE: 1/2" = 1'-0"

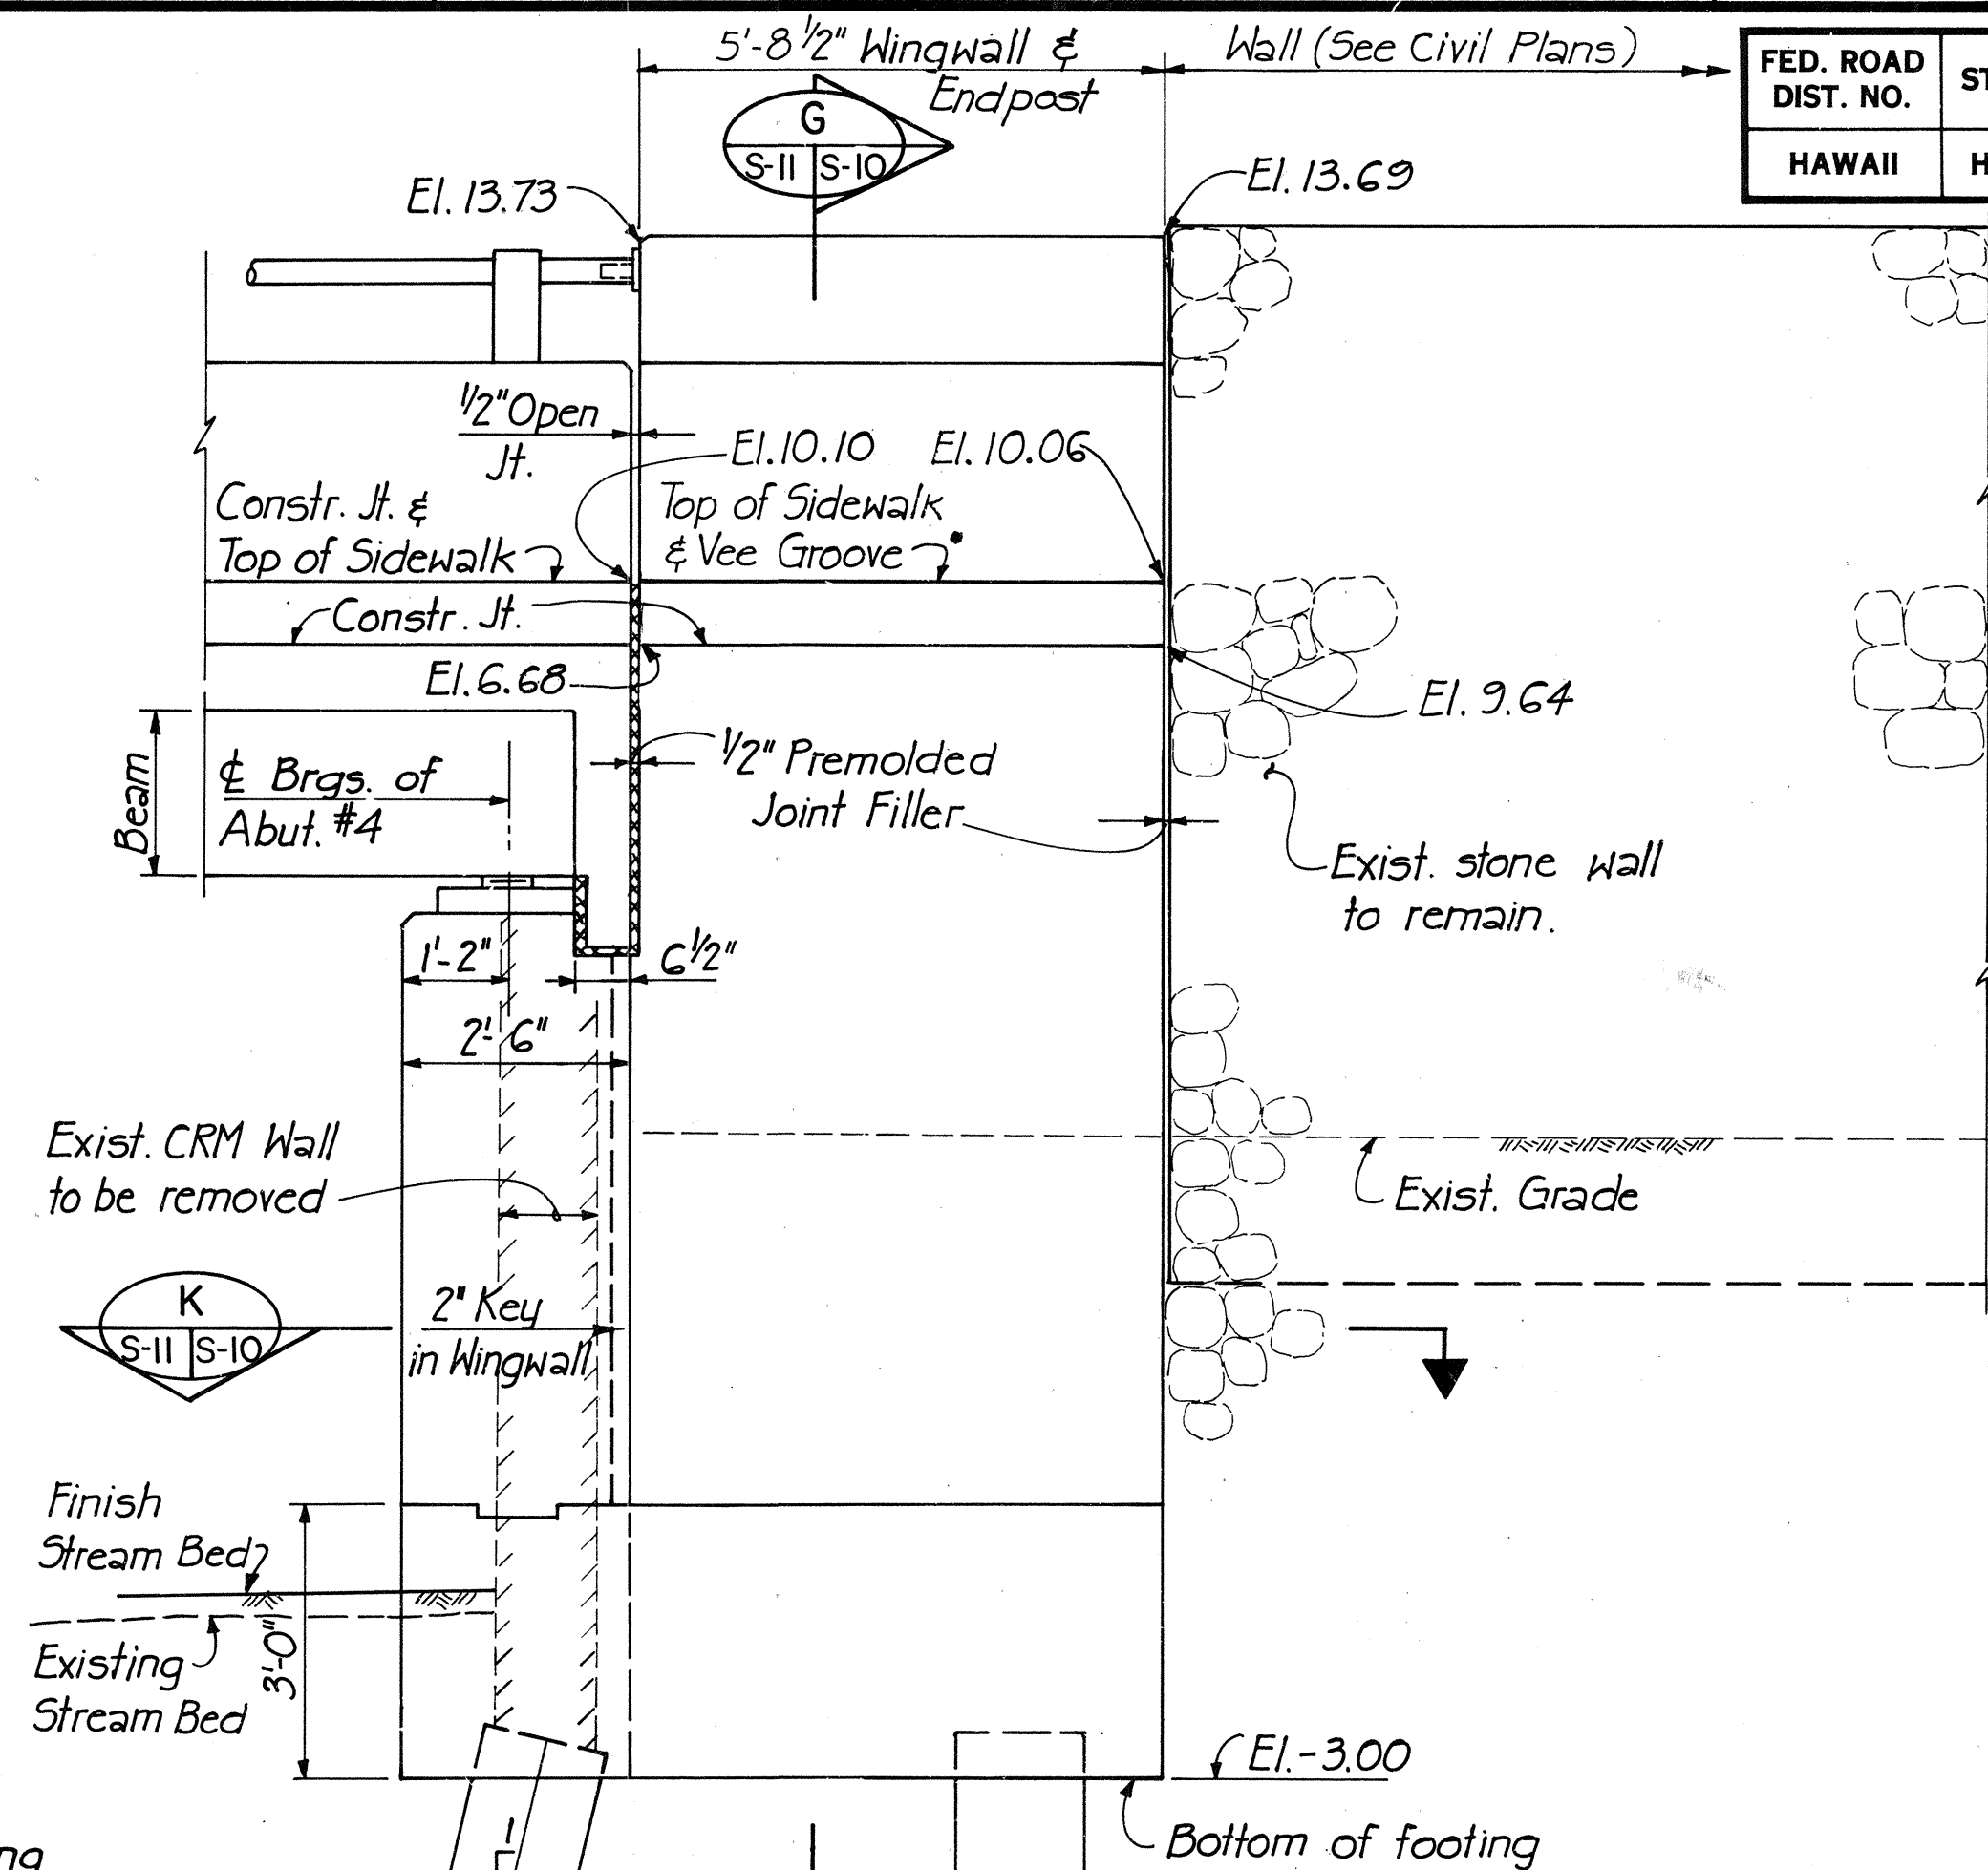


VIEW D
SCALE: 1/2" = 1'-0"

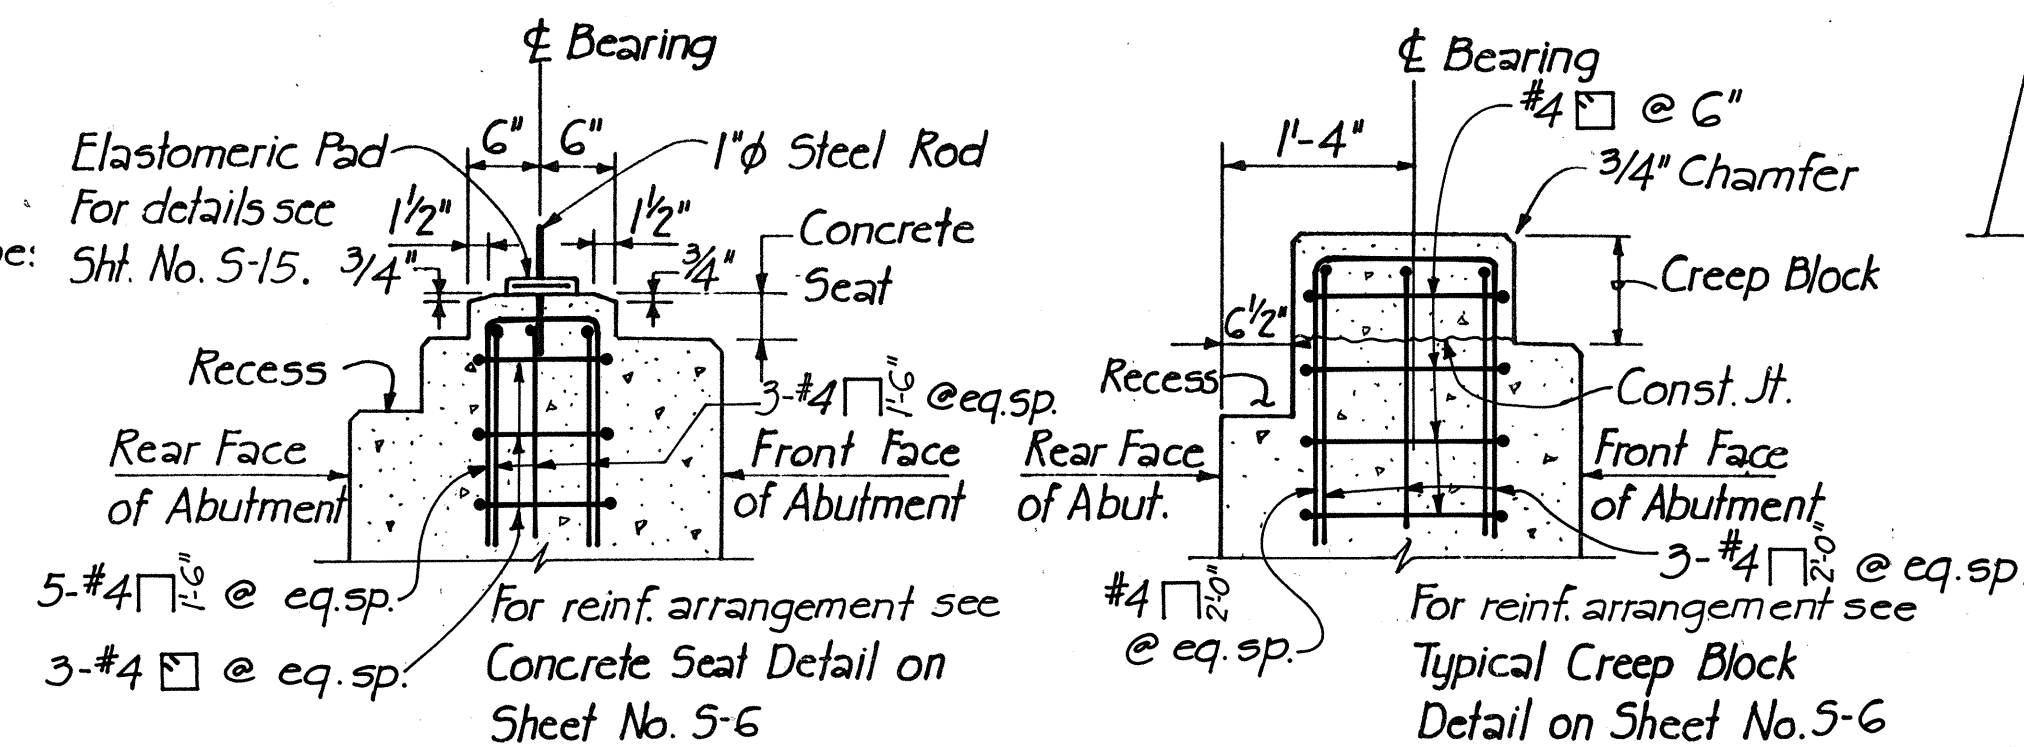


SECTION A
SCALE: 3/4" = 1'-0"

SECTION E
SCALE: 3/4" = 1'-0"

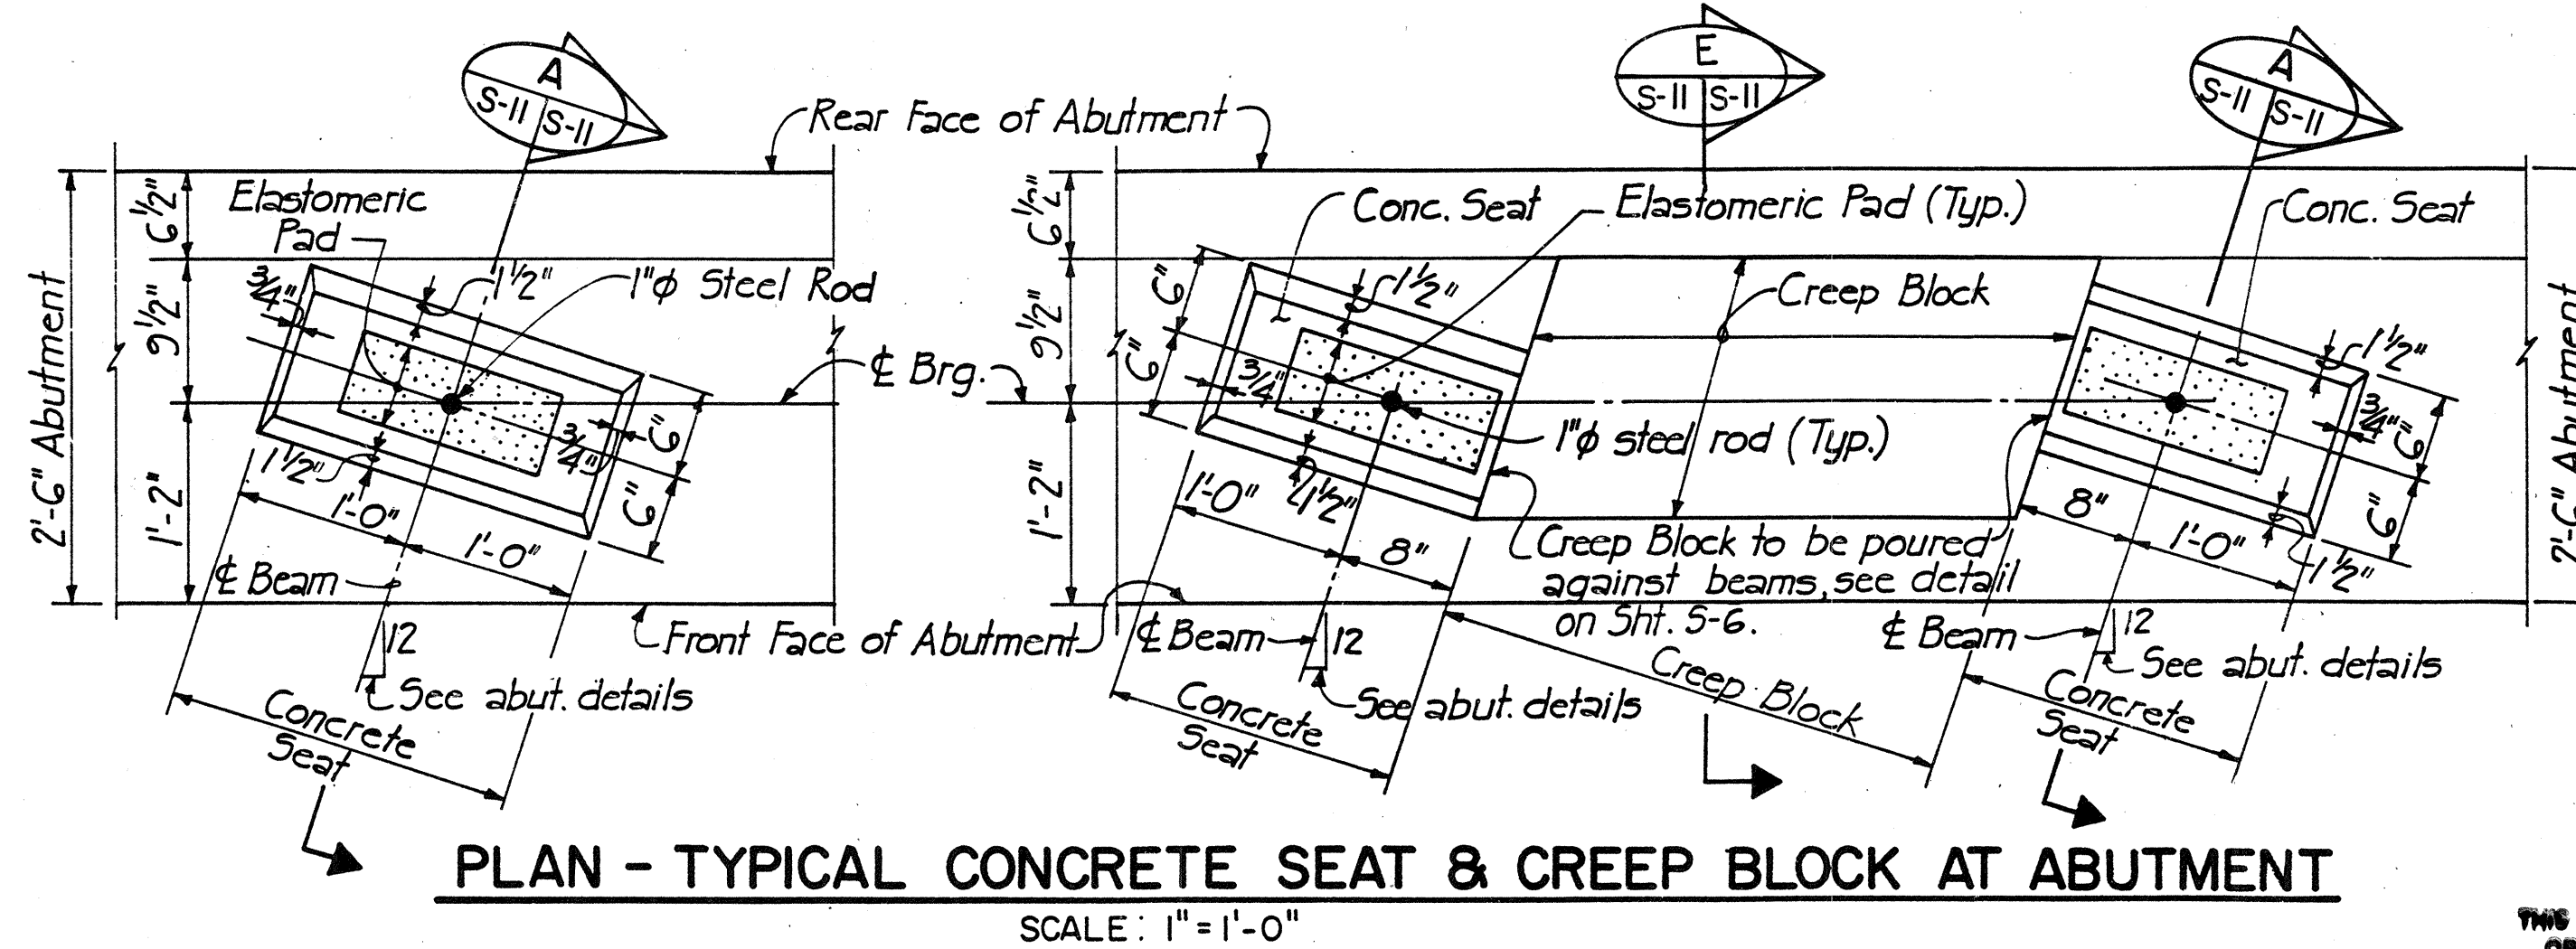

PLAN - TYPICAL CONCRETE SEAT & CREEP BLOCK AT ABUTMENT

SCALE: 1" = 1'-0"

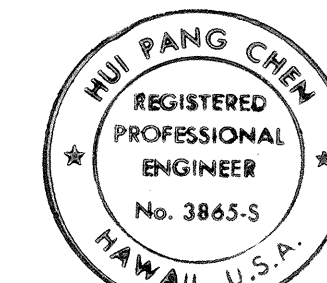

THIS WORK WAS PREPARED BY ME OR UNDER MY SUPERVISION.
Hui Pang Chen

STATE OF HAWAII
DEPARTMENT OF TRANSPORTATION
HIGHWAYS DIVISION
WAILUPE STREAM BRIDGE WIDENING
ABUTMENT SECTIONS
SHEET 2 OF 2
KALANIANA'OLE HIGHWAY
Wailupe Circle to East Hind Drive
FA Project No. F-072-1(34)-A
SCALE: As shown
DATE: JUNE 30, 1990
SHEET NO. S-11 OF 19 SHEETS

166

Technical drawing of a bridge deck expansion detail. The drawing shows a cross-section of a bridge deck with various beams (A, B, C, D) and cradles. Key dimensions include beam widths (e.g., 7'-3 7/8", 7'-3 1/4"), beam spacings (e.g., 8", 3'-5 3/4"), and vertical dimensions (e.g., 5'-11", 1'-10"). Labels include "Type 1 Cradle", "Type 2 Cradle", "WP#1", "WP#2", "WP#3", "BRG. ABUT.#1 (Hinge)", "BRG. ABUT.#2 (Hinge)", "PIER #1", and "TRUE NORTH". The drawing is oriented with a north arrow pointing towards the top right.



NOTE: For details of Beam 'B' at piers, See Sht. Nos. S-13
 & S-16.

NOTE: Beam length given is horizontal distance between ϕ Bearings.



FRAMING PLAN
SCALE: $\frac{1}{8}'' = 1'-0''$



THIS WORK WAS PREPARED BY
OR, UNDER MY SUPERVISION.

Shirong Chen

STATE OF HAWAII
DEPARTMENT OF TRANSPORTATION
HIGHWAYS DIVISION

WAILUPE STREAM BRIDGE WIDENING

FRAMING PLAN

KALANIANA'OLE HIGHWAY
Wailupe Circle to East Hind Drive
E.A. Project No. F-072-1 (34) -A

SCALE : As shown DATE : JUNE 30, 1990


SHEET NO. S-12 OF 19 SHEETS

FED. ROAD DIST. NO.	STATE	FED. AID PROJ. NO.	FISCAL YEAR	SHEET NO.	TOTAL SHEETS
HAWAII	HAW.	F-072-1(34)-A	1990	168	186


NOTES FOR PRESTRESSED BEAMS

PRETENSIONING


1. Concrete shall have a minimum 28 day compressive strength of 6000 psi.
2. Prestensioned strands shall be 7 wire $\frac{7}{16}$ " stress-relieved steel strands (area = 0.115 in²) with an ultimate strength of 270 ksi. For properties see State Standard Specifications.
- Total loss due to creep, shrinkage, elastic shortening and relaxation of steel = 45,000 psi.
3. Non-prestressed reinforcing steel shall be Grade 40 unless otherwise noted. For properties see State Standard Specifications.
4. The calculated camber includes the effect of the initial prestress force and the weight of the beam after removal from bed. Negative values shown for calculated camber indicate a net upward deflection. Calculated camber values shown do not account for any camber growth of the beam. The actual camber shall not exceed the calculated camber shown on the plans by more than 100% at time of installation.
5. The dead load deflection includes the combined effects of the weight of slab, haunch & diaphragm.
6. Strand pattern shall be symmetrical about the longitudinal ϕ of the beam.
7. Strand release sequence shall not induce any lateral deflection of the beam.
8. Contractor shall submit his proposed strand pattern and releasing sequence to the Engineer for approval.
9. During curing care shall be taken to avoid any lateral deflection of the beam due to improper orientation.
10. Lifting devices shall be placed as close as possible to the center line of bearings of the beam. Details and locations of lifting devices shall be submitted to the Engineer for approval. Such approval does not relieve the Contractor of his responsibilities if beam is damaged due to failure of the lifting device.
11. See Framing Plans for locations of diaphragms & beam mark numbers. For beam types and lengths see beam type schedule. Lengths shown do not include effect of elastic shortening.
12. Provide slotted holes at beam ends. For detail see Section D S-13 S-15
13. For beam end skew angles see shits. 5-6 thru 5-9.

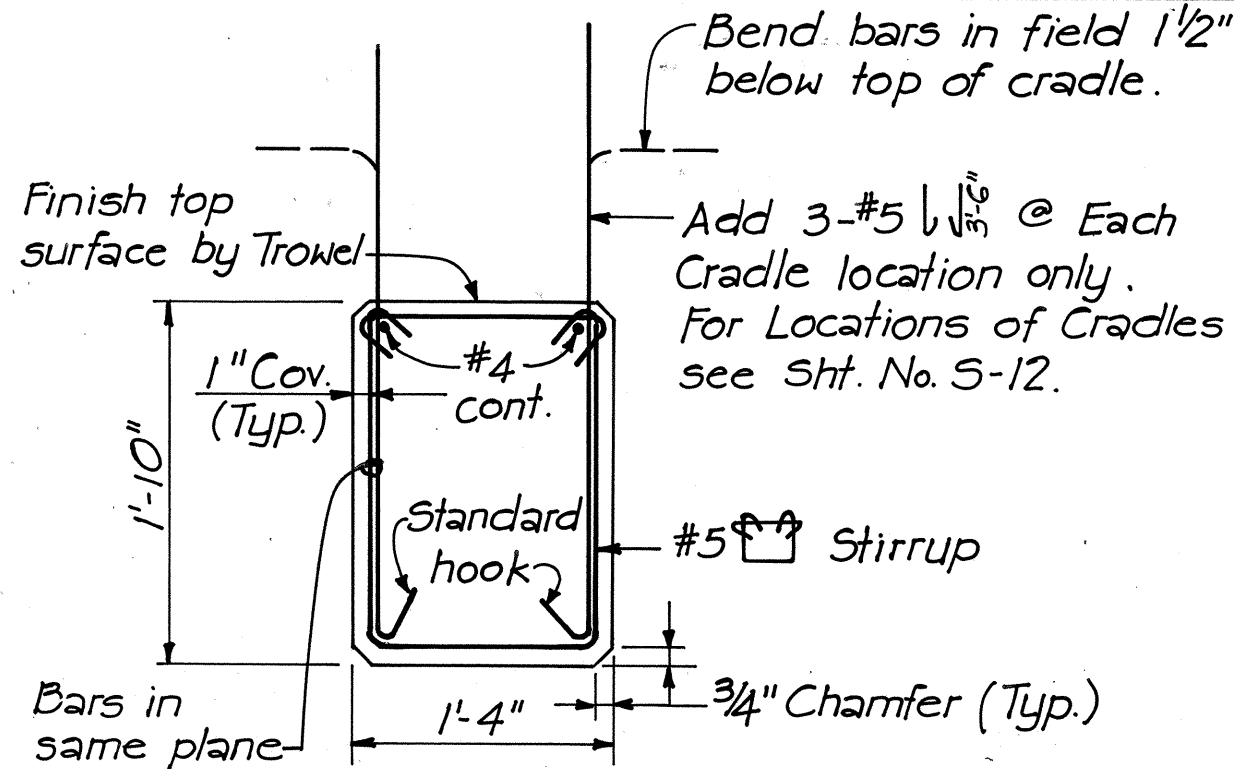


TYPICAL BEAM SECTION
FOR BEAMS IIB4 AND 2IB4
SCALE: 1" = 1'-0"

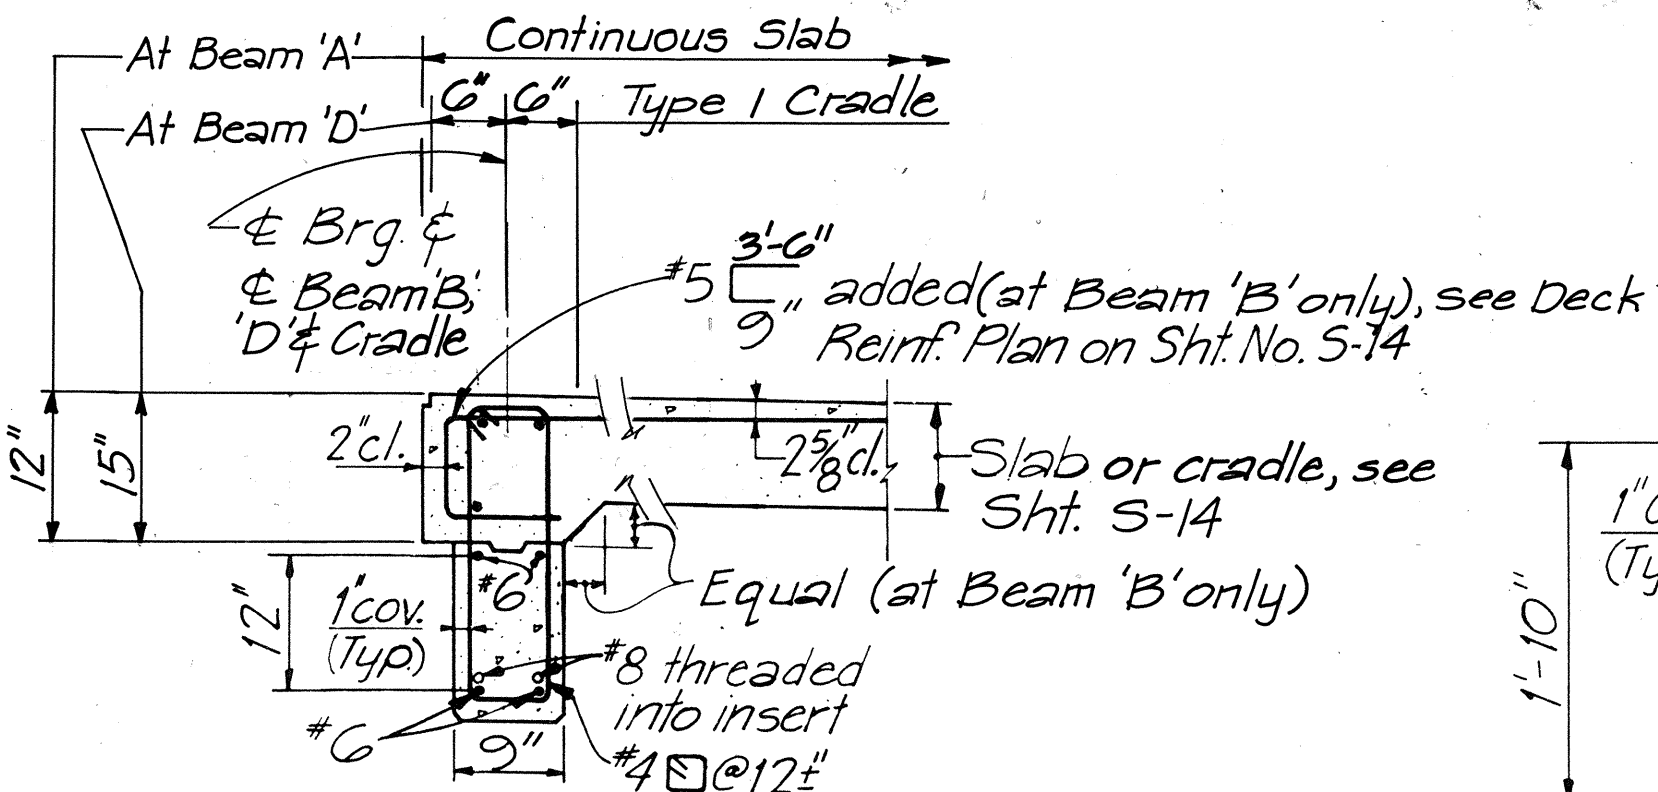


SECTION D
SCALE: 3/4" = 1'-0"

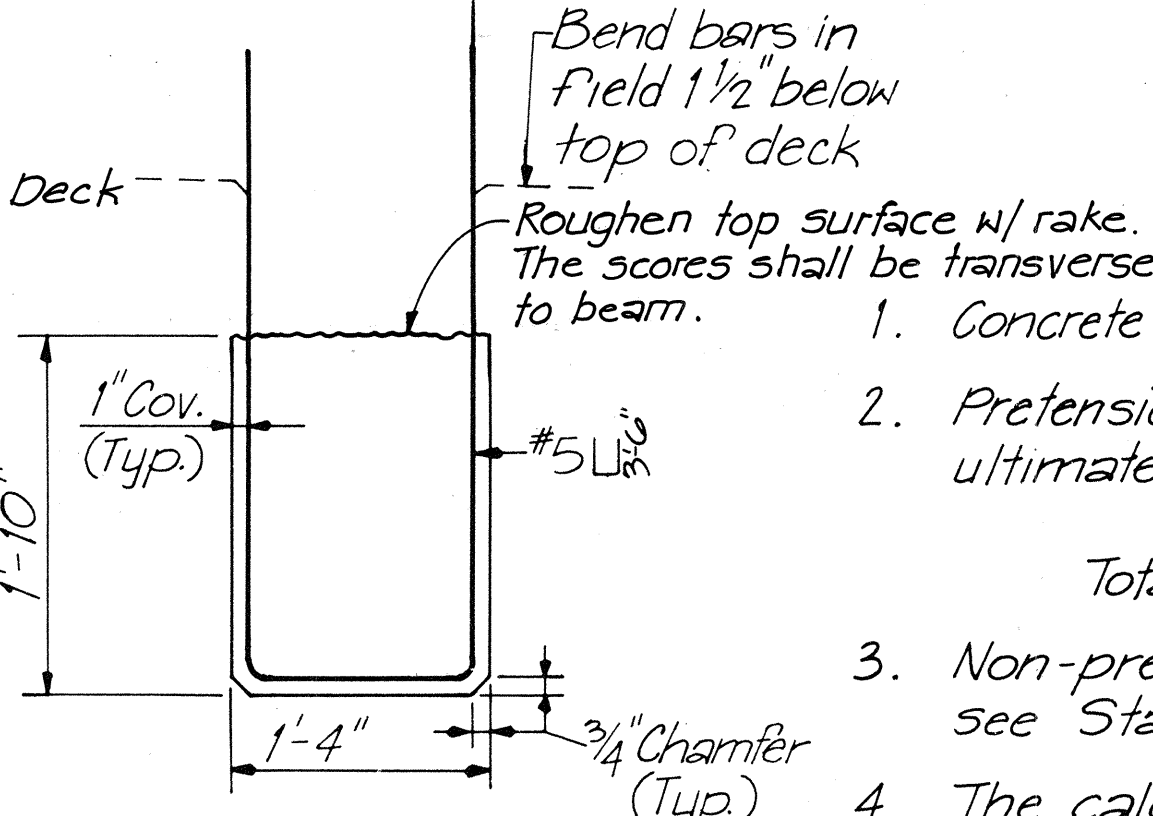


TYPICAL BEAM SECTION FOR BEAMS IIB1 TO
IIB3, 2IB1 TO 2IB3, IOB1 TO IOB4, 2OB1 TO 2OB4
SCALE: 1" = 1'-0"

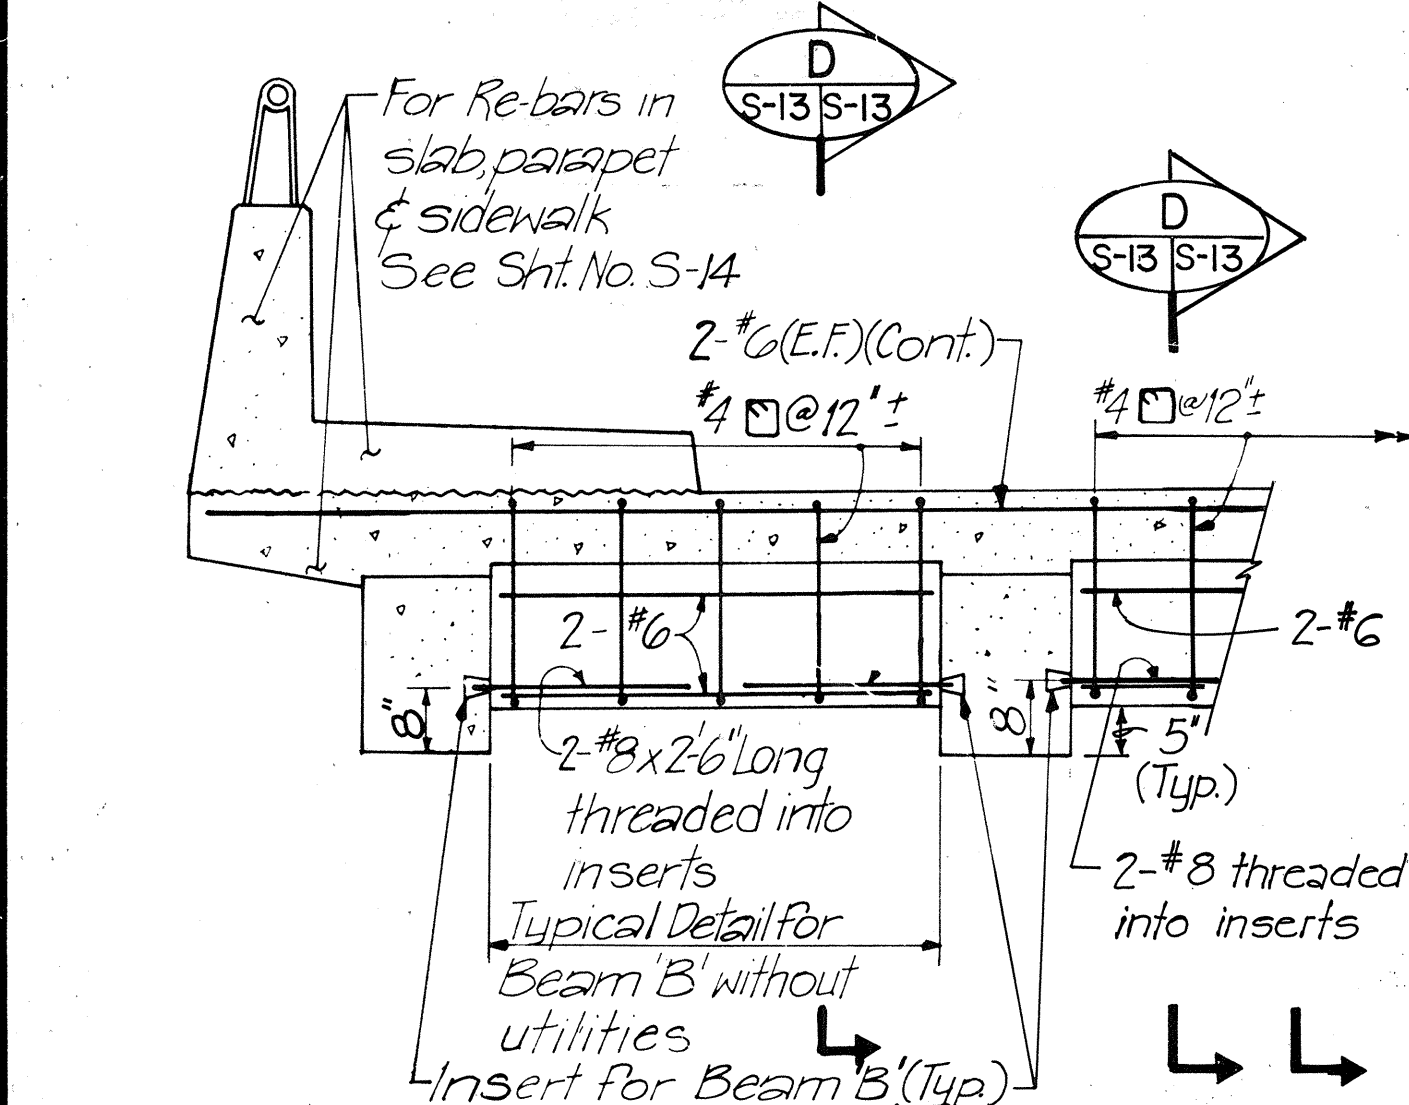


TYPICAL BEAM 'B' DETAILS
SCALE: 1/2" = 1'-0"

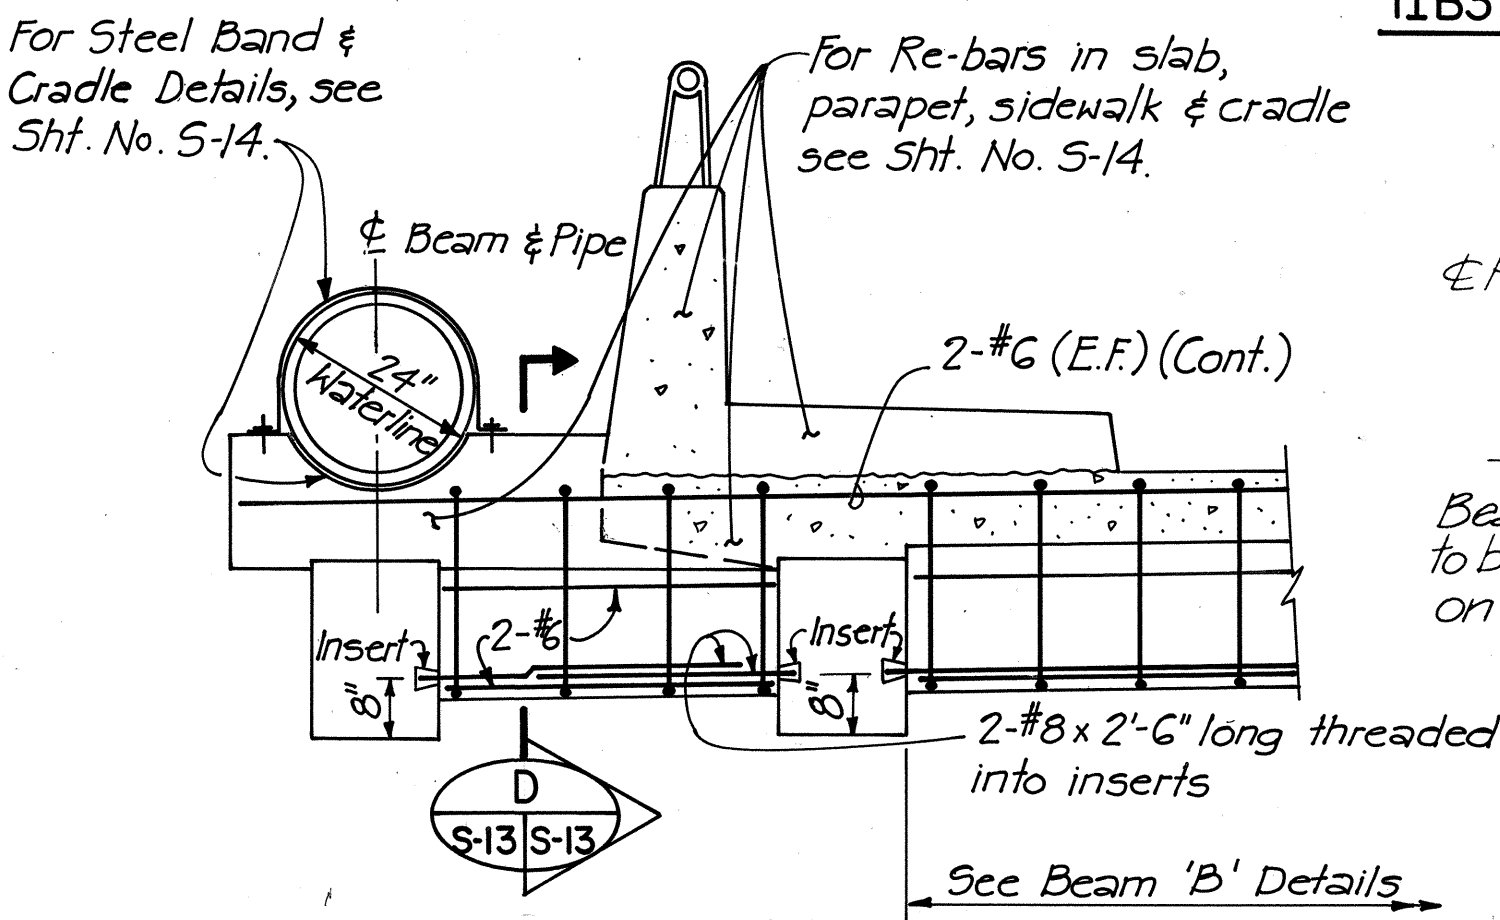



TYPICAL BEAM 'D' DETAILS
SCALE: 1/2" = 1'-0"

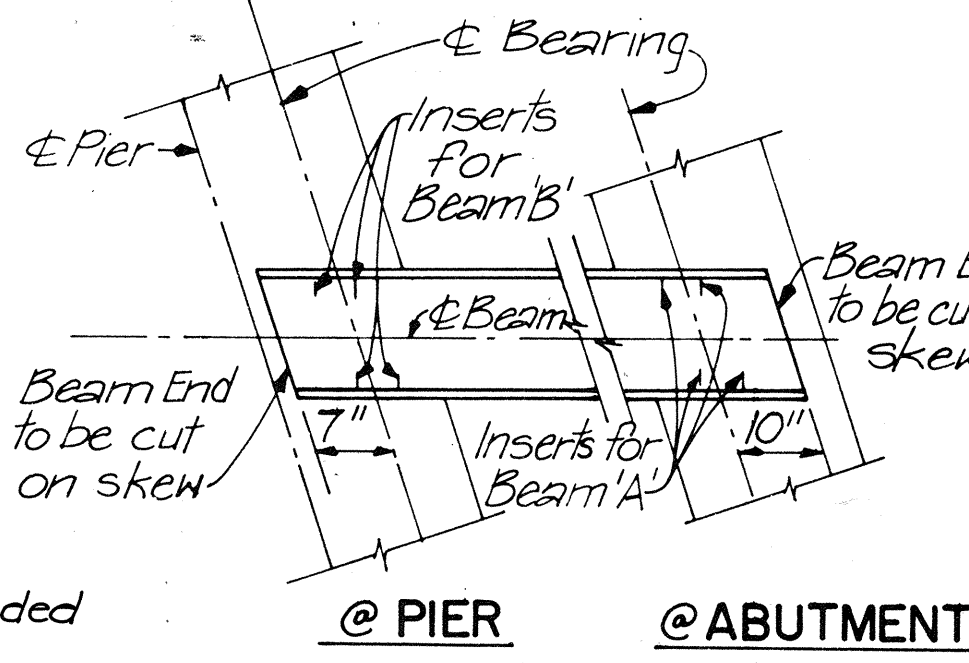


BEAM END PLAN
N.T.S.

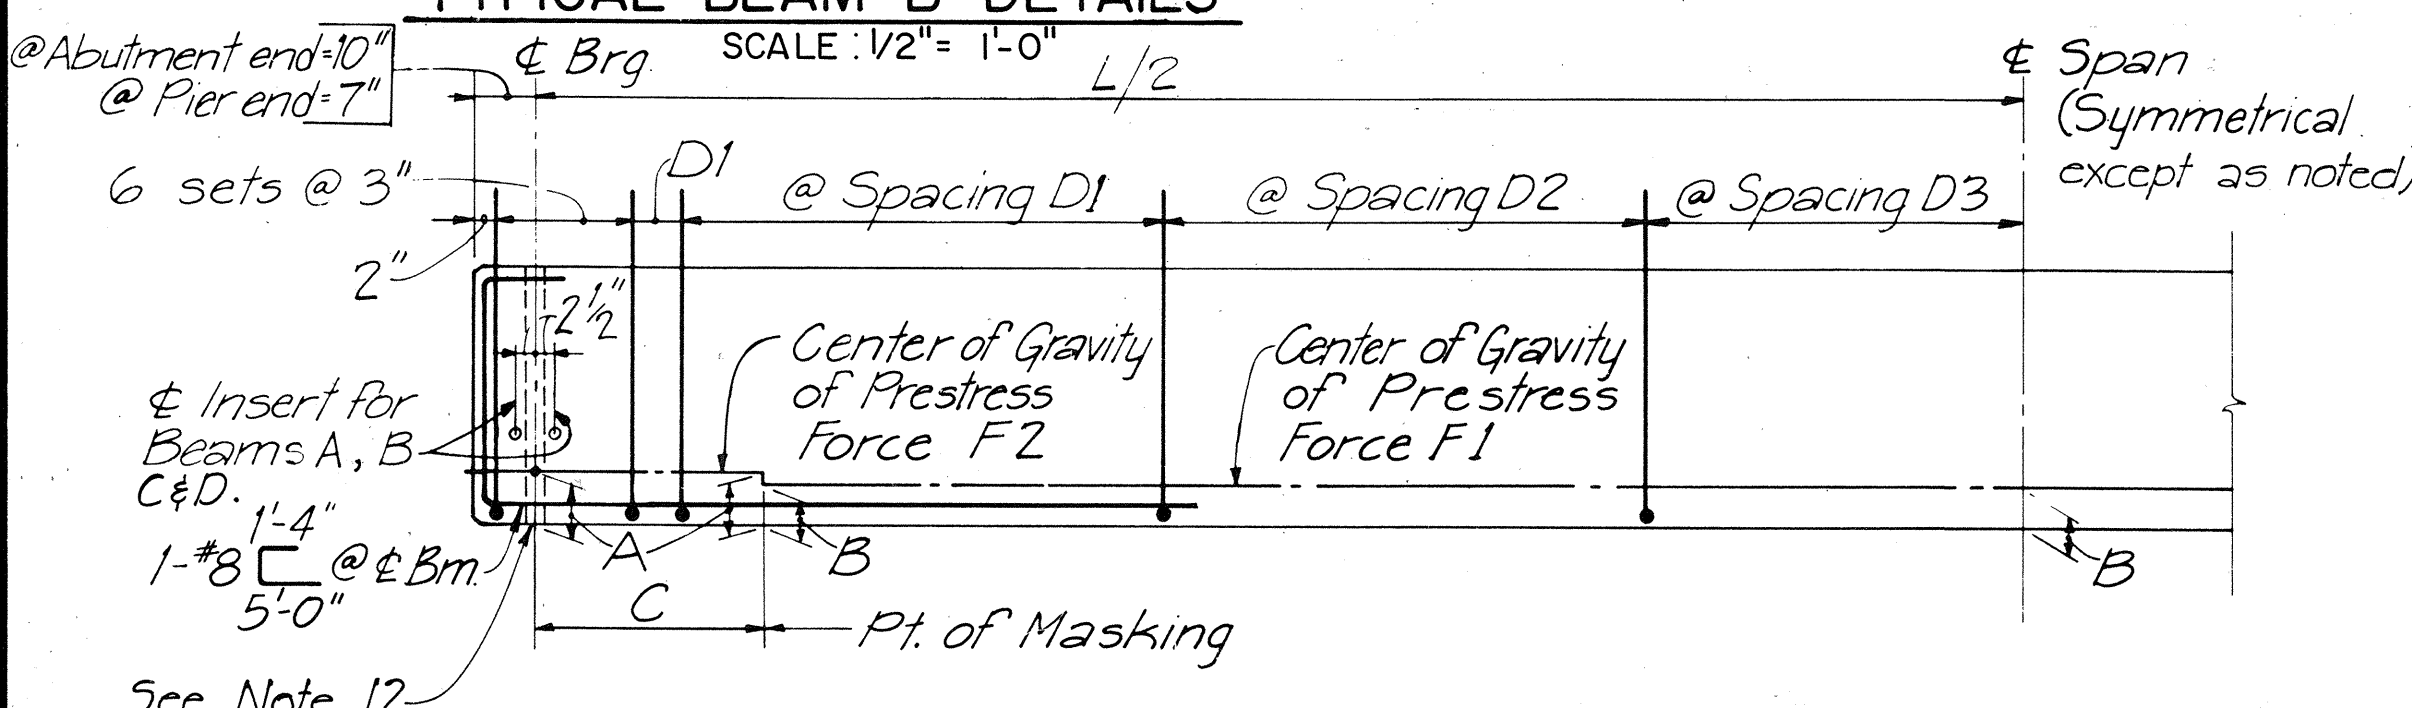

LONGITUDINAL SECTION
N.T.S.

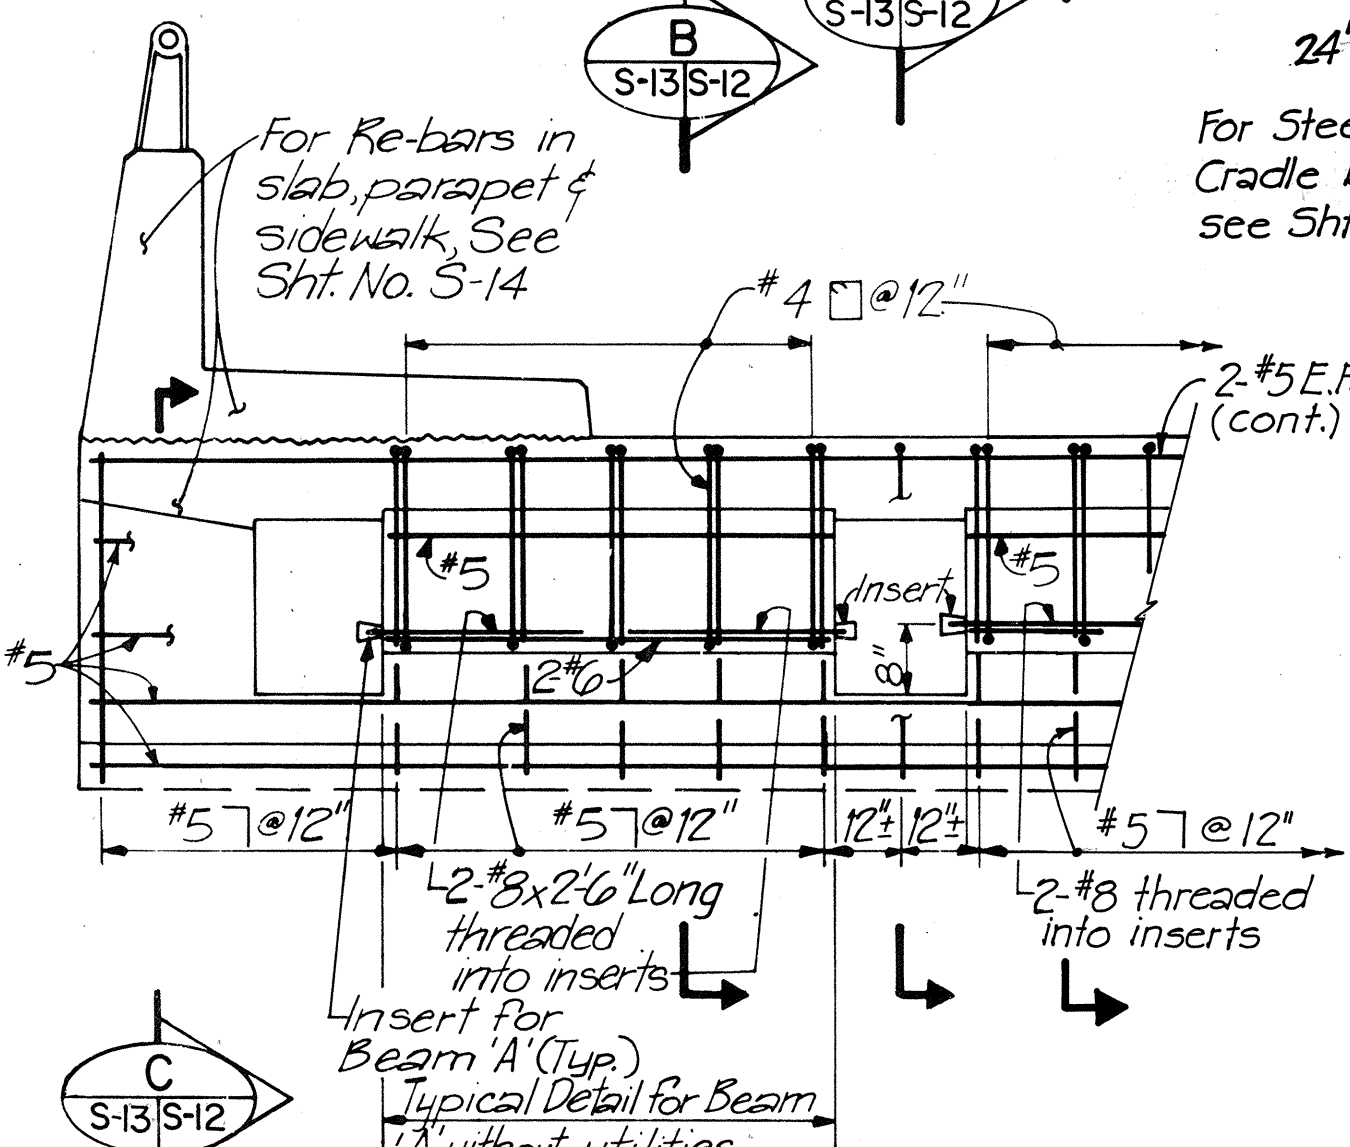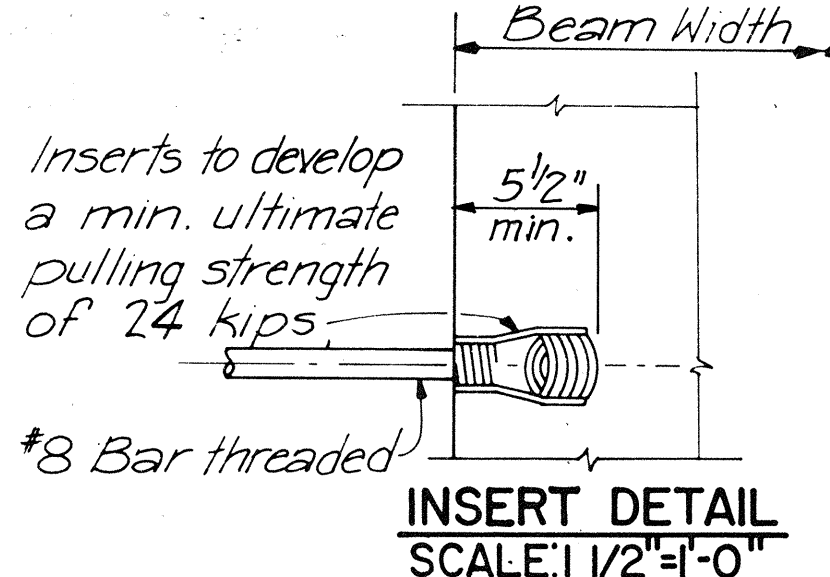

TYPICAL BEAM 'A' DETAILS
SCALE: 1/2" = 1'-0"

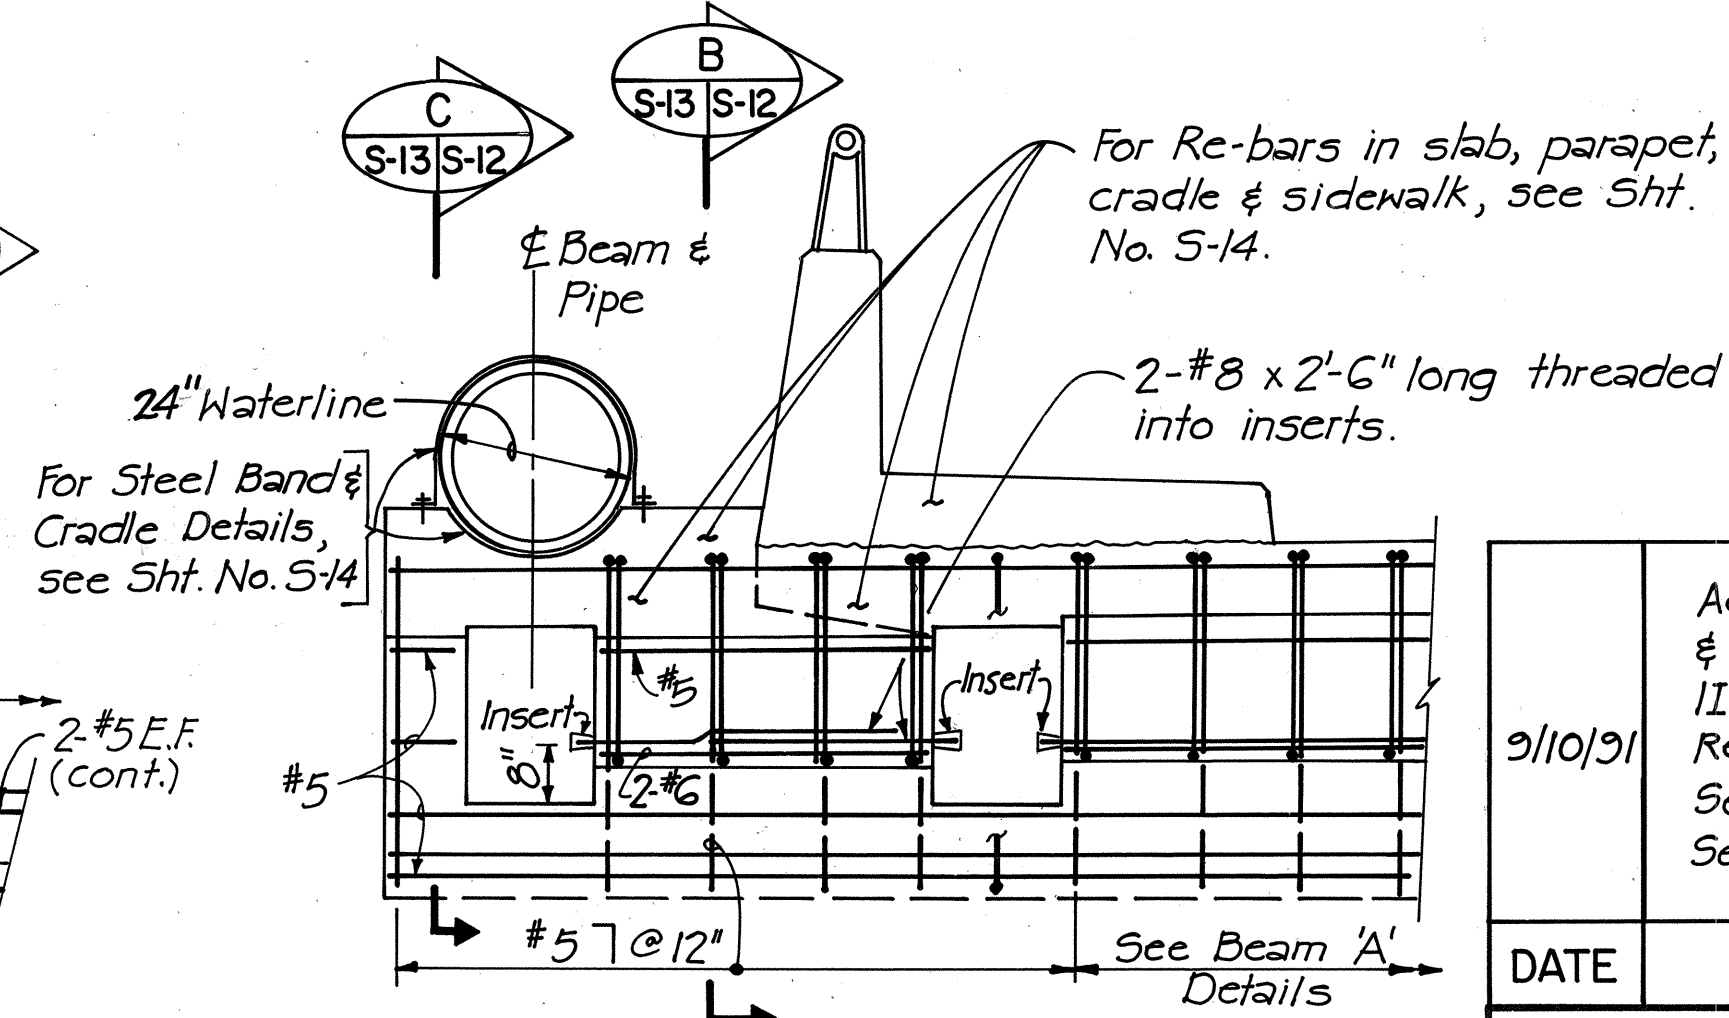

TYPICAL BEAM 'C' DETAILS
SCALE: 1/2" = 1'-0"

BEAM SCHEDULE										
BEAM TYPE	FL. WORKING * FORCE (KIPS)	F2. WORKING * FORCE (KIPS)	CALCULATED CAMBER SEE NOTE 4	DEAD LOAD DEFLECTION SEE NOTE 5	LOCATION OF CENTER OF GRAVITY OF PRESTRESS FORCE			STIRRUPS		
					DIST A	DIST B	DIST. TO PT. OF MASKING C	NO. OF STIRRUPS @ SPACING D1	NO. OF STIRRUPS @ SPACING D2	SPACING D3
I	4968 ^K	4306 ^K	-0.46"	0.23"	8.31"	7.47"	5'-3"	5 @ 9"	5 @ 15"	18"
II	3975 ^K	3312 ^K	-0.48"	0.19"	7.40"	6.50"	3'-9"	5 @ 9"	5 @ 15"	18"

Added Details of Beam 'C', Beam 'D'
& Typical Beam Section for Beams
IIB4 & 2IB4 to add 24" Water Line.
Revised Title of Typical Beam
Section, Longitudinal Section and
Section D S-13 S-15

2/10/91

DATE

REVISIONS

STATE OF HAWAII
DEPARTMENT OF TRANSPORTATION
HIGHWAYS DIVISION

WAILUPE STREAM BRIDGE WIDENING

PRESTRESS BEAM DETAILS

KALANIANA'OLE HIGHWAY


Wailupe Circle to East Hind Drive

EA. Project No. F-072-1 (34) -A

SCALE: As shown

DATE: JUNE 30, 1990








SHEET No. S-13 OF 19 SHEETS

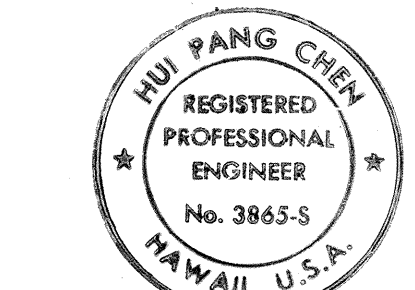

THIS WORK WAS PREPARED BY ME
OR UNDER MY SUPERVISION.
Hui Pang Chen


For [Signature] 10/24/91
Chief, Plng. & Engr. BWS. Date

FED. ROAD DIST. NO.	STATE	FED. AID PROJ. NO.	FISCAL YEAR	SHEET NO.	TOTAL SHEETS
HAWAII	HAW.	F-072-1(34)-A	1990	169	186

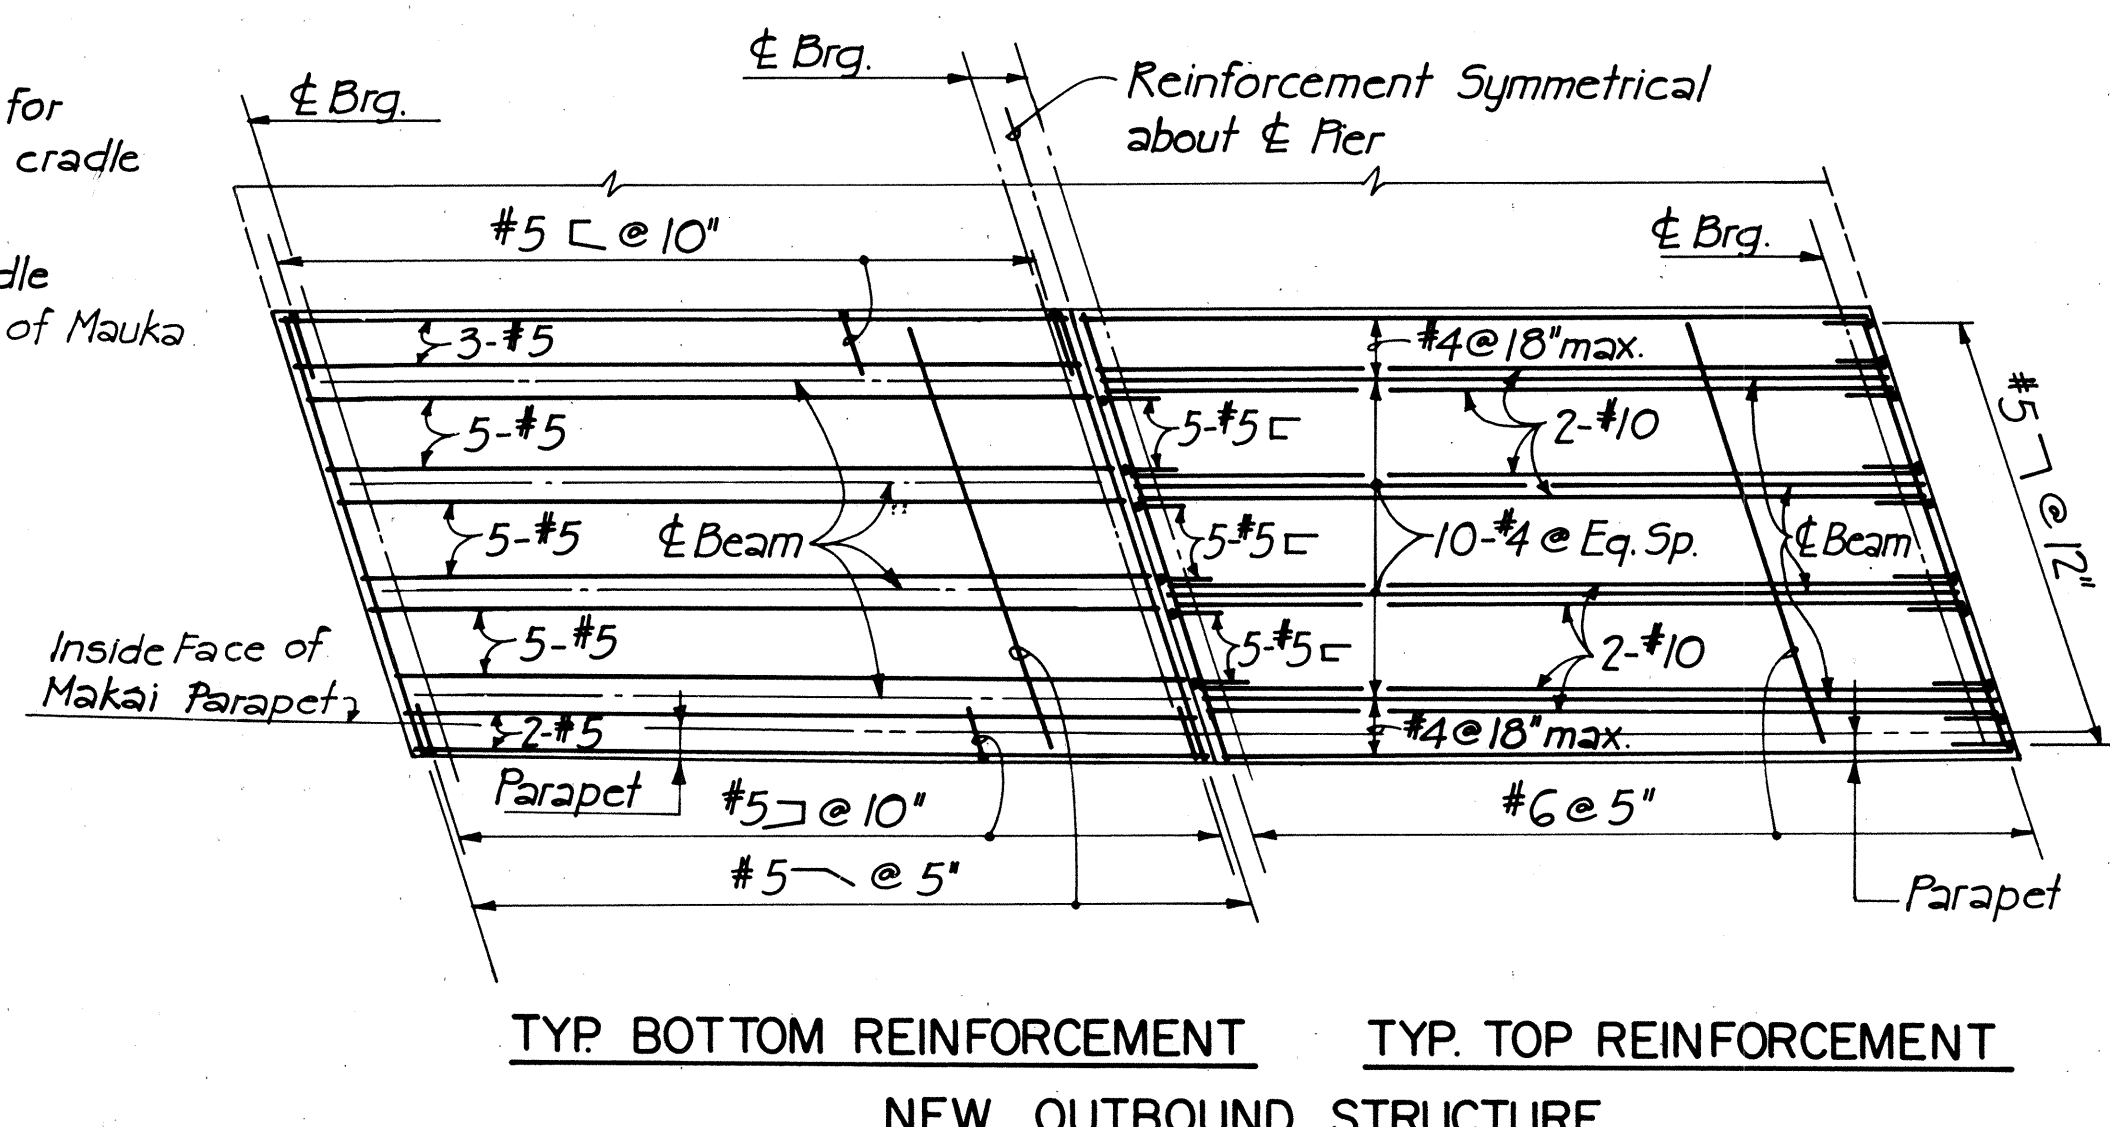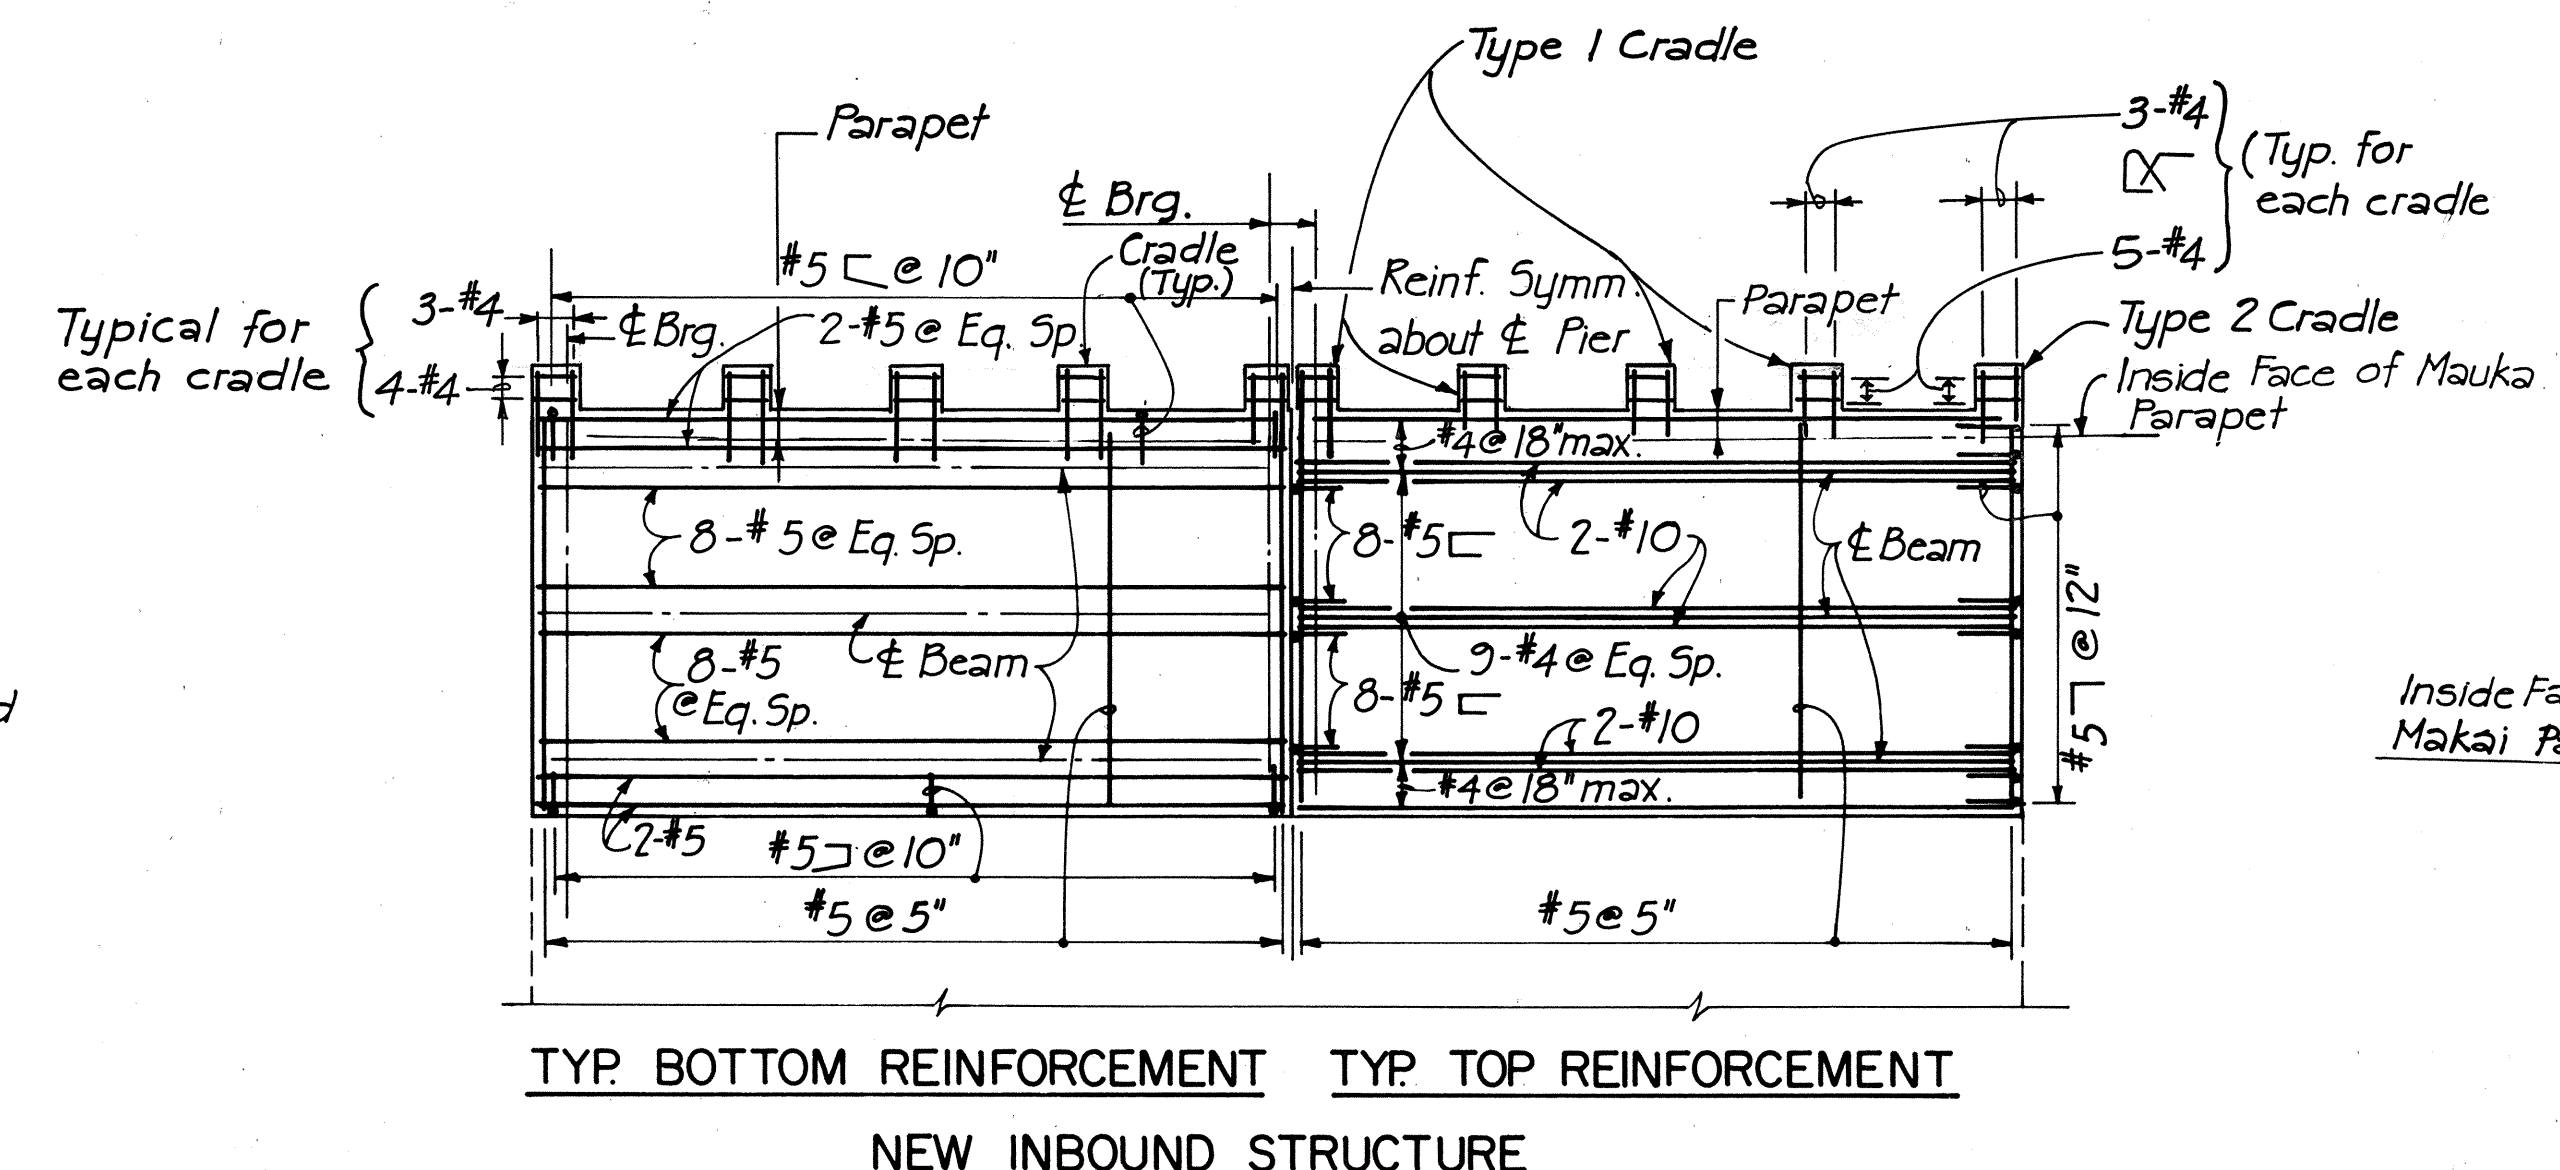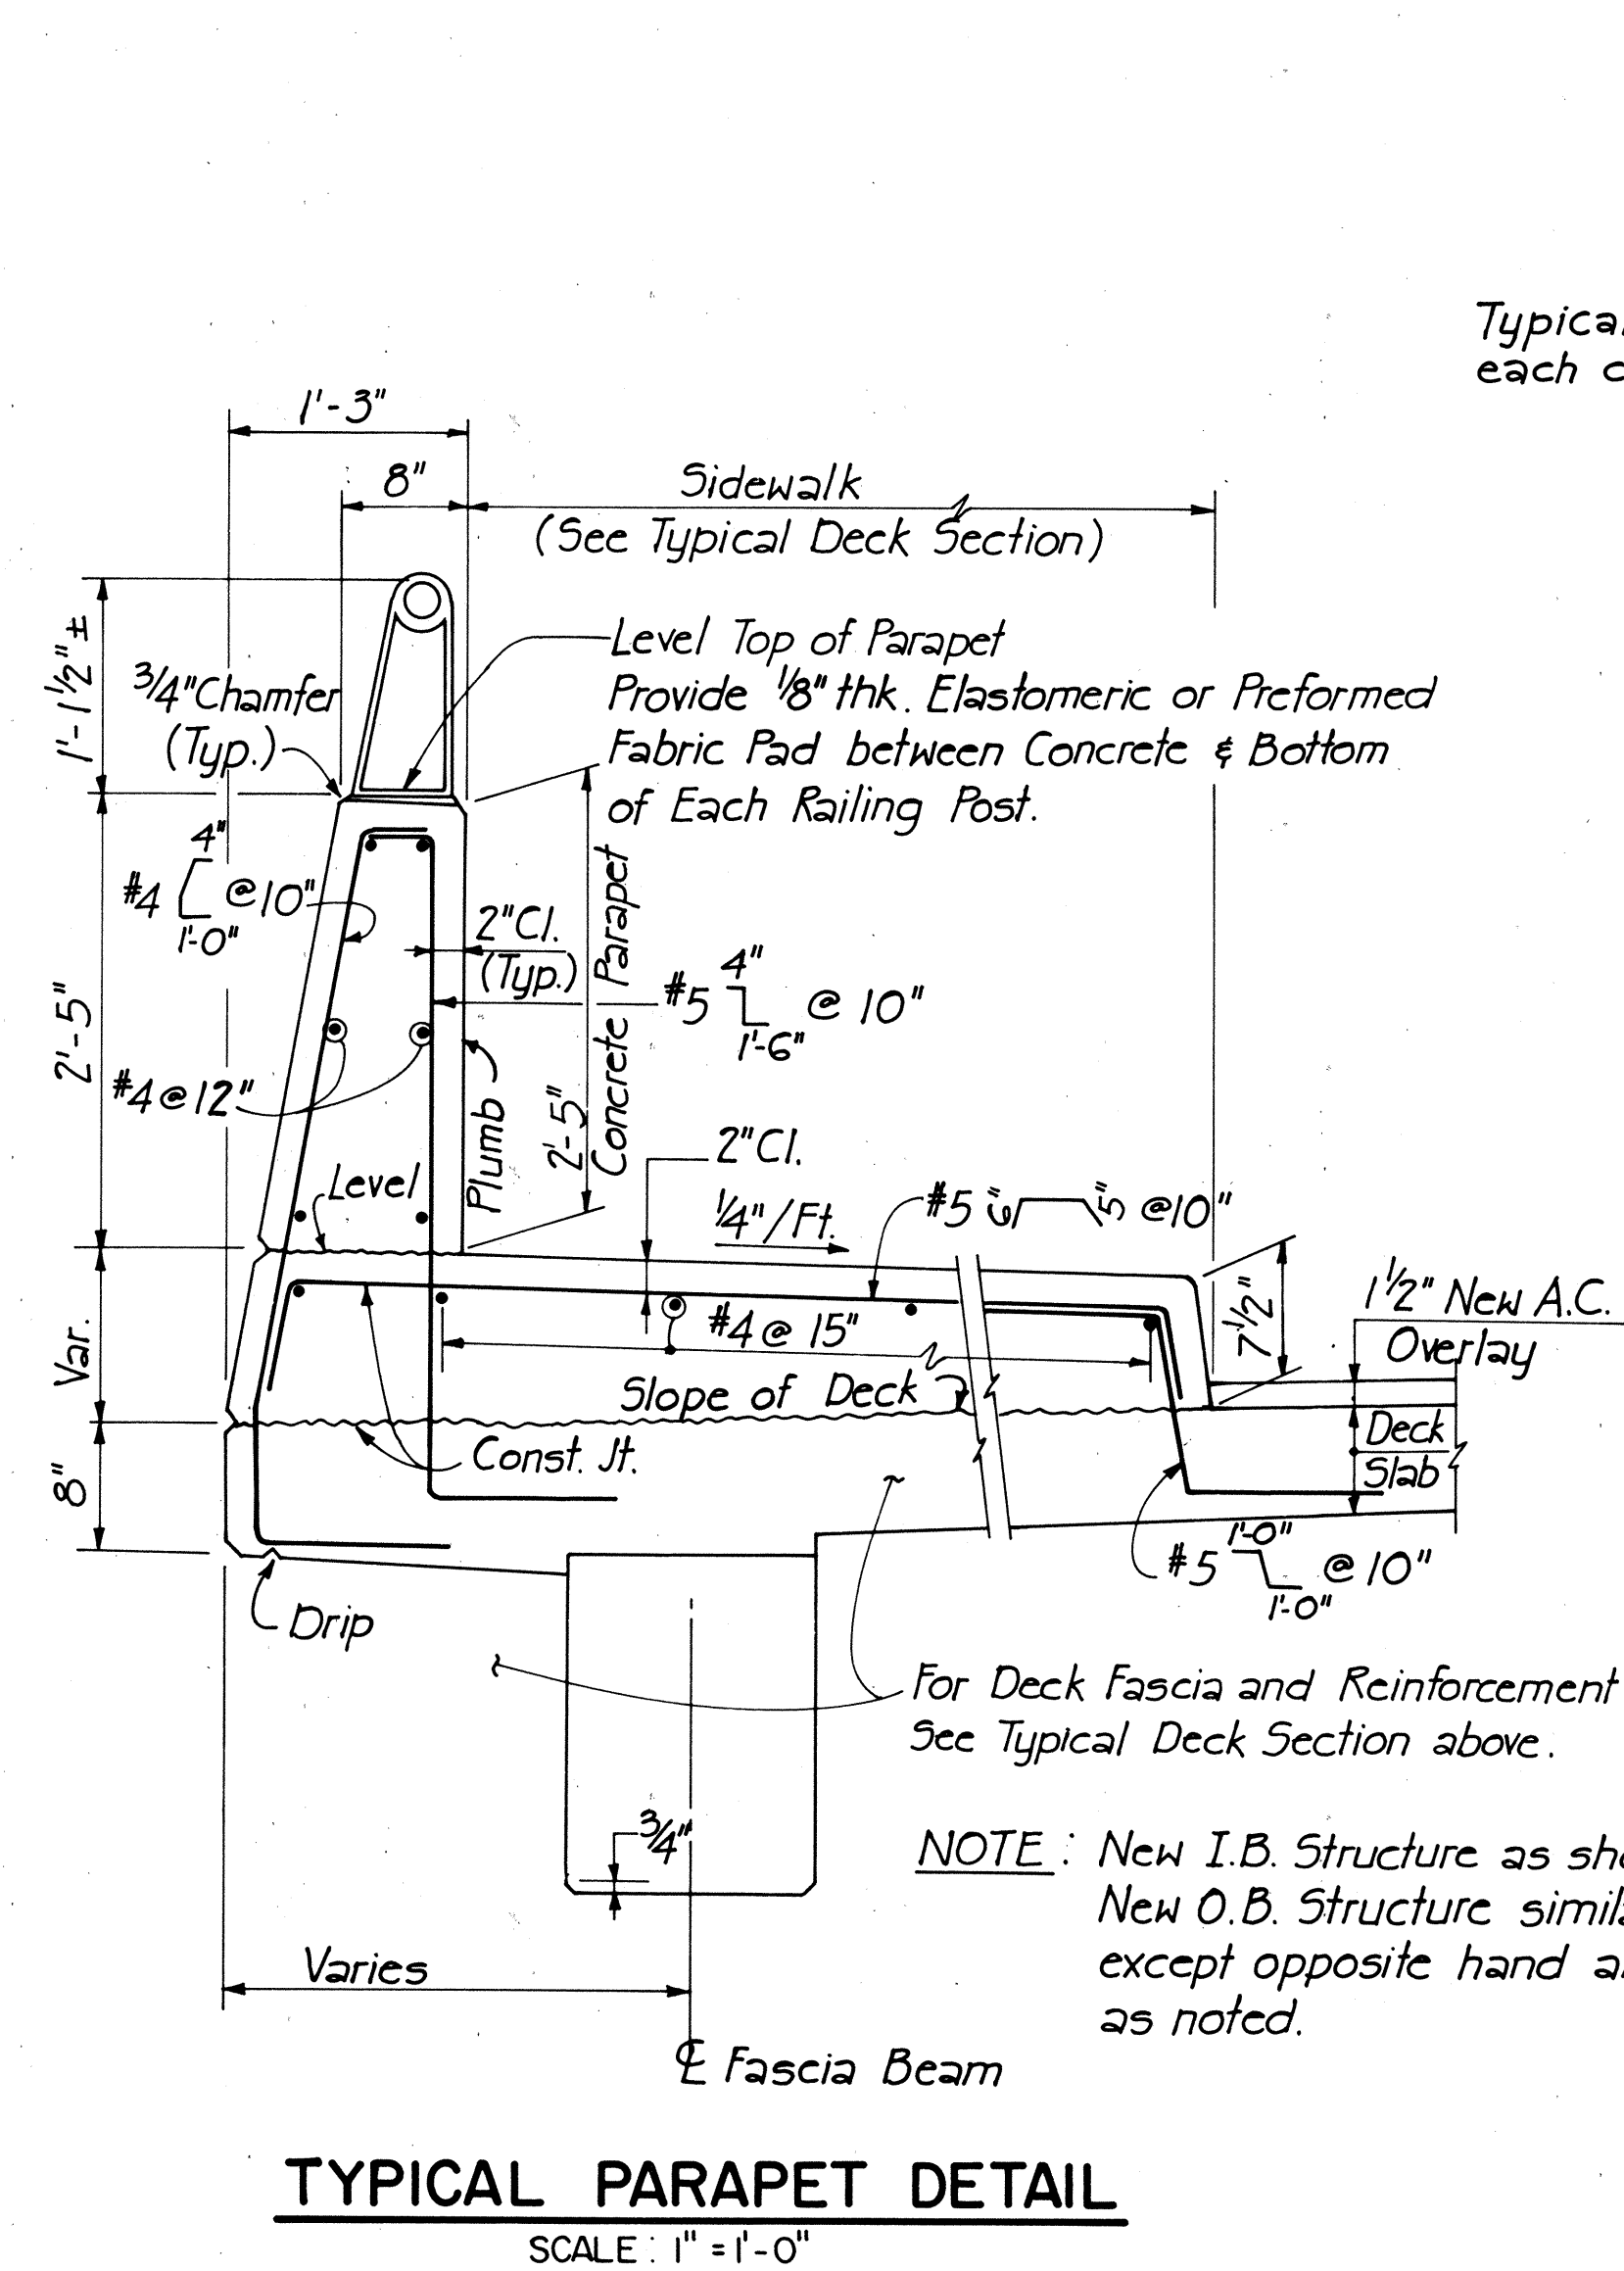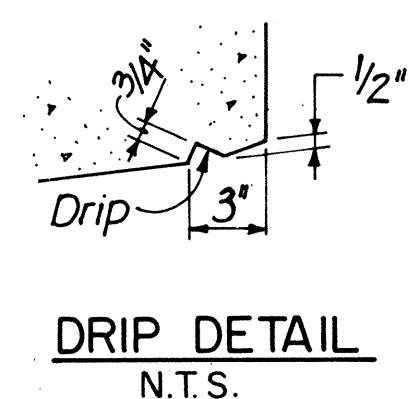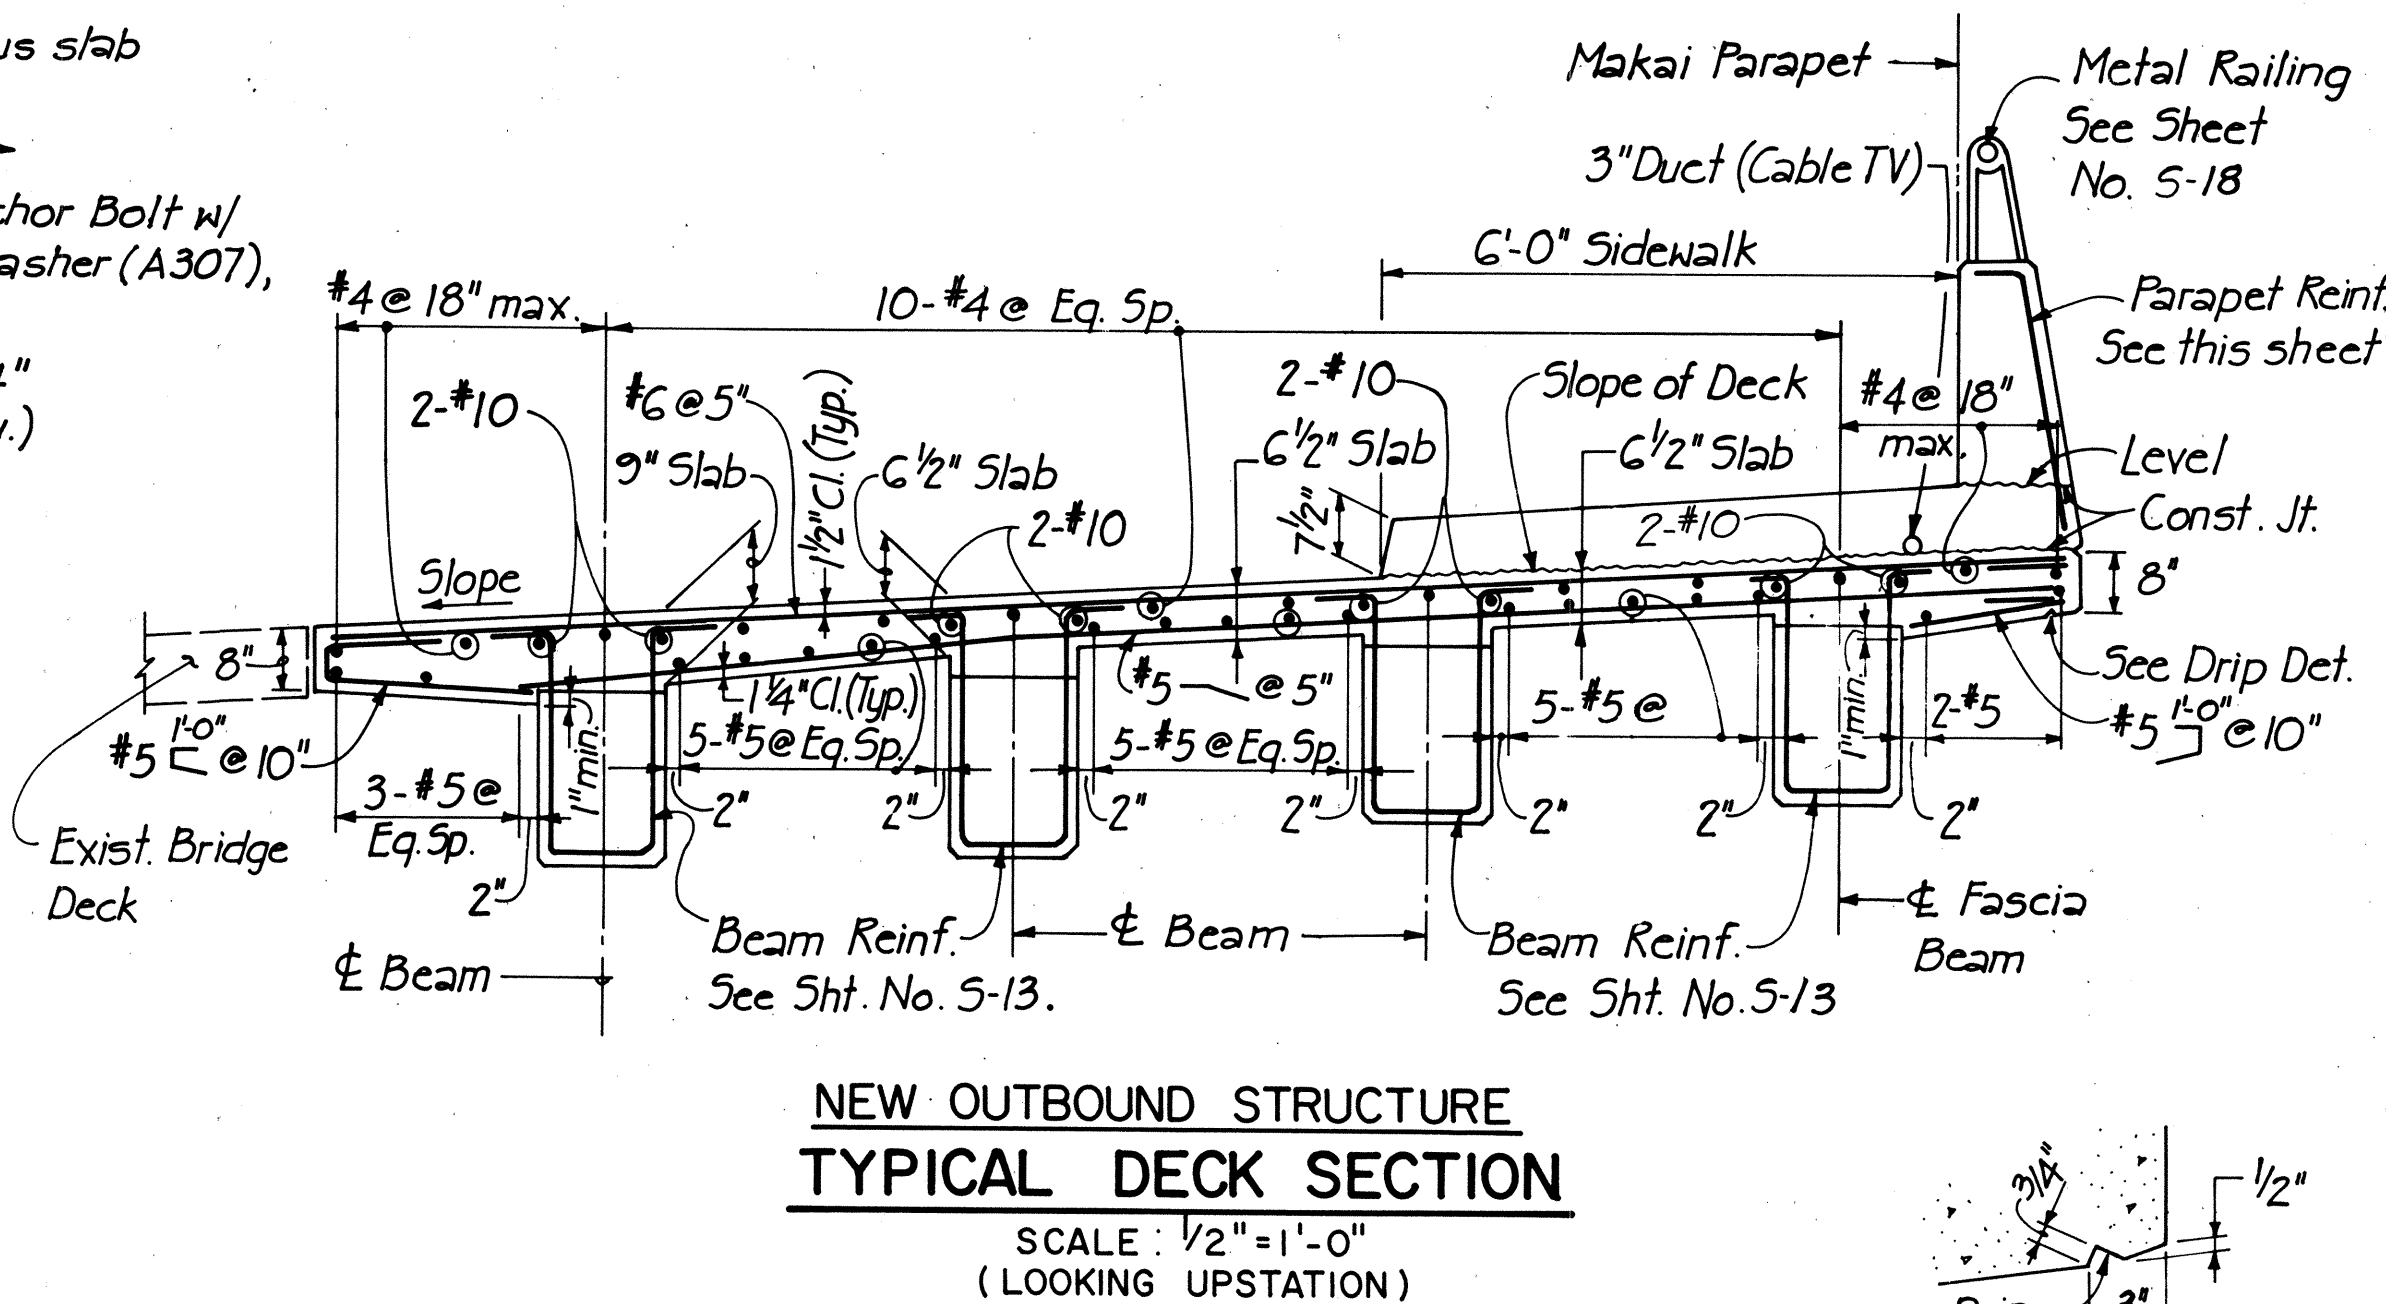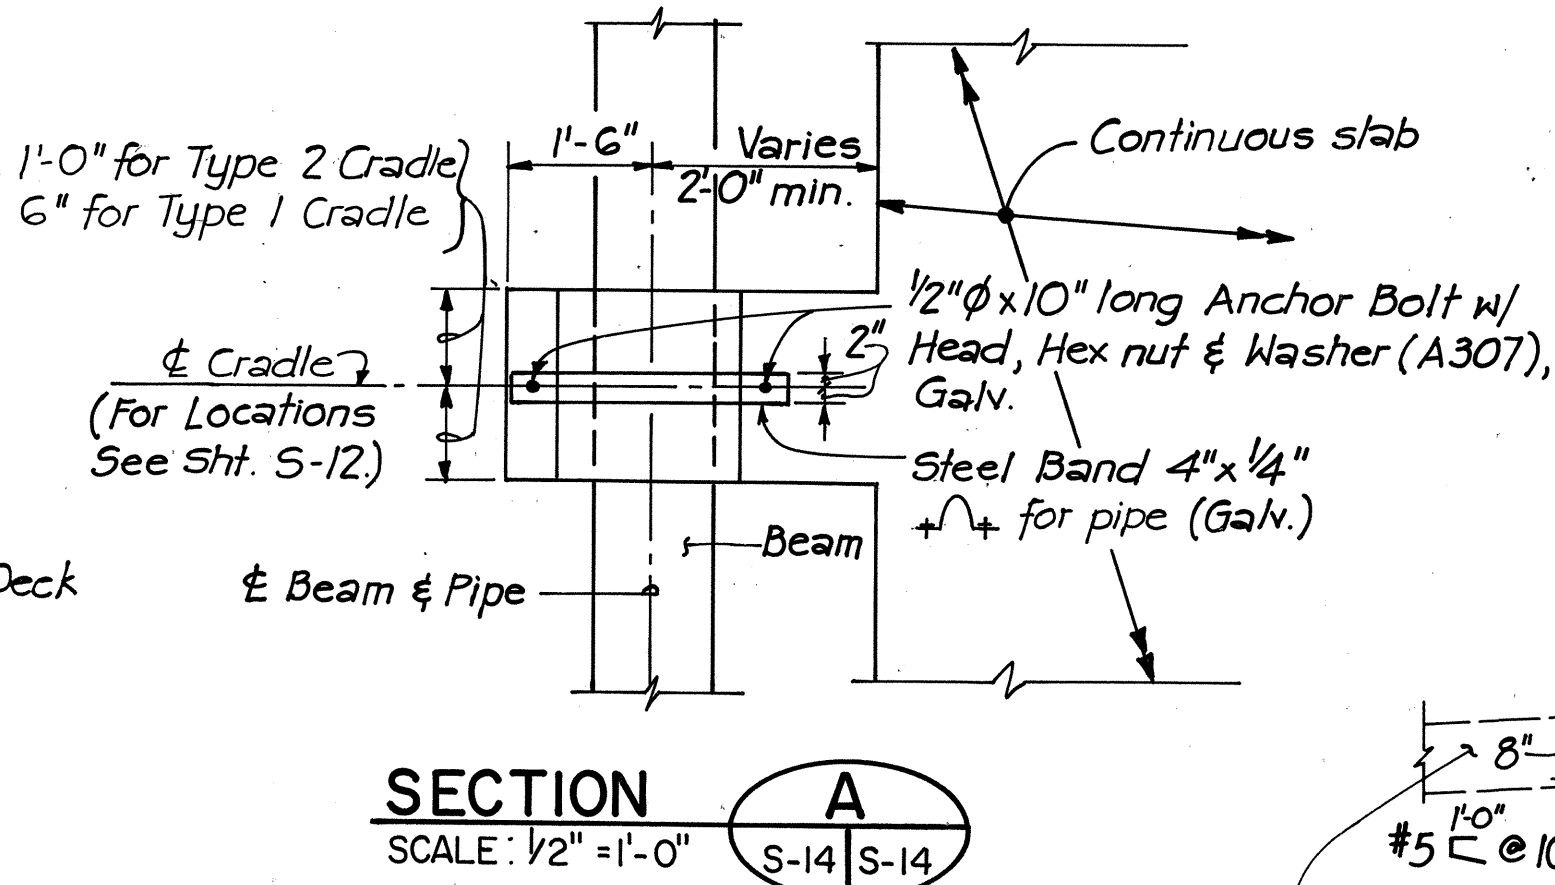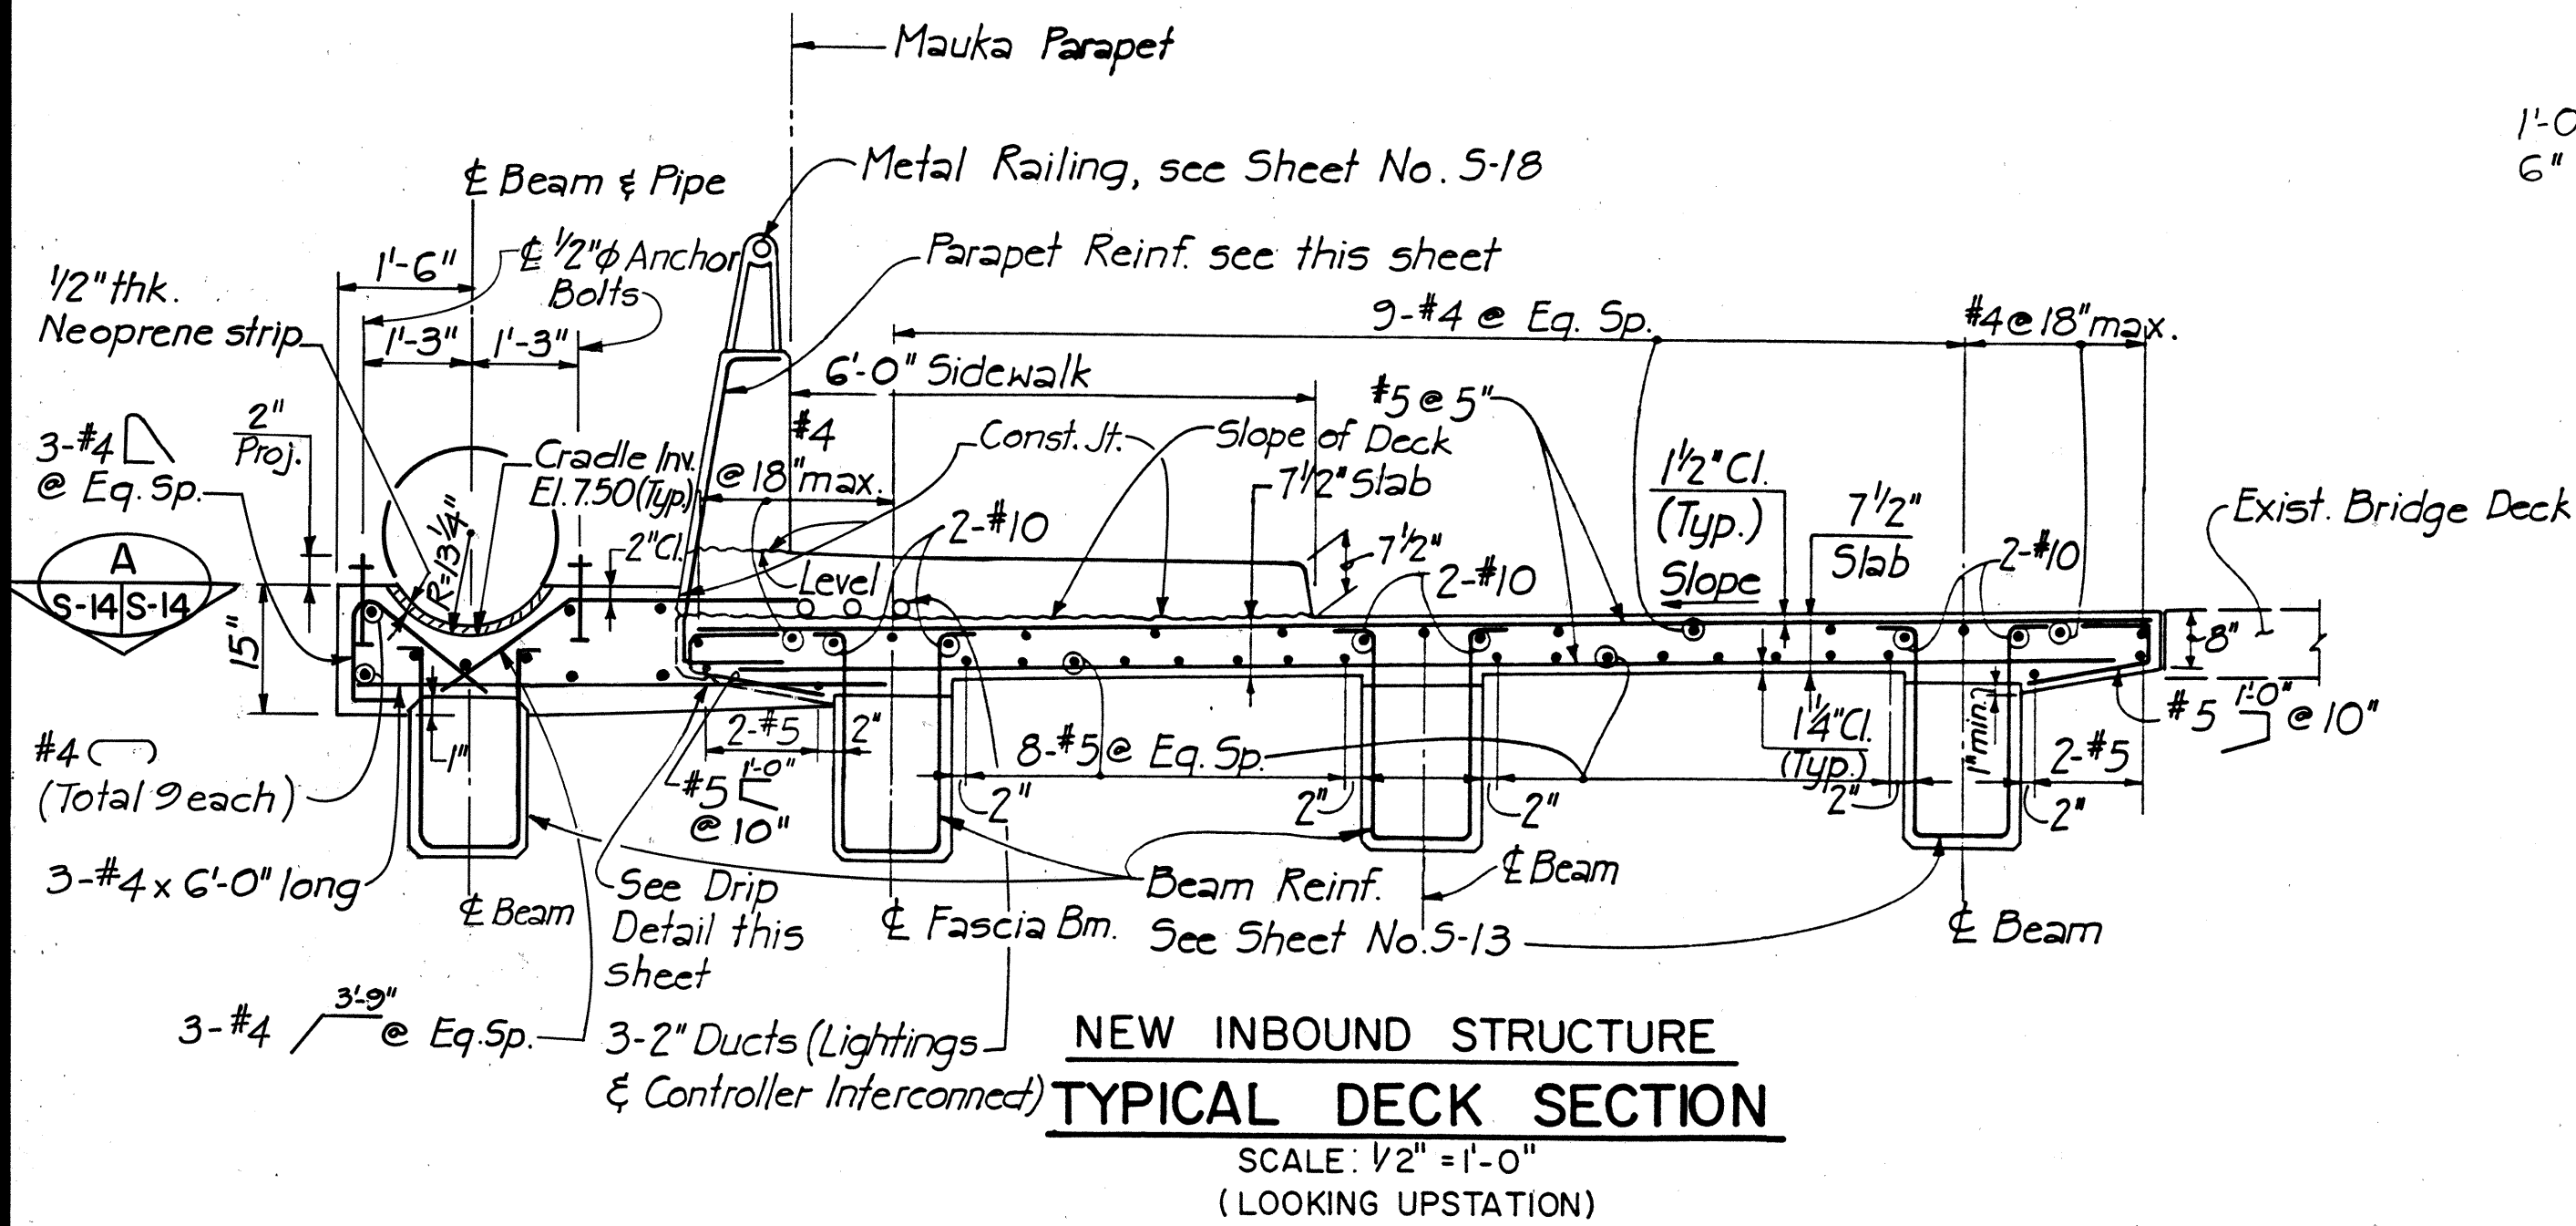

DECK REINFORCING PLAN
NOT TO SCALE

NOTE: New I.B. Structure as shown.
New O.B. Structure similar
except opposite hand and
as noted.

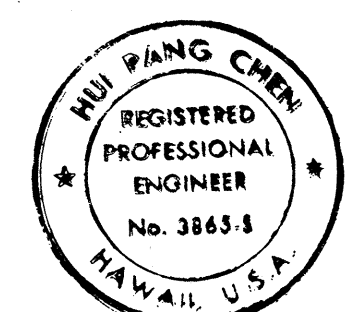


For *[Signature]* 10/24/91
Chief, Png. & Engr., B.W.S. Date

THIS WORK WAS PREPARED BY ME
OR UNDER MY SUPERVISION.
[Signature]

9/10/91	Revised Typical Deck Section of New I.B. Structure & Deck Reinf. Plan of New I.B. Structure. Added Section A to add 24" Water Line. S-14/S-14
DATE	REVISIONS
STATE OF HAWAII DEPARTMENT OF TRANSPORTATION HIGHWAYS DIVISION WAILUPE STREAM BRIDGE WIDENING DECK REINFORCING PLANS AND SECTIONS KALANIANA'OLE HIGHWAY Wailupe Circle to East Hind Drive FA. Project No. F-072-1 (34) -A SCALE: As shown DATE: JUNE 30, 1990 SHEET No. S-14 OF 19 SHEETS	

DATE	
SURVEY PLOTTED BY	
DRAWN BY	
DESIGNED BY	
QUANTITIES BY	
CHECKED BY	
ORIGINAL PLAN	
NOTE BOOK	
No.	

FED. ROAD DIST. NO.	STATE	FED. AID PROJ. NO.	FISCAL YEAR	SHEET NO.	TOTAL SHEETS
HAWAII	HAW.	F-0720-1(34)-A	1990	171	186

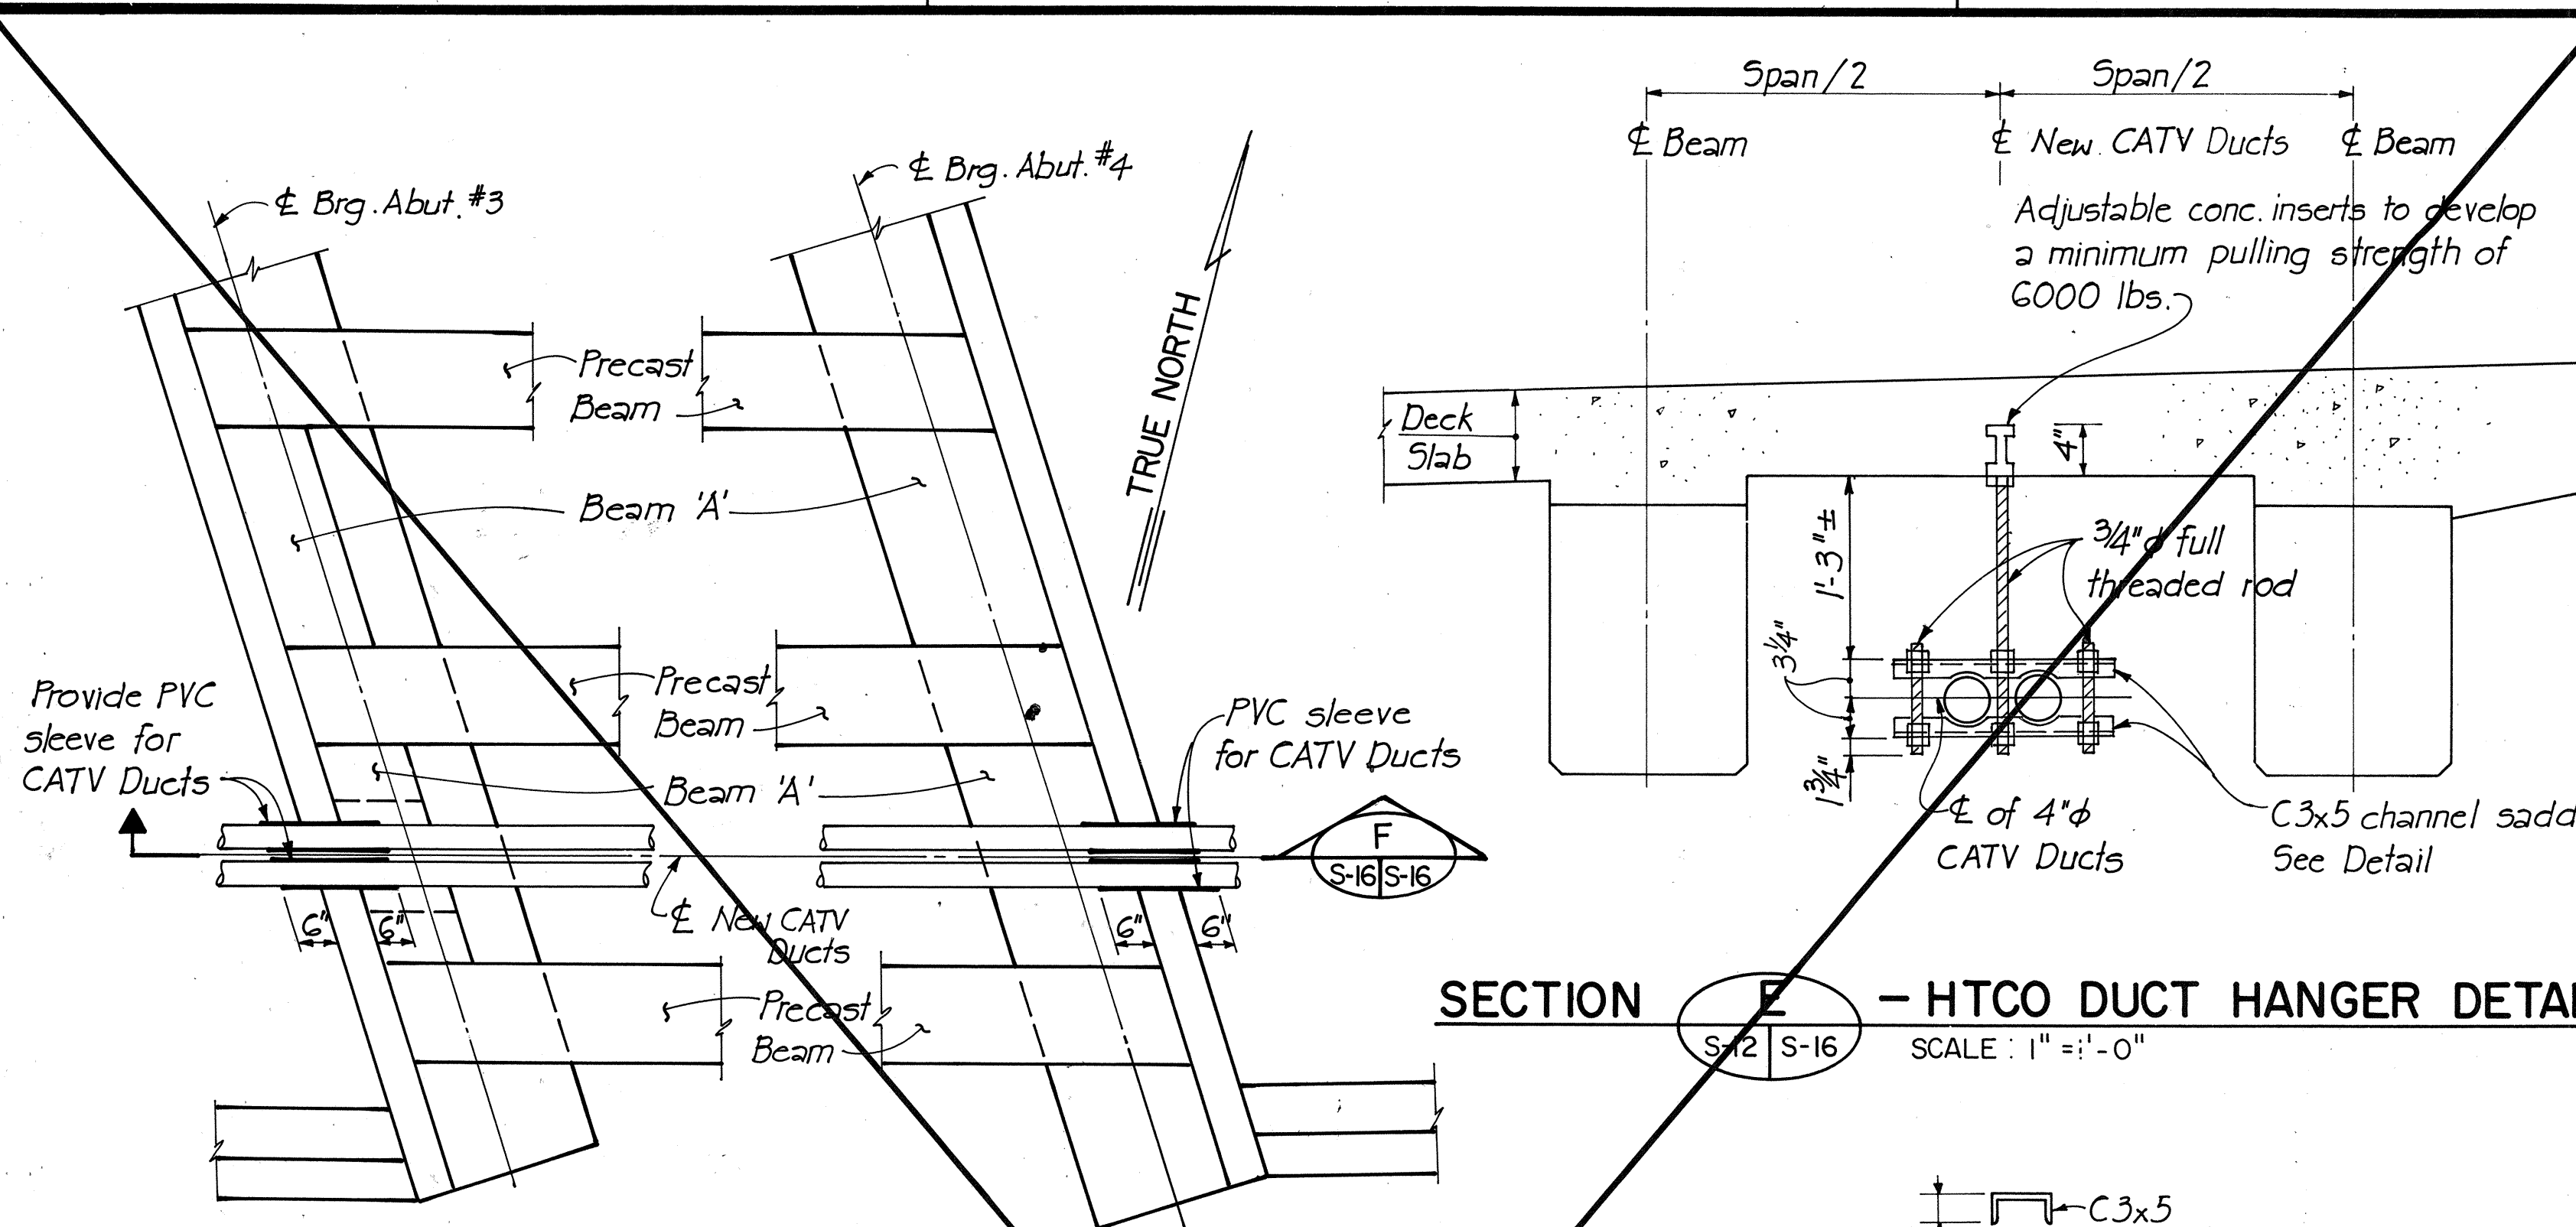


PLAN - NEW CATV DUCTS THROUGH ABUTMENTS


SCALE: 1/2" = 1'-0"

SECTION E - HTCO DUCT HANGER DETAIL


SCALE: 1" = 1'-0"

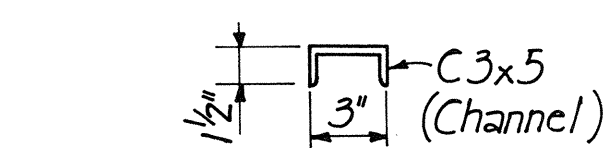

SECTION

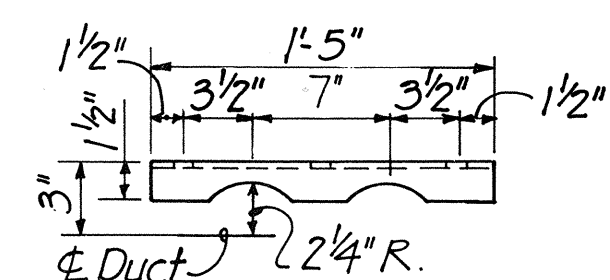

ELEVATION

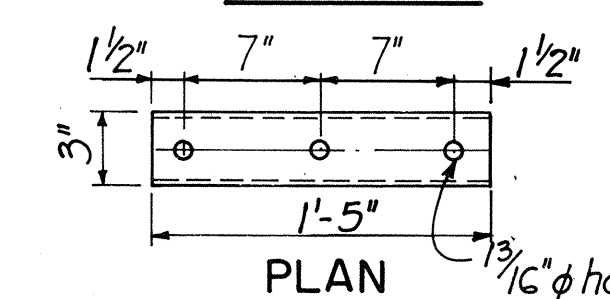


PLAN

3" CHANNEL SADDLE HANGER


DETAIL 2

N.T.S.

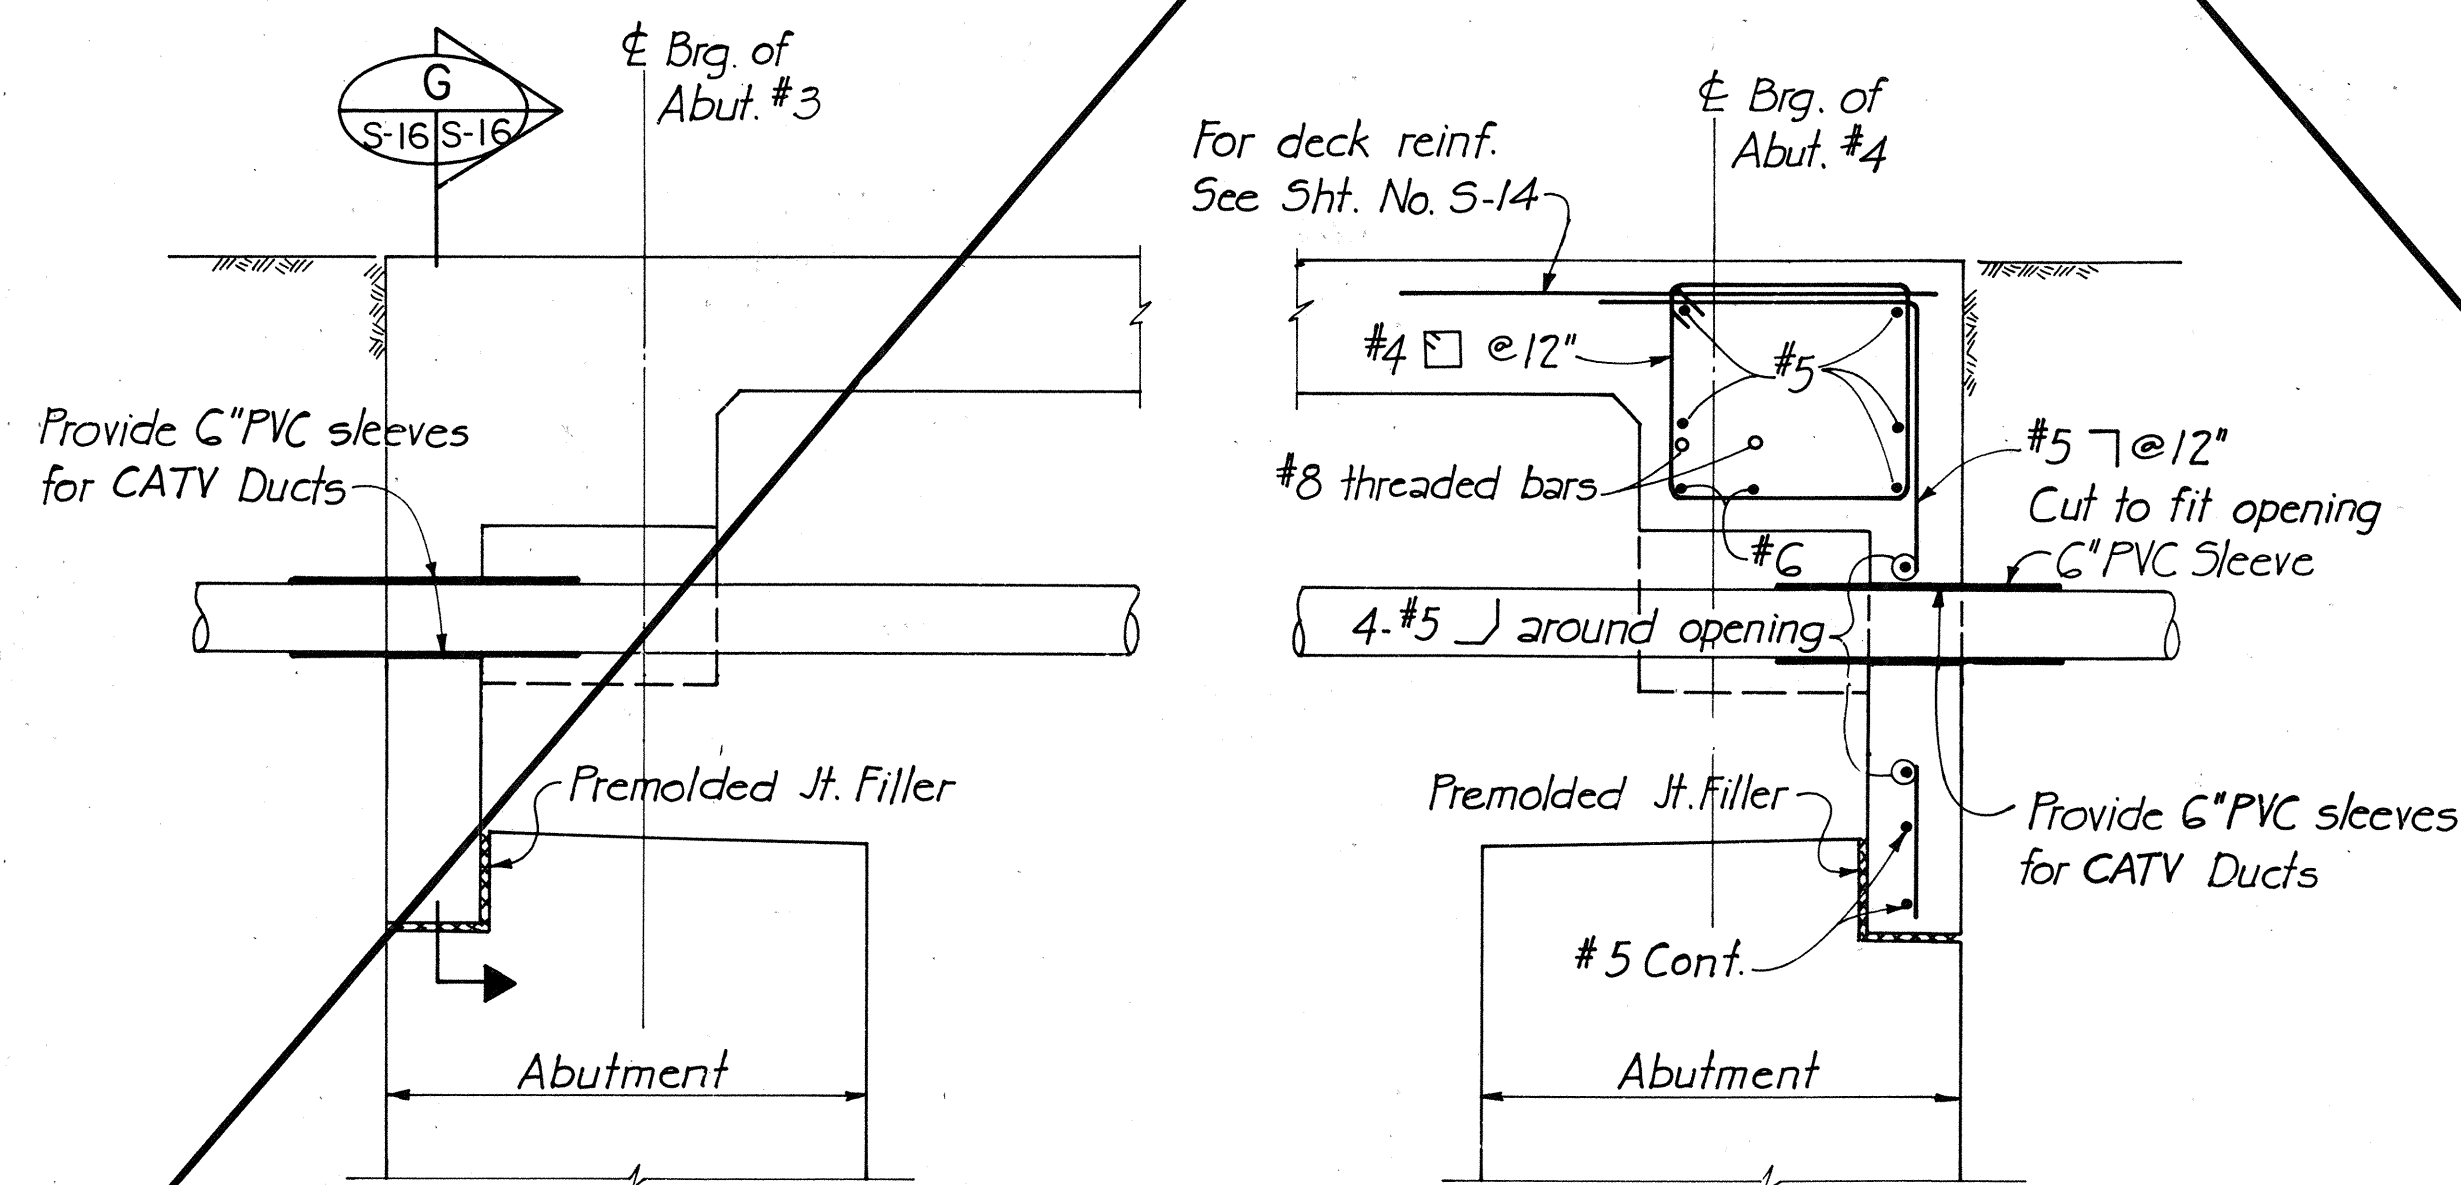


SECTION F

SCALE: 1" = 1'-0"

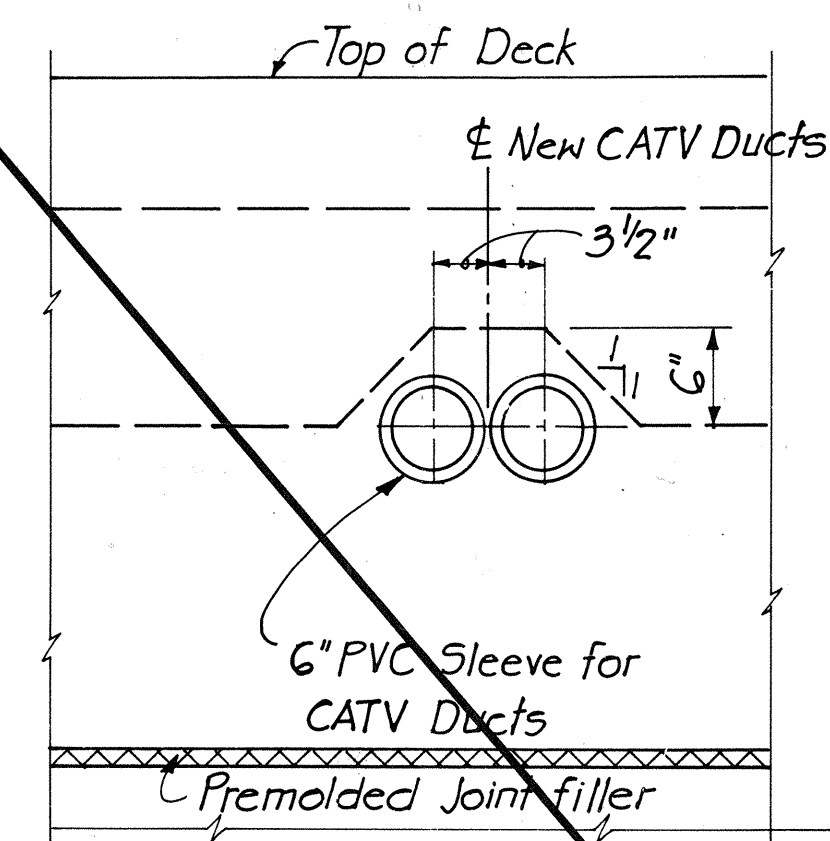

SECTION G

SCALE: 1" = 1'-0"

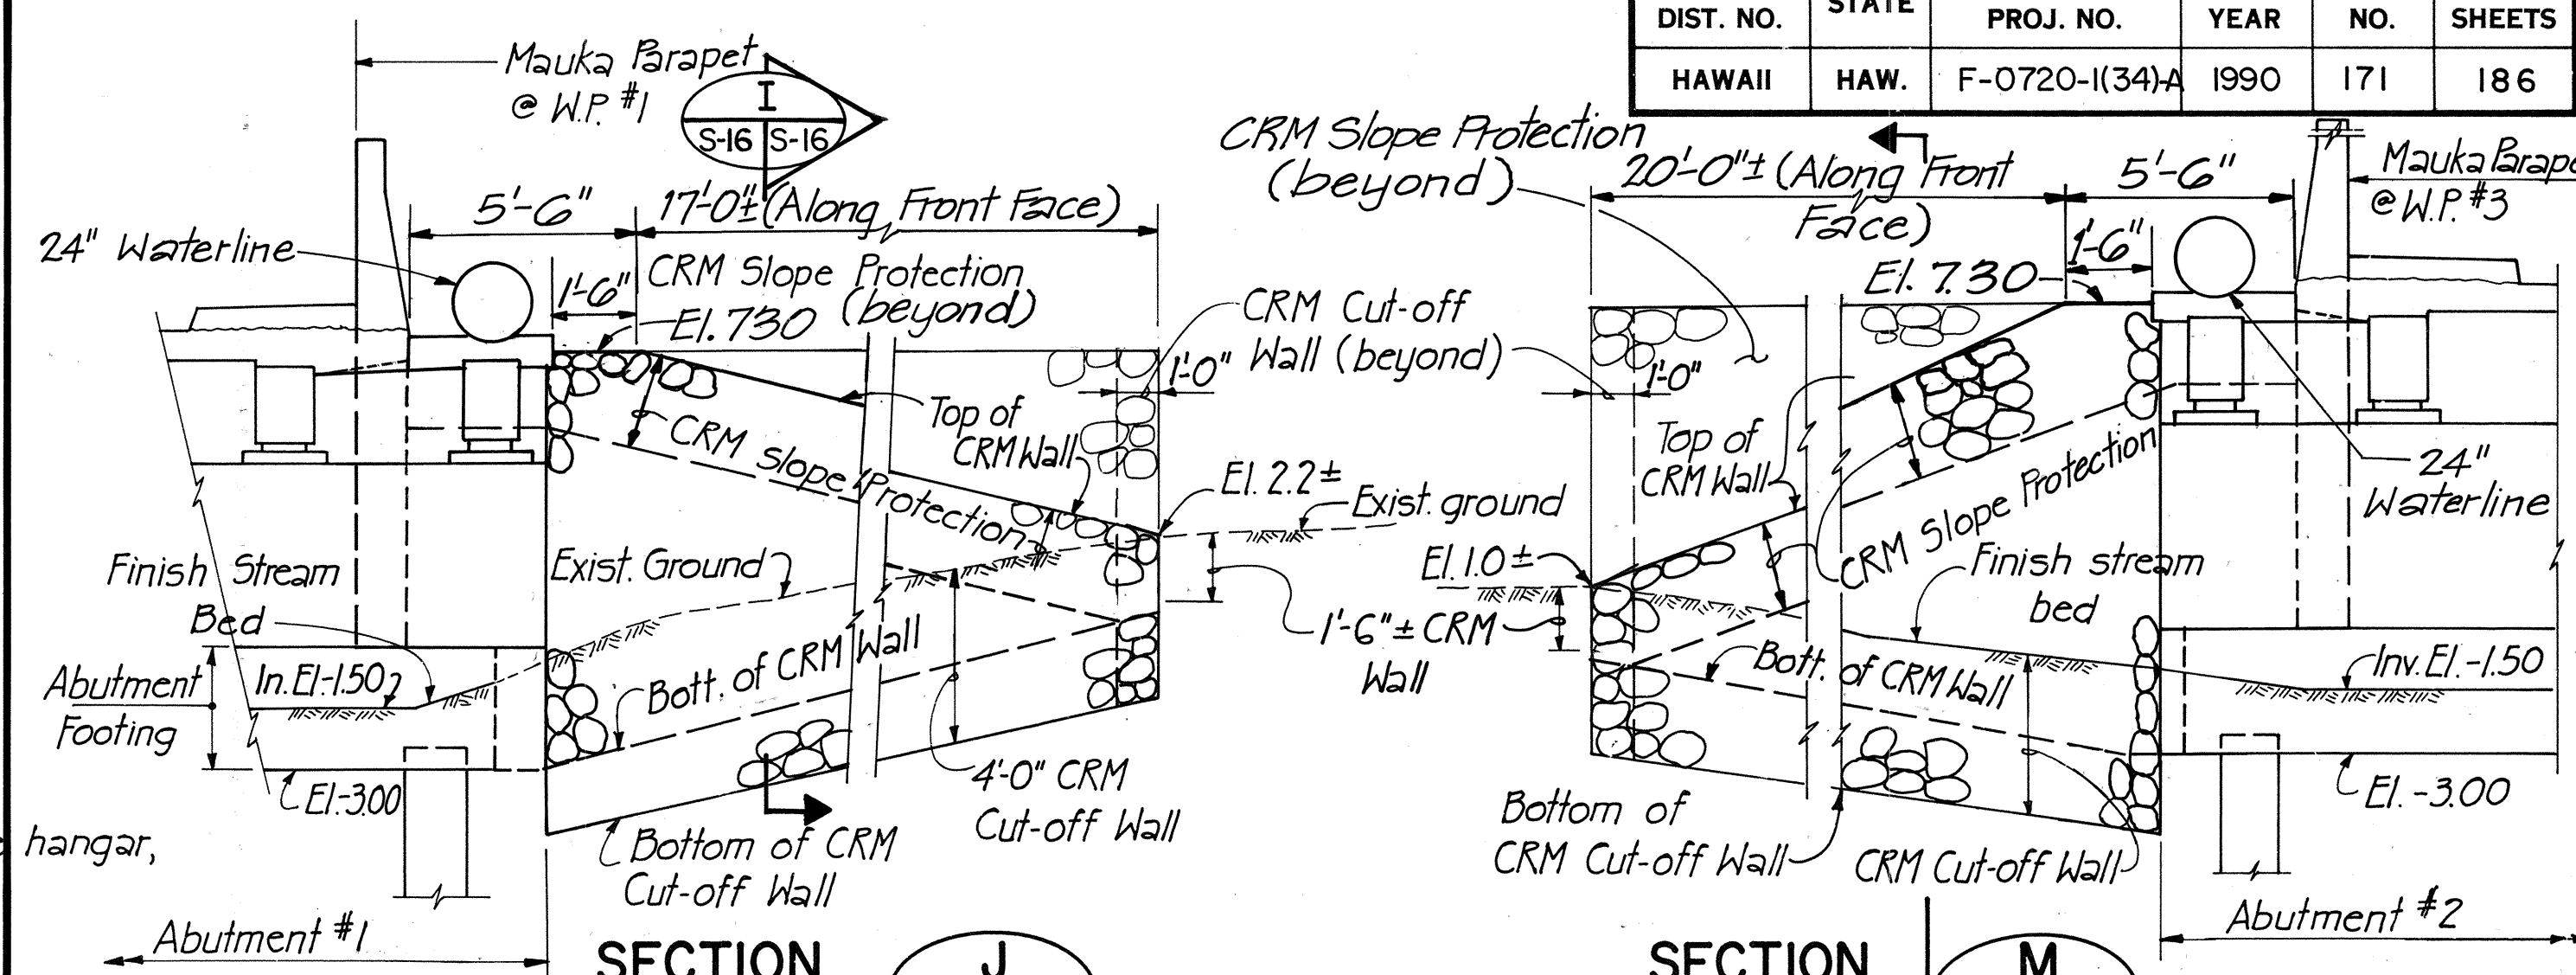


SECTION J

S-5 S-16

SECTION M

S-5 S-16

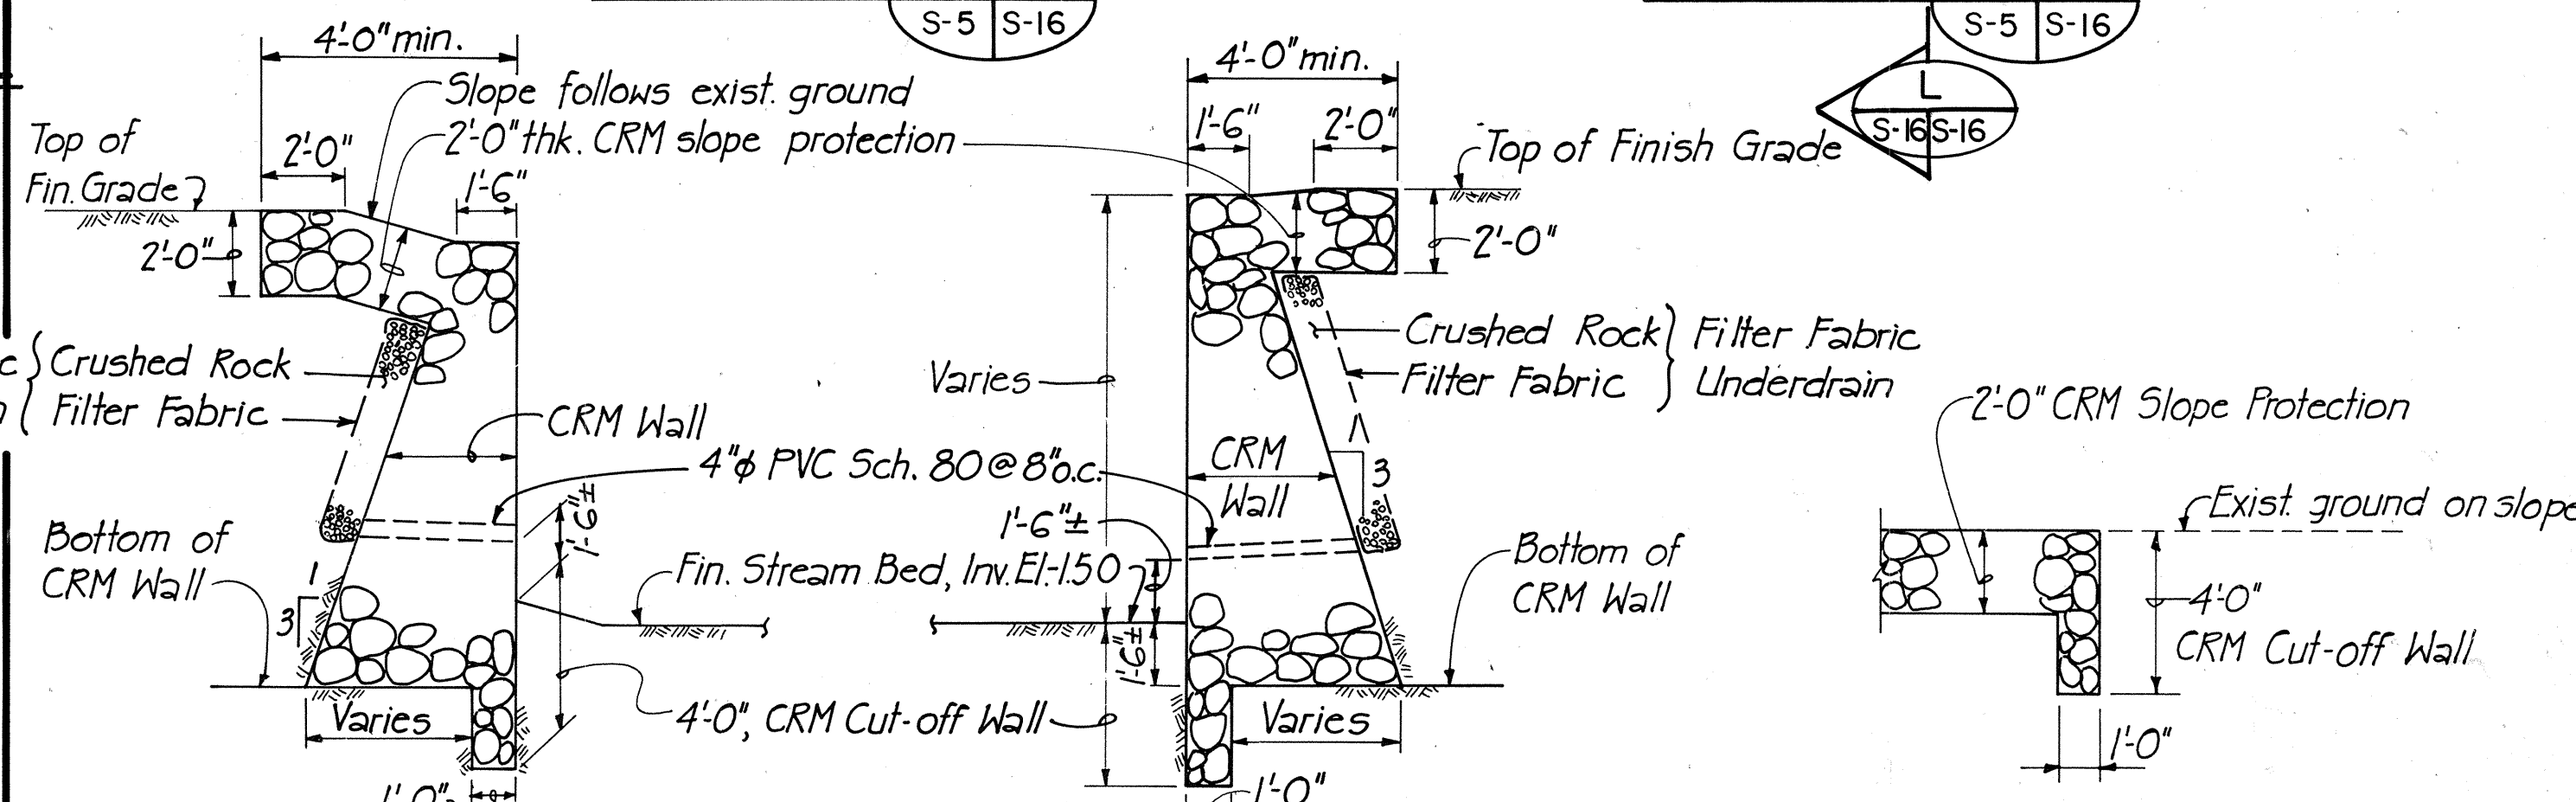

SECTION H


S-5 S-16

SECTION K

S-5 S-16

SECTION N

S-5 S-16

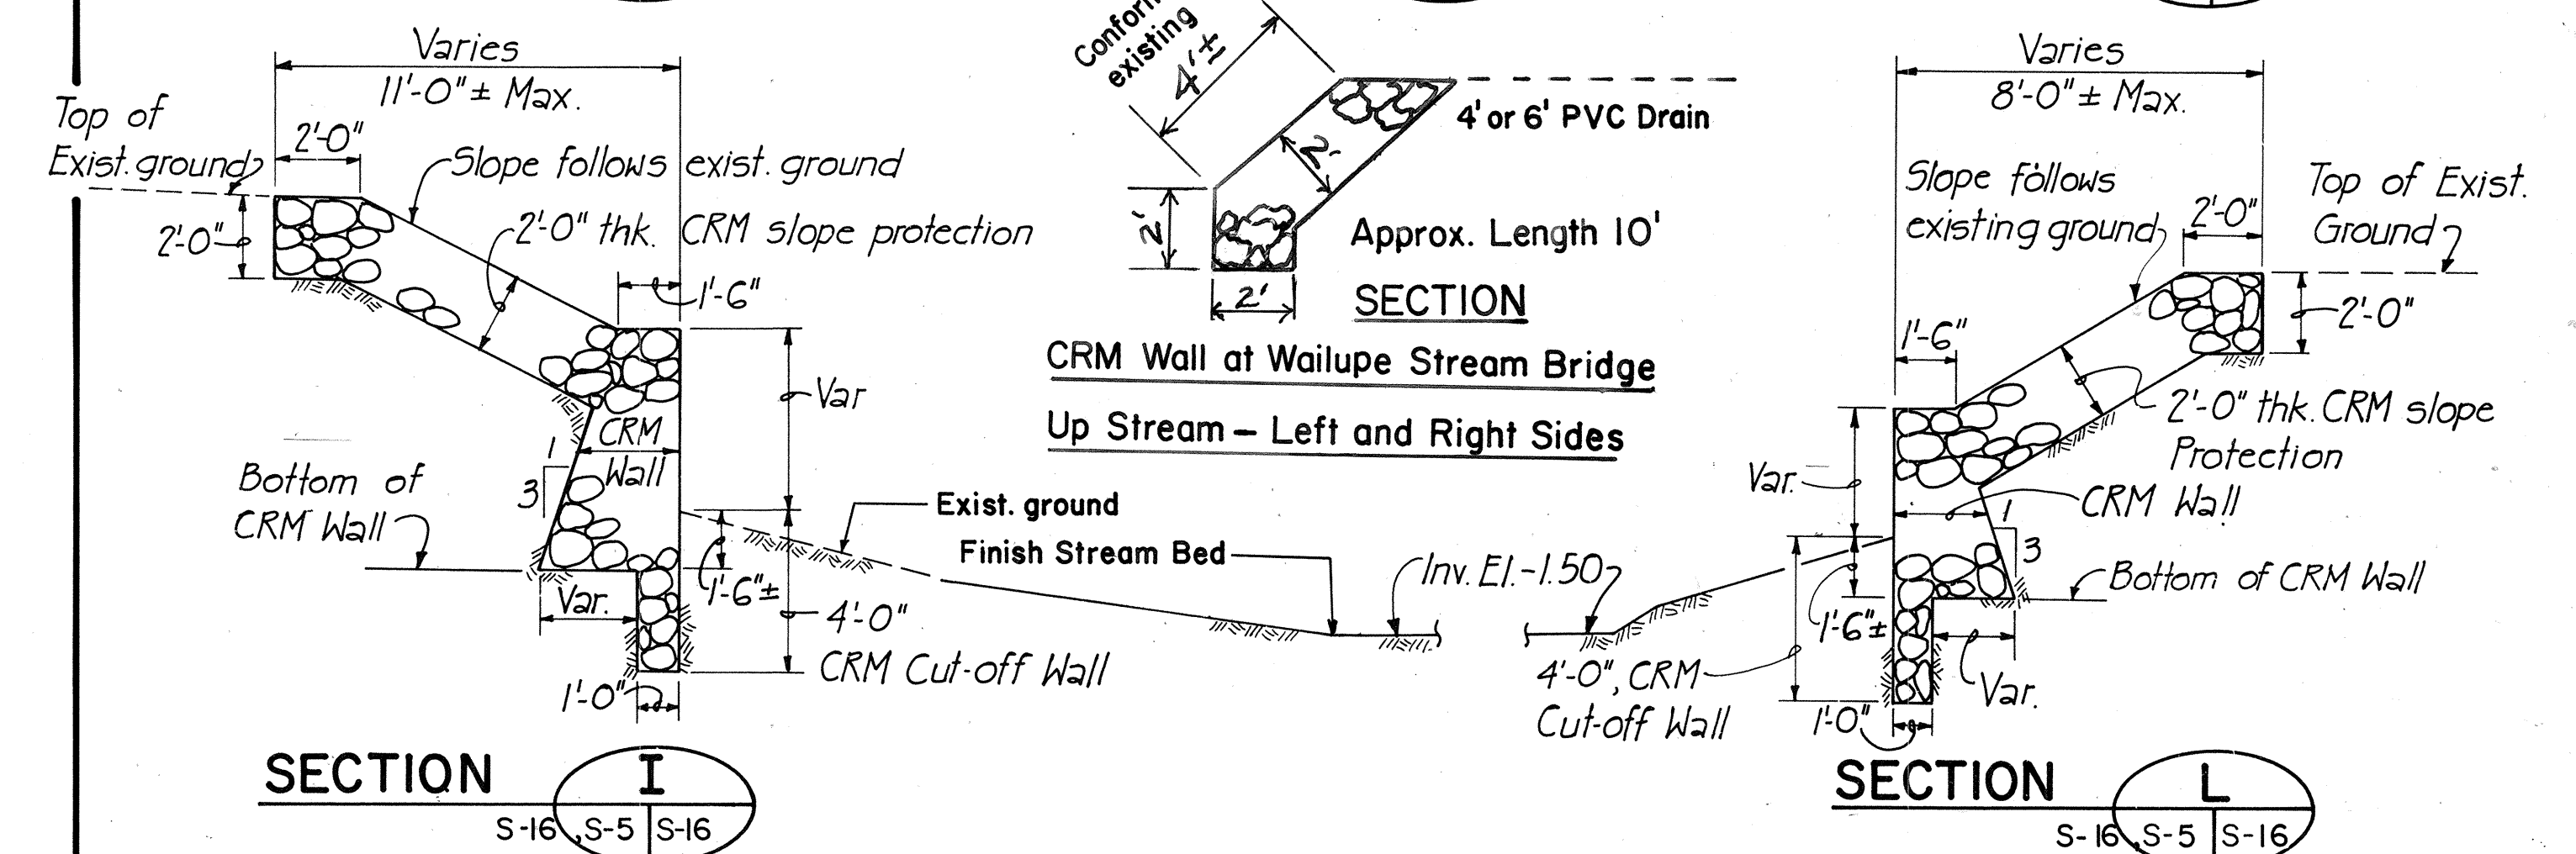

SECTION I


S-16 S-5 S-16

SECTION L

S-16 S-5 S-16

CRM SLOPE PROTECTION DETAILS

SCALE: 1/4" = 1'-0"

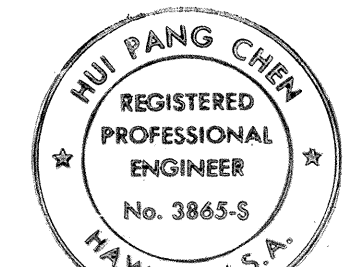


THIS WORK WAS PREPARED BY ME OR UNDER MY SUPERVISION.

Hui Pang Chen

DATE	REVISIONS
9/10/91	Revised Sections to add 24" Water Line
	J S-5 S-16 M S-5 S-16

STATE OF HAWAII
DEPARTMENT OF TRANSPORTATION
HIGHWAYS DIVISION
WAILUPE STREAM BRIDGE WIDENING
MISCELLANEOUS DETAILS
SHEET 2 OF 3
KALANIANA'OLE HIGHWAY
Wailupe Circle to East Hind Drive
FA. Project No. F-072-1 (34) - A
SCALE: As shown DATE: JUNE 30, 1990
SHEET No. S-16 OF 19 SHEETS


FED. ROAD DIST. NO.	STATE	FED. AID PROJ. NO.	FISCAL YEAR	SHEET NO.	TOTAL SHEETS
HAWAII	HAW.	F-072-1(34)-A	1990	172	186

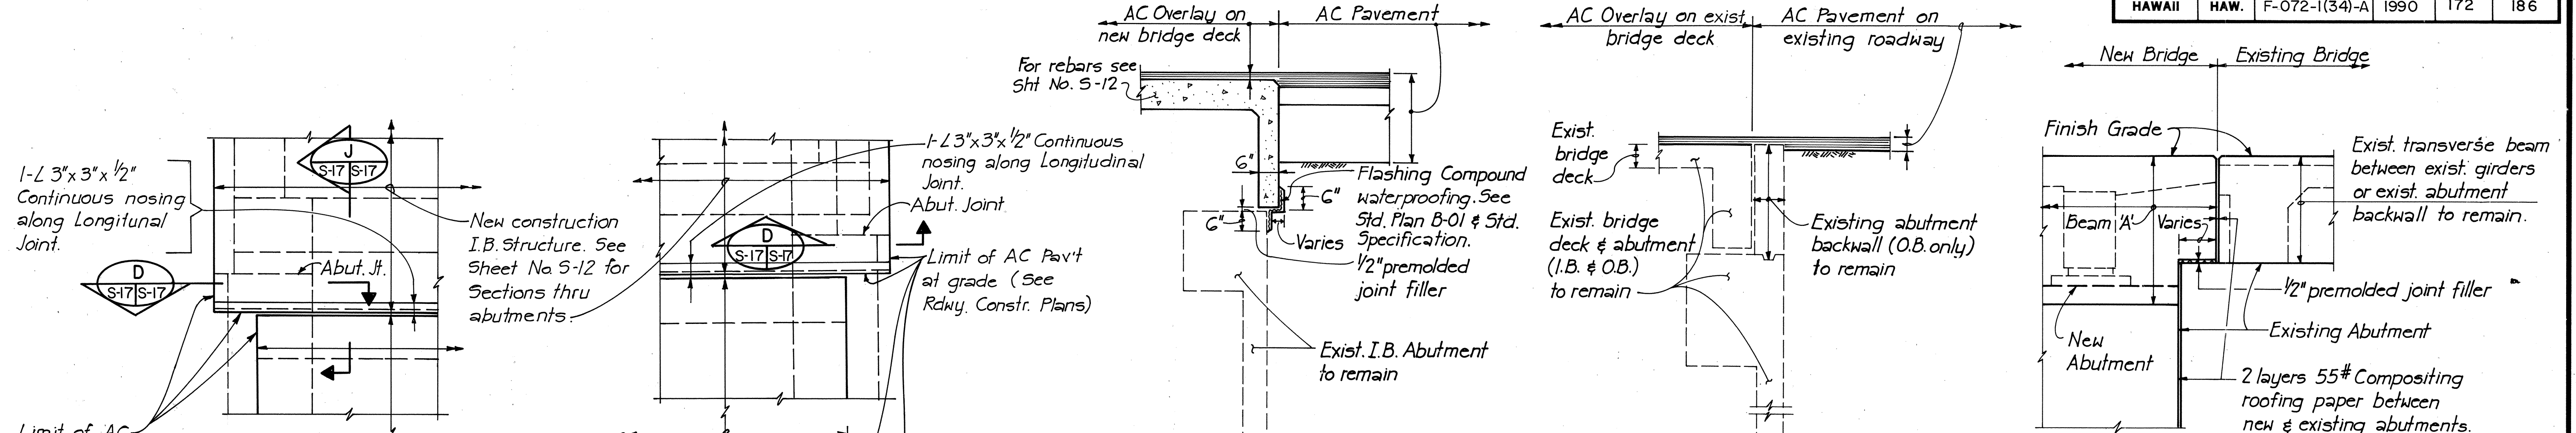

SECTION D
SCALE: 1/2" = 1'-0" S-17 S-17

SECTION F
SCALE: 1/2" = 1'-0" S-17 S-17


SECTION H
SCALE: 1/2" = 1'-0" S-17 S-17 (TYPICAL SECTION THRU BEAM 'A' & EXIST. STRUCTURE)

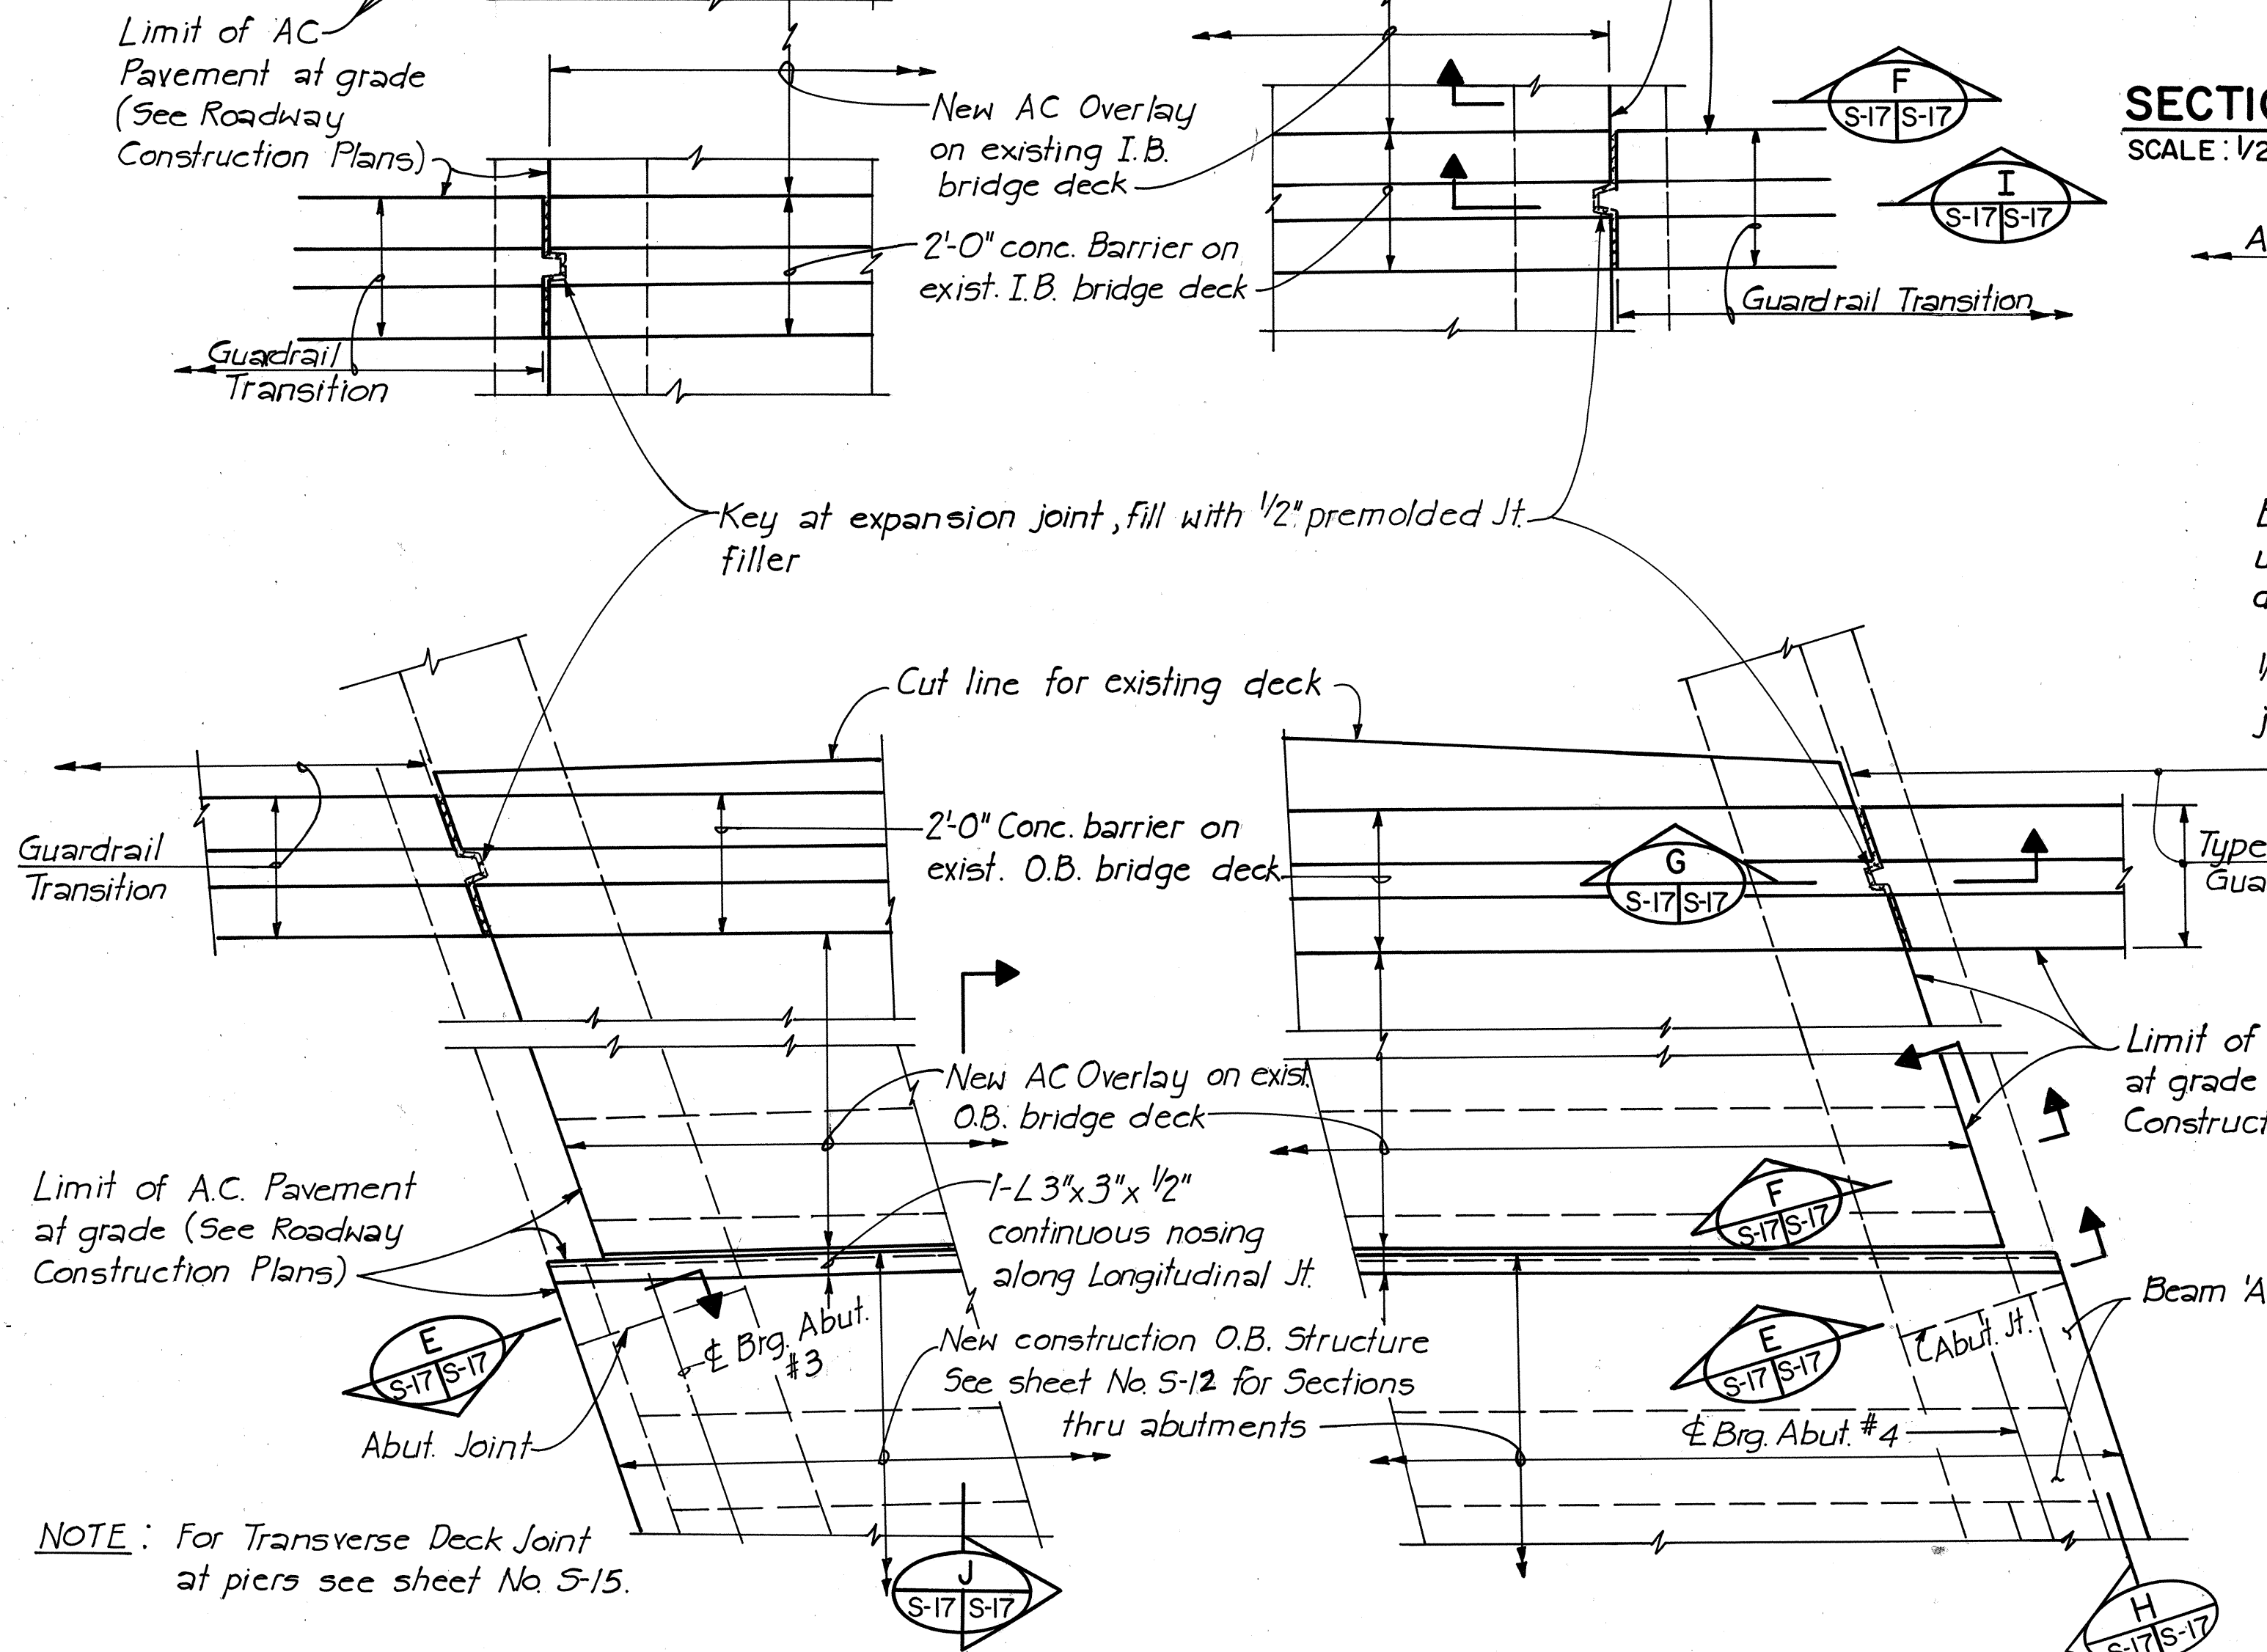

SECTION E
SCALE: 1/2" = 1'-0" S-17 S-17

SECTION G
SCALE: 1/2" = 1'-0" S-17 S-17

SECTION I
SCALE: 1/2" = 1'-0" S-17 S-17

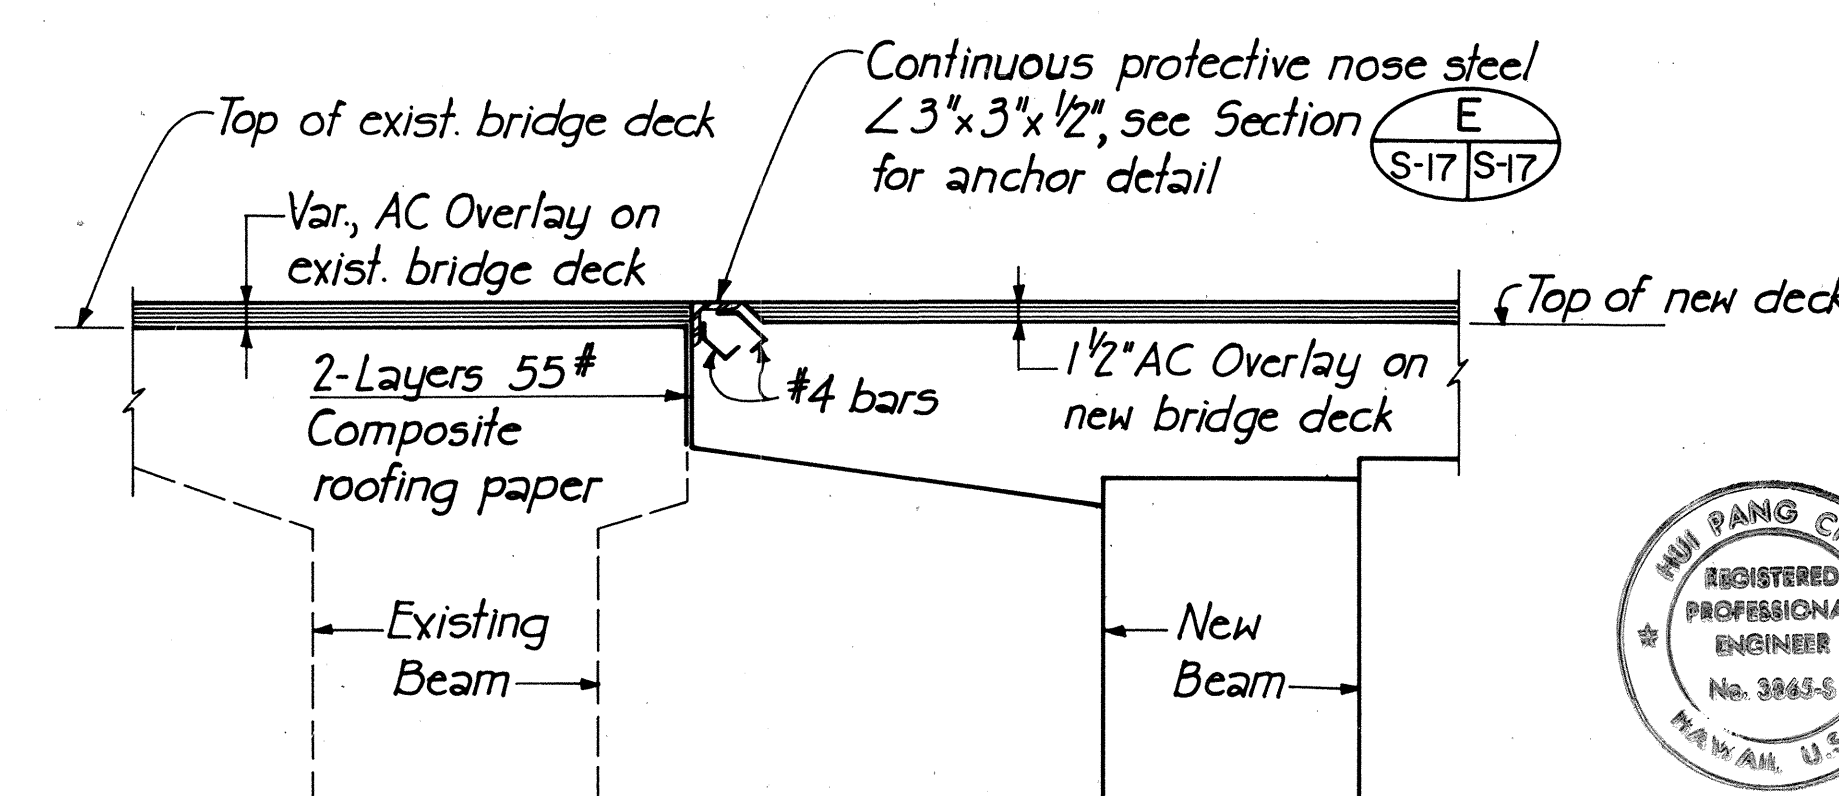

SECTION J
SCALE: 1" = 1'-0" S-17 S-17

PARTIAL DECK JOINT PLAN
SCALE: 1/2" = 1'-0"

NOTE: For Transverse Deck Joint at piers see sheet No S-15.

DATE	_____
SURVEY PLOTTED BY	_____
DESIGNED BY	_____
QUANTITIES BY	_____
CHECKED BY	_____
NO.	_____



THIS WORK WAS PREPARED BY ME OR UNDER MY SUPERVISION


Rui Pang Chen

STATE OF HAWAII
DEPARTMENT OF TRANSPORTATION
HIGHWAYS DIVISION
WAILUPE STREAM BRIDGE WIDENING
MISCELLANEOUS DETAILS
SHEET 3 OF 3
KALANIANA'OLE HIGHWAY
Wailupe Circle to East Hind Drive
FA. Project No. F-072-1(34)-A
SCALE: As shown DATE: JUNE 30, 1990
SHEET No. S-17 OF 19 SHEETS

FED. ROAD DIST. NO.	STATE	FED. AID PROJ. NO.	FISCAL YEAR	SHEET NO.	TOTAL SHEETS
HAWAII	HAW.	F-072-1(34)-A	1990	173S-1	186

GENERAL NOTES FOR PILE

- Concrete strengths (28-day compressive strength):
 - Standard pile: $f'_c = 6000$ psi
 - Pile build-up with driving: $f'_c = 6000$ psi
 - Pile build-up without driving: f'_c identical with footing or pile cap concrete.
- Reinforcing steel shall conform to the following ASTM specifications:
 - Bar reinforcement: ASTM A615, Grade 60
 - Spiral reinforcement: ASTM A82.
 - Prestressing strand: ASTM A416 Grade 270.
- Splice Can:
 - Structural steel shall conform to ASTM A36.
 - All welding shall meet the requirements of Section 501 of the Standard Specification.
 - No measurement for payment will be made for the splice can as it shall be considered incidental to the driving of the pile.
 - CJP = Complete Joint Penetration groove weld.
- The minimum working force in the prestressing steel shall be 165 kips (*after all losses*).
- Piles accepted by the Engineer shall be of sound concrete. Damaged piles shall be replaced or repaired as directed by the Engineer, at the Contractor's expense.
- Work of cutting off prestress concrete piles or concrete pile build-ups shall be performed in such a manner as to avoid spalling or damaging of the pile below cut-off. Damaged portions shall be removed and pile cut-off elevation lowered as directed by the Engineer.
- Top of pile at cut-off line shall be prepared as required for construction joints in Section 503 of the Standard Specifications.
- Pile splice will not be permitted, except for pile length in excess of 100 feet, unless otherwise approved by the Engineer.
- The in-place length of pile above the splice shall be approximately 50 percent of the total length of pile driven, unless location of splice is indicated in the plans or specifications.
- Build-ups may be driven after the concrete attains a compressive strength of 4000 psi, but not earlier than 7 days after the concrete is poured.

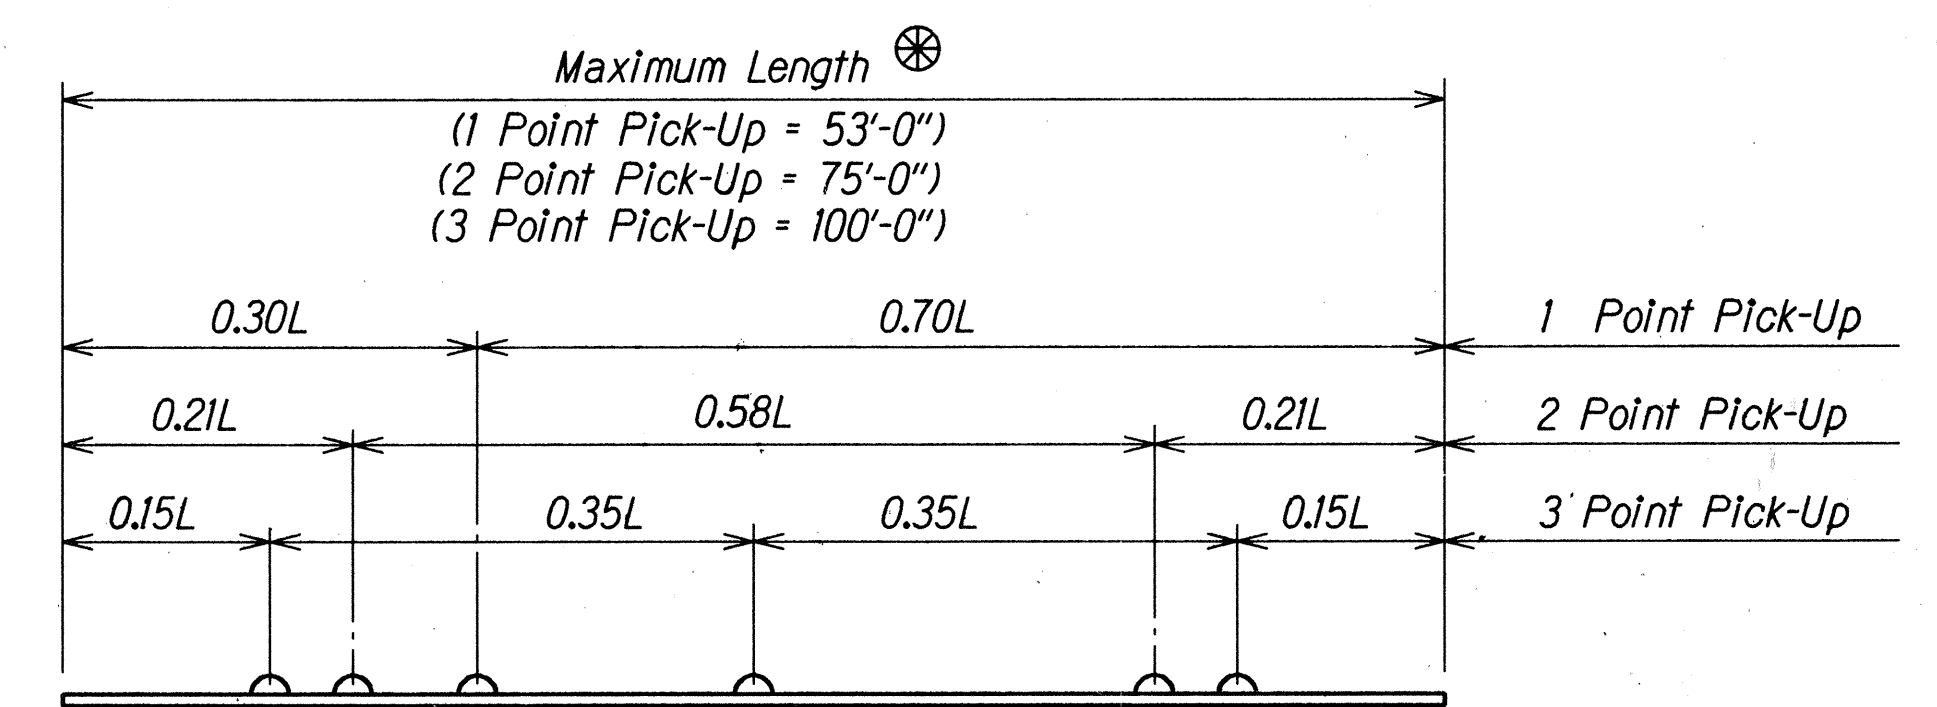

⊗ The length "L" is the distance end to end of pile.

PILE PICK-UP POINTS

STATE OF HAWAII

DEPARTMENT OF TRANSPORTATION

HIGHWAYS DIVISION

WAILUPE STREAM BRIDGE WIDENING

PRESTRESSED CONCRETE PILES

SHEET 1 OF 2

KALANIANA'OLE HIGHWAY

Wailupe Circle to East Hind Drive


FA Project No. F-072-1(34)-A

SCALE: As shown


DATE: JUNE 30, 1990

SHEET No. S-18A OF 19 SHEETS


DATE	REVISION

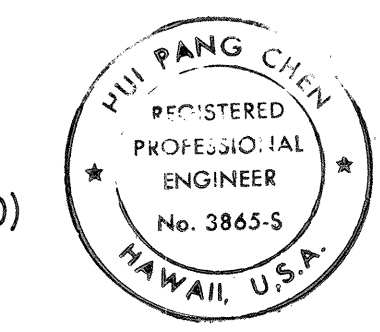


THIS WORK WAS PREPARED BY ME
OR UNDER MY SUPERVISION.
Hui Pang Chen

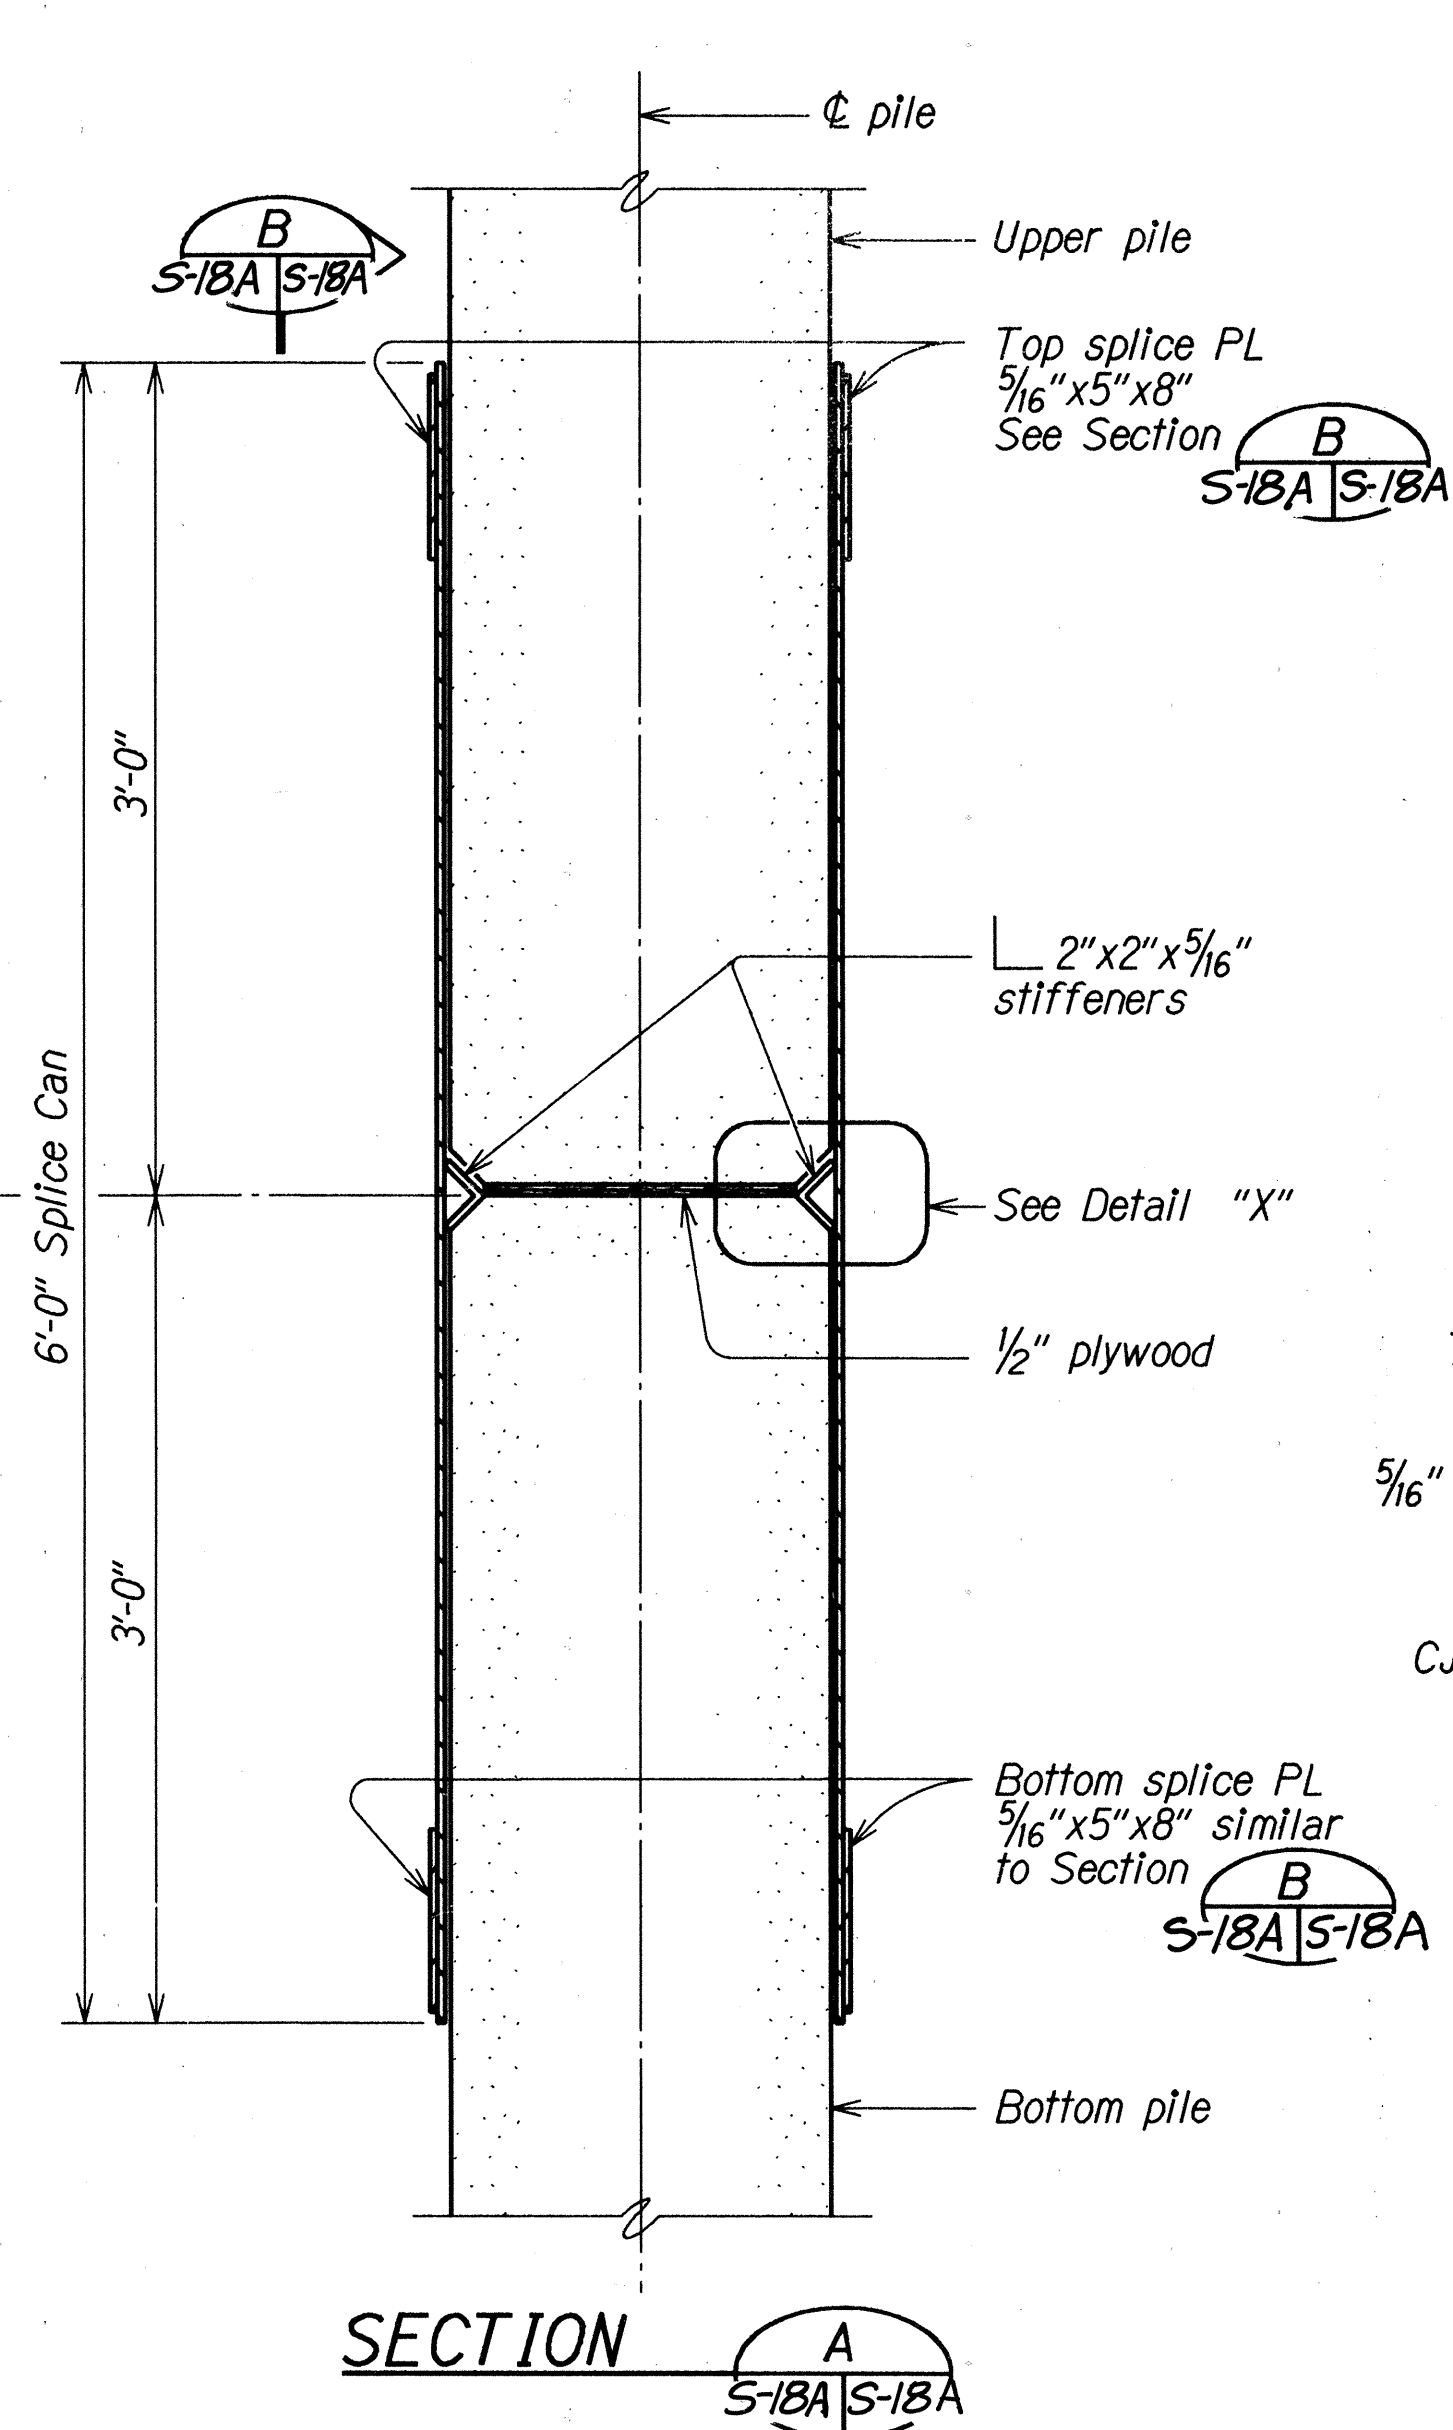

SECTION A
S-18A S-18A

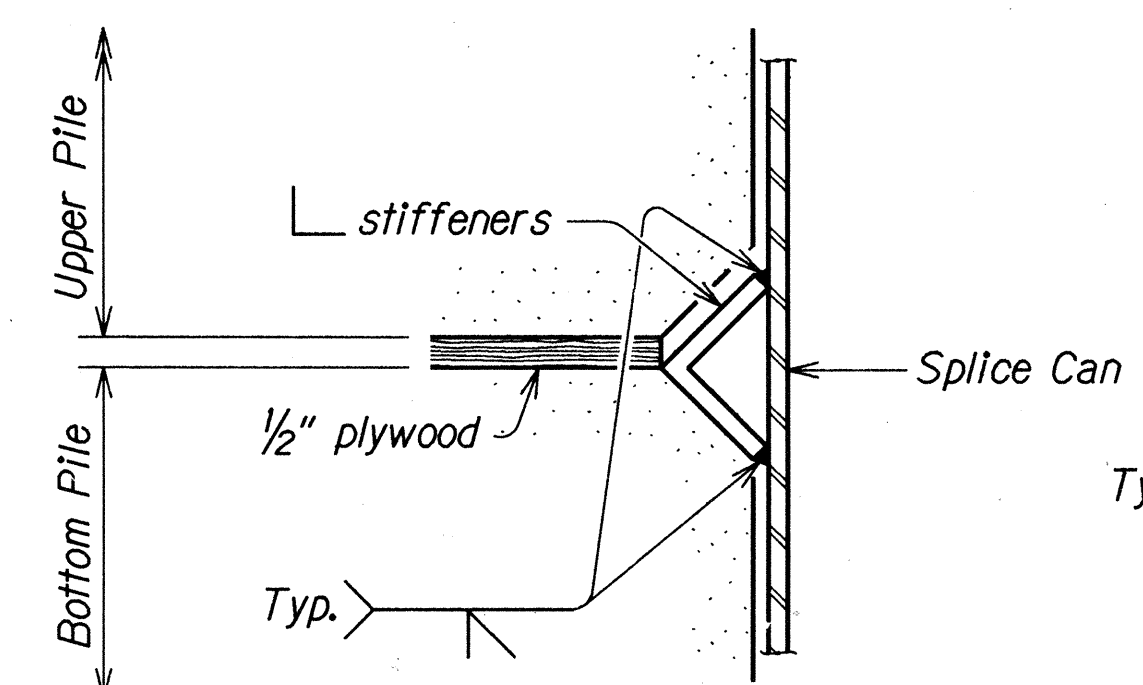


DETAIL "X"

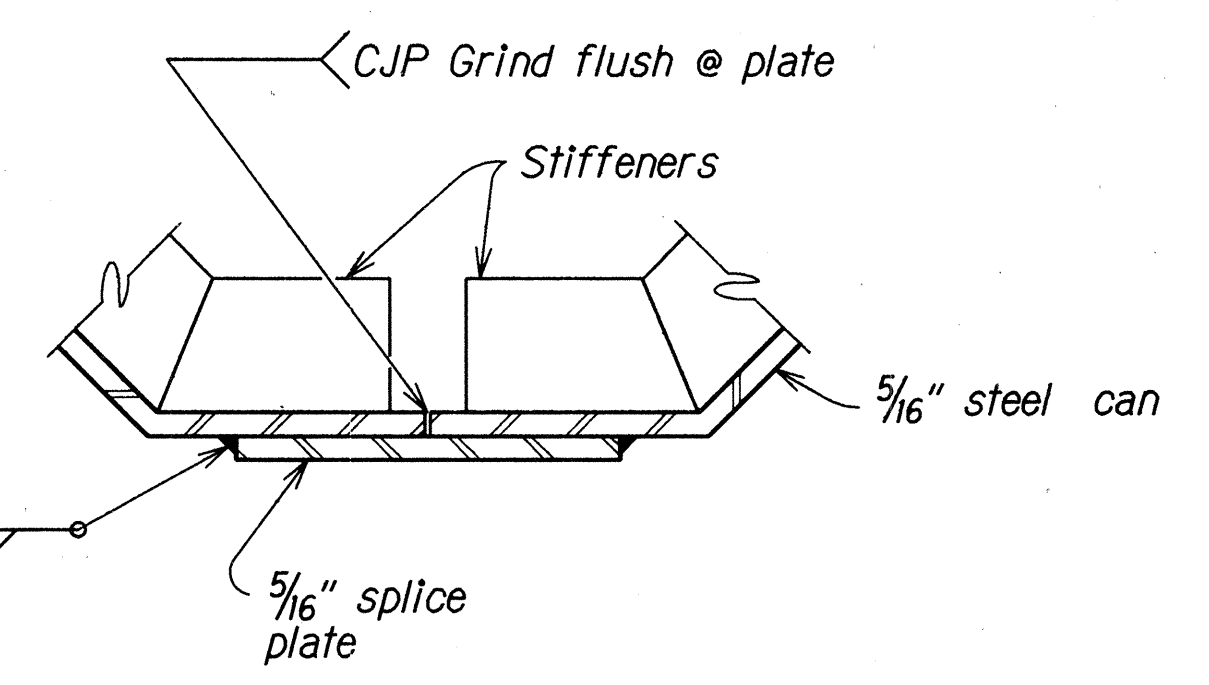

DETAIL "Y"

TYPICAL PILE SPLICE DETAILS


- NOTES:
- Test piles indicate bearing to be at -80.00 feet instead of -30.00 feet MSL (See sheet no. 160)
 - Revised pile tip elevation and pile length was increased to meet required pile bearing capacity.

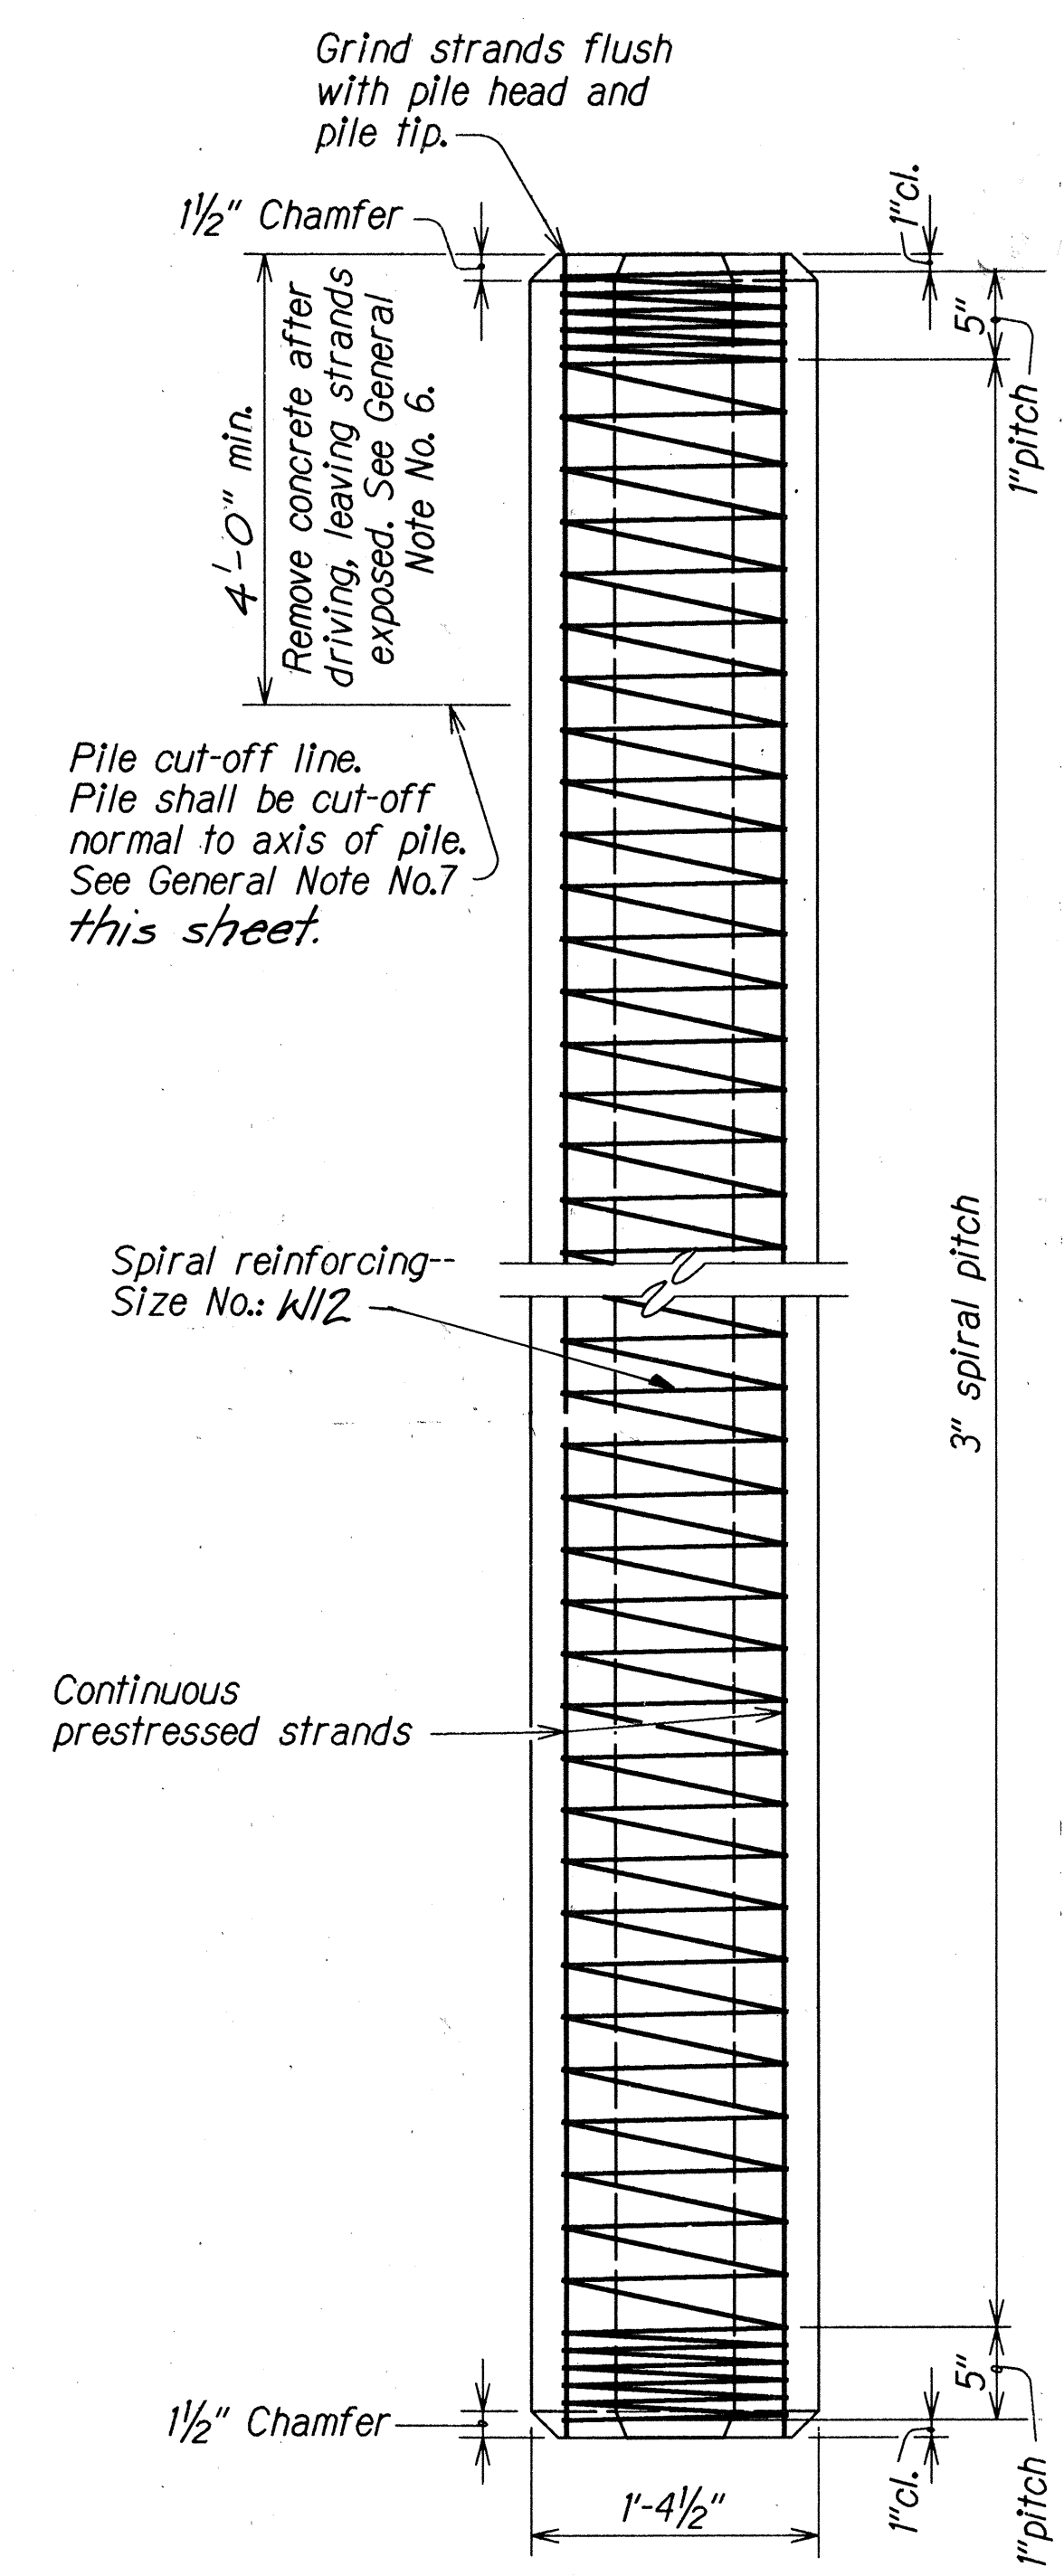

ELEVATION


SECTION

TYPICAL PILE DETAILS

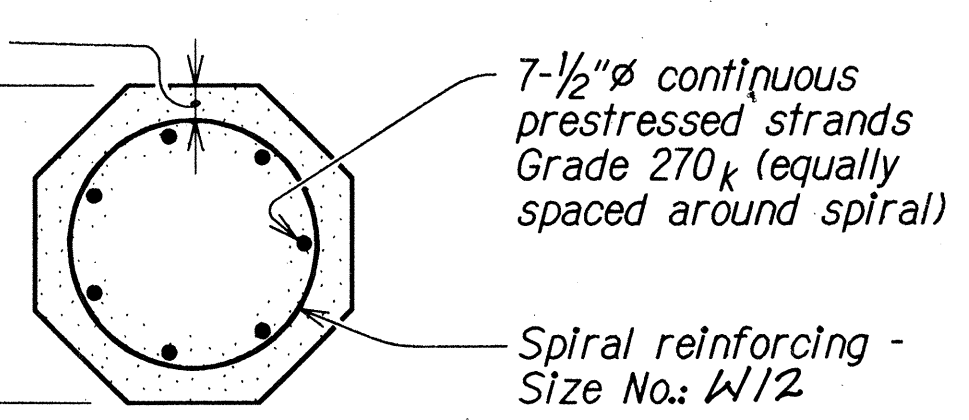


DESIGNED BY	DATE
DRAWN BY	
CHECKED BY	
ORIGINAL PLAN	
TRACED BY	
DESIGN FILE	
QUANTITIES BY	
CHECKED BY	
N.	


FED. ROAD DIST. NO.	STATE	FED. AID PROJ. NO.	FISCAL YEAR	SHEET NO.	TOTAL SHEETS
HAWAII	HAW.	F-072-1(34)-A	1990	173S-2	186

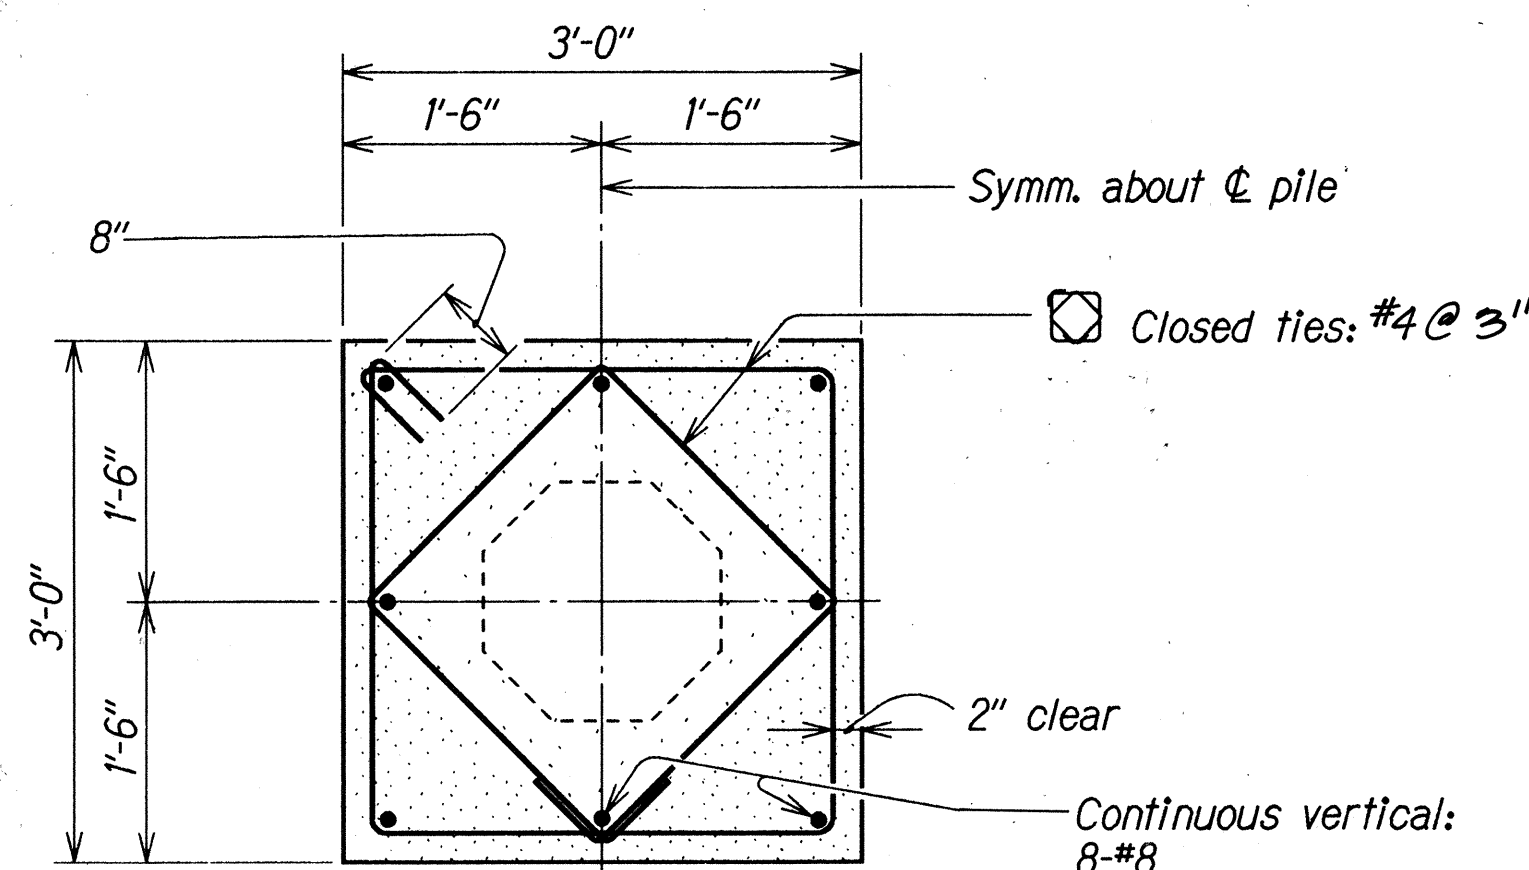


SQUARE BUILD-UP

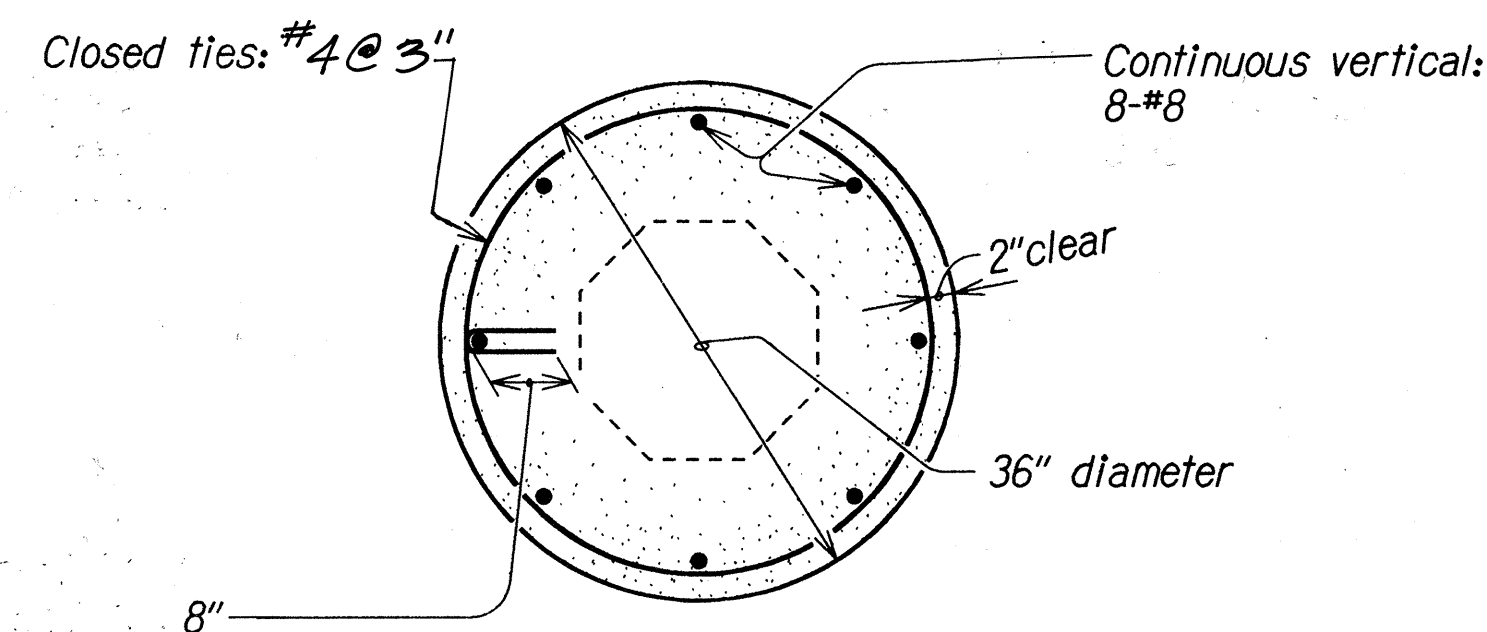

CIRCULAR BUILD-UP SECTION

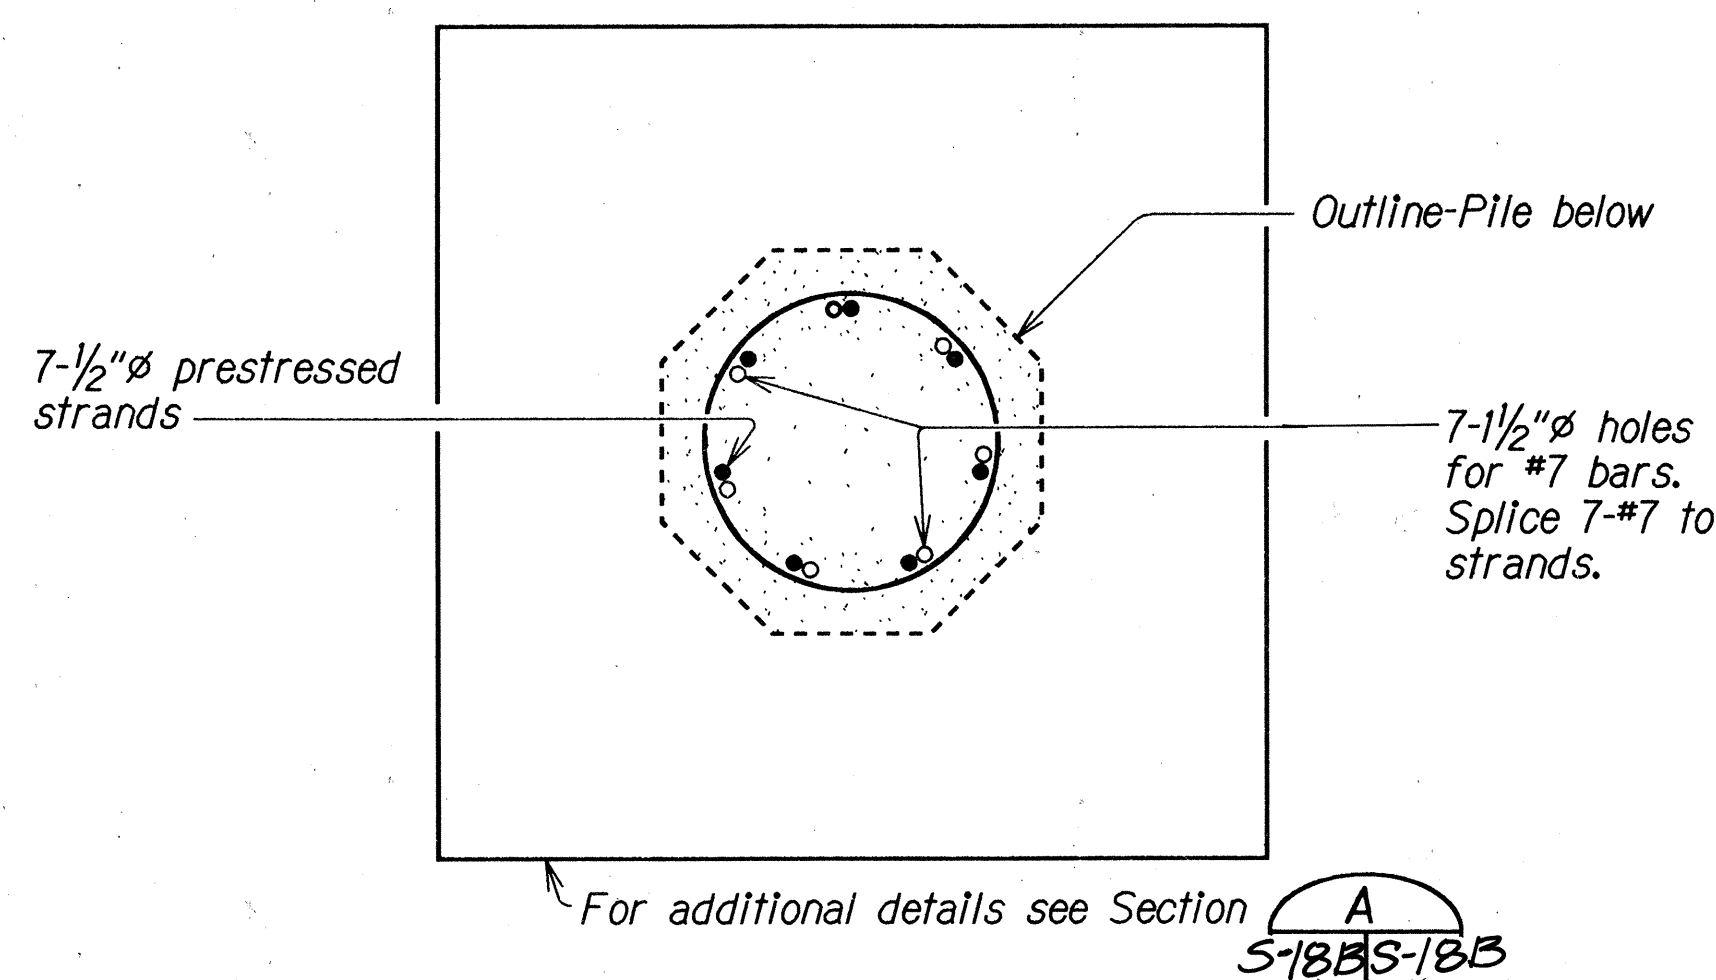


SECTION B S-18B S-18B

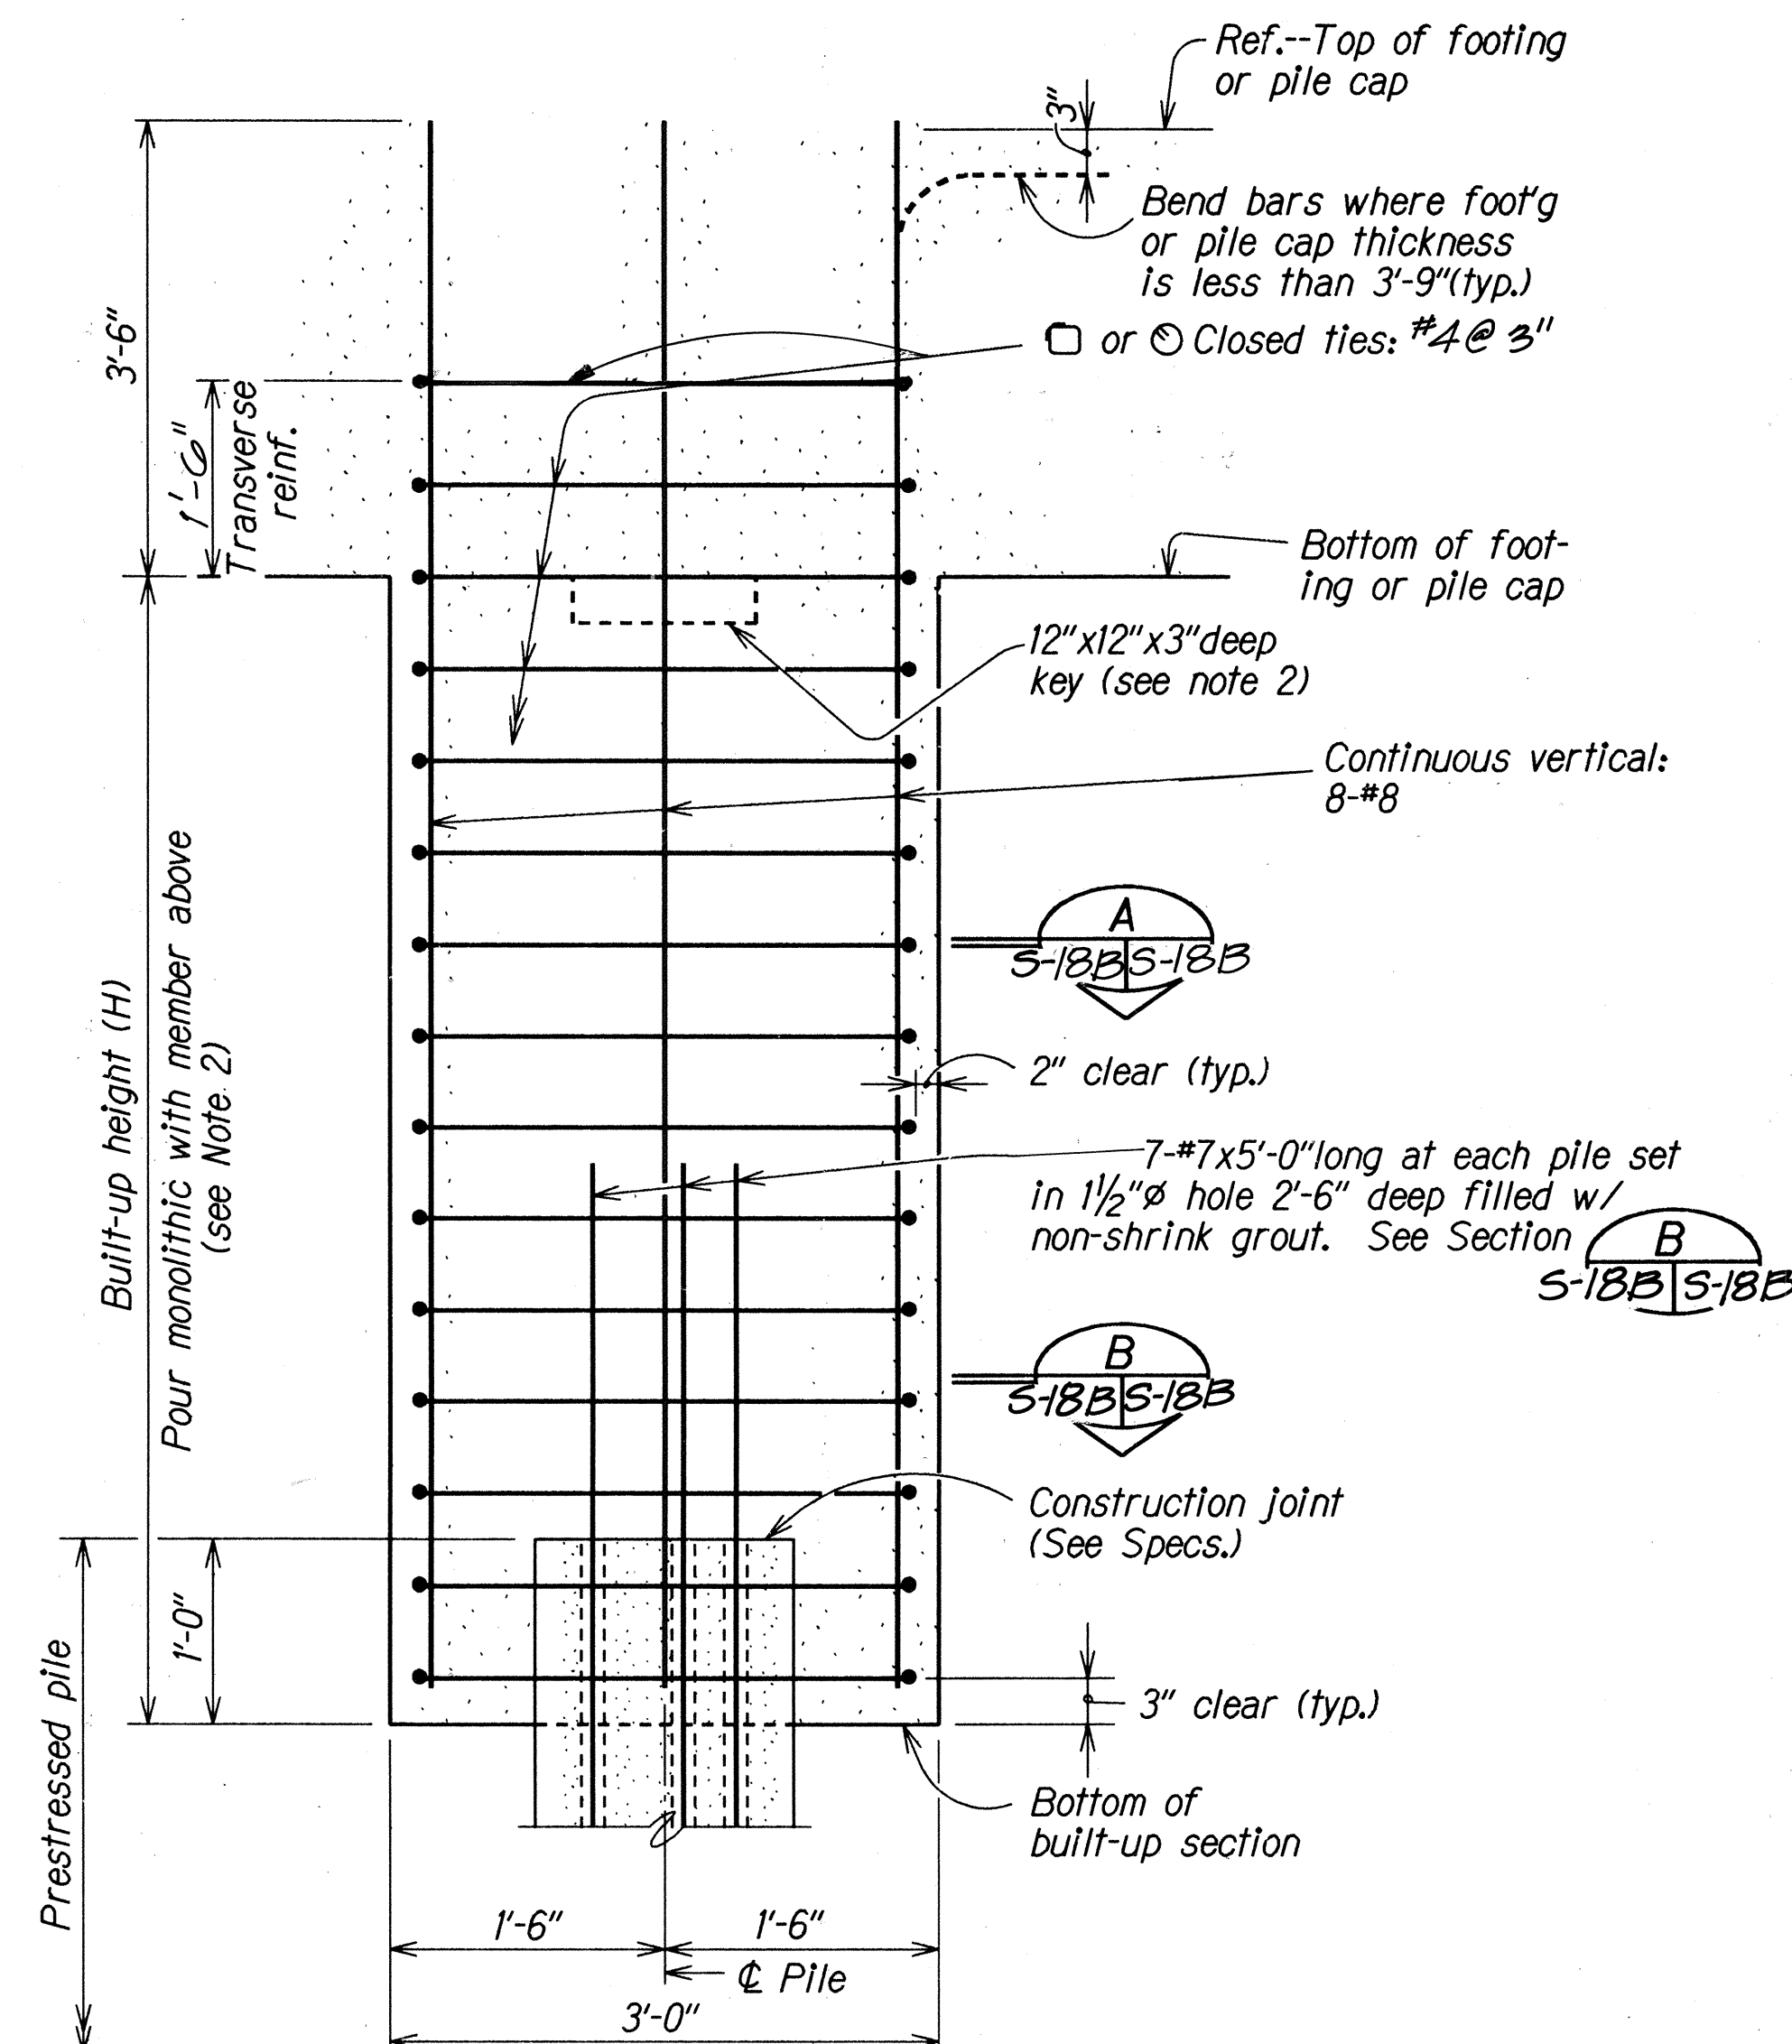

ALTERNATE PILE BUILD-UP DETAIL

NOTES:

- Selection of pile build-up type without driving to be determined by the Engineer.
- When the built-up height (H) exceeds 4'-0", the built-up section shall be poured separately from the main body of the footing or pile cap.
- Pile build-ups may be omitted for pile heads embedded at least 4" into footing, provided at least 90 percent of the pile in each footing have the minimum embedment into footing as shown in contract plans and #7 bars are spliced to strands as shown in Section B (S-18B S-18B).
- For built-up pile with driving, remove concrete after driving, leaving reinforcement exposed. See General Note 6 on Sht. No. S-18A.
- Circular built-up section may be used only when approved by the Engineer.
- Alternate pile build-up detail shall apply only to pile build-up without driving.

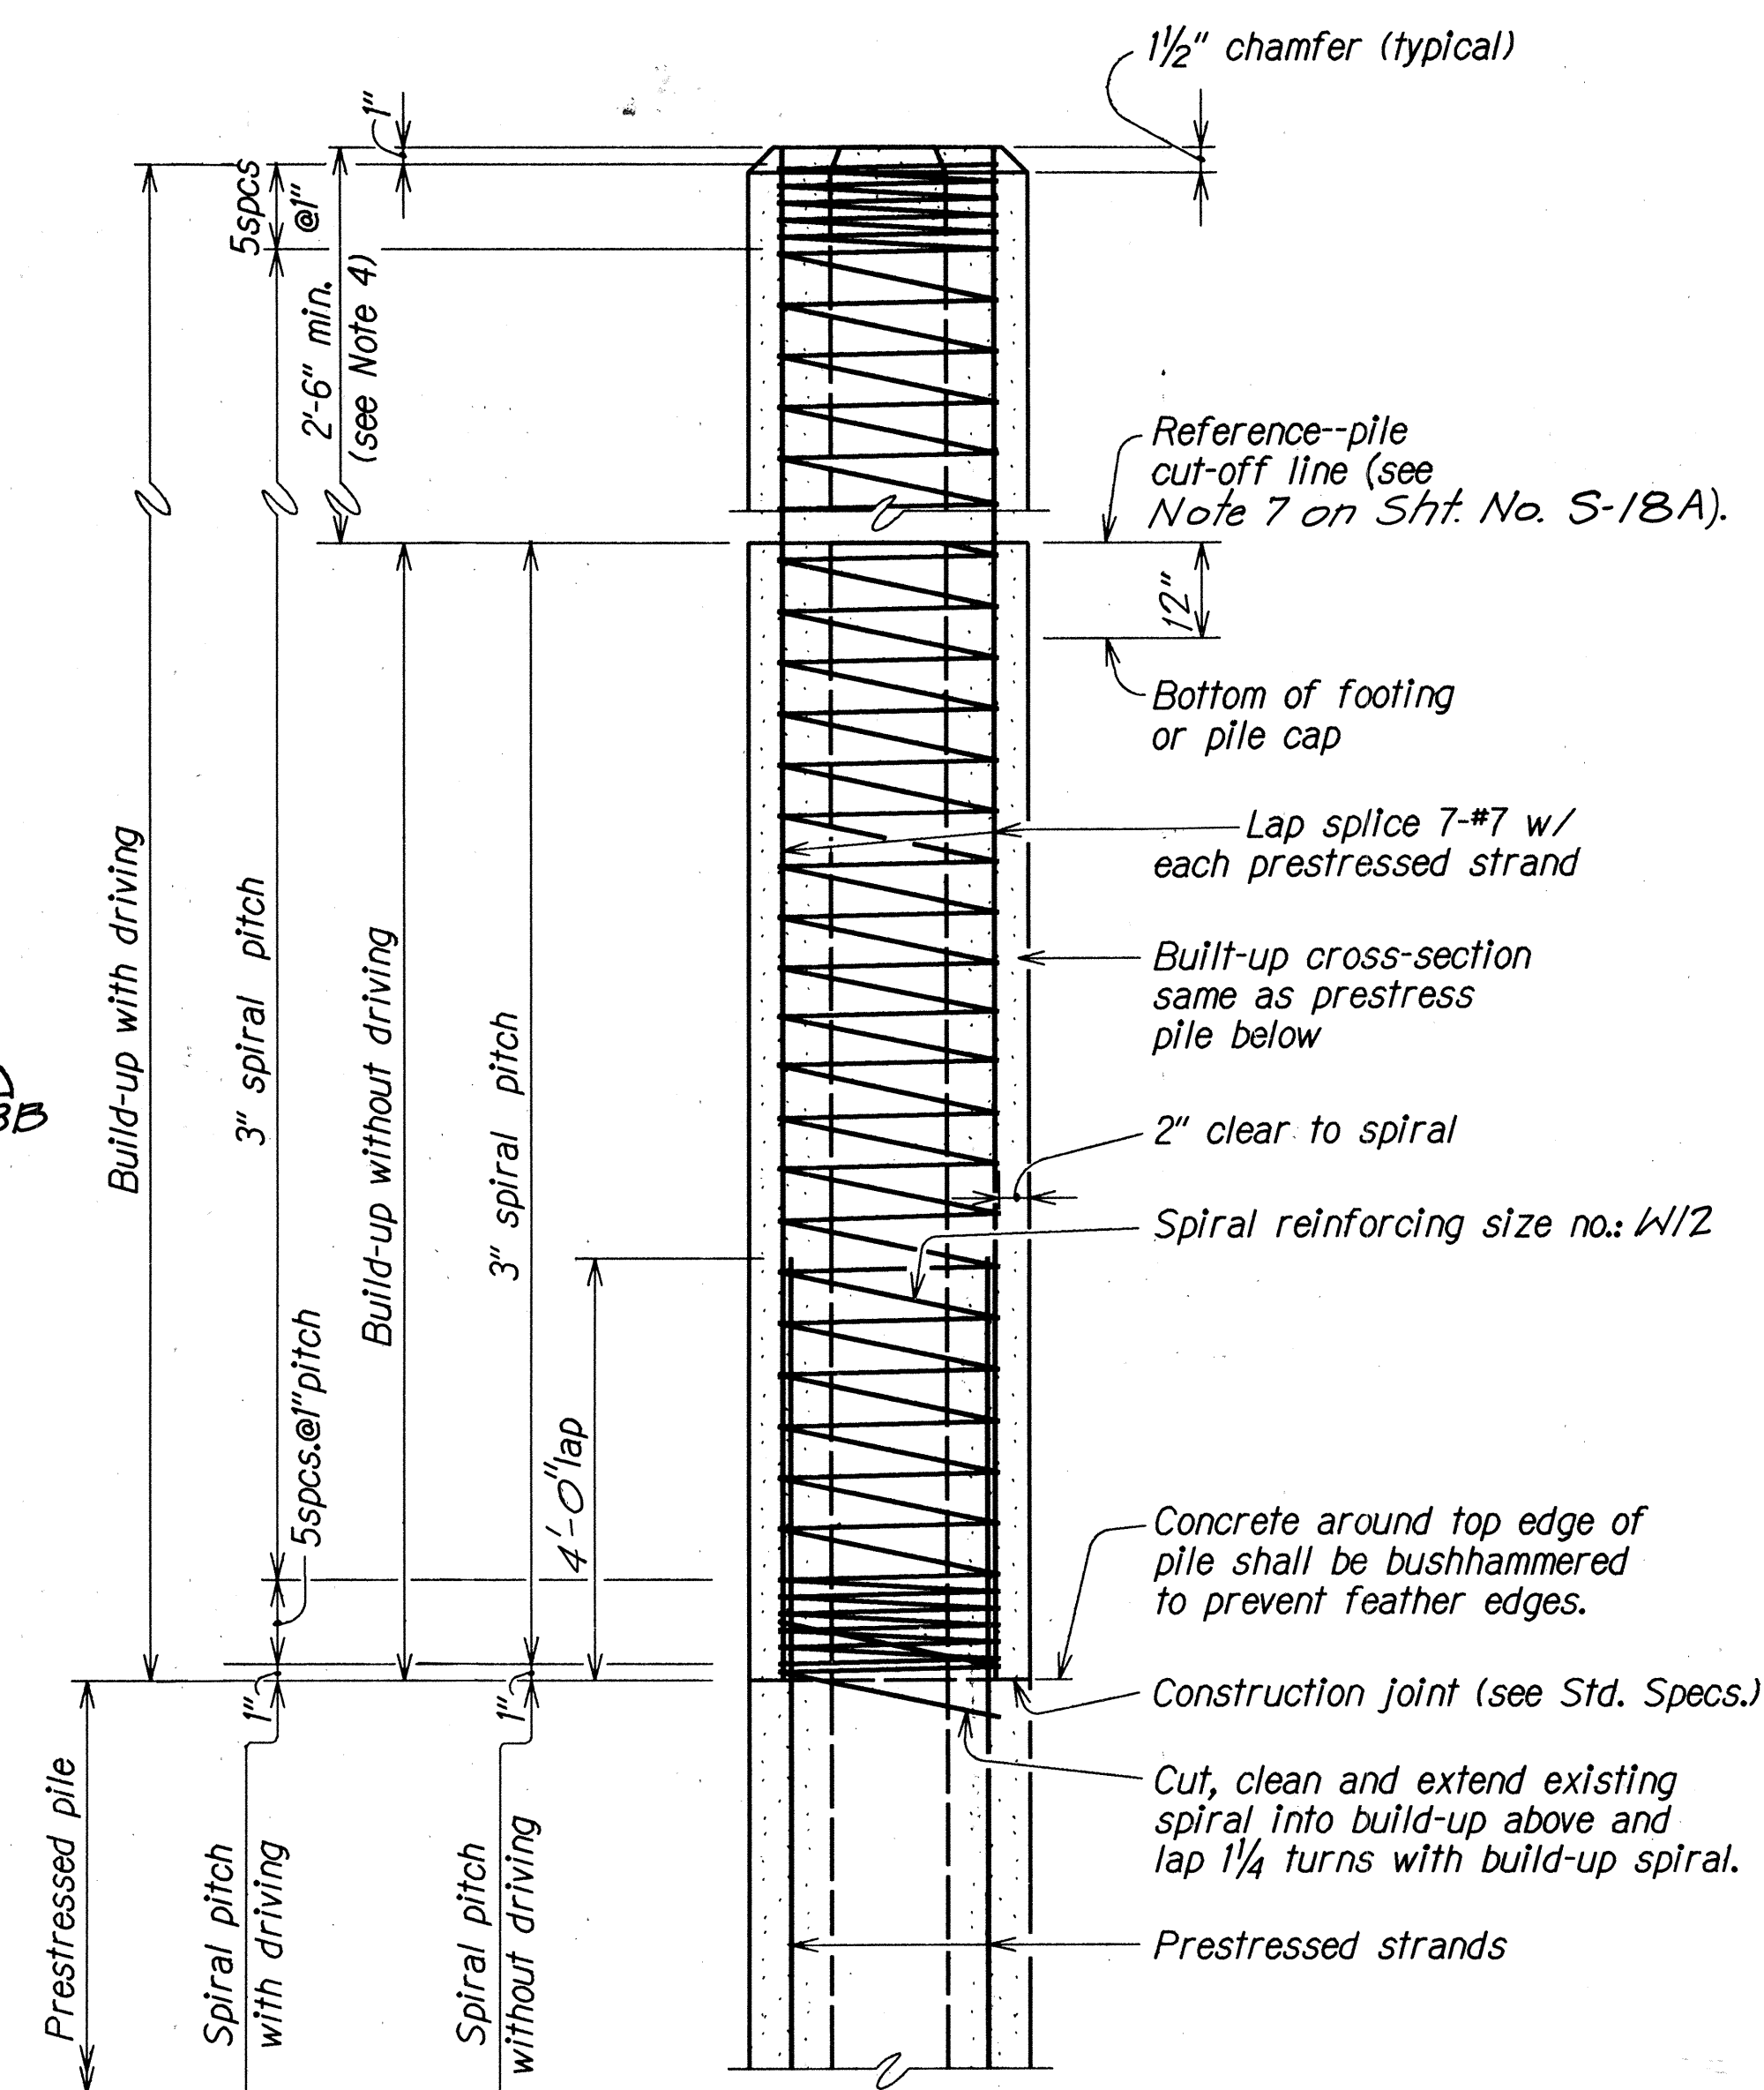

TYPICAL PILE BUILD-UP DETAIL

DESIGNED BY	DATE
TRACED BY	
DESIGN FILE	
QUANTITIES BY	
CHECKED BY	
N.	




THIS WORK WAS PREPARED BY ME OR UNDER MY SUPERVISION.

Hui Pang Chen


DATE	REVISION
------	----------

STATE OF HAWAII DEPARTMENT OF TRANSPORTATION HIGHWAYS DIVISION WAILUPE STREAM BRIDGE WIDENING
PRESTRESSED CONCRETE PILES
SHEET 2 OF 2
KALANIANA'OLE HIGHWAY Wailupe Circle to East Hind Drive FA Project No. F-072-1(34)-A
SCALE: As shown DATE: JUNE 30, 1990 SHEET No. S-18B OF 19 SHEETS


FED. ROAD DIST. NO.	STATE	FED. AID PROJ. NO.	FISCAL YEAR	SHEET NO.	TOTAL SHEETS
HAWAII	HAW.	F-072-1(34)-A	1990	174	186

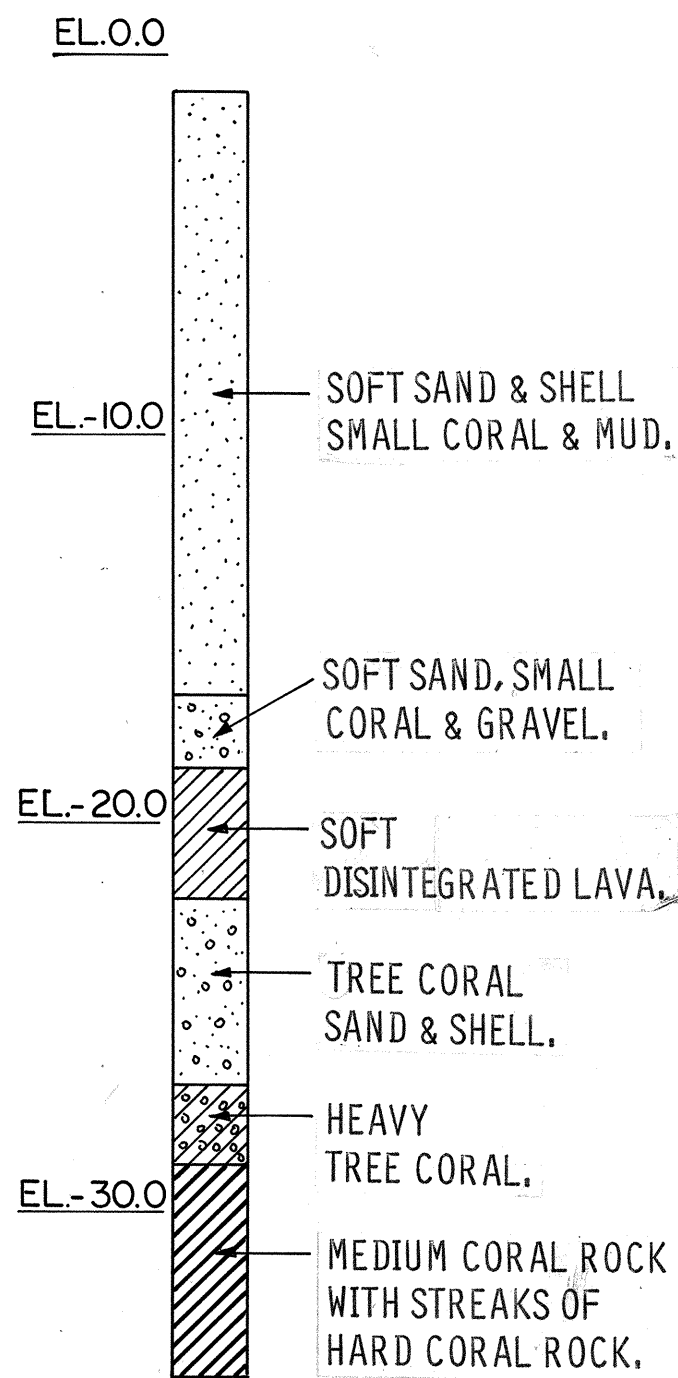


HOLE NO. 1

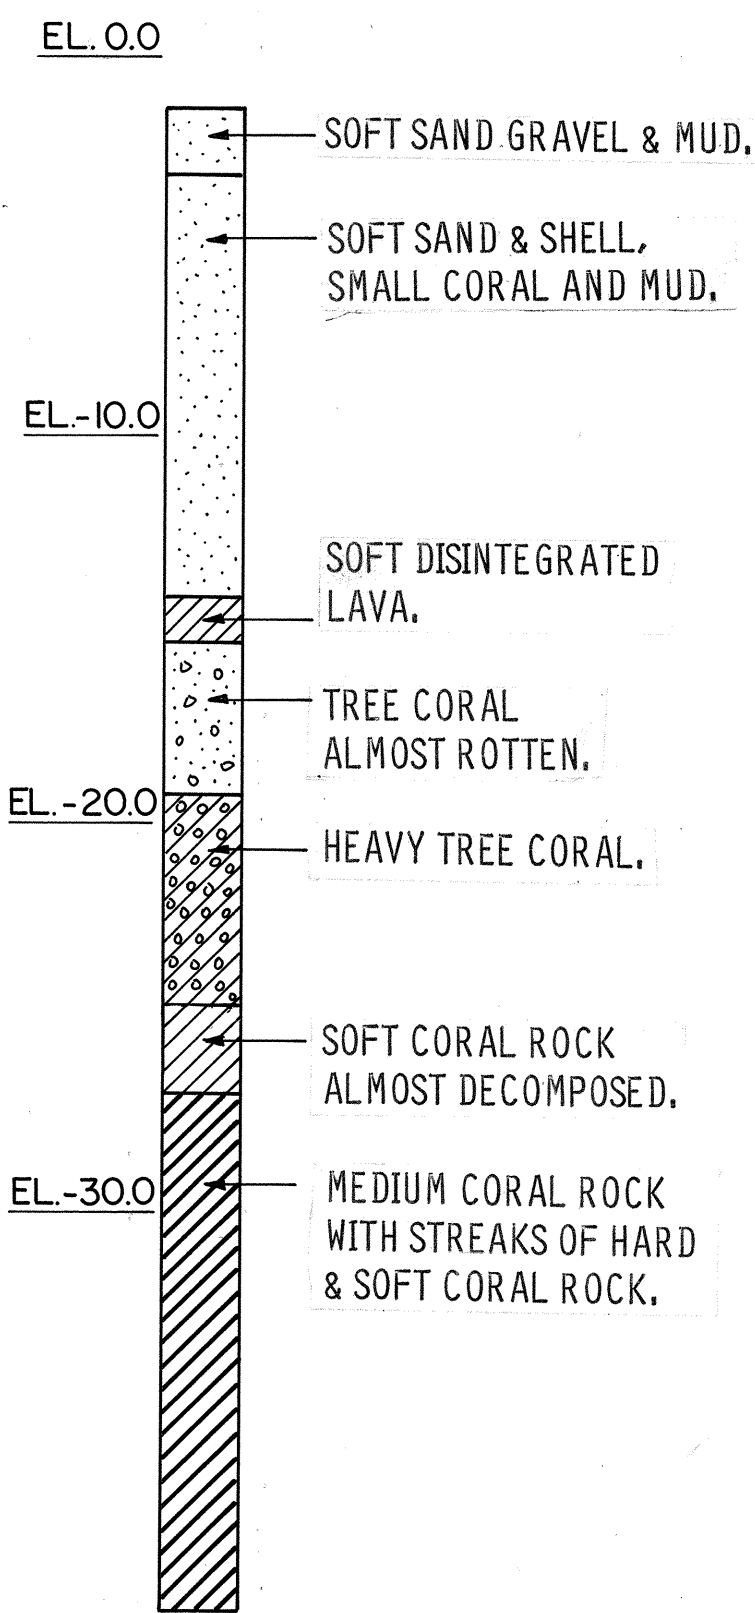


HOLE NO. 2

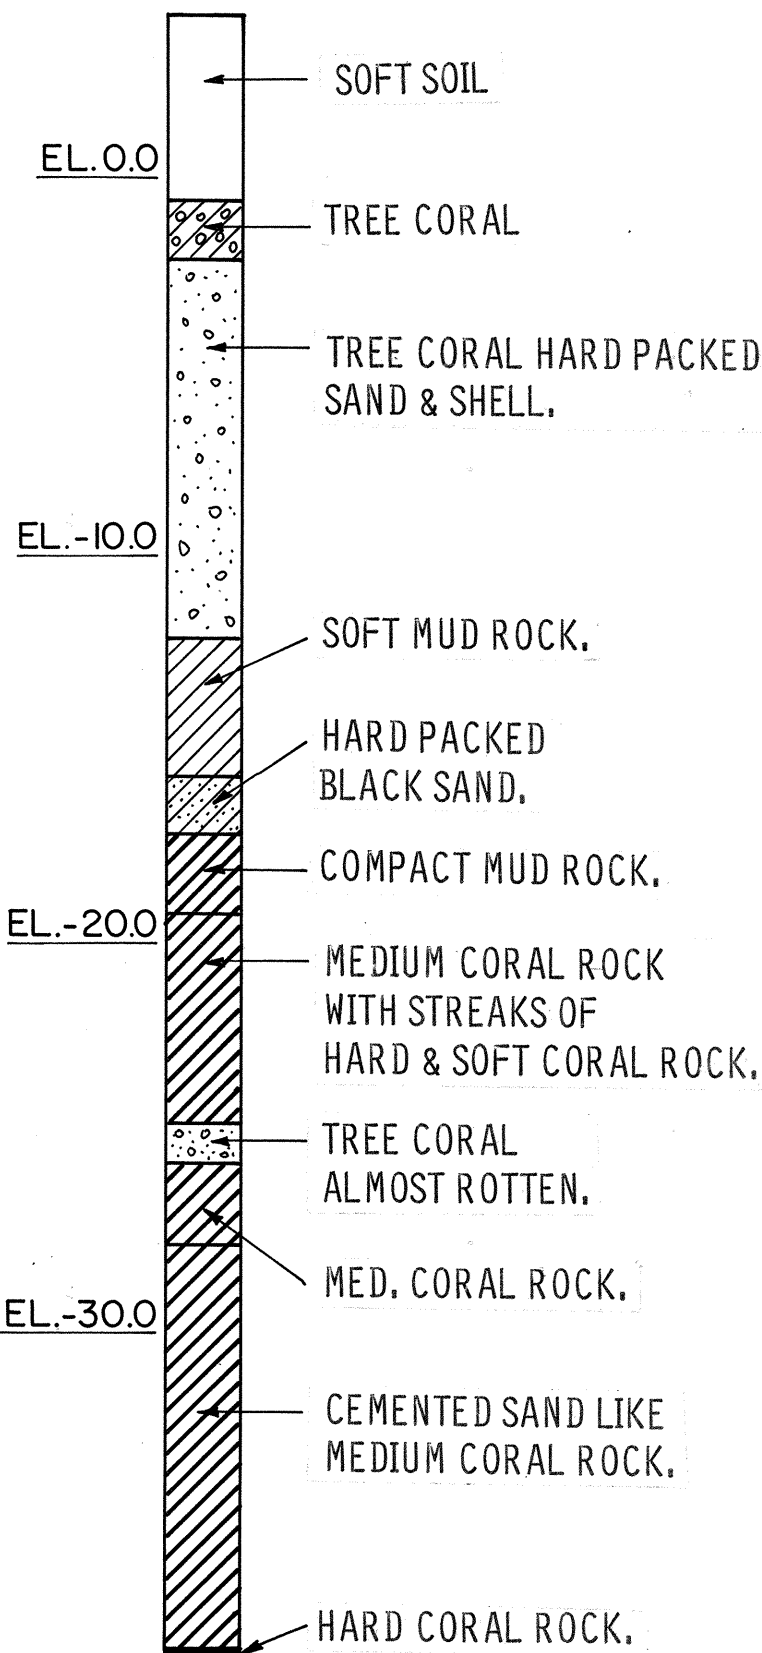

HOLE NO. 3

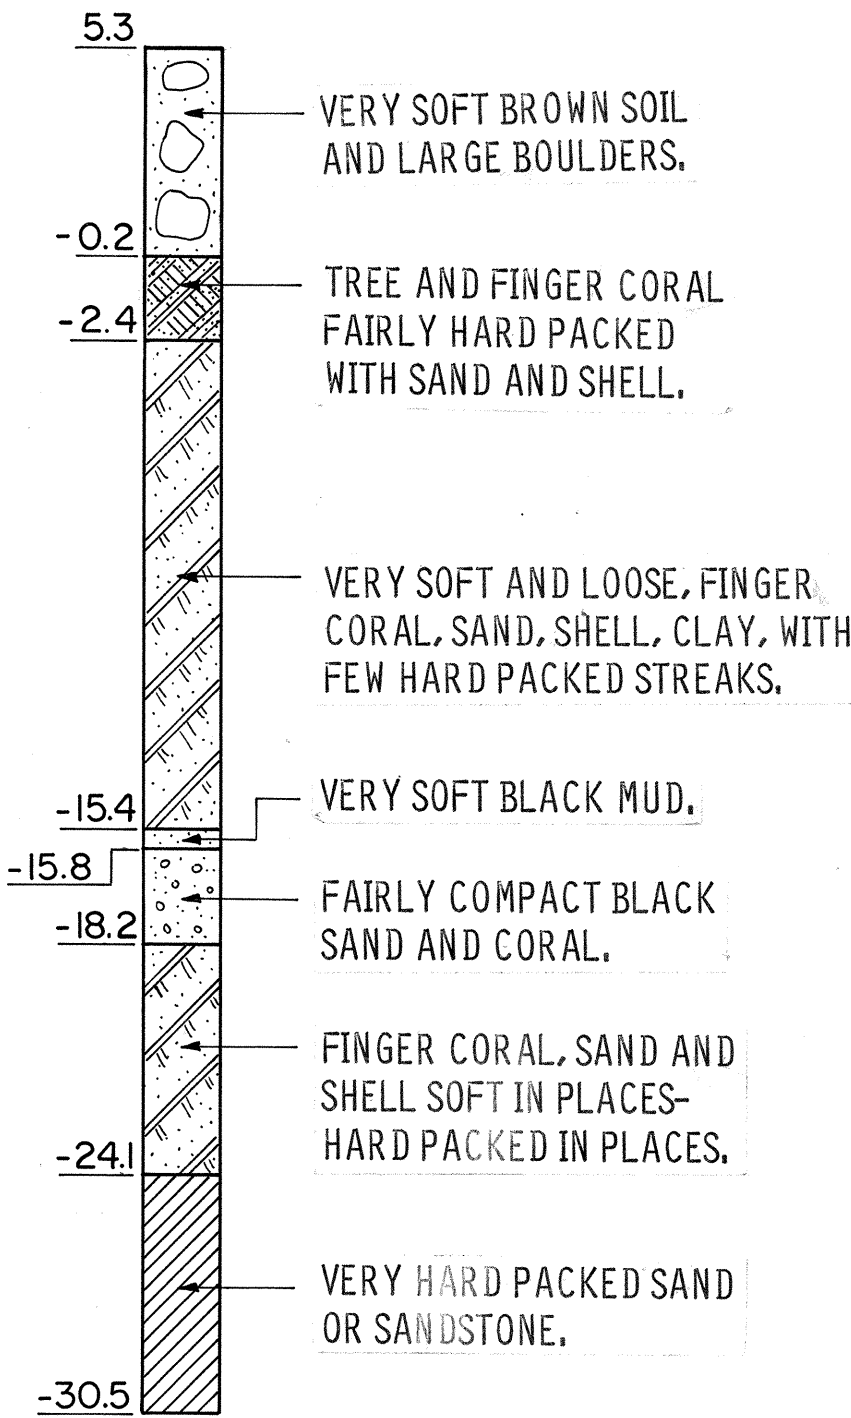

B-1

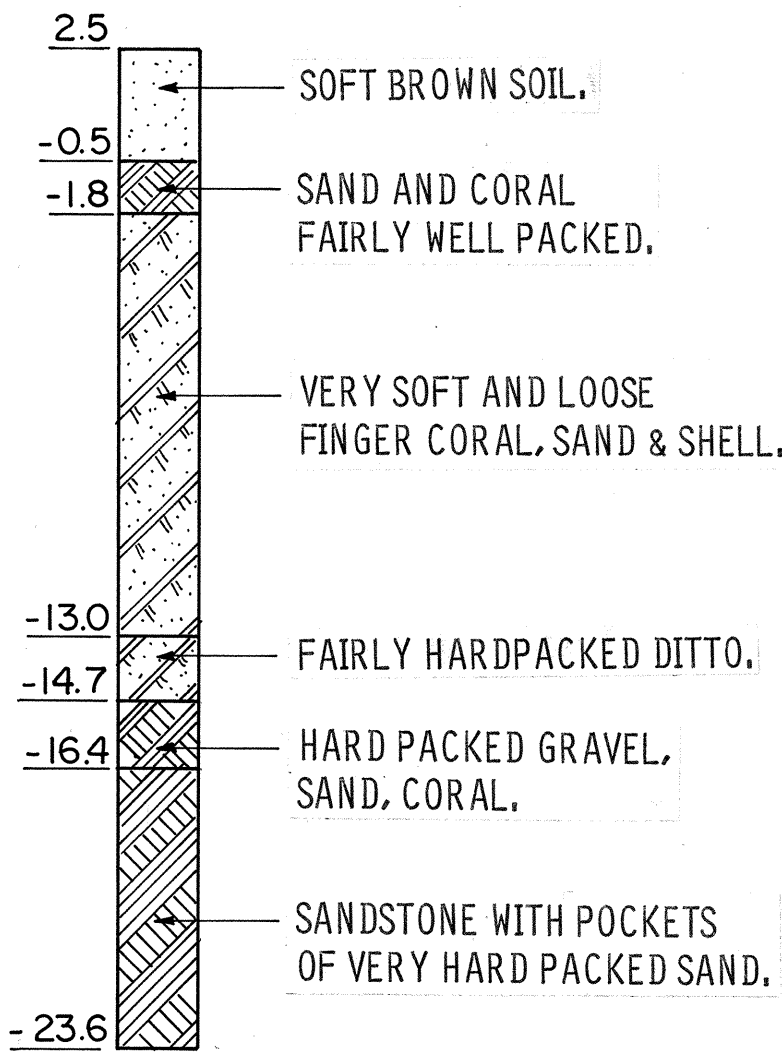


B-2


NOTES:

- THE BORING DATA SHOWN ARE COPIED FROM THE FOLLOWING EXISTING BRIDGE PLANS:
(A) HOLE NO. 1 THRU NO. 3:
KALANIANA'OLE HWY. FAP NO. 6B
DRAWING NO. 4141.4 (DATED APR., 1930)
(B) B-1 THRU B-6:
KALANIANA'OLE HWY. FAP NO. F6 (18)
DRAWING NO. 5686.39 (DATED MAR., 1954)


- FOR BORE HOLE LOCATIONS SEE SHEET NO. S-5.

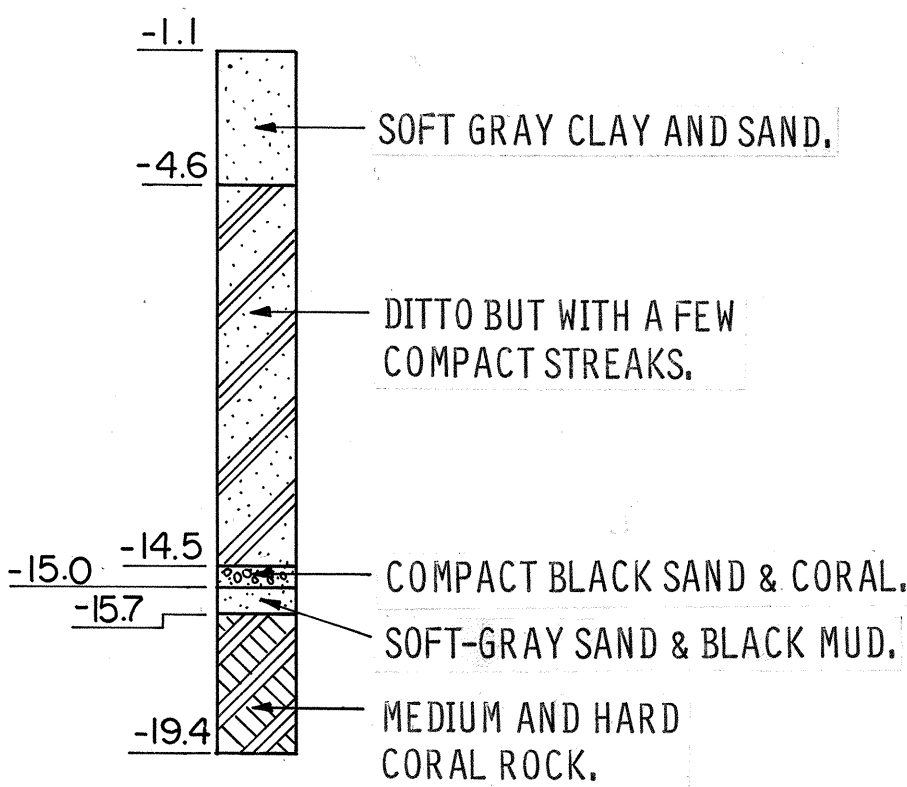


B-3

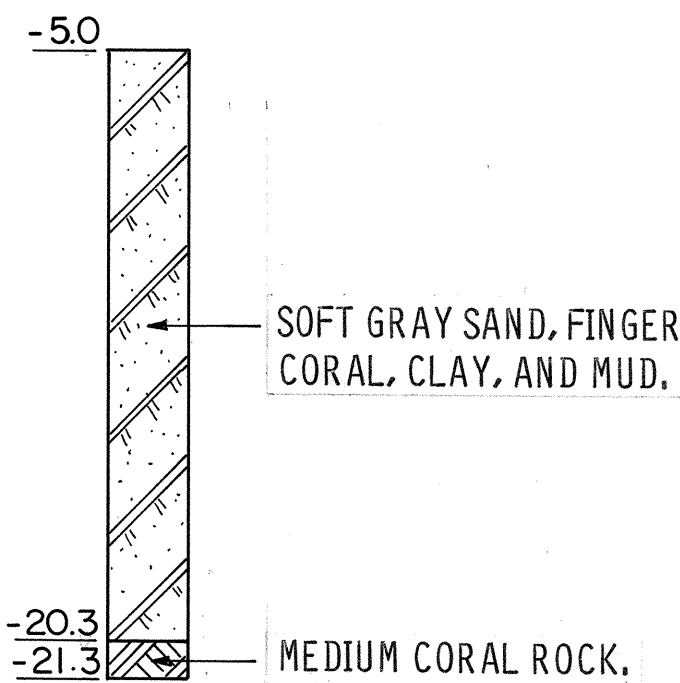

B-4

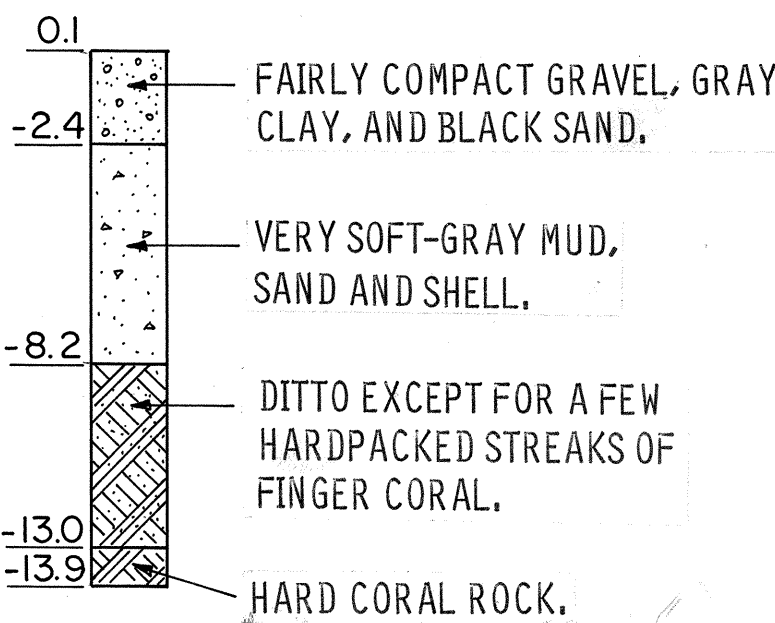

B-5

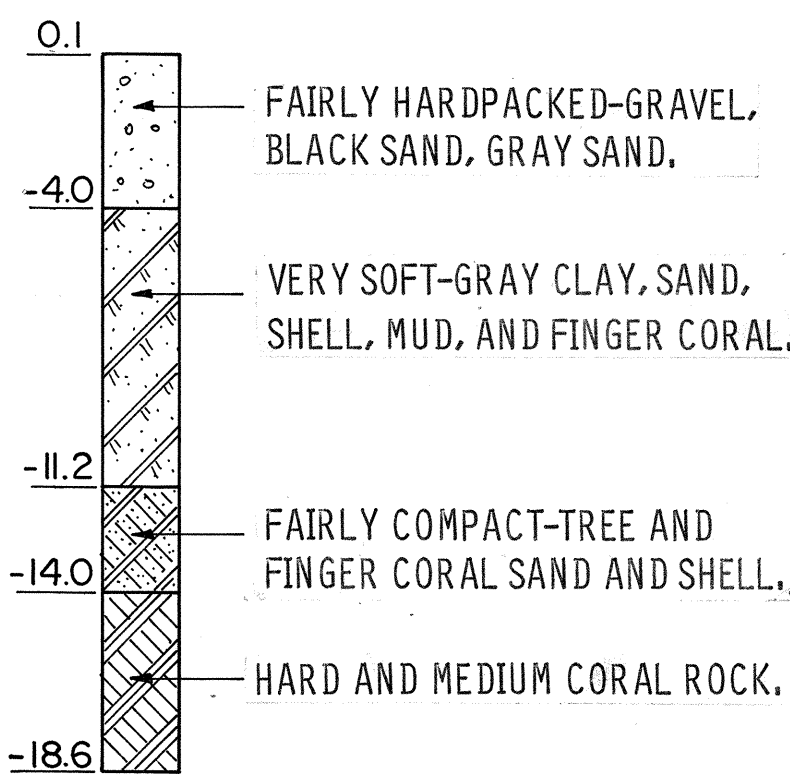

B-6

EXISTING BORING DATA

SCALE: 1" = 5'-0"

DATE	_____
SURVEY PLOTTED BY	_____
ORIGINAL PLAN	_____
DESIGNED BY	_____
NOTE BOOK	_____
QUANTITIES BY	_____
CHECKED BY	_____
No.	_____



THIS WORK WAS PREPARED BY ME
OR UNDER MY SUPERVISION.

Hui Pang Chen

STATE OF HAWAII
DEPARTMENT OF TRANSPORTATION
HIGHWAYS DIVISION

WAILUPE STREAM BRIDGE WIDENING

BORING LOGS

KALANIANA'OLE HIGHWAY
Wailupe Circle to East Hind Drive
FA Project No. F-072-1(34)-A

SCALE: As shown DATE: JUNE 30, 1990

SHEET No. S-19 OF 19 SHEETS