



NOTE:

THE CONTRACTOR SHALL PROVIDE OPENINGS BETWEEN PORTABLE CONCRETE GUARDRAILS (TEMPORARY) FOR MAKAI PROPERTIES AND DRIVEWAYS DURING THE CONSTRUCTION.


FED. ROAD DIST. NO.	STATE	FED. AID PROJ. NO.	FISCAL YEAR	SHEET NO.	TOTAL SHEETS
HAWAII	HAW.	F-072-1(34)B	1991	95	123

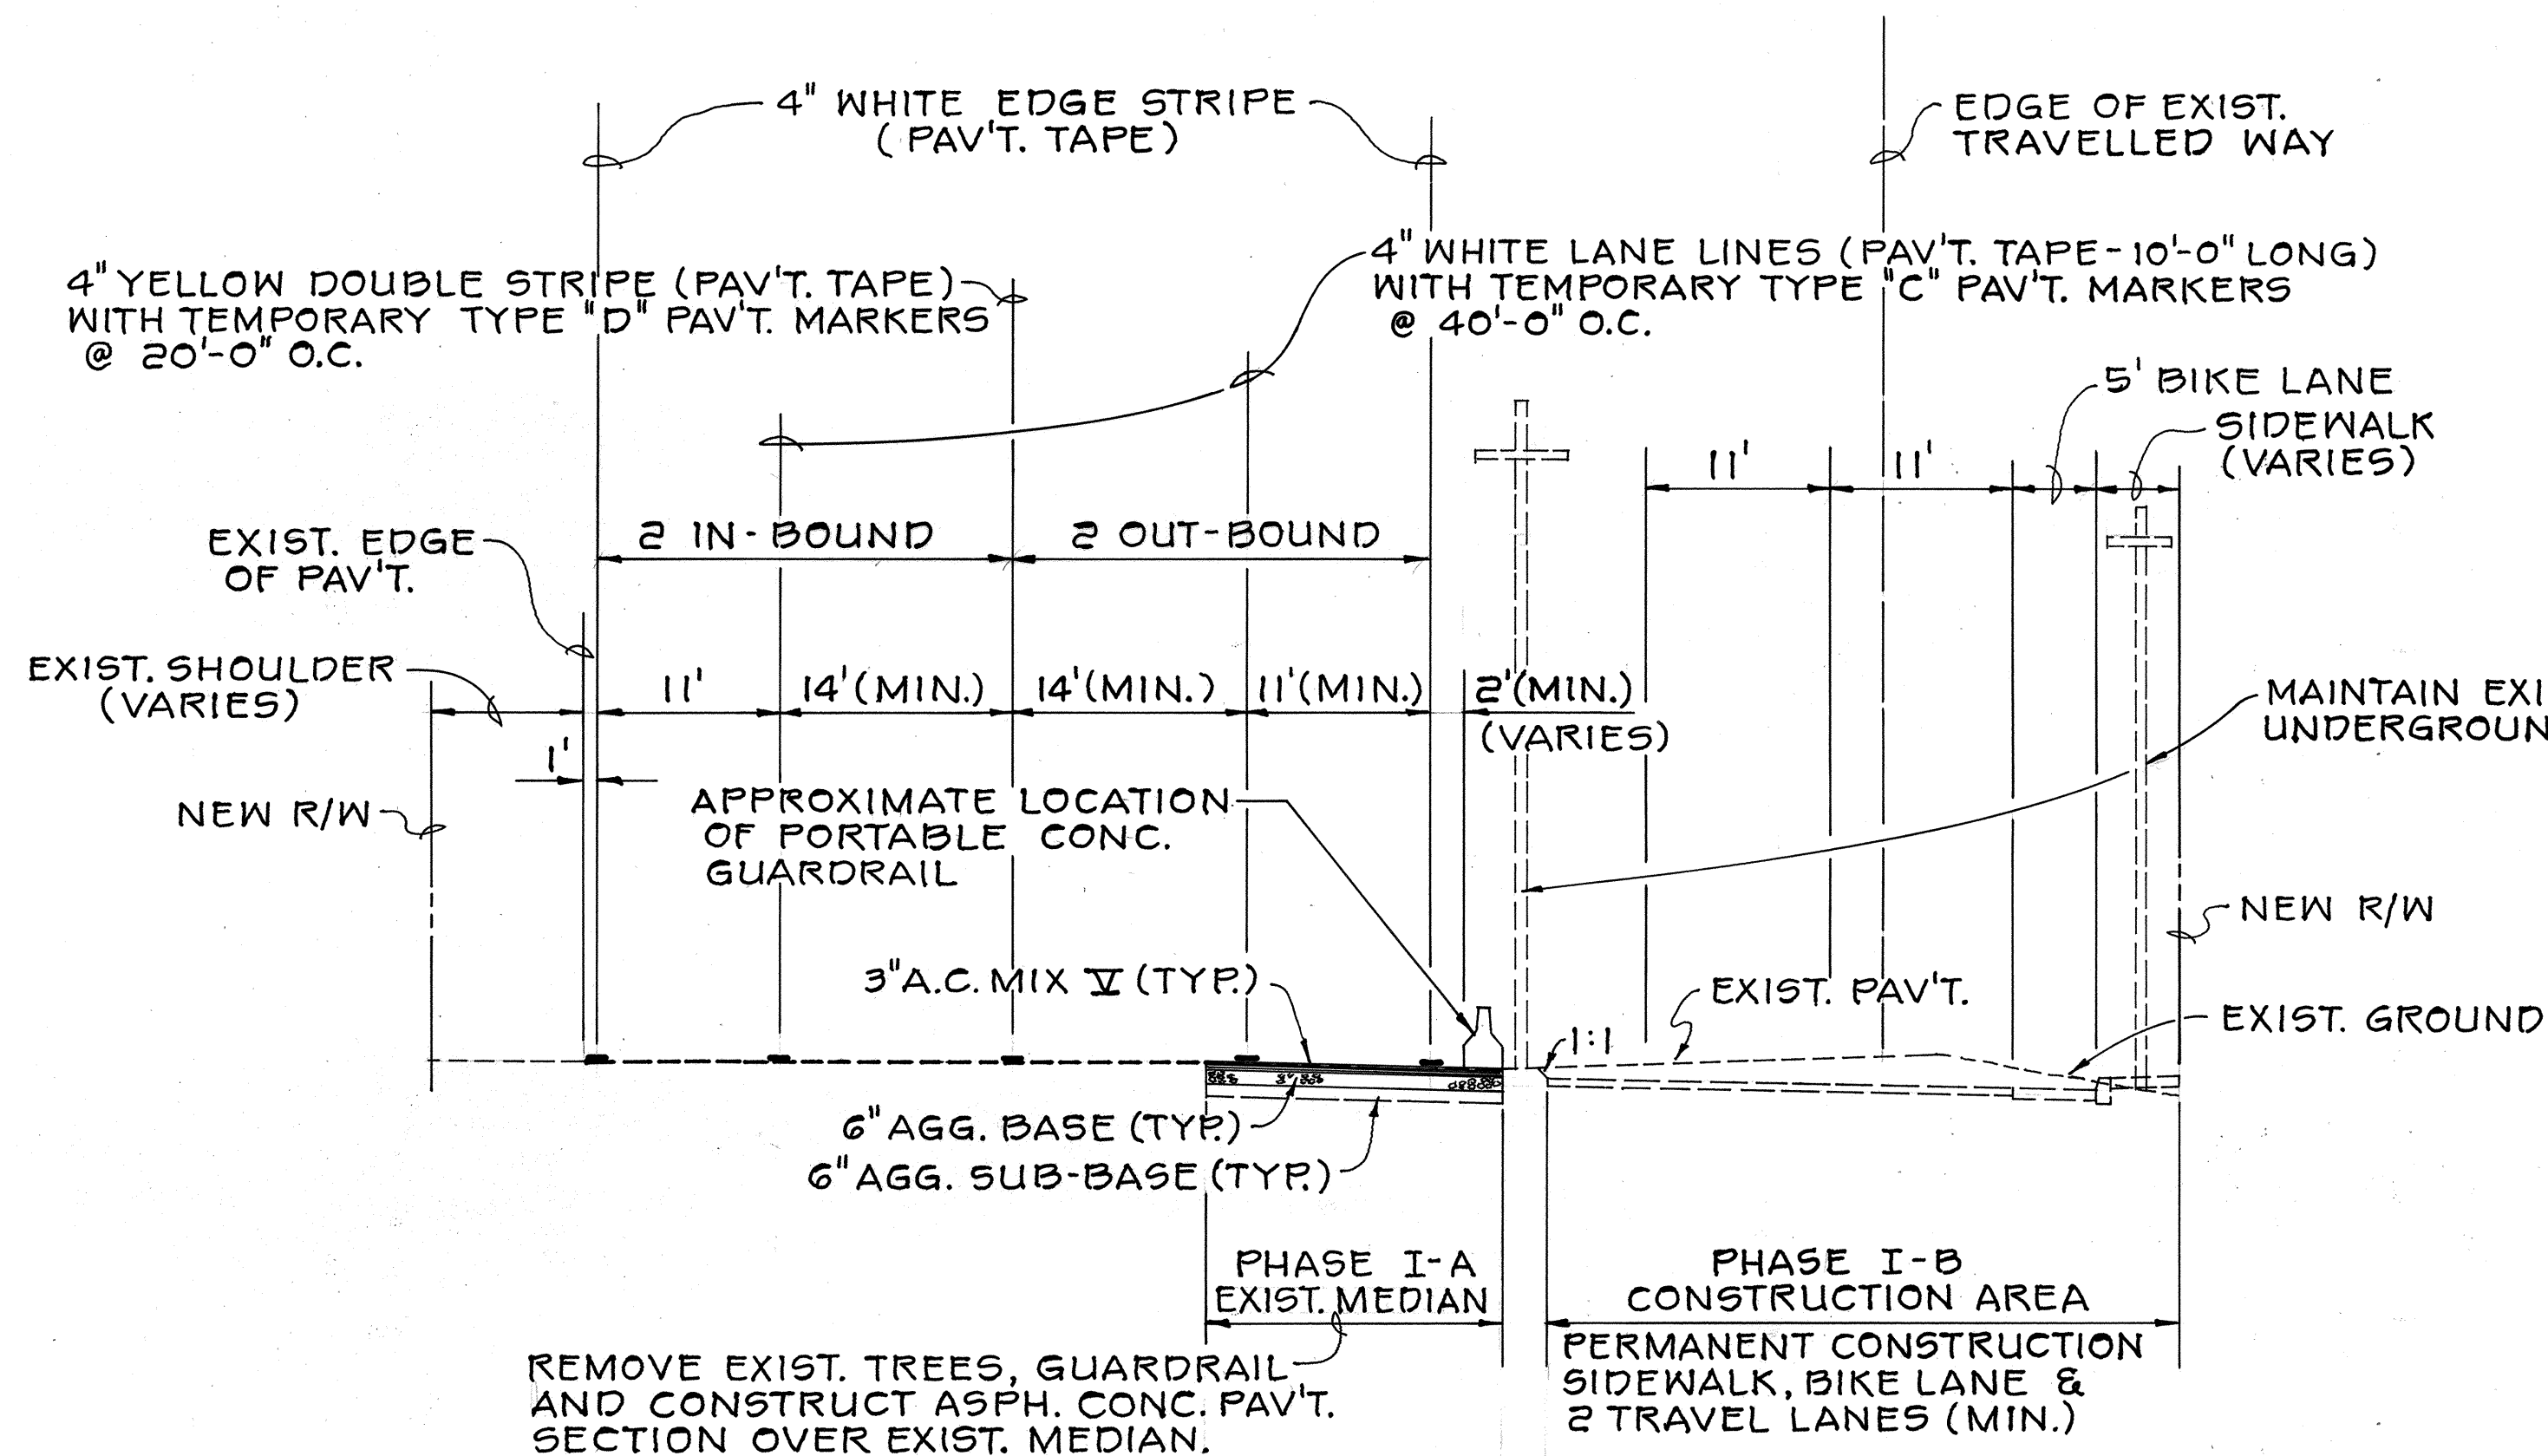


PHASE I

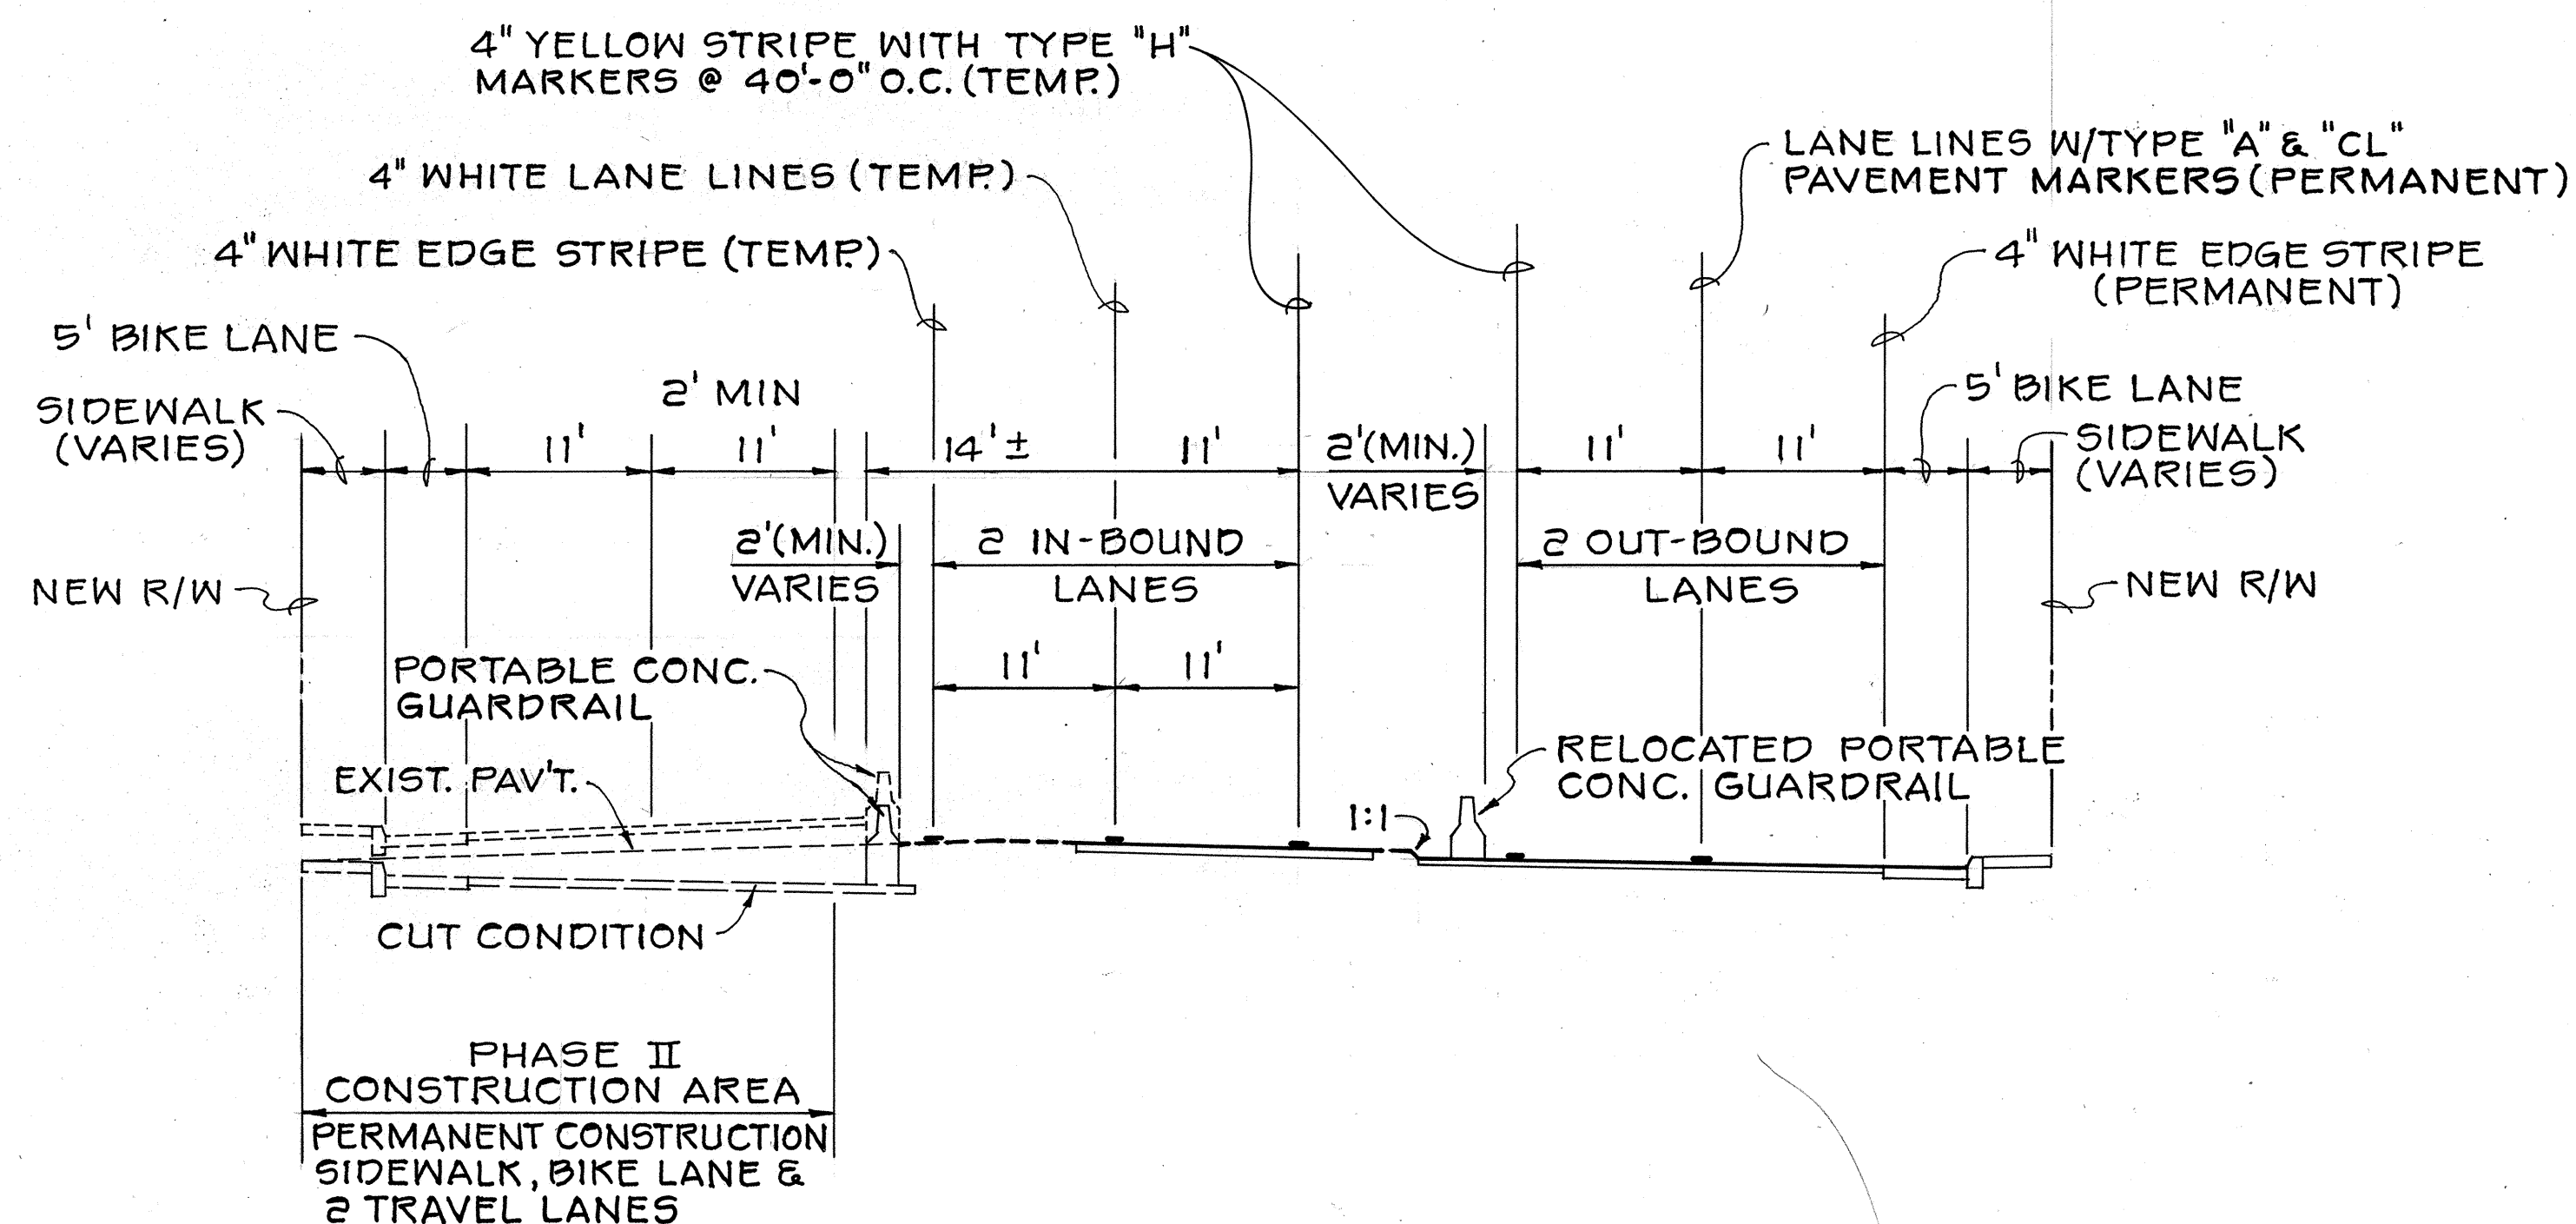

PHASE II

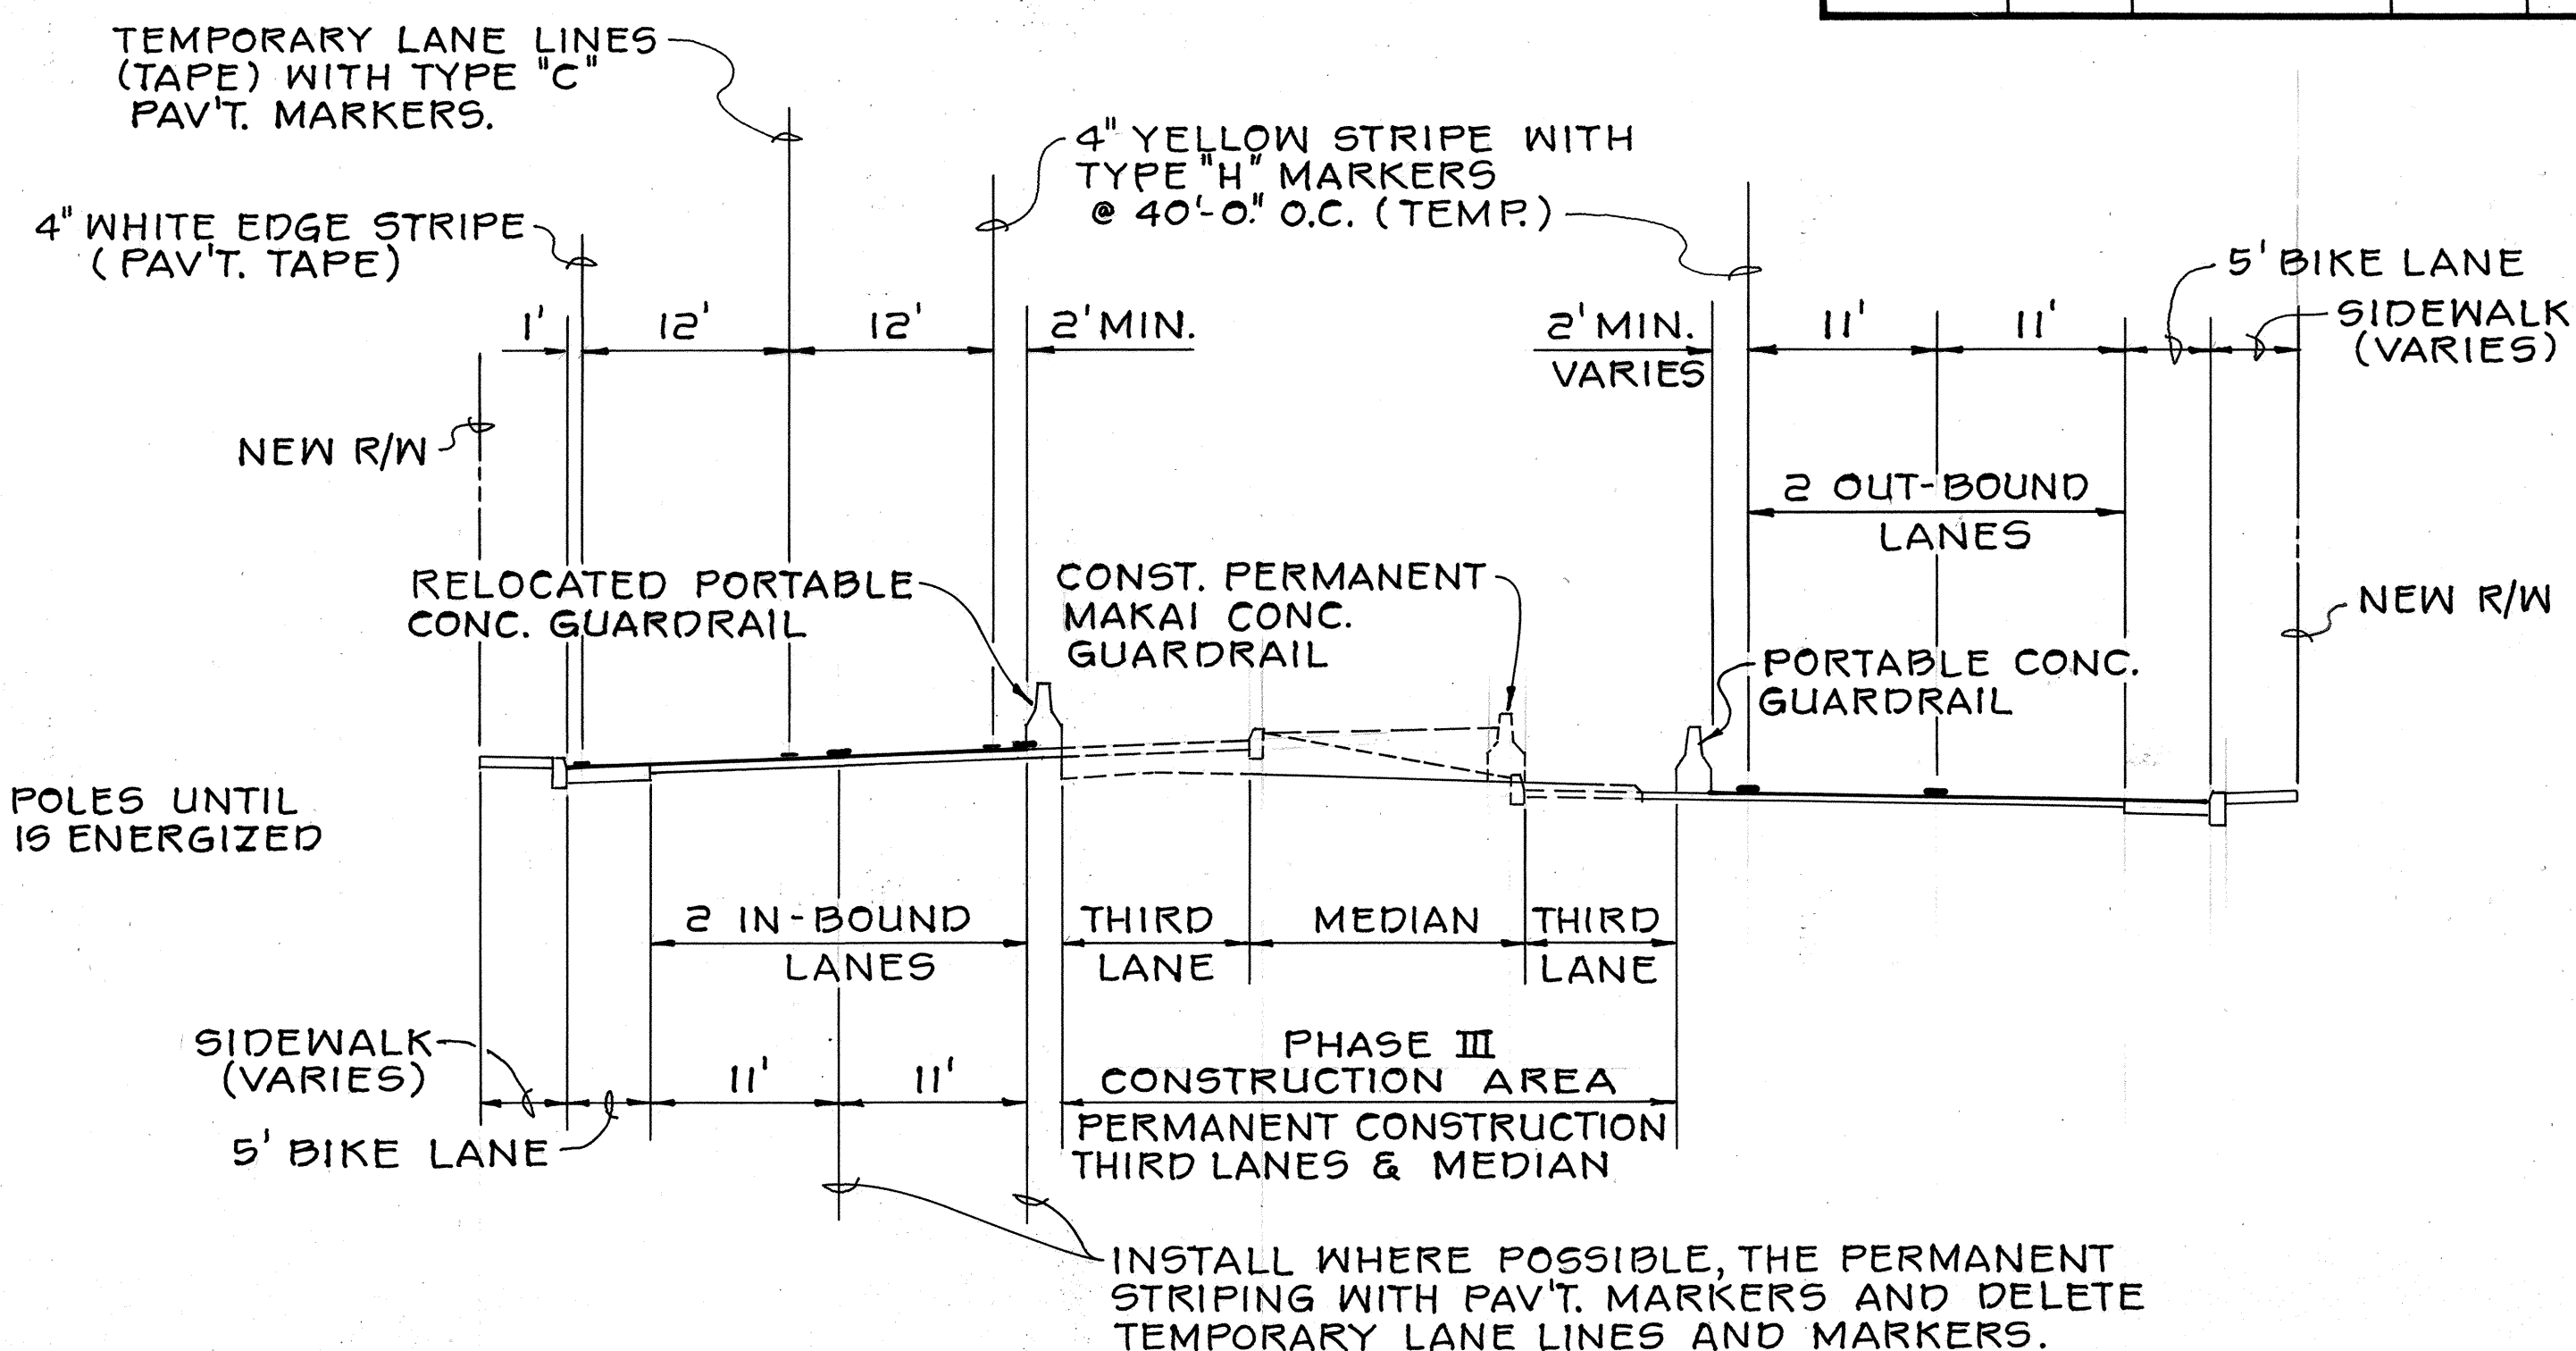

PHASE III

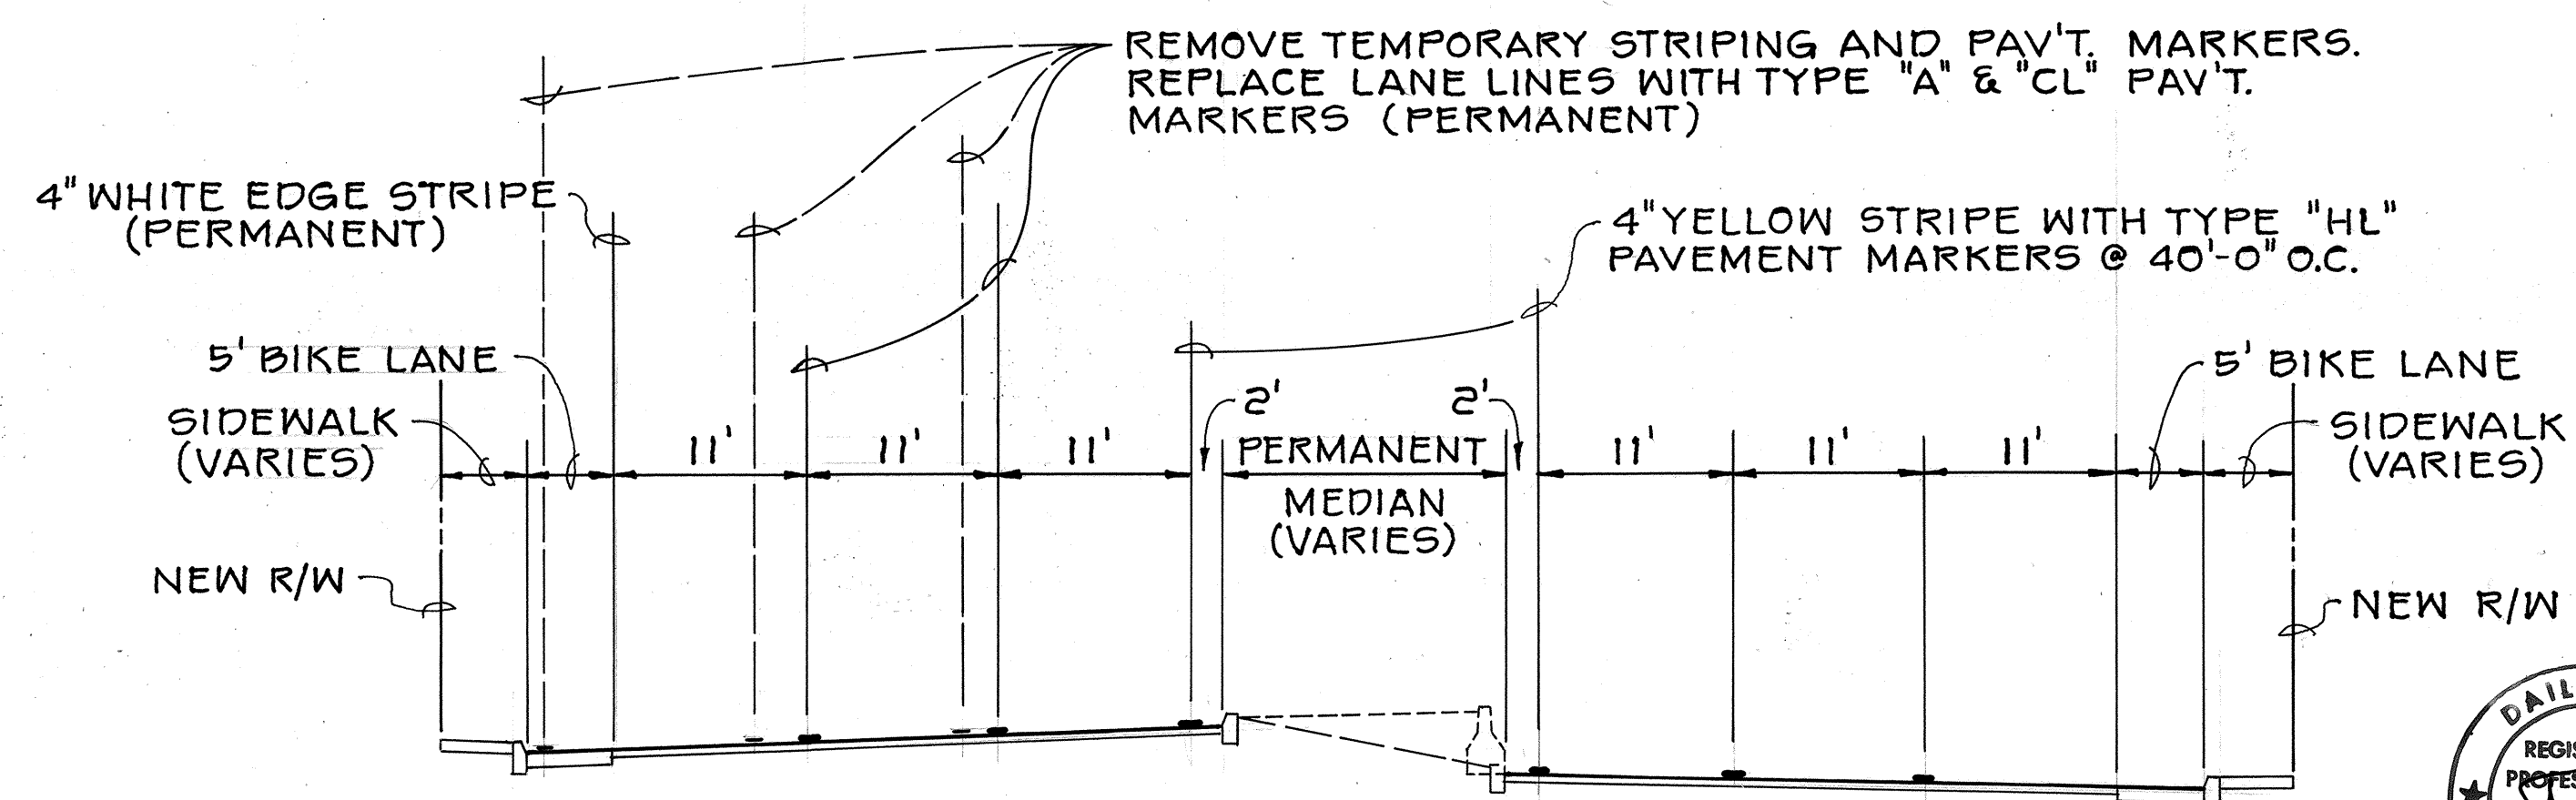

FINAL SECTION (PERMANENT)



STATE OF HAWAII
DEPARTMENT OF TRANSPORTATION
HIGHWAYS DIVISION

**CONSTRUCTION
PHASES & DETOURS
KALANIANA'OLE HIGHWAY**

E. HIND DR. TO E. HALEMAUMAU ST.
F. A. PROJECT NO. F-072-1(34) B

SCALE: 1"=10' DATE:

SHEET No. 95 OF 123 SHEETS