

FED. ROAD DIST. NO.	STATE	FED. AID PROJ. NO.	FISCAL YEAR	SHEET NO.	TOTAL SHEETS
HAWAII	HAW.	F-072-1(34)B	1991	89	103



STATE OF HAWAII  
DEPARTMENT OF TRANSPORTATION  
HIGHWAYS DIVISION





SIGN DETAILS

KALANIANA'OLE HIGHWAY  
E. HIND DR. TO E. HALEMAUMAU ST.  
F.A. PROJECT NO. F-072-1(34)B

NO SCALE

DATE:




SHEET No. 8-3 OF 18 SHEETS

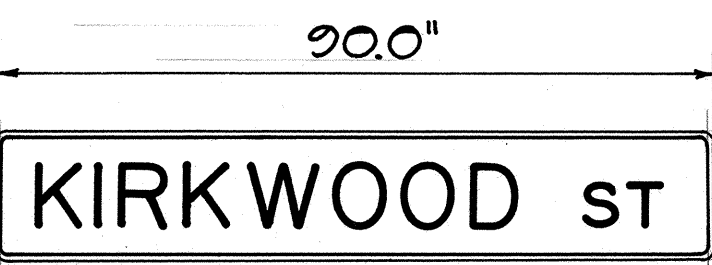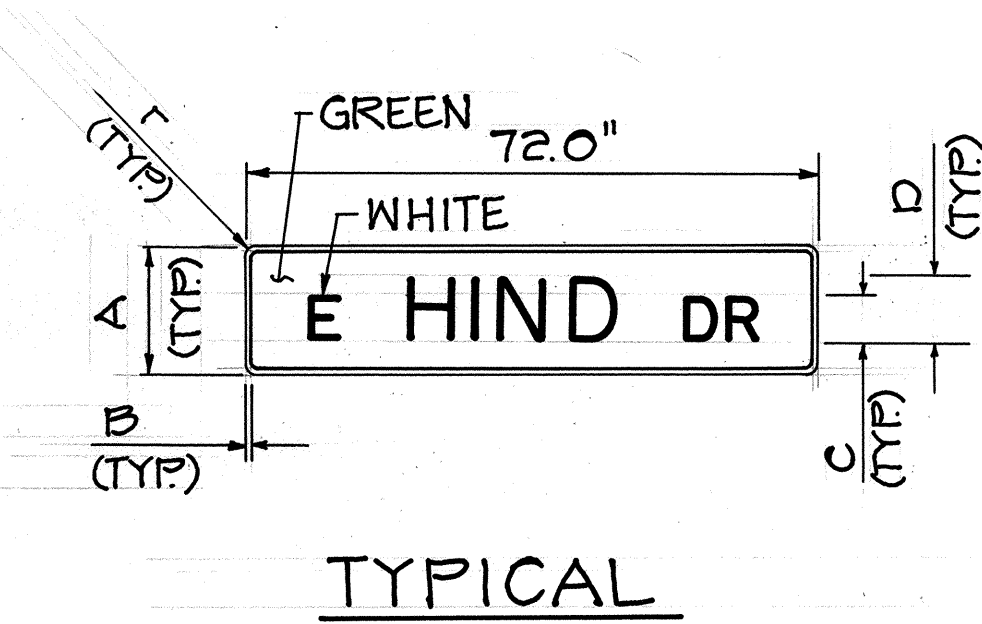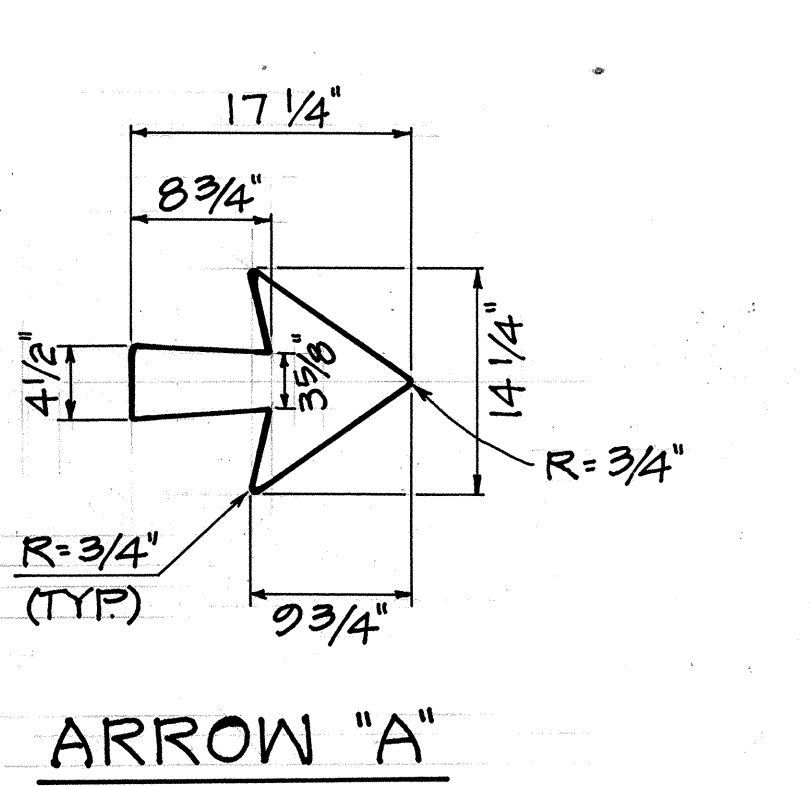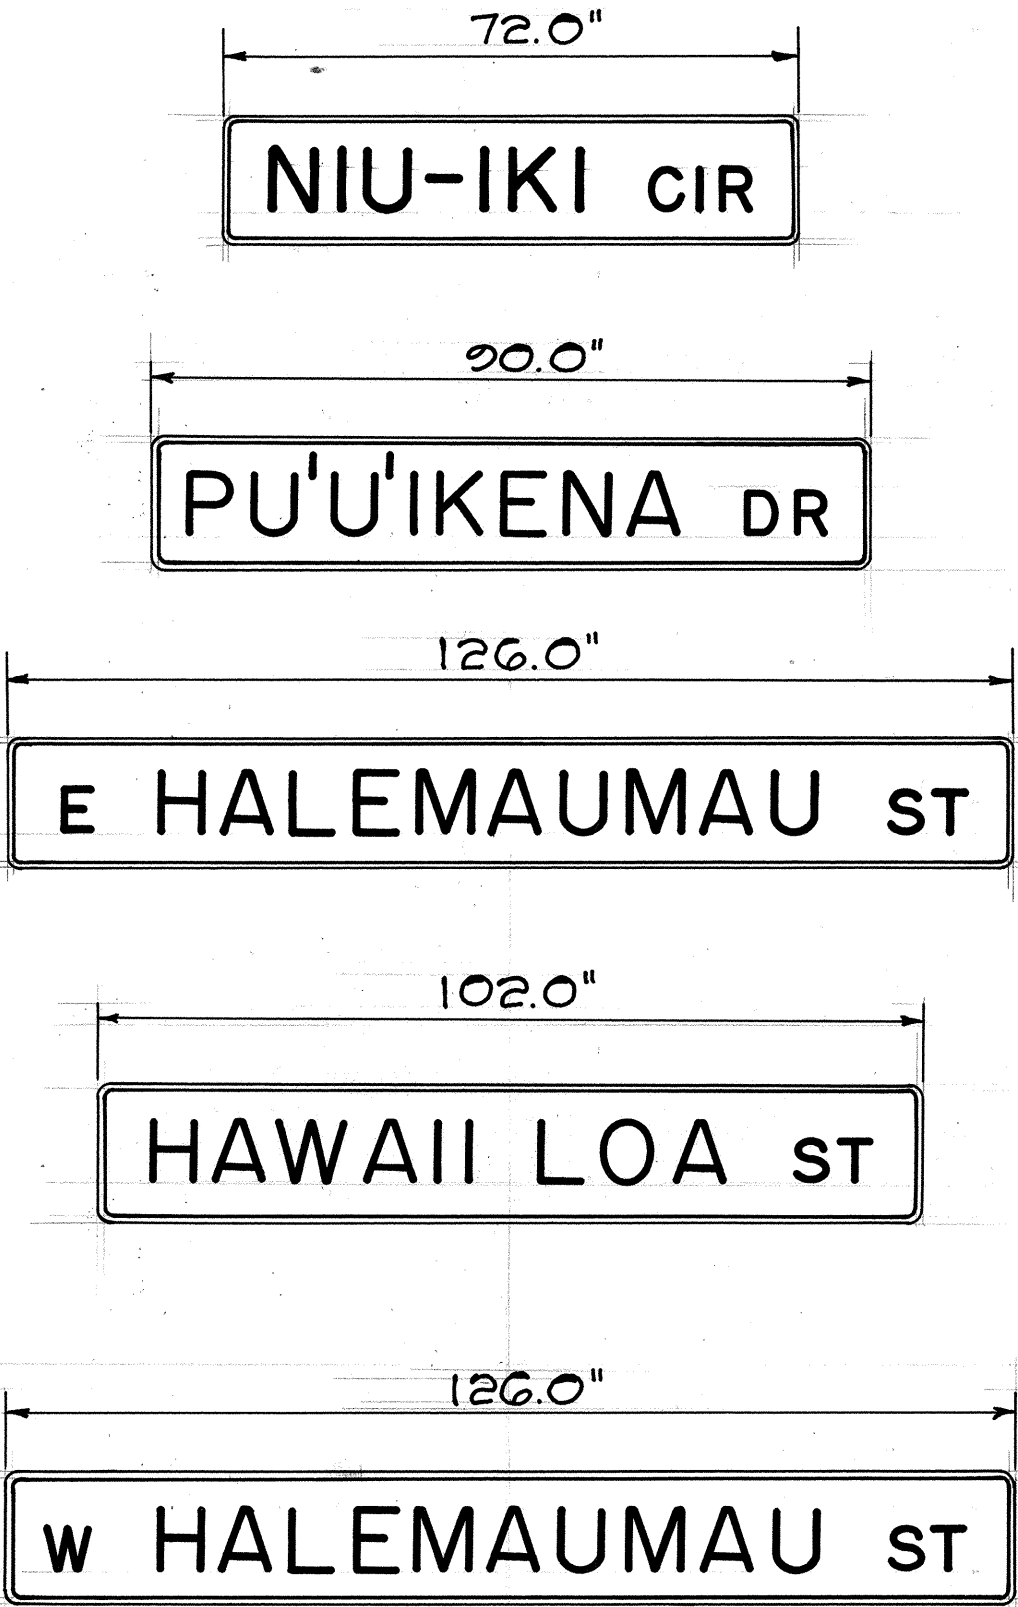


	DIMENSIONS (INCHES)				
SIGN	A	B	C	D	F
STD	16	1/4	60	80	3

### STREET NAME SIGNS ON MAST ARM

FOR SIGN SUPPORT DETAILS, SEE STANDARD PLANS TE-20 & TE-25.  
THE MINIMUM NO. OF SUPPORTS SHALL BE 3.

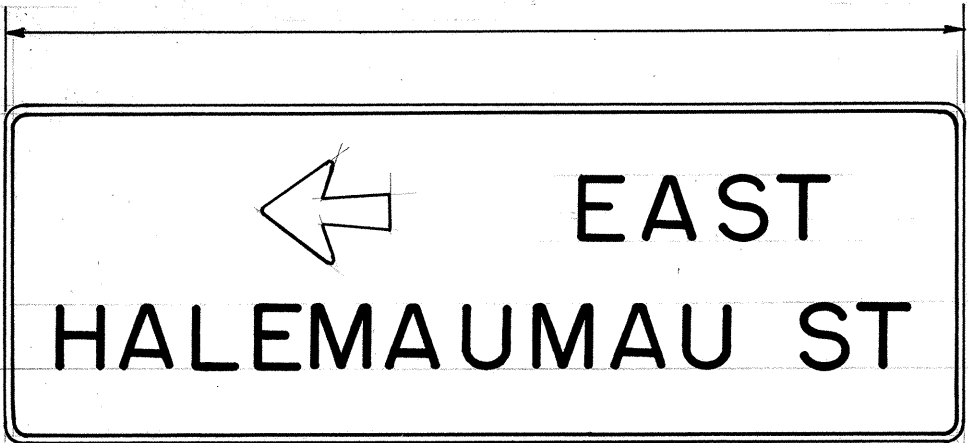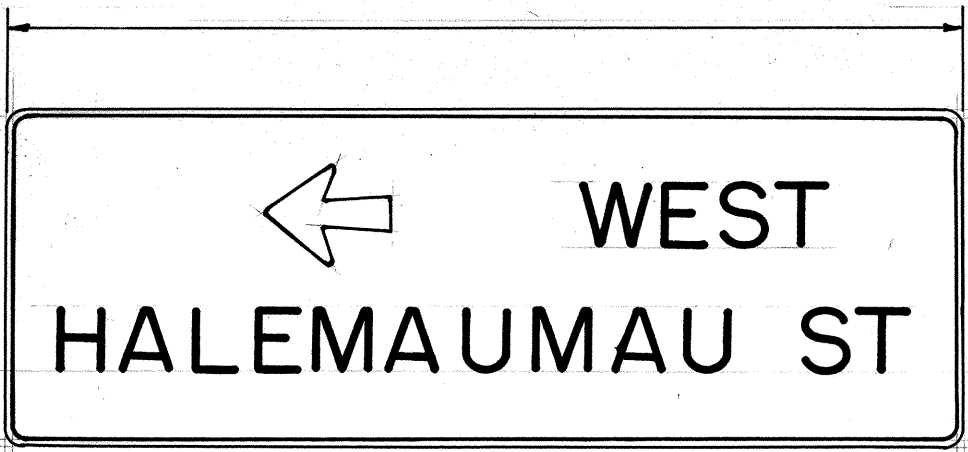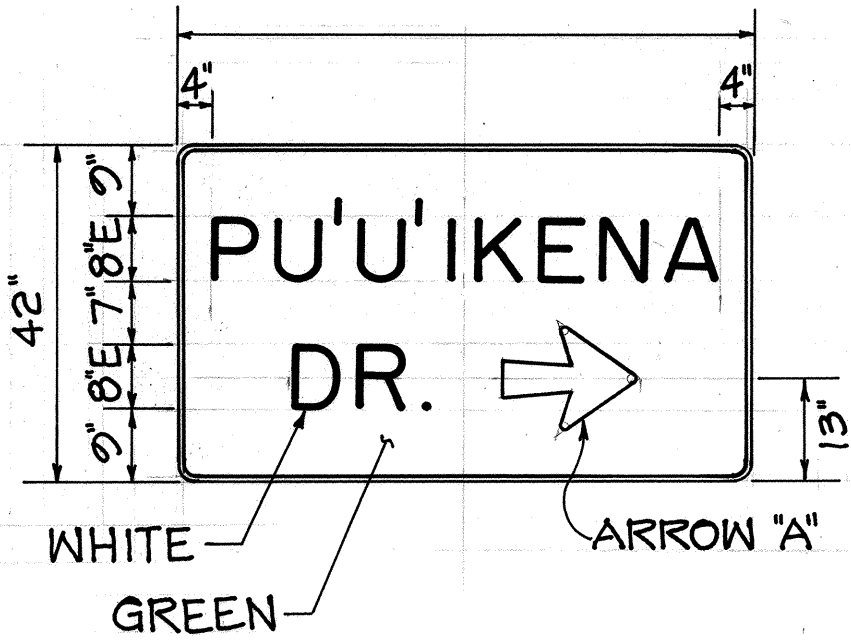

### DI-2 SIGNS

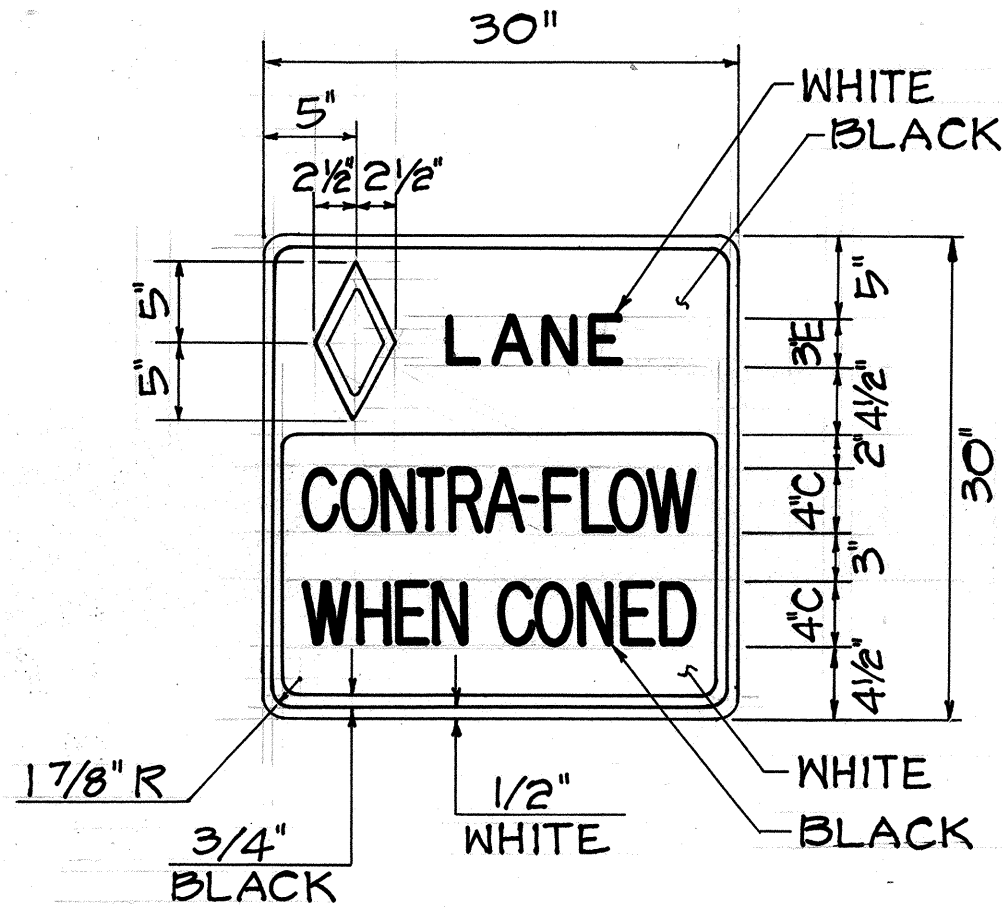

ORIGINAL PLAN	SURVEY PLOTTED BY	DATE
NOTE BOOK	DRAWN BY	
	DESIGNED BY	
	CHECKED BY	
	NO.	