
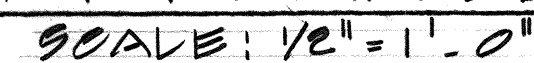
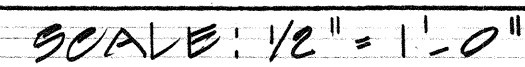
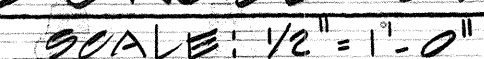


NH_2 

1. BROWN: UNDERSIDE OF
ROOF STRUCTURE;
FASCIA
2. BROWN: CROSS BEAM,
TILE COLUMN

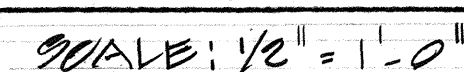

7. FOR POOR SOIL OR FOR AREAS WHERE POSSIBLE SOIL PROBLEMS MAY BE ANTICIPATED, CONSULT AN ENGR. FOR SPECIFIC STUDIES AND RECOMMENDATIONS.

SHEET No.C-24 OF 24 SHEETS