



FED. ROAD DIST. NO.	STATE	FED. AID PROJ. NO.	FISCAL YEAR	SHEET NO.	TOTAL SHEETS
HAWAII	HAW.	NH-STP-072-1(35)	1993	57	240

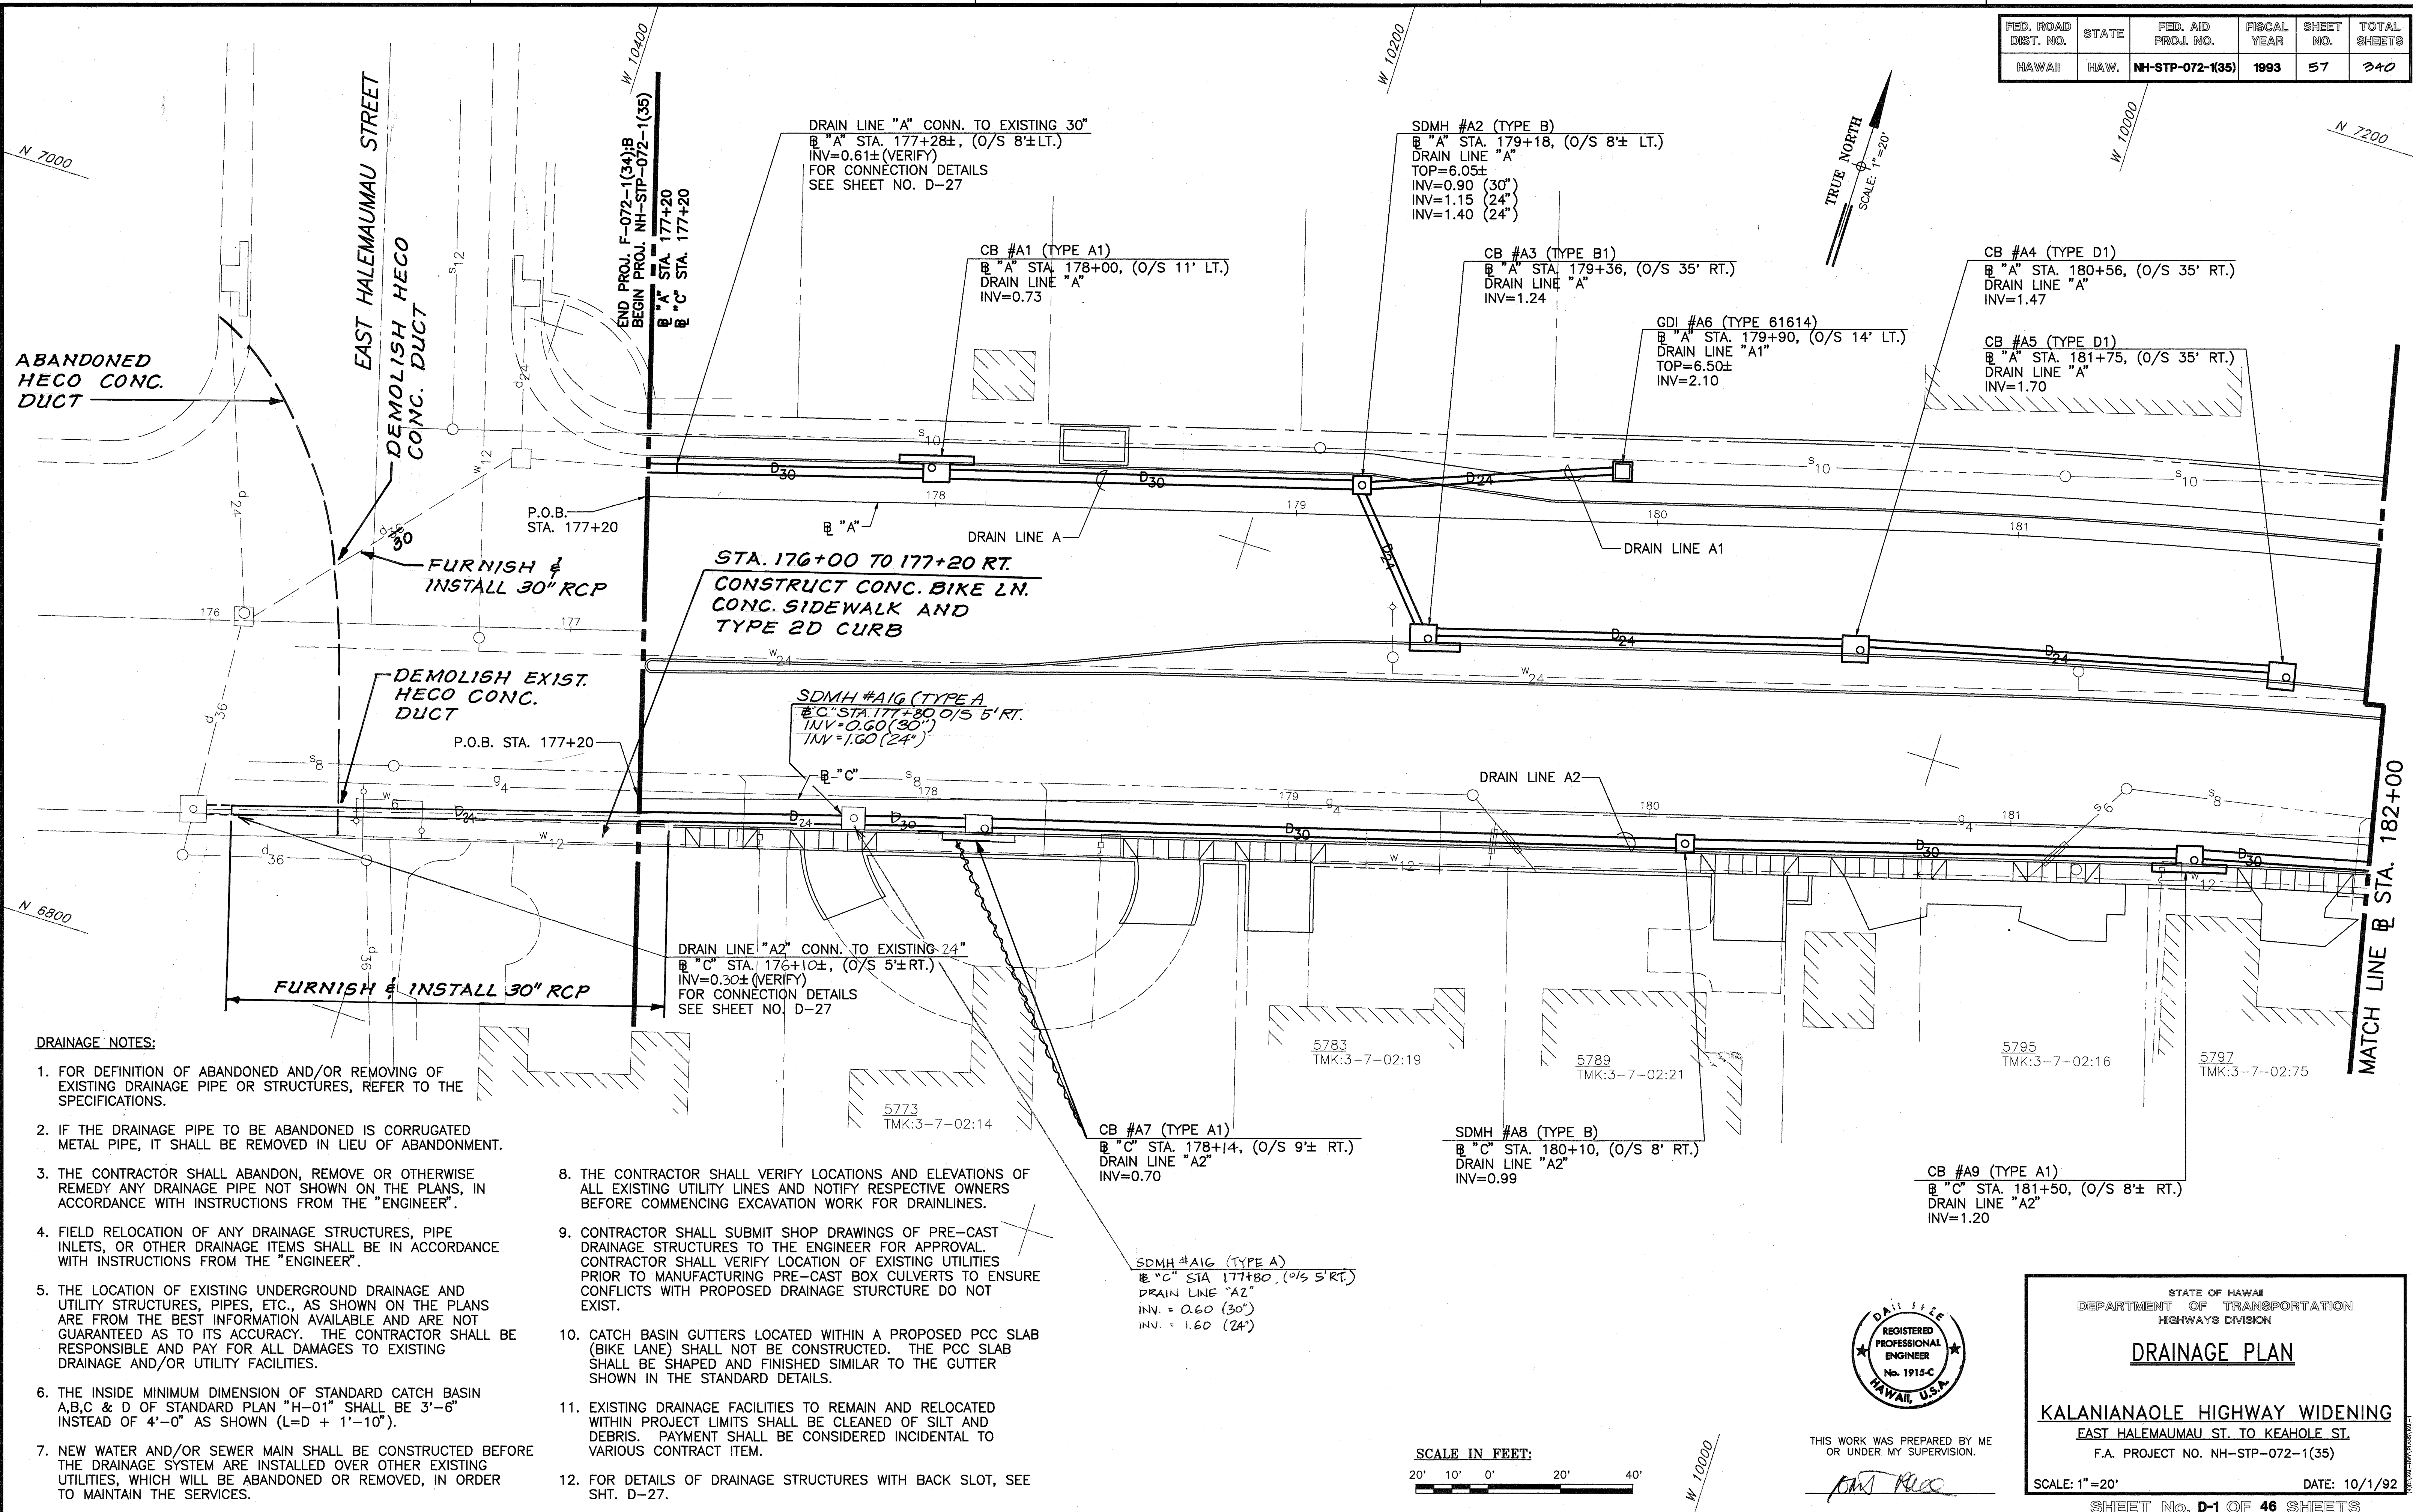

ORIGINAL PLAN	DATE
DRAWN BY	
DESIGNED BY	
NOTED BY	
CHECKED BY	
NO.	

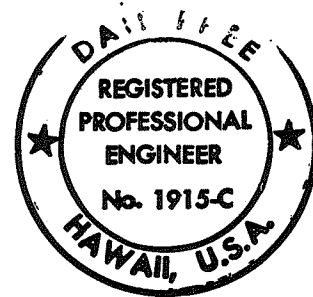

THIS WORK WAS PREPARED BY ME OR UNDER MY SUPERVISION.

STATE OF HAWAII
DEPARTMENT OF TRANSPORTATION
HIGHWAYS DIVISION


DRAINAGE PLAN

KALANIANA'OLE HIGHWAY WIDENING
EAST HALEMAU ST. TO KEAHOE ST.
F.A. PROJECT NO. NH-STP-072-1(35)


SCALE: 1"=20' DATE: 10/1/92

SHEET No. D-1 OF 46 SHEETS


FED. ROAD DIST. NO.	STATE	FED. AID PROJ. NO.	FISCAL YEAR	SHEET NO.	TOTAL SHEETS
HAWAII	HAW.	NH-STP-072-1(35)	1993	58	340

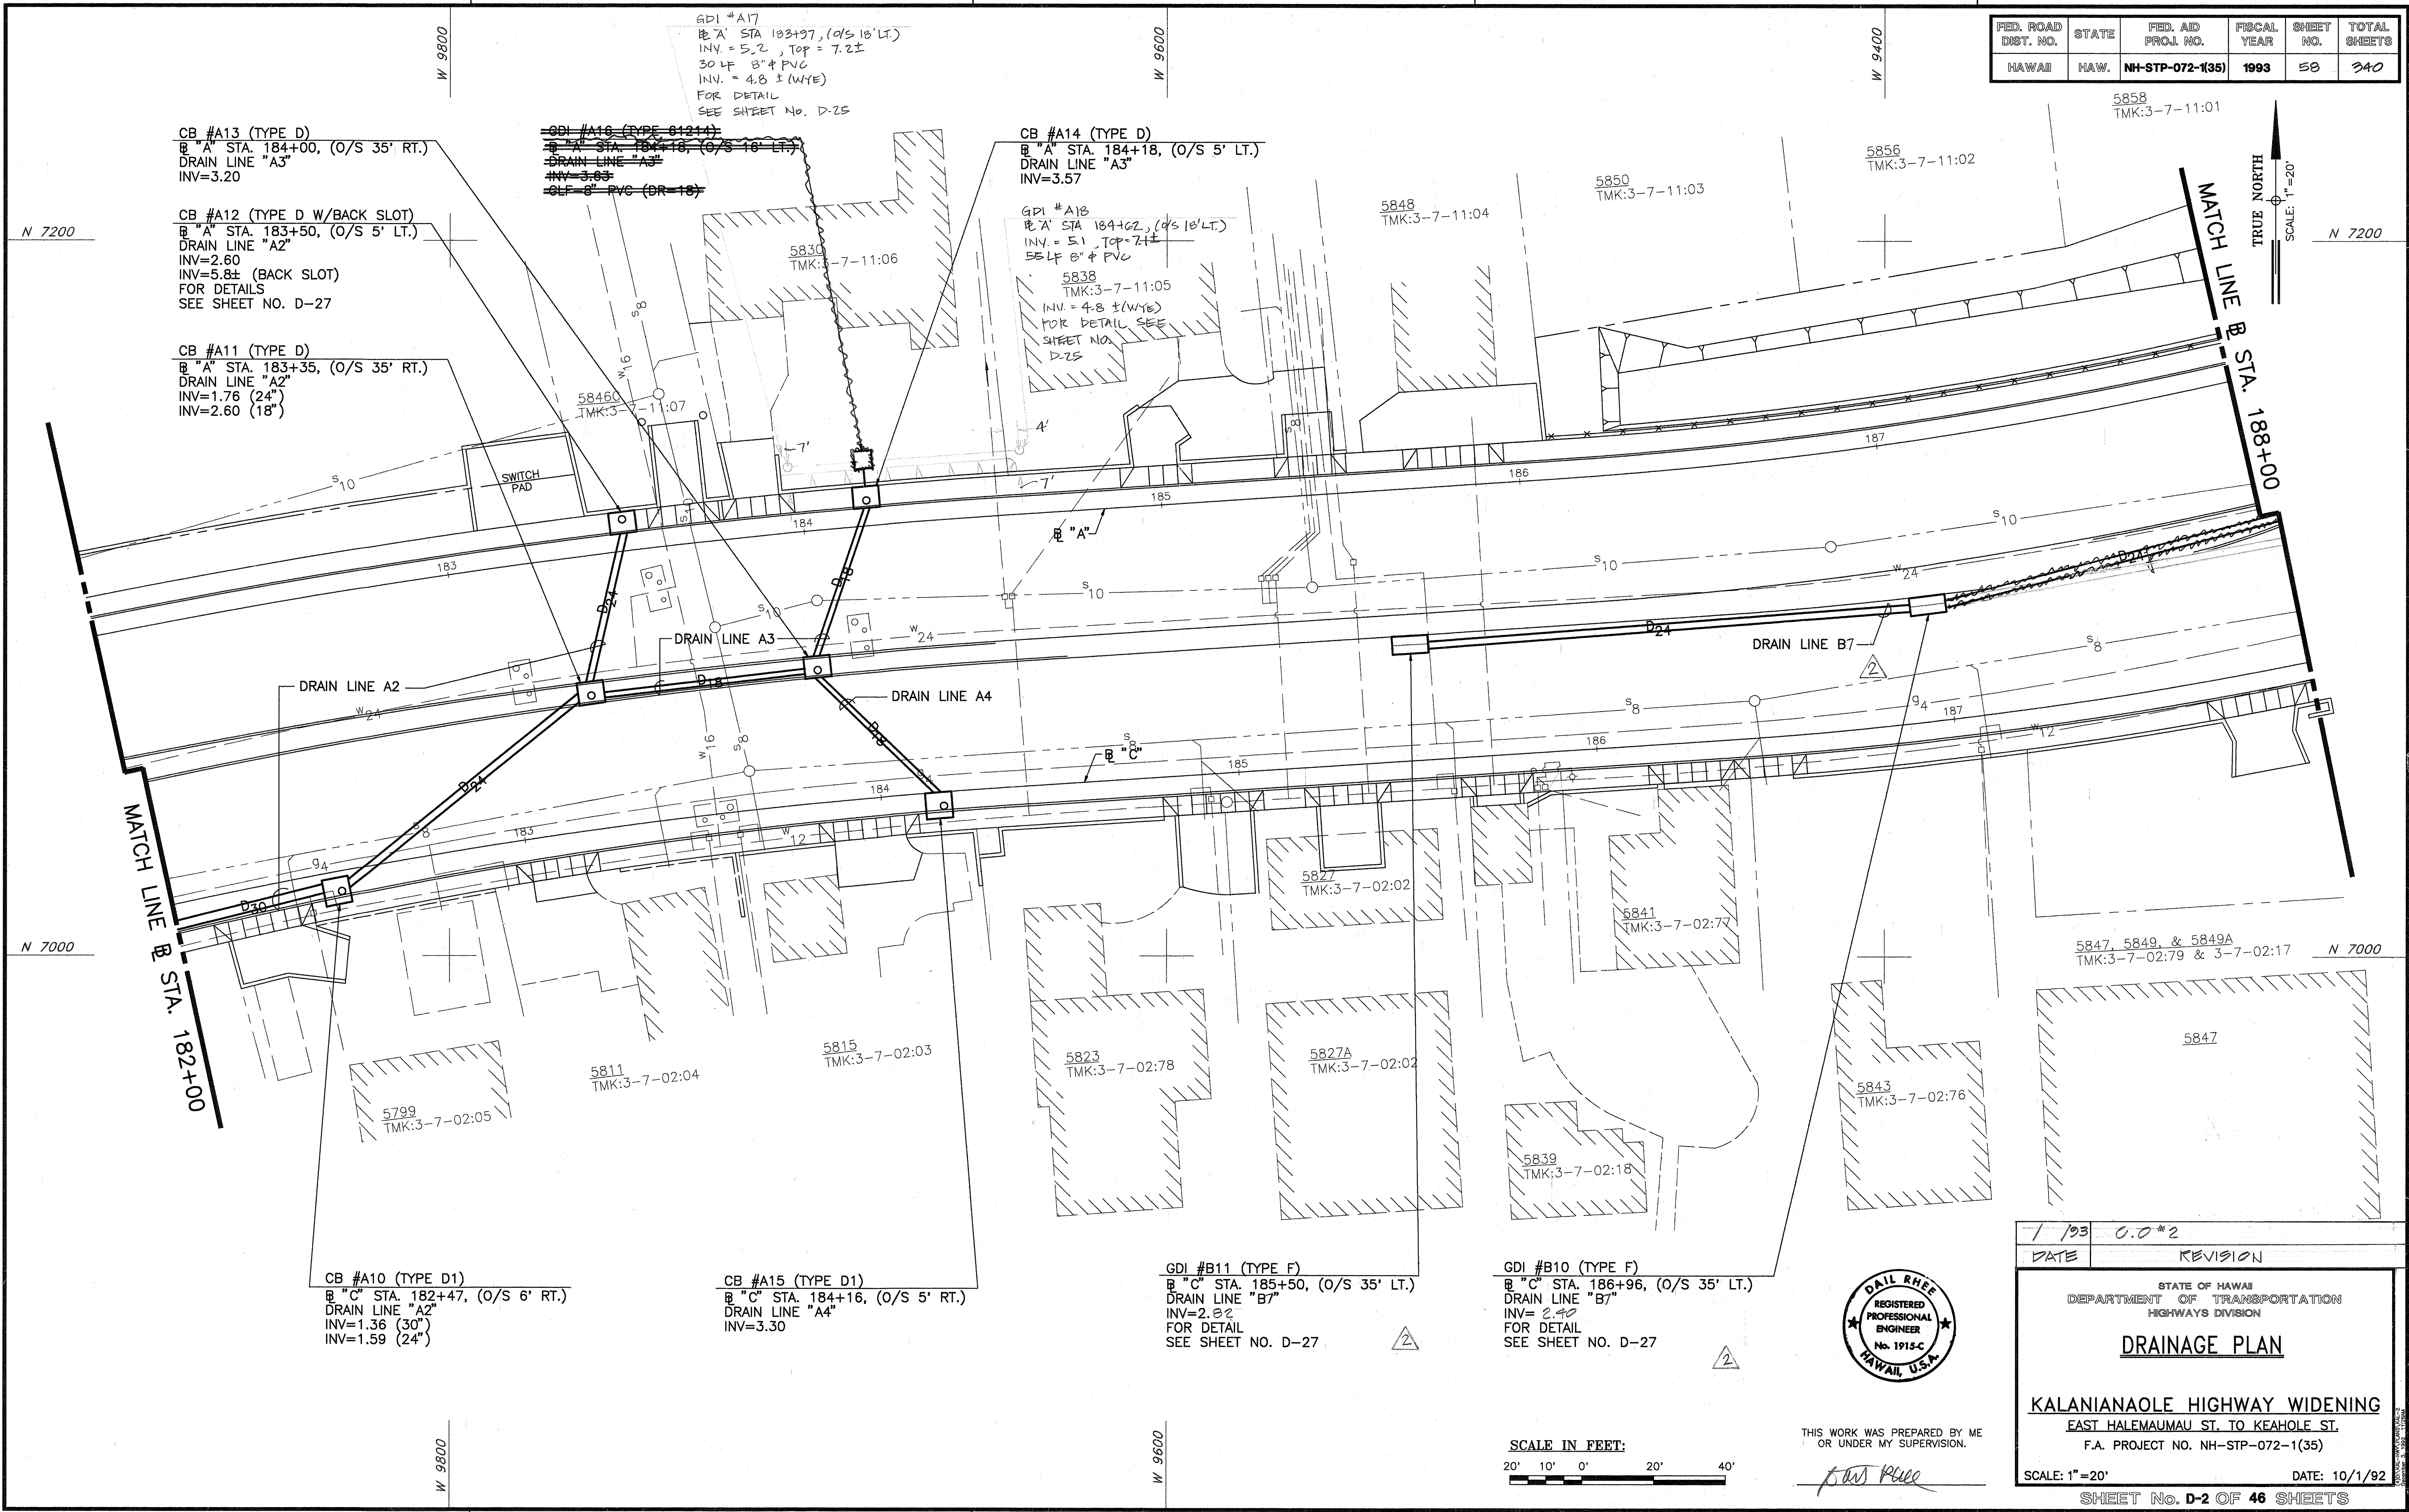

SURVEY PLOTTED BY	DATE
DRAWN BY	
DESIGNED BY	
CHECKED BY	
ORIGINAL PLAN	
NOTE BOOK	
No.	

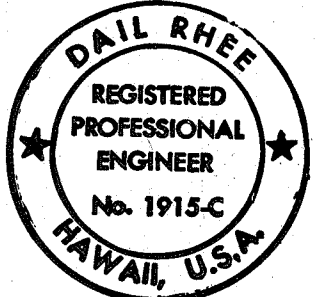

THIS WORK WAS PREPARED BY ME OR UNDER MY SUPERVISION.

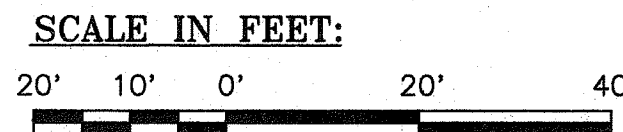

DATE	REVISION
1/93	0.0*2

STATE OF HAWAII
DEPARTMENT OF TRANSPORTATION
HIGHWAYS DIVISION

DRAINAGE PLAN

KALANIANA'OLE HIGHWAY WIDENING
EAST HALEMAUMAU ST. TO KEAHOE ST.
F.A. PROJECT NO. NH-STP-072-1(35)

SCALE: 1"=20' DATE: 10/1/92


SHEET No. D-2 OF 46 SHEETS

TRUE NORTH

MAGNETIC NORTH

SCALE: 1" = 20°


W 8800

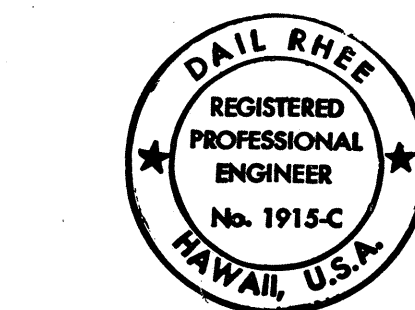



Ans False

C.O. 59

FED. ROAD DIST. NO.	STATE	FED. AID PROJ. NO.	FISCAL YEAR	SHEET NO.	TOTAL SHEETS
HAWAII	HAW.	NH-STP-072-1(35)	1993	60	240

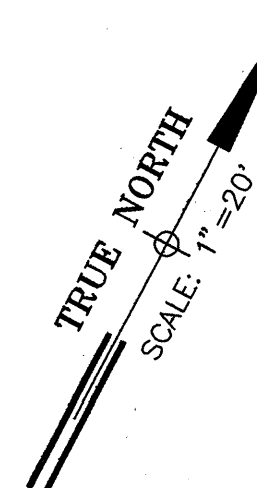


DATE	_____
SURVEY PLOTTED BY	_____
DRAWN BY	_____
DESIGNED BY	_____
CHECKED BY	_____
ORIGINAL PLAN	_____
NOTE BOOK	_____
No.	_____

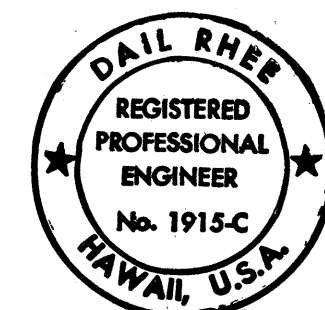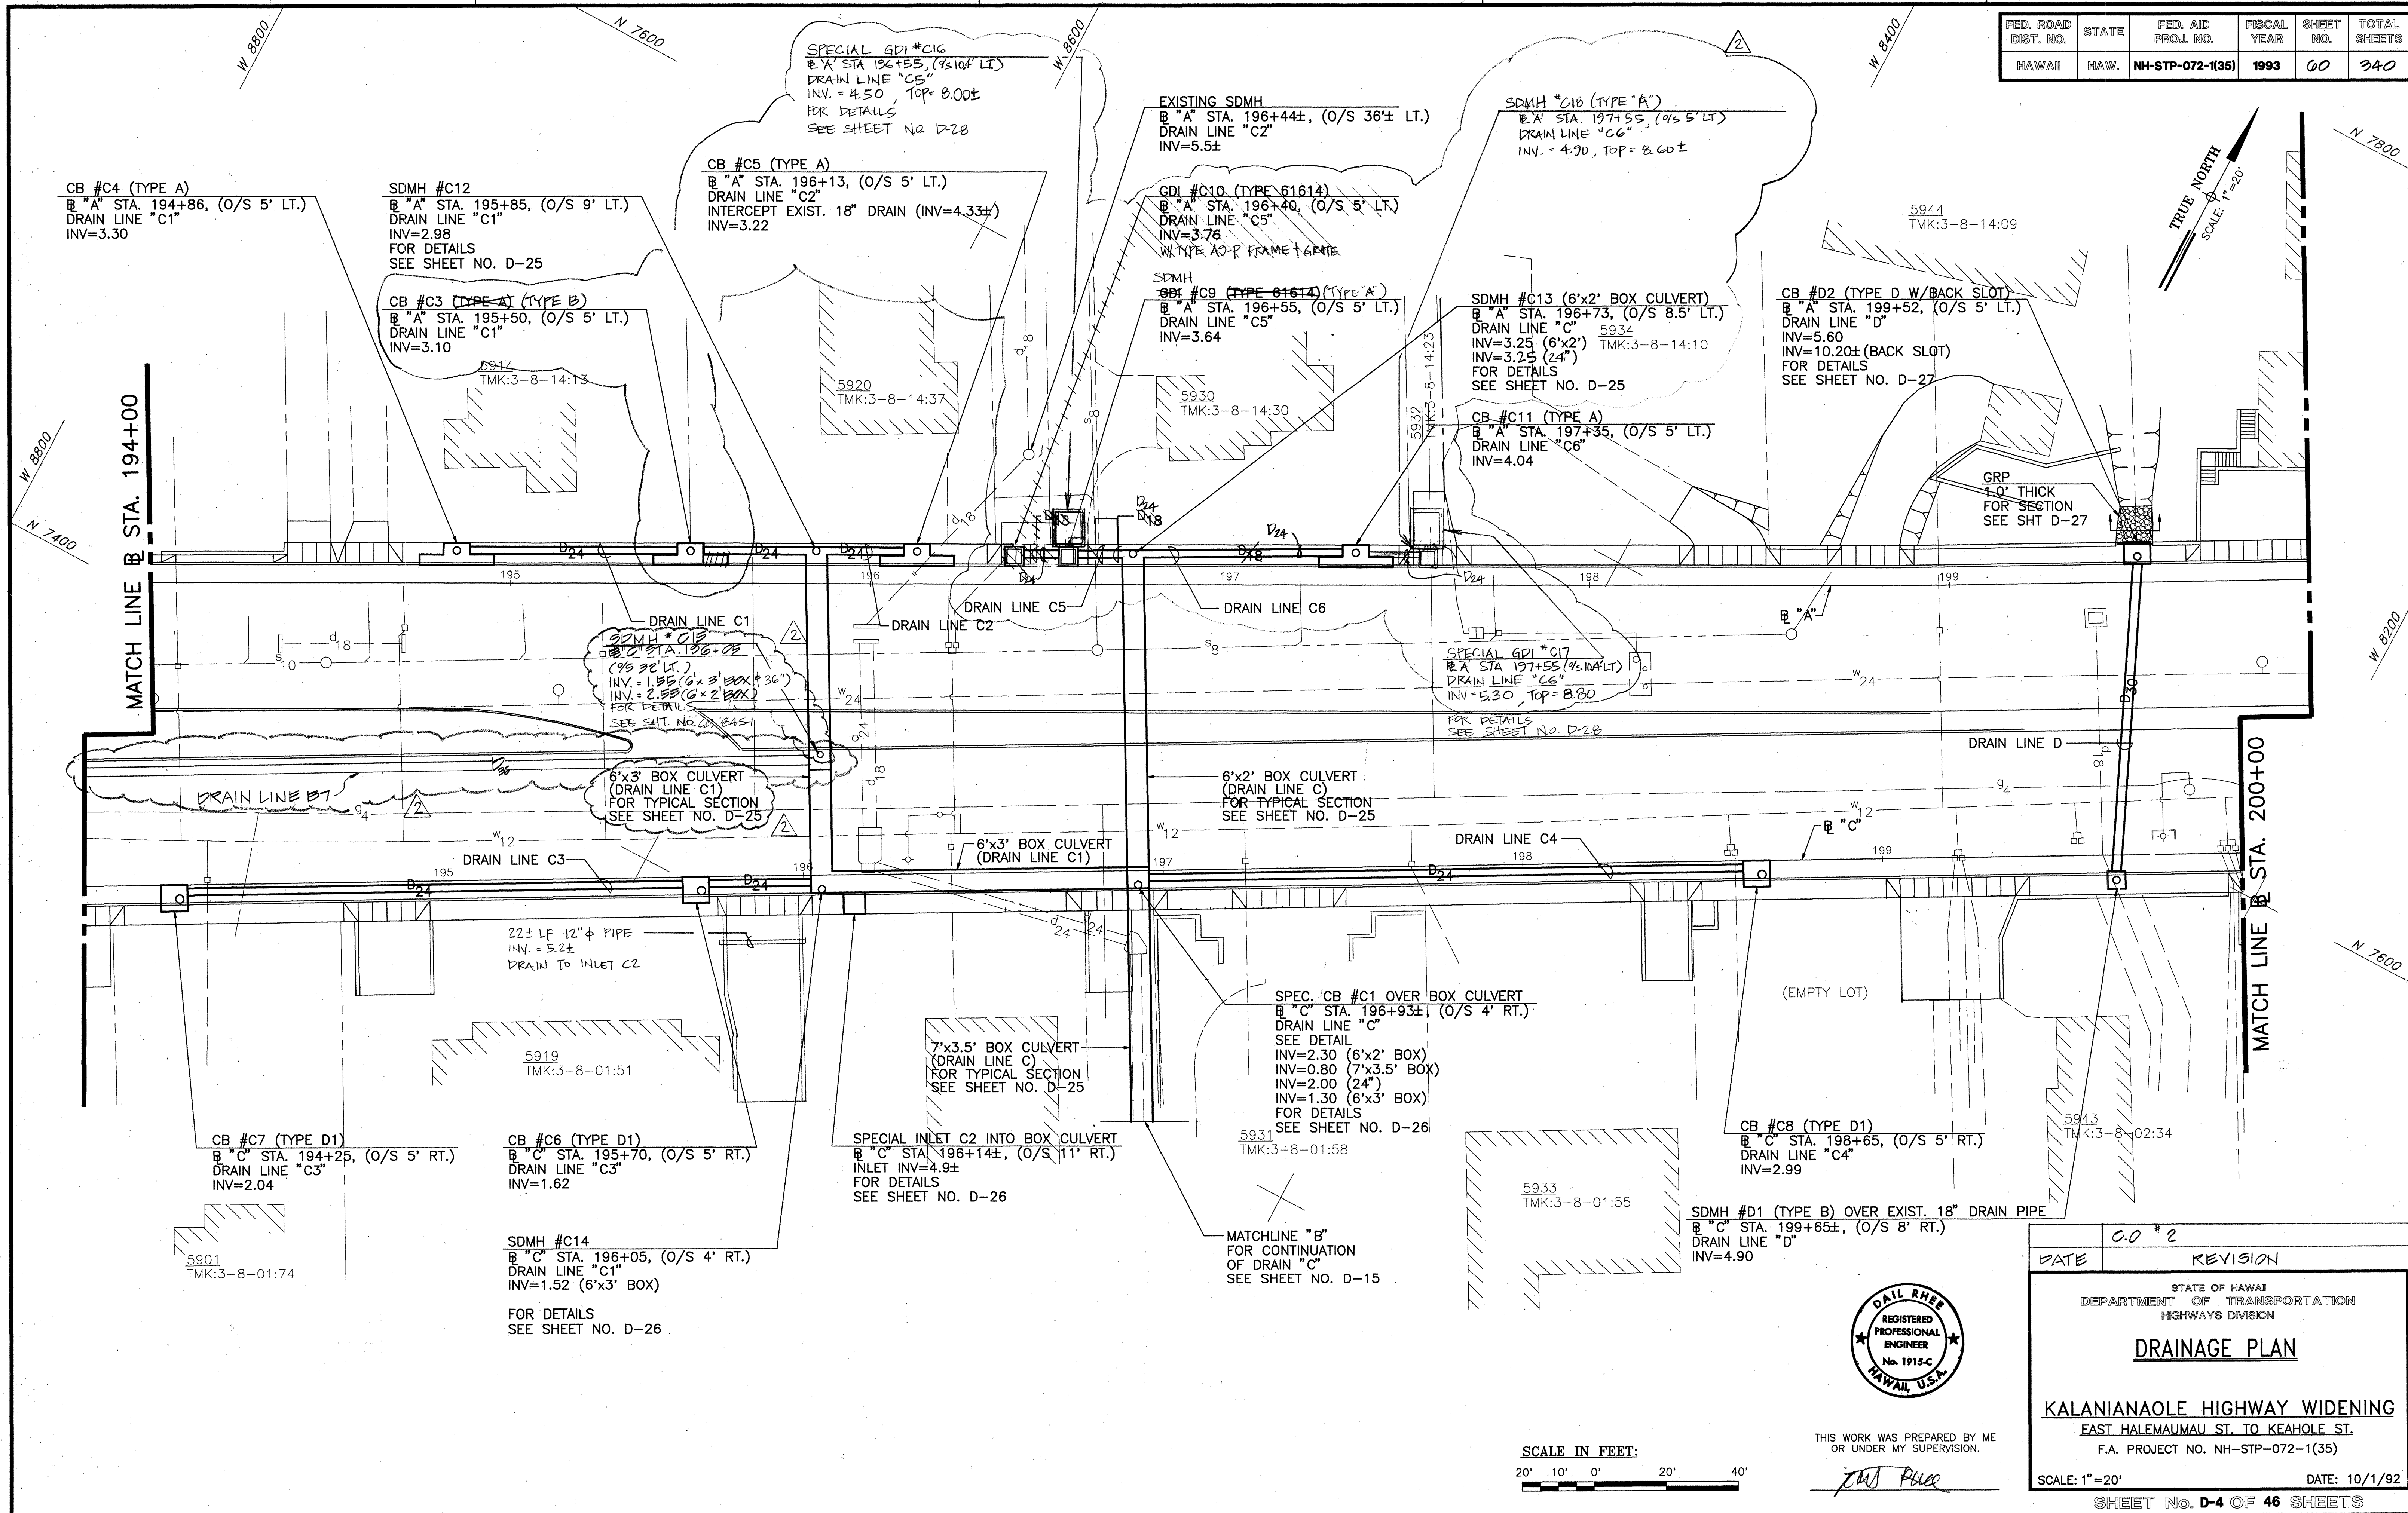

THIS WORK WAS PREPARED BY ME OR UNDER MY SUPERVISION.


JMS Price

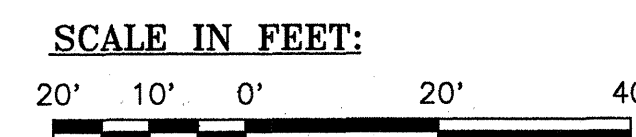


DATE	10/1/92
REVISION	C.O. #2
STATE OF HAWAII DEPARTMENT OF TRANSPORTATION HIGHWAYS DIVISION	
DRAINAGE PLAN	
KALANIANA'OLE HIGHWAY WIDENING EAST HALEMAUMAU ST. TO KEAHOLE ST. F.A. PROJECT NO. NH-STP-072-1(35)	
SCALE: 1"=20'	DATE: 10/1/92
SHEET No. D-4 OF 46 SHEETS	

C.O. 60

FED. ROAD DIST. NO.	STATE	FED. AID PROJ. NO.	FISCAL YEAR	SHEET NO.	TOTAL SHEETS
HAWAII	HAW.	NH-STP-072-1(35)	1993	61	340

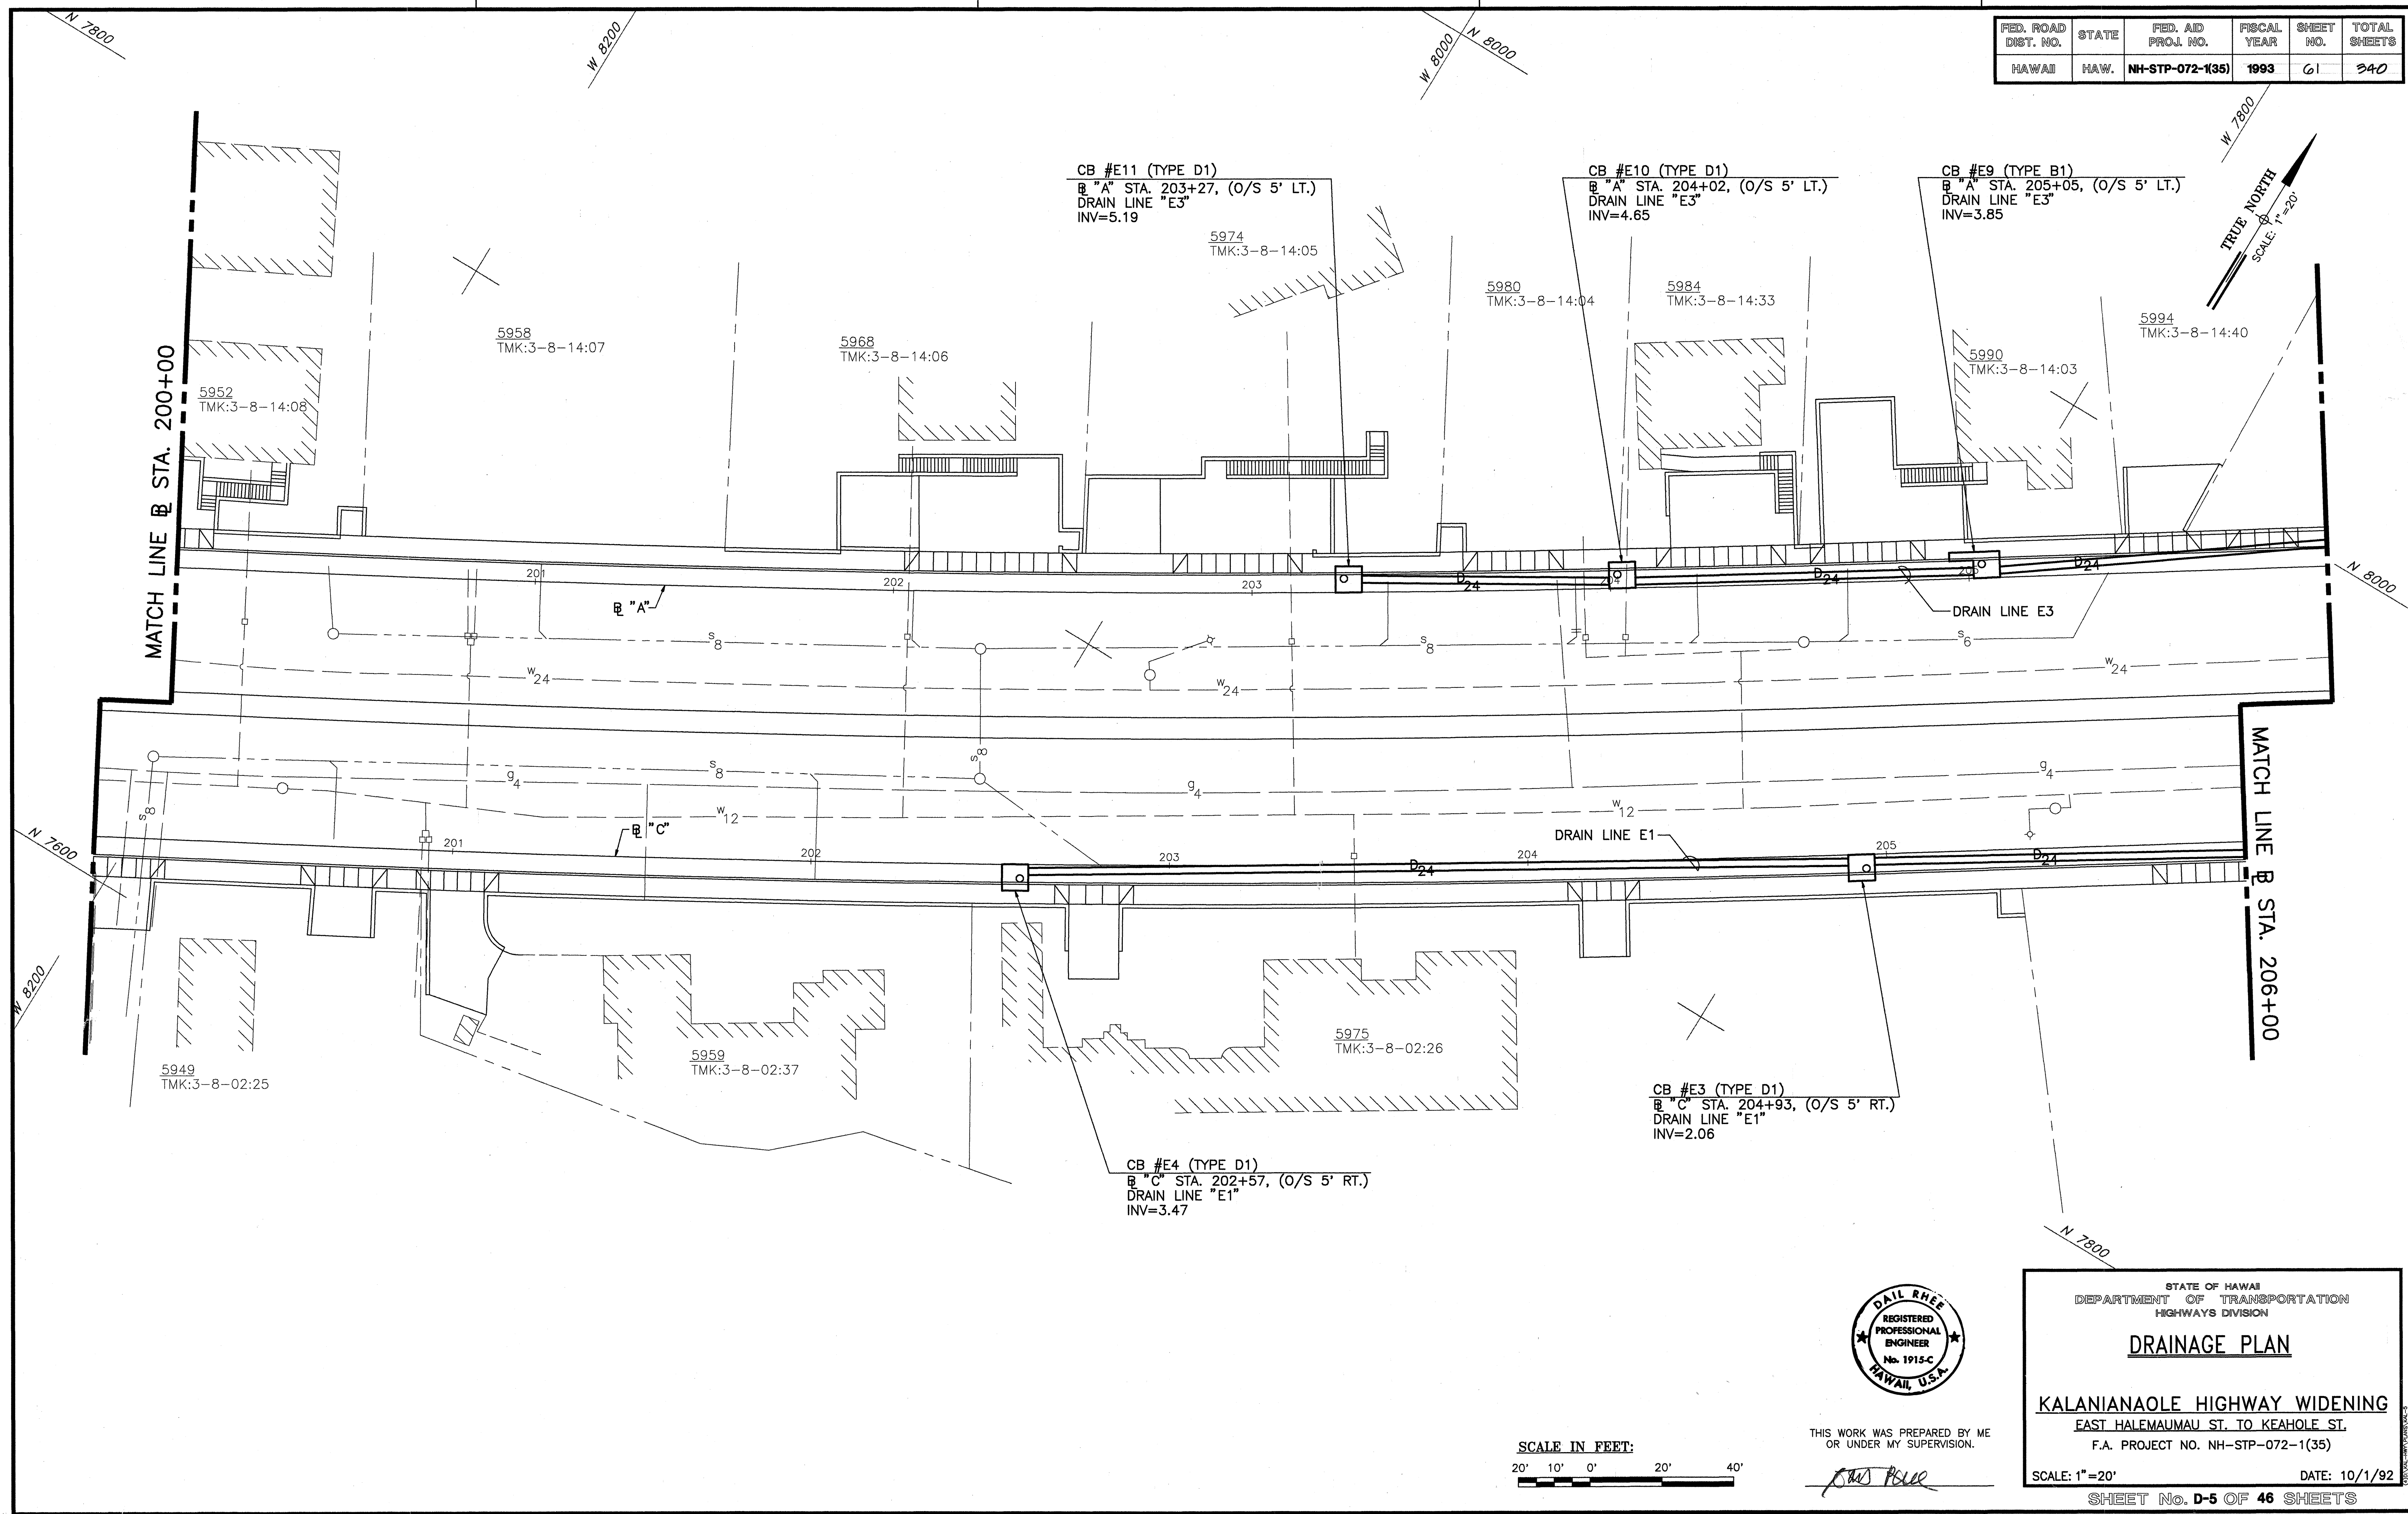


ORIGINAL PLAN	DATE
DRAWN BY	
DESIGNED BY	
NOTED BY	
CHECKED BY	
NO.	

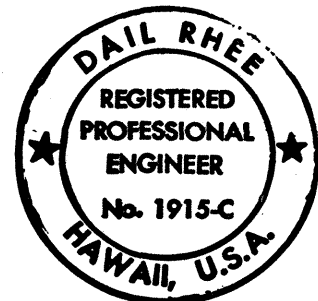

THIS WORK WAS PREPARED BY ME OR UNDER MY SUPERVISION.

DAIL RHEE

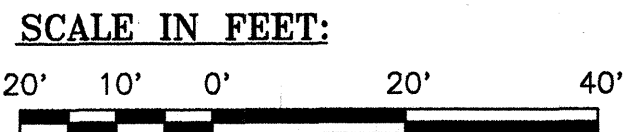

STATE OF HAWAII
DEPARTMENT OF TRANSPORTATION
HIGHWAYS DIVISION


DRAINAGE PLAN

KALANIANAʻOLE HIGHWAY WIDENING
EAST HALEMAUMAU ST. TO KEAHOLE ST.
F.A. PROJECT NO. NH-STP-072-1(35)


SCALE: 1"=20' DATE: 10/1/92

SHEET No. D-5 OF 46 SHEETS

FED. ROAD DIST. NO.	STATE	FED. AID PROJ. NO.	FISCAL YEAR	SHEET NO.	TOTAL SHEETS
HAWAII	HAW.	NH-STP-072-1(35)	1993	62	240

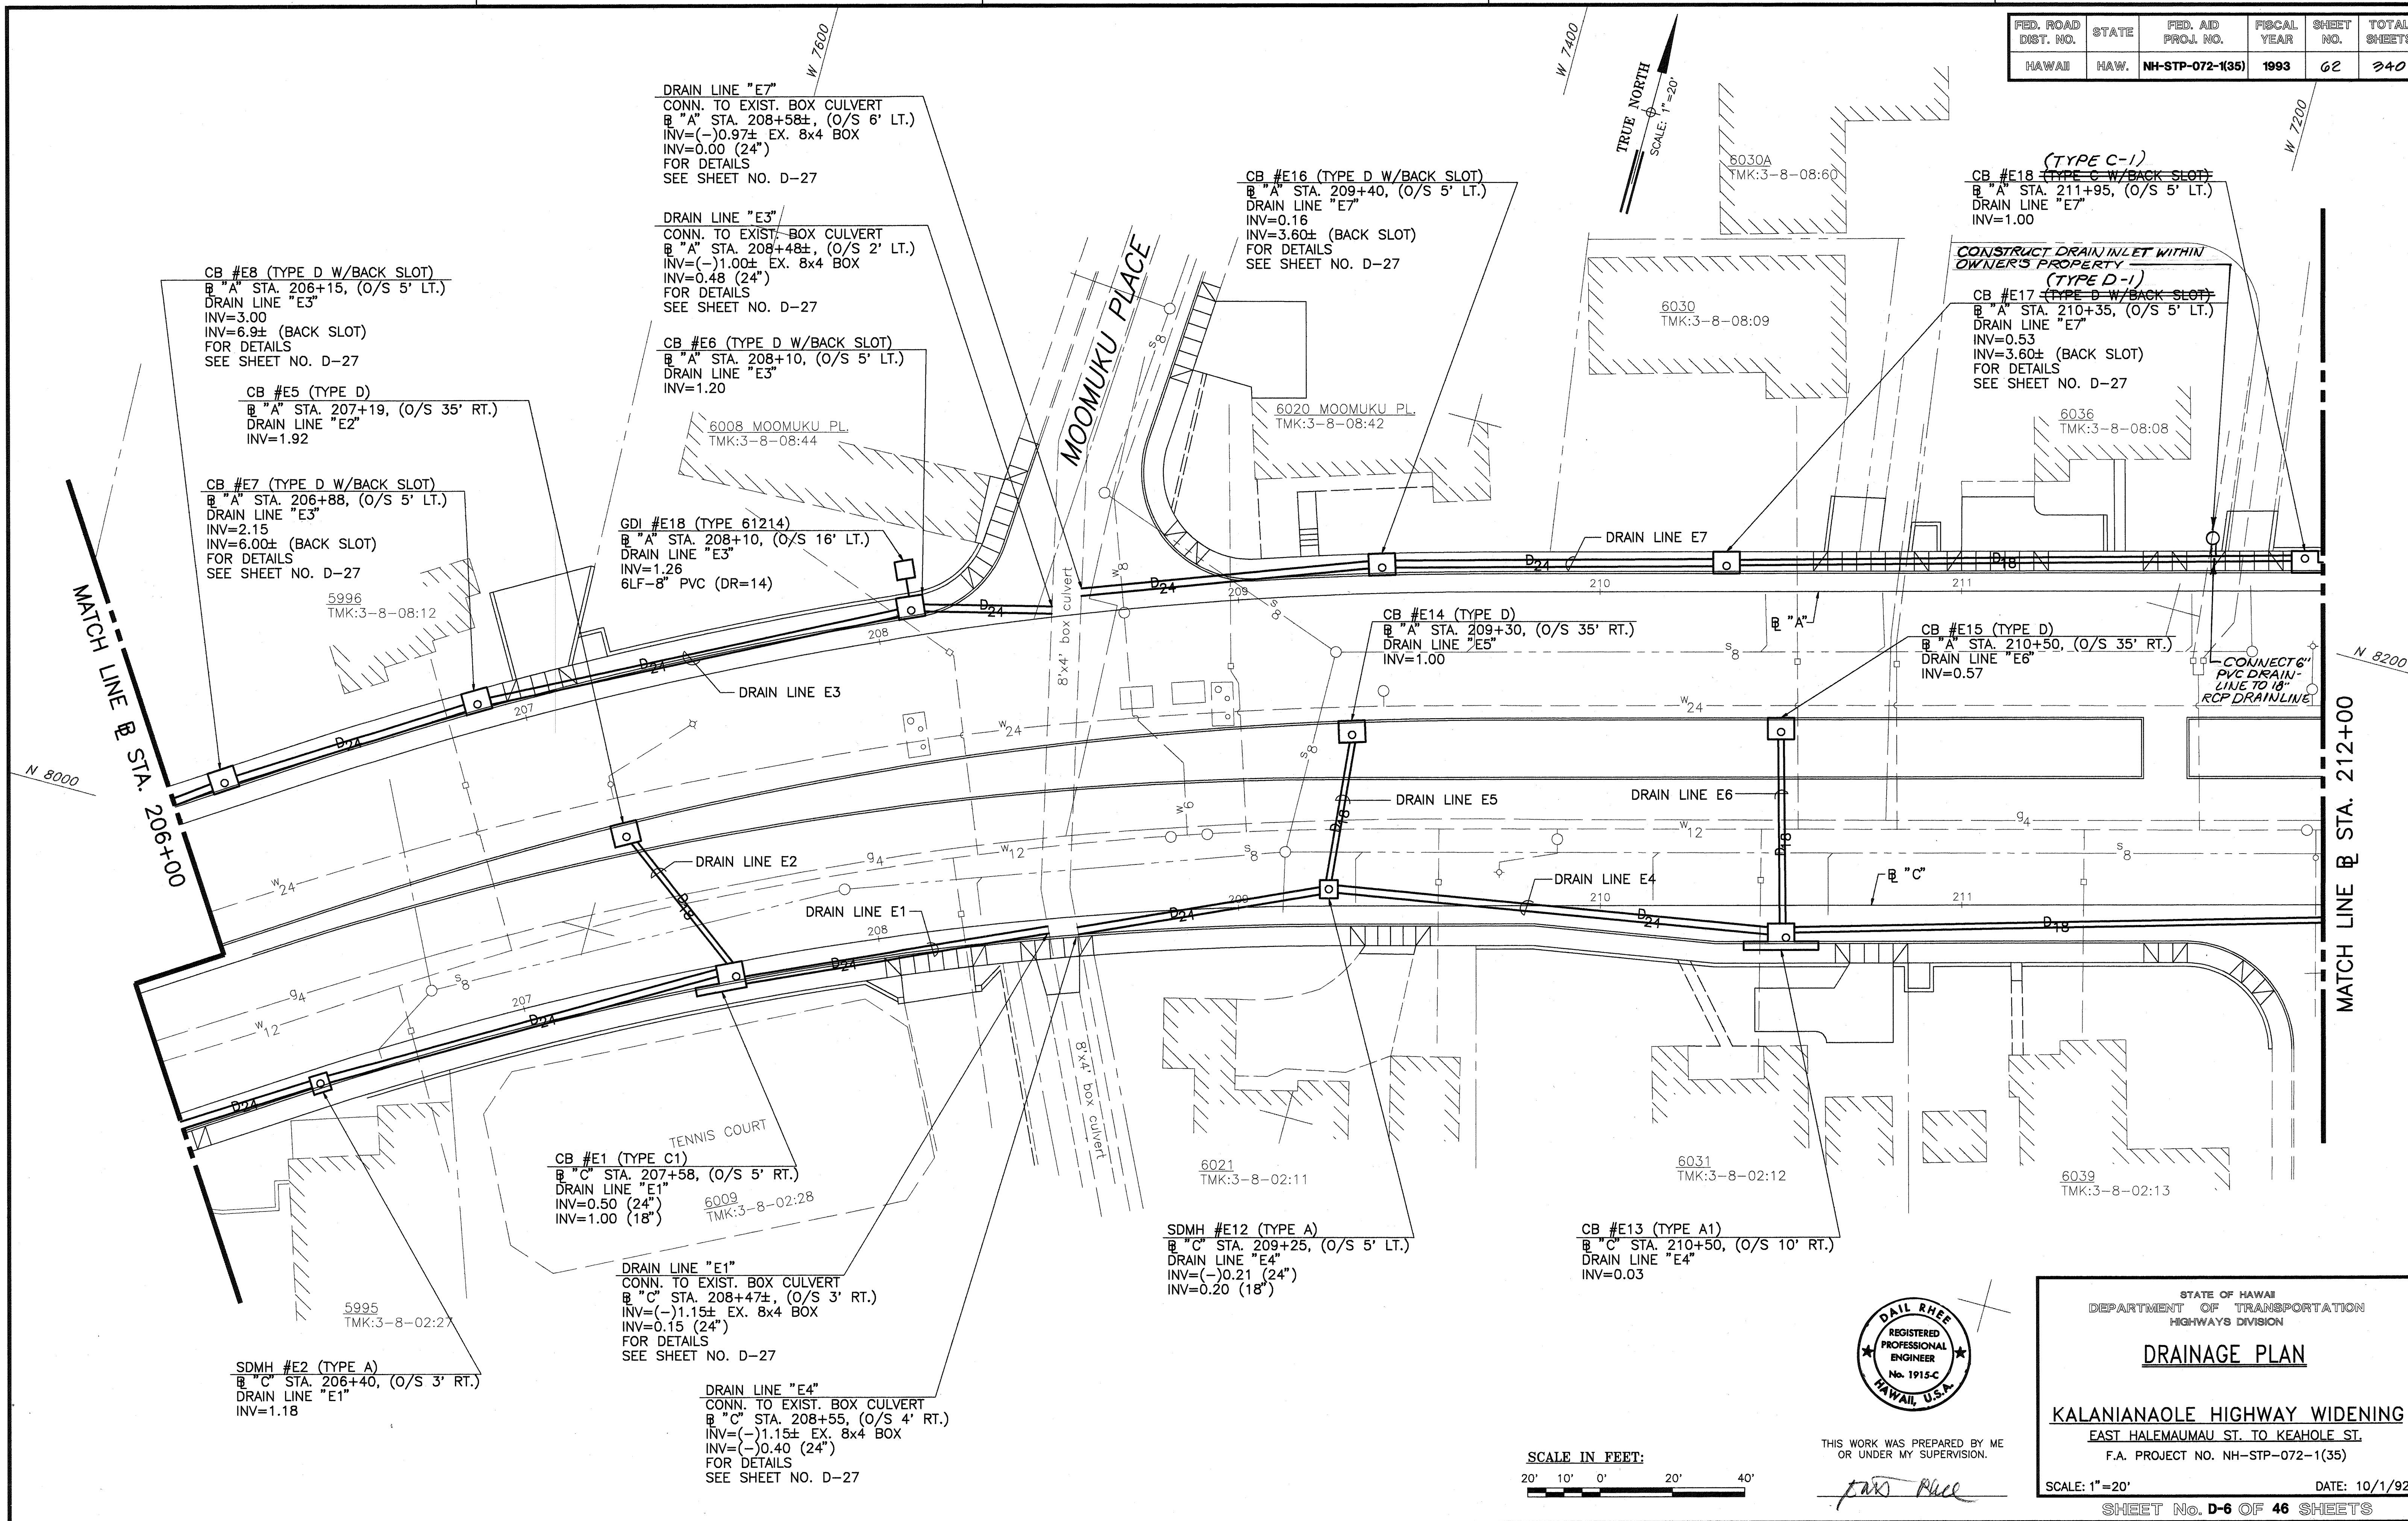

ORIGINAL PLAN	SURVEY PLOTTED BY	DATE
NOTE BOOK	DRAWN BY	
QUANTITIES BY	DESIGNED BY	
CHECKED BY		

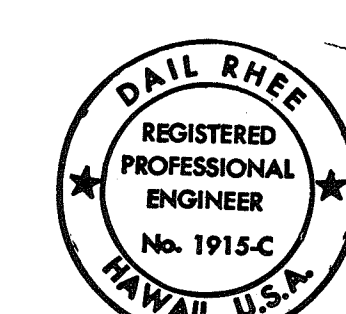

STATE OF HAWAII
DEPARTMENT OF TRANSPORTATION
HIGHWAYS DIVISION

DRAINAGE PLAN


KALANIANA'OLE HIGHWAY WIDENING
EAST HALEMAUMAU ST. TO KEAHOLE ST.
F.A. PROJECT NO. NH-STP-072-1(35)

SCALE: 1"=20' DATE: 10/1/92

SHEET No. D-6 OF 46 SHEETS



THIS WORK WAS PREPARED BY ME
OR UNDER MY SUPERVISION.

DAIL RHEE

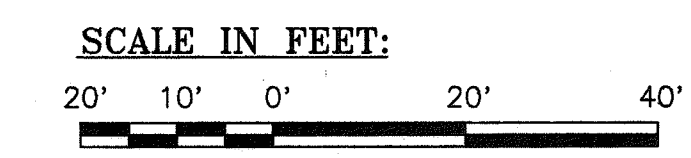

"AS-BUILT"

FED. ROAD DIST. NO.	STATE	FED. AID PROJ. NO.	FISCAL YEAR	SHEET NO.	TOTAL SHEETS
HAWAII	HAW.	NH-STP-072-1(35)	1993	63	340

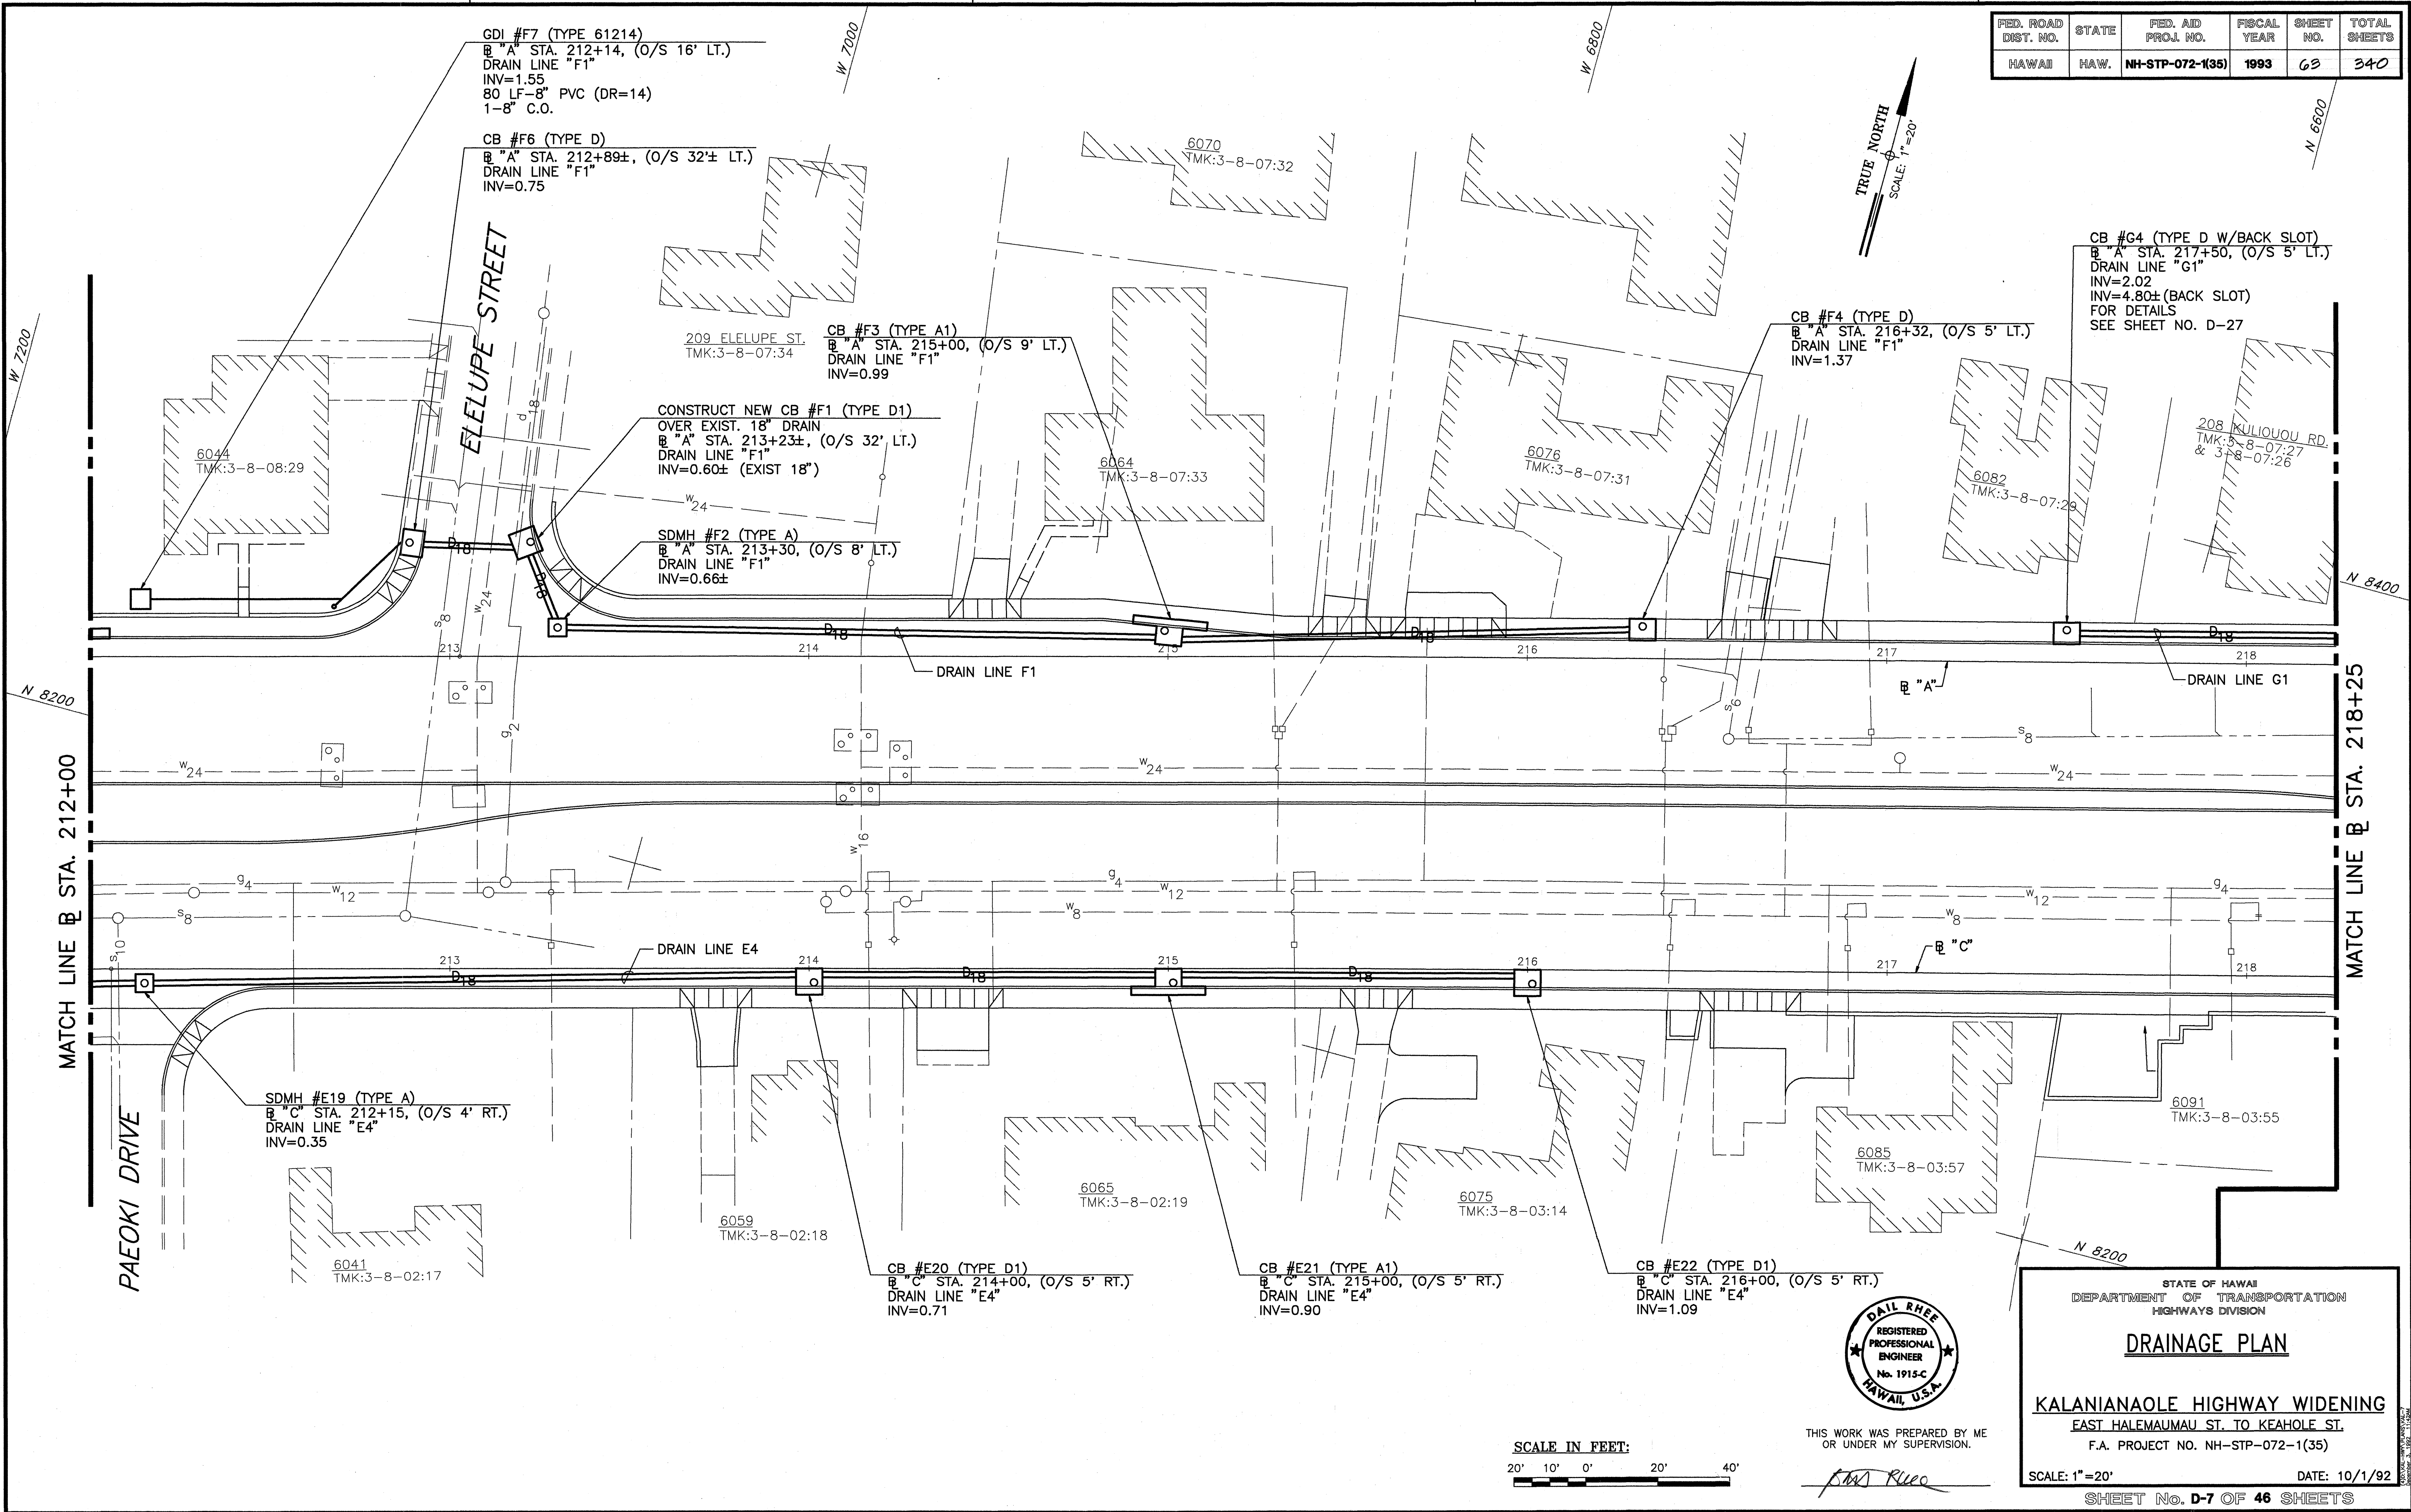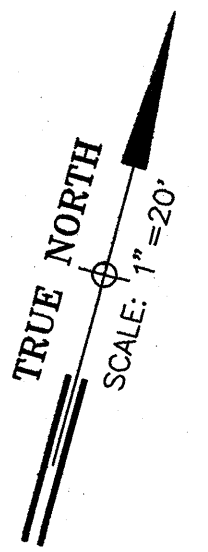

SURVEY PLOTTED BY	DATE
DRAWN BY	
DESIGNED BY	
QUANTITIES BY	
CHECKED BY	
ORIGINAL PLAN	
NOTE BOOK	
No.	



THIS WORK WAS PREPARED BY ME
 OR UNDER MY SUPERVISION.

DAIL RHEE


STATE OF HAWAII
 DEPARTMENT OF TRANSPORTATION
 HIGHWAYS DIVISION

DRAINAGE PLAN

KALANIANA'OLE HIGHWAY WIDENING
 EAST HALEMAUMAU ST. TO KEAHOLE ST.
 F.A. PROJECT NO. NH-STP-072-1(35)

SCALE: 1"=20' DATE: 10/1/92
 SHEET NO. D-7 OF 46 SHEETS

FED. ROAD DIST. NO.	STATE	FED. AID PROJ. NO.	FISCAL YEAR	SHEET NO.	TOTAL SHEETS
HAWAII	HAW.	NH-STP-072-1(35)	1993	04	340

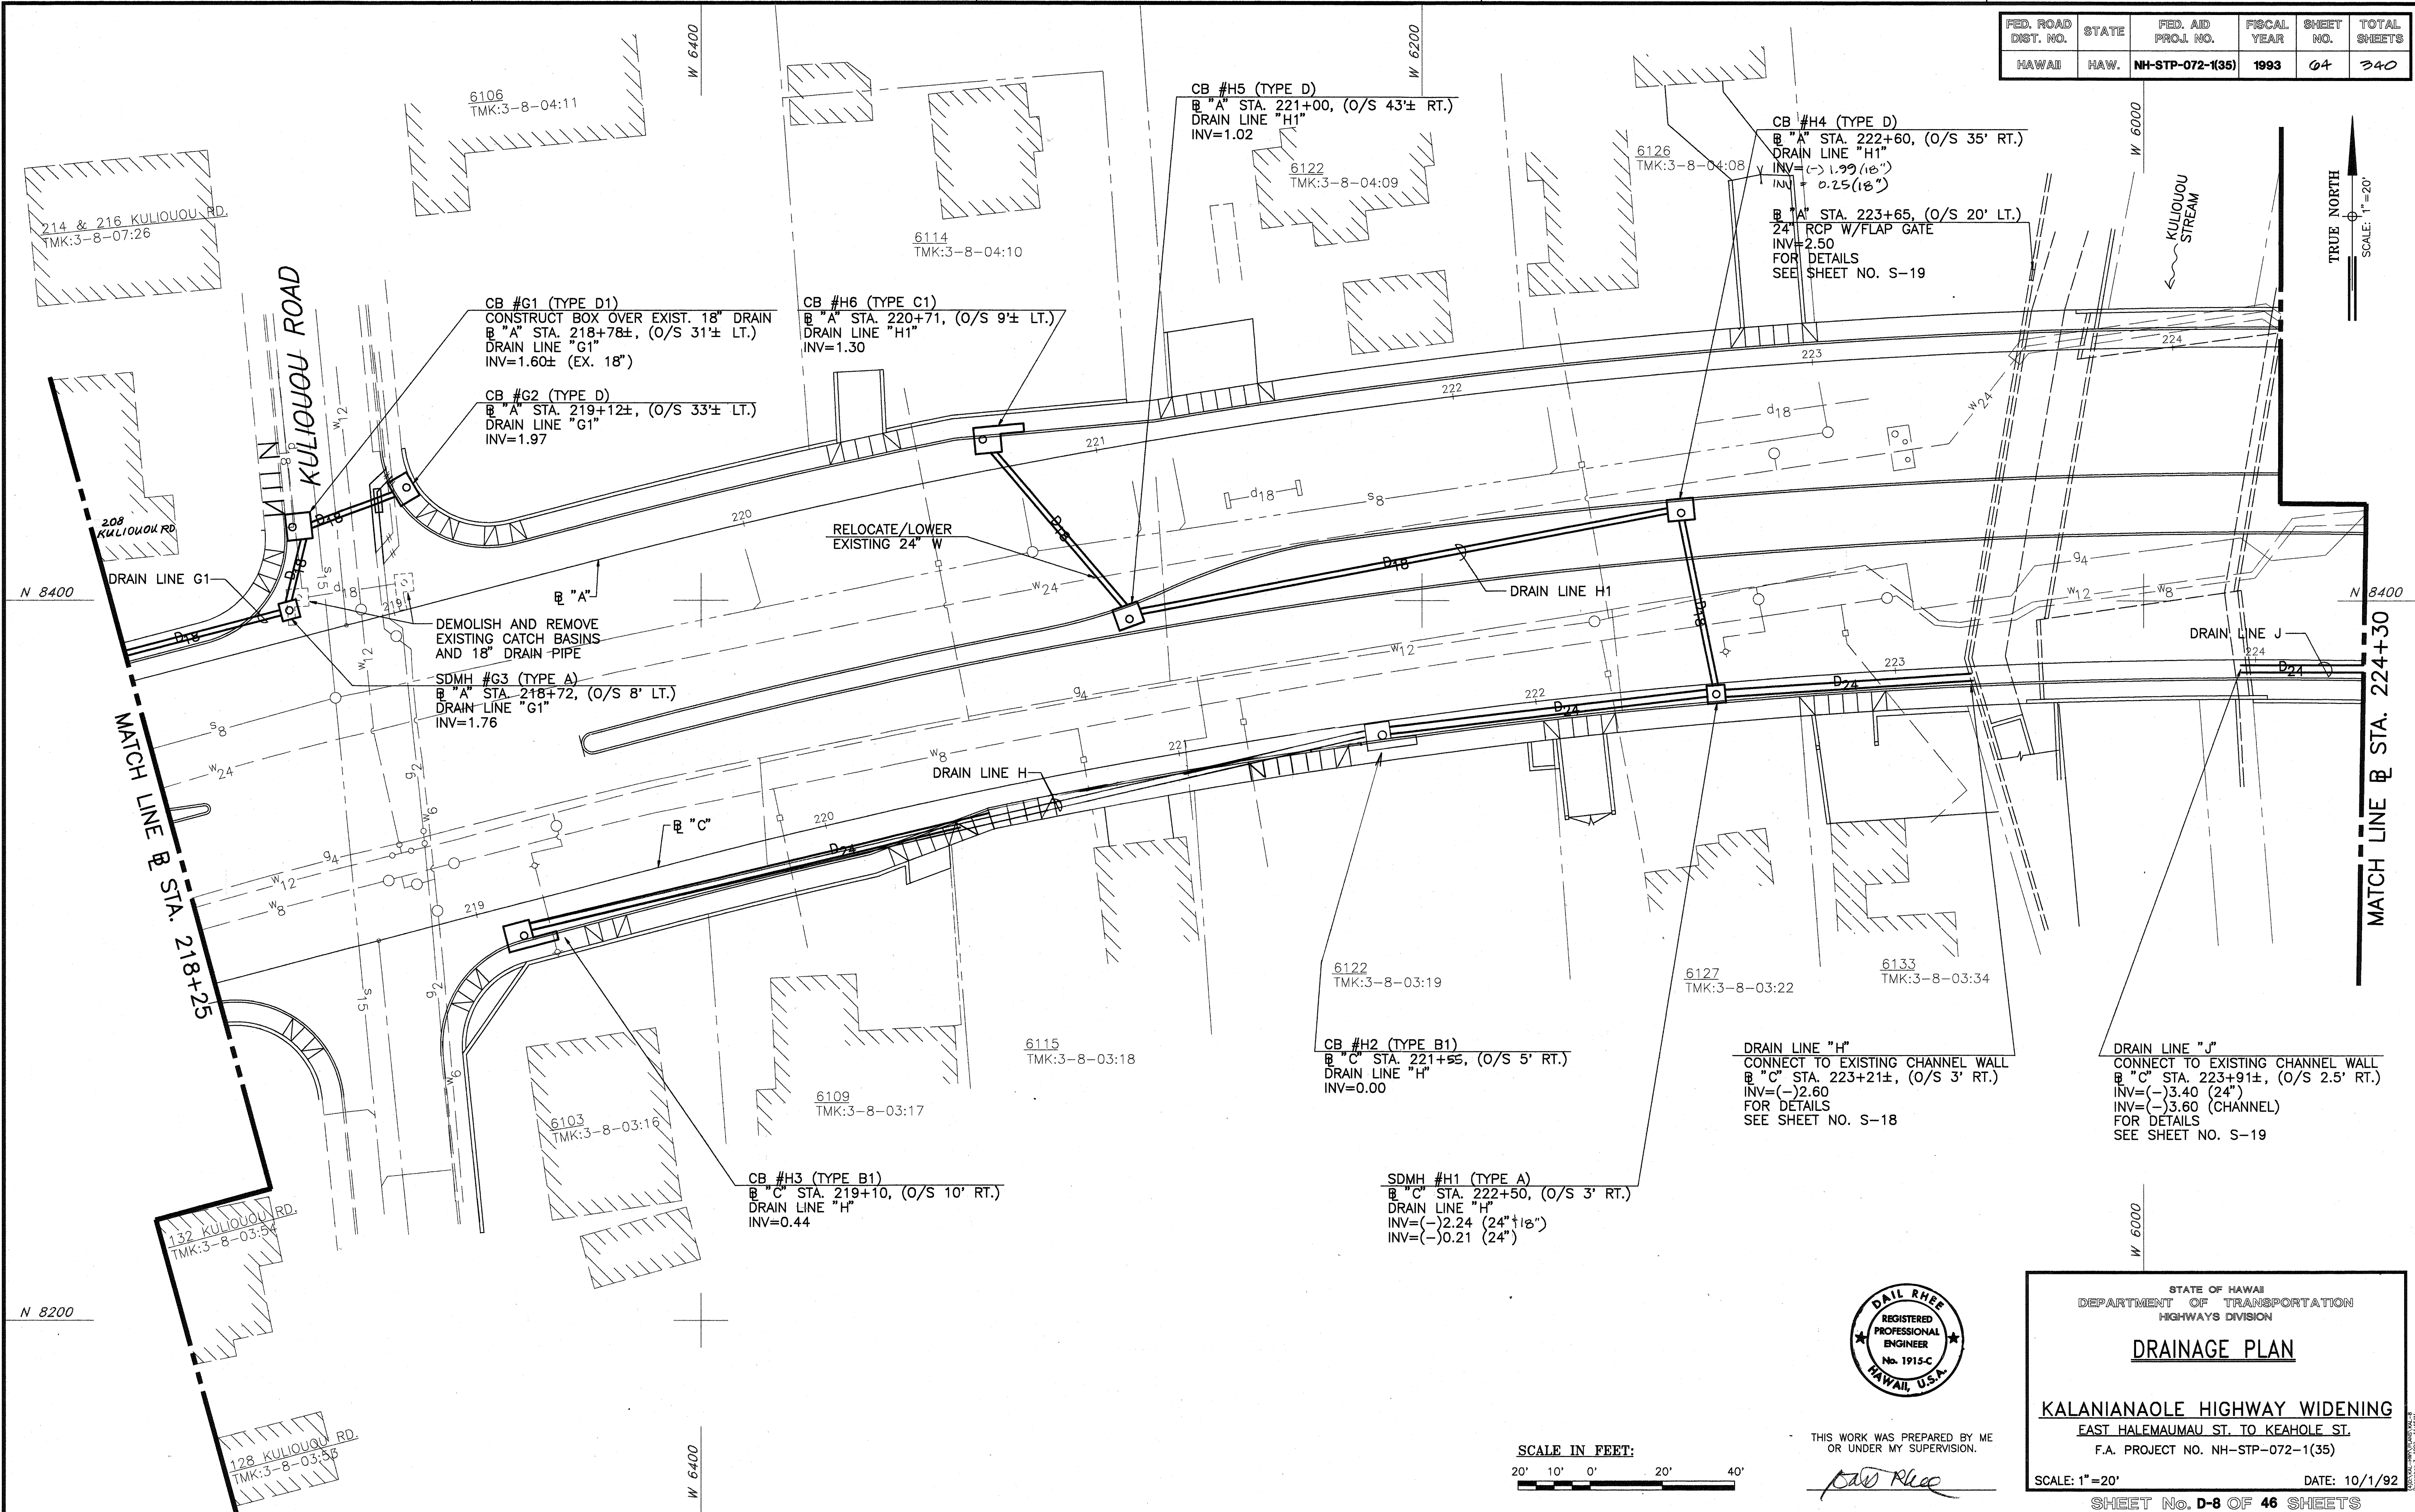

ORIGINAL PLAN	DATE
DESIGNED BY	
TRACED BY	
NOTE BOOK	
QUANTITIES BY	
CHECKED BY	



THIS WORK WAS PREPARED BY ME
OR UNDER MY SUPERVISION.

STATE OF HAWAII
DEPARTMENT OF TRANSPORTATION
HIGHWAYS DIVISION



DRAINAGE PLAN

KALANIANA'OLE HIGHWAY WIDENING
EAST HALEMAUMAU ST. TO KEAHOE ST.
F.A. PROJECT NO. NH-STP-072-1(35)

SCALE: 1"=20' DATE: 10/1/92



SHEET NO. D-8 OF 46 SHEETS

FED. ROAD DIST. NO.	STATE	FED. AID PROJ. NO.	FISCAL YEAR	SHEET NO.	TOTAL SHEETS
HAWAII	HAW.	NH-STP-072-1(35)	1993	65	340

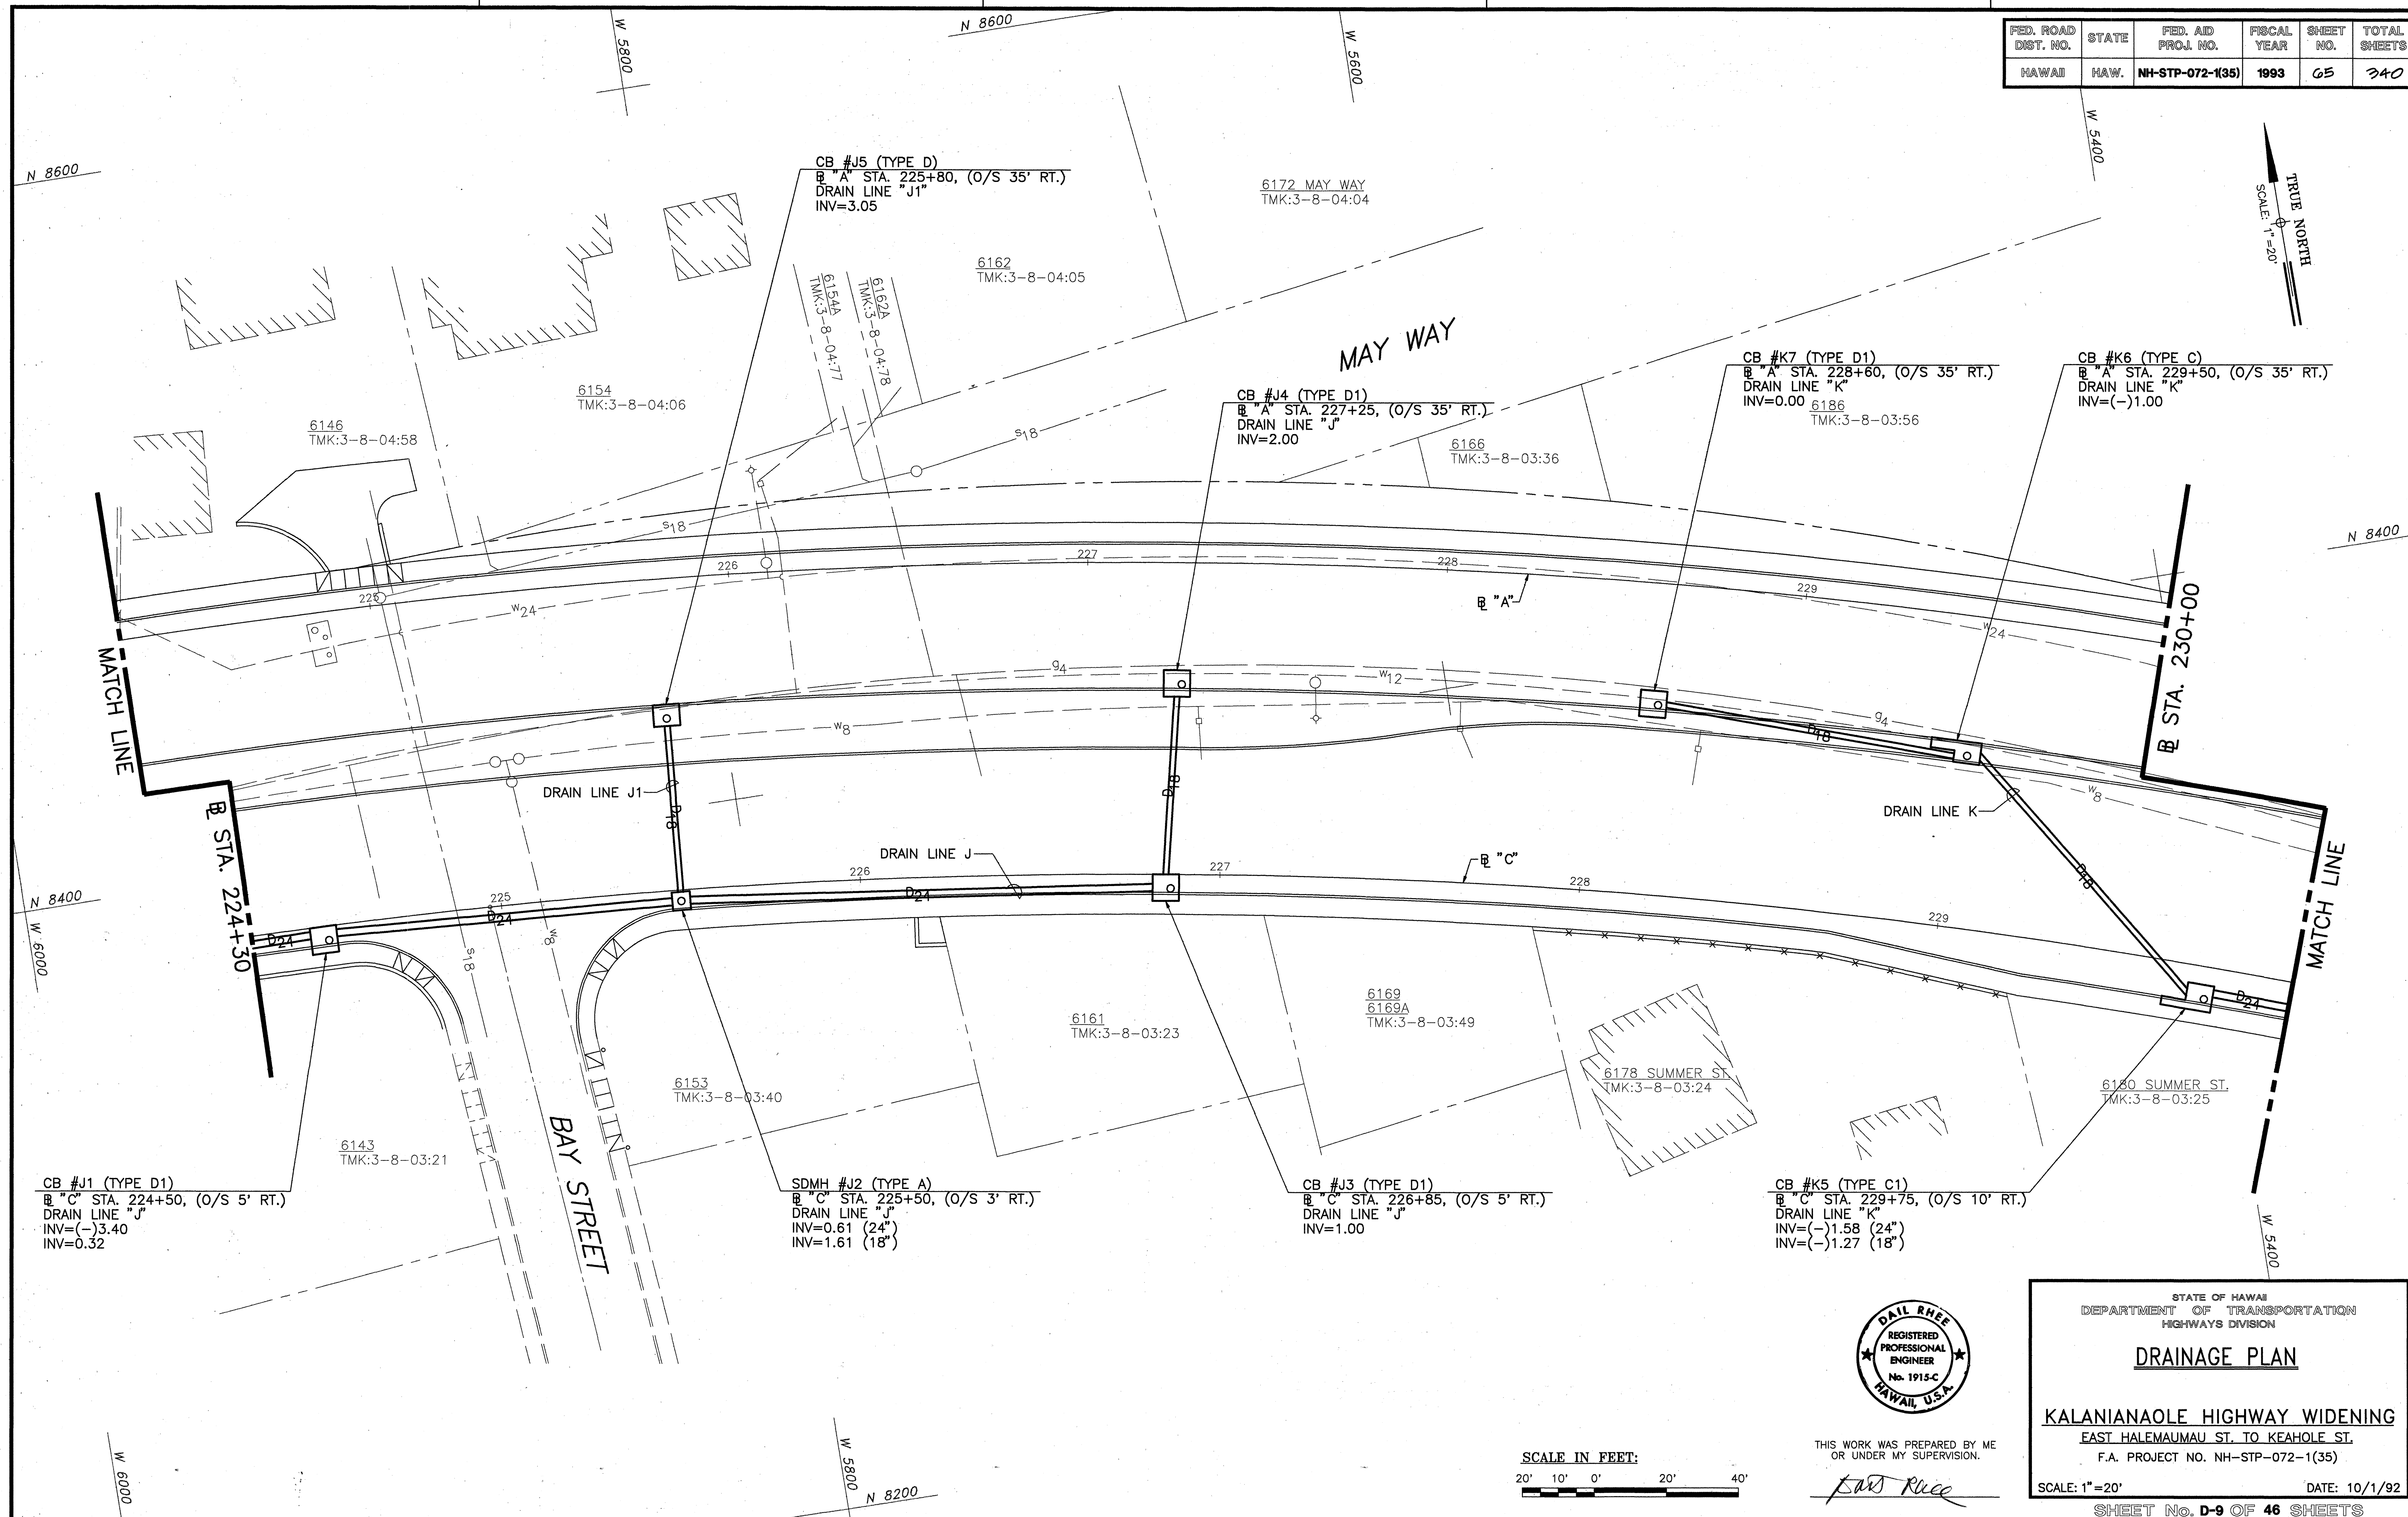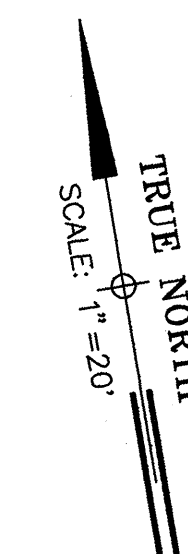


ORIGINAL PLAN	DATE
DRAWN BY	
DESIGNED BY	
NOTED BY	
CHECKED BY	
QUANTITIES BY	
NO.	

FED. ROAD DIST. NO.	STATE	FED. AID PROJ. NO.	FISCAL YEAR	SHEET NO.	TOTAL SHEETS
HAWAII	HAW.	NH-STP-072-1(35)	1993	66	340

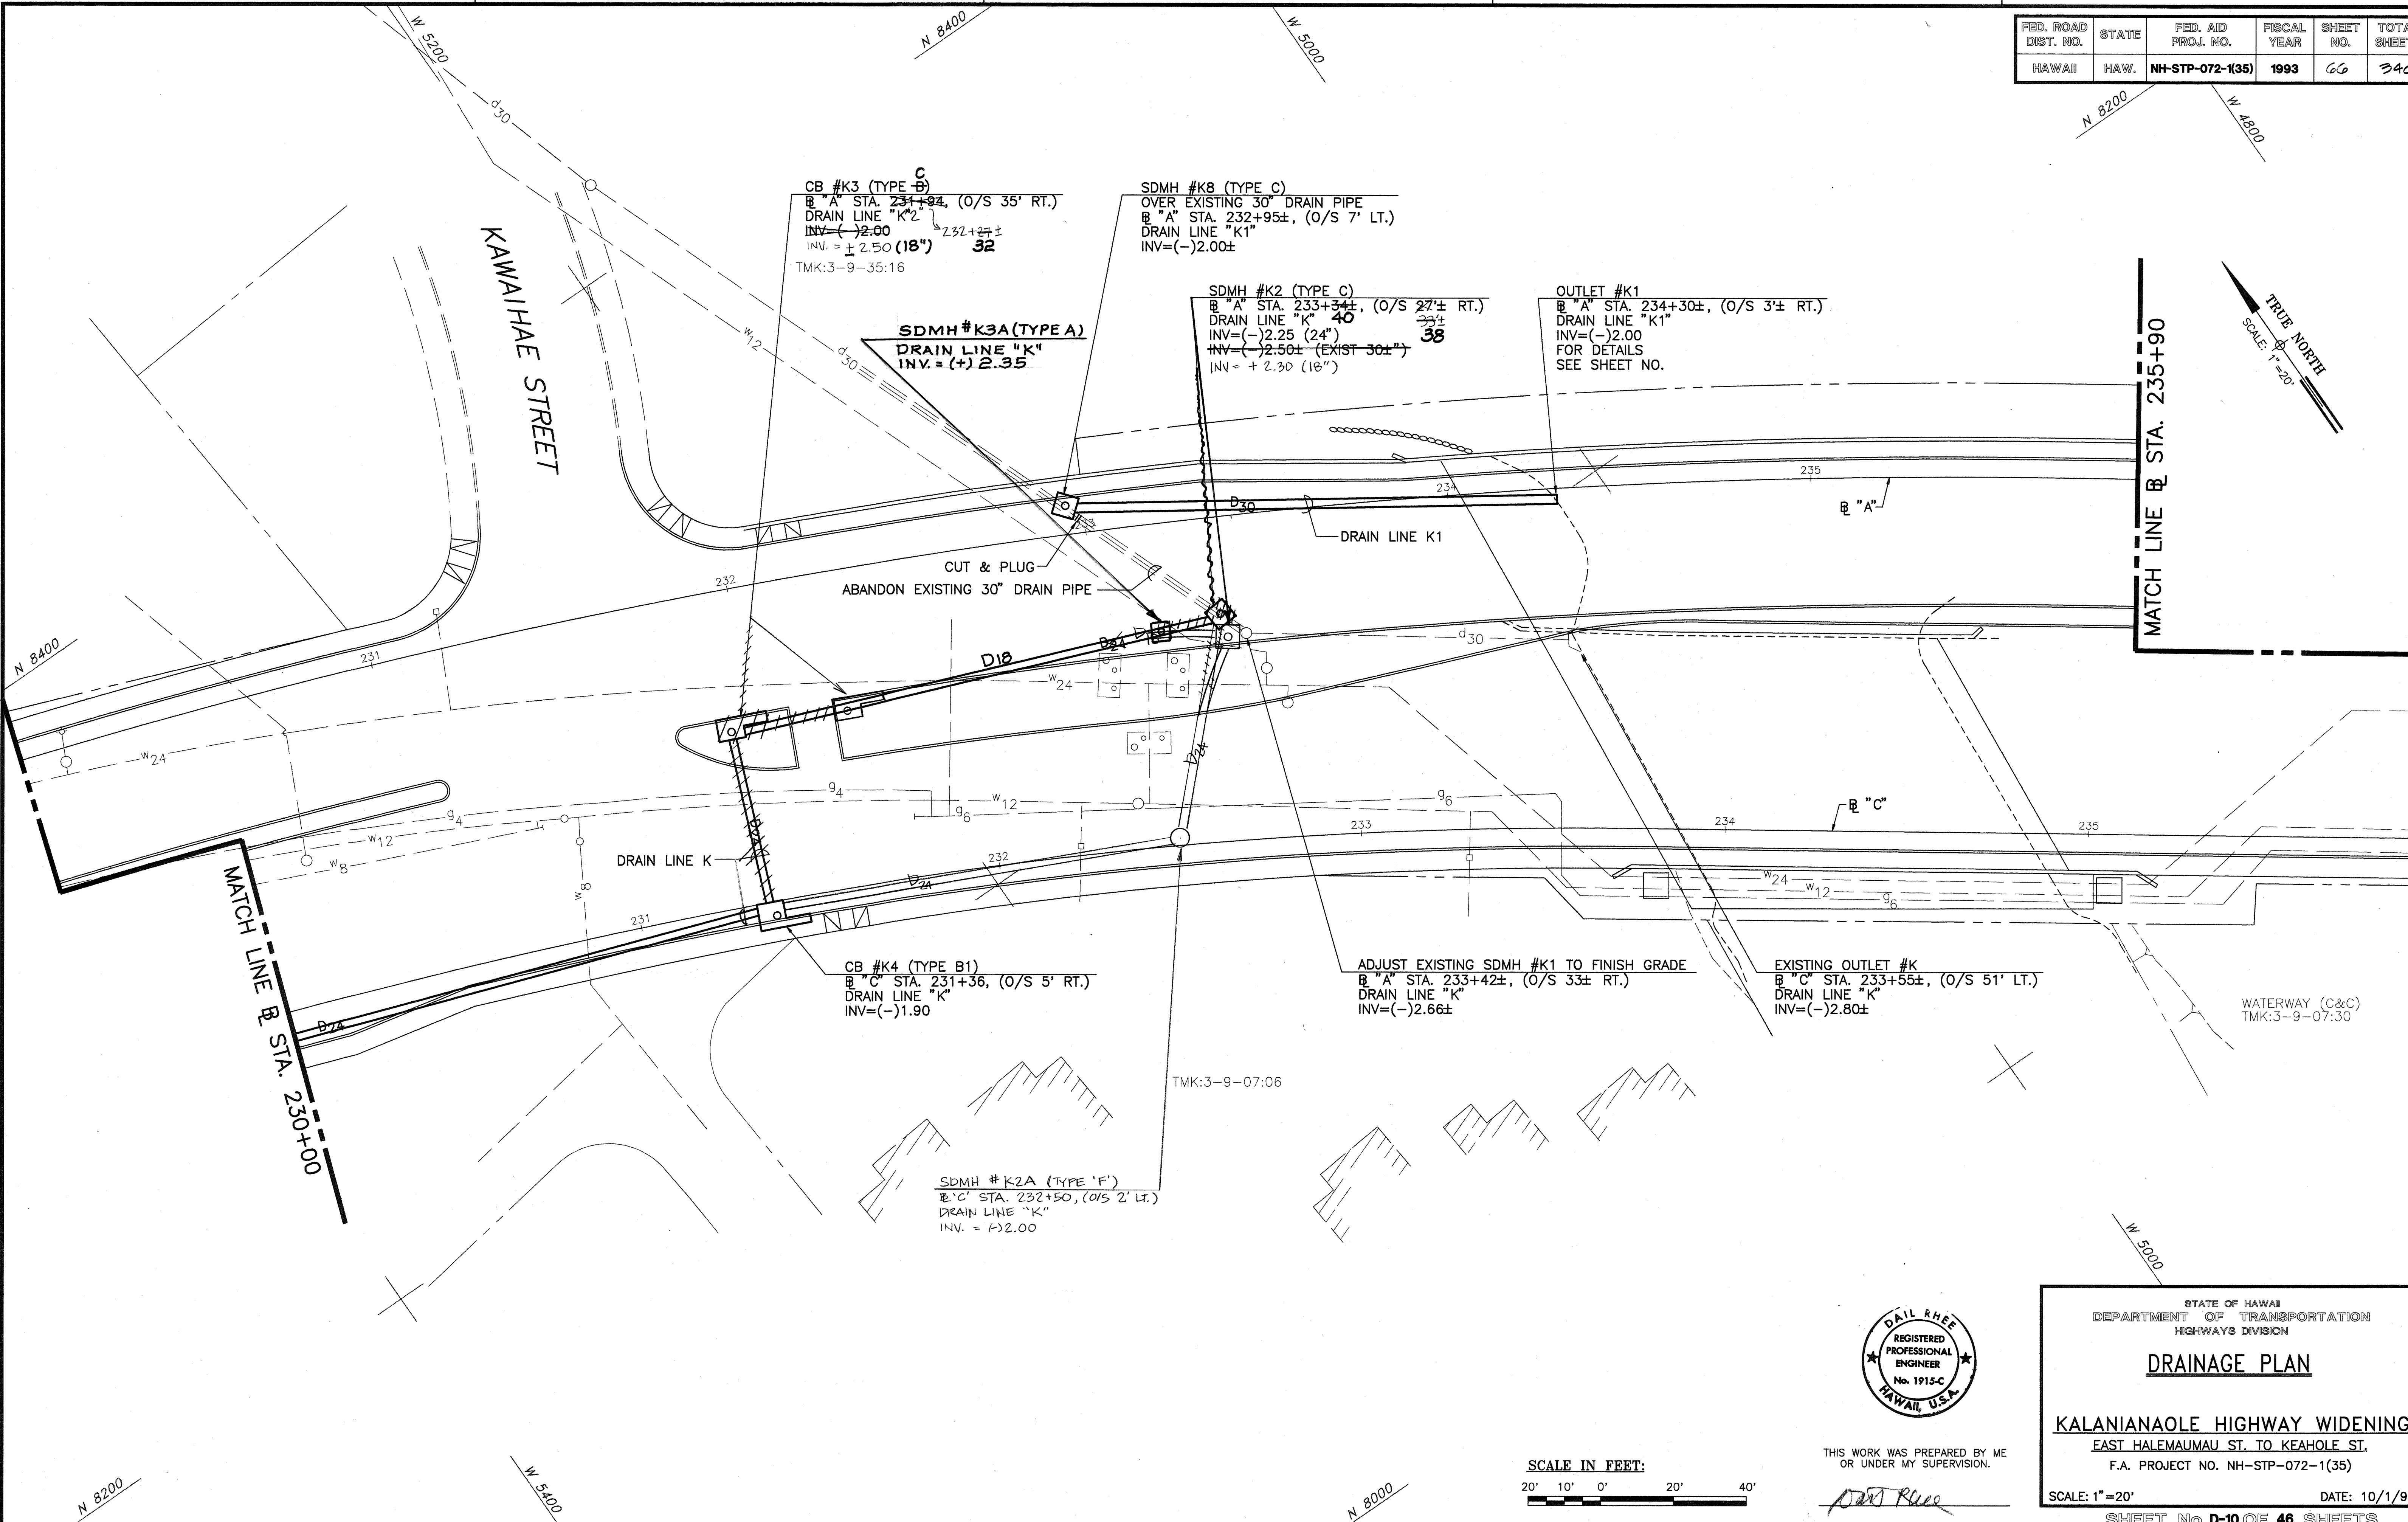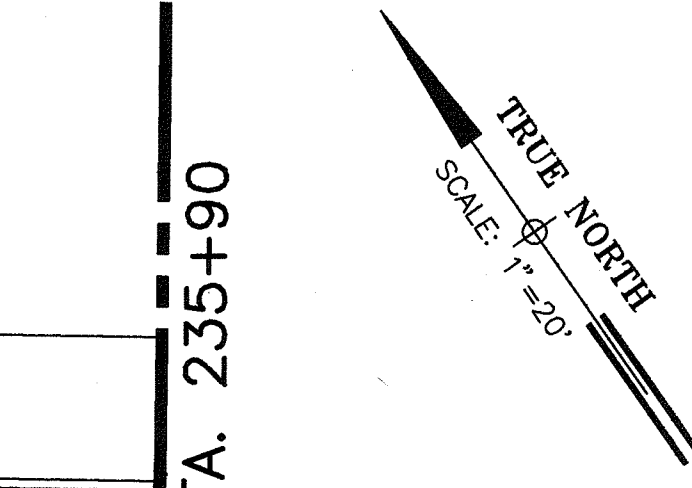


ORIGINAL PLAN	SURVEY PLOTTED BY	DATE
NO.	DRAWN BY	
	CHECKED BY	
	QUANTITIES BY	
	DESIGNED BY	

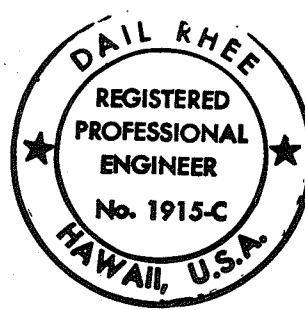

THIS WORK WAS PREPARED BY ME OR UNDER MY SUPERVISION.

DAI KHEE

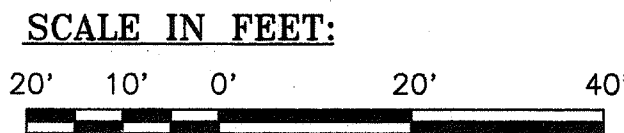


STATE OF HAWAII
DEPARTMENT OF TRANSPORTATION
HIGHWAYS DIVISION

DRAINAGE PLAN

KALANIANA'OLE HIGHWAY WIDENING
EAST HALEMAUMAU ST. TO KEAHOLE ST.
F.A. PROJECT NO. NH-STP-072-1(35)
SCALE: 1"=20' DATE: 10/1/92
SHEET No. D-10 OF 46 SHEETS

FED. ROAD DIST. NO.	STATE	FED. AID PROJ. NO.	FISCAL YEAR	SHEET NO.	TOTAL SHEETS
HAWAII	HAW.	NH-STP-072-1(35)	1993	67	340

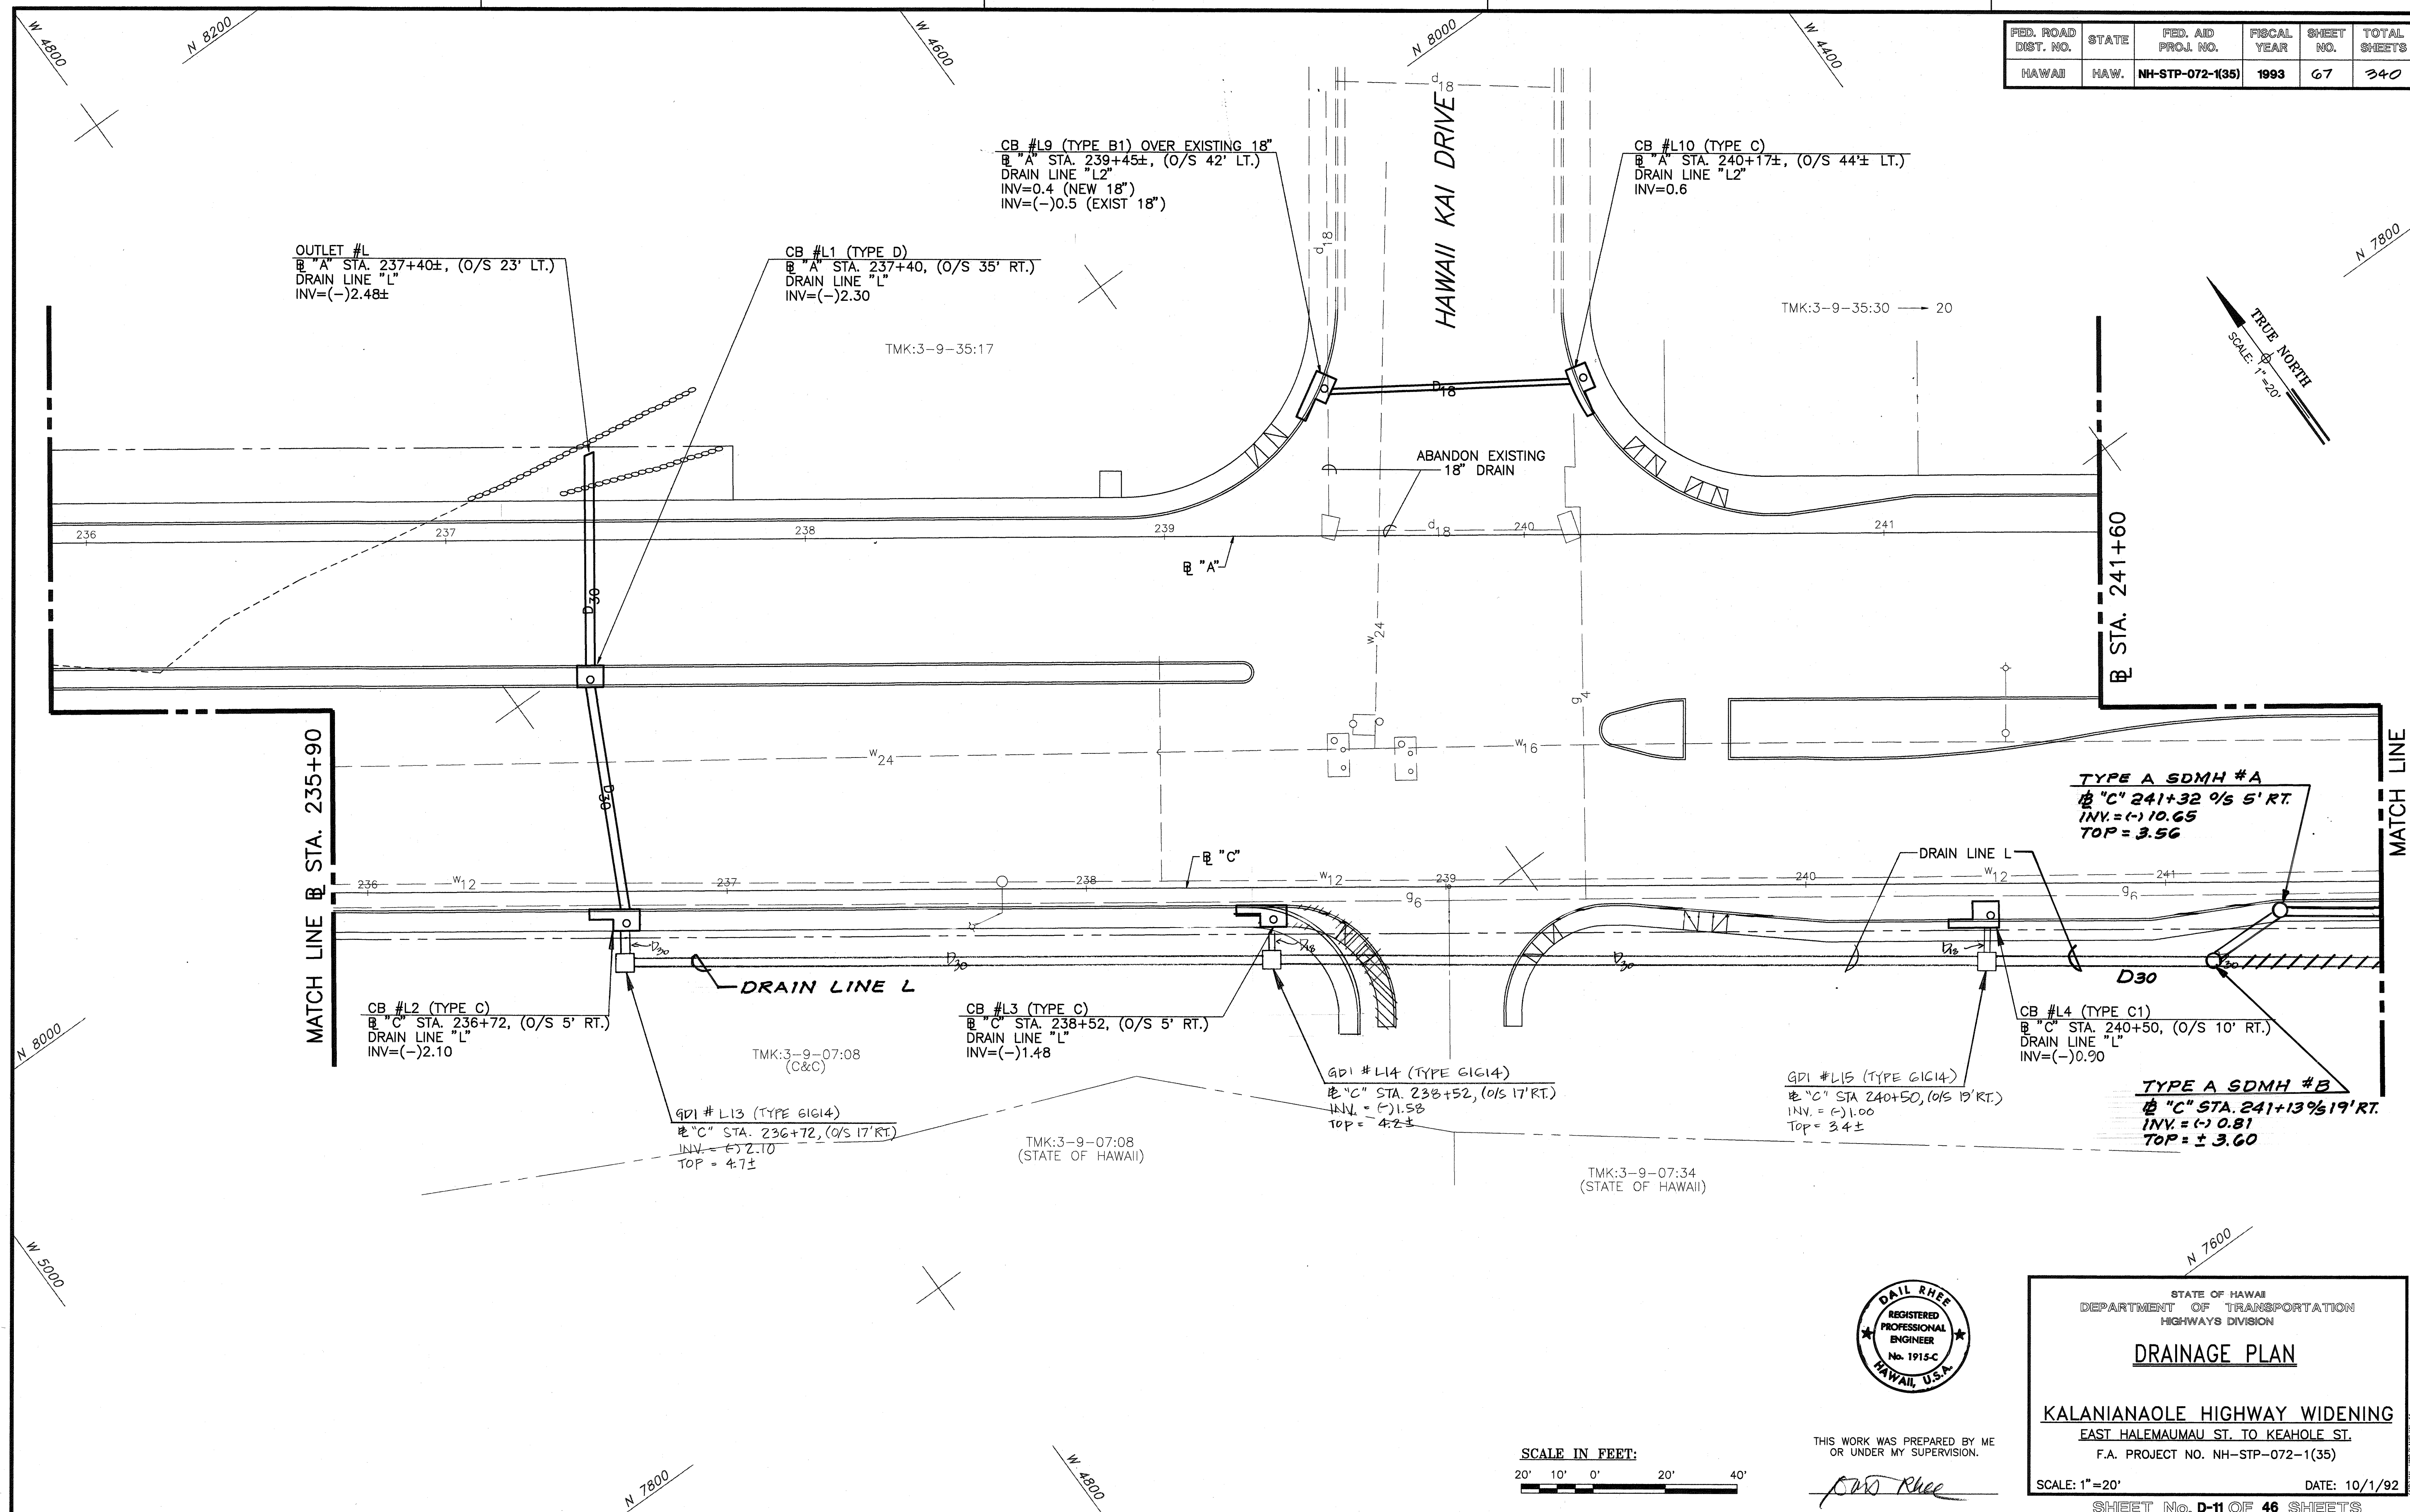

THIS WORK WAS PREPARED BY ME
OR UNDER MY SUPERVISION.

Paul Rhee

"AS-BUILT"

STATE OF HAWAII
DEPARTMENT OF TRANSPORTATION
HIGHWAYS DIVISION

DRAINAGE PLAN



KALANIWAOLE HIGHWAY WIDENING
EAST HALEMAUMAU ST. TO KEAHOE ST.
F.A. PROJECT NO. NH-STP-072-1(35)

SCALE: 1"=20' DATE: 10/1/92


SHEET No. **D-11** OF 46 SHEETS

67

FED. ROAD DIST. NO.	STATE	FED. AID PROJ. NO.	FISCAL YEAR	SHEET NO.	TOTAL SHEETS
HAWAII	HAW.	NH-STP-072-1(35)	1993	68	340

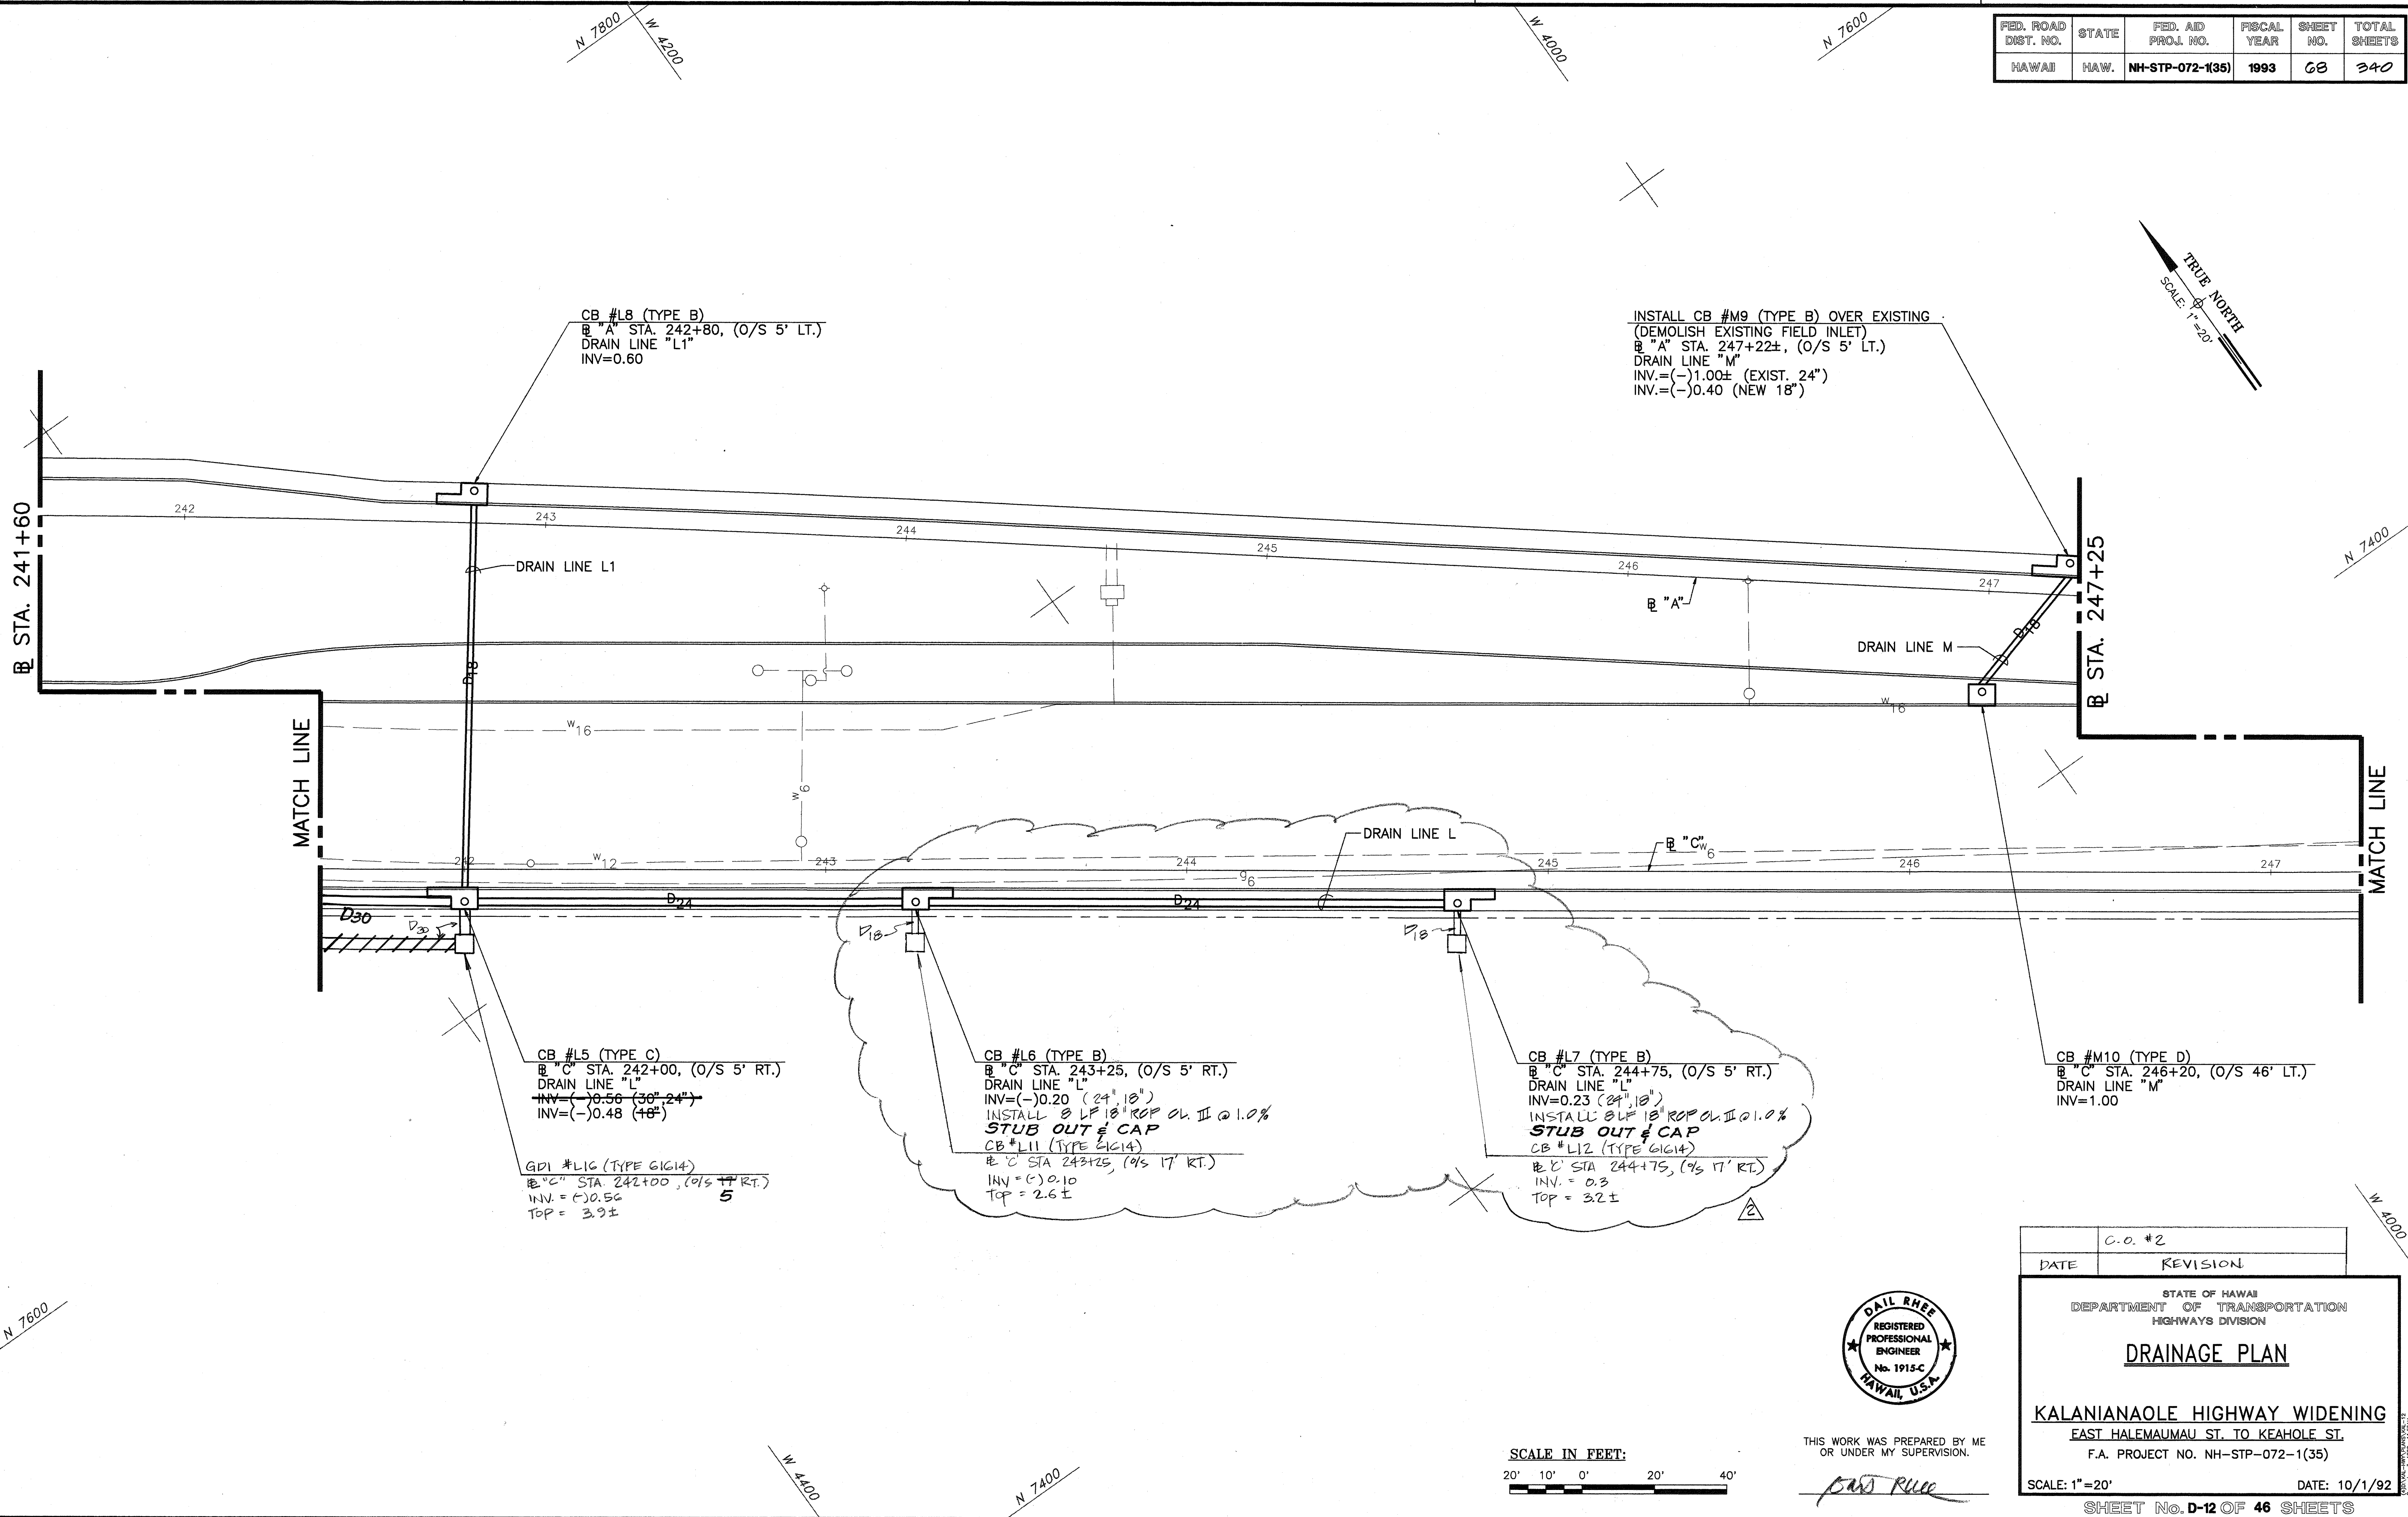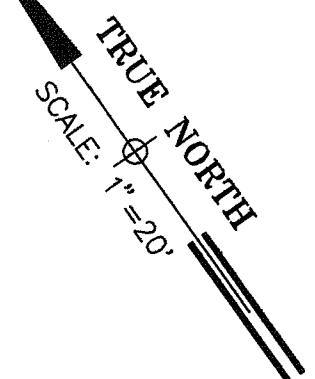

ORIGINAL PLAN	SURVEY PLOTTED BY	DATE
NOTE BOOK	DRAWN BY	
	DESIGNED BY	
	QUANTITIES BY	
	CHECKED BY	
	No.	

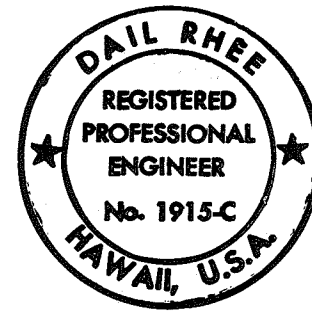

THIS WORK WAS PREPARED BY ME
OR UNDER MY SUPERVISION.



DAIL RHEE

DATE	C.O. #2
REVISION	
STATE OF HAWAII DEPARTMENT OF TRANSPORTATION HIGHWAYS DIVISION	
DRAINAGE PLAN	
KALANIANA'OLE HIGHWAY WIDENING EAST HALEMAUMAU ST. TO KEAHOE ST. F.A. PROJECT NO. NH-STP-072-1(35)	
SCALE: 1"=20'	DATE: 10/1/92
SHEET No. D-12 OF 46 SHEETS	

"AS-BUILT"

C.O. 68

FED. ROAD DIST. NO.	STATE	FED. AID PROJ. NO.	FISCAL YEAR	SHEET NO.	TOTAL SHEETS
HAWAII	HAW.	NH-STP-072-1(35)	1993	69	340

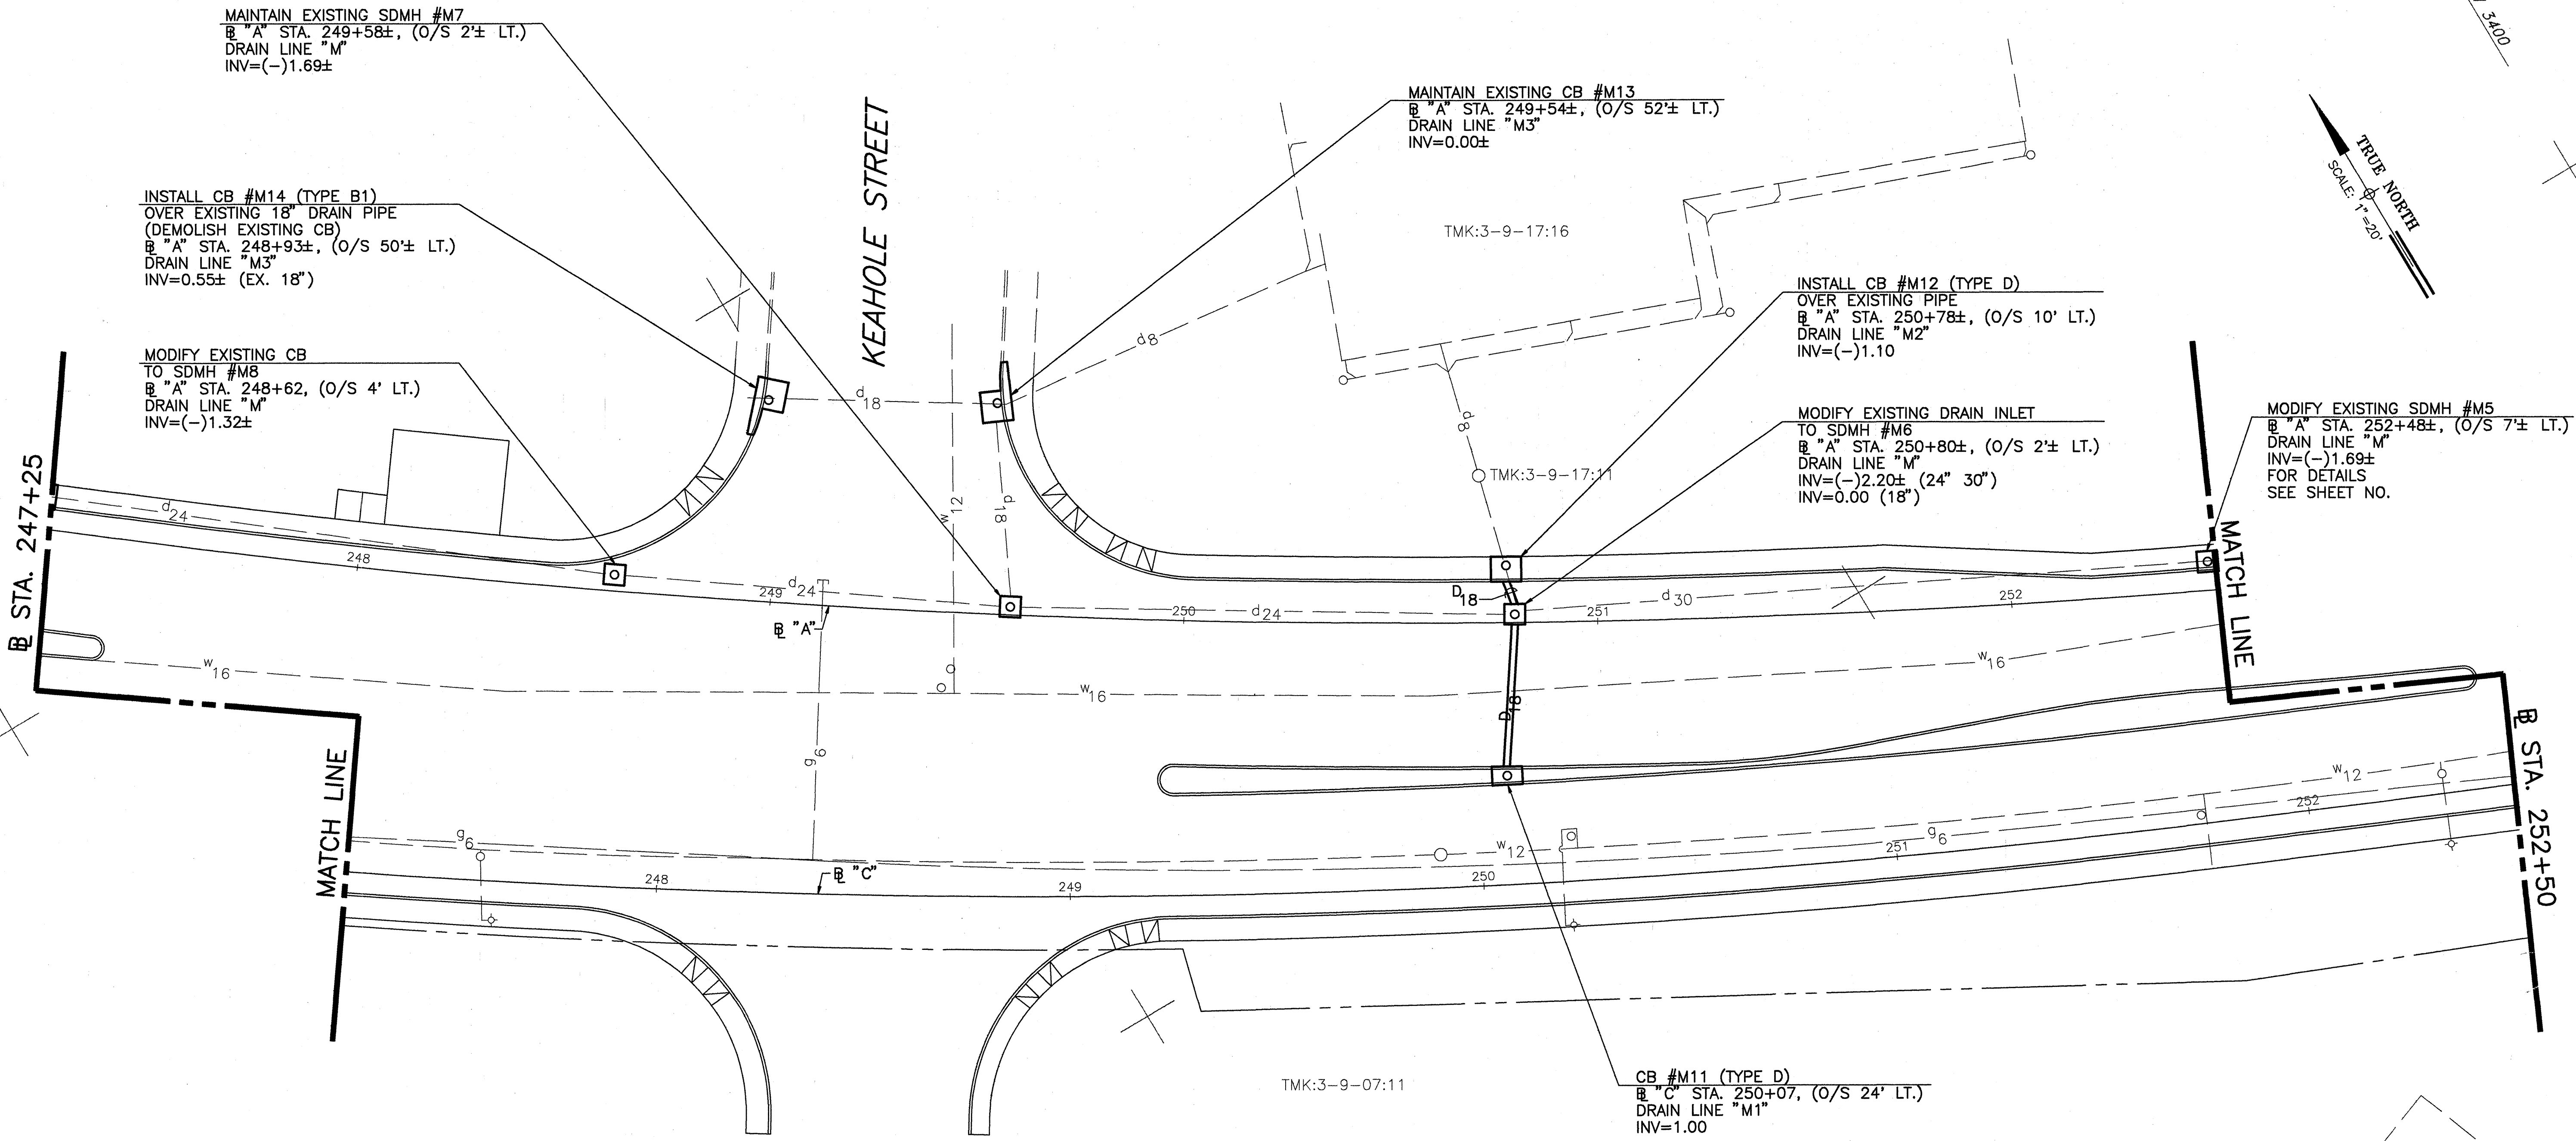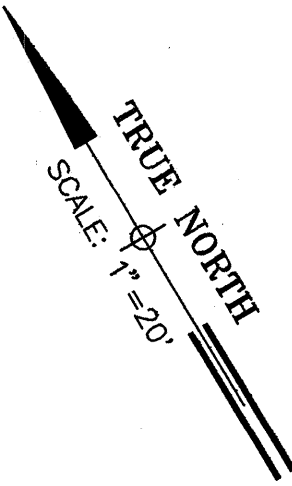


ORIGINAL PLAN	SURVEY PLOTTED BY	DATE
DESIGNED BY	____	____
NOTED BY	____	____
CHECKED BY	____	____
NO.	____	____



THIS WORK WAS PREPARED BY ME OR UNDER MY SUPERVISION.


Dail Rhee

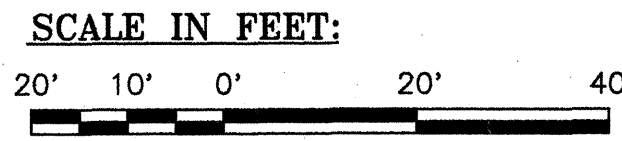

STATE OF HAWAII
 DEPARTMENT OF TRANSPORTATION
 HIGHWAYS DIVISION
DRAINAGE PLAN
 KALANIANA'OLE HIGHWAY WIDENING
 EAST HALEMAUMAU ST. TO KEAHOLE ST.
 F.A. PROJECT NO. NH-STP-072-1(35)
 SCALE: 1"=20' DATE: 10/1/92
 SHEET No. D-13 OF 46 SHEETS

TRUE NORTH

SCALE: 1"=20'

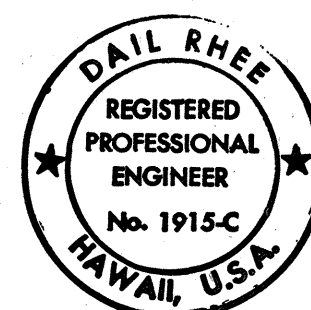

Baris Ruler

70

