

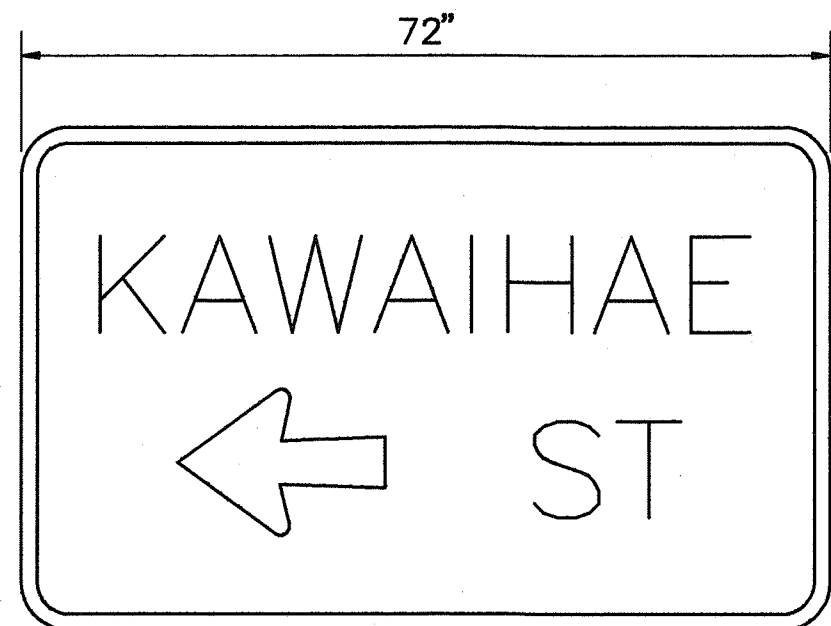
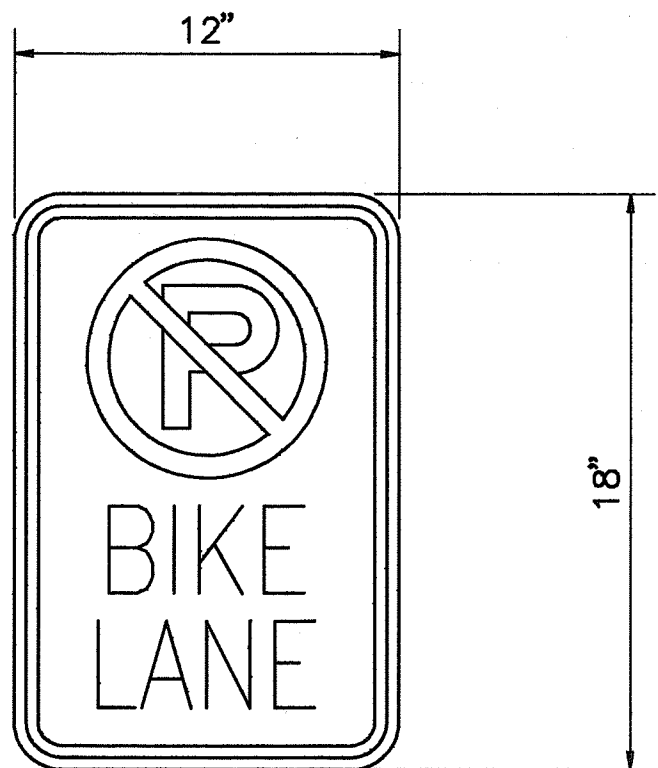
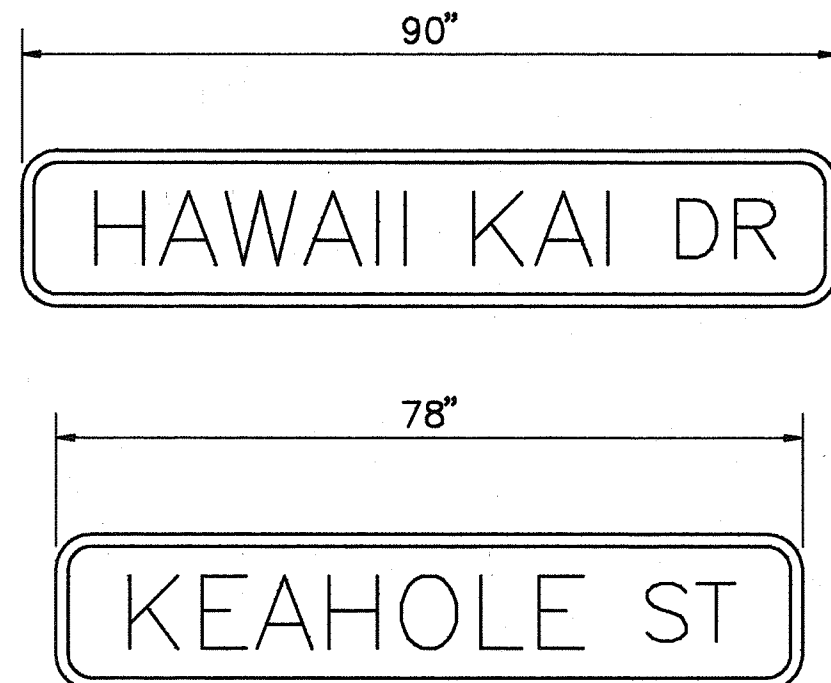
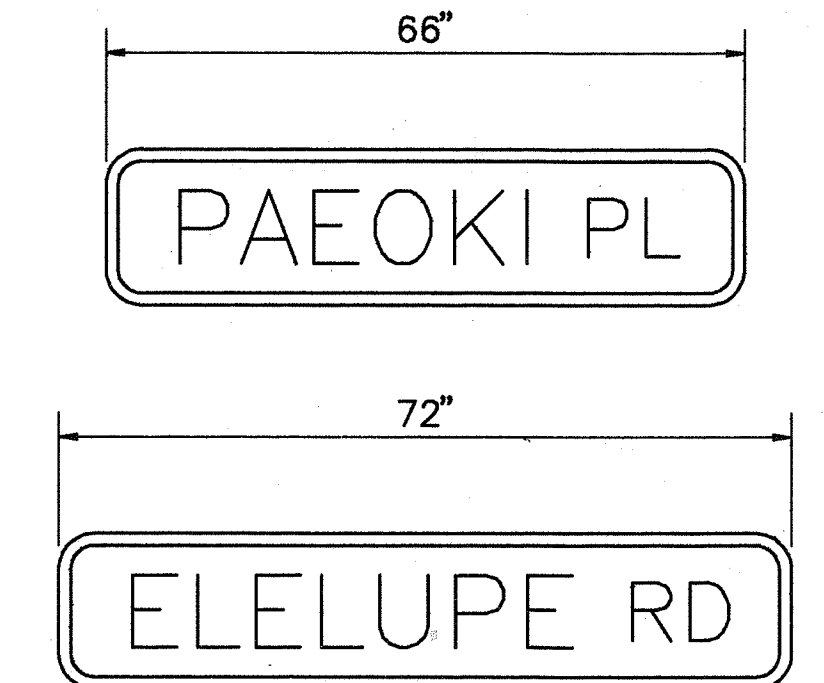
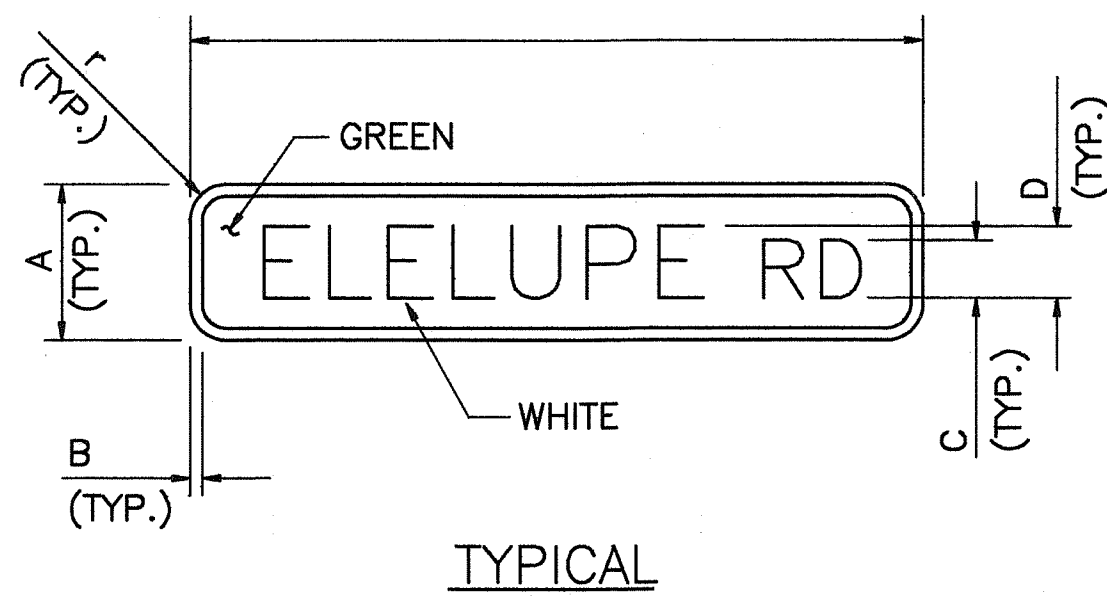
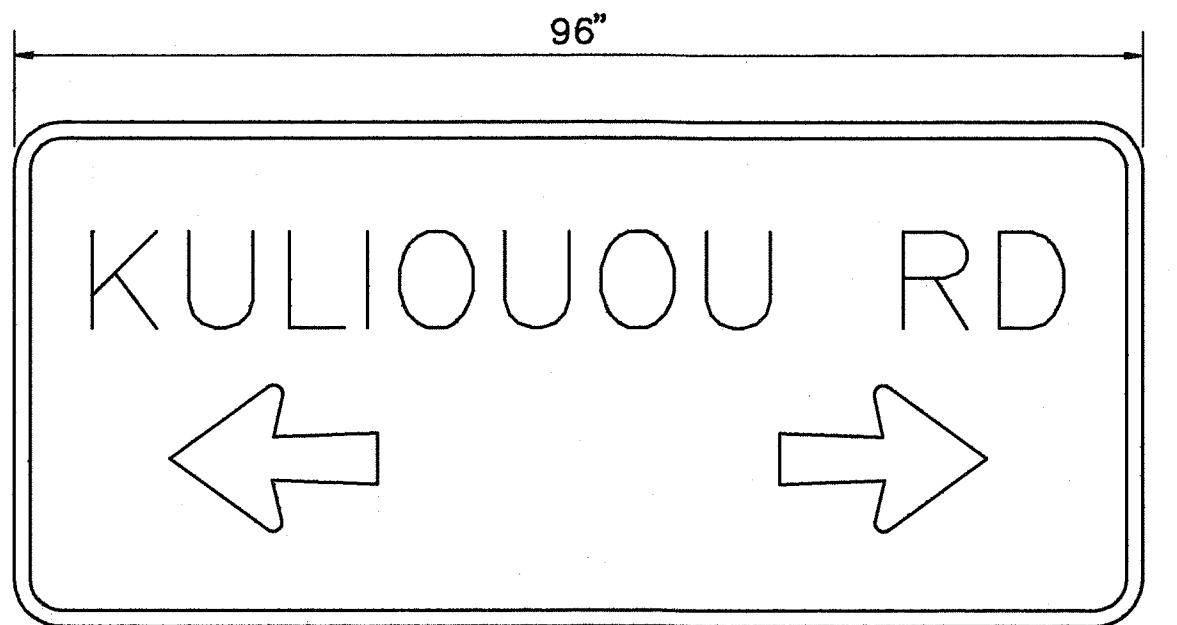
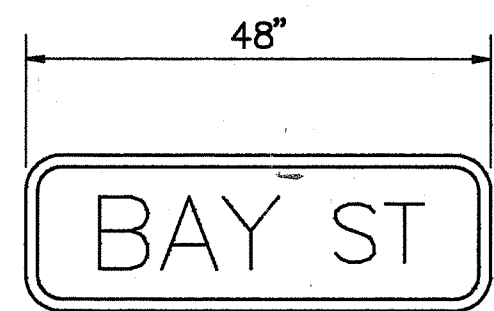
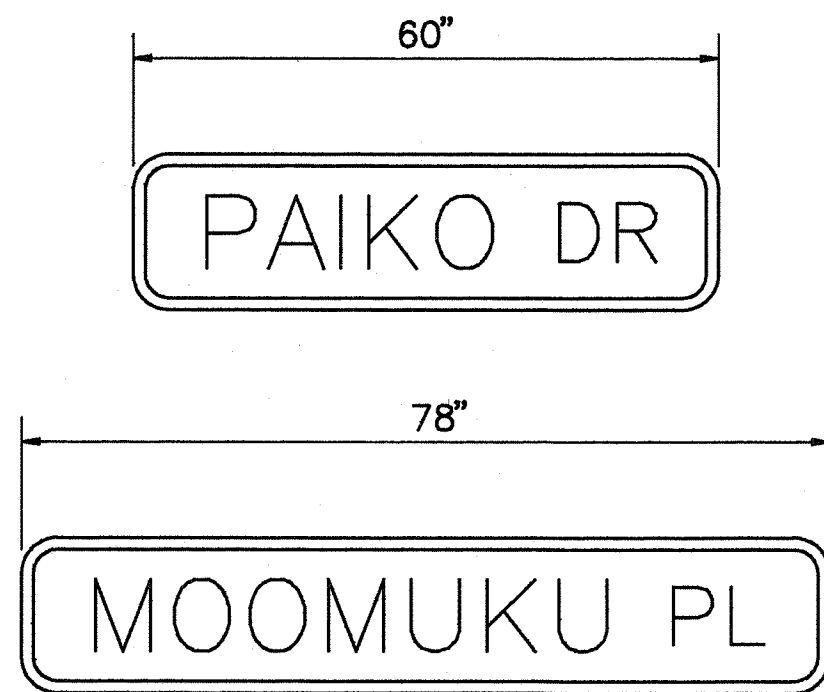
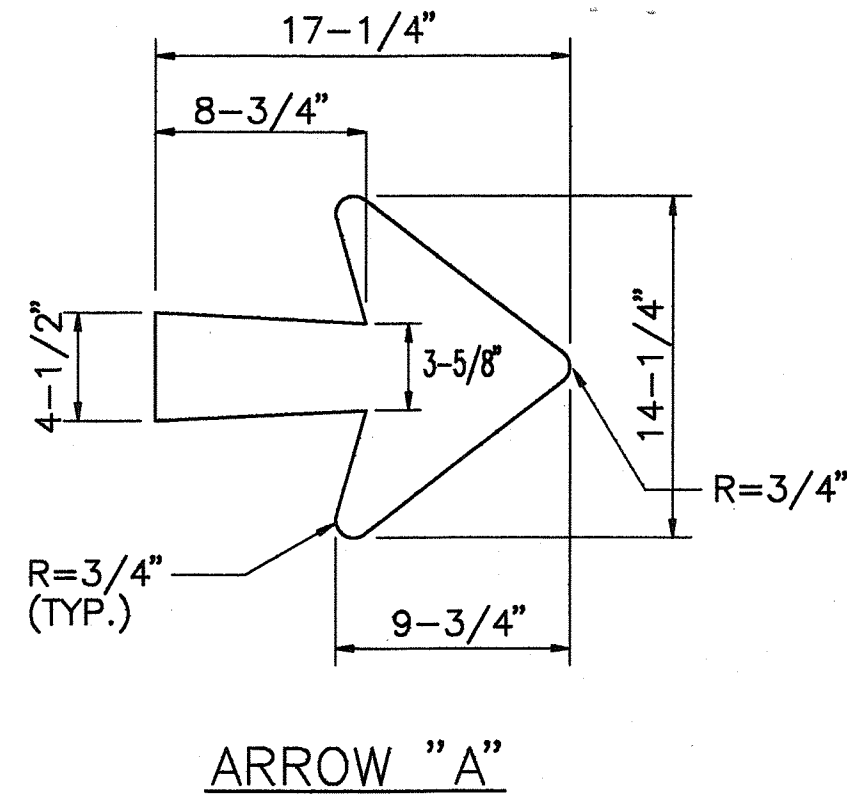
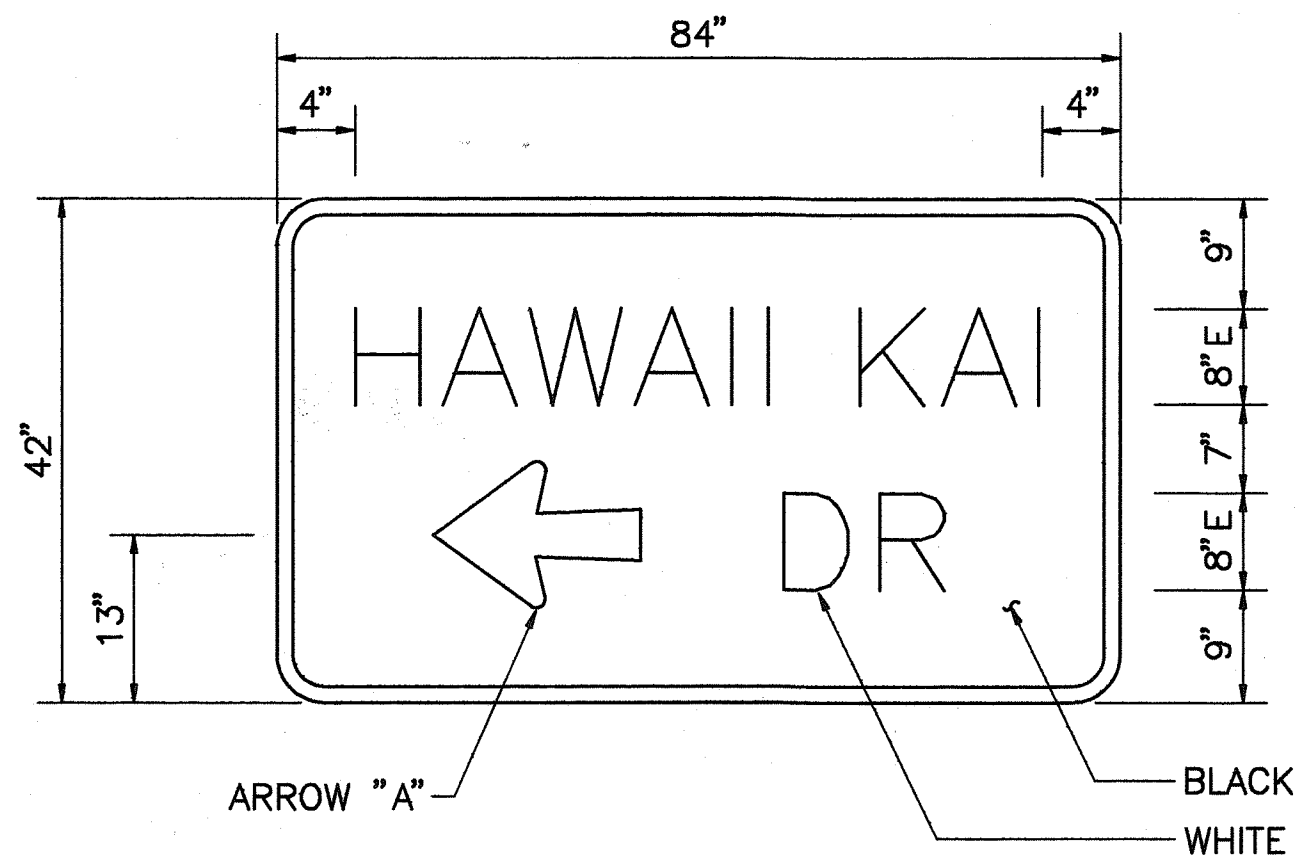
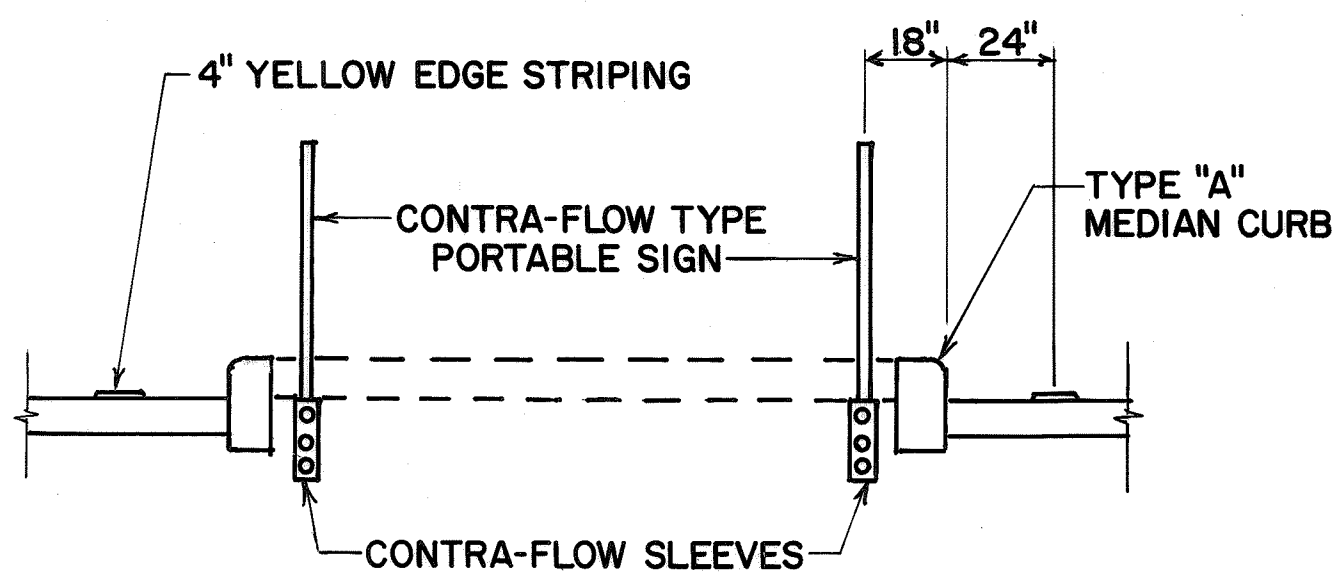
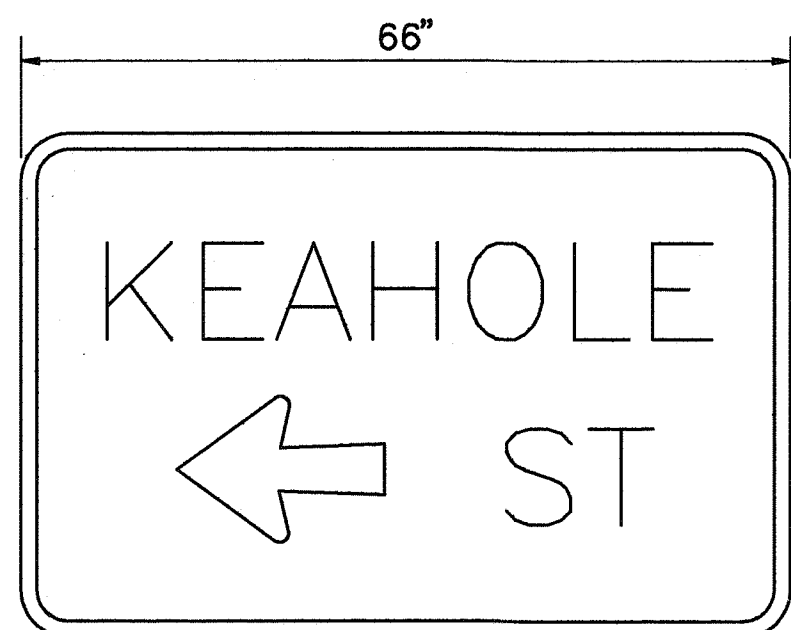
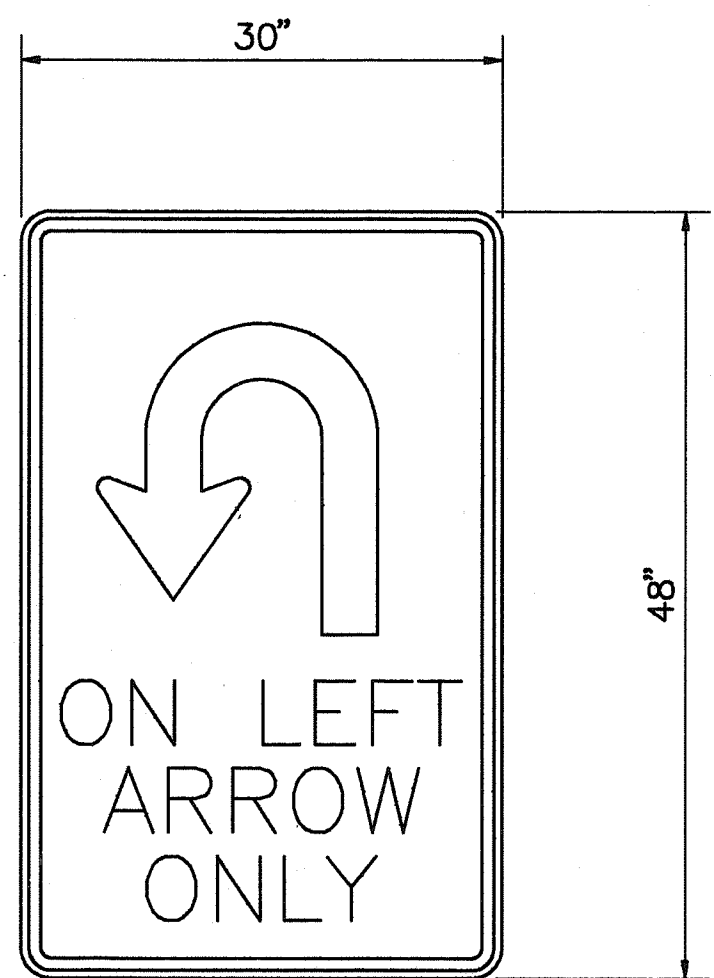


FED. ROAD DIST. NO.	STATE	FED. AID PROJ. NO.	FISCAL YEAR	SHEET NO.	TOTAL SHEETS
HAWAII	HAW.	NH-STP-072-1(35)	1993	105	340

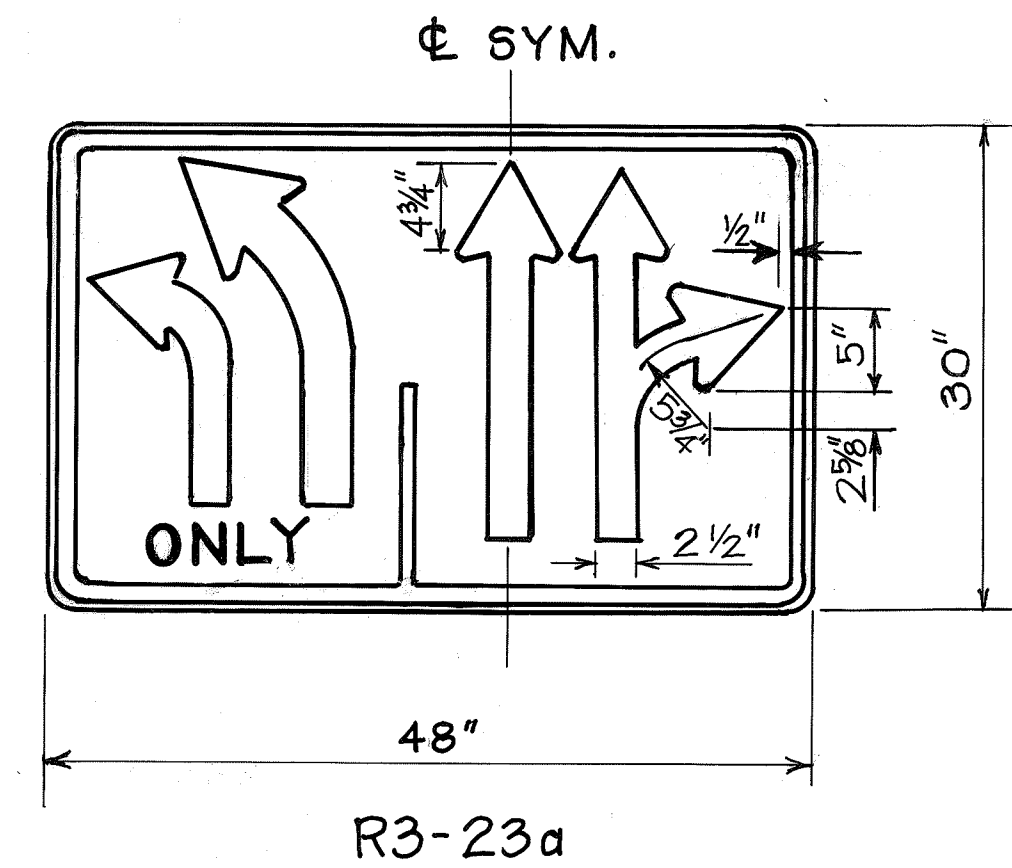

	DIMENSIONS (INCHES)				
SIGN	A	B	C	D	r
STD	16	1/4	6D	8D	3

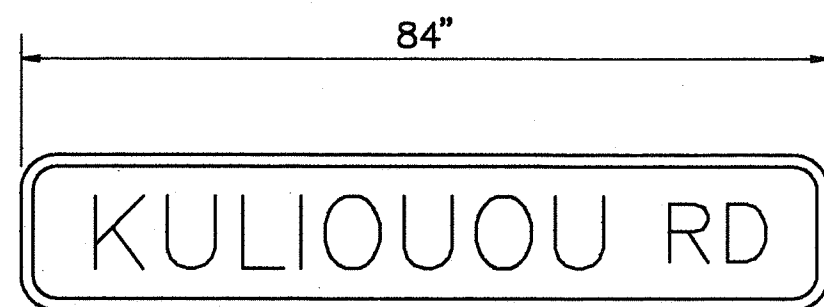





STREET NAME SIGNS ON MAST ARM

FOR SIGN SUPPORT DETAIL, SEE STANDARD PLANS TE-20 & TE-25. THE MINIMUM NUMBER OF SUPPORTS SHALL BE 3.
FOR ALTERNATE SIGN POST INSTALLATION, SEE PLAN SHEET NO. 184. REQUIRED WHERE THERE ARE TOO MANY UNDERGROUND UTILITIES AND RELOCATION OF THE SIGN LOCATION IS NOT POSSIBLE.

R3-23a

R17-1a

D1-2 SIGNS

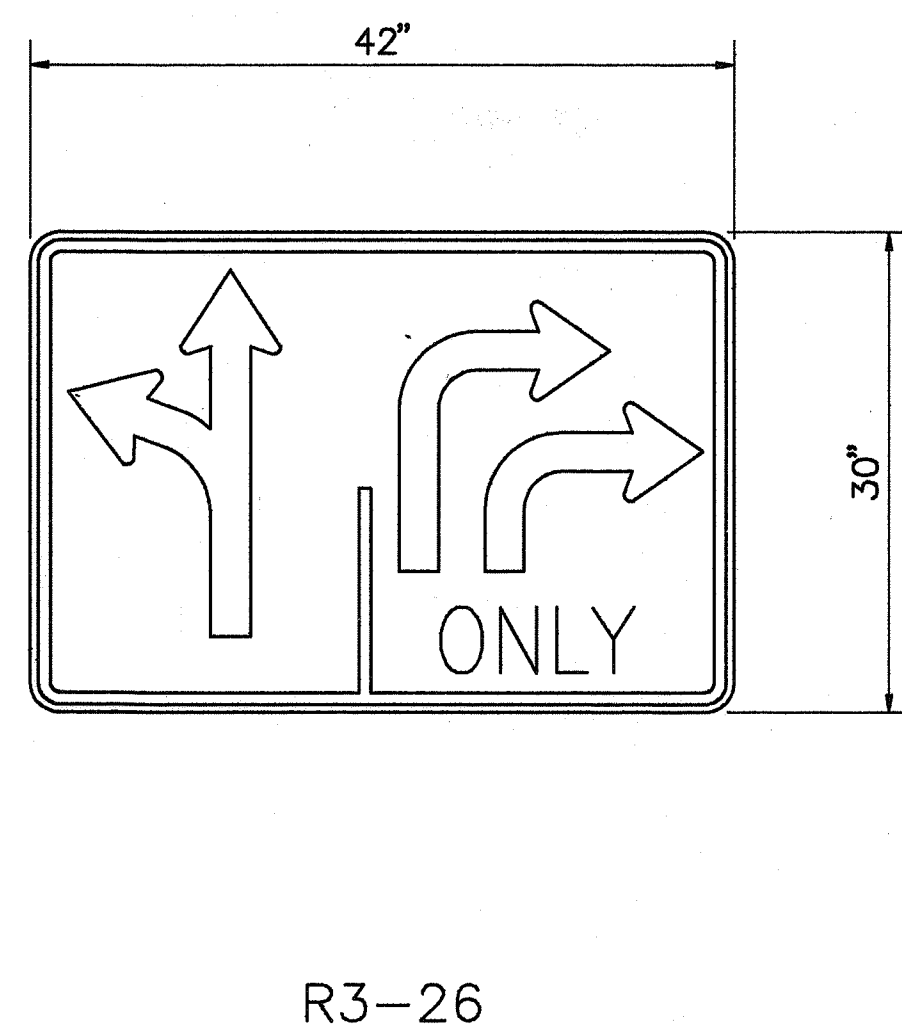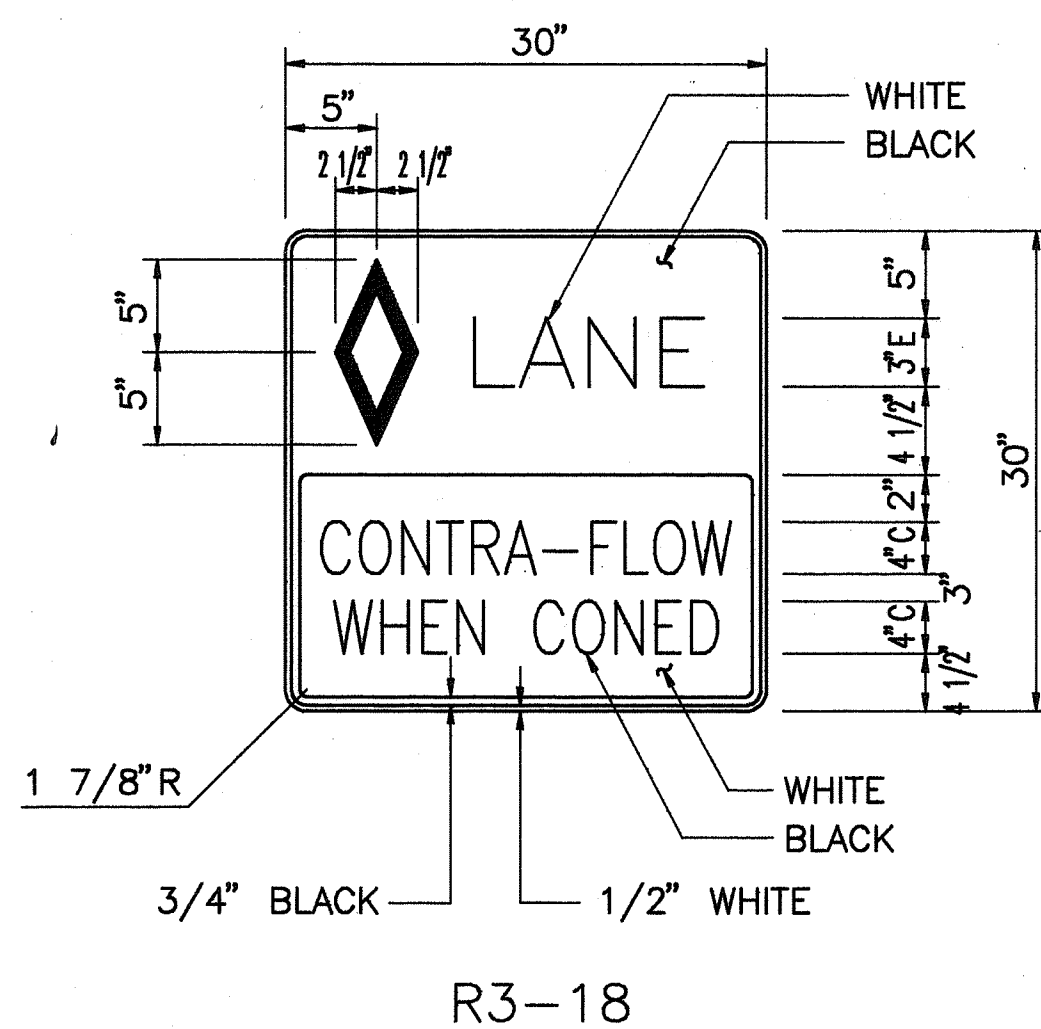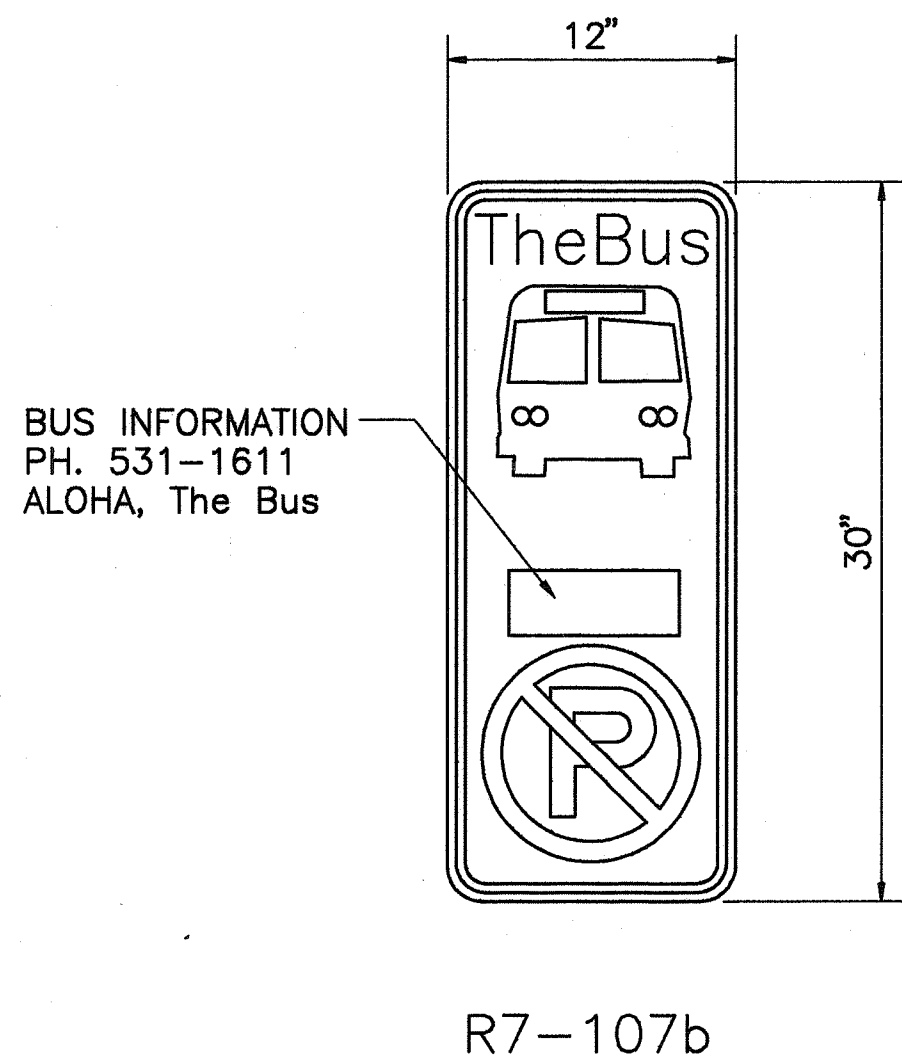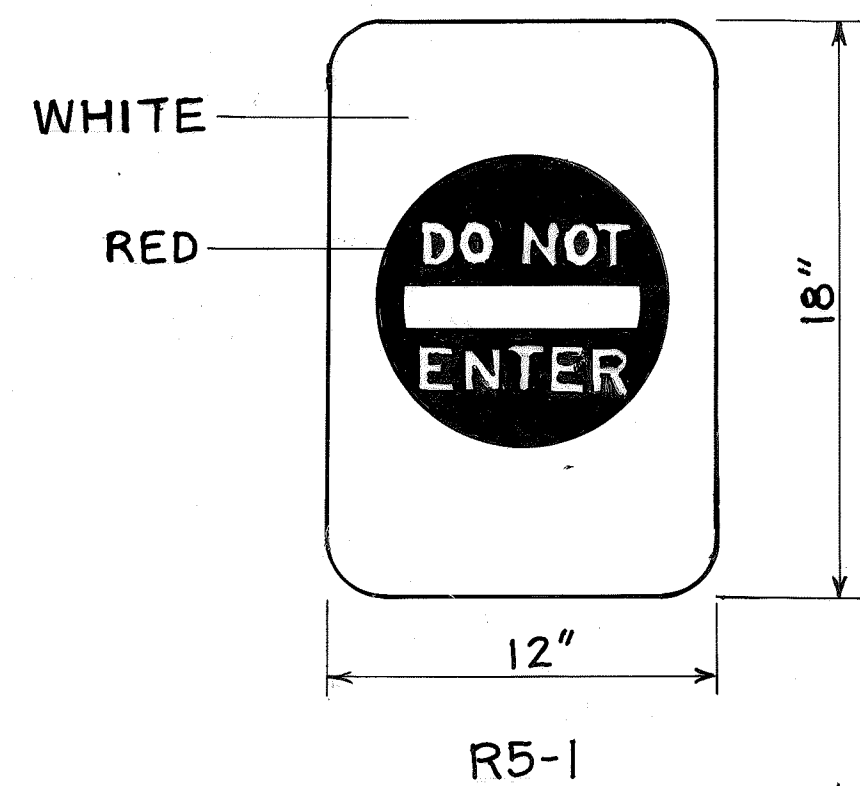

THIS WORK WAS PREPARED BY ME OR UNDER MY SUPERVISION.

STATE OF HAWAII
DEPARTMENT OF TRANSPORTATION
HIGHWAYS DIVISION

SIGN DETAILS

KALANIANA'OLE HIGHWAY WIDENING
EAST HALEMAUMAU ST. TO KEAHOLE ST.
F.A. PROJECT NO. NH-STP-072-1(35)
SCALE: NONE DATE: 10/1/92
SHEET No. G-3 OF 23 SHEETS

"AS-BUILT"