
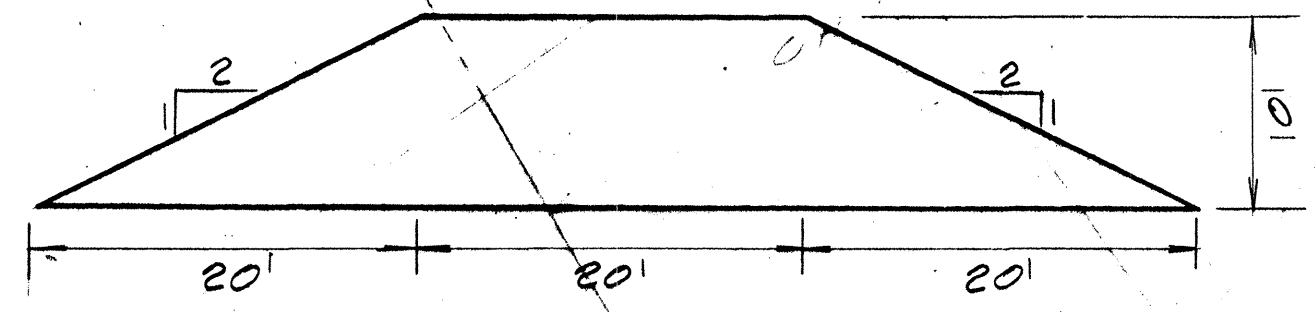


FED. ROAD DIST. NO.	STATE	FED. AID PROJ. NO.	FISCAL YEAR	SHEET NO.	TOTAL SHEETS
HAWAII	HAW.	NH-STP-072-1(35)	1993	20	340


NOTES:

- APPROX. 2000 C.Y. OF AGGREGATE SUBBASE FOR ROADWAY TO BE STOCKPILED.
- STOCKPILE TO BE LEFT IN PLACE AT LEAST 12 MONTHS
- STOCKPILE ELEVATION SHOULD BE SURVEYED ONCE A MONTH & RECORDED USING MONITORING RODS WITHIN STOCKPILE

TRUE NORTH
SCALE 1"=20'

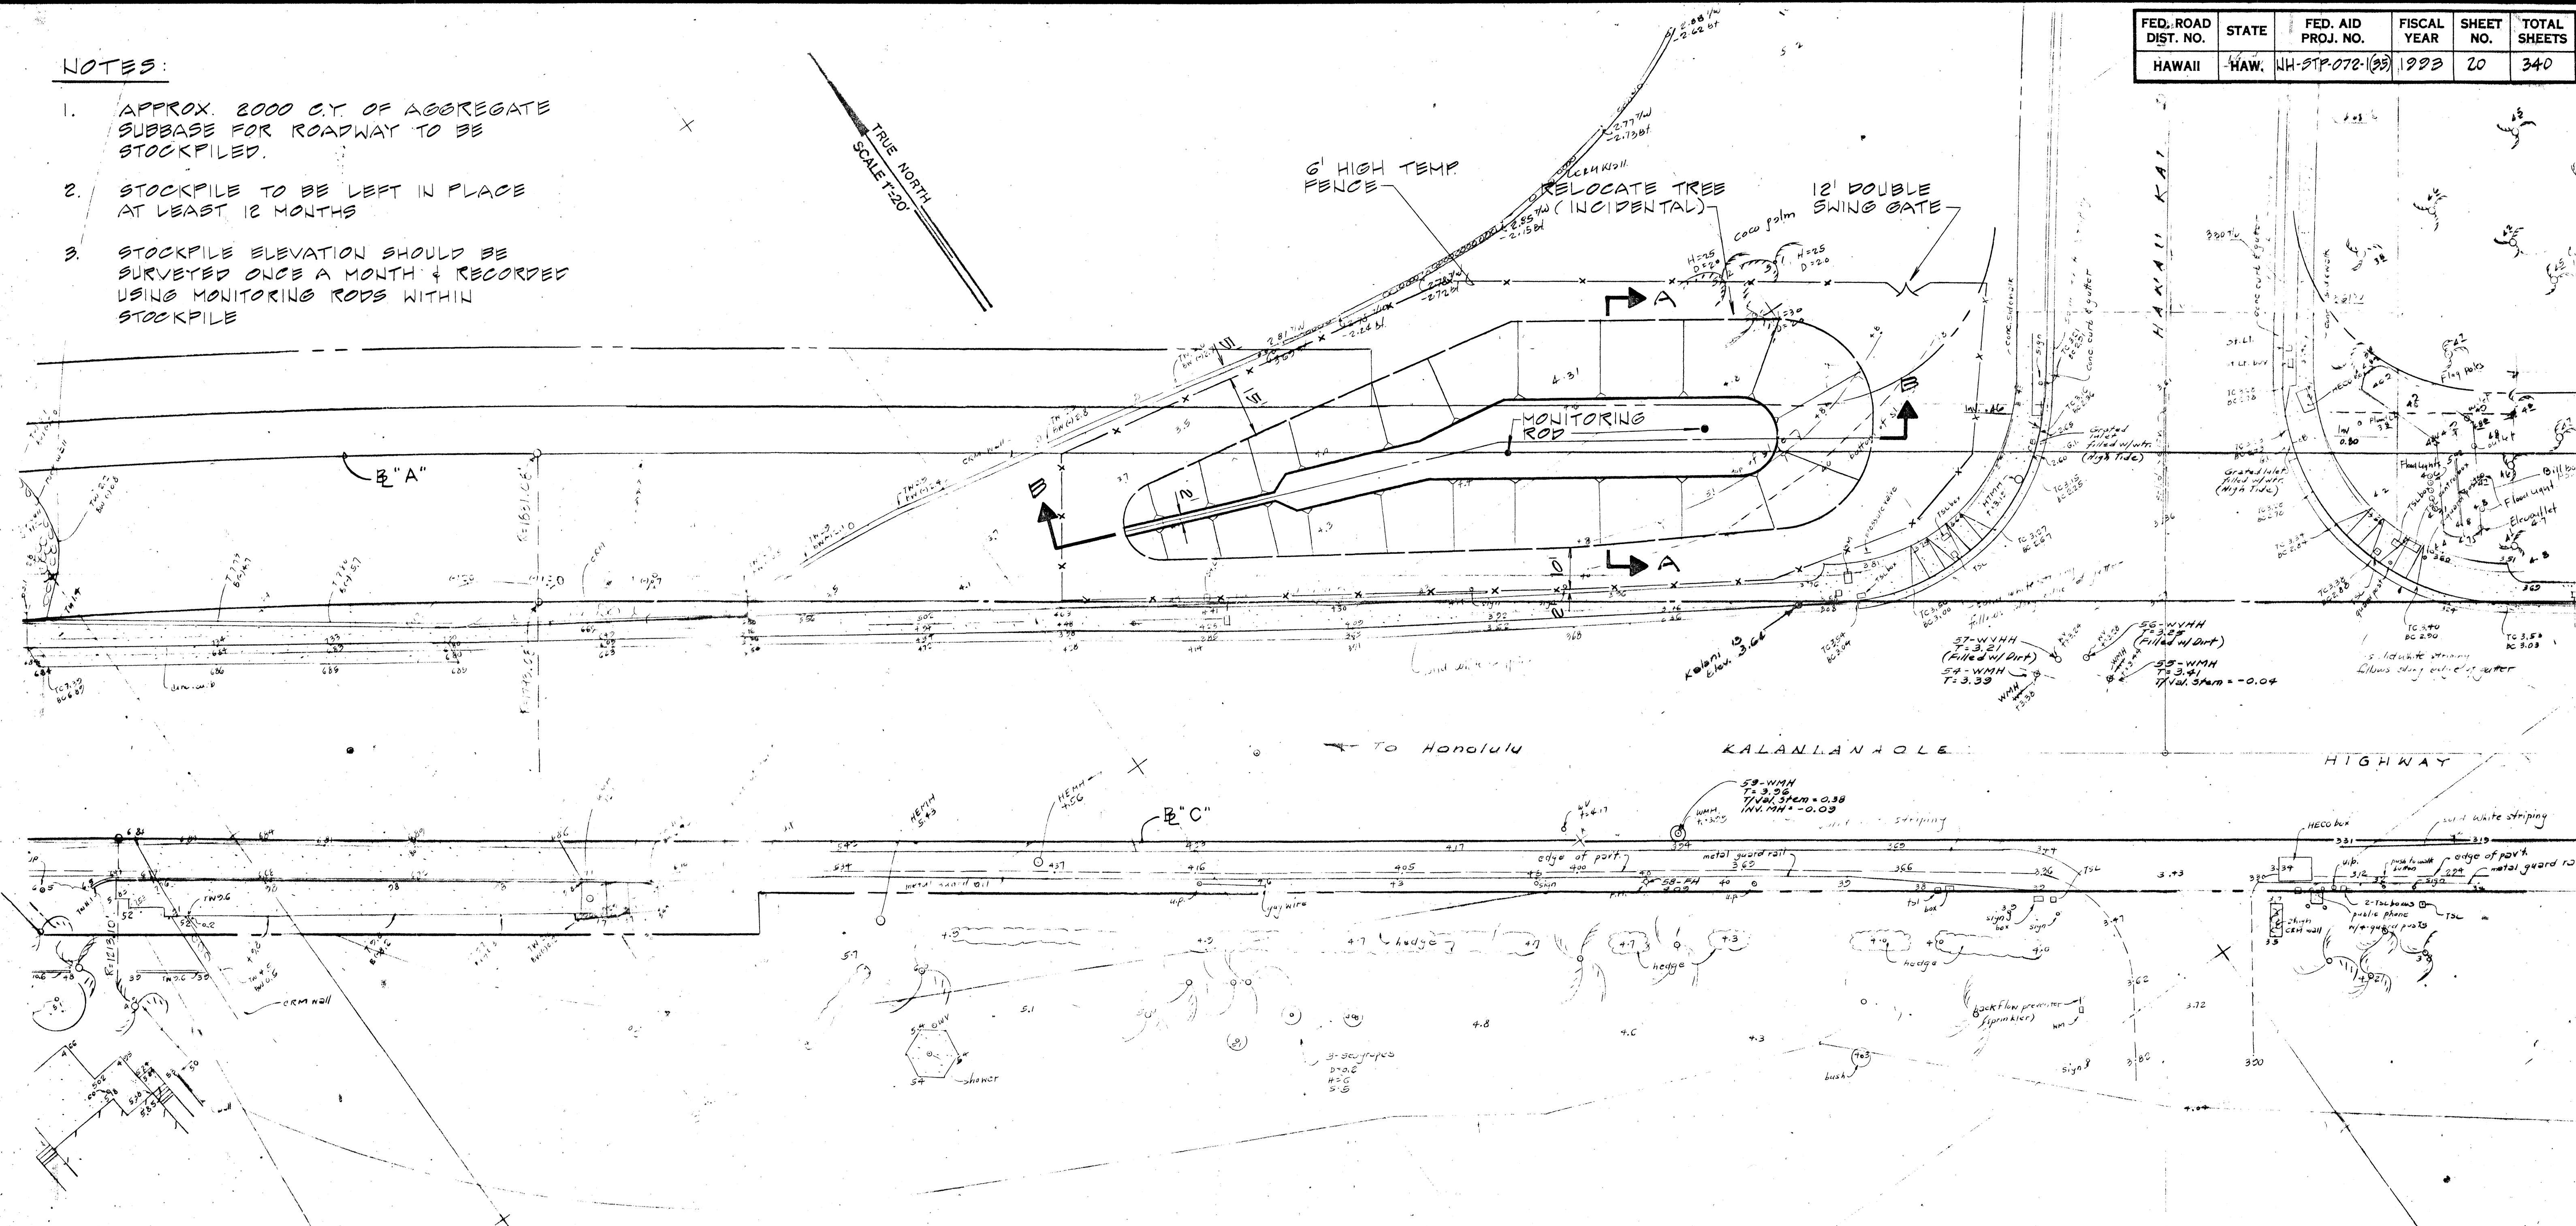

SECTION A-A
N.T.S.

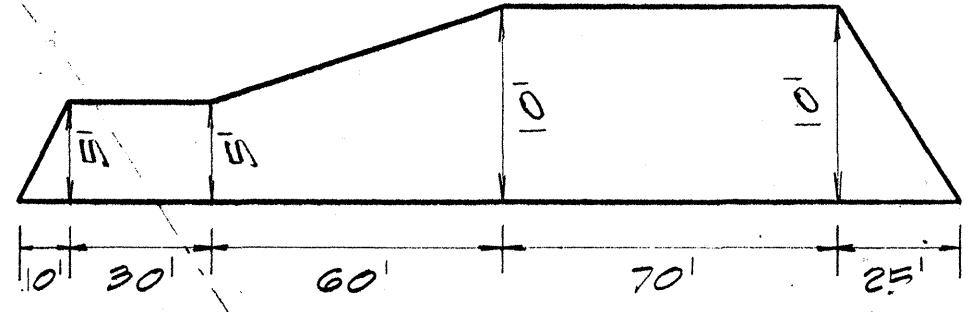

SECTION B-B
N.T.S.

DELETE THIS SHEET

DATE	01/30/93	C.O.#	1
DATE		REVISION	
STATE OF HAWAII DEPARTMENT OF TRANSPORTATION HIGHWAYS DIVISION			
STOCKPILE PLAN			
KALANIANA'OLE HIGHWAY E. HALEMAUMAU ST. TO KEAHOLE ST. F.A. PROJECT NO. NH-STP-072-1 (35)			
Scale:		Date:	
SHEET NO. A-18 OF 18 SHEETS			