


FED. ROAD DIST. NO.	STATE	PROJ. NO.	FISCAL YEAR	SHEET NO.	TOTAL SHEETS
HAWAII	HAW.	72A-01-96M	1996	44	55

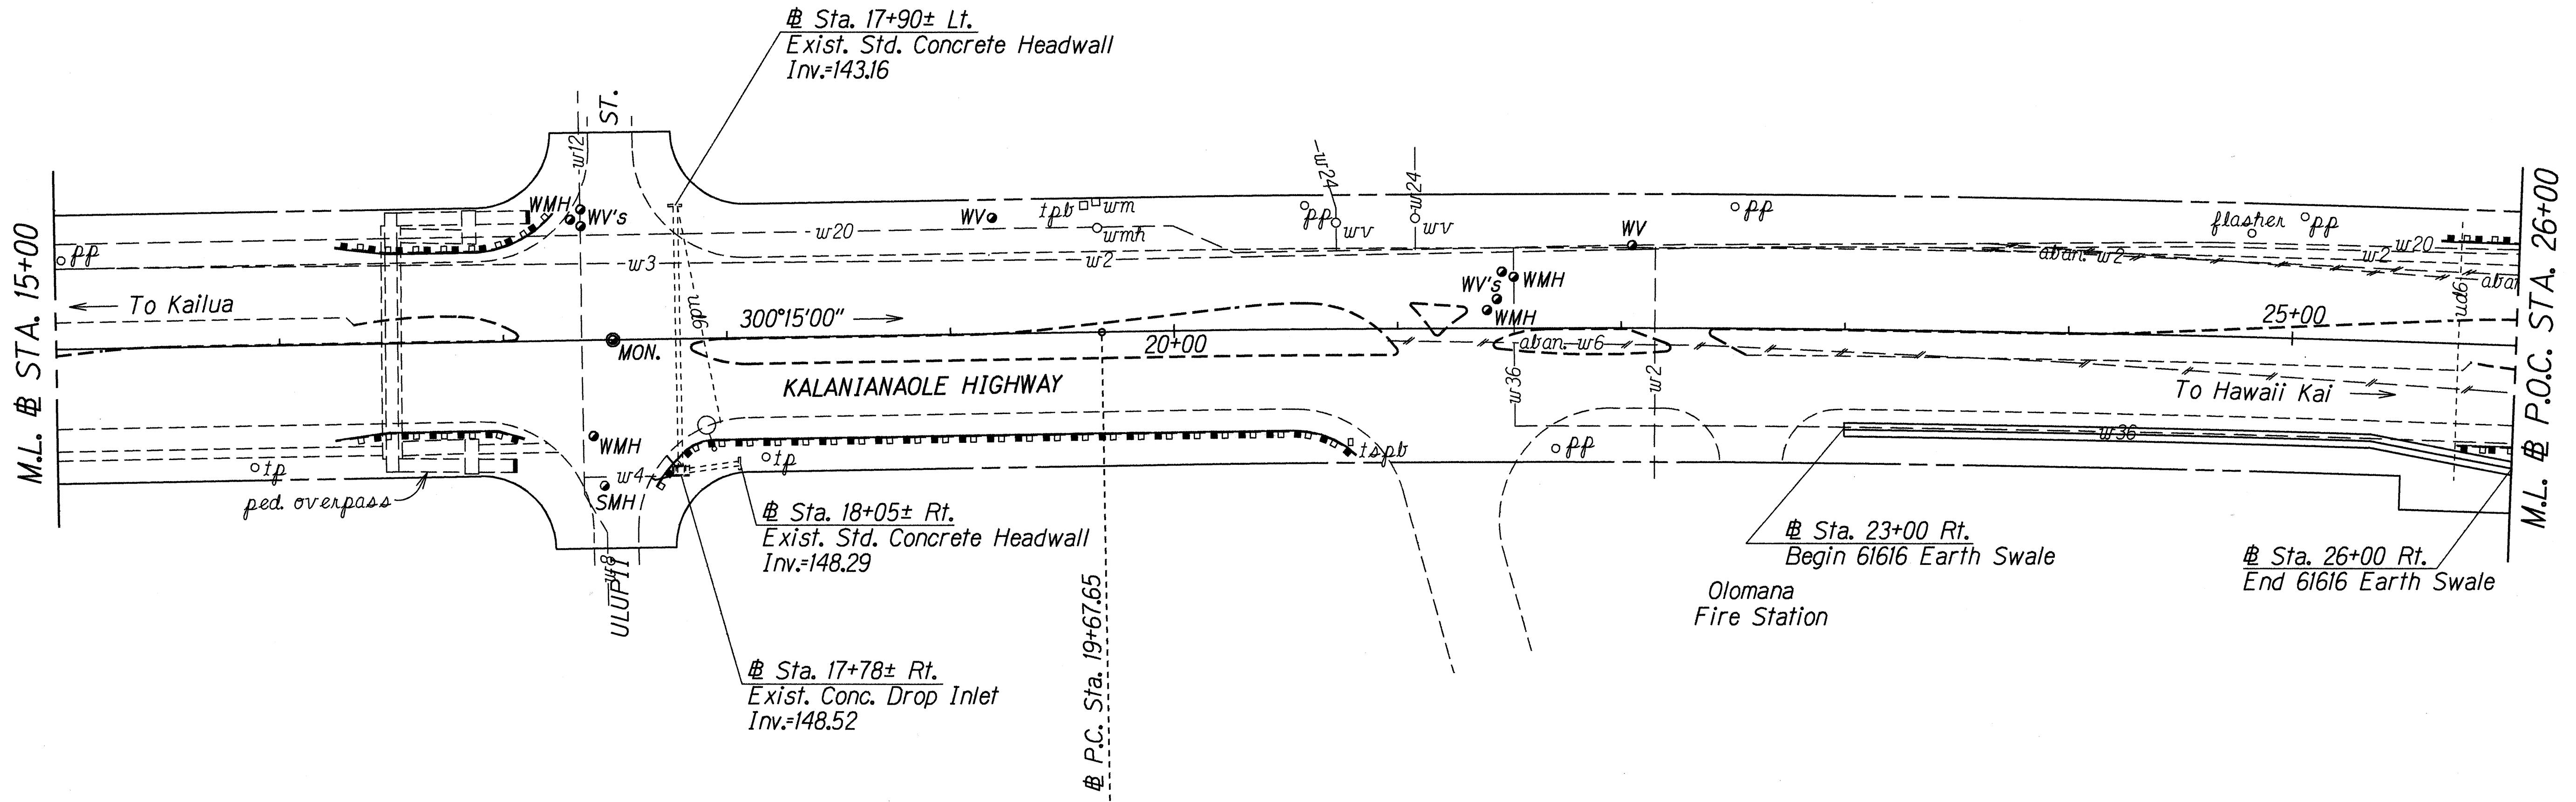

TRUE NORTH
SCALE: 1" = 40'

ORIGINAL PLAN	SURVEY PLOTTED BY	DATE
NOTE BOOK	DRAWN BY	1/20/96
DESIGNED BY	DESIGNED BY	
QUANTITIES BY	QUANTITIES BY	
CHECKED BY	CHECKED BY	

Sta. 17+78± Rt.
Construct: Concrete Pad
(For Details see Sht. No. H12A)
Estimated Quantities
Class A Concrete = 1 C.Y.

Sta. 23+00 Rt. to # Sta. 26+00 Rt.
Construct: 61616 Earth Swale
(For Detail see Sht. No. H12J)
Estimated Quantities
Ditch and Channel Excavation = 17 C.Y.

9/13/96	Class B Concrete changed to Class A.
6/14/96	Notes added to clarify plans.
DATE	REVISION
STATE OF HAWAII DEPARTMENT OF TRANSPORTATION HIGHWAYS DIVISION	
DRAINAGE PLAN	
KALANIANA'OLE HIGHWAY RESURFACING	
Kailua Rd. to Hilo St.	
Project No. 72A-01-96M	
Scale: 1"=40'	Date: May 1996
SHEET No. 44 OF 44 SHEETS	



FED. ROAD DIST. NO.	STATE	PROJ. NO.	FISCAL YEAR	SHEET NO.	TOTAL SHEETS
HAWAII	HAW.	72A-01-96M	1996	45	55

Sta. 30+40±
Construct: Type "X" C.B.
(For Details see Sht. No. H12B)
Estimated Quantities
Type "X" Catch Basin = 1 Ea.

Sta. 32+71± Lt.
Remove and Dispose: Existing Metal Cover
Install: Type A-8 Frame and Grates
(For Details see Sht. No. H12C)
Estimated Quantities
Type A-8 Frame and Grates = 1 Ea.

Sta. 34+40 Lt.
Construct: Std. Concrete Headwall
(For Details see Std. Plan Sht. H-16)
Earth Ditch
Remove: 10' existing CMP
Place: Dumped Riprap
(For Detail see Sht. No. H12E)
Estimated Quantities
Structure Excavation for
Drainage System = 6 C.Y.
Ditch and Channel Excavation = 17 C.Y.
Class A Concrete = 2 C.Y.
Reinforcing Steel = 43 Lb.
Dumped Riprap = 45 C.Y.


Sta. 35+10 Lt.
Remove and Dispose: Existing Metal Cover
Install: Type A-15 Frame and Grate
(For Details see Sht. No. H12D)
Estimated Quantities
Type A-15 Frame and Grate = 1 Ea.

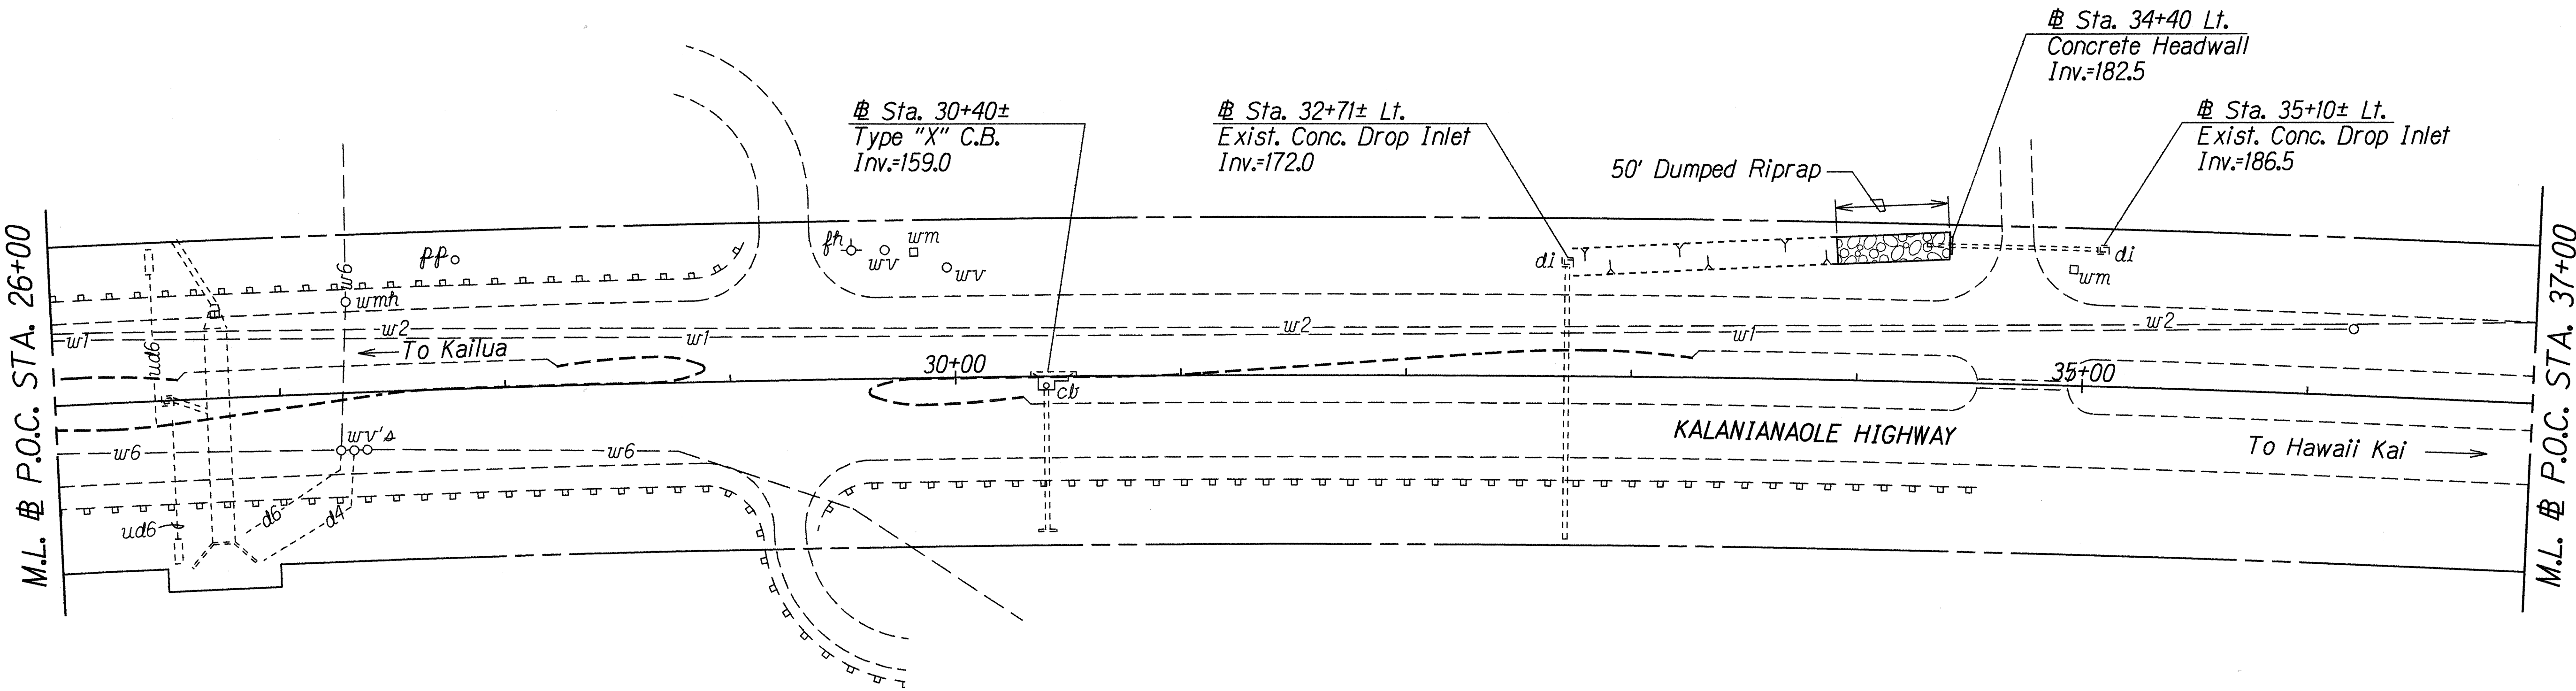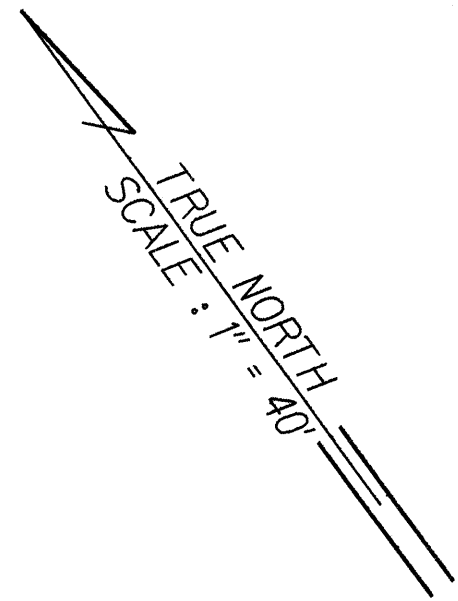

ORIGINAL PLAN	SURVEY PLOTTED BY	DATE
NOTE BOOK	DRAWN BY	5/20/96
QUANTITIES BY	DESIGNED BY	
CHECKED BY	CHECKED BY	

6/14/96	Notes added to clarify plans.
DATE	REVISION
STATE OF HAWAII DEPARTMENT OF TRANSPORTATION HIGHWAYS DIVISION DRAINAGE PLAN KALANIANA'OLE HIGHWAY RESURFACING Kailua Rd. to Hilu St. Project No. 72A-01-96M Scale: 1"=40' Date: May 1996	
SHEET No. H2 OF 12 SHEETS	

FED. ROAD DIST. NO.	STATE	PROJ. NO.	FISCAL YEAR	SHEET NO.	TOTAL SHEETS
HAWAII	HAW.	72A-01-96M	1996	47	55

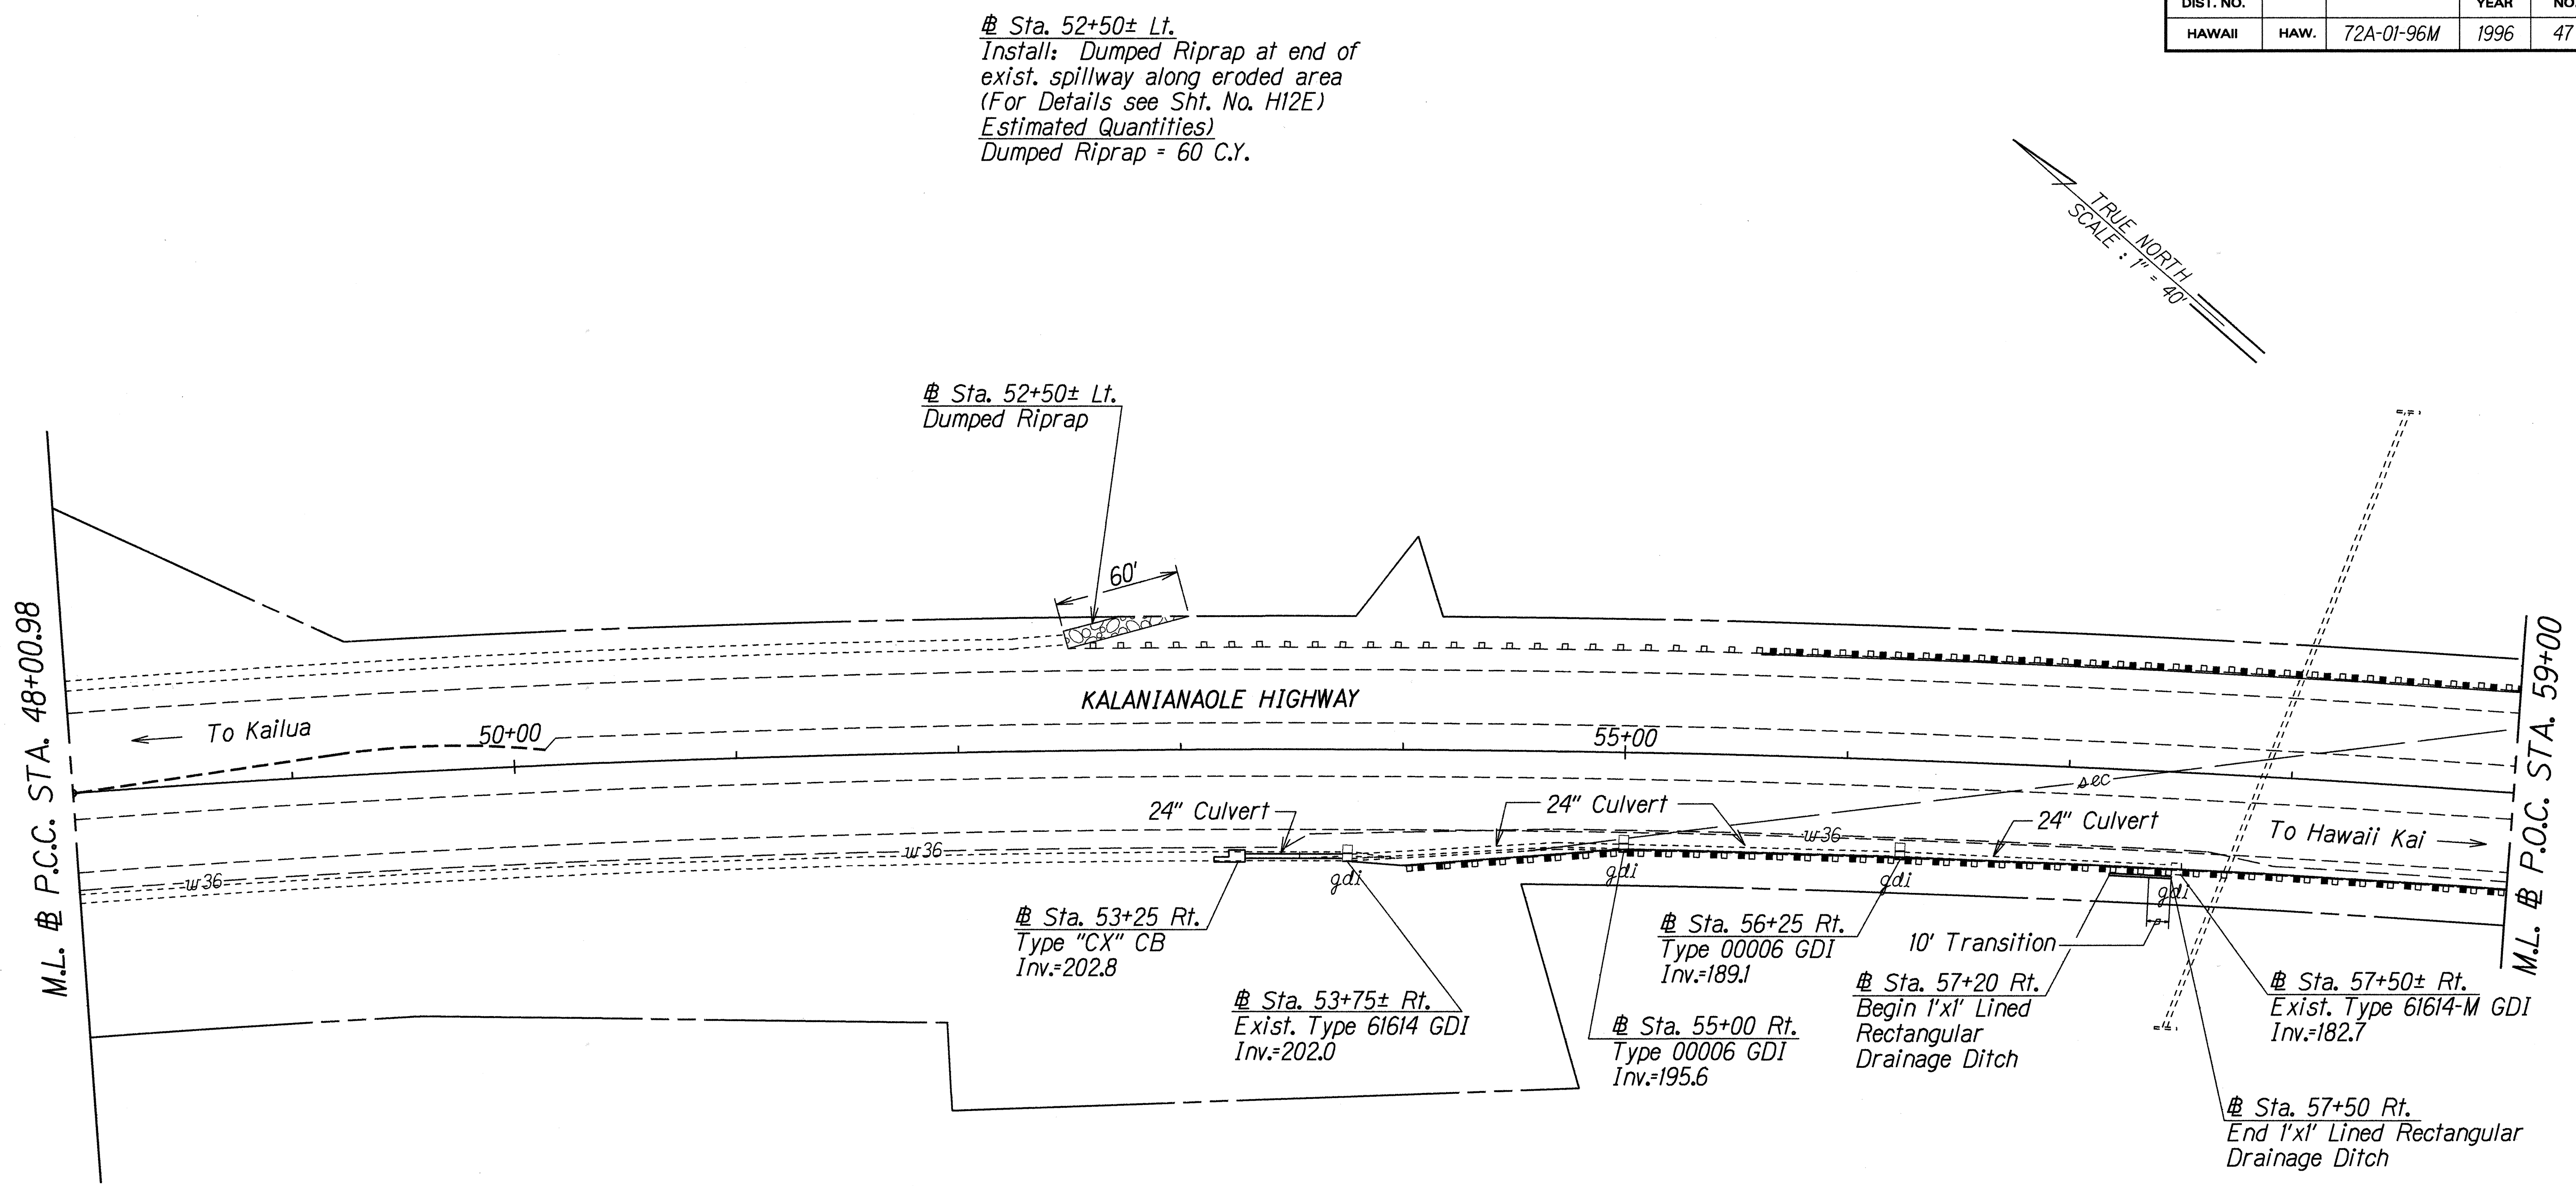

Sta. 52+50± Lt.
Install: Dumped Riprap at end of
exist. spillway along eroded area
(For Details see Sht. No. H12E)
Estimated Quantities
Dumped Riprap = 60 C.Y.

Sta. 52+50± Lt.
Dumped Riprap

Sta. 53+25 Rt.
Type "CX" CB
Inv.=202.8

Sta. 53+75± Rt.
Exist. Type 61614 GDI
Inv.=202.0

Sta. 56+25 Rt.
Type 00006 GDI
Inv.=189.1

Sta. 55+00 Rt.
Type 00006 GDI
Inv.=195.6

Sta. 57+20 Rt.
Begin 1'x1' Lined
Rectangular
Drainage Ditch

Sta. 57+50± Rt.
Exist. Type 61614-M GDI
Inv.=182.7

Sta. 57+50 Rt.
End 1'x1' Lined Rectangular
Drainage Ditch

Sta. 53+25 Rt.
Construct: Type "CX" CB
(For Details see Sht. No. H12N)
Install: 24" CSP
Reconstruct: Concrete Gutter
(For Details see Sht. No. H12O)
Estimated Quantities
Structure Excavation for
Drainage System = 41 C.Y.
Gutter, Type 2(61214) = 50 L.F.
24" CSP, Sht. 1=0.109" = 50 L.F.
Type "CX" CB = 1 Ea.
4.00 Ft. to 4.99 Ft.

Sta. 55+00 Rt.
Construct: Type 00006 GDI
(For Details see Sht. No. H12G)
Estimated Quantities
Type 00006 GDI = 1 Ea.
4.00 Ft. to 4.99 Ft.

Sta. 56+25 Rt.
Construct: Type 00006 GDI
(For Details see Sht. No. H12G)
Estimated Quantities
Type 00006 GDI = 1 Ea.
4.00 Ft. to 4.99 Ft.

Sta. 57+20 Rt. to # Sta. 57+50 Rt.
Construct: 1'x1' Lined Rectangular Drainage Ditch
(For Details see Sht. No. H12K)
Estimated Quantities
Ditch and Channel Excavation = 3 C.Y.
1'x1' Lined Rectangular Drainage Ditch = 30 L.F.

Sta. 57+50± Rt.
Modify: Type 61614-M GDI
(For Details see Sht. No. H12L)

12/5/96	Changed beginning of 1'x1' Lined Rectangular Drainage Ditch
10/1/96	Notes revised to clarify plans.
9/13/96	Changed Type 61214B GDI to Type "CX" CB and portion of Type 2D Curb replaced with 1'x1' Lined Rectangular Drainage Ditch.
6/14/96	Notes added to clarify plans.

DATE	REVISION
STATE OF HAWAII DEPARTMENT OF TRANSPORTATION HIGHWAYS DIVISION DRAINAGE PLAN KALANIANA'OLE HIGHWAY RESURFACING Kailua Rd. to Hilo St. Project No. 72A-01-96M Scale: 1"=40' Date: May 1996	


ORIGINAL PLAN	SURVEY PLOTTED BY	DATE
NOTE BOOK	DRAWN BY	5/20/96
dhialaka	DESIGNED BY	
dhialaka	QUANTITIES BY	
dhialaka	CHECKED BY	

FED. ROAD DIST. NO.	STATE	PROJ. NO.	FISCAL YEAR	SHEET NO.	TOTAL SHEETS
HAWAII	HAW.	72A-01-96M	1996	49	55

Sta. 70+50±
 Modify: Exist. Type 61616 Grates
 (For Details see Sht. No. H12H)
Estimated Quantities
 Type 61616M Grate = 2 Ea.

Sta. 72+00
 Construct: Type 61616M GDI
 (For Grate Details see Sht. No. H12H,
 for GDI and Frame Details see
 Std. Plan Shts. H-12 & H-13)
Estimated Quantities
 Type 61616M GDI, 3.0 Ft. = 1 Ea.

Sta. 80+92±
 Modify: Exist. Type 61616 Grates
 (For Details see Sht. No. H12H)
Estimated Quantities
 Type 61616M Grate = 2 Ea.

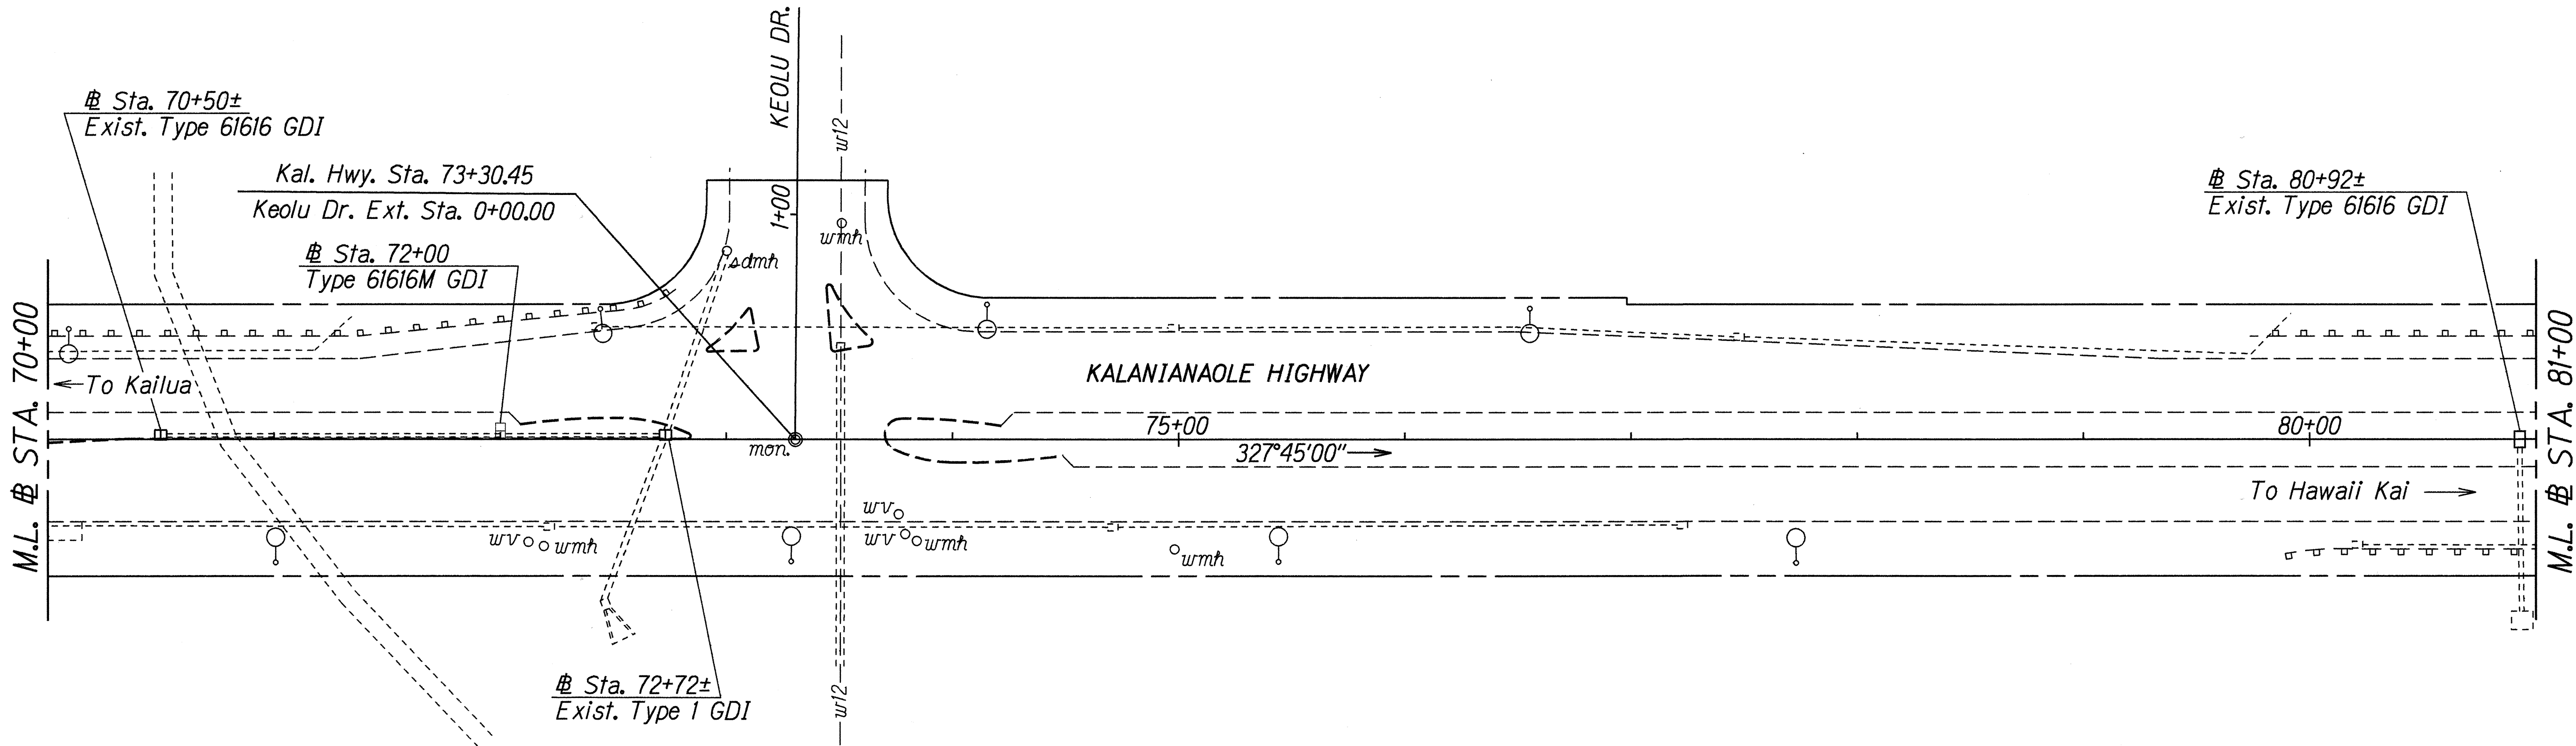

Sta. 72+72±
 Dispose: Exist. Grate
 Install: Type A-9P Grate
 (For Details see Std. Plan Sht. H-09)
Estimated Quantities
 Type A-9P Grate = 1 Ea.



ORIGINAL PLAN	SURVEY PLOTTED BY	DATE
NOTE BOOK	DRAWN BY	5/21/96
DESIGNED BY	DESIGNED BY	
QUANTITIES BY	QUANTITIES BY	
CHECKED BY	CHECKED BY	

6/14/96	Notes added to clarify plans.
DATE	REVISION

STATE OF HAWAII
DEPARTMENT OF TRANSPORTATION
HIGHWAYS DIVISION

DRAINAGE PLAN
KALANIANAʻOLE HIGHWAY RESURFACING
Kailua Rd. to Hilo St.
Project No. 72A-01-96M
Scale: 1"=40'
Date: May 1996

FED. ROAD DIST. NO.	STATE	PROJ. NO.	FISCAL YEAR	SHEET NO.	TOTAL SHEETS
HAWAII	HAW.	72A-01-96M	1996	50	55

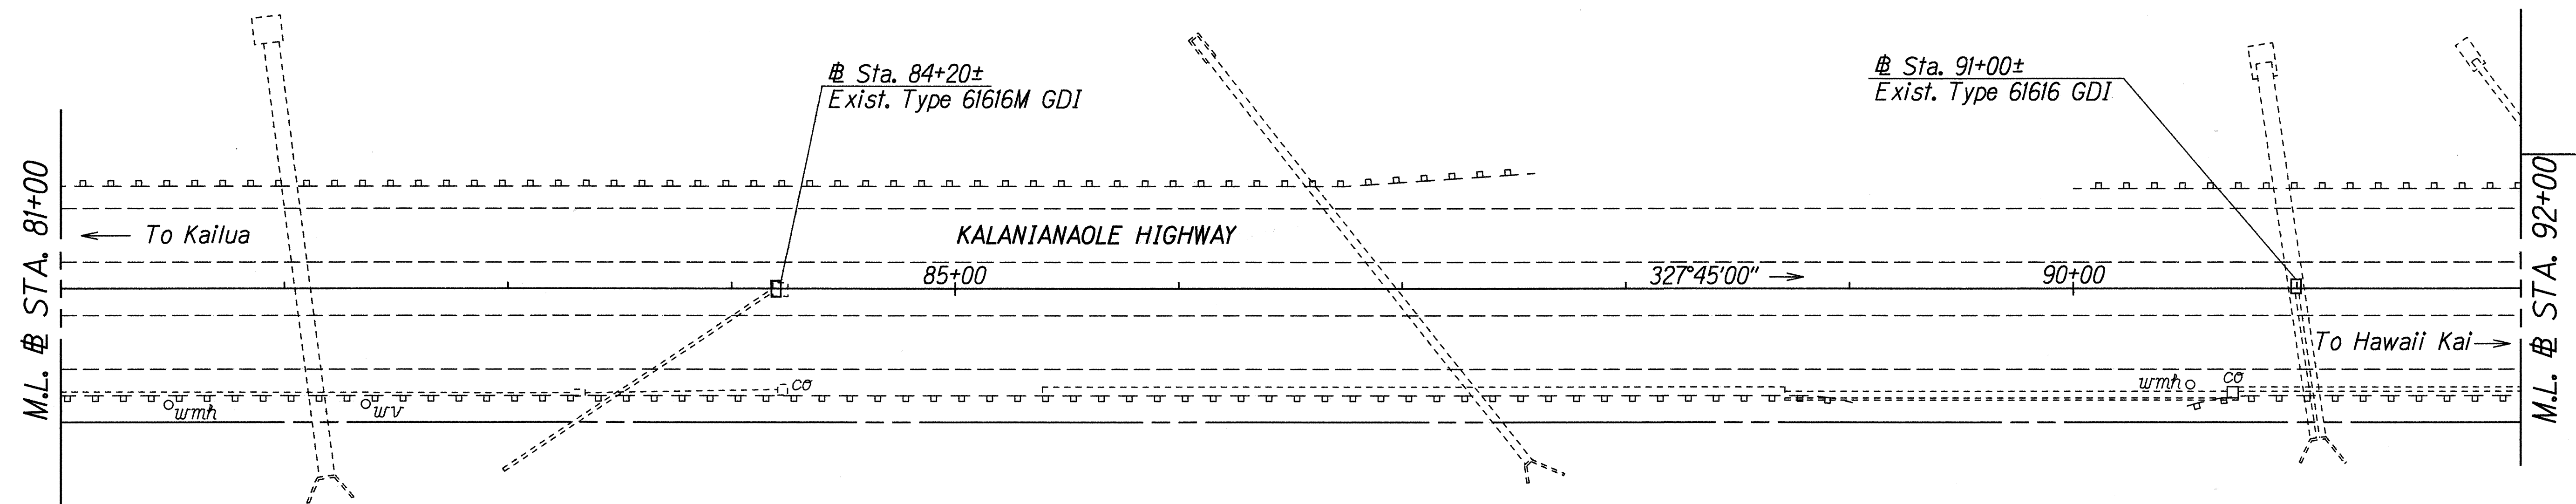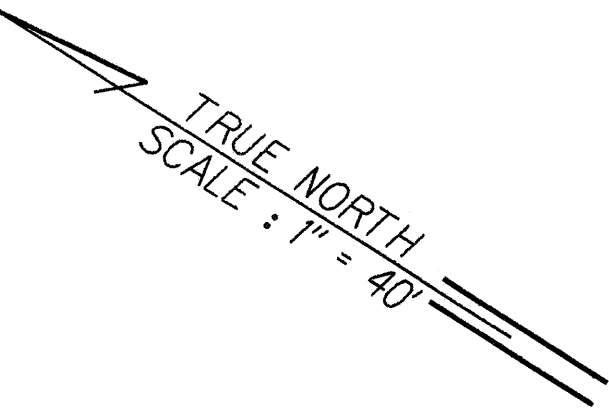

ORIGINAL PLAN	SURVEY PLOTTED BY	DATE
NOTE BOOK	DRAWN BY A. Kailua	5/21/96
DESIGNED BY R. Sakamoto		
QUANTITIES BY N. Kanaka		
CHECKED BY		

Sta. 84+20±
Demolish, Remove and Dispose:
Exist. Type 2 GDI
Construct: Type 61616M GDI
(For Grate Details see Sht. No. H12H,
for GDI and Frame Details see
Std. Plan Shts. H-12 & H-13)
Estimated Quantities
Type 61616M GDI, 2.8 Ft. = 1 Ea.

Sta. 91+00±
Modify: Exist. Type 61616 Grates
(For Details see Sht. No. H12H)
Estimated Quantities
Type 61616M Grate = 2 Ea.

6/14/96 Notes added to clarify plans.

DATE REVISION

STATE OF HAWAII
DEPARTMENT OF TRANSPORTATION
HIGHWAYS DIVISION
DRAINAGE PLAN
KALANIANA'OLE HIGHWAY RESURFACING
Kailua Rd. to Hilo St.
Project No. 72A-01-96M

Scale: 1"=40' Date: May 1996


SHEET No. H7 OF 12 SHEETS

ADD. 50

FED. ROAD DIST. NO.	STATE	PROJ. NO.	FISCAL YEAR	SHEET NO.	TOTAL SHEETS
HAWAII	HAW.	72A-01-96M	1996	51	55

Sta. 99+00±
 Modify: Exist. Type 61616 Grates
 (For Details see Sht. No. H12H)
 Estimated Quantities
 Type 61616M Grate = 2 Ea.

Sta. 101+50± Lt. to # Sta. 103+00 Lt.
 Construct: Gutter, Type 2(61614)
 Estimated Quantities
 Gutter, Type 2(61614) = 150 L.F.

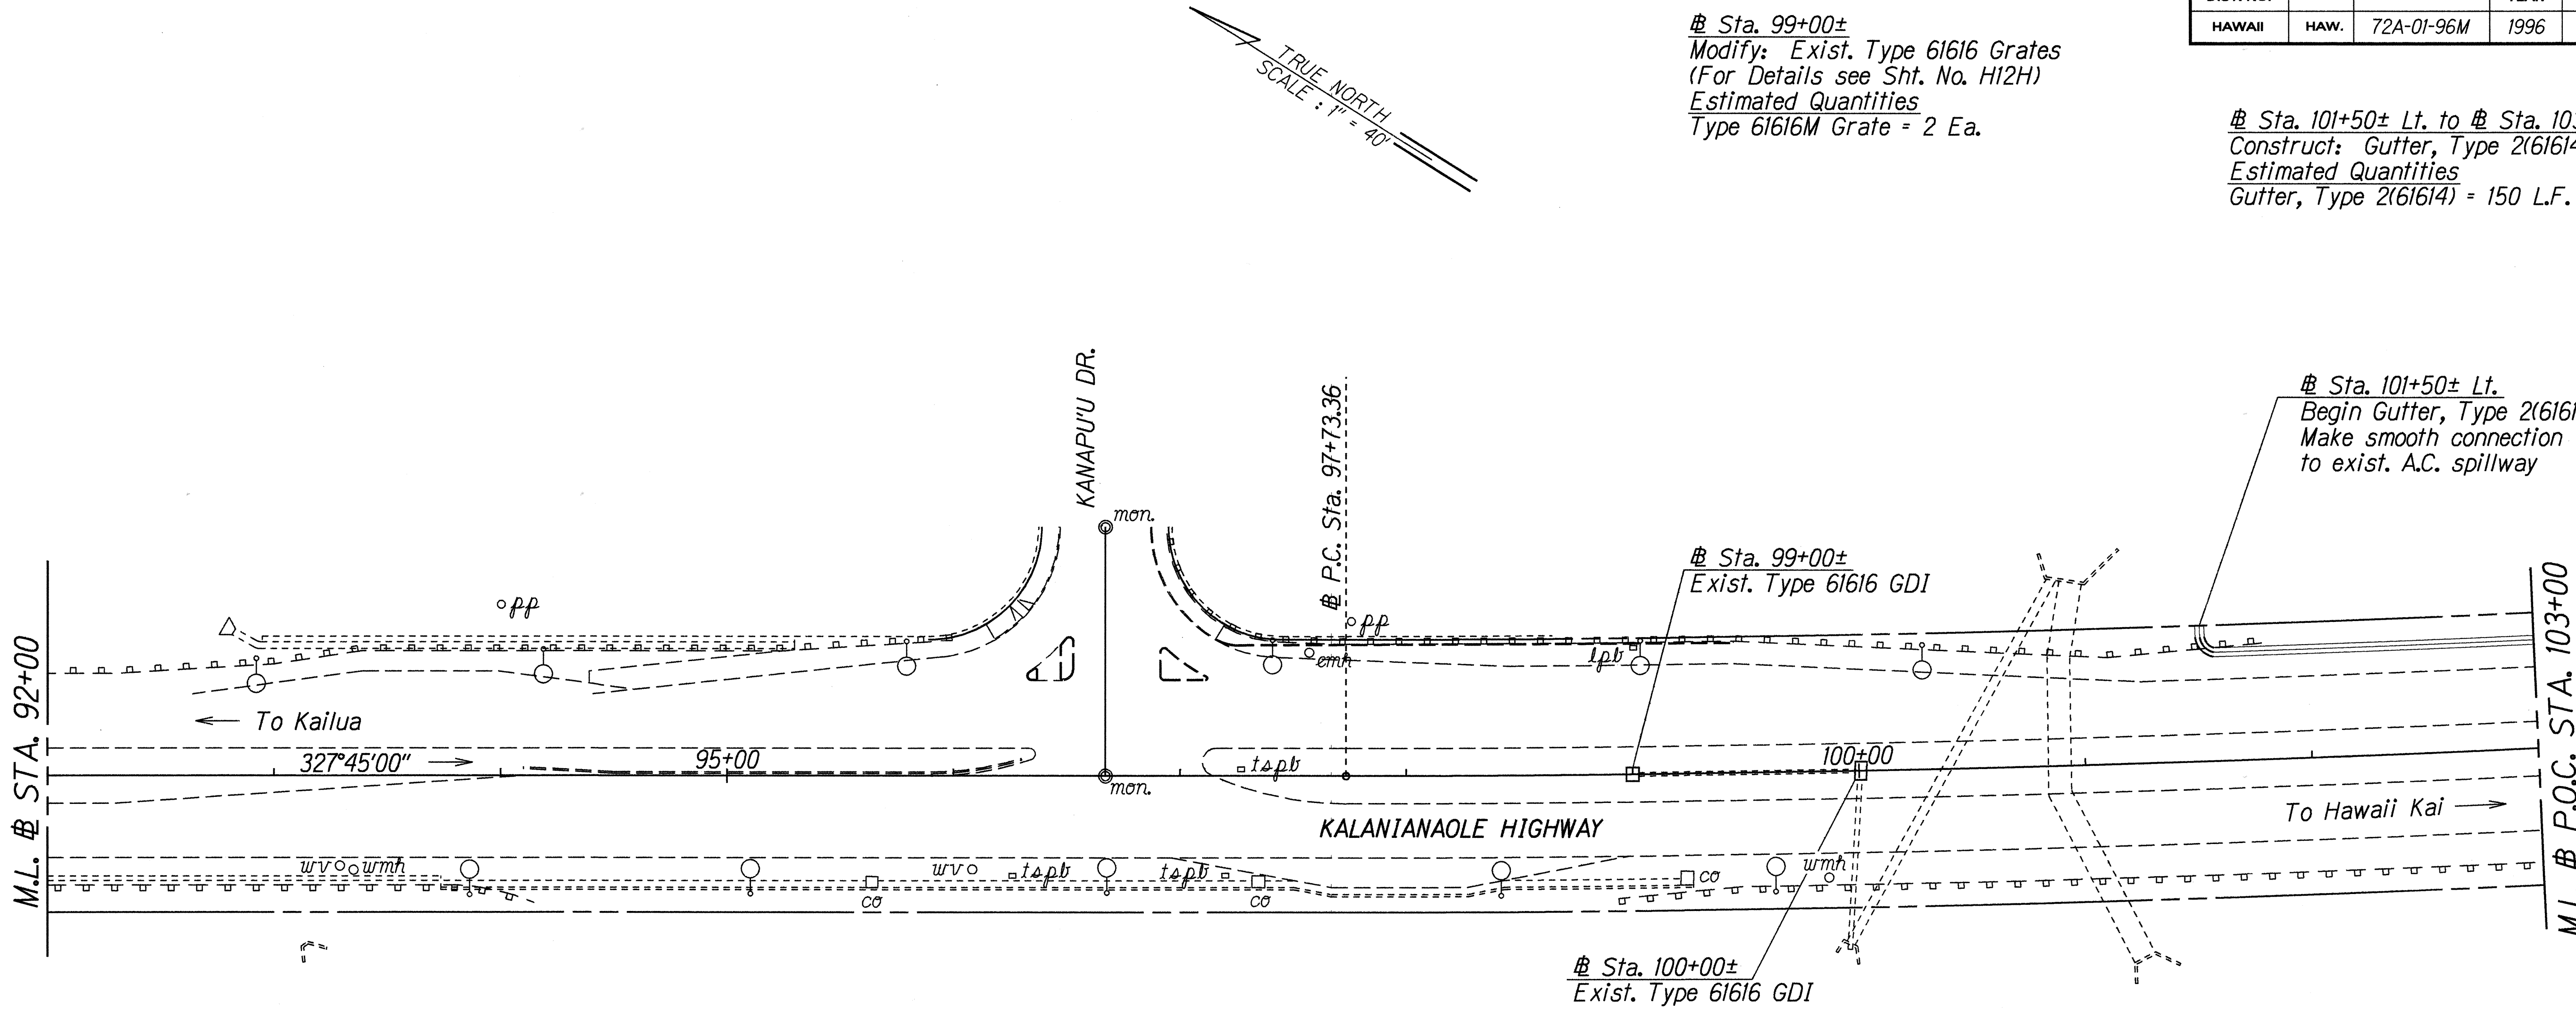

ORIGINAL PLAN	SURVEY PLOTTED BY	DATE
NOTE BOOK	DRAWN BY A. Kama	5/21/96
DESIGNED BY R. Sato		
QUANTITIES BY		
CHECKED BY		

Sta. 100+00±
 Modify: Exist. Type 61616 Grates
 (For Details see Sht. No. H12H)
 Estimated Quantities
 Type 61616M Grate = 2 Ea.

6/14/96 Notes added to clarify plans.

DATE REVISION

STATE OF HAWAII
 DEPARTMENT OF TRANSPORTATION
 HIGHWAYS DIVISION

DRAINAGE PLAN

KALANIANA'OLE HIGHWAY RESURFACING

Kailua Rd. to Hilo St.

Project No. 72A-01-96M



Scale: 1"=40'

Date: May 1996

SHEET No. H8 OF 12 SHEETS

FED. ROAD DIST. NO.	STATE	PROJ. NO.	FISCAL YEAR	SHEET NO.	TOTAL SHEETS
HAWAII	HAW.	72A-01-96M	1996	52	55

@ Sta. 103+00 Lt. to @ Sta. 114+00 Lt.
 Construct: Gutter, Type 2(61614)
 Estimated Quantities
 Gutter, Type 2(61614) = 1100 L.F.

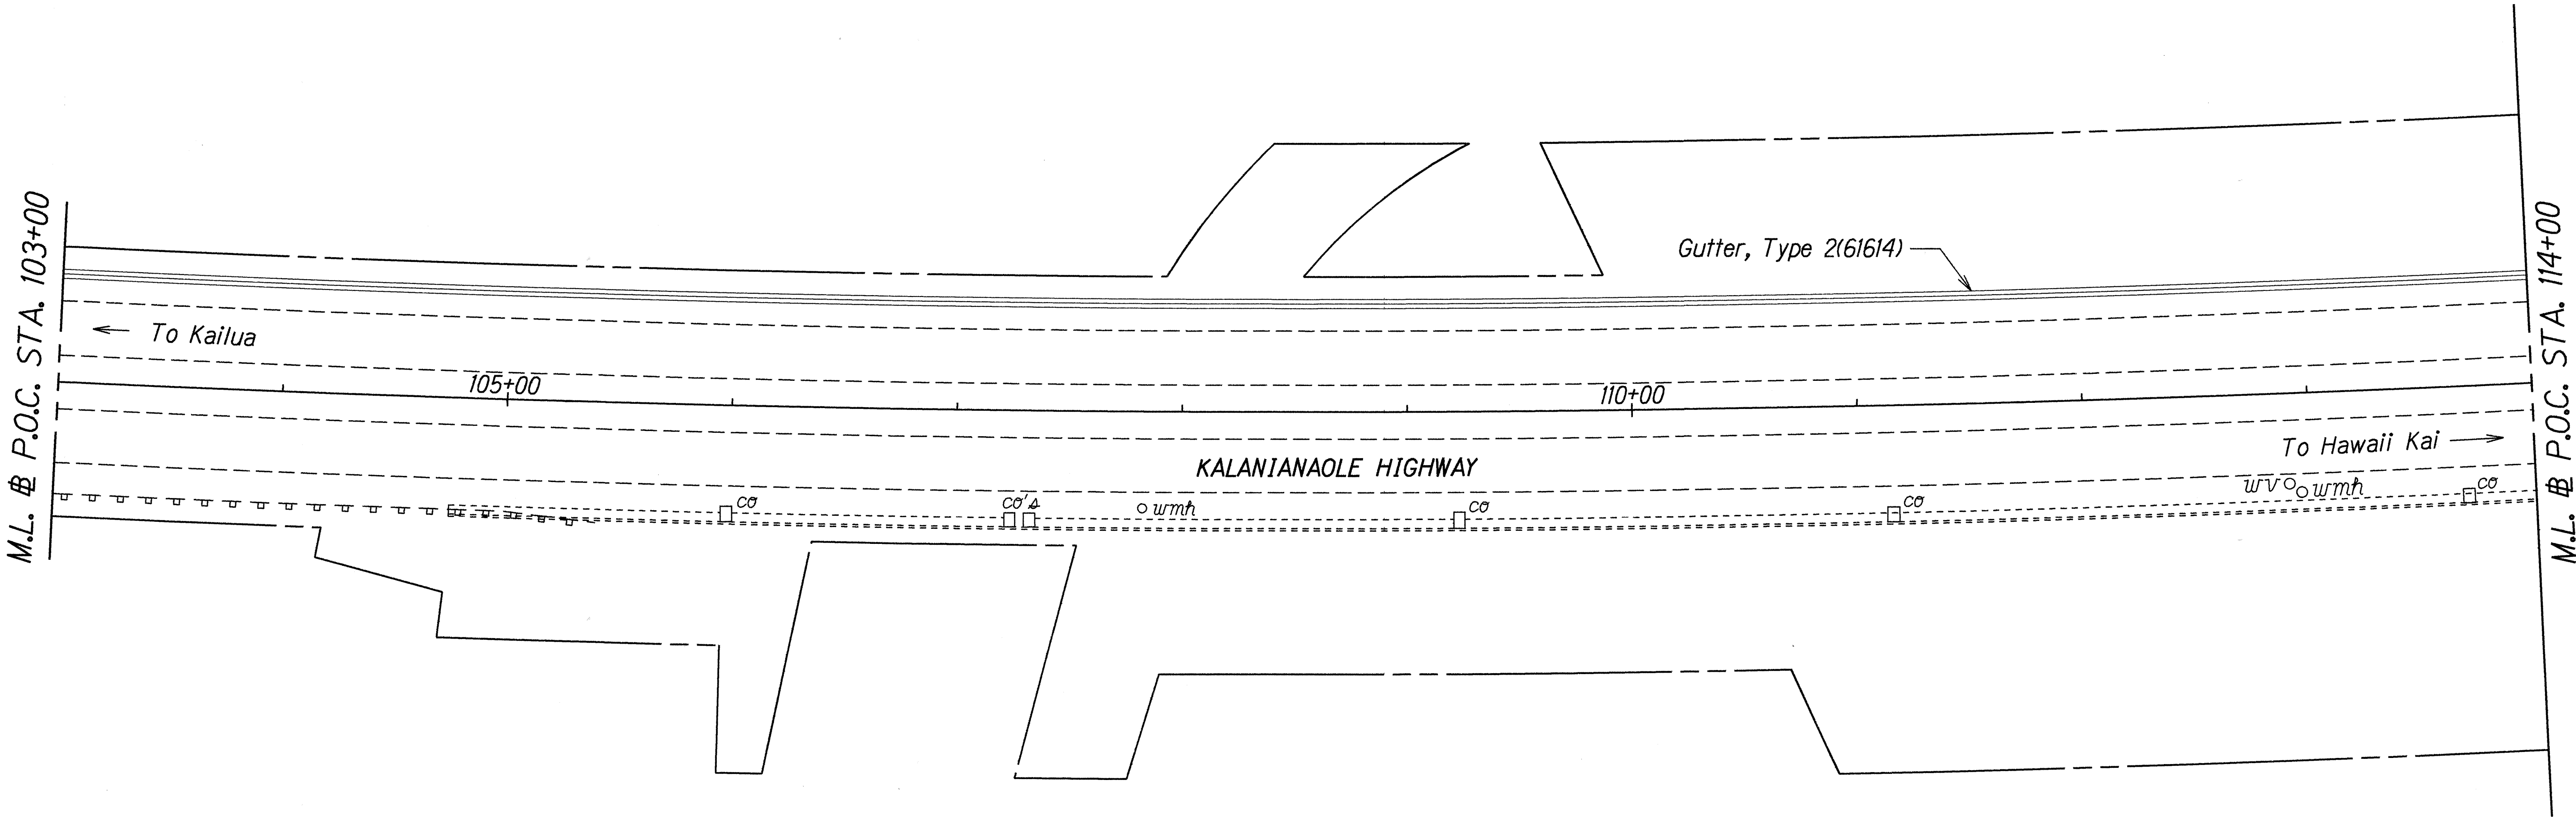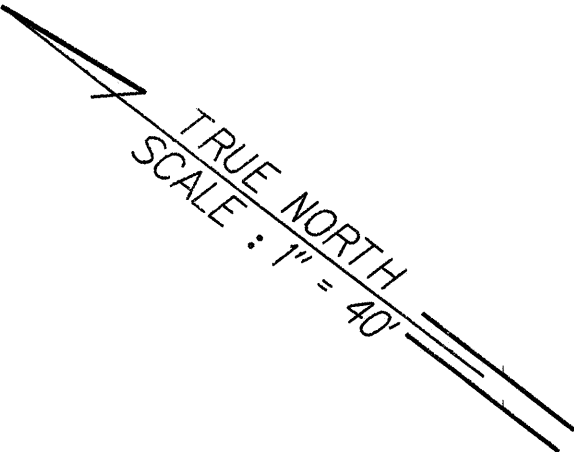

ORIGINAL PLAN	SURVEY PLOTTED BY	DATE
NOTE BOOK	DRAWN BY A. Kama	5/21/96
dhialakai	DESIGNED BY R. Sakamoto	
quantities	CHECKED BY	
5/21/96		

6/14/96	Notes added to clarify plans.
DATE	REVISION
STATE OF HAWAII DEPARTMENT OF TRANSPORTATION HIGHWAYS DIVISION <u>DRAINAGE PLAN</u> <u>KALANIANA'OLE HIGHWAY RESURFACING</u> <u>Kailua Rd. to Hilo St.</u> <u>Project No. 72A-01-96M</u> Scale: 1"=40' Date: May 1996	
SHEET No. H9 OF 12 SHEETS	

FED. ROAD DIST. NO.	STATE	PROJ. NO.	FISCAL YEAR	SHEET NO.	TOTAL SHEETS
HAWAII	HAW.	72A-01-96M	1996	53	55



Sta. 114+00 Lt. to # Sta. 114+50 Lt.
Sta. 118+50 Lt. to # Sta. 122+00 Lt.
Construct: Gutter, Type 2(61614)
Estimated Quantities
Gutter, Type 2(61614) = 400 L.F.

Sta. 114+55± Lt.
Construct: Inlet Structure and Concrete Load Distribution Pad over Pipe
(For Details see Sht. No. H12F)
Install: 24" CSP
Estimated Quantities
Structure Excavation for Drainage System = 40 C.Y.
Class A Concrete for Drainage System = 7 C.Y.
Reinforcing Steel For Drainage System = 675 Lb.
24" CSP, Sht. "P"=0.109" = 60 L.F.

Sta. 115+18± Lt.
Construct: Standard Concrete Headwall
(For Details see Std. Plan Sht. H-16)
2'x1' Concrete Lined Vee Ditch
(For Detail see Sht. No. H12J)
Estimated Quantities
Structure Excavation for Drainage System = 6 C.Y.
Ditch and Channel Excavation = 13 C.Y.
Class A Concrete for Drainage System = 2 C.Y.
Reinforcing Steel for Drainage System = 43 Lb.
2'x1' Concrete Lined Vee Ditch = 90 L.F.
Dumped Riprap = 4 C.Y.

Sta. 118+00 Lt.
Construct: Type A Spillway
(For Detail see Sht. No. H12I)
Estimated Quantities
Type A Spillway = 1 Ea.

Sta. 122+00 Lt.
Construct: 2'x1' Concrete Lined Vee Ditch
(For Detail see Sht. No. H12J)
Estimated Quantities
Ditch and Channel Excavation = 12 C.Y.
2'x1' Concrete Lined Vee Ditch = 80 L.F.
Dumped Riprap = 4 C.Y.

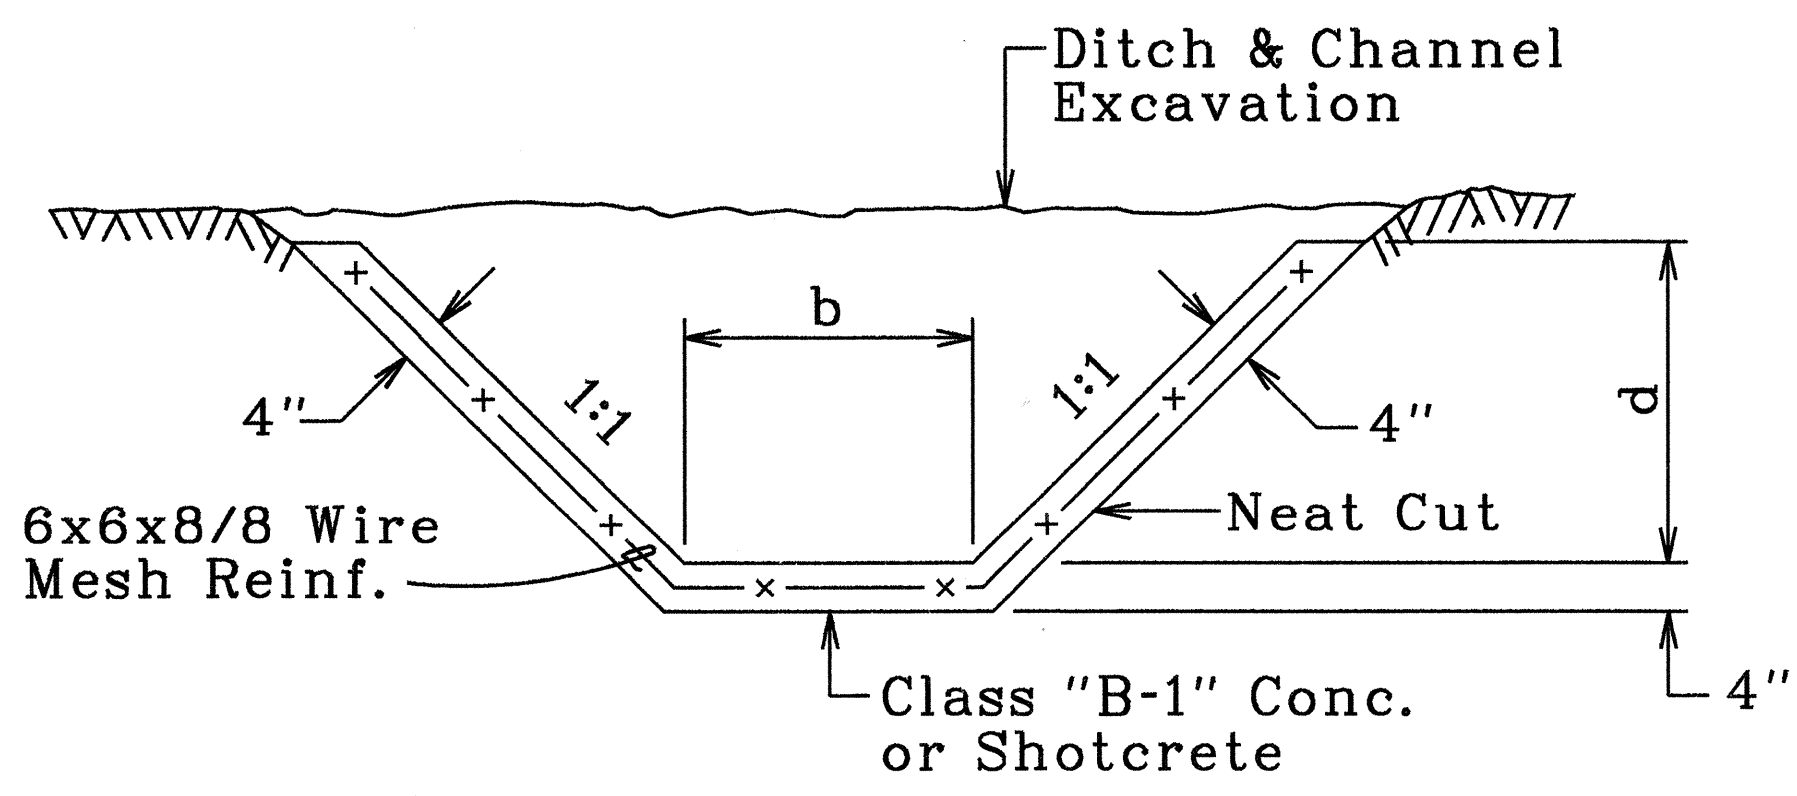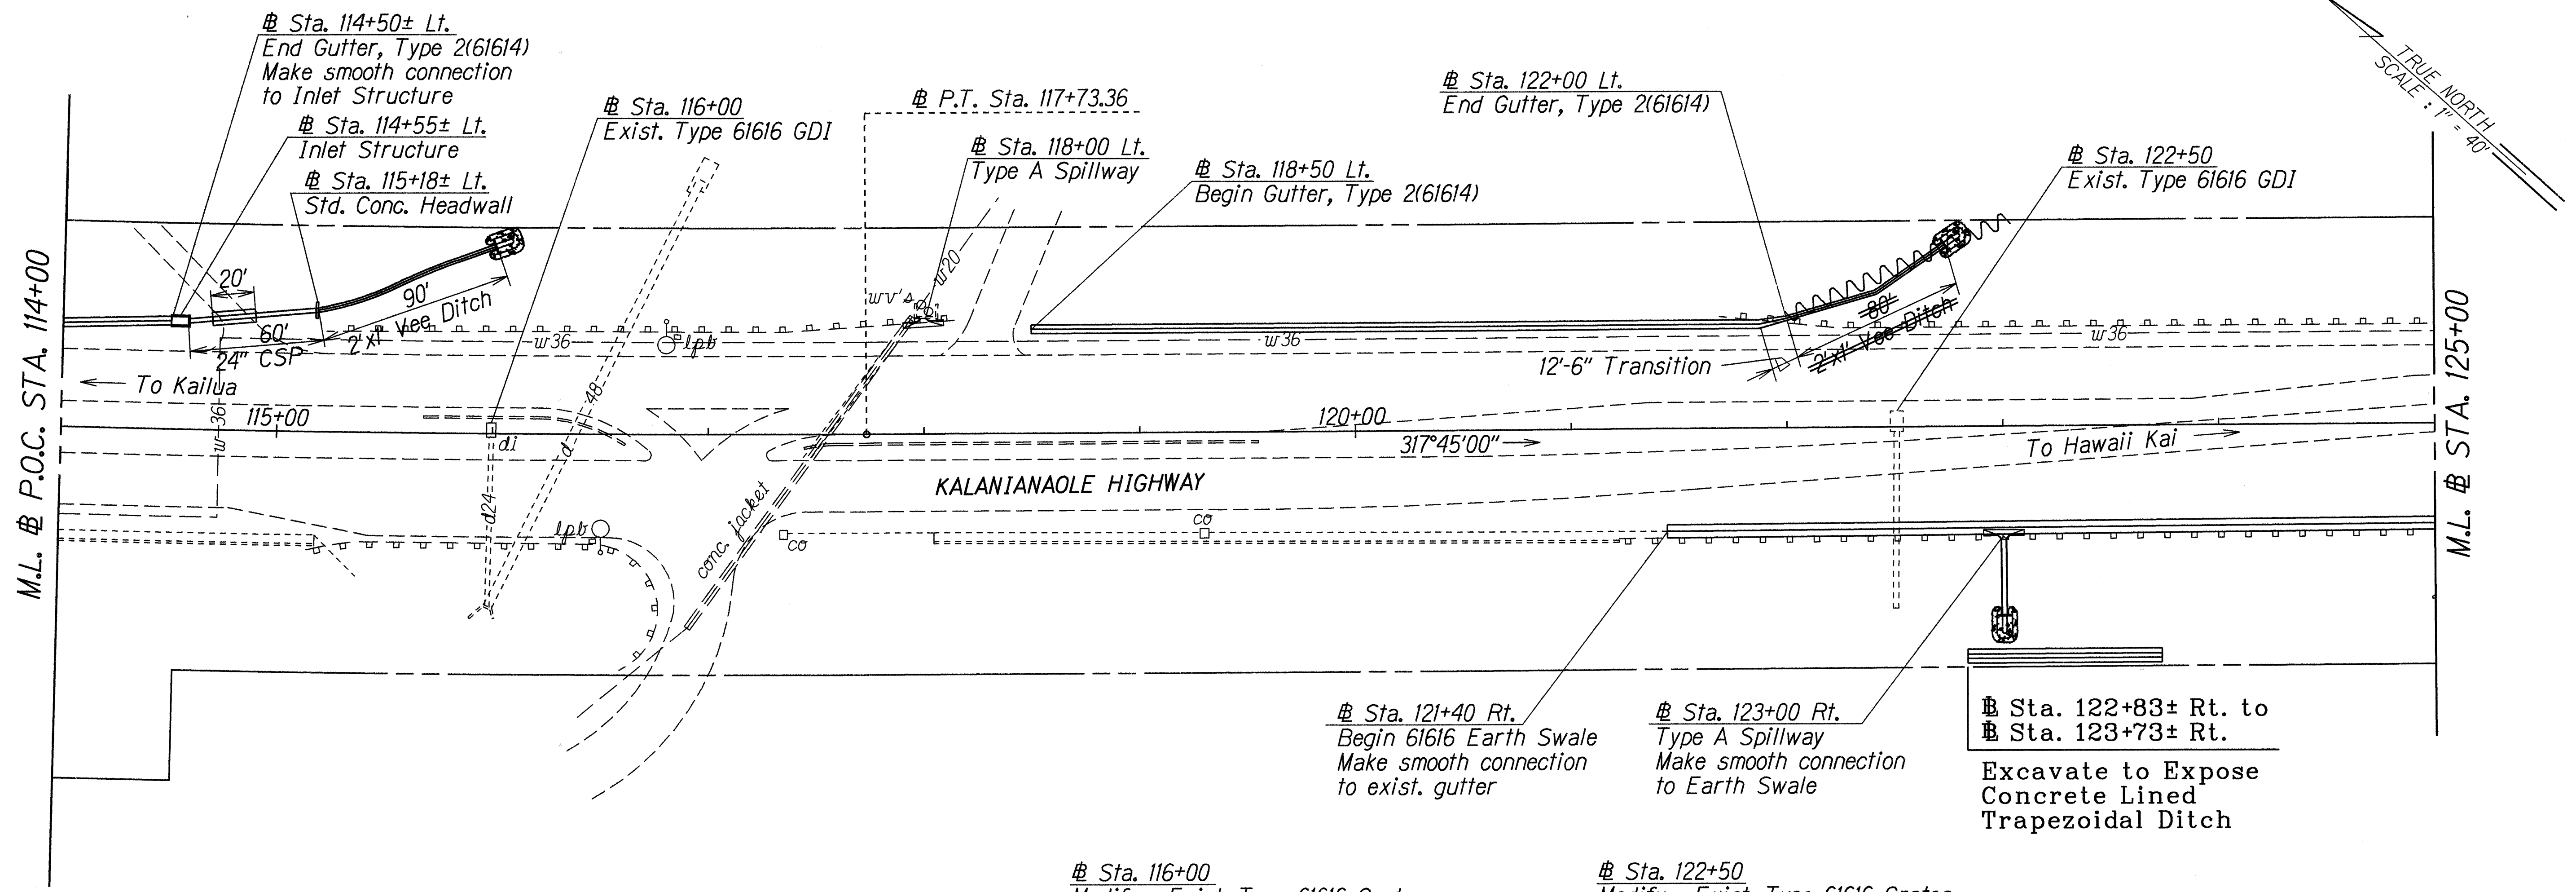

CONCRETE LINED DITCH (b x d)
Scale: 3/4"=1'-0"

Sta. 116+00
Modify: Exist. Type 61616 Grates
(For Details see Sht. No. H12H)
Estimated Quantities
Type 61616M Grate = 2 Ea.

Sta. 121+40 Rt. to # Sta. 125+00 Rt.
Construct: 61616 Earth Swale
(For Details see Sht. No. H12J)
Estimated Quantities
Ditch and Channel Excavation = 20 C.Y.

Sta. 122+50
Modify: Exist. Type 61616 Grates
(For Details see Sht. No. H12H)
Estimated Quantities
Type 61616M Grate = 2 Ea.

Sta. 123+00 Rt.
Construct: Type A Spillway,
2'x1' Concrete Lined Vee Ditch
(For Details see Sht. Nos. H12I & H12J)
Estimated Quantities
Ditch and Channel Excavation = 5 C.Y.
2'x1' Concrete Lined Vee Ditch = 32 L.F.
Type A Spillway = 1 Ea.
Dumped Riprap = 4 C.Y.

Sta. 122+83± Rt. to # Sta. 123+73± Rt.
Excavate to Expose Concrete Lined Trapezoidal Ditch


LEGEND FOR AS-BUILT POSTINGS	
	Squiggly line for as-built deletion
	Double line for as-built deletion
Roadway	Text for as-built posting

6/14/96	Notes added to clarify plans.
DATE	REVISION
STATE OF HAWAII DEPARTMENT OF TRANSPORTATION HIGHWAYS DIVISION	
DRAINAGE PLAN	
KALANIANA'OLE HIGHWAY RESURFACING	
Kailua Rd. to Hilu St.	
Project No. 72A-01-96M	
Scale: 1"=40'	Date: May 1996
SHEET No. H10 OF 12 SHEETS	

SURVEY PLOTTED BY	DATE
DRAWN BY A. Manuwa & A. Saino	5/21/96
TRACED BY B. Sakamoto	
NOTE BOOK	
QUANTITIES BY	
CHECKED BY	

FED. ROAD DIST. NO.	STATE	PROJ. NO.	FISCAL YEAR	SHEET NO.	TOTAL SHEETS
HAWAII	HAW.	72A-01-96M	1996	54	55

126+35± Lt.
~~# Sta. 126+43± Lt.~~
Construct: Type A Spillway,
2'x1' Concrete Lined Vee Ditch
(For Details see Sht. Nos. H12I & H12J)
Estimated Quantities
Ditch and Channel Excavation = 6 C.Y.
2'x1' Concrete Lined Vee Ditch = 44 L.F.
Type A Spillway = 1 Ea.
Dumped Riprap = 4 C.Y.

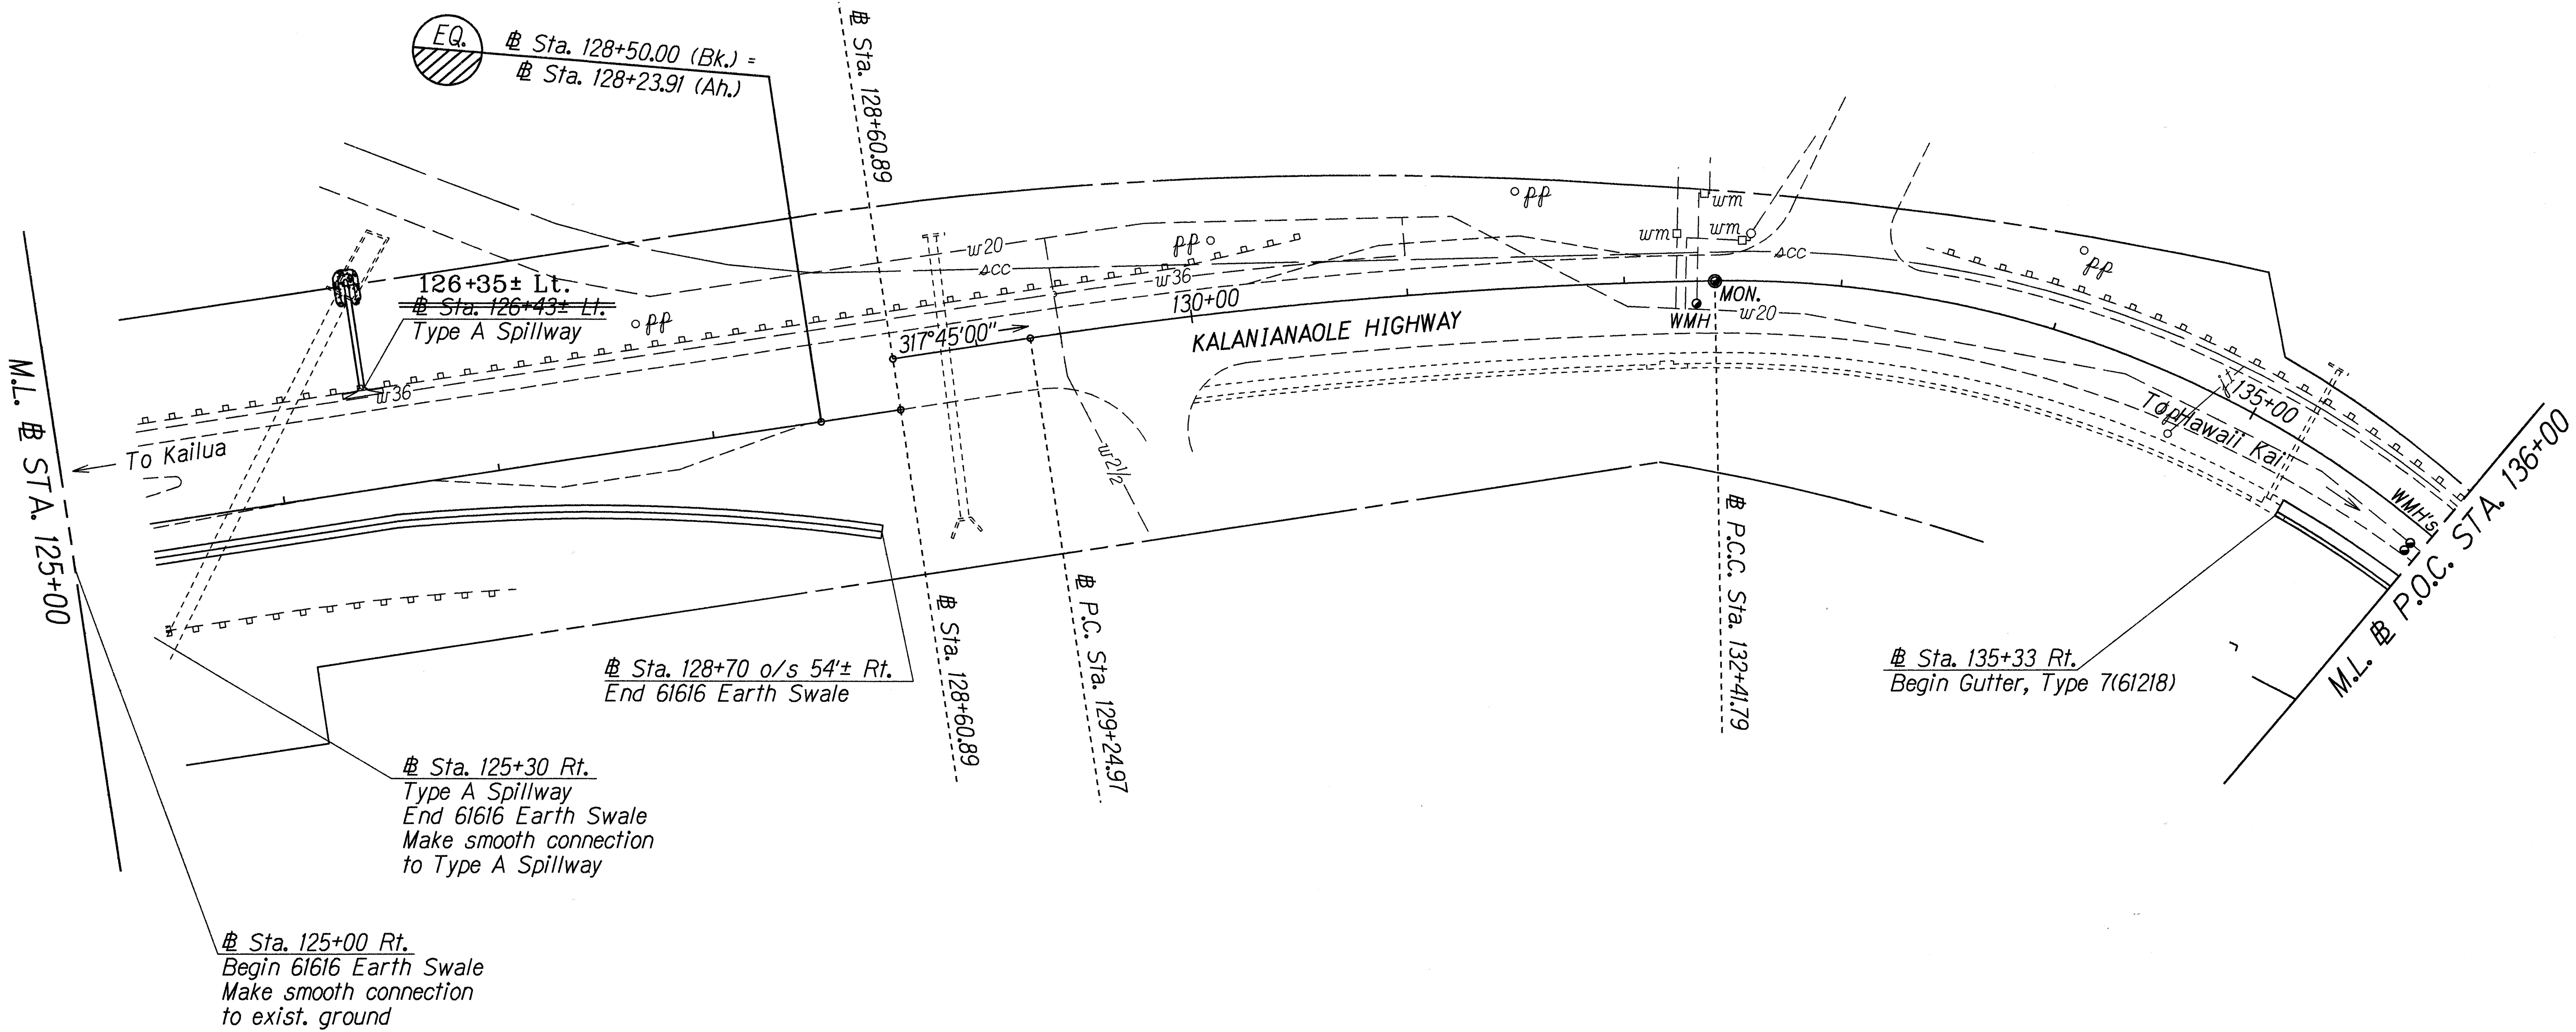

Sta. 125+00 Rt. to # Sta. 128+70 o/s 54± Rt.
Construct: 61616 Earth Swale
Estimated Quantities
Ditch and Channel Excavation = 21 C.Y.

Sta. 125+00 Rt. to # Sta. 125+30 Rt.
Construct: 61616 Earth Swale
Estimated Quantities
Ditch and Channel Excavation = 2 C.Y.

Sta. 125+30 Rt.
Construct: Type A Spillway,
2'x1' Concrete Lined Vee Ditch
(For Details see Sht. Nos. H12I & H12J)
Estimated Quantities
Ditch and Channel Excavation = 4 C.Y.
2'x1' Concrete Lined Vee Ditch = 30 L.F.
Type A Spillway = 1 Ea.
Dumped Riprap = 4 C.Y.


Sta. 135+33 Rt. to # Sta. 136+00 Rt.
Construct: Gutter, Type 7(61218)
Estimated Quantities
Gutter, Type 7(61218) = 67 L.F.

LEGEND FOR AS-BUILT POSTINGS	
	Squiggly line for as-built deletion
	Double line for as-built deletion
Roadway	Text for as-built posting

12/5/96	Added spillway at # Sta. 126+43± Rt.
6/14/96	Notes added to clarify plans.
DATE	REVISION
STATE OF HAWAII DEPARTMENT OF TRANSPORTATION HIGHWAYS DIVISION	
DRAINAGE PLAN	
KALANIANA'OLE HIGHWAY RESURFACING	
Kailua Rd. to Hilo St.	
Project No. 72A-01-96M	
Scale: 1"=40'	Date: May 1996
SHEET No. H11 OF 12 SHEETS	


ORIGINAL PLAN	DATE: 5/21/96
NOTE BOOK	DRAWN BY: A. Sato
CHIEF ENGINEER	CHECKED BY: B. Salando
DESIGNED BY: B. Salando	QUANTITIES BY: B. Salando
CHECKED BY: B. Salando	

FED. ROAD DIST. NO.	STATE	PROJ. NO.	FISCAL YEAR	SHEET NO.	TOTAL SHEETS
HAWAII	HAW.	72A-01-96M	1996	55	55

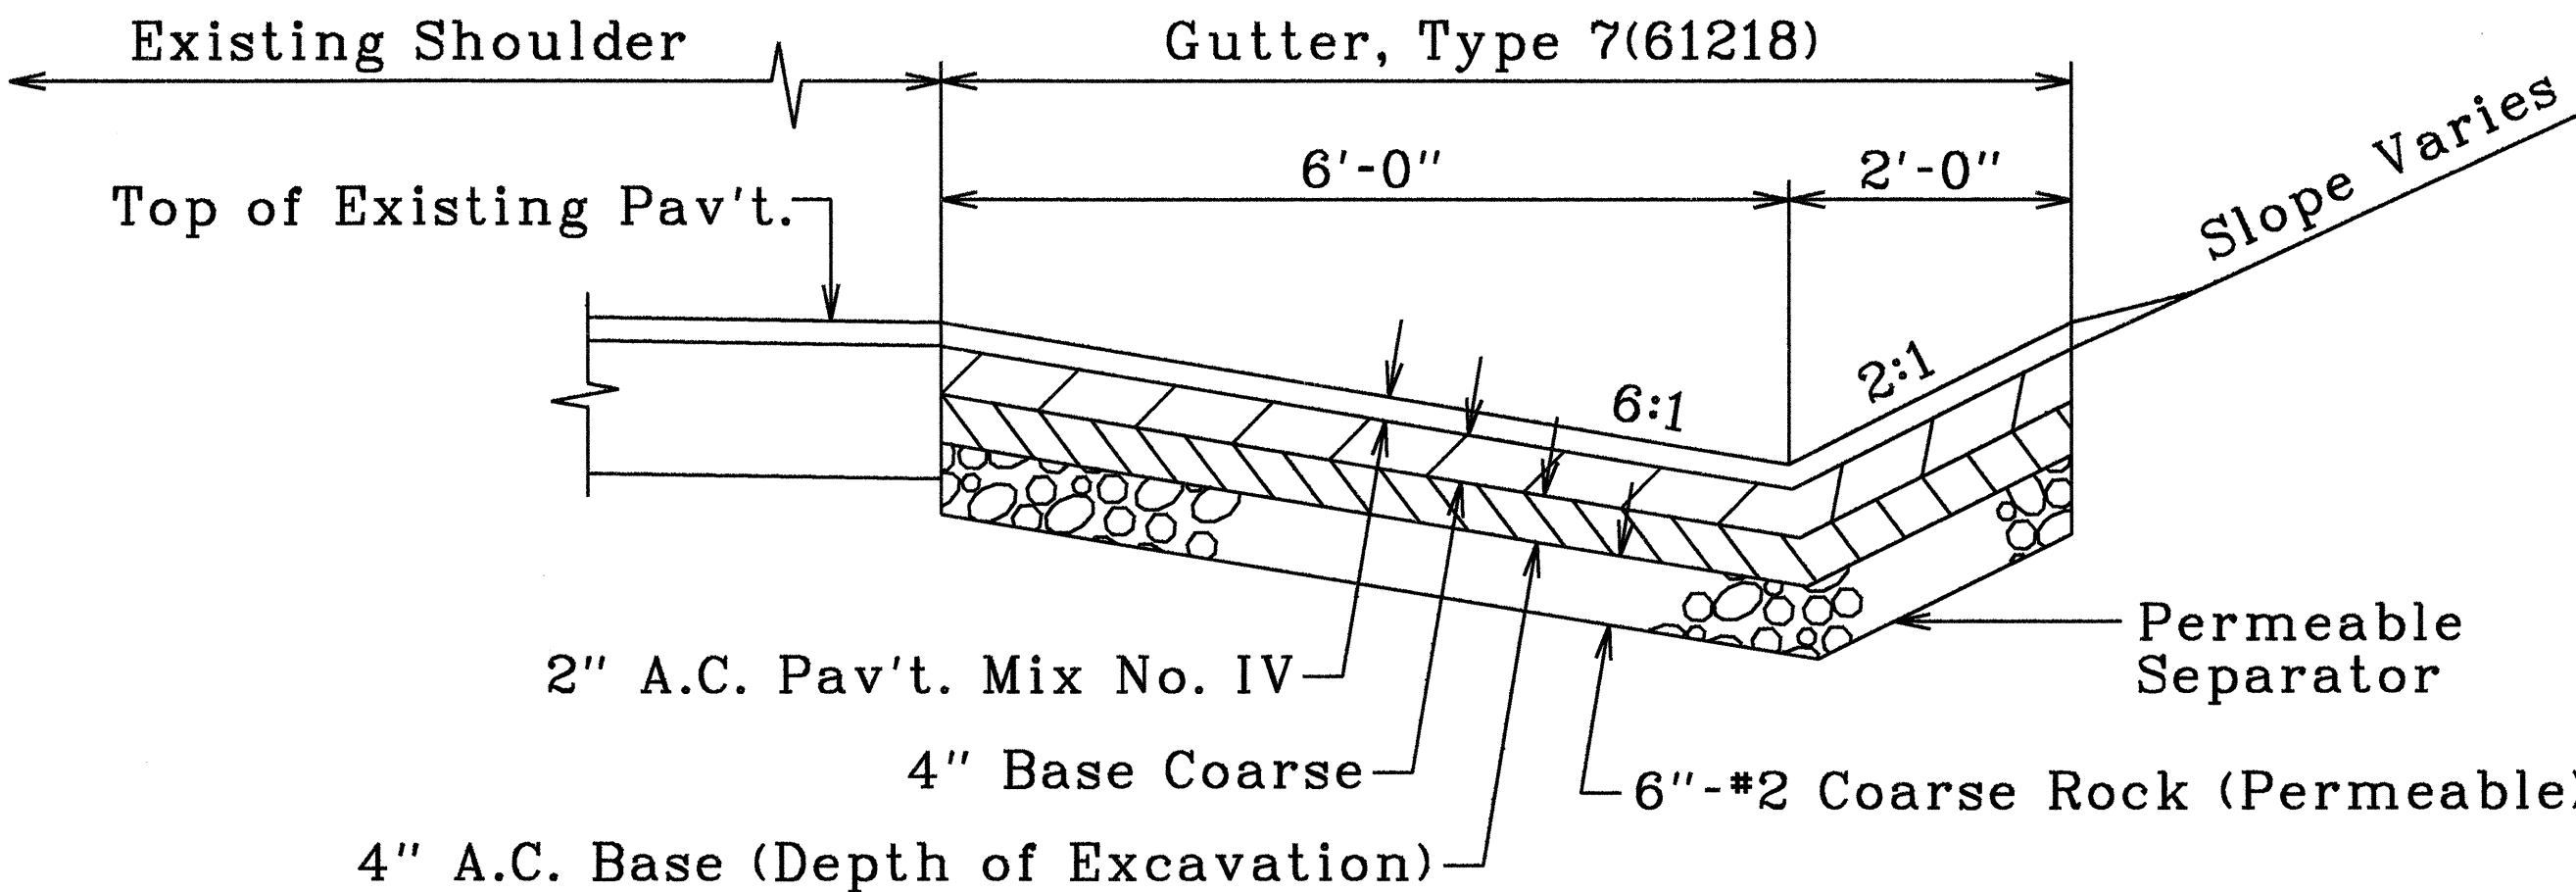

TRUE NORTH
SCALE : 1" = 40'

GUTTER, TYPE 7(61218) DETAIL
STA. 138+16 RT. TO # STA. 140+30 RT.
SCALE: 3/4" = 1'-0"

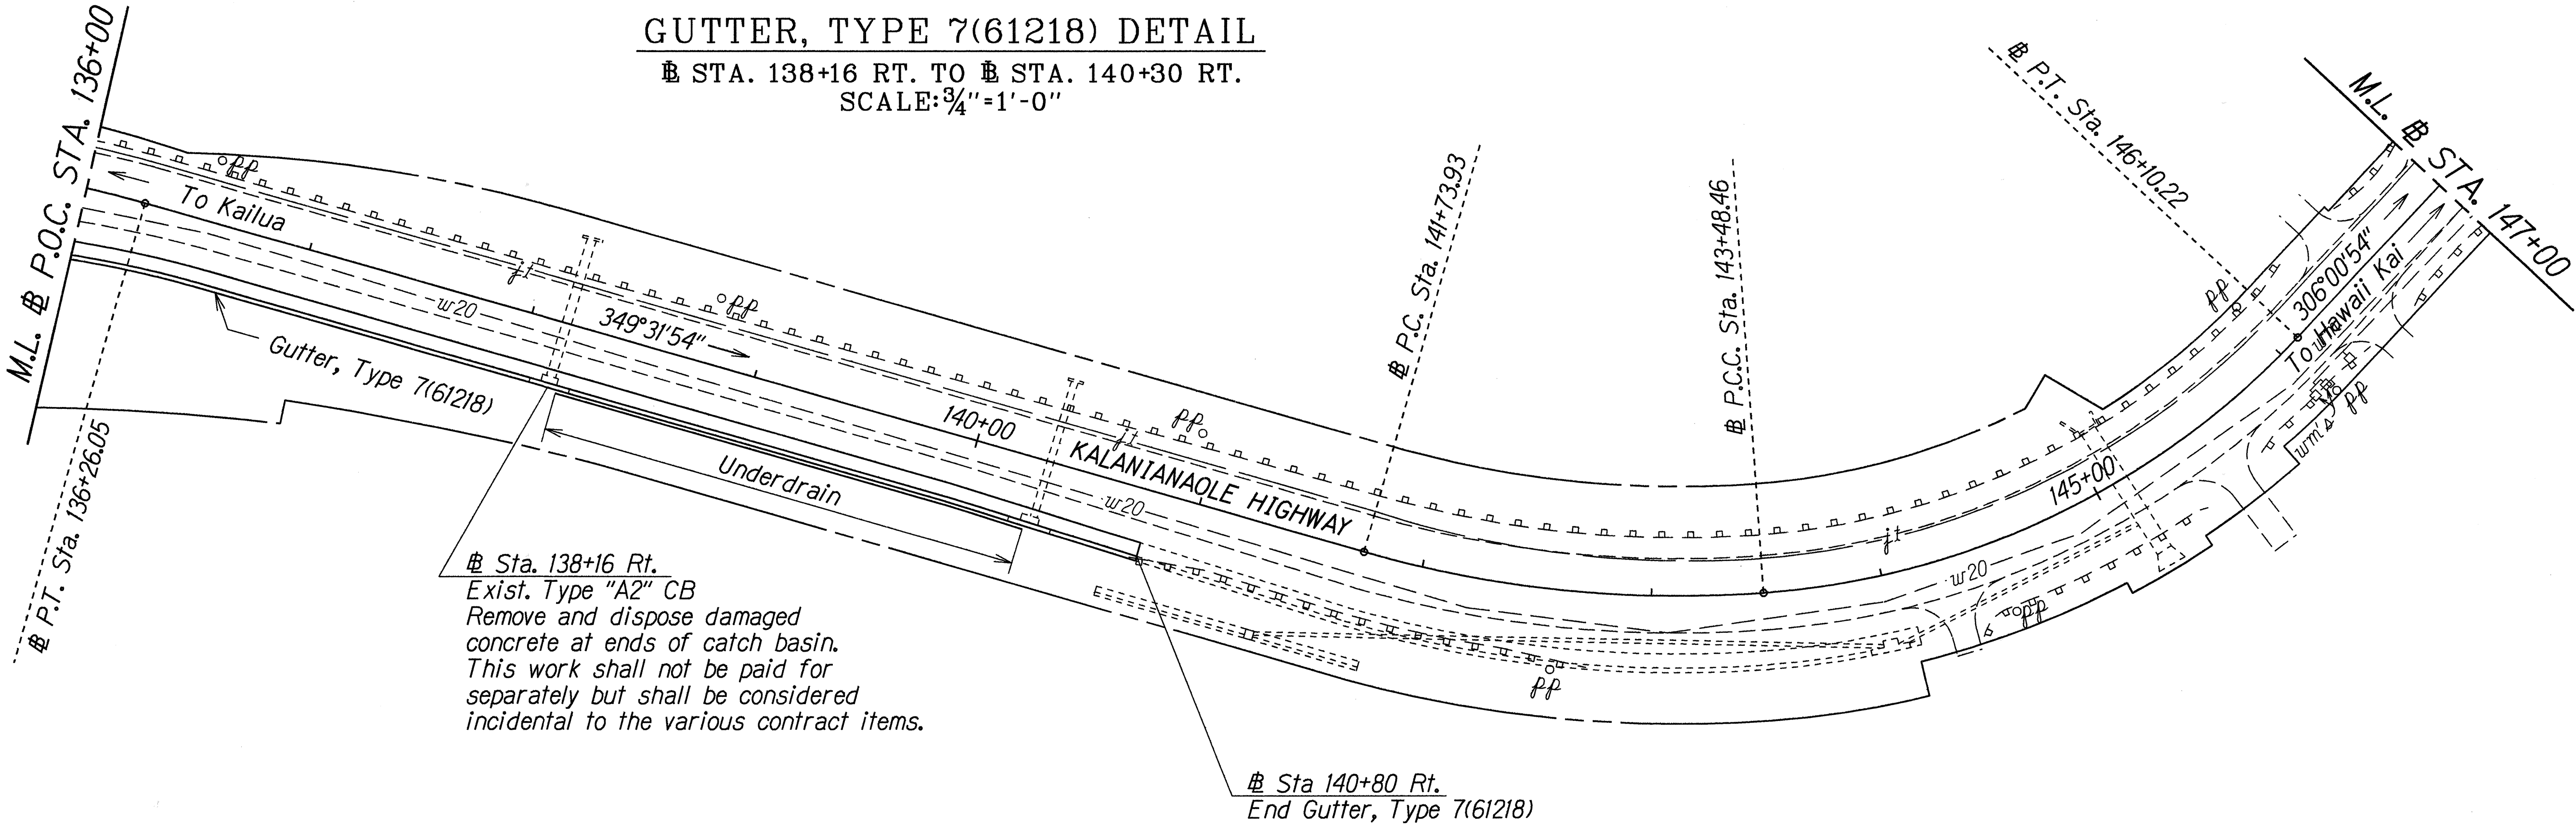

Sta. 136+00 Rt. to # Sta. 140+80 Rt.
Construct: Gutter, Type 7(61218)
Estimated Quantities
Gutter, Type 7(61218) = 480 L.F.


Sta. 138+19 Rt. to # Sta. 140+29 Rt.
Install: Underdrain
(For Details see Sht. No. H12J & H12P)
Estimated Quantities
Underdrain = 210 L.F.
6-Inch Perforated Underdrain Pipe = 210 L.F.
6-Inch Nonperforated Underdrain Pipe = 4 L.F.

LEGEND FOR AS-BUILT POSTINGS	
	Squiggly line for as-built deletion
	Double line for as-built deletion
Roadway	Text for as-built posting


2/20/97	Underdrain added.
6/14/96	Notes added to clarify plans.
DATE	REVISION
STATE OF HAWAII DEPARTMENT OF TRANSPORTATION HIGHWAYS DIVISION	
DRAINAGE PLAN	
KALANIANA'OLE HIGHWAY RESURFACING	
Kailua Rd. to Hilo St.	
Project No. 72A-01-96M	
Scale: 1"=40'	Date: May 1996
SHEET No. H12 OF 12 SHEETS	

ORIGINAL PLAN	DATE
DRAWN BY A. Mamiya & R. Sato	5/21/96
NOTE BOOK	
DESIGNED BY R. Sakamoto	
QUANTITIES BY	
CHECKED BY	

FED. ROAD DIST. NO.	STATE	PROJ. NO.	FISCAL YEAR	SHEET NO.	TOTAL SHEETS
HAWAII	HAW.	72A-01-96M	1996	ADD. 55S-1	55

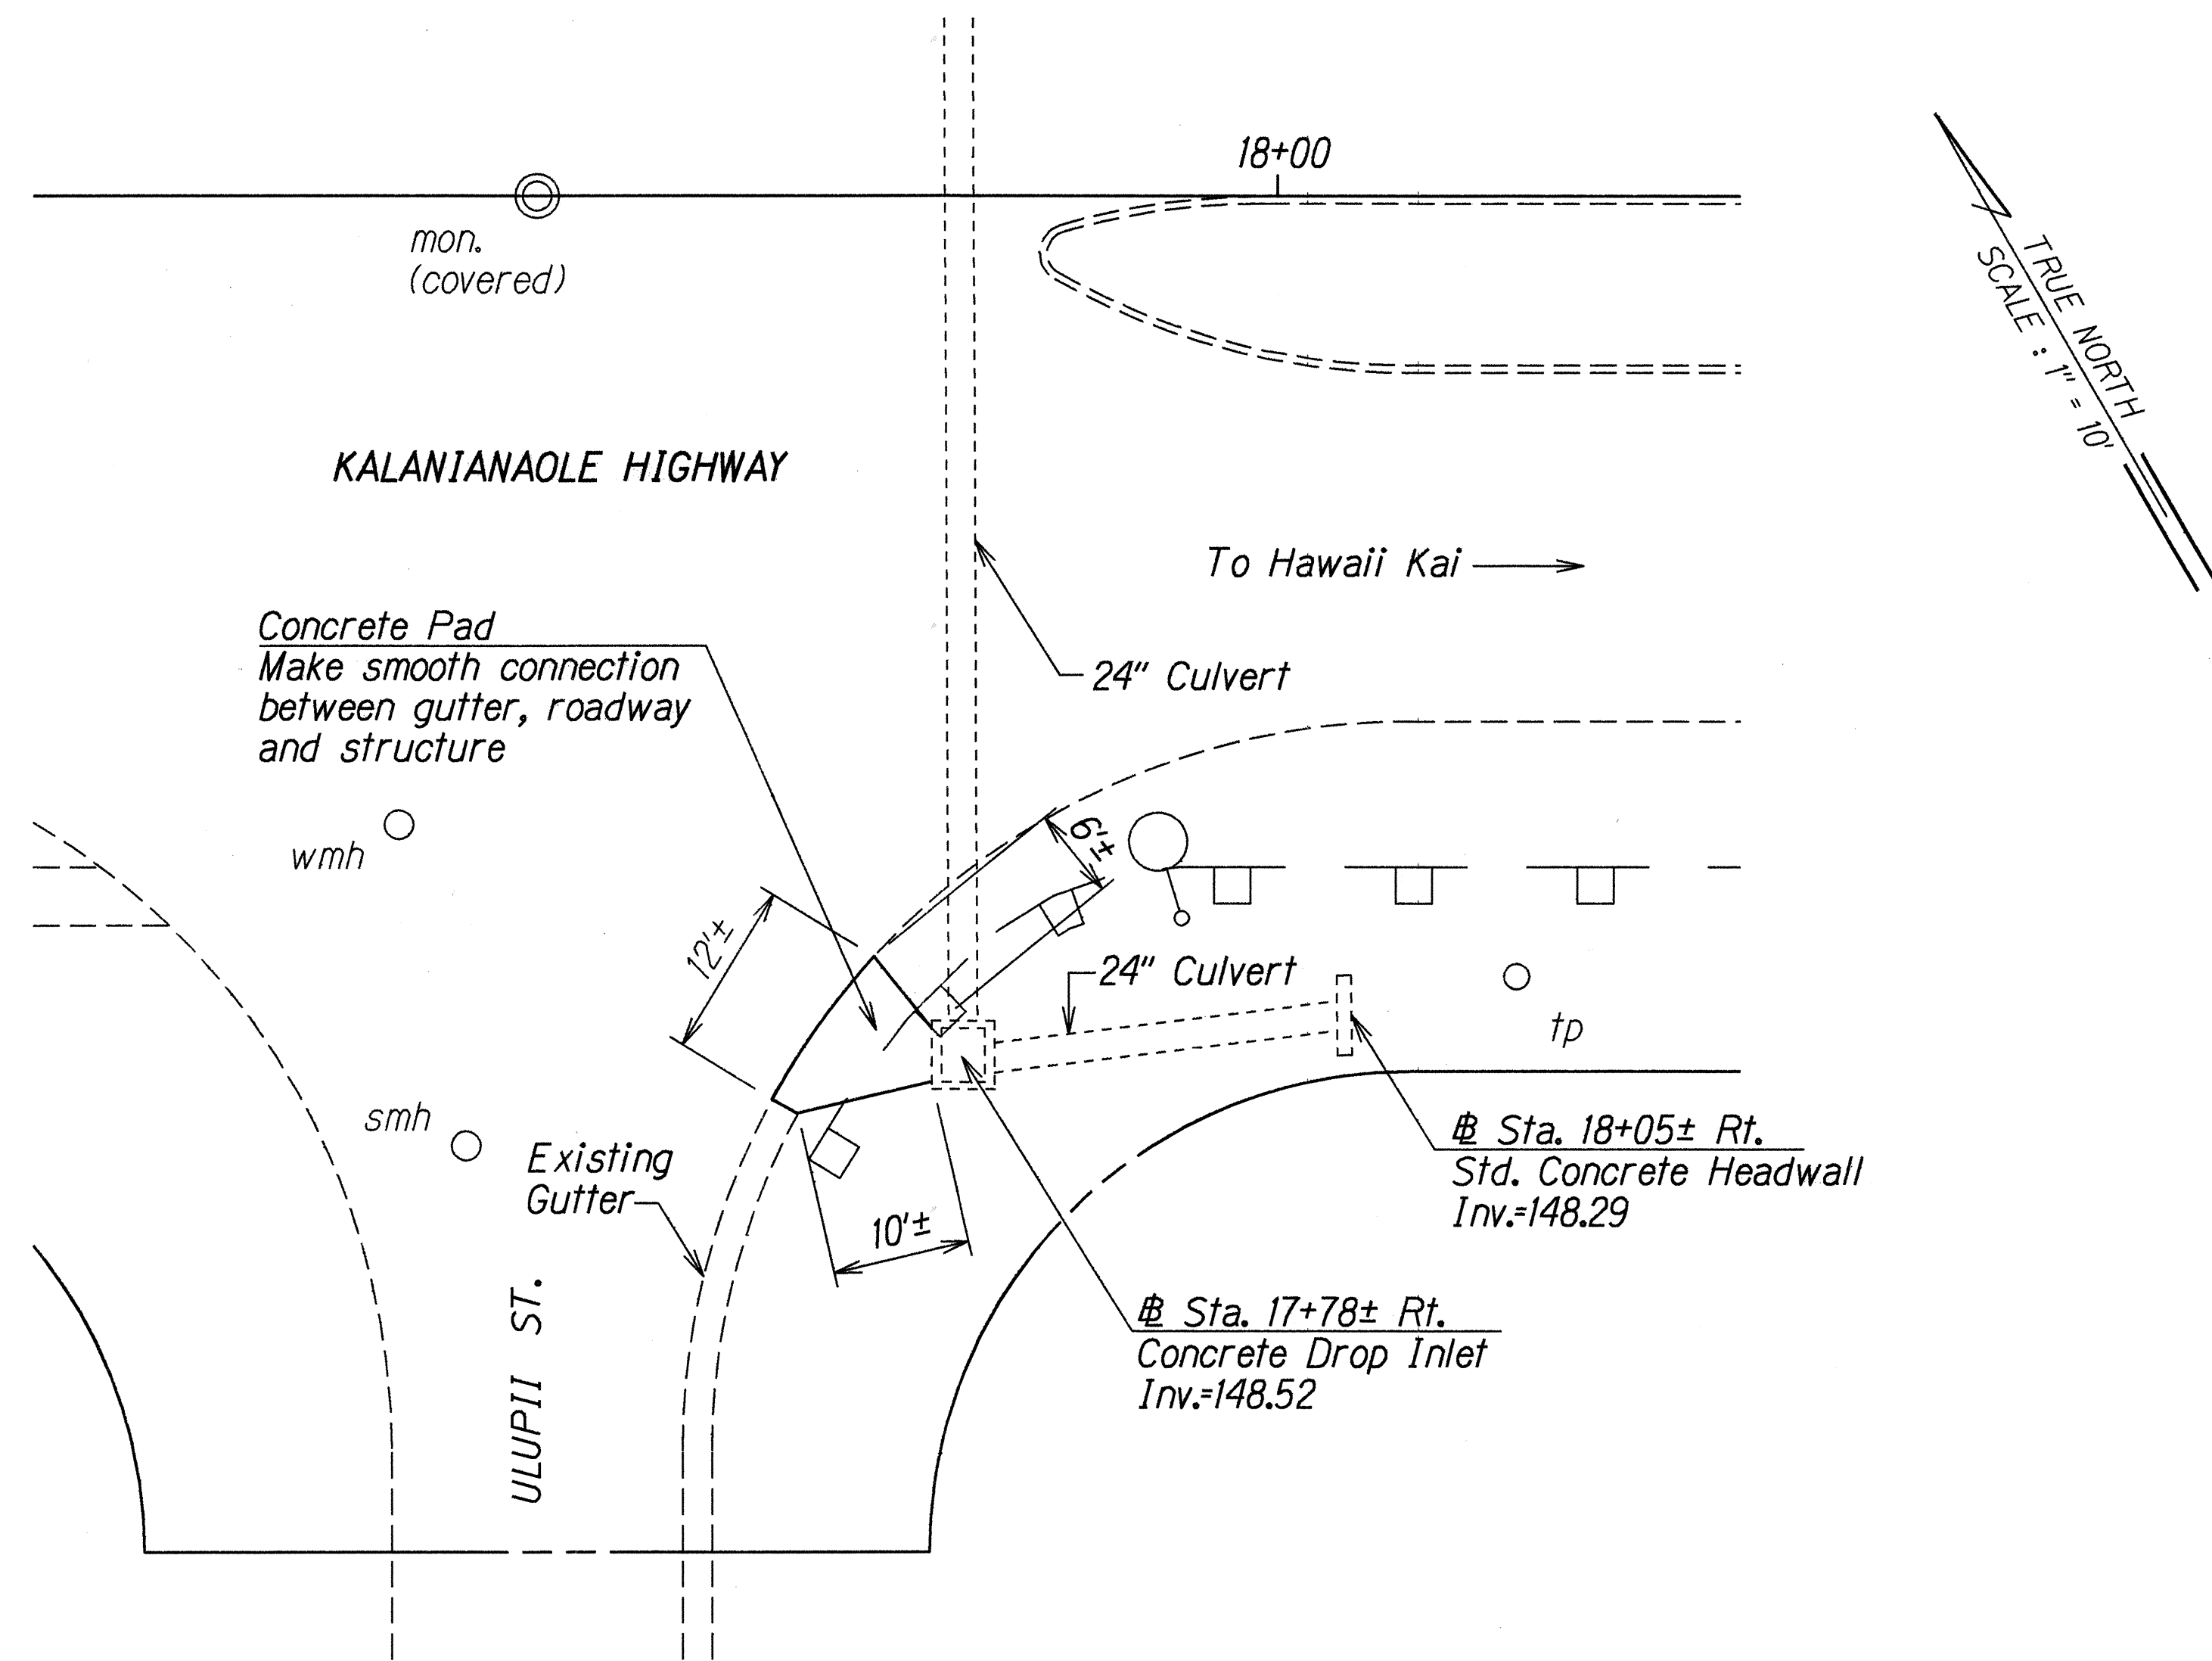

PLAN

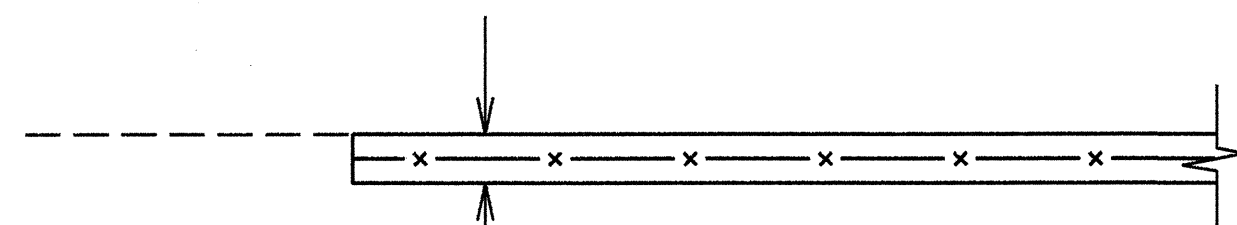

TYPICAL SECTION
Scale: 3/4"=1'-0"

CONCRETE PAD DETAIL AT $\pm$ STA. 17+78± RT.


DRAINAGE NOTES:

- Existing drainage systems will be functional at all times during construction. The Contractor is to furnish materials, equipment, labor, tools and incidentals necessary to accomplish maintenance of flow. The cost shall be incidental to the various Contract Items.
- The Contractor shall verify the locations of all existing culverts and utilities in the field. Any existing culverts and utilities damaged during construction shall be repaired or replaced by the Contractor at his own expense.
- Concrete shall be Class A unless otherwise noted.


SURVEY PLOTTED BY	DATE
DRAWN BY	
DESIGNED BY	
QUANTITIES BY	
CHECKED BY	
ORIGINAL PLAN	
NOTE: BOOK	
REVISIONS	
BY	
DATE	

9/13/96	Class B Concrete changed to Class A.
6/14/96	Details added to complete drainage plan.
DATE	REVISION
STATE OF HAWAII DEPARTMENT OF TRANSPORTATION HIGHWAYS DIVISION	
DRAINAGE DETAILS	
KALANIANAʻOLE HIGHWAY RESURFACING	
Kailua Rd. to Hilo St.	
Project No. 72A-01-96M	
Scale: As Noted	Date: June, 1996
SHEET No. H12A OF 12 SHEETS	


FED. ROAD DIST. NO.	STATE	PROJ. NO.	FISCAL YEAR	SHEET NO.	TOTAL SHEETS
HAWAII	HAW.	72A-01-96M	1996	ADD. 55S-3	55

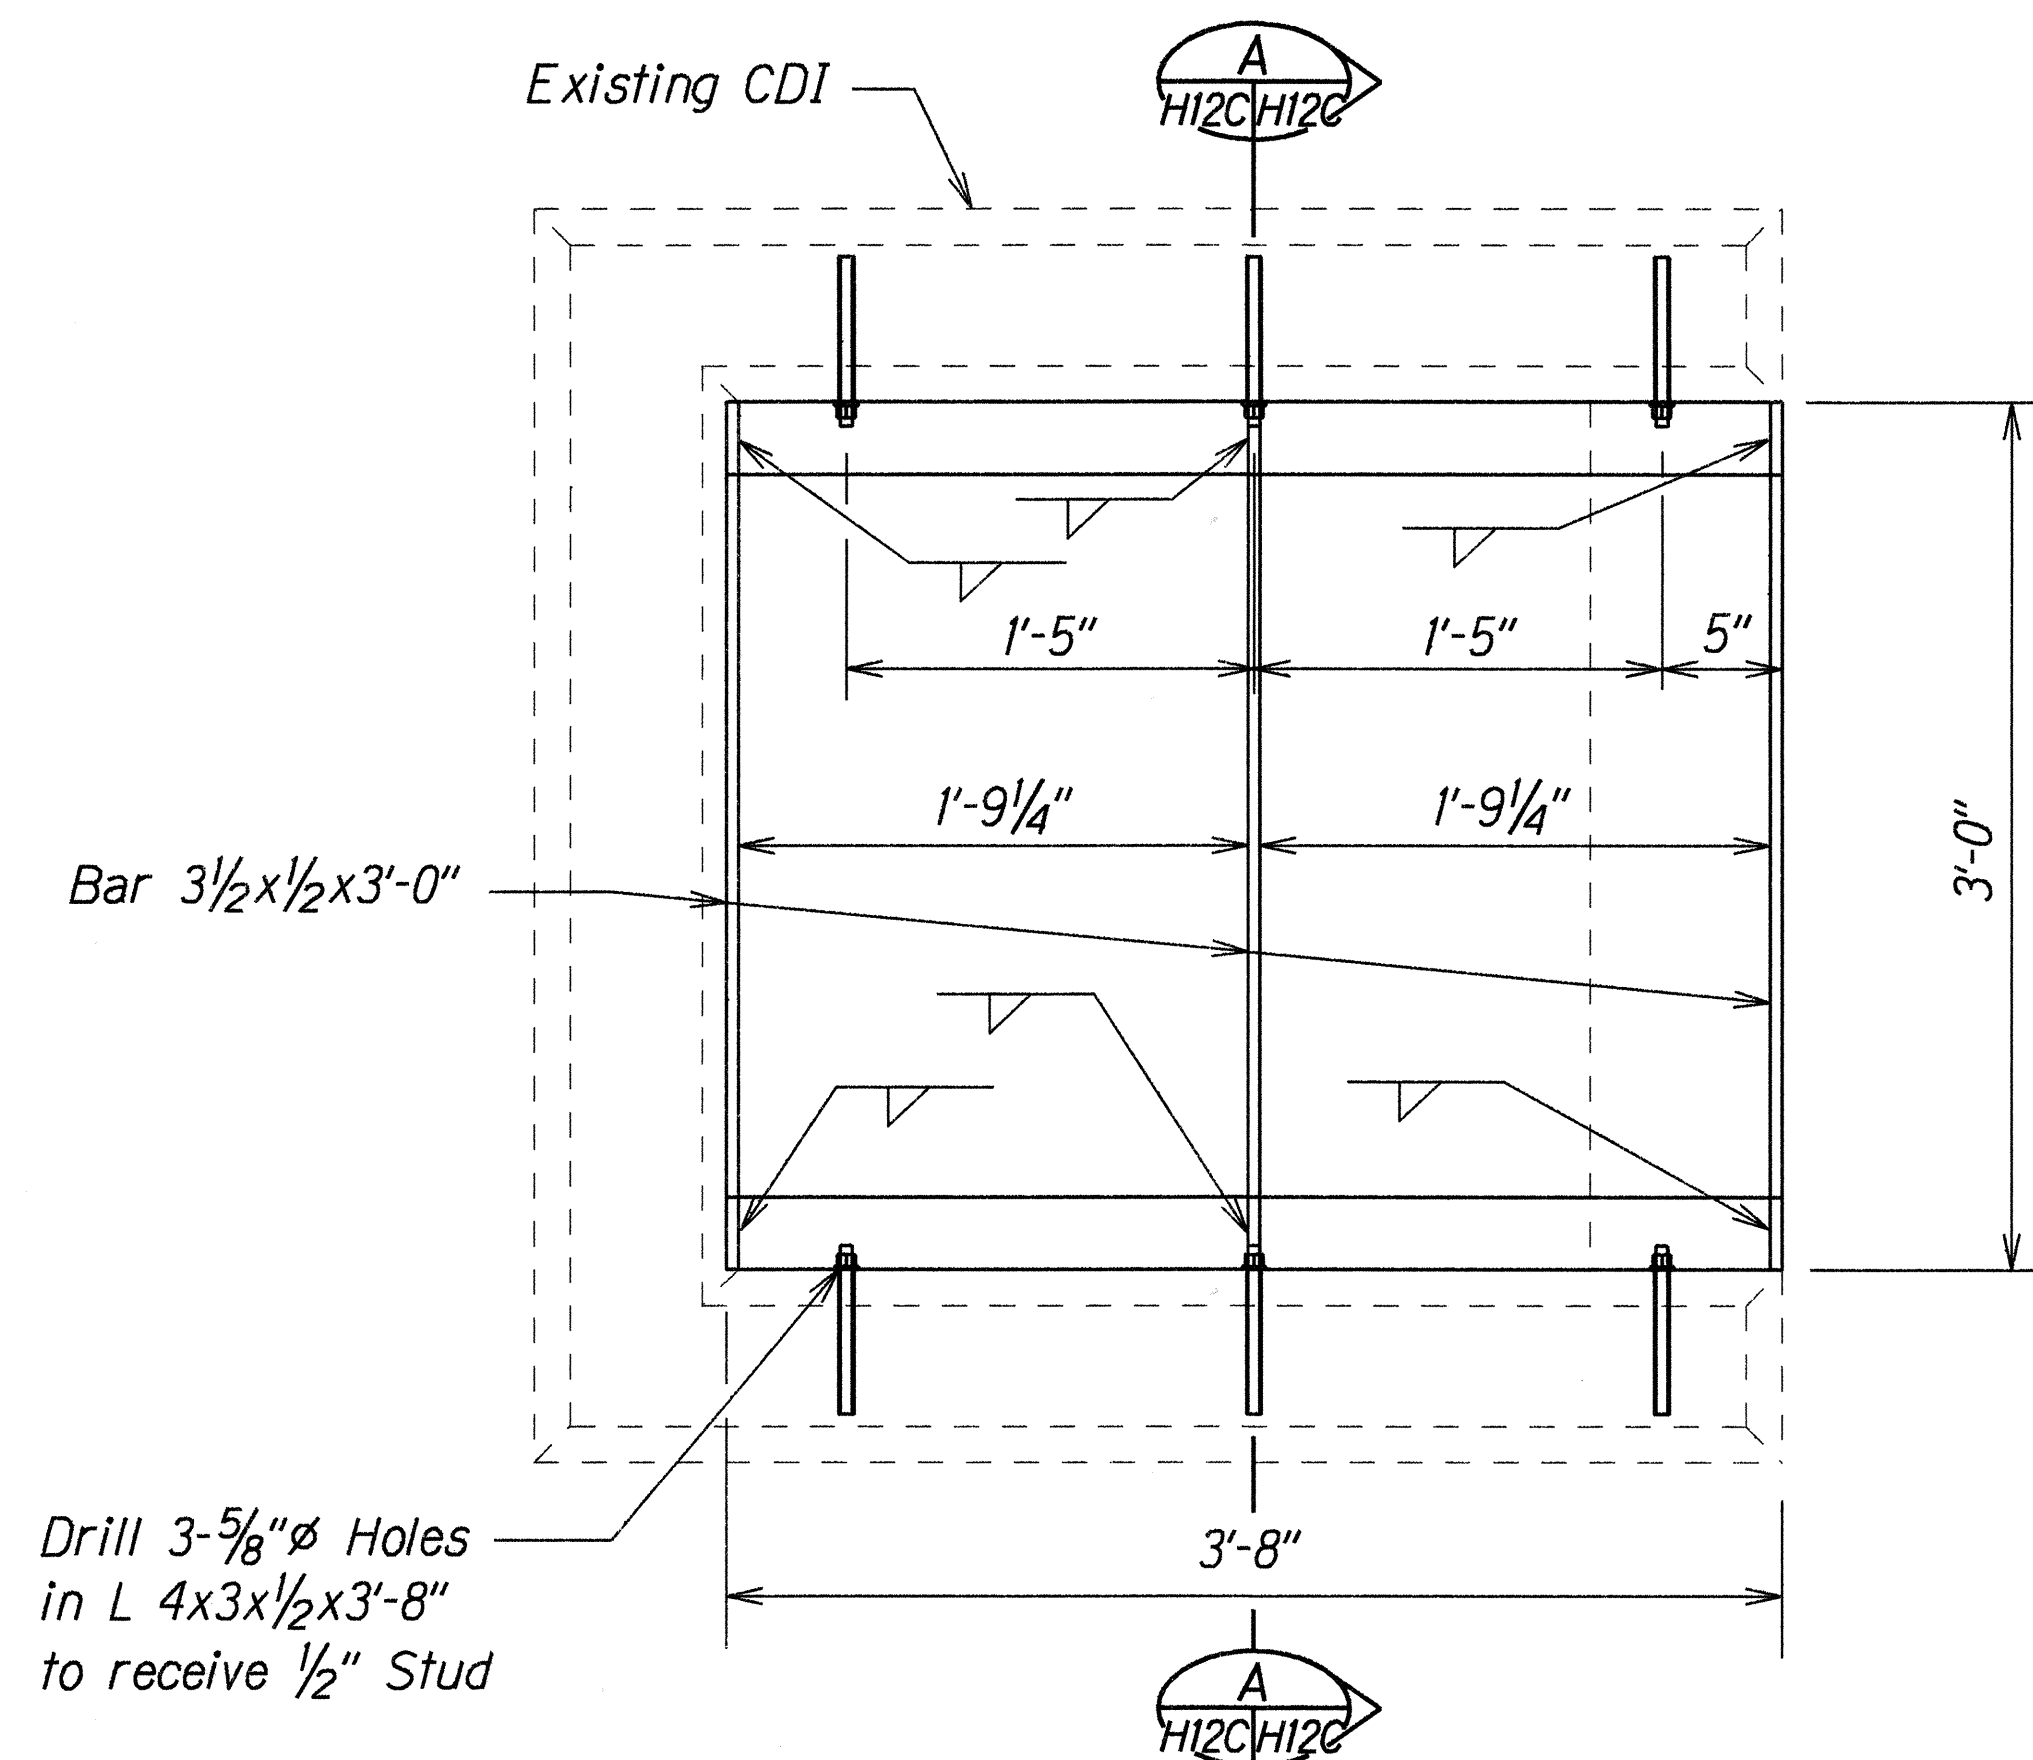

PLAN

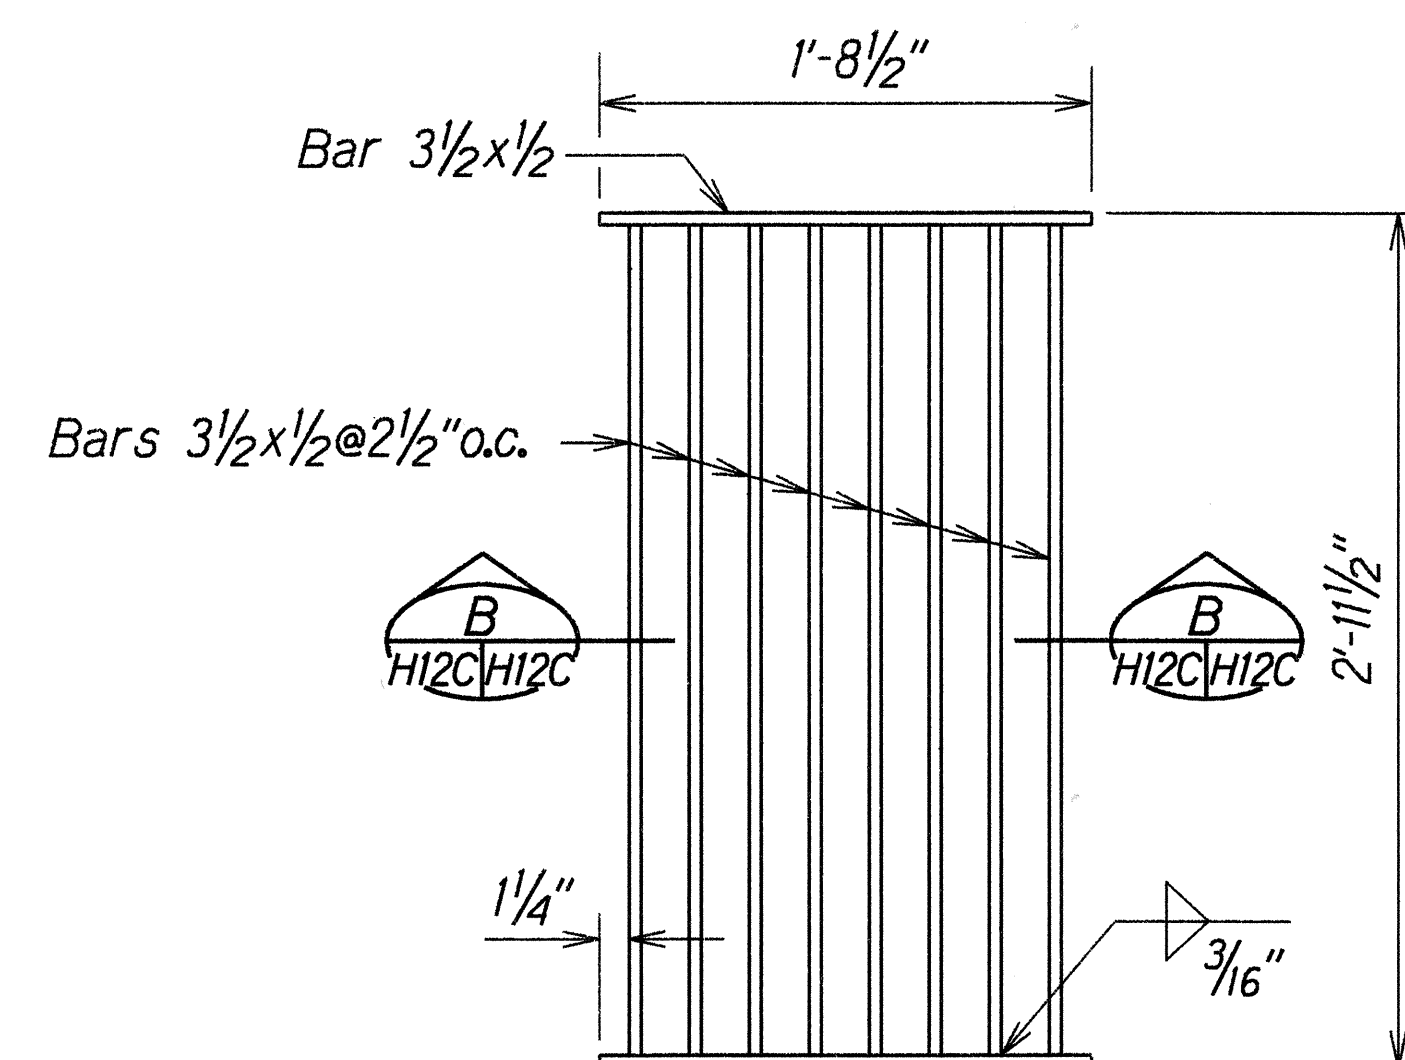


PLAN

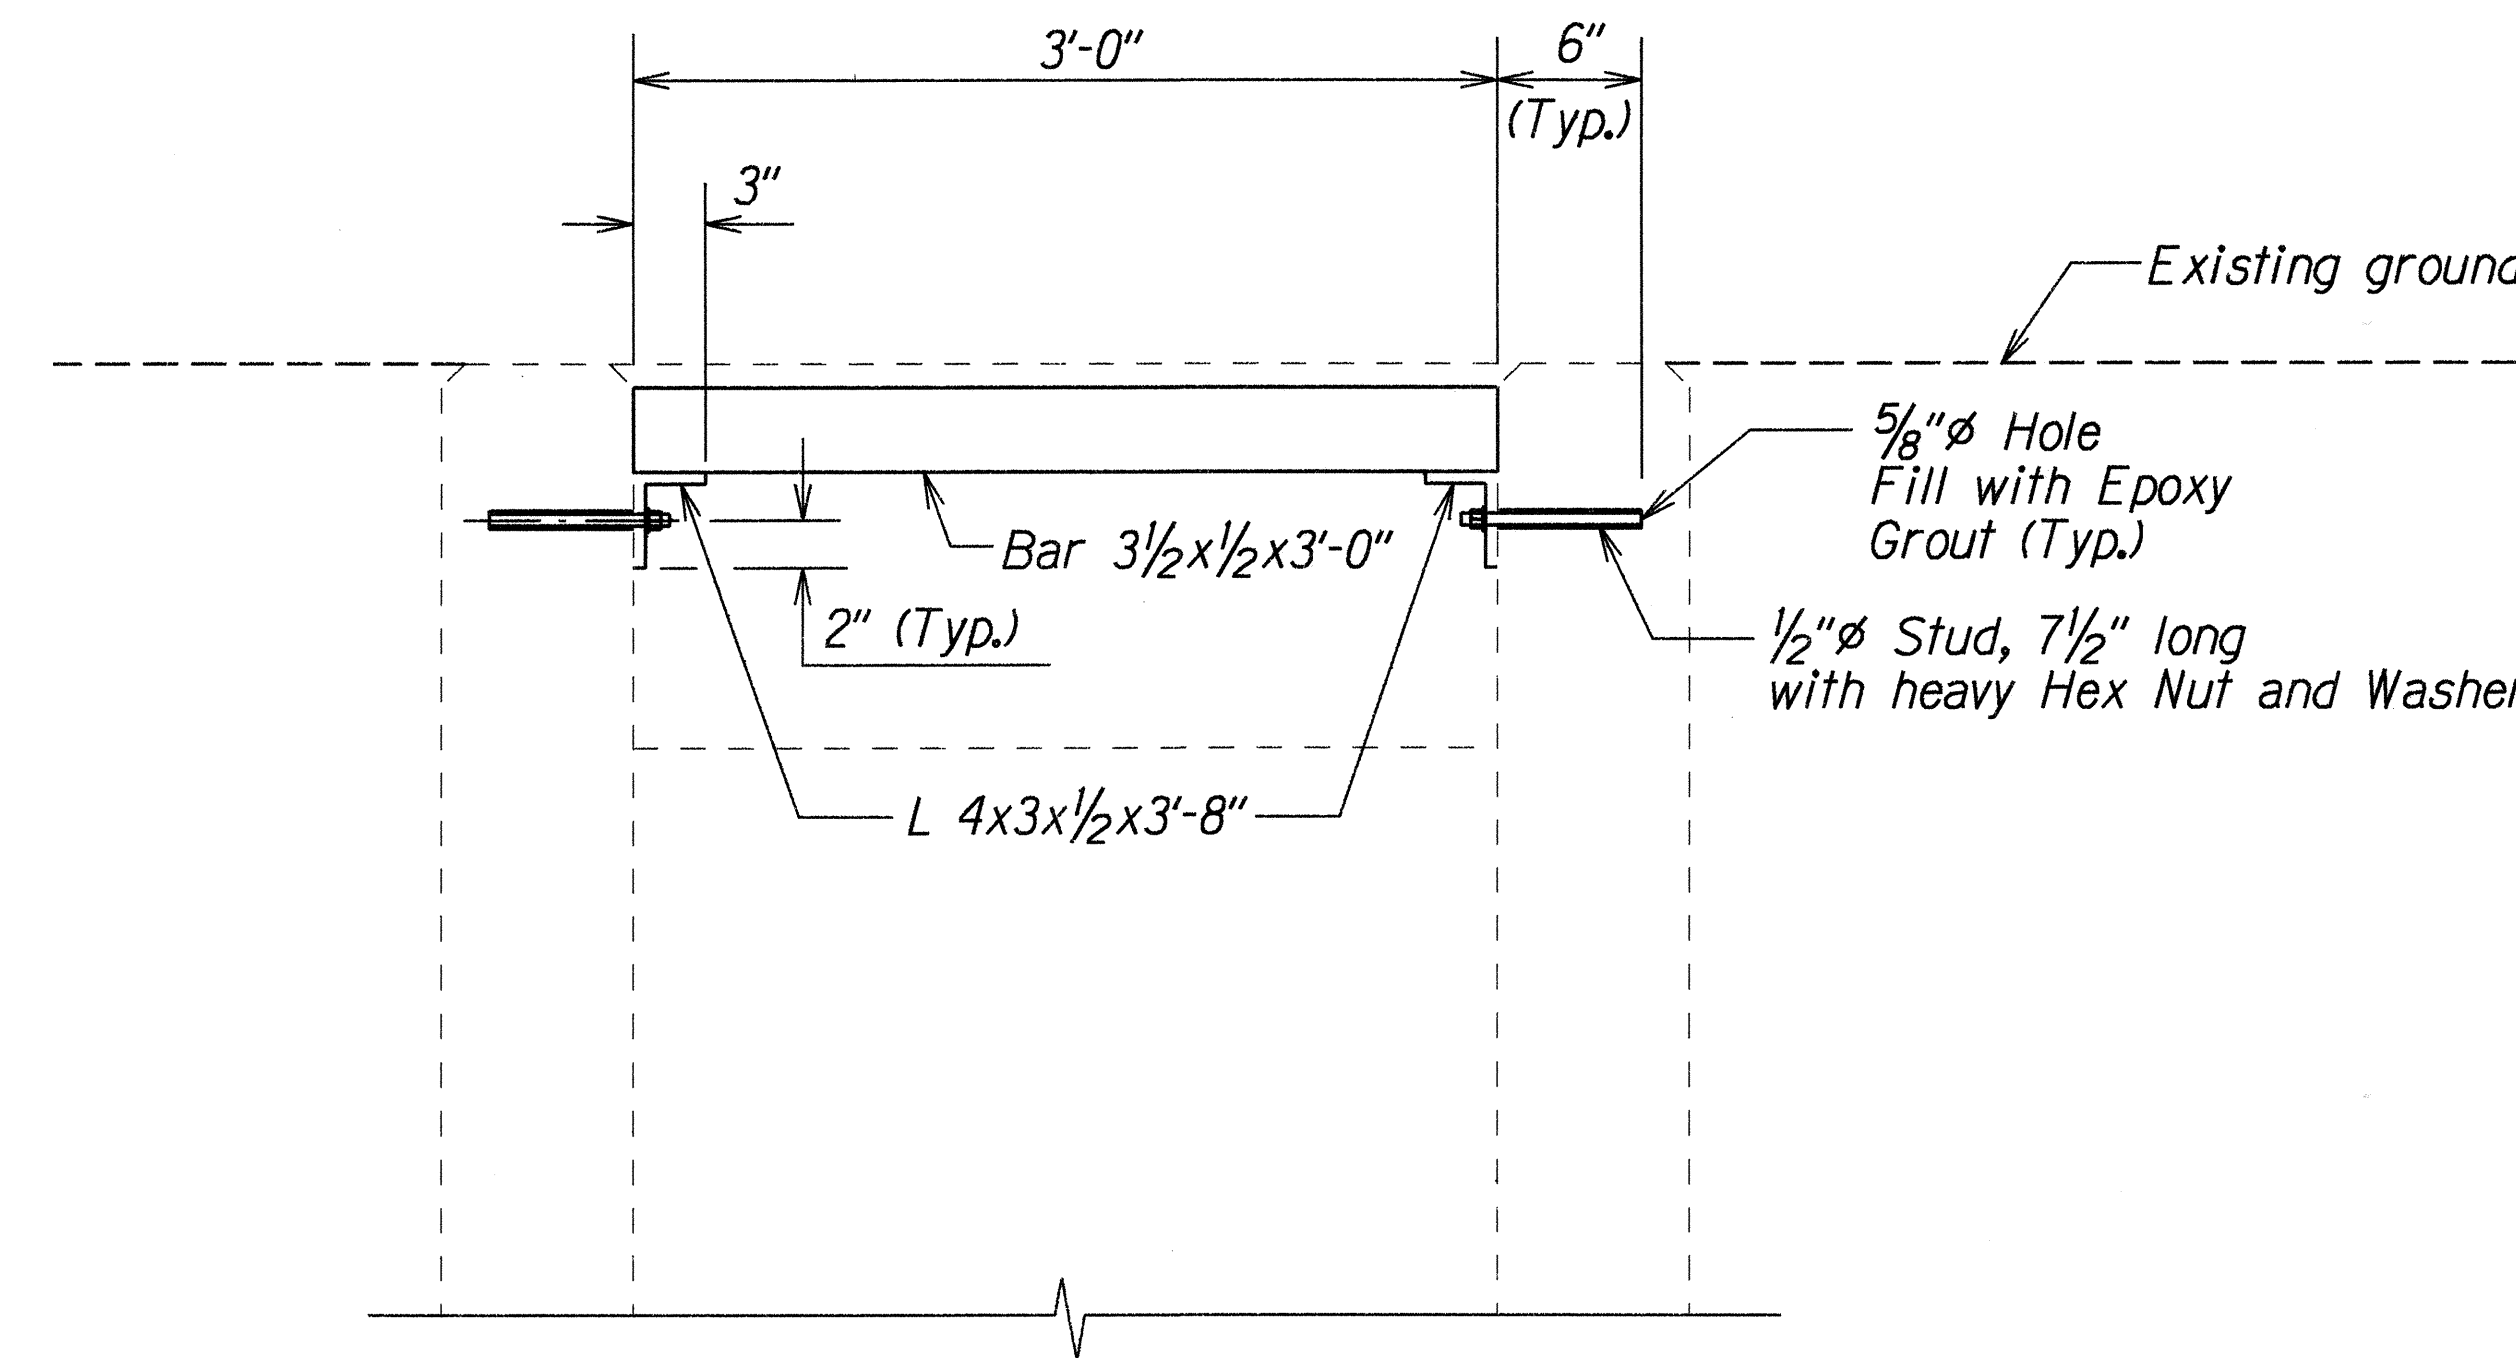

SECTION A
HI2C/HI2C

NOTES

- Only non-pneumatic type of drill as approved by the Engineer will be permitted for drilling holes in concrete. The approximate diameter of drilled holes for installation of studs shall be 5/8 inches. After installing studs the voids shall be filled with epoxy grout as directed by the Engineer. Above work shall be considered incidental to the various contract items.
- Frames and grates shall be hot dip galvanized after fabrication.
- All welds 5/16" unless otherwise noted.

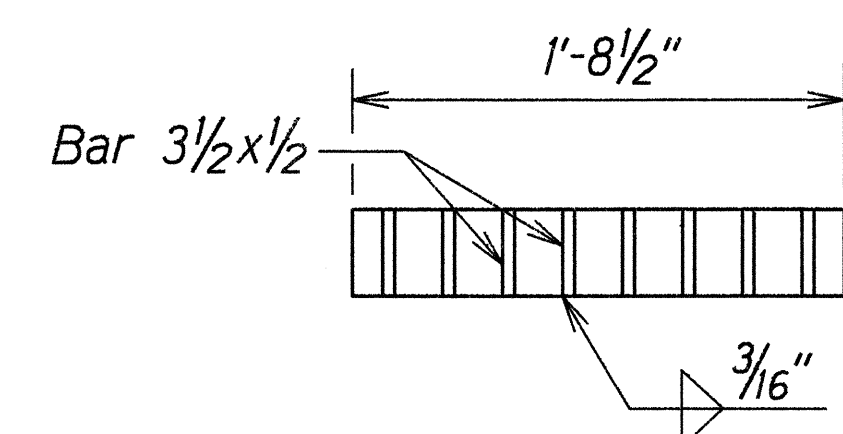

SECTION B
HI2C/HI2C

TYPE A-8 STEEL GRATE DETAILS

CONCRETE DROP INLET AT STA. 32+71± LT.

SURVEY PLOTTED BY	DATE
DRAWN BY A. Nishida	5/27/96
DESIGNED BY A. Salas	
QUANTITIES BY	
CHECKED BY	

6/14/96 Details added to complete drainage plan.

DATE REVISION

STATE OF HAWAII
DEPARTMENT OF TRANSPORTATION
HIGHWAYS DIVISION

DRAINAGE DETAILS

KALANIANA'OLE HIGHWAY RESURFACING

Kailua Rd. to Hilo St.

Project No. 72A-01-96M



Scale: 1 1/2"=1'-0"

Date: May 1996


SHEET No. HI2C OF 12 SHEETS

ADD. 55S-3

FED. ROAD DIST. NO.	STATE	PROJ. NO.	FISCAL YEAR	SHEET NO.	TOTAL SHEETS
HAWAII	HAW.	72A-01-96M	1996	ADD. 55S-4	55

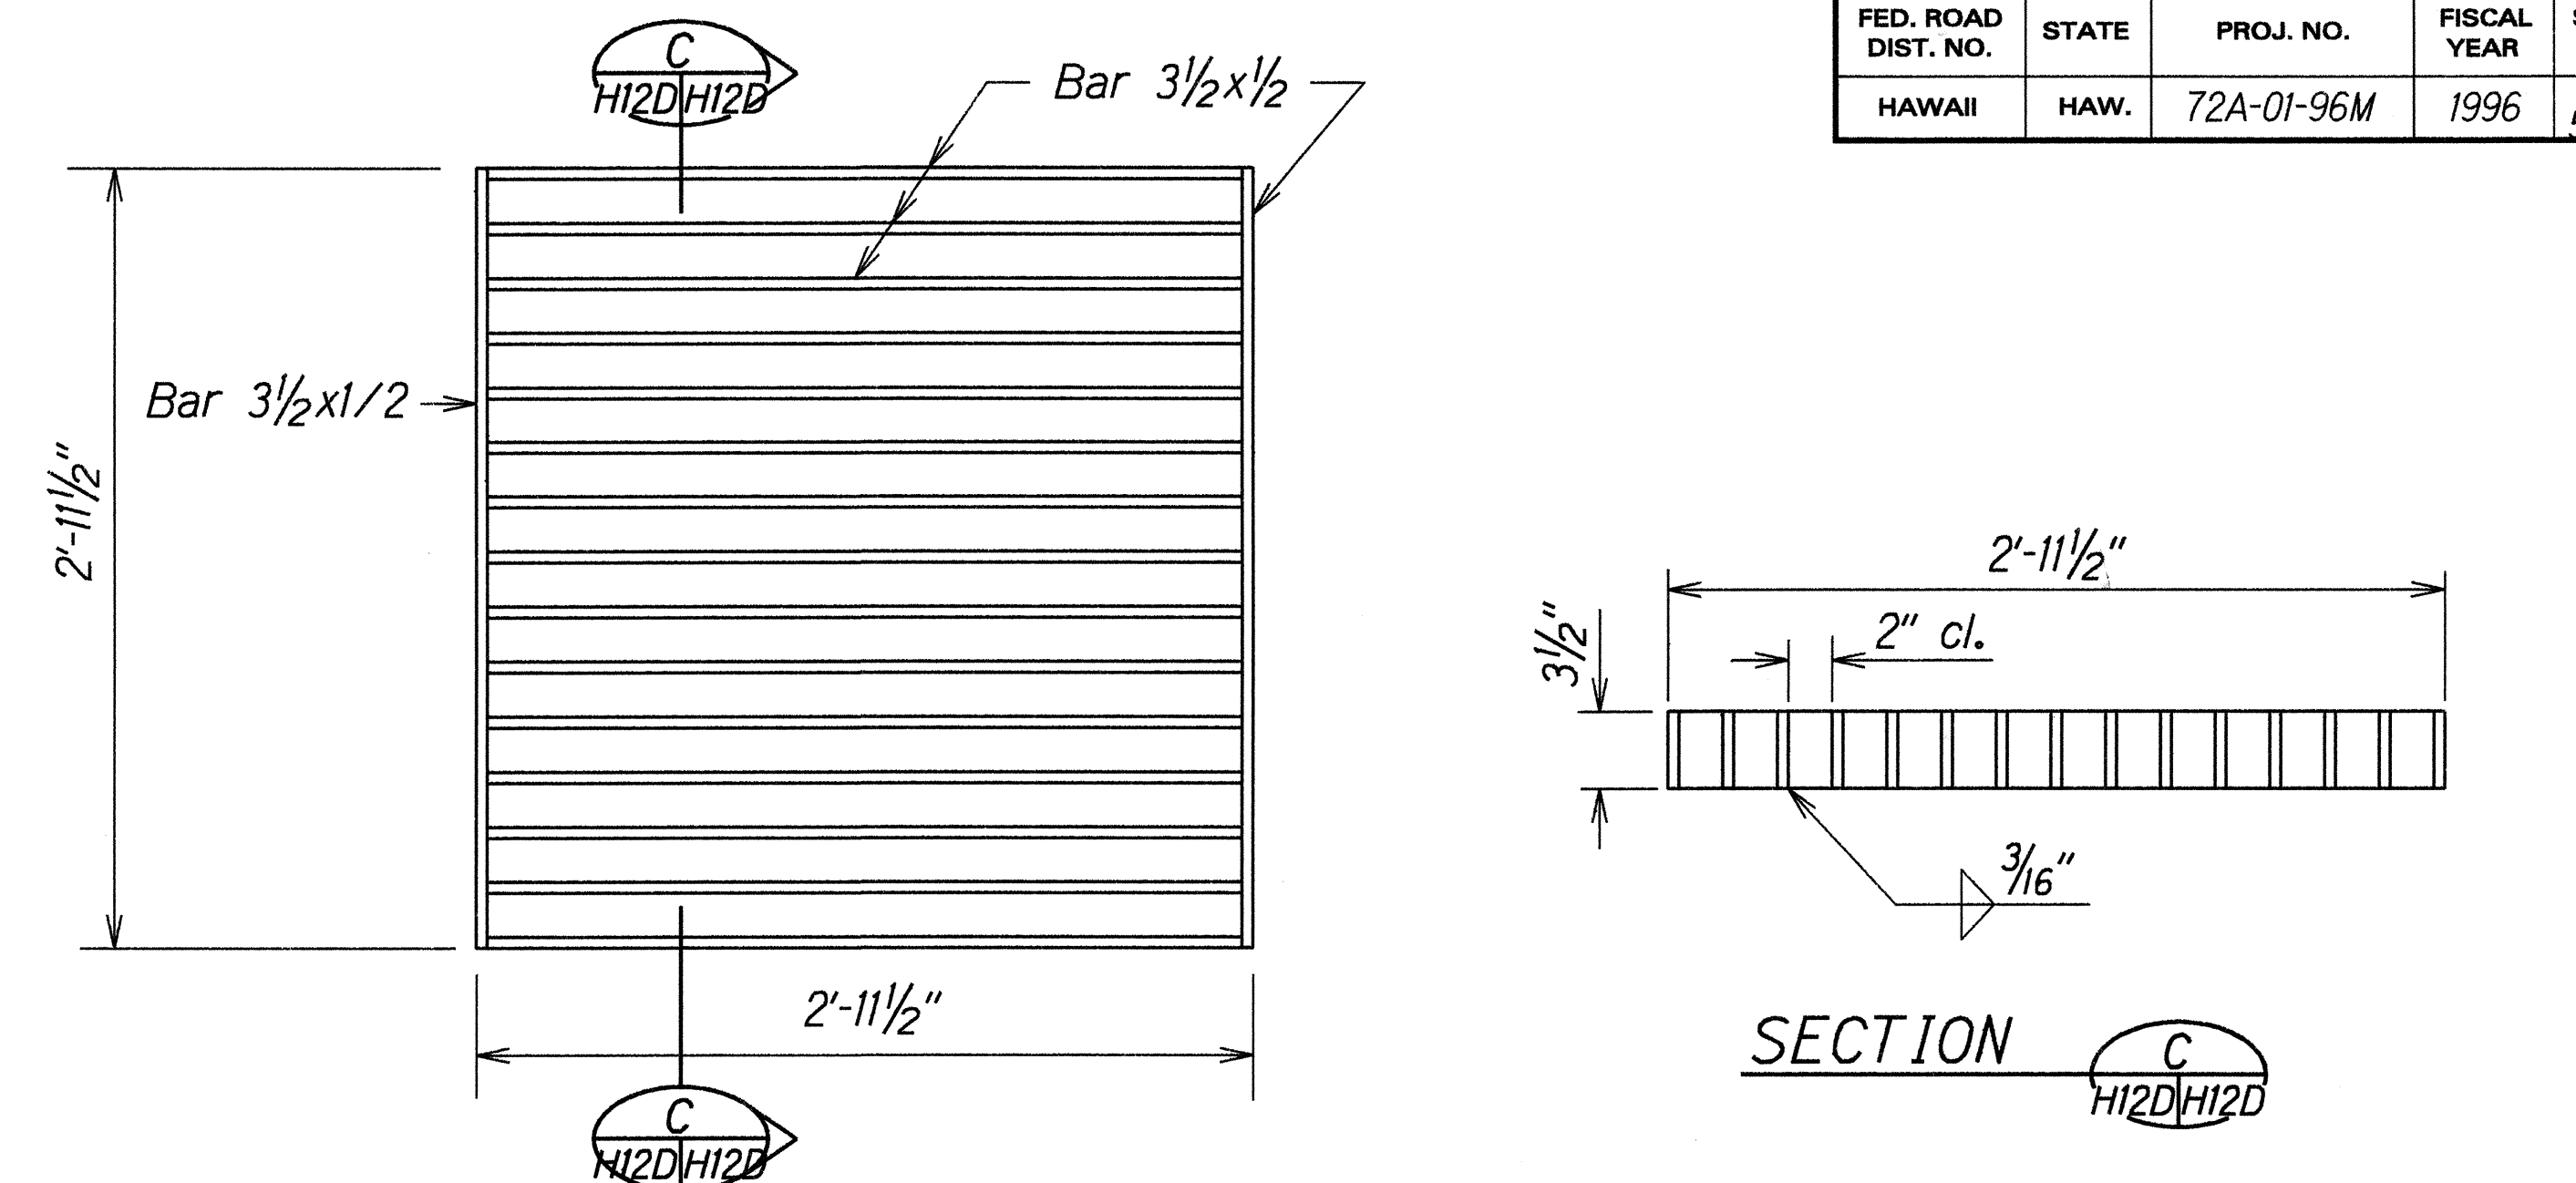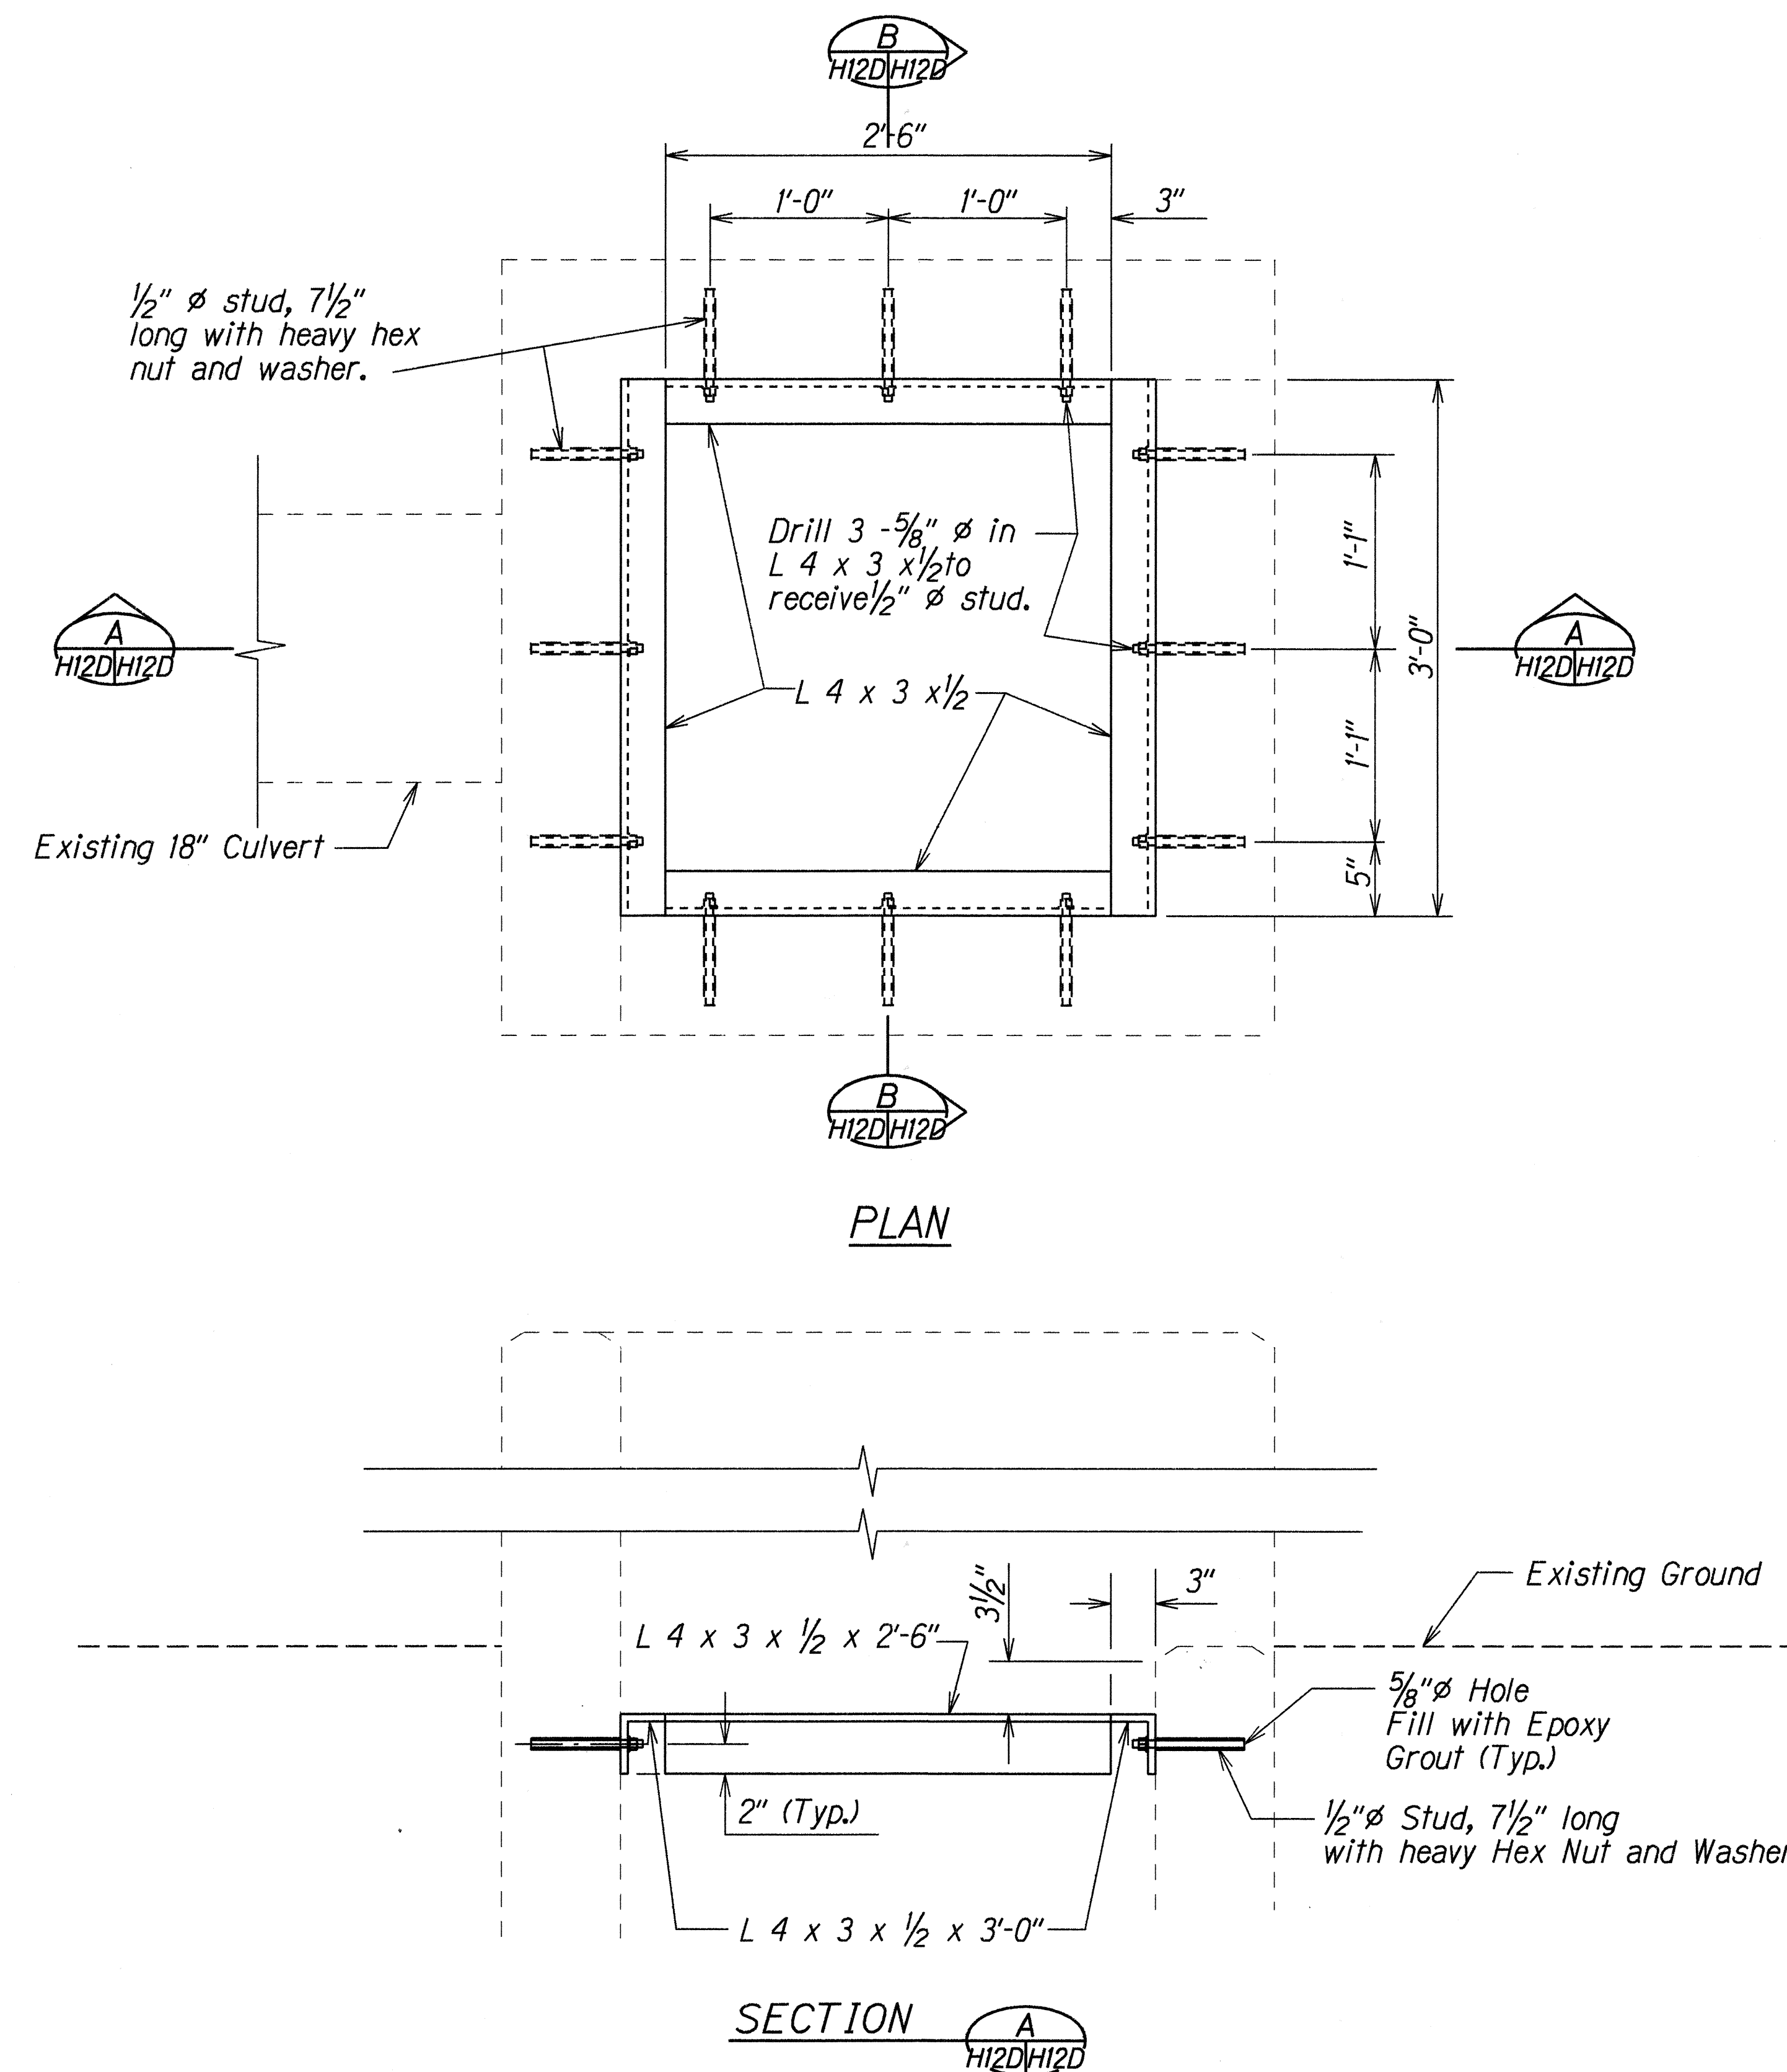

PLAN
TYPE A-15 STEEL GRATE DETAIL

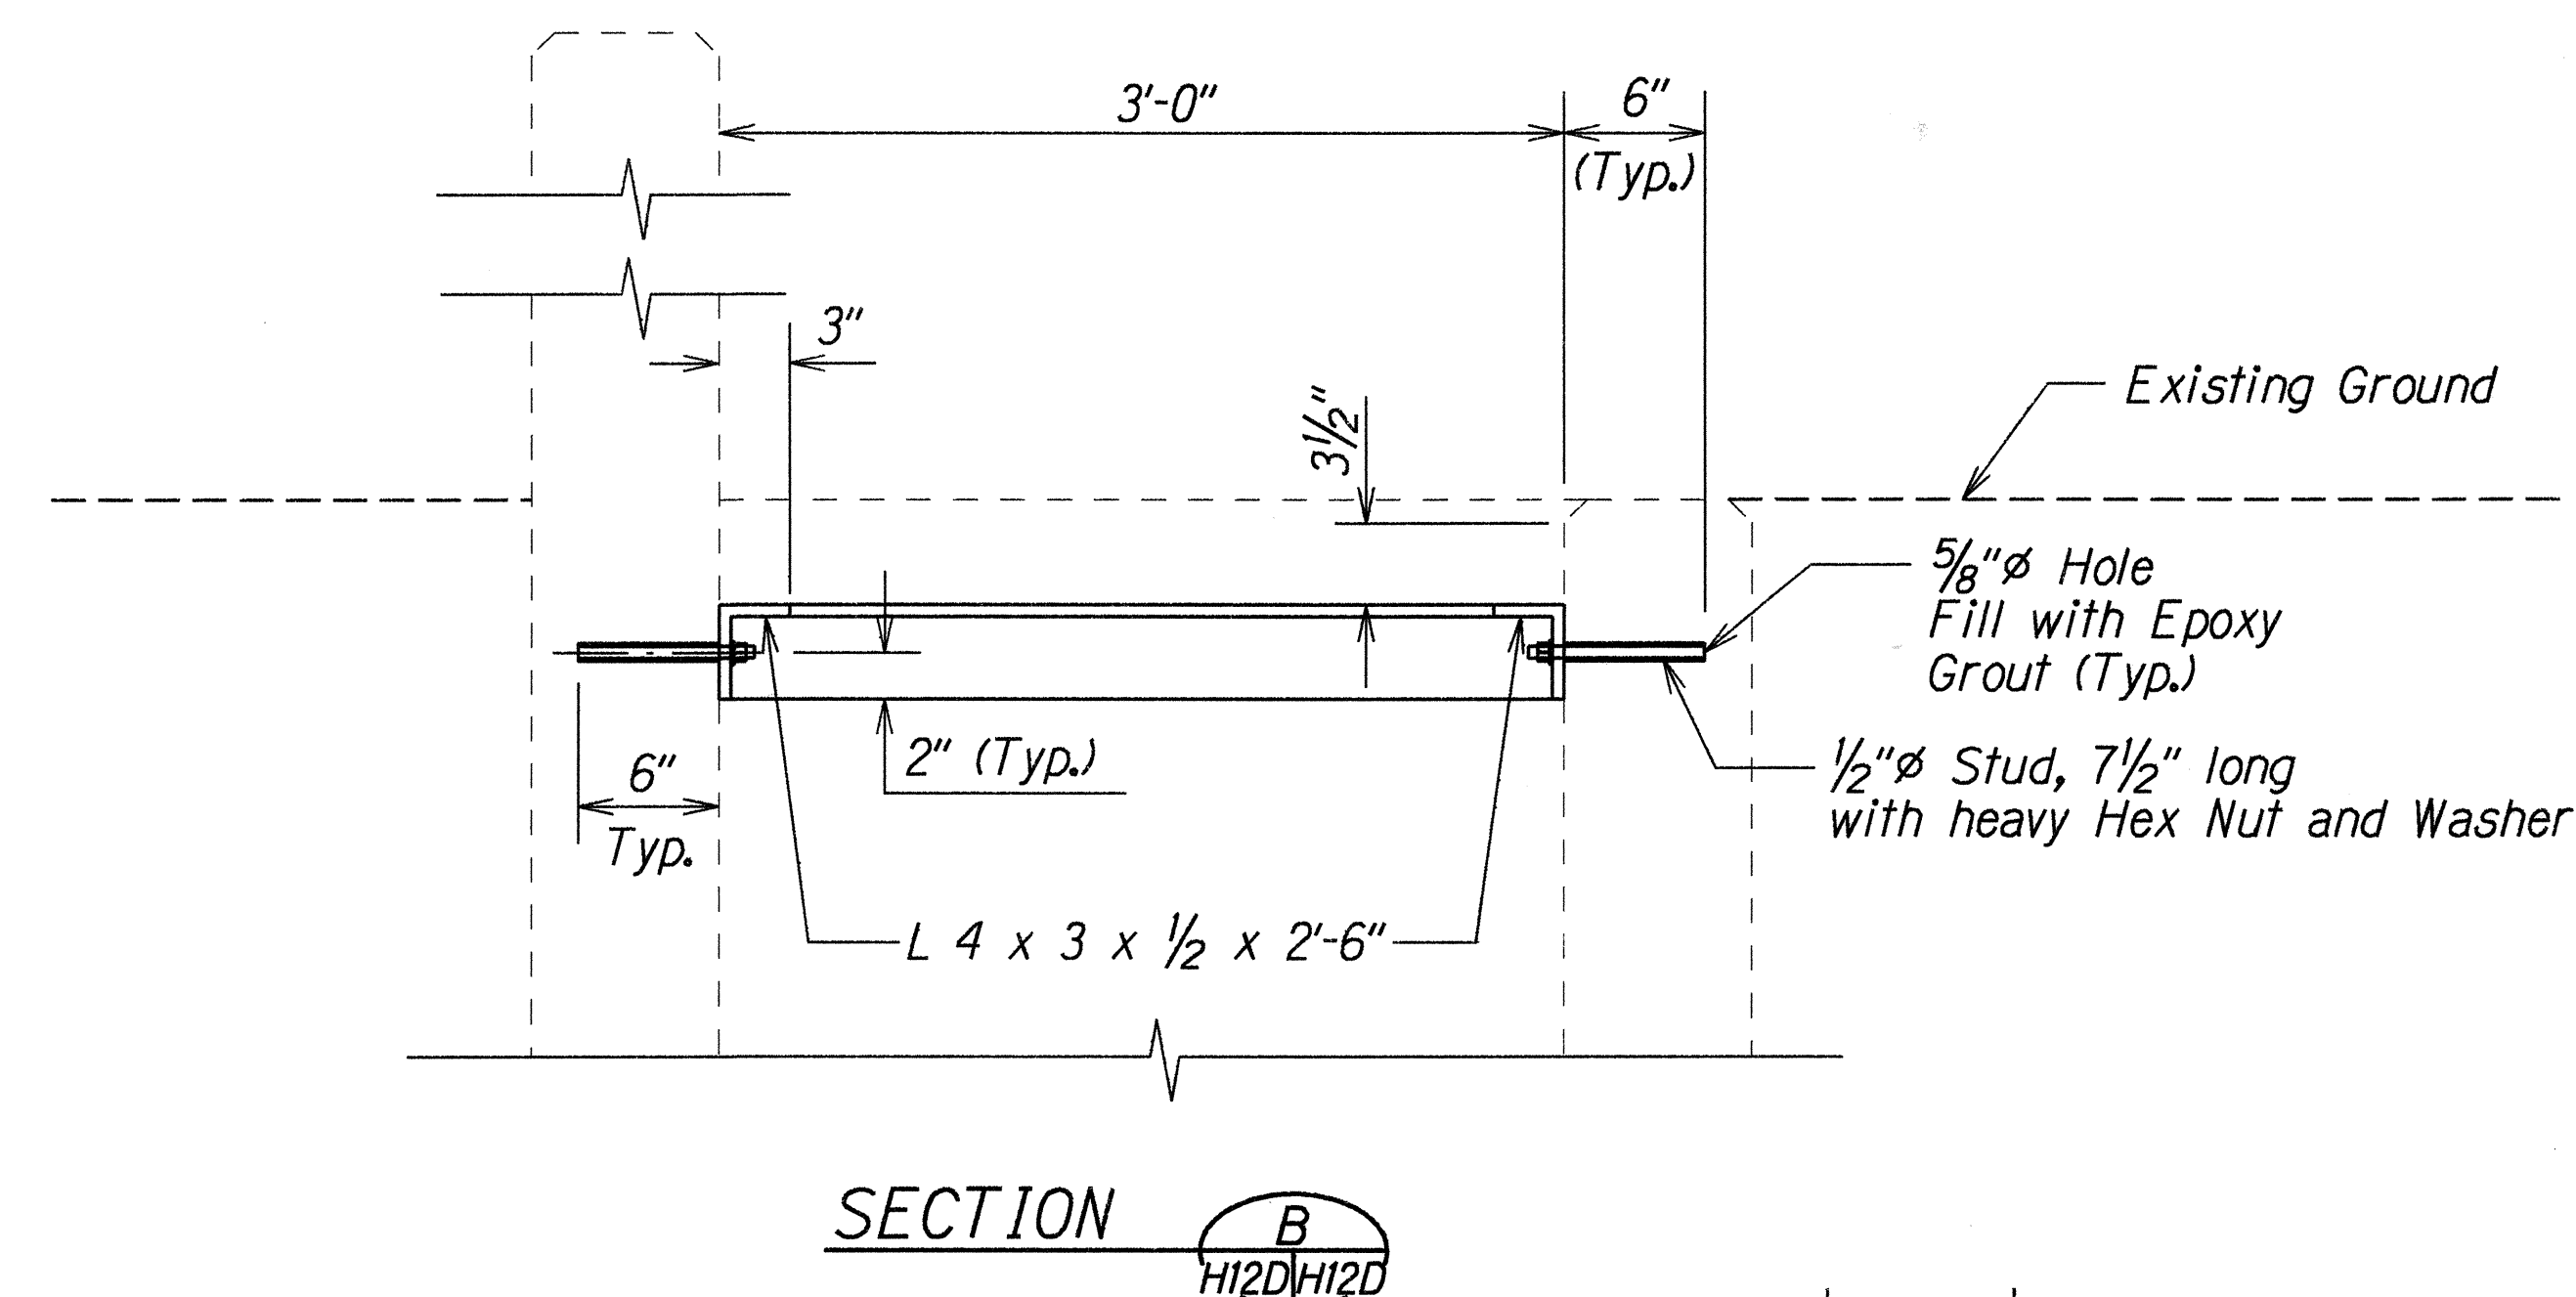

NOTES



- Only non-pneumatic type of drill as approved by the Engineer will be permitted for drilling holes in concrete. The approximate diameter of drilled holes for installation of studs shall be 5/8 inches. After installing studs the voids shall be filled with epoxy grout as directed by the Engineer. Above work shall be considered incidental to the various contract items.
- Frames and grates shall be hot dip galvanized after fabrication.

DETAILS OF A-15 FRAME & GRATE IN CDI AT STA. 35+10 LT.


6/14/96	Details added to complete drainage plan.
DATE	REVISION
STATE OF HAWAII DEPARTMENT OF TRANSPORTATION HIGHWAYS DIVISION	
DRAINAGE DETAILS	
KALANIANA'OLE HIGHWAY RESURFACING Kailua Rd. to Hilu St. Project No. 72A-01-96M	
Scale: 1 1/2"=1'-0"	Date: June, 1996
SHEET No. H12D OF 12 SHEETS	

ADD. 55S-4

FED. ROAD DIST. NO.	STATE	PROJ. NO.	FISCAL YEAR	SHEET NO.	TOTAL SHEETS
HAWAII	HAW.	72A-01-96M	1996	ADD. 55S-5	55

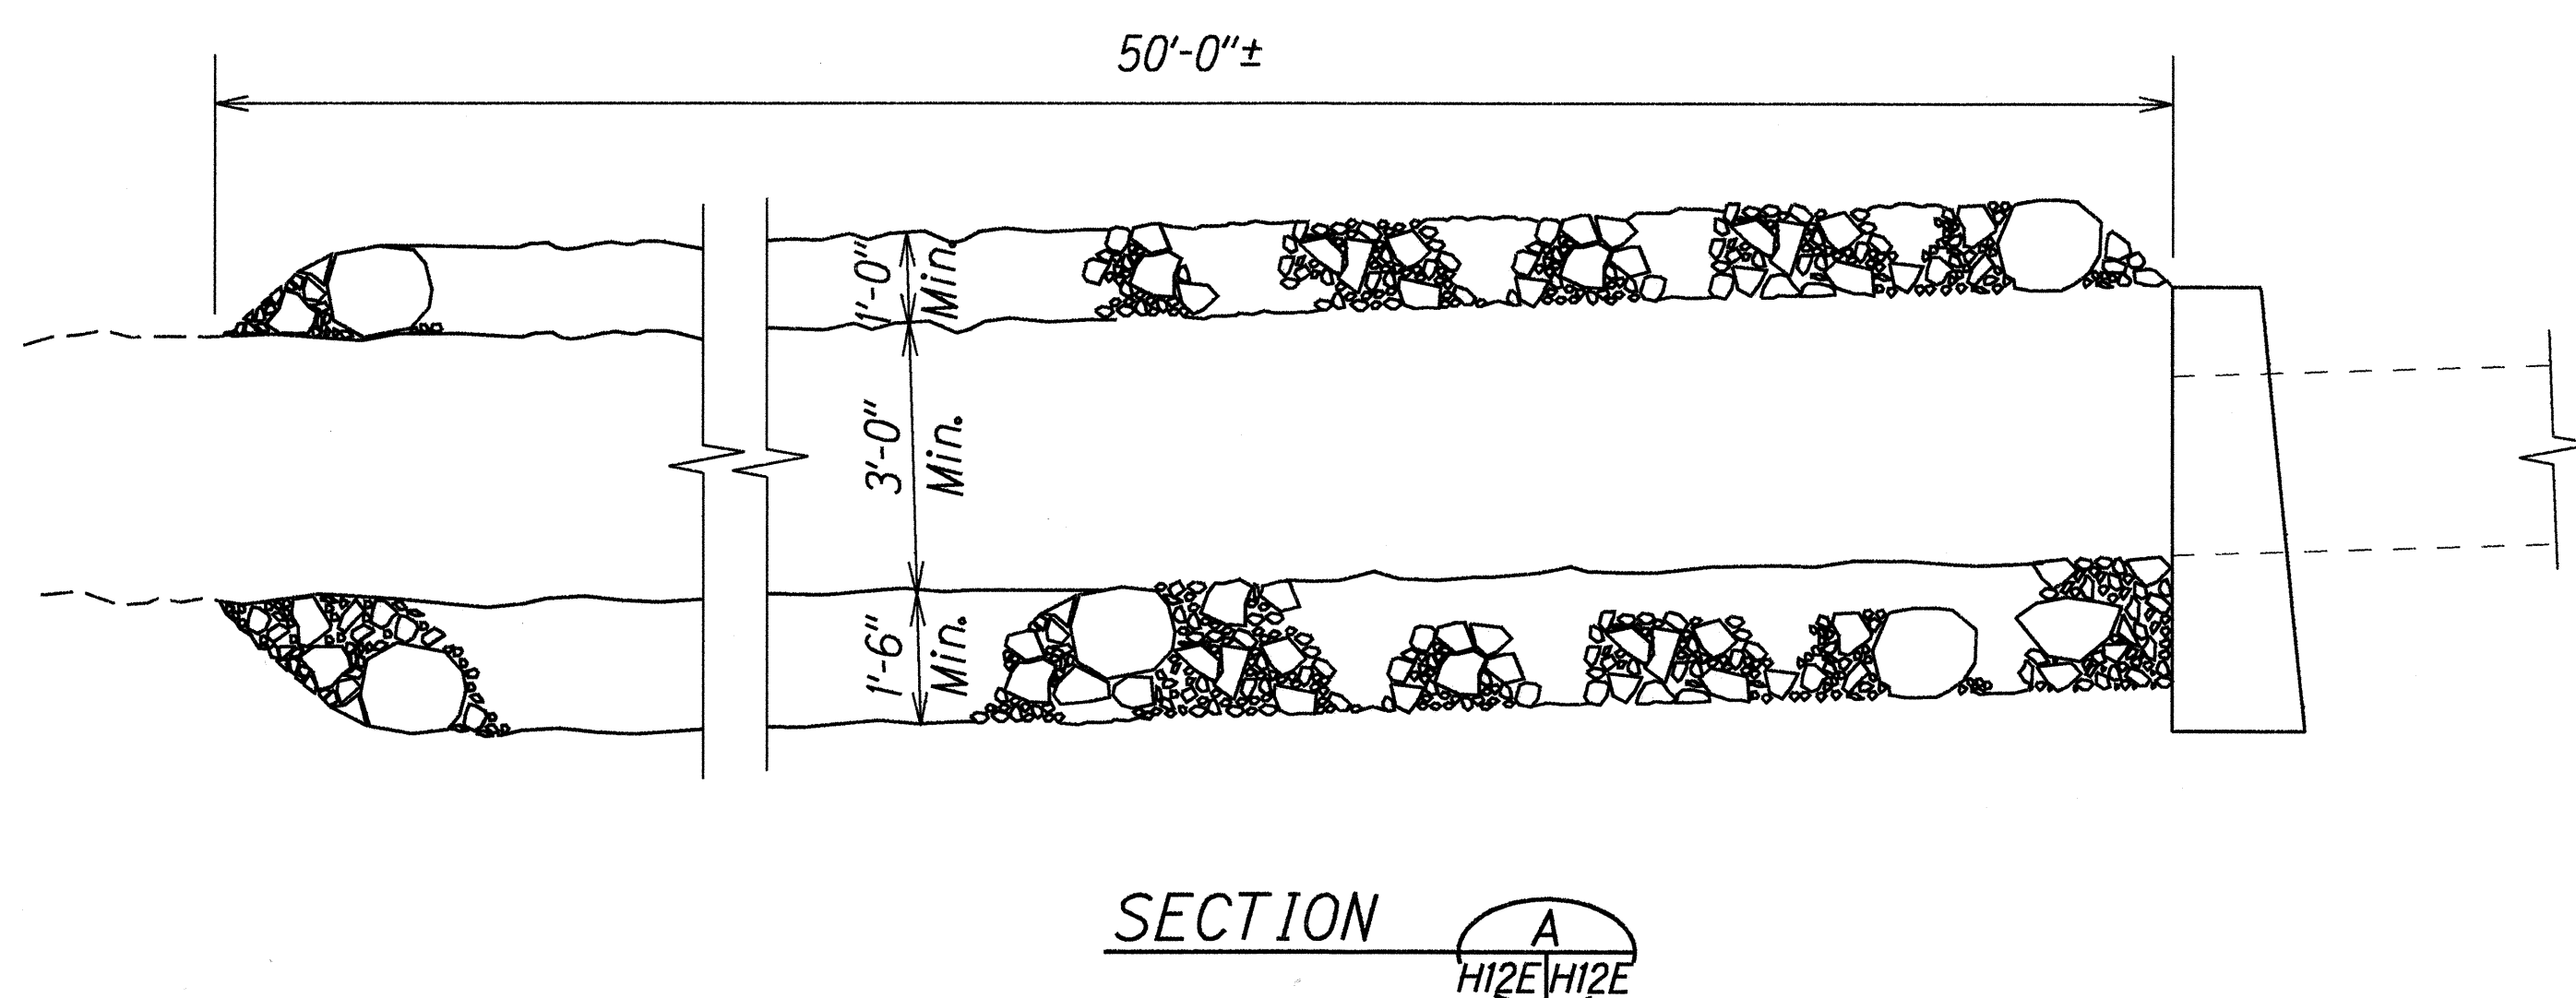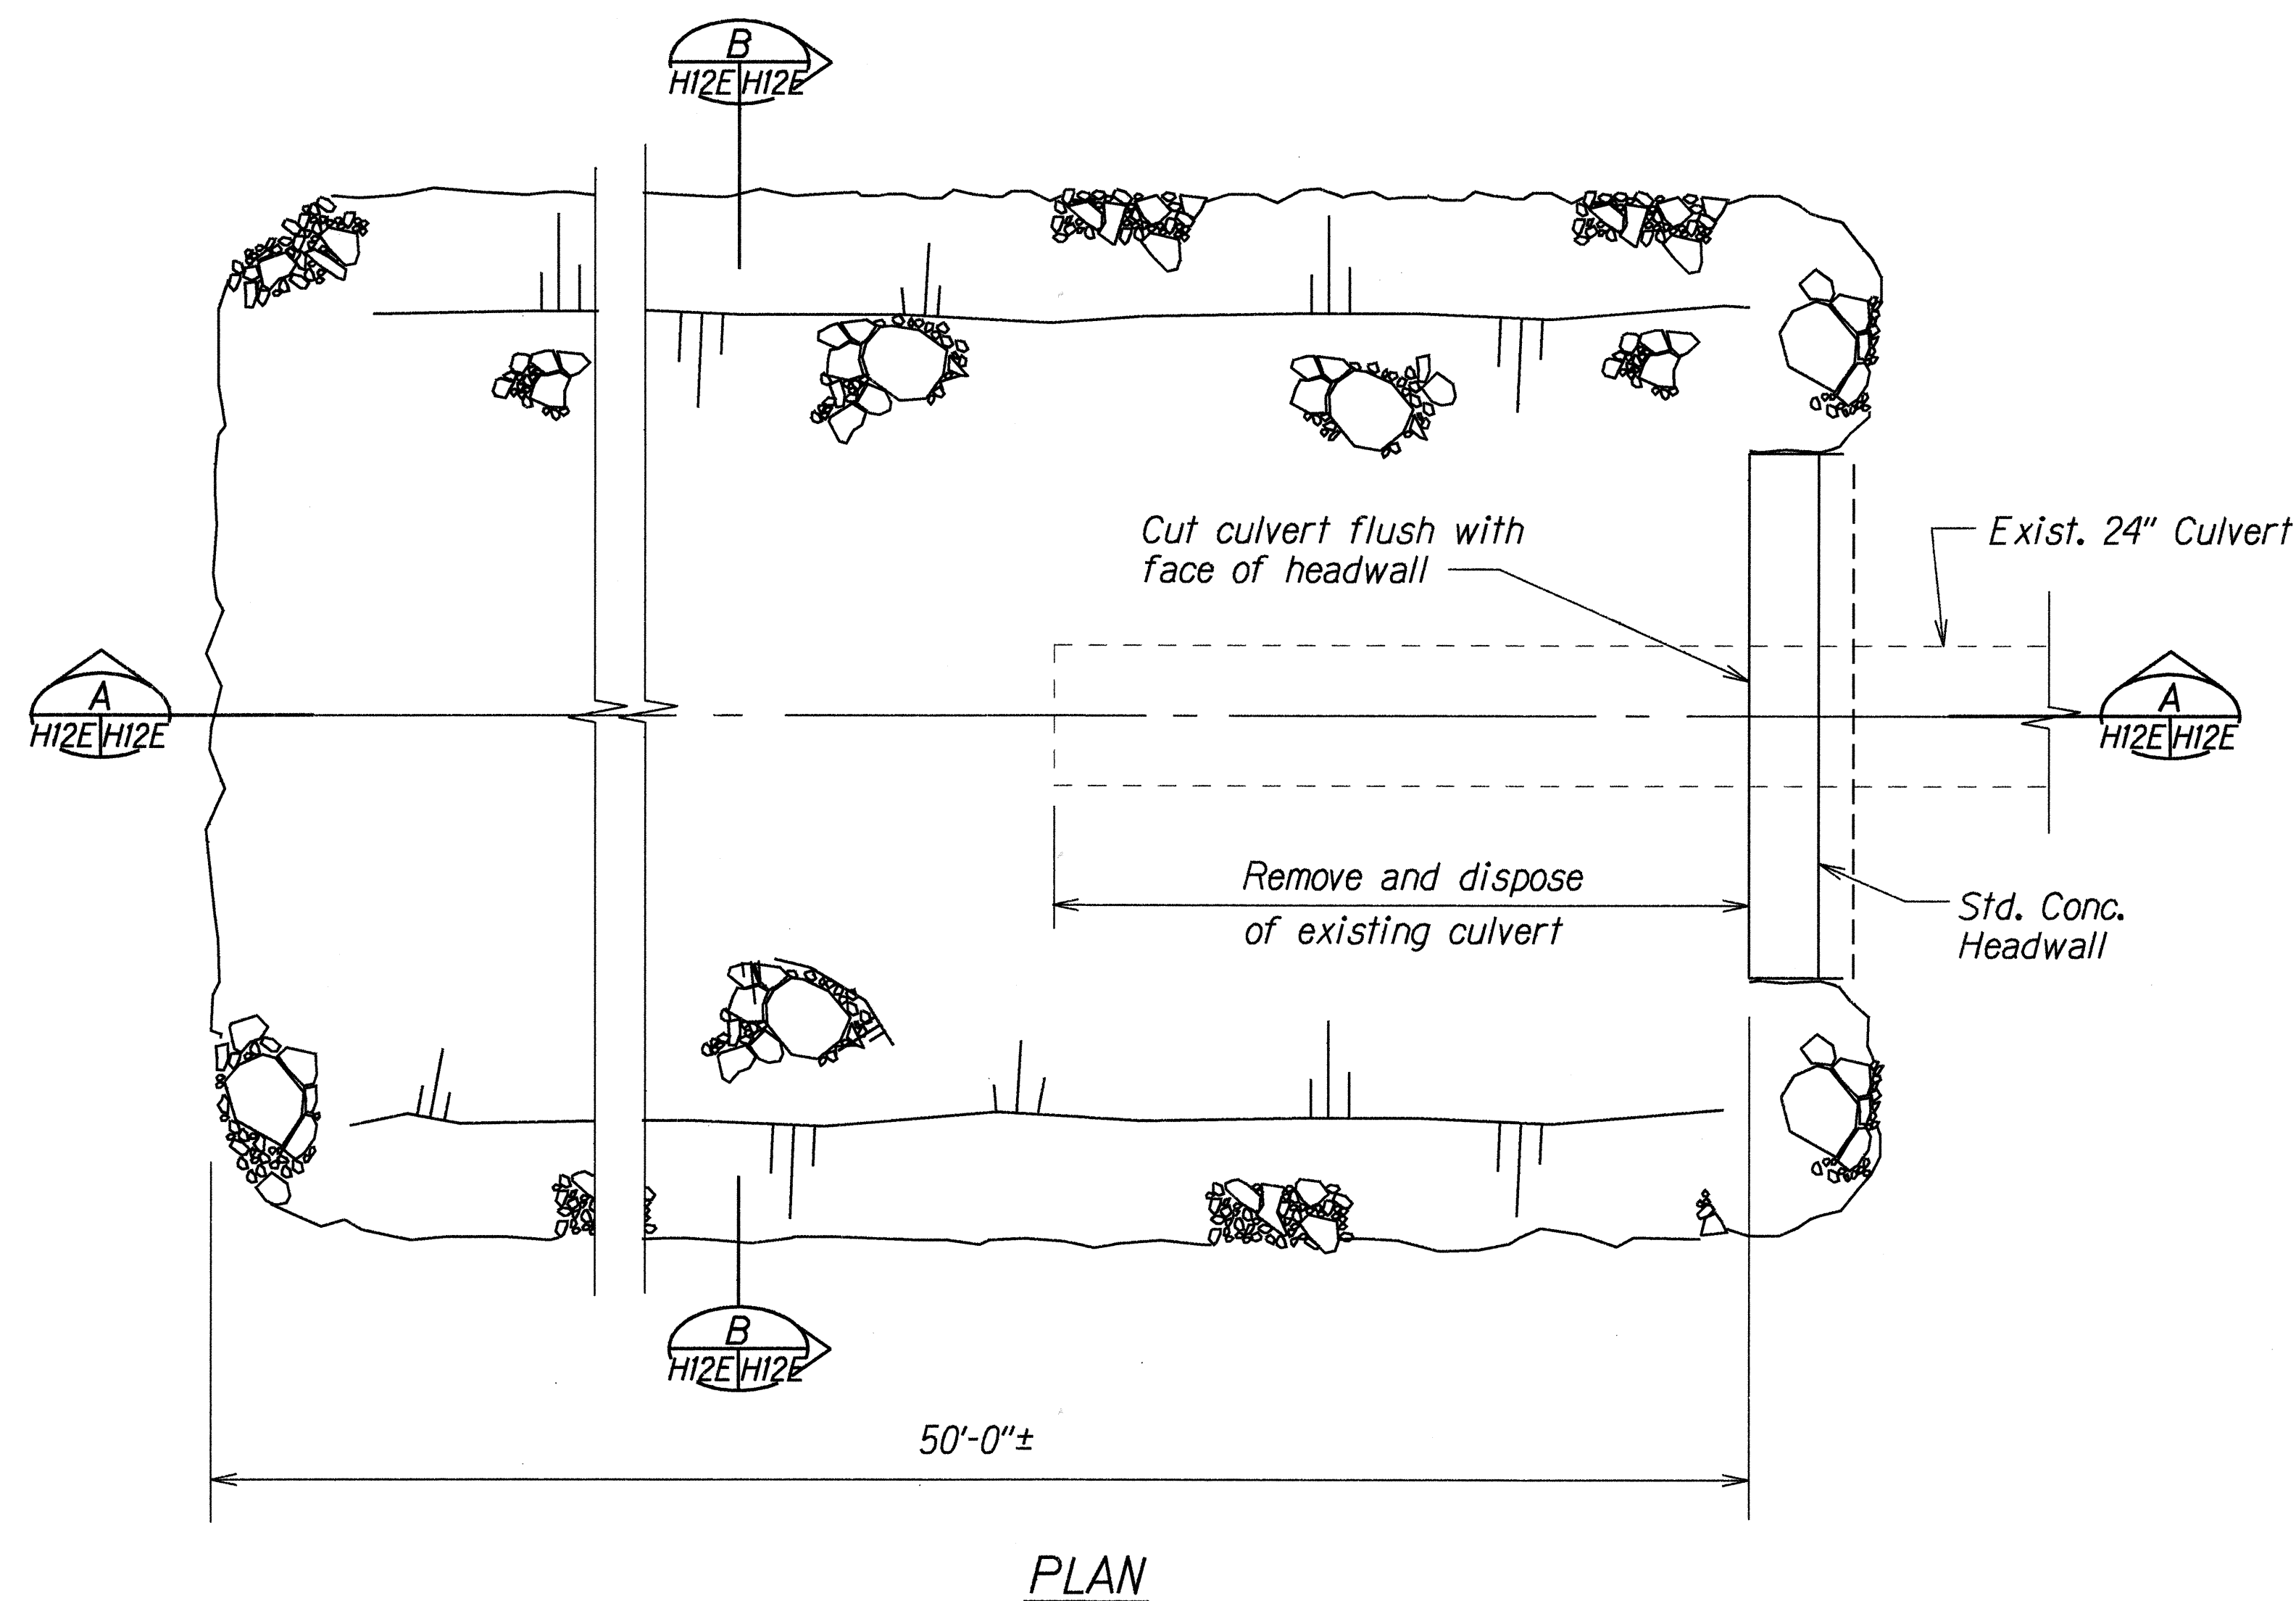


DUMPED RIPRAP IN EARTH DITCH AT STA. 34+40 LT.

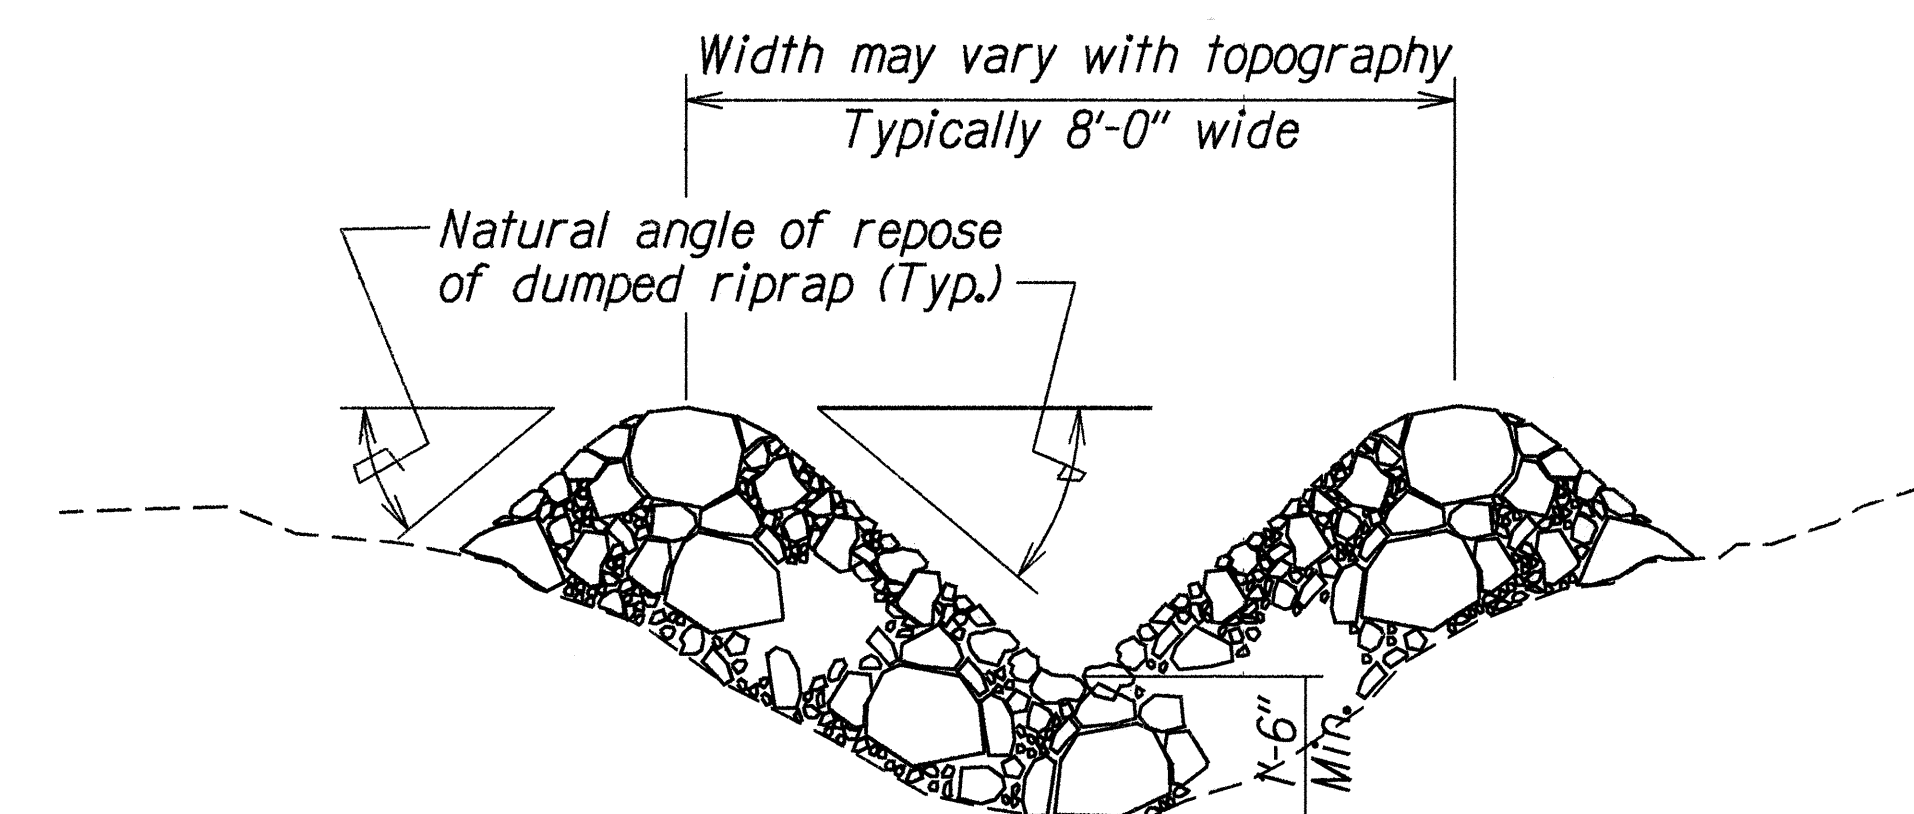

NOTE: Riprap shall be dumped loosely, hand placement of stones is not necessary.

DUMPED RIPRAP AT STA. 52+50± LT.

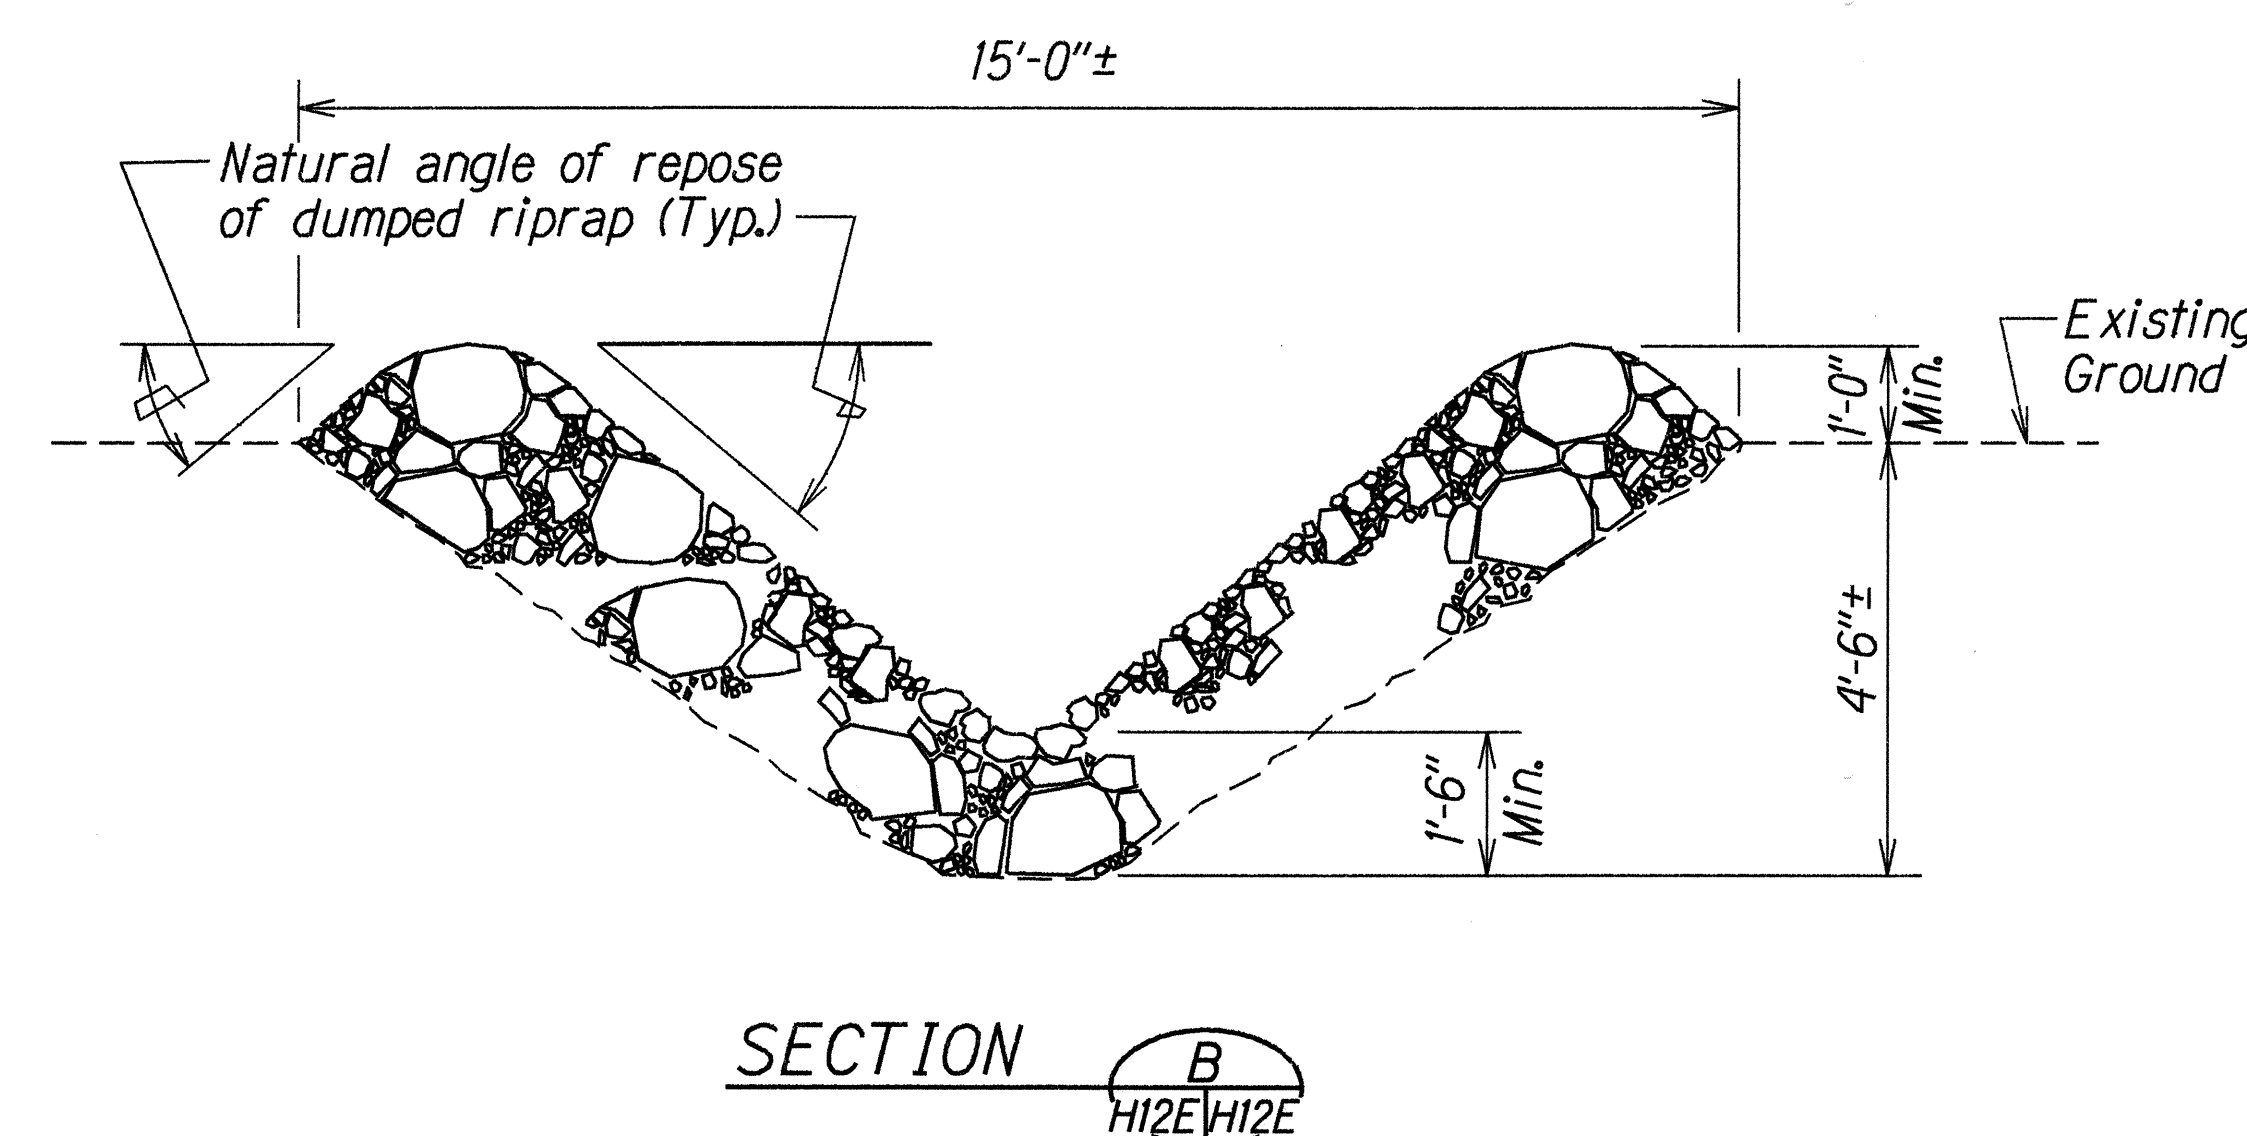

6/14/96 Details added to complete drainage plan.

DATE REVISION

STATE OF HAWAII
DEPARTMENT OF TRANSPORTATION
HIGHWAYS DIVISION

DRAINAGE DETAILS

KALANIANA'OLE HIGHWAY RESURFACING

Kailua Rd. to Hilo St.

Project No. 72A-01-96M

Scale: 1/2"=1'-0"






Date: May 1996

SHEET No. HI2E OF 12 SHEETS

ADD. 55S-5

ORIGINAL PLAN	SURVEY PLOTTED BY	DATE
NOTE BOOK	DRAWN BY	5/27/96
DESIGNED BY	DESIGNED BY	
QUANTITIES BY	QUANTITIES BY	
CHECKED BY	CHECKED BY	

FED. ROAD DIST. NO.	STATE	PROJ. NO.	FISCAL YEAR	SHEET NO.	TOTAL SHEETS
HAWAII	HAW.	72A-01-96M	1996	ADD. 55S-6	55

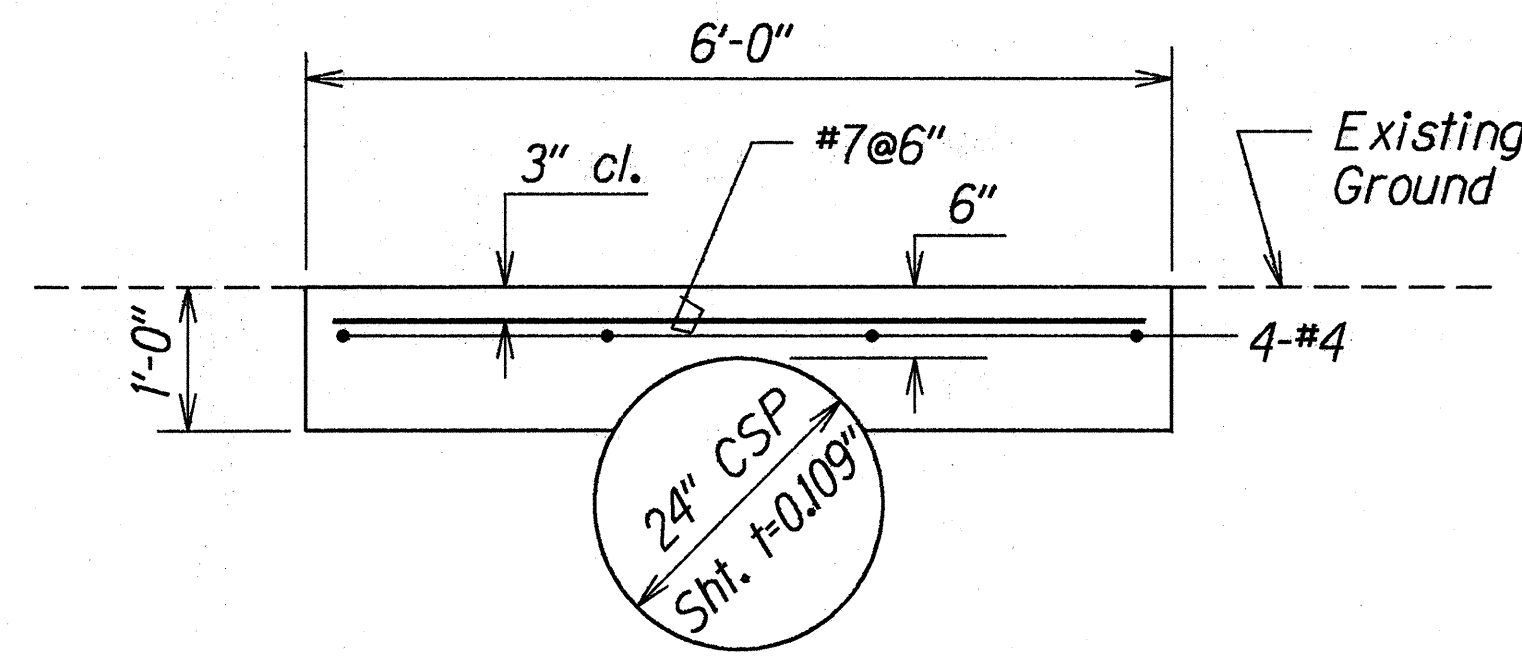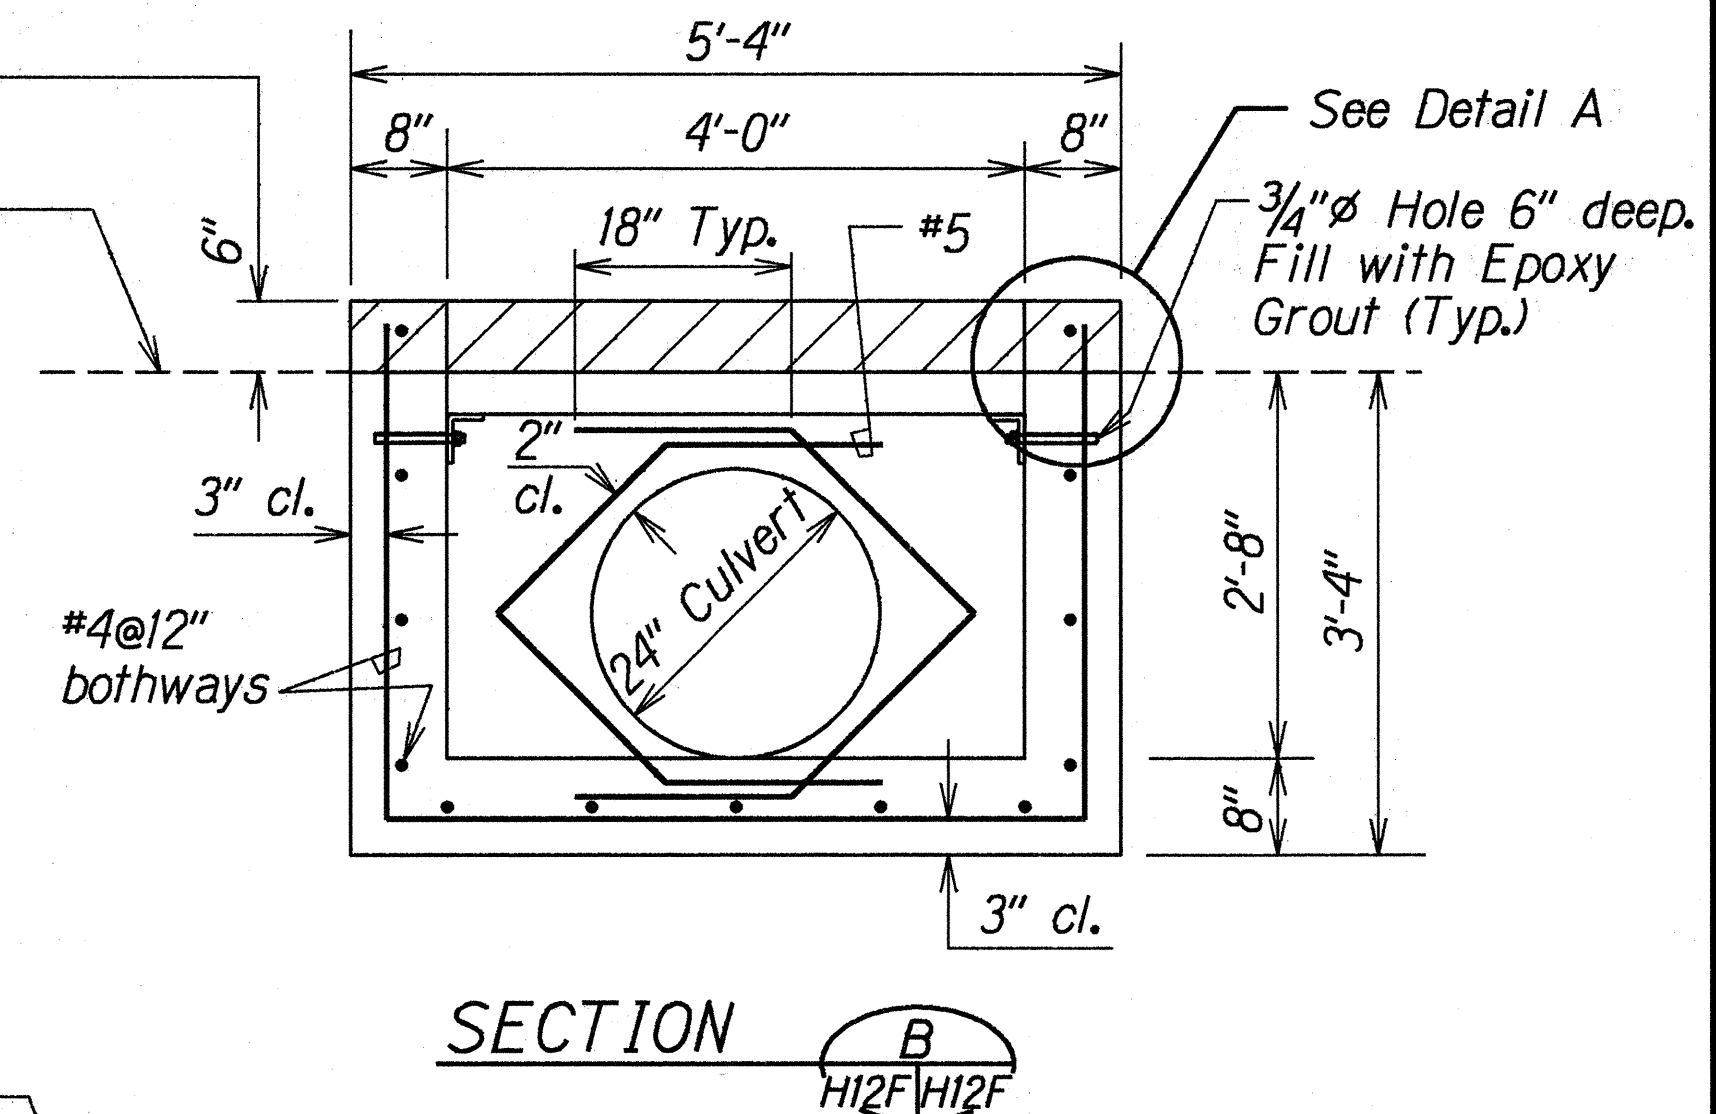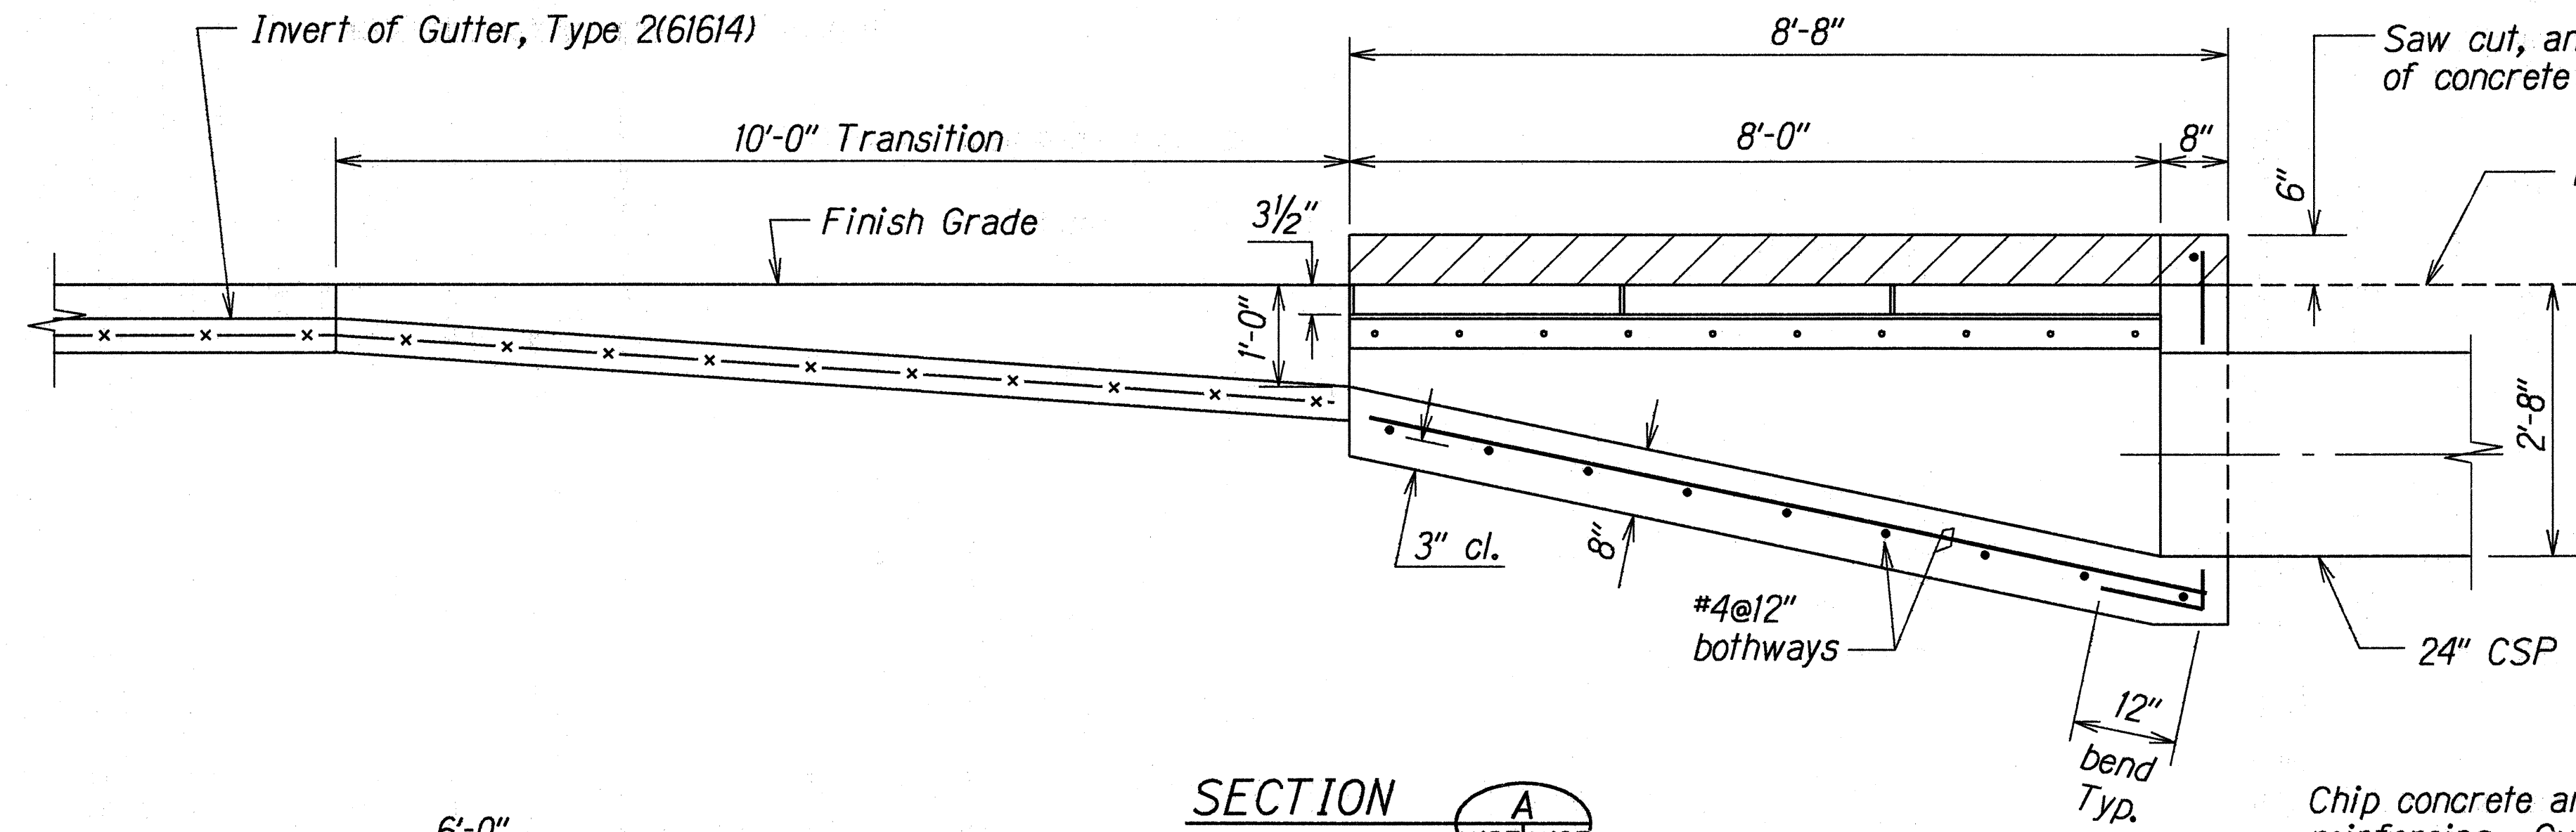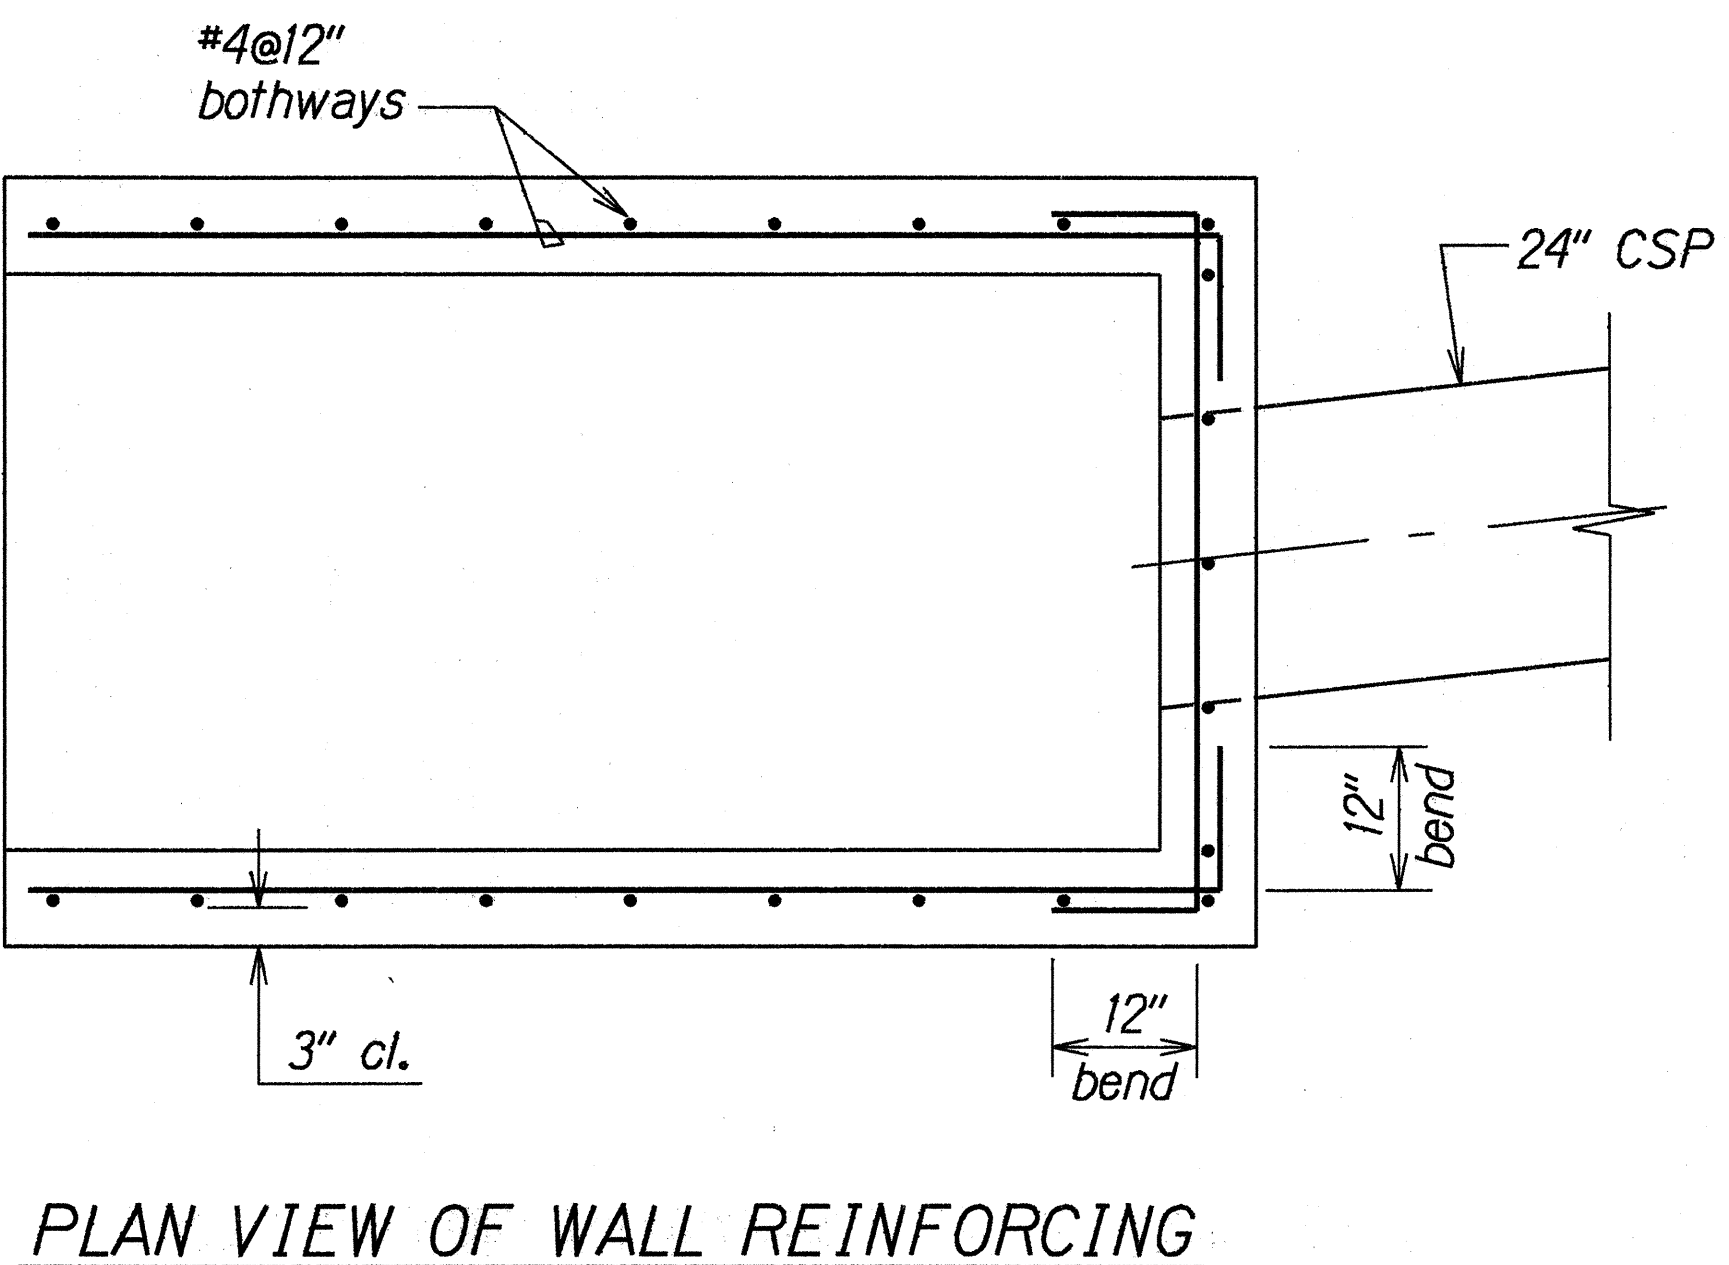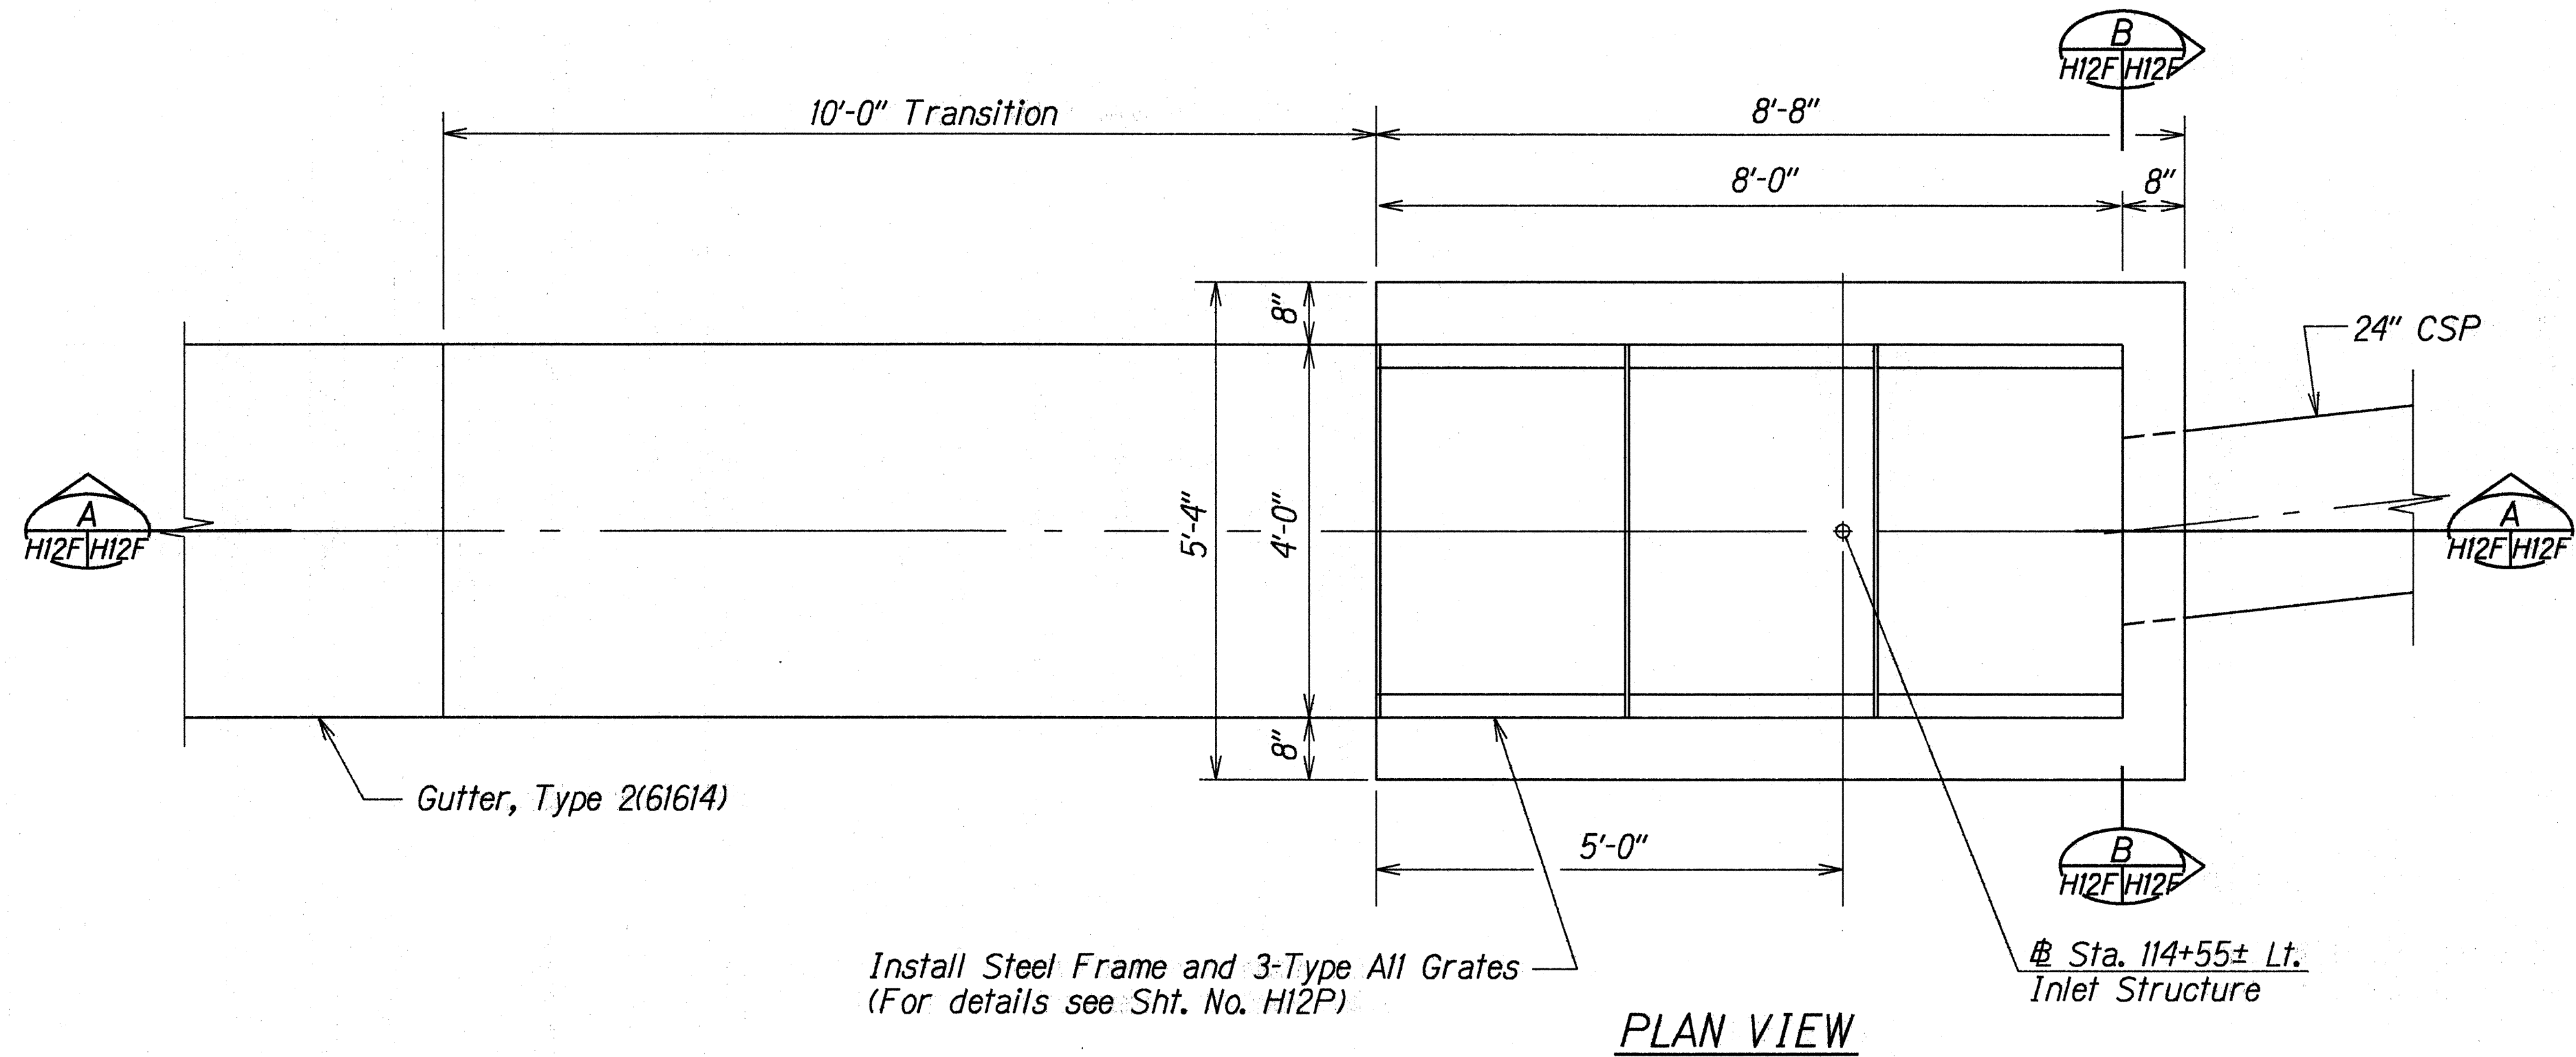


SECTION A

NOTE

Only non-pneumatic type of drill as approved by the Engineer will be permitted for drilling holes in concrete. The approximate diameter of drilled holes for installation of studs shall be 3/4 inches. After installing studs the voids shall be filled with epoxy grout as directed by the Engineer. Above work shall be considered incidental to the various contract items.

Chip concrete around existing reinforcing. Cut reinforcing bar 1" below saw cut. Fill chipped out area with epoxy mortar.

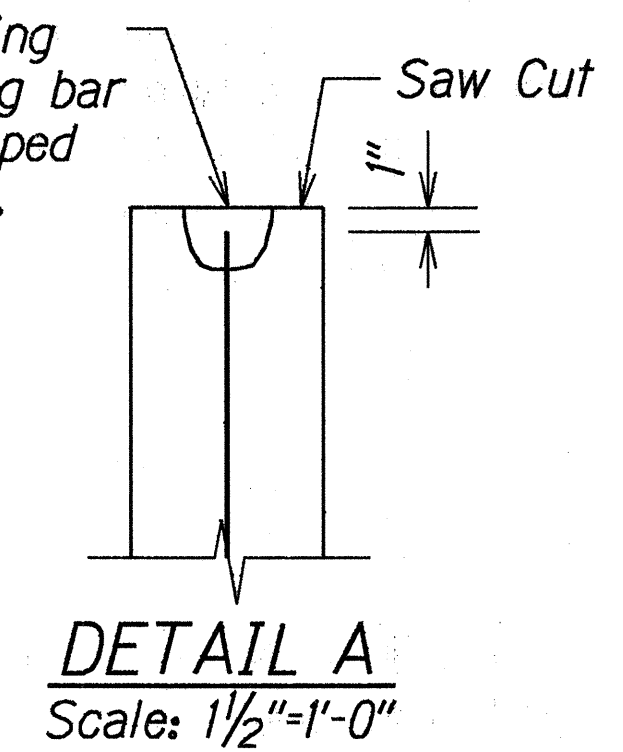


INLET STRUCTURE AT # STA. 114+55± LT.


DATE	REVISION
4/15/97	Revised Inlet Structure for safety.
6/14/96	Details added to complete drainage plan.
STATE OF HAWAII DEPARTMENT OF TRANSPORTATION HIGHWAYS DIVISION DRAINAGE DETAILS KALANIANA'OLE HIGHWAY RESURFACING Kailua Rd. to Hilu St. Project No. 72A-01-96M Scale: 3/4"=1'-0" Date: May 1996	
SHEET No. HI2F OF 12 SHEETS	

ORIGINAL PLAN	DATE 5/27/96
SURVEY PLOTTED BY	
DRAWN BY A. KANAKA	
CHECKED BY B. SALAMON	
NOTE BOOK	
QUANTITIES BY	
CHECKED BY	


FED. ROAD DIST. NO.	STATE	PROJ. NO.	FISCAL YEAR	SHEET NO.	TOTAL SHEETS
HAWAII	HAW.	72A-01-96M	1996	ADD 55S-7	55

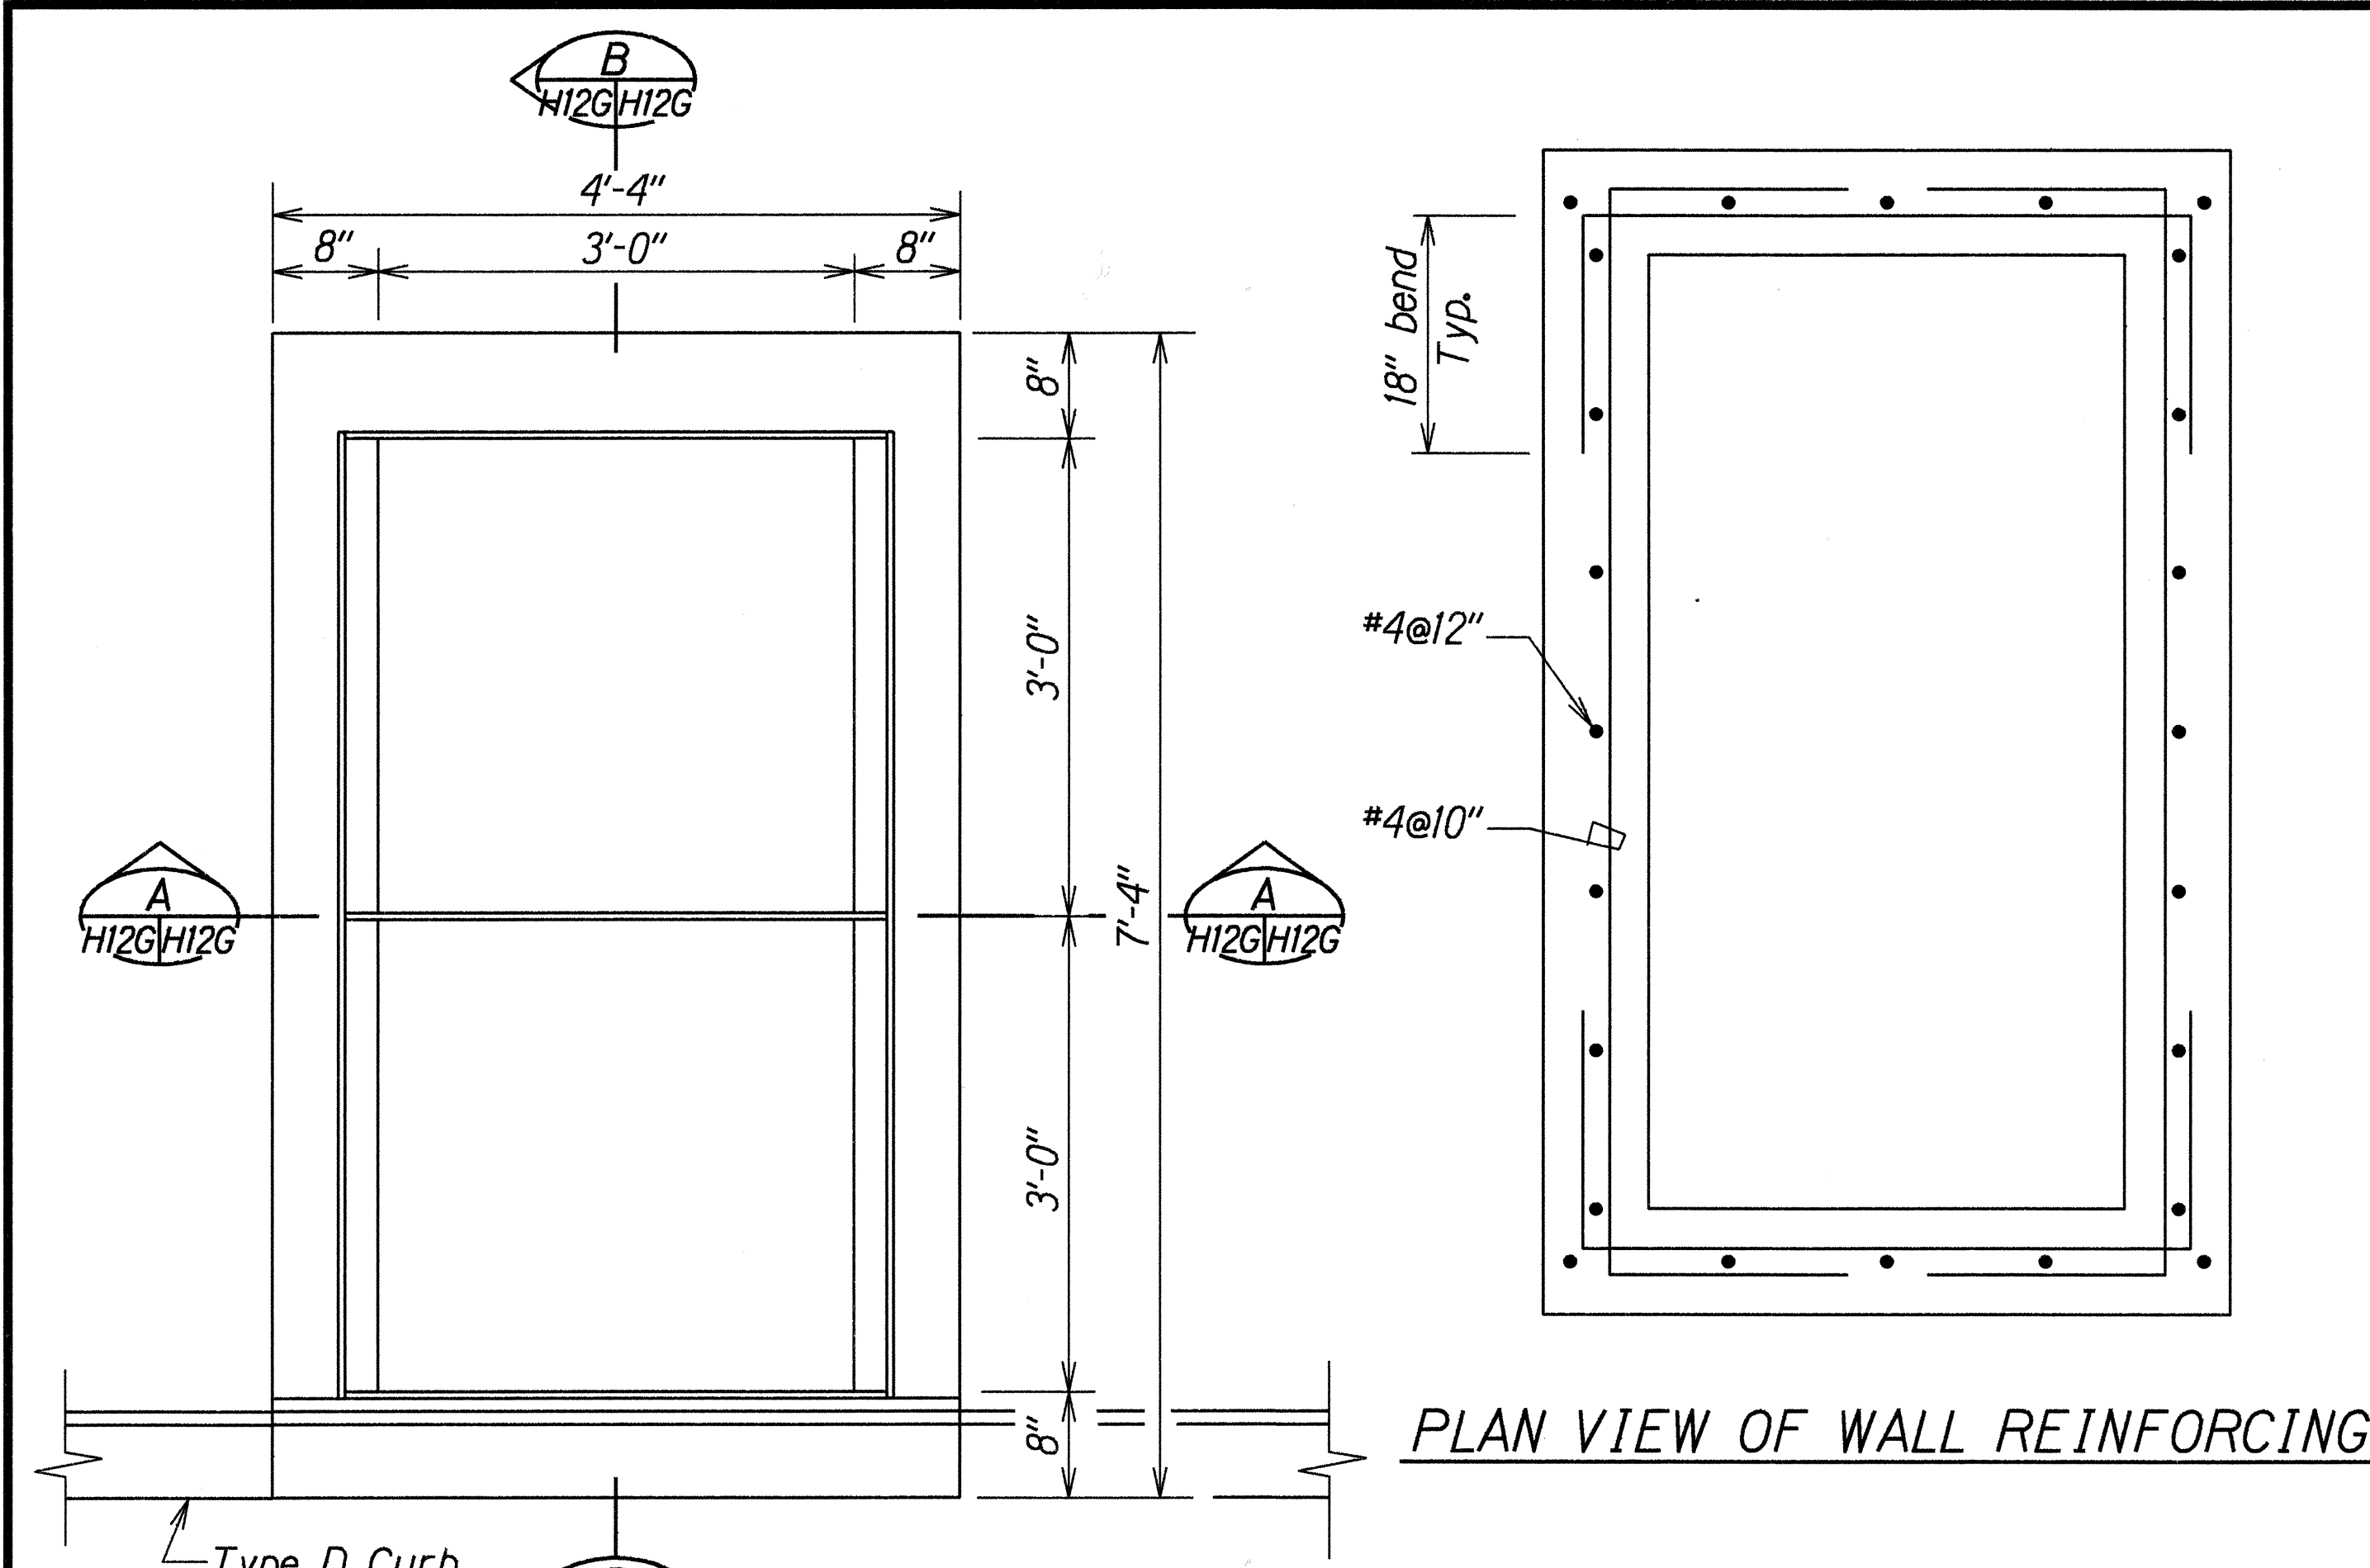

PLAN VIEW OF WALL REINFORCING

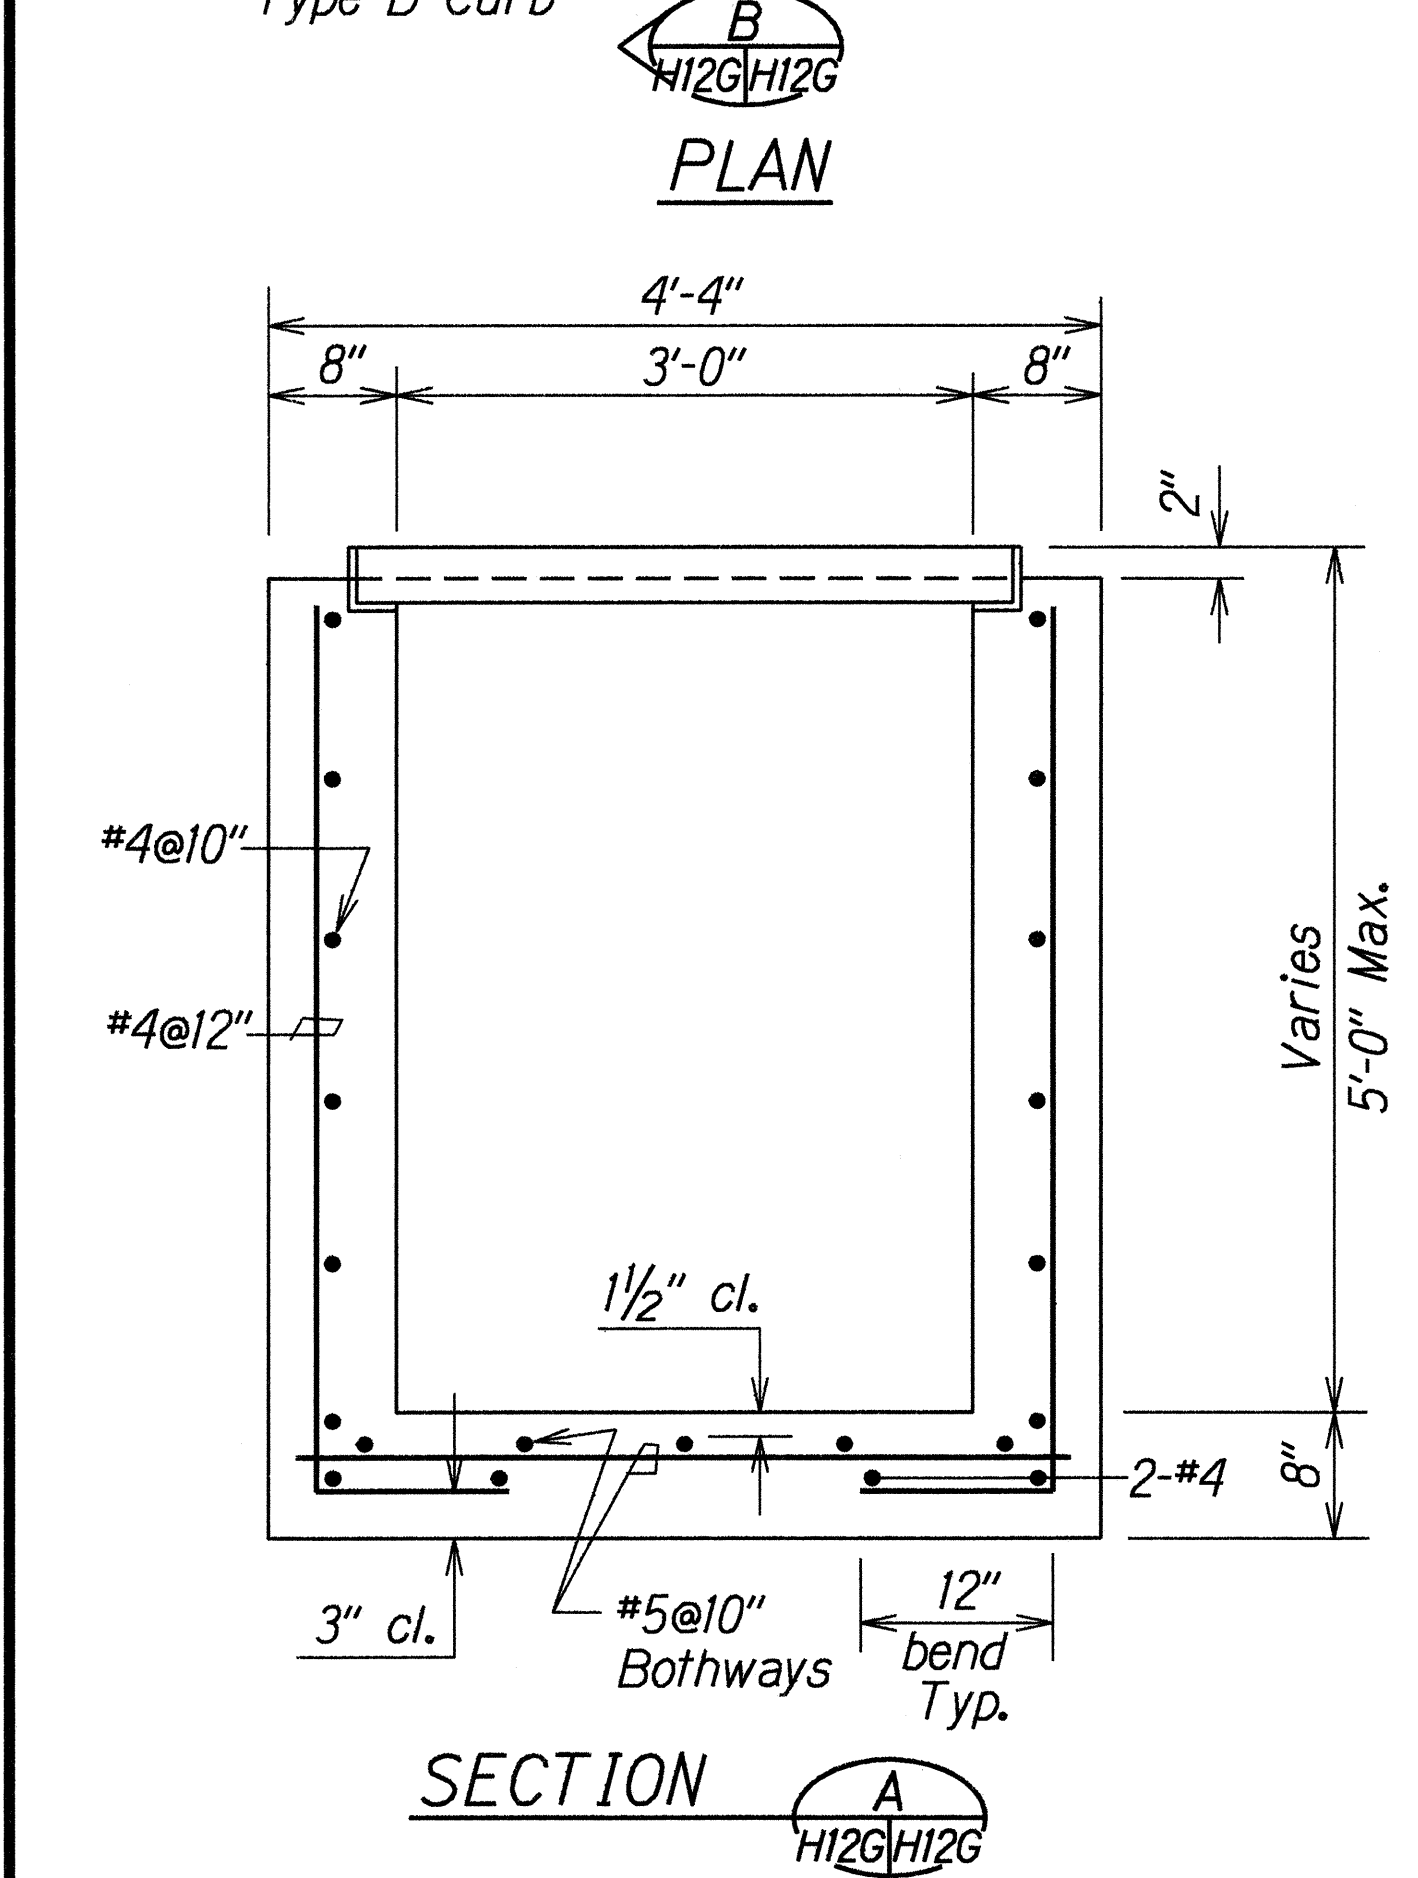


SECTION A-A
H12GHI2G

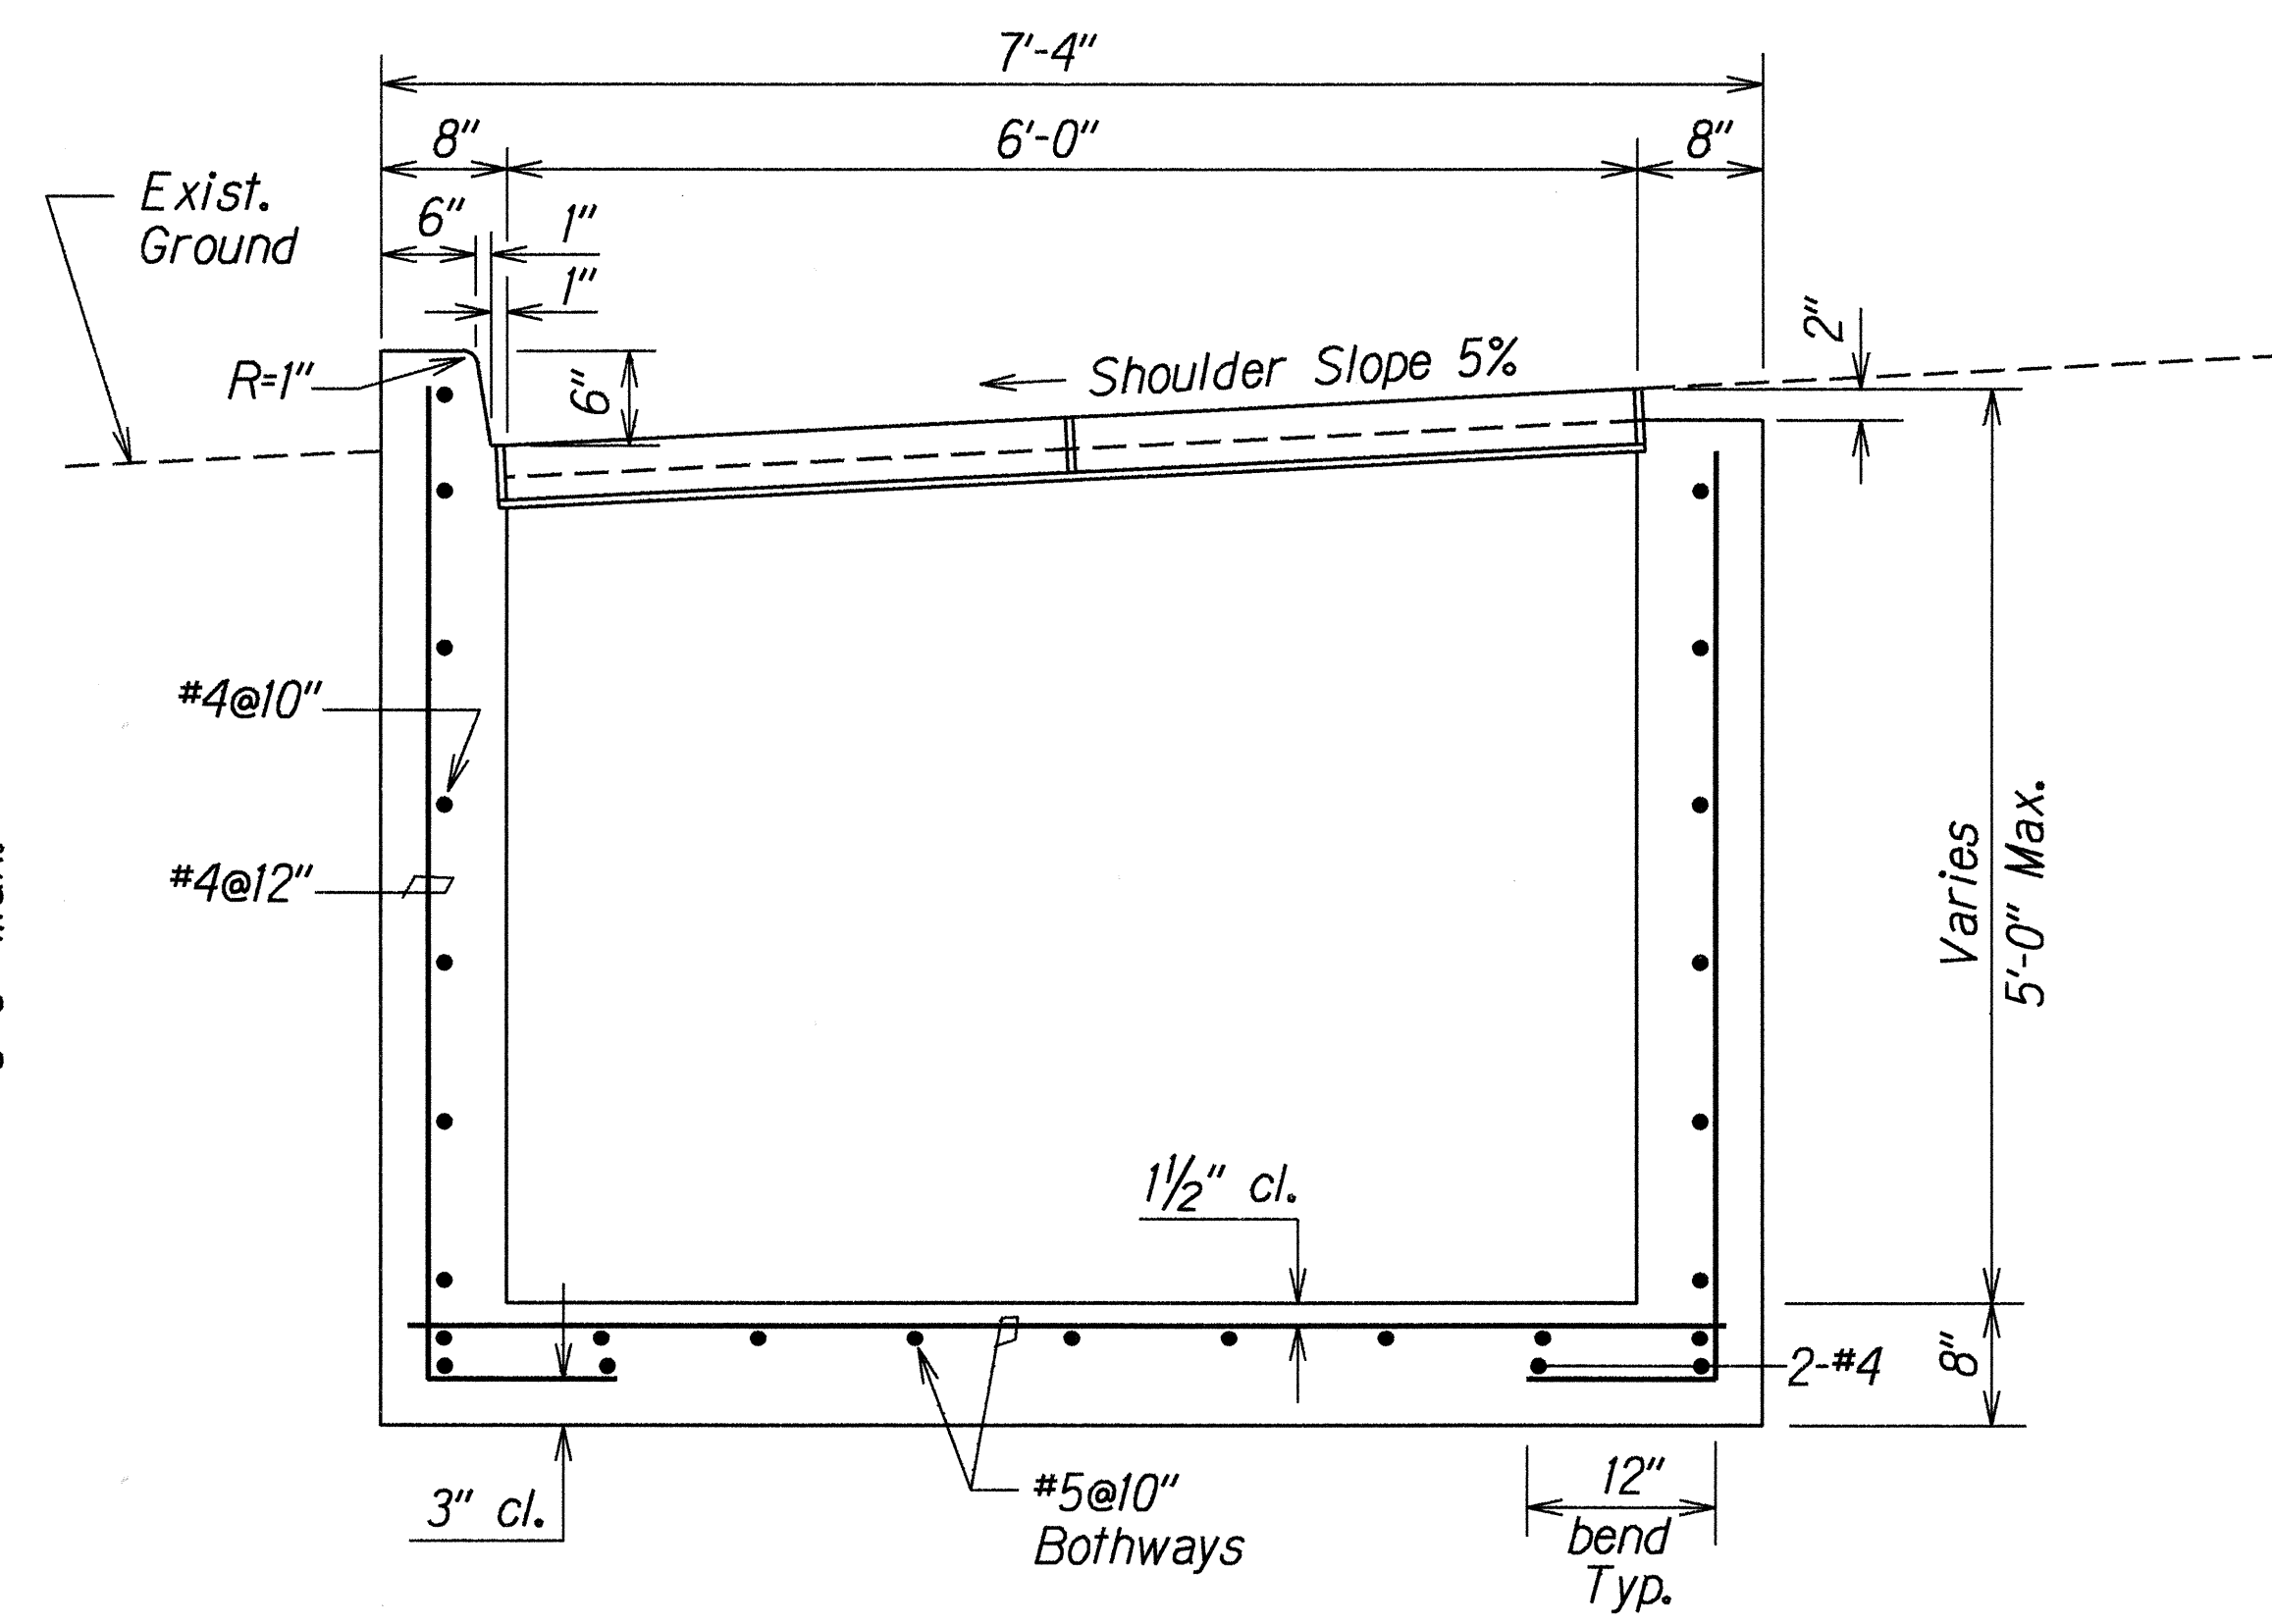


SECTION B-B
H12GHI2G

TYPE 00006 GDI DETAILS

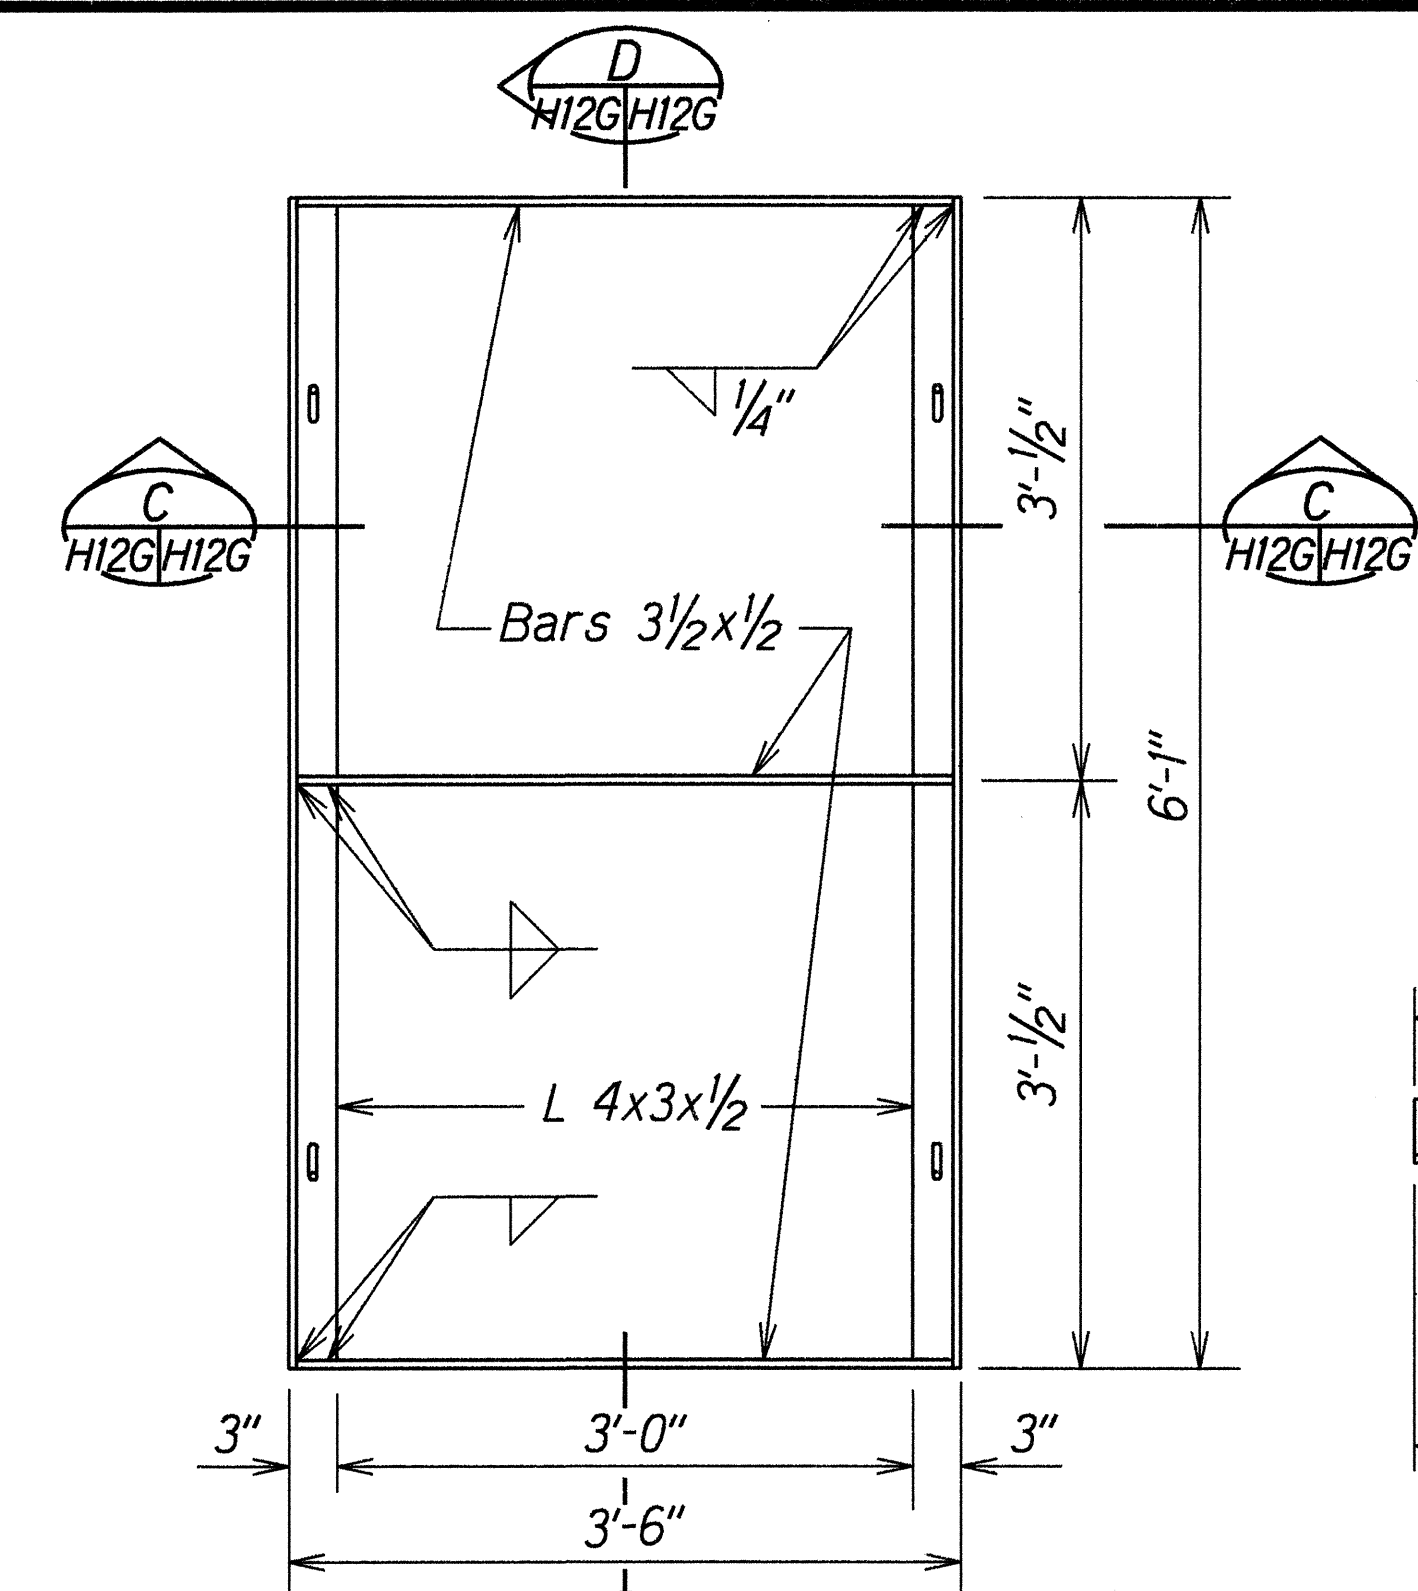

PLAN

DETAIL OF FRAME

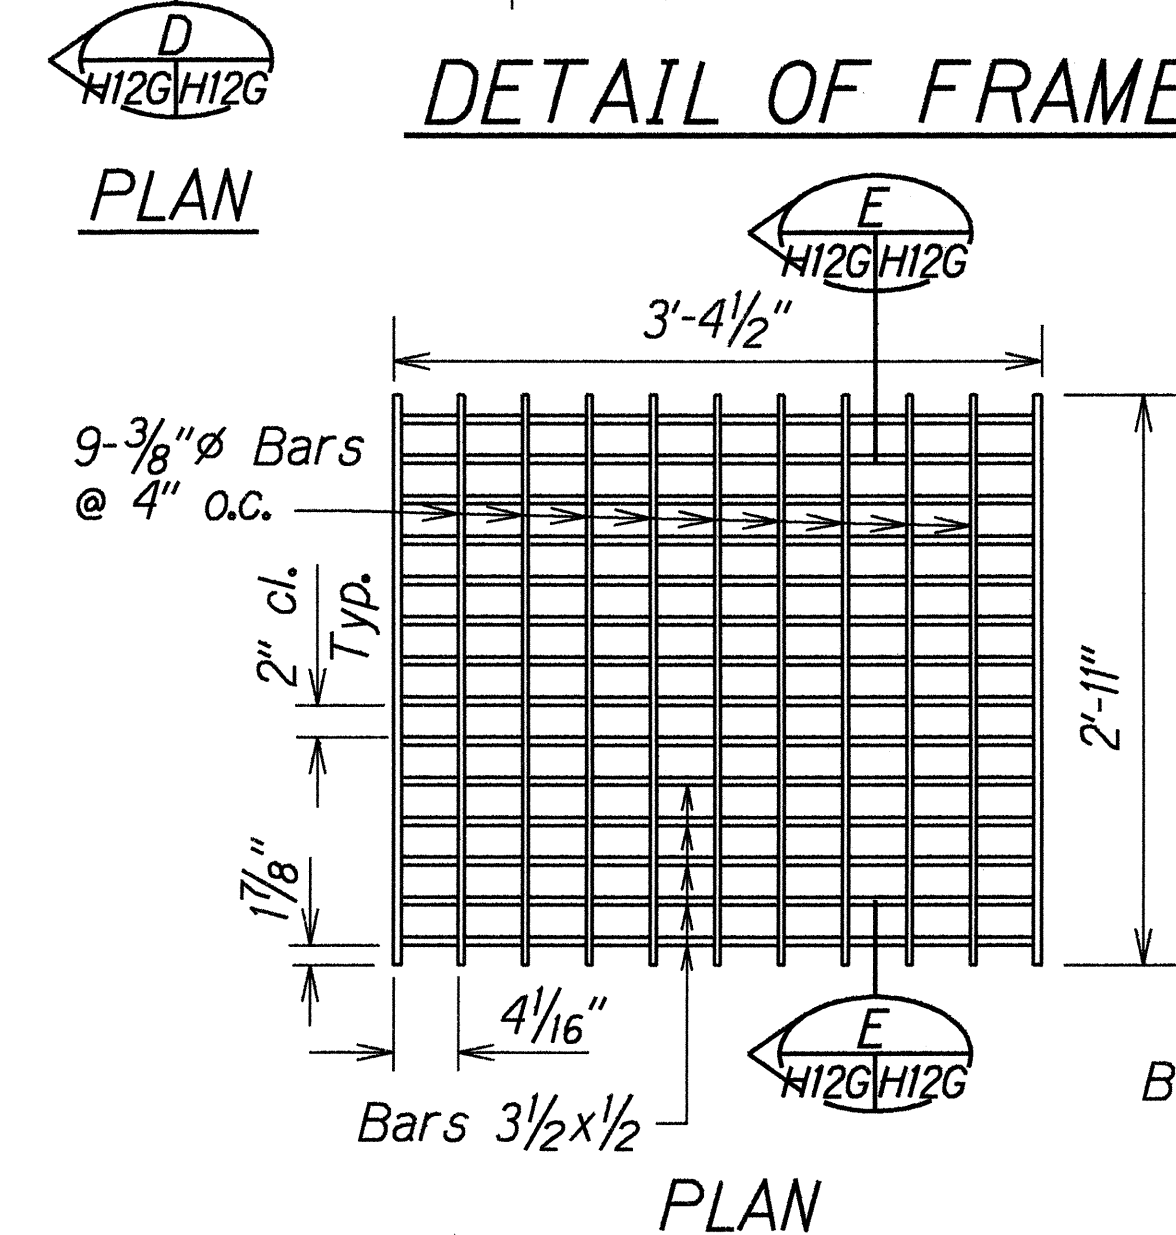


PLAN


DETAIL OF GRATE

- NOTES:
1. All welds $\frac{3}{8}$ " unless otherwise noted.
 2. Frame and grates shall be hot dip galvanized after fabrication.


STEEL FRAME AND GRATE DETAILS

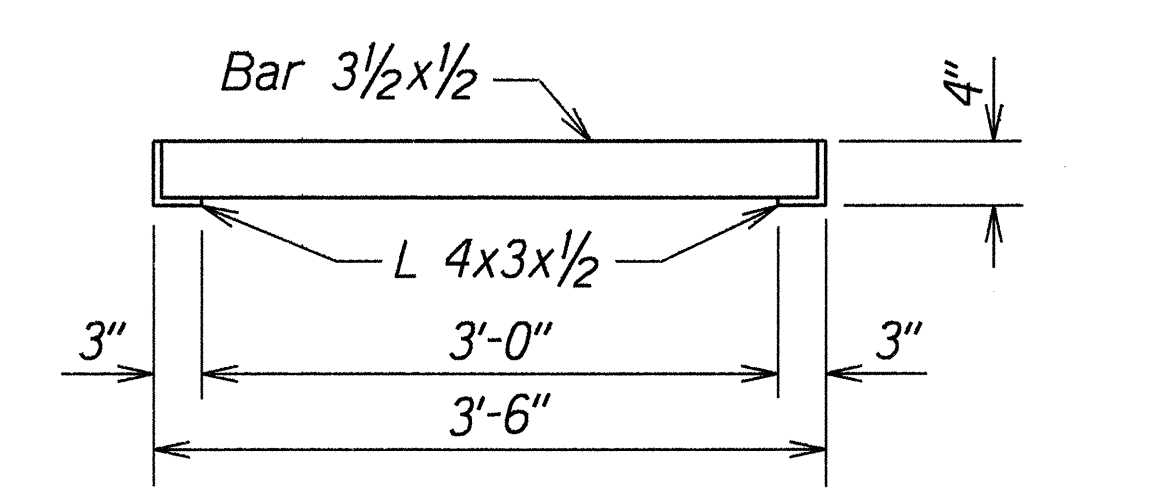


SECTION C-C
H12GHI2G

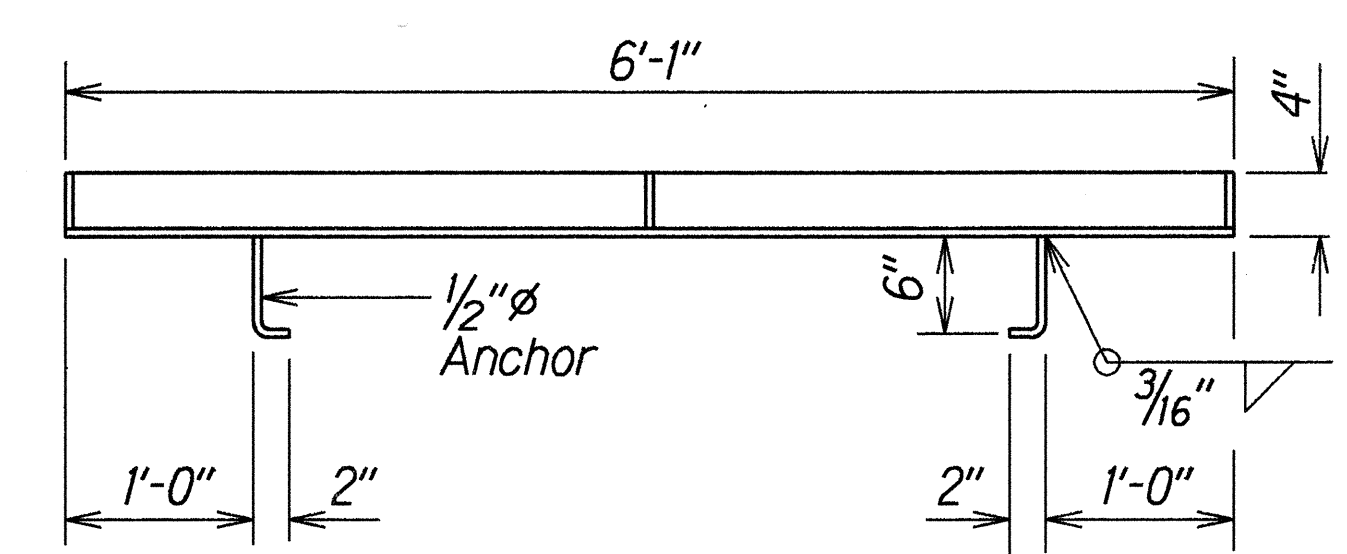

SECTION D-D
H12GHI2G

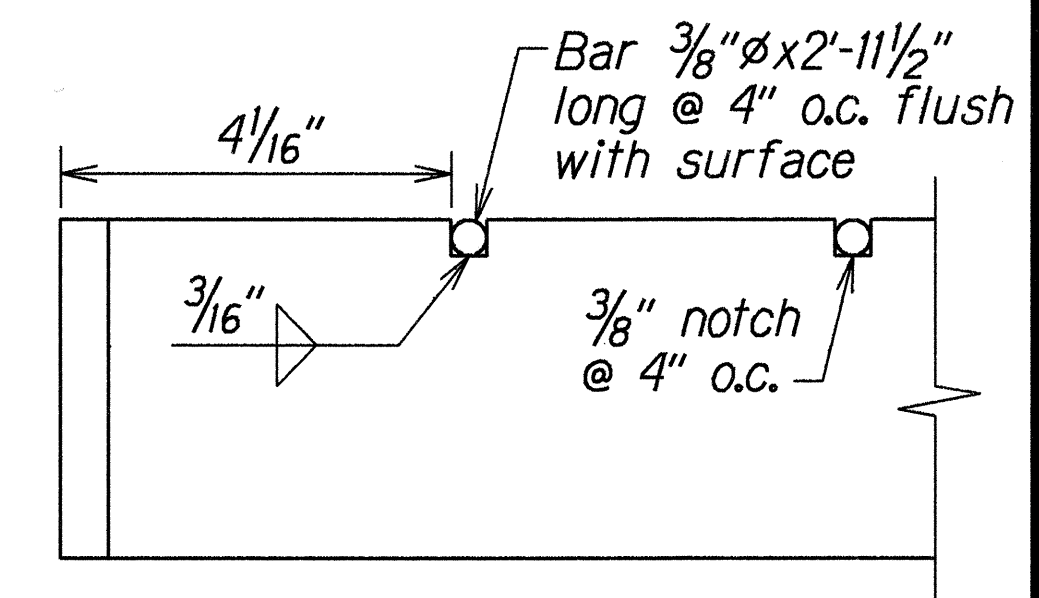

NOTCH DETAIL
Scale: 6"=1'-0"

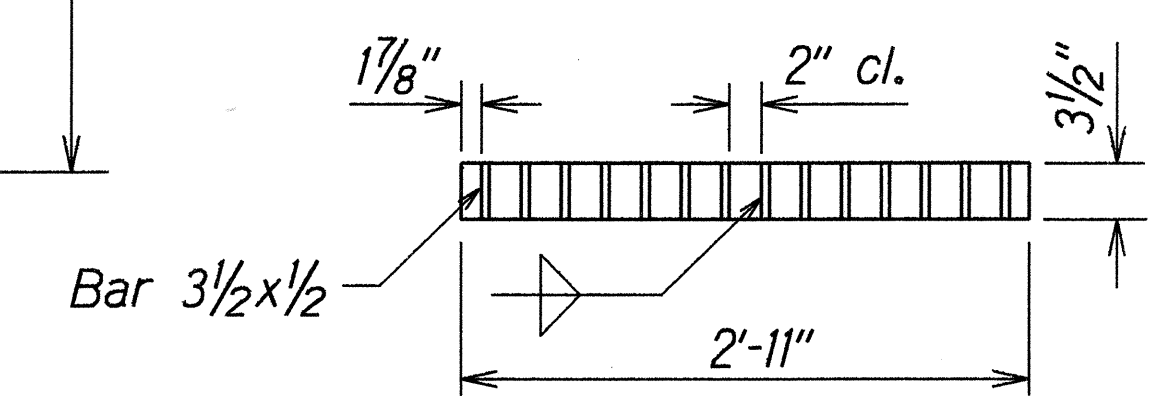

SECTION E-E
H12GHI2G

ORIGINAL PLAN	DATE	5/27/96
SURVEY PLOTTED BY		
DRAWN BY		
DESIGNED BY		
CHECKED BY		
NOTED BY		

6/14/96	Details added to complete drainage plan.
DATE	REVISION

STATE OF HAWAII
DEPARTMENT OF TRANSPORTATION
HIGHWAYS DIVISION


DRAINAGE DETAILS

KALANIANA'OLE HIGHWAY RESURFACING
Kailua Rd. to Hilo St.
Project No. 72A-01-96M


Scale: 1"=1'-0" Date: May 1996

SHEET No. H12G OF 12 SHEETS


FED. ROAD DIST. NO.	STATE	PROJ. NO.	FISCAL YEAR	SHEET NO.	TOTAL SHEETS
HAWAII	HAW.	72A-01-96M	1996	ADD. 55S-8	55

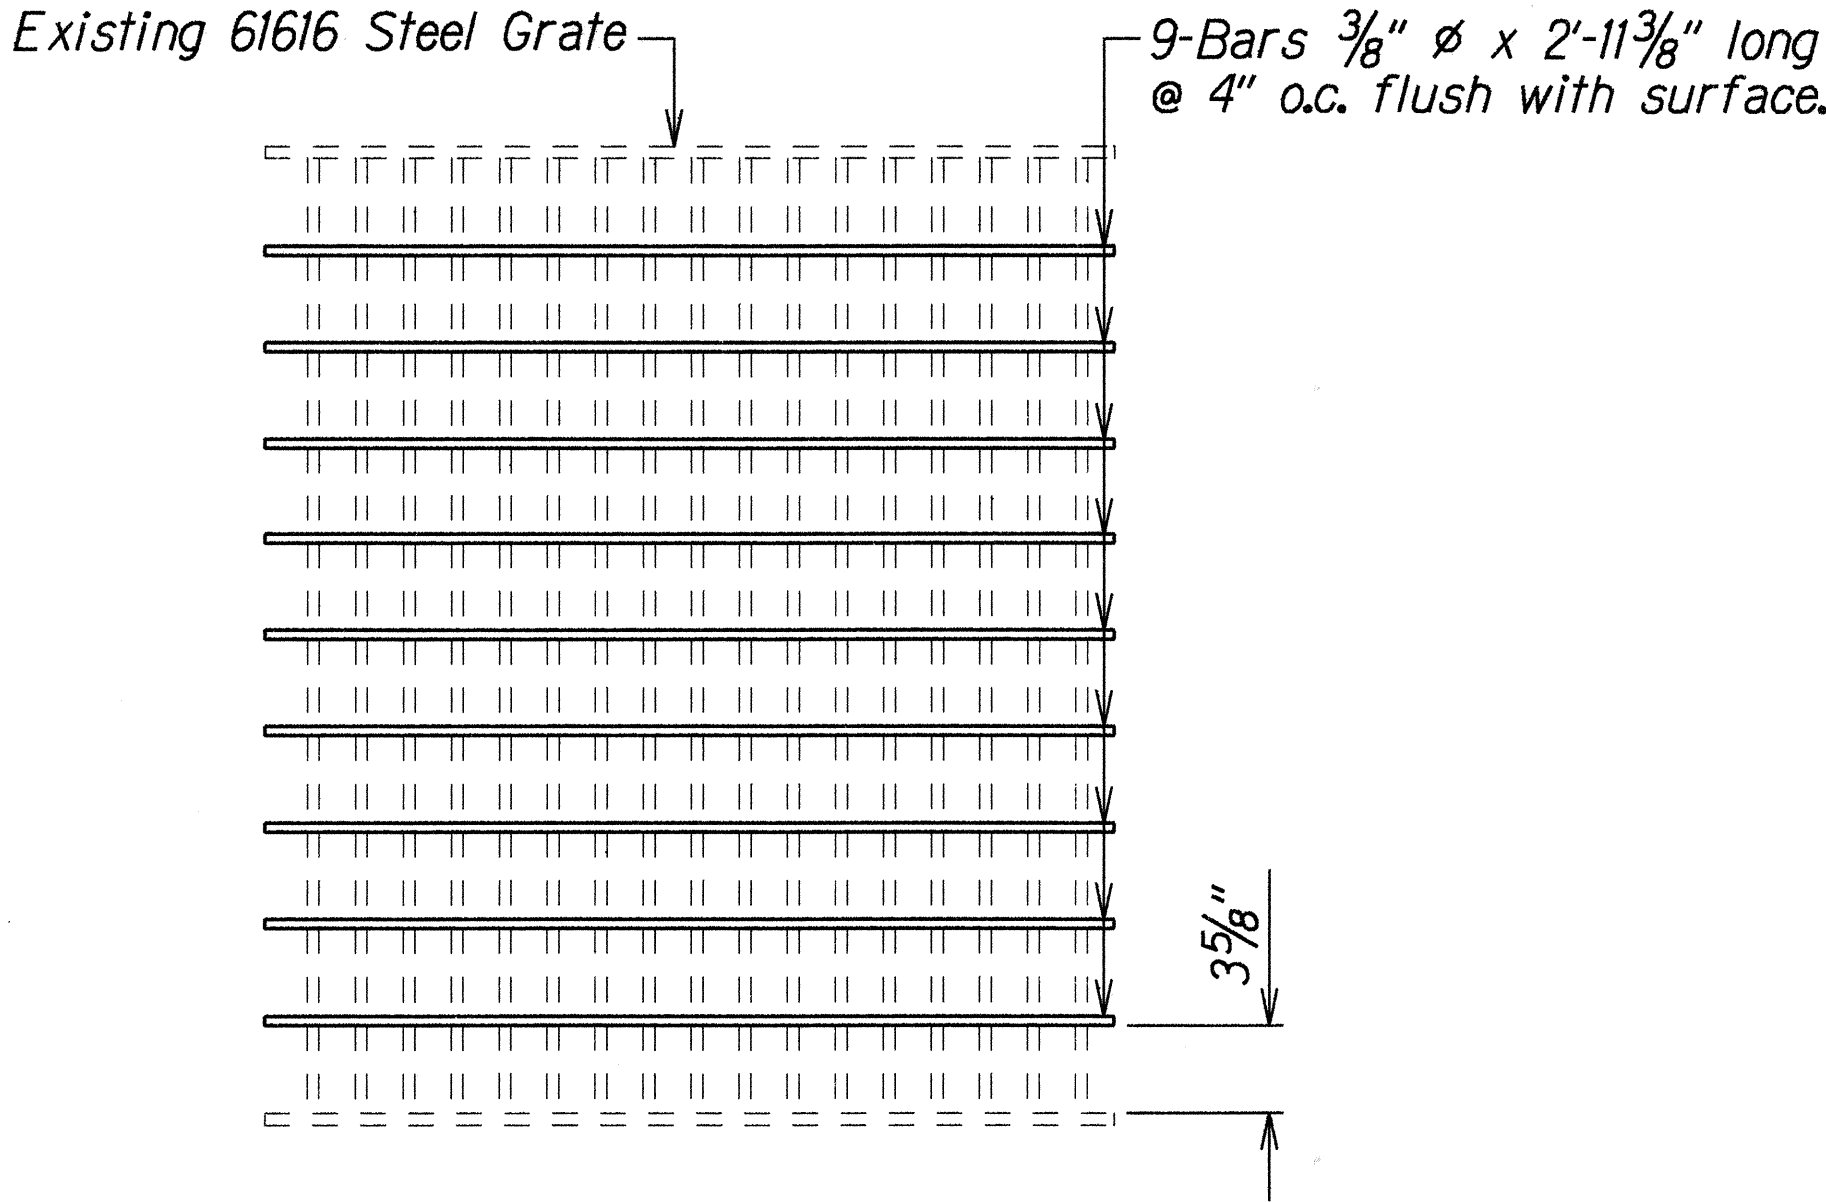

PLAN
Scale: 1 $\frac{1}{2}$ "=1'-0"

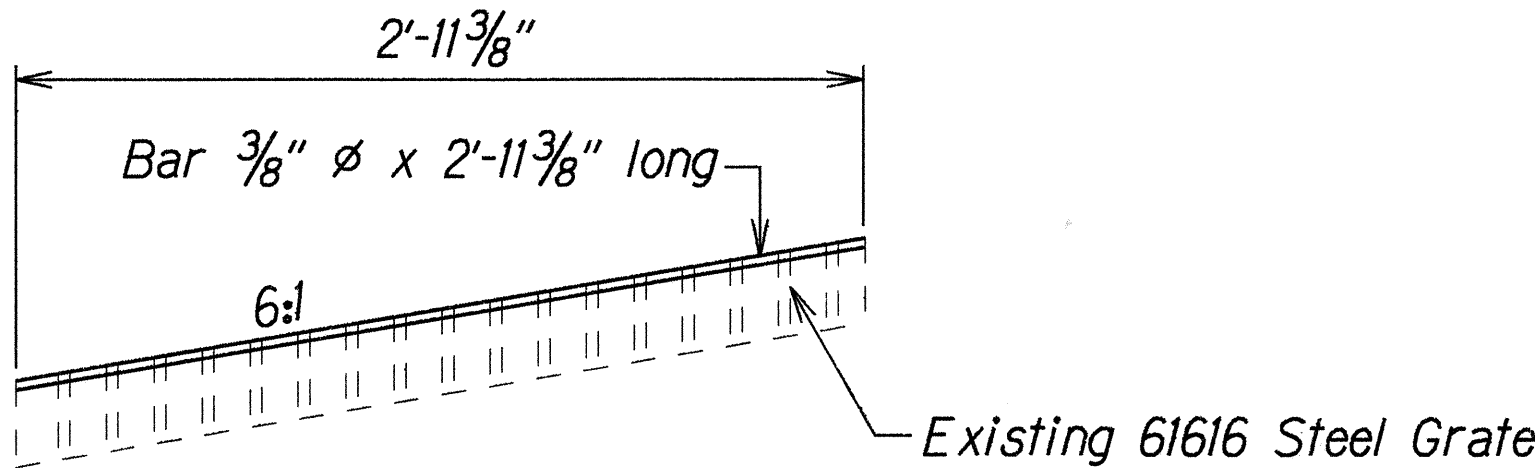

SECTION
Scale: 1 $\frac{1}{2}$ "=1'-0"

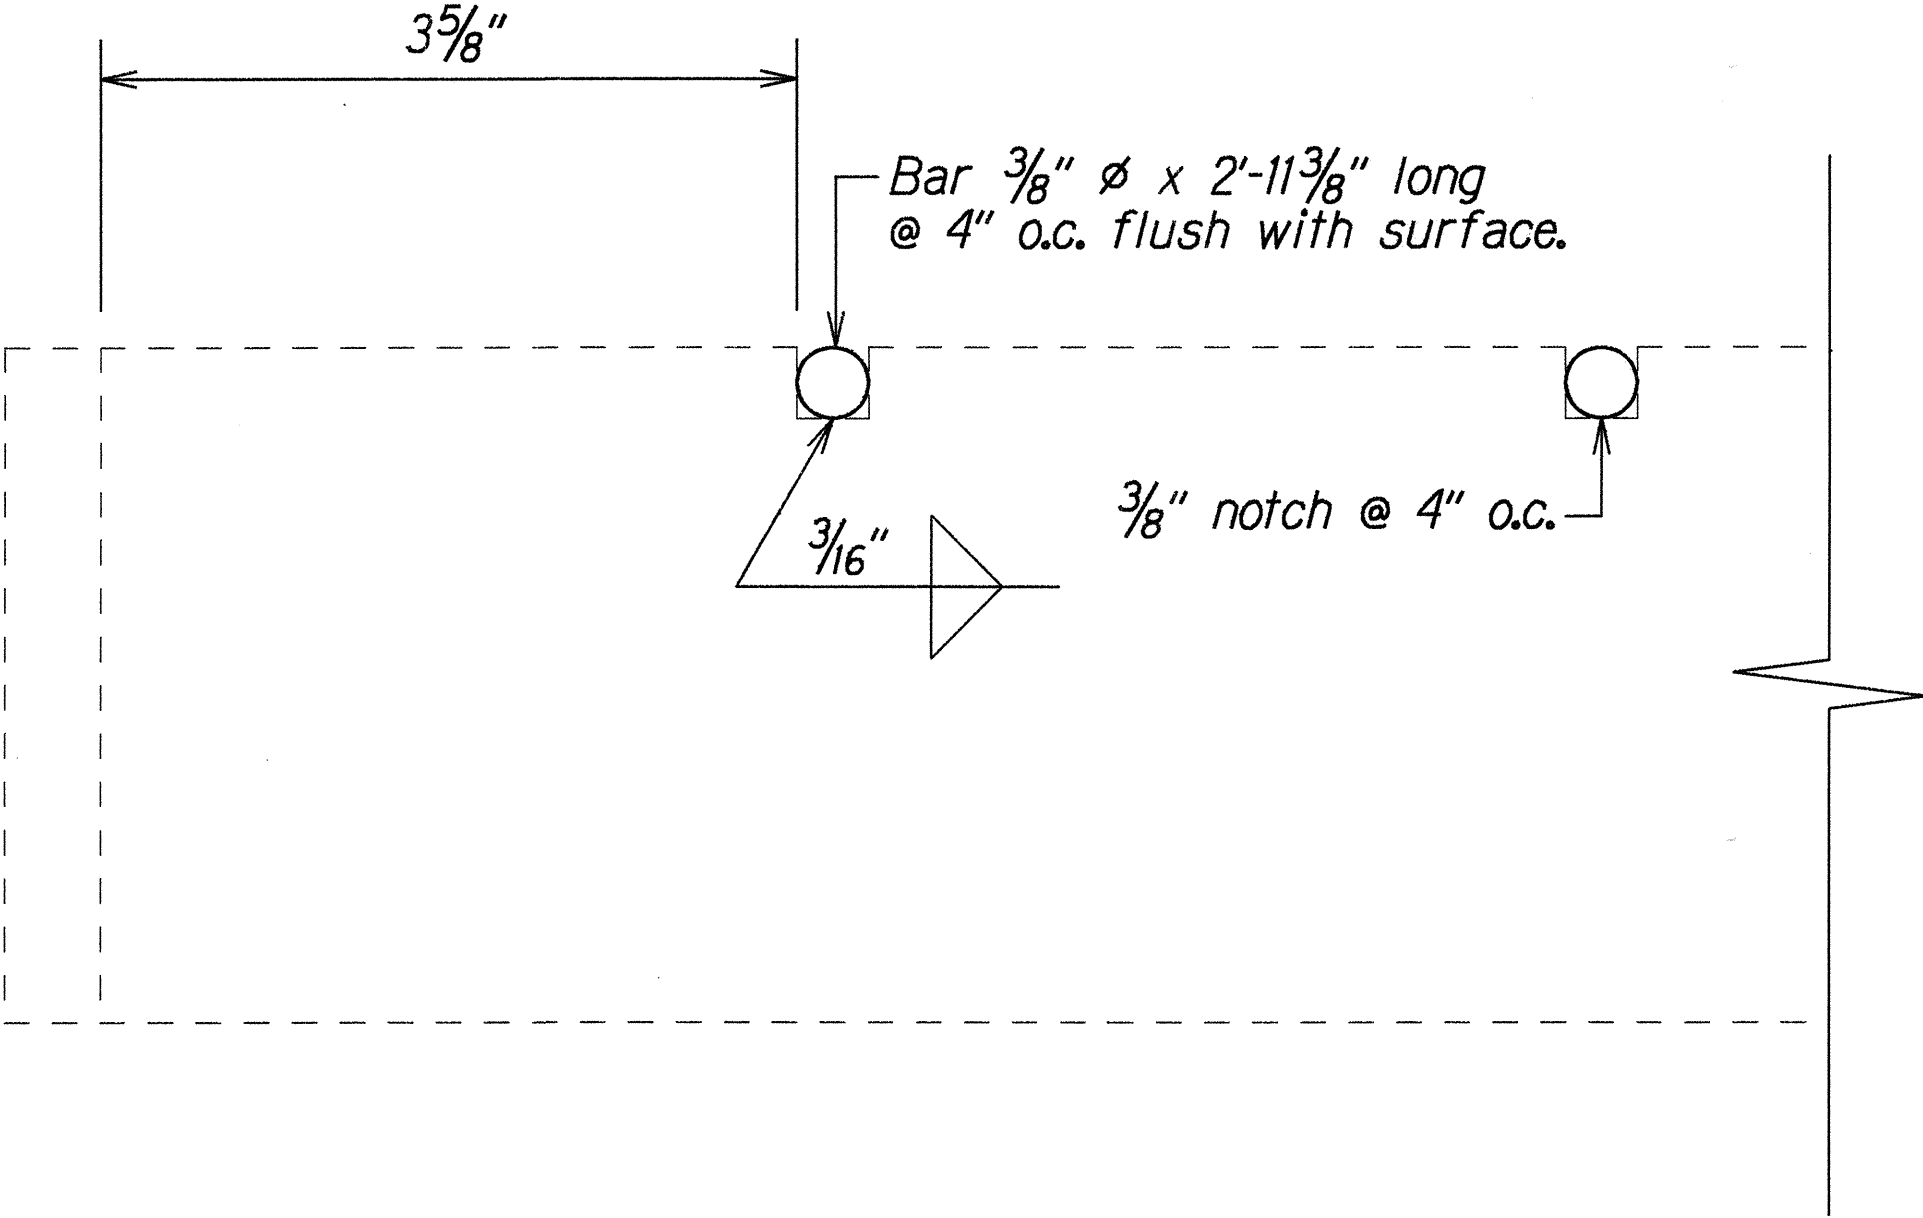

NOTCH DETAIL
Scale: Full Size

NOTE:


- Existing Drainage System shall be functional at all times.
- Grated Drop Inlets shall not be left open while the existing grates are being modified.
- The grate shall be cleaned of all rust and bent bars shall be straightened before the notches are cut.
- The grate shall be galvanized after the $\frac{3}{8}$ " ϕ bars are welded into the notches.
- Grates shall fit into the frames of existing grated drop inlets without rocking. Any adjustments to the grate shall be done before galvanizing.

61616M STEEL GRATE DETAILS

ORIGINAL PLAN	SURVEY PLOTTED BY	DATE
NOTE BOOK	DRAWN BY	5/22/96
DESIGNED BY	DESIGNED BY	
QUANTITIES BY	QUANTITIES BY	
CHECKED BY	CHECKED BY	

6/14/96	Details added to complete drainage plan.
DATE	REVISION

STATE OF HAWAII DEPARTMENT OF TRANSPORTATION HIGHWAYS DIVISION
<u>DRAINAGE DETAILS</u>
<u>KALANIANA'OLE HIGHWAY RESURFACING</u>
<u>Kailua Rd. to Hilo St.</u>
<u>Project No. 72A-01-96M</u>
Scale: As Shown Date: May 1996
SHEET No. H12H OF 12 SHEETS

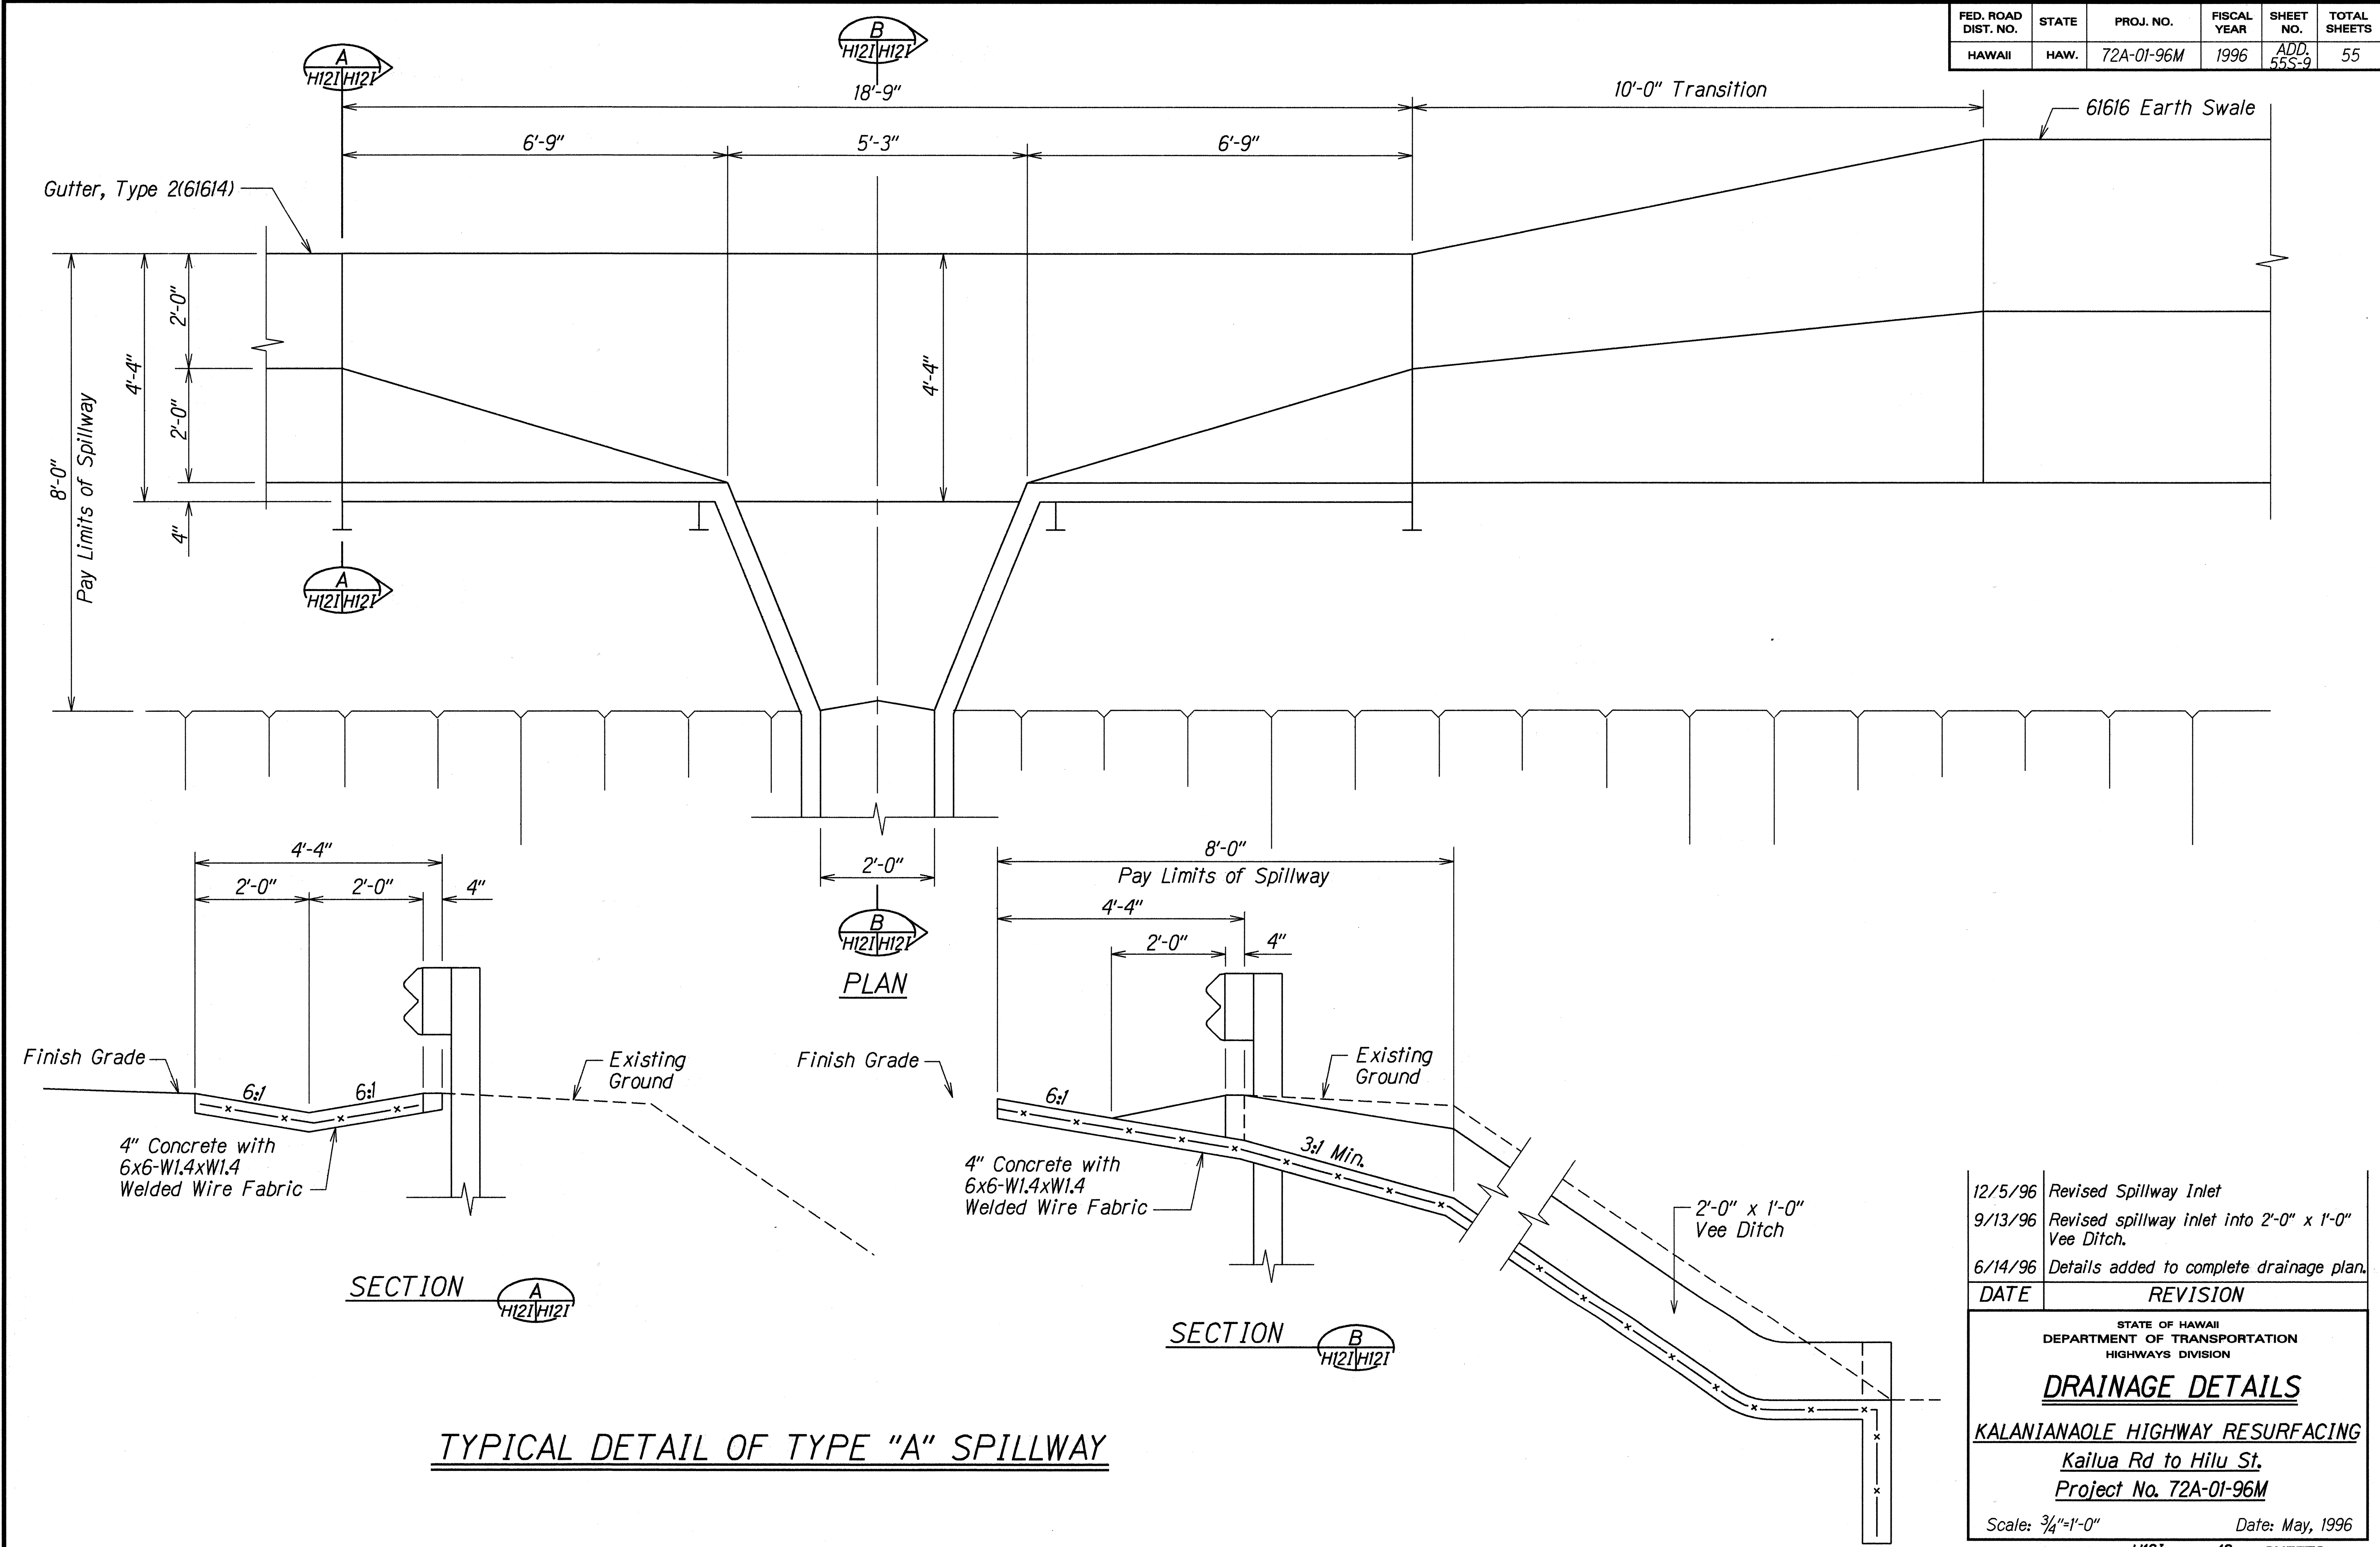

12/5/96	<i>Revised Spillway Inlet</i>
9/13/96	<i>Revised spillway inlet into 2'-0" x 1'-0" Vee Ditch.</i>
6/14/96	<i>Details added to complete drainage plan.</i>
DATE	REVISION

STATE OF HAWAII
DEPARTMENT OF TRANSPORTATION
HIGHWAYS DIVISION








DRAINAGE DETAILS

KALANIANA'OLE HIGHWAY RESURFACING
Kailua Rd to Hilu St.
Project No. 72A-01-96M

Scale: $\frac{3}{4}" = 1'-0"$ Date: May, 1996

C.O. ADD. 55S-9

FED. ROAD DIST. NO.	STATE	PROJ. NO.	FISCAL YEAR	SHEET NO.	TOTAL SHEETS
HAWAII	HAW.	72A-01-96M	1996	ADD. 55S-10	55

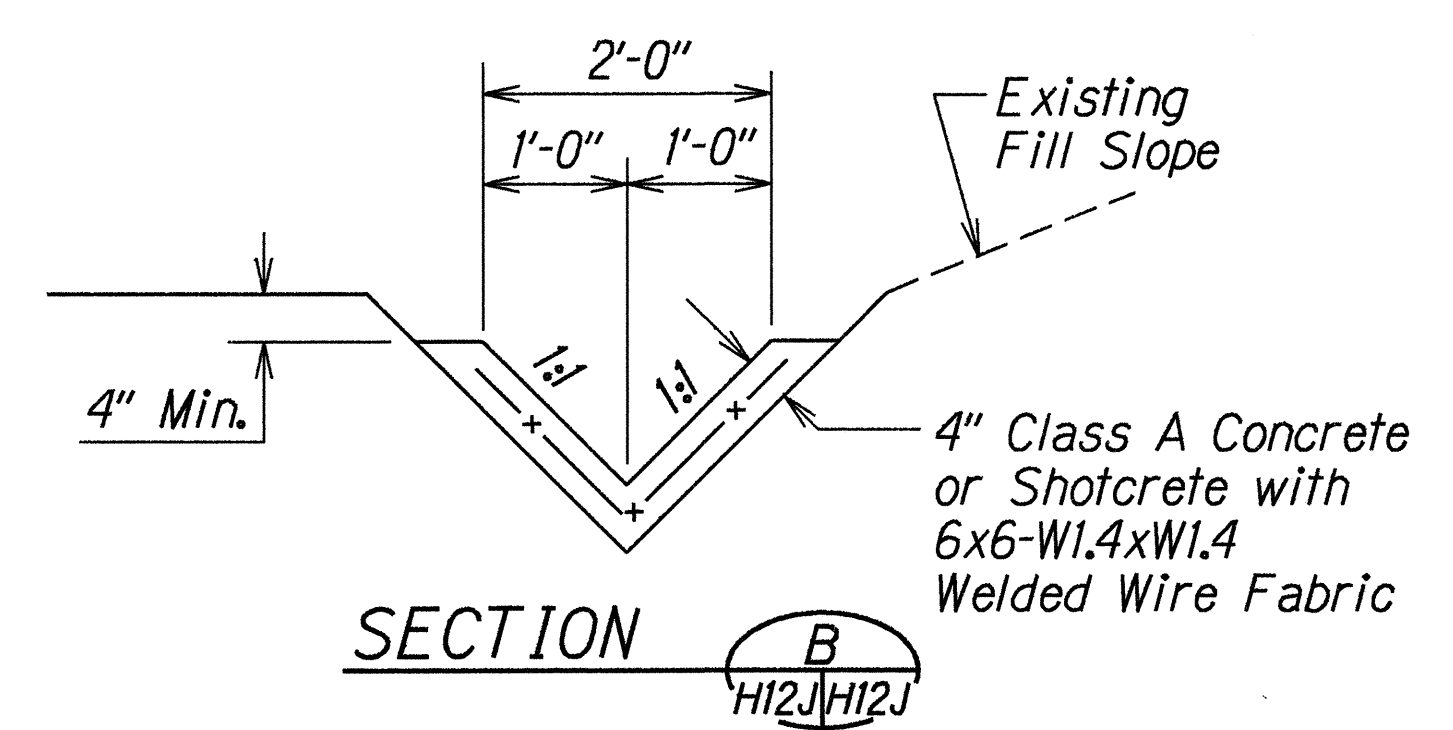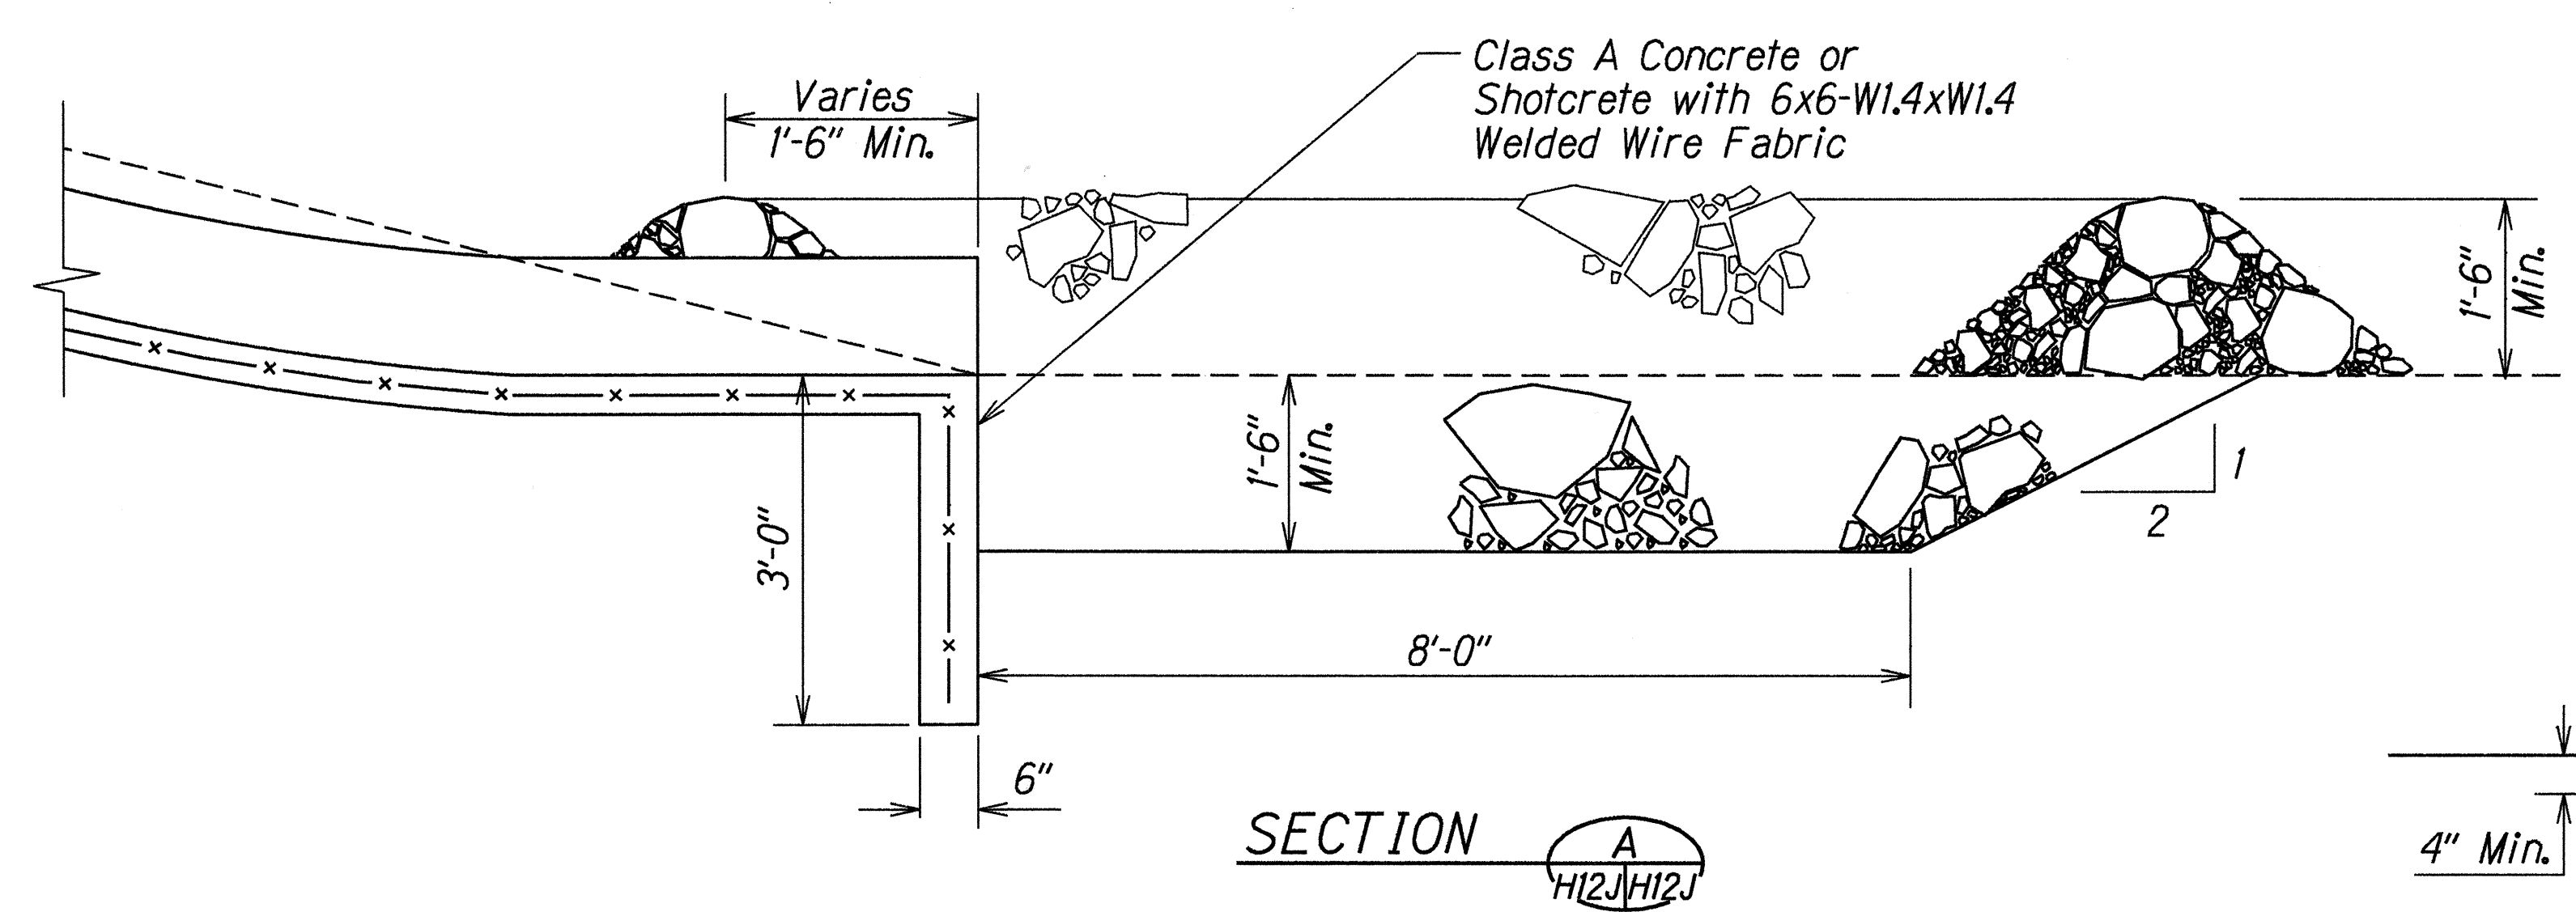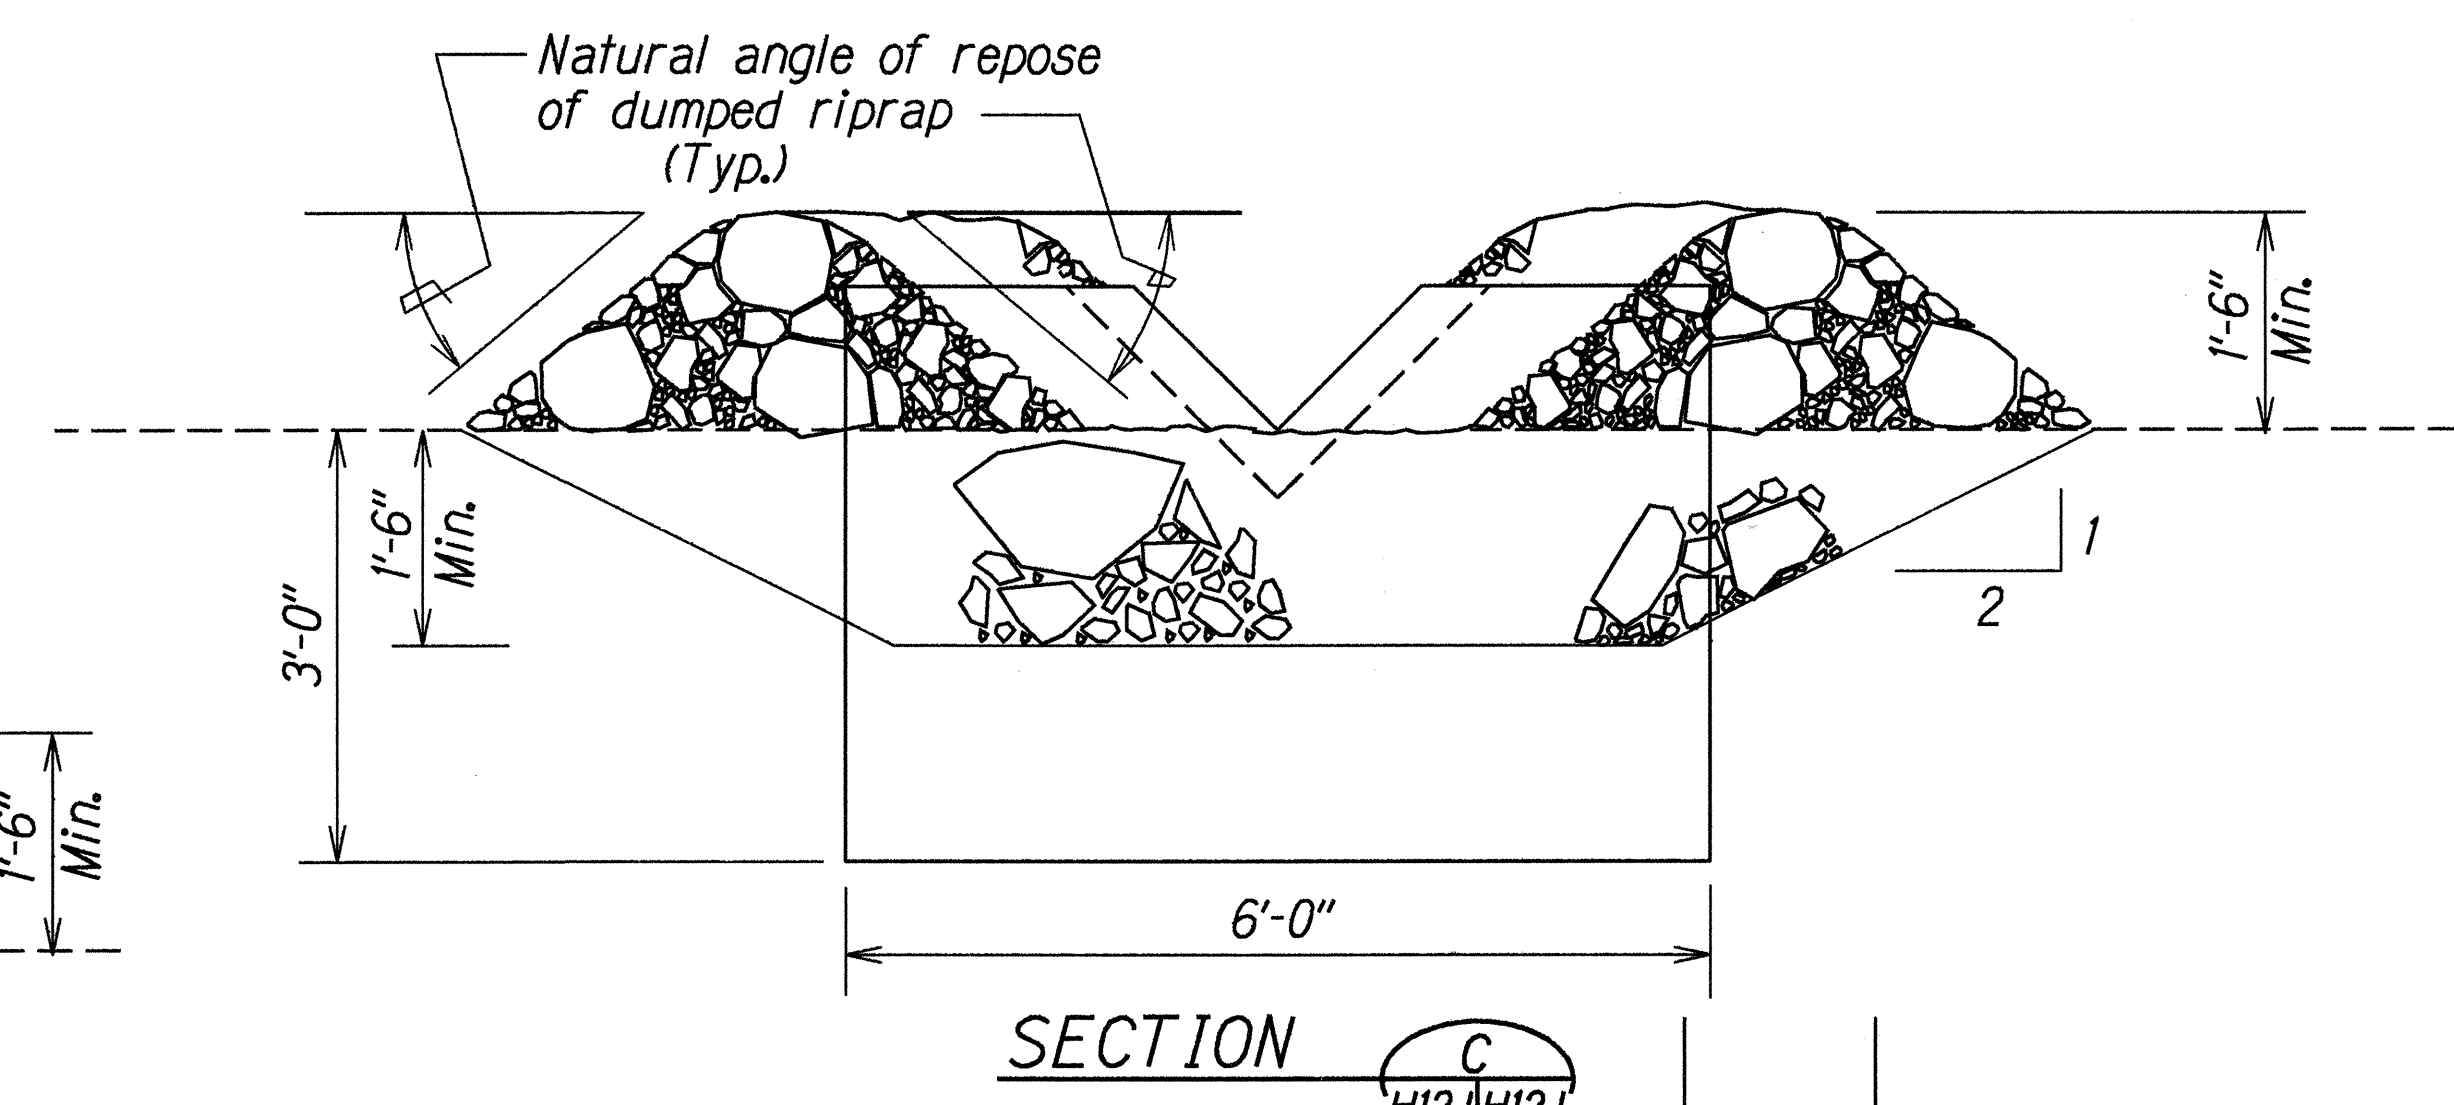
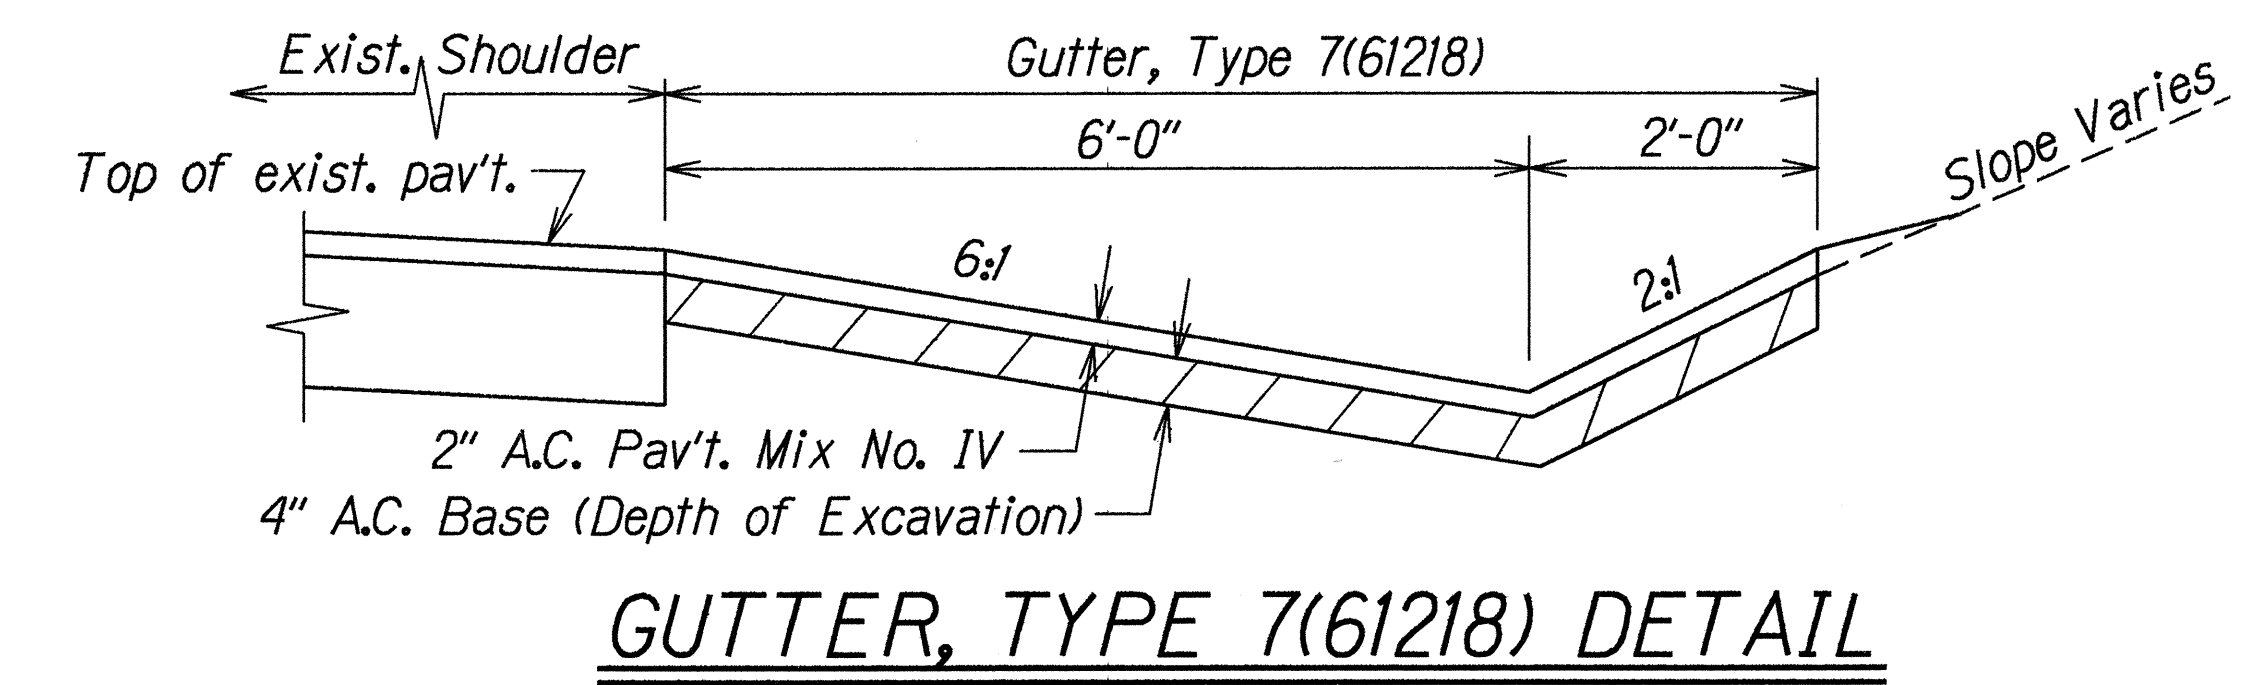
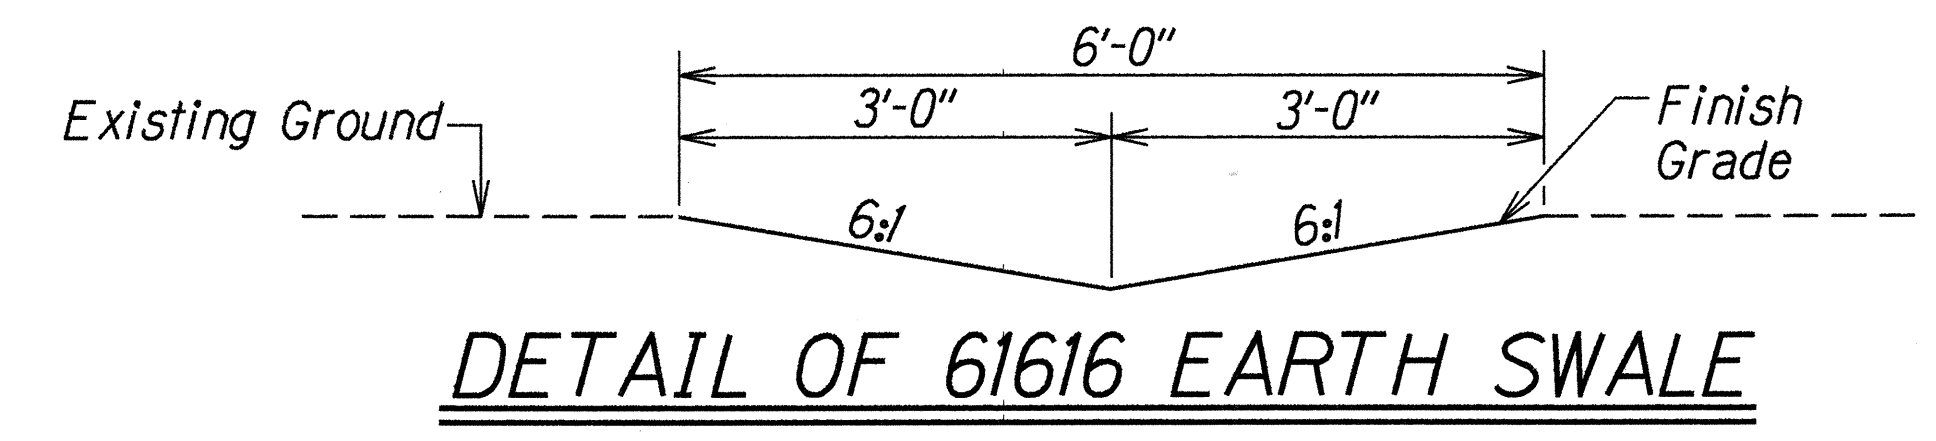
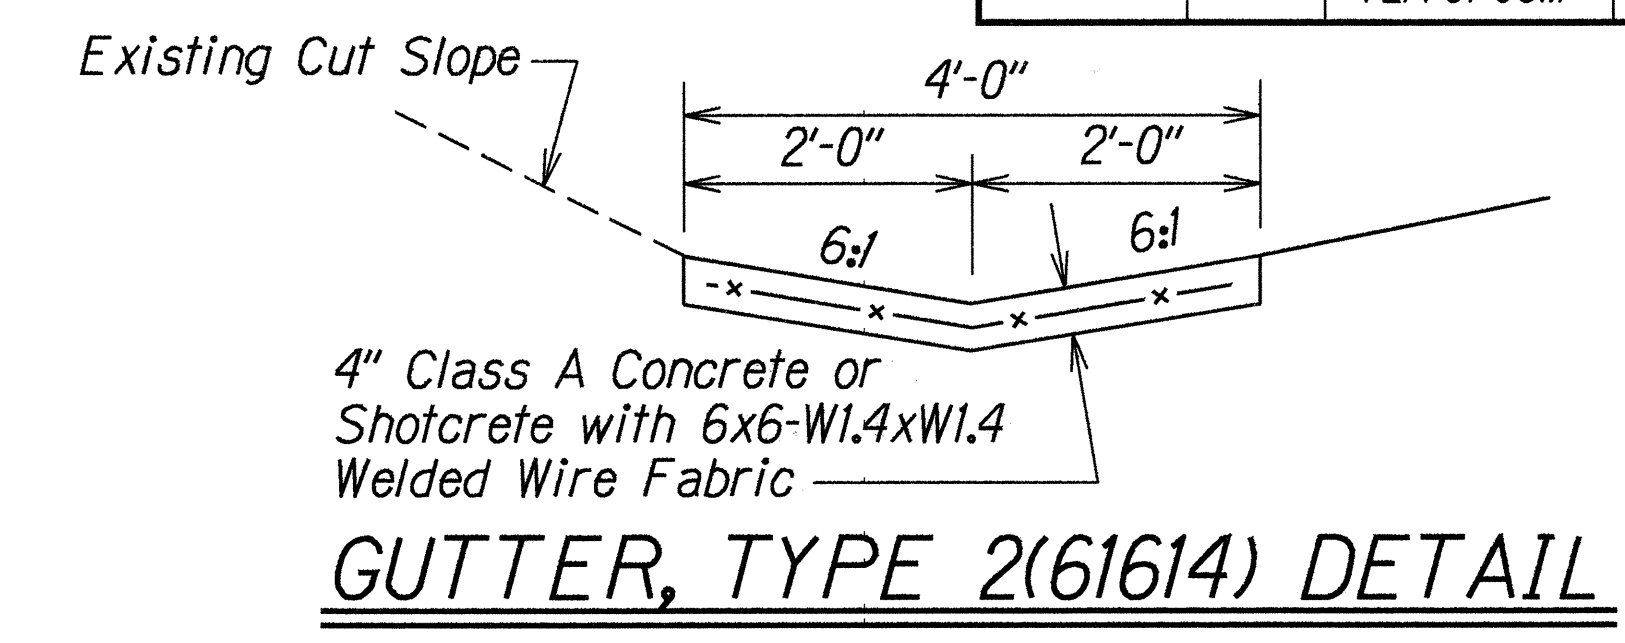
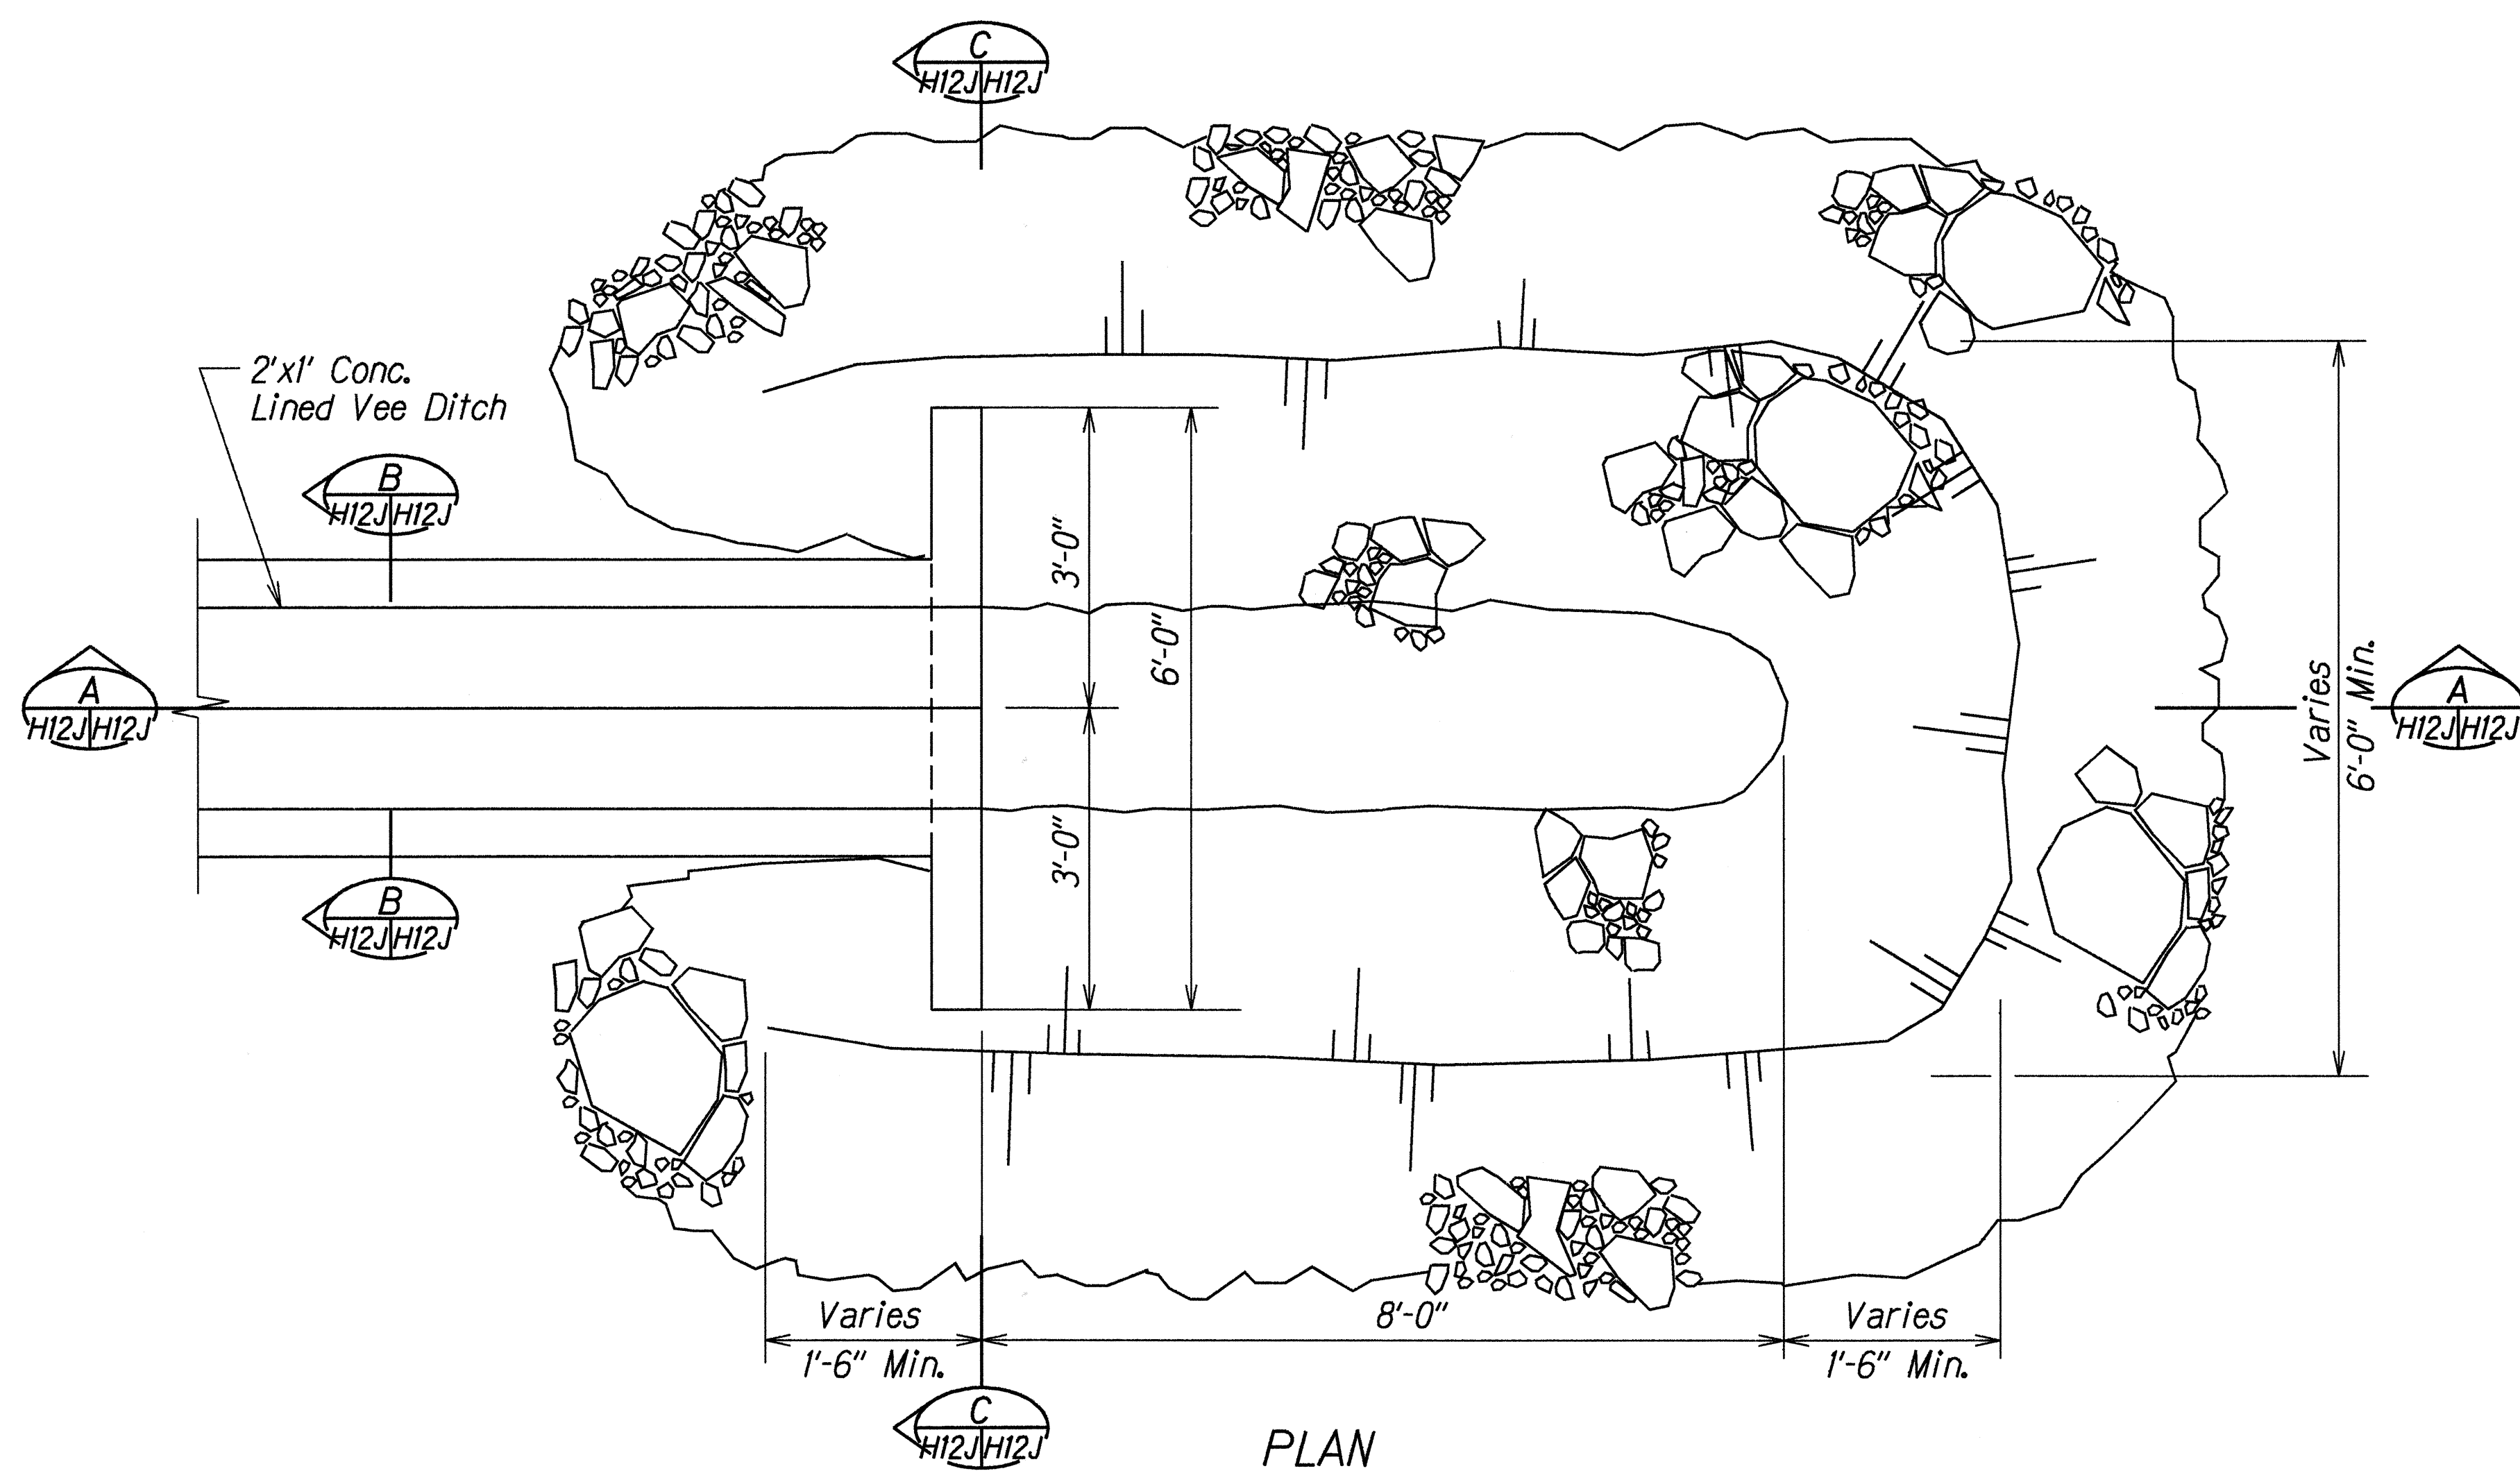


2'x1' CONCRETE LINED VEE DITCH

9/13/96	Class B Concrete changed to Class A.
6/14/96	Details added to complete drainage plan.
DATE	REVISION
STATE OF HAWAII DEPARTMENT OF TRANSPORTATION HIGHWAYS DIVISION	
DRAINAGE DETAILS	
KALANIANA'OLE HIGHWAY RESURFACING	
Kailua Rd. to Hilo St.	
Project No. 72A-01-96M	
Scale: 3/4"=1'-0"	Date: May 1996
SHEET No. H12J OF 12 SHEETS	

ORIGINAL PLAN	DATE
DESIGNED BY	5/27/96
NOTED BY	
CHECKED BY	
QUANTITIES BY	
DESIGNED BY	
NOTED BY	
CHECKED BY	
QUANTITIES BY	

FED. ROAD DIST. NO.	STATE	FED. AID PROJ. NO.	FISCAL YEAR	SHEET NO.	TOTAL SHEETS
HAWAII	HAW.	72A-01-96M	1996	C.O. 55S-11	55

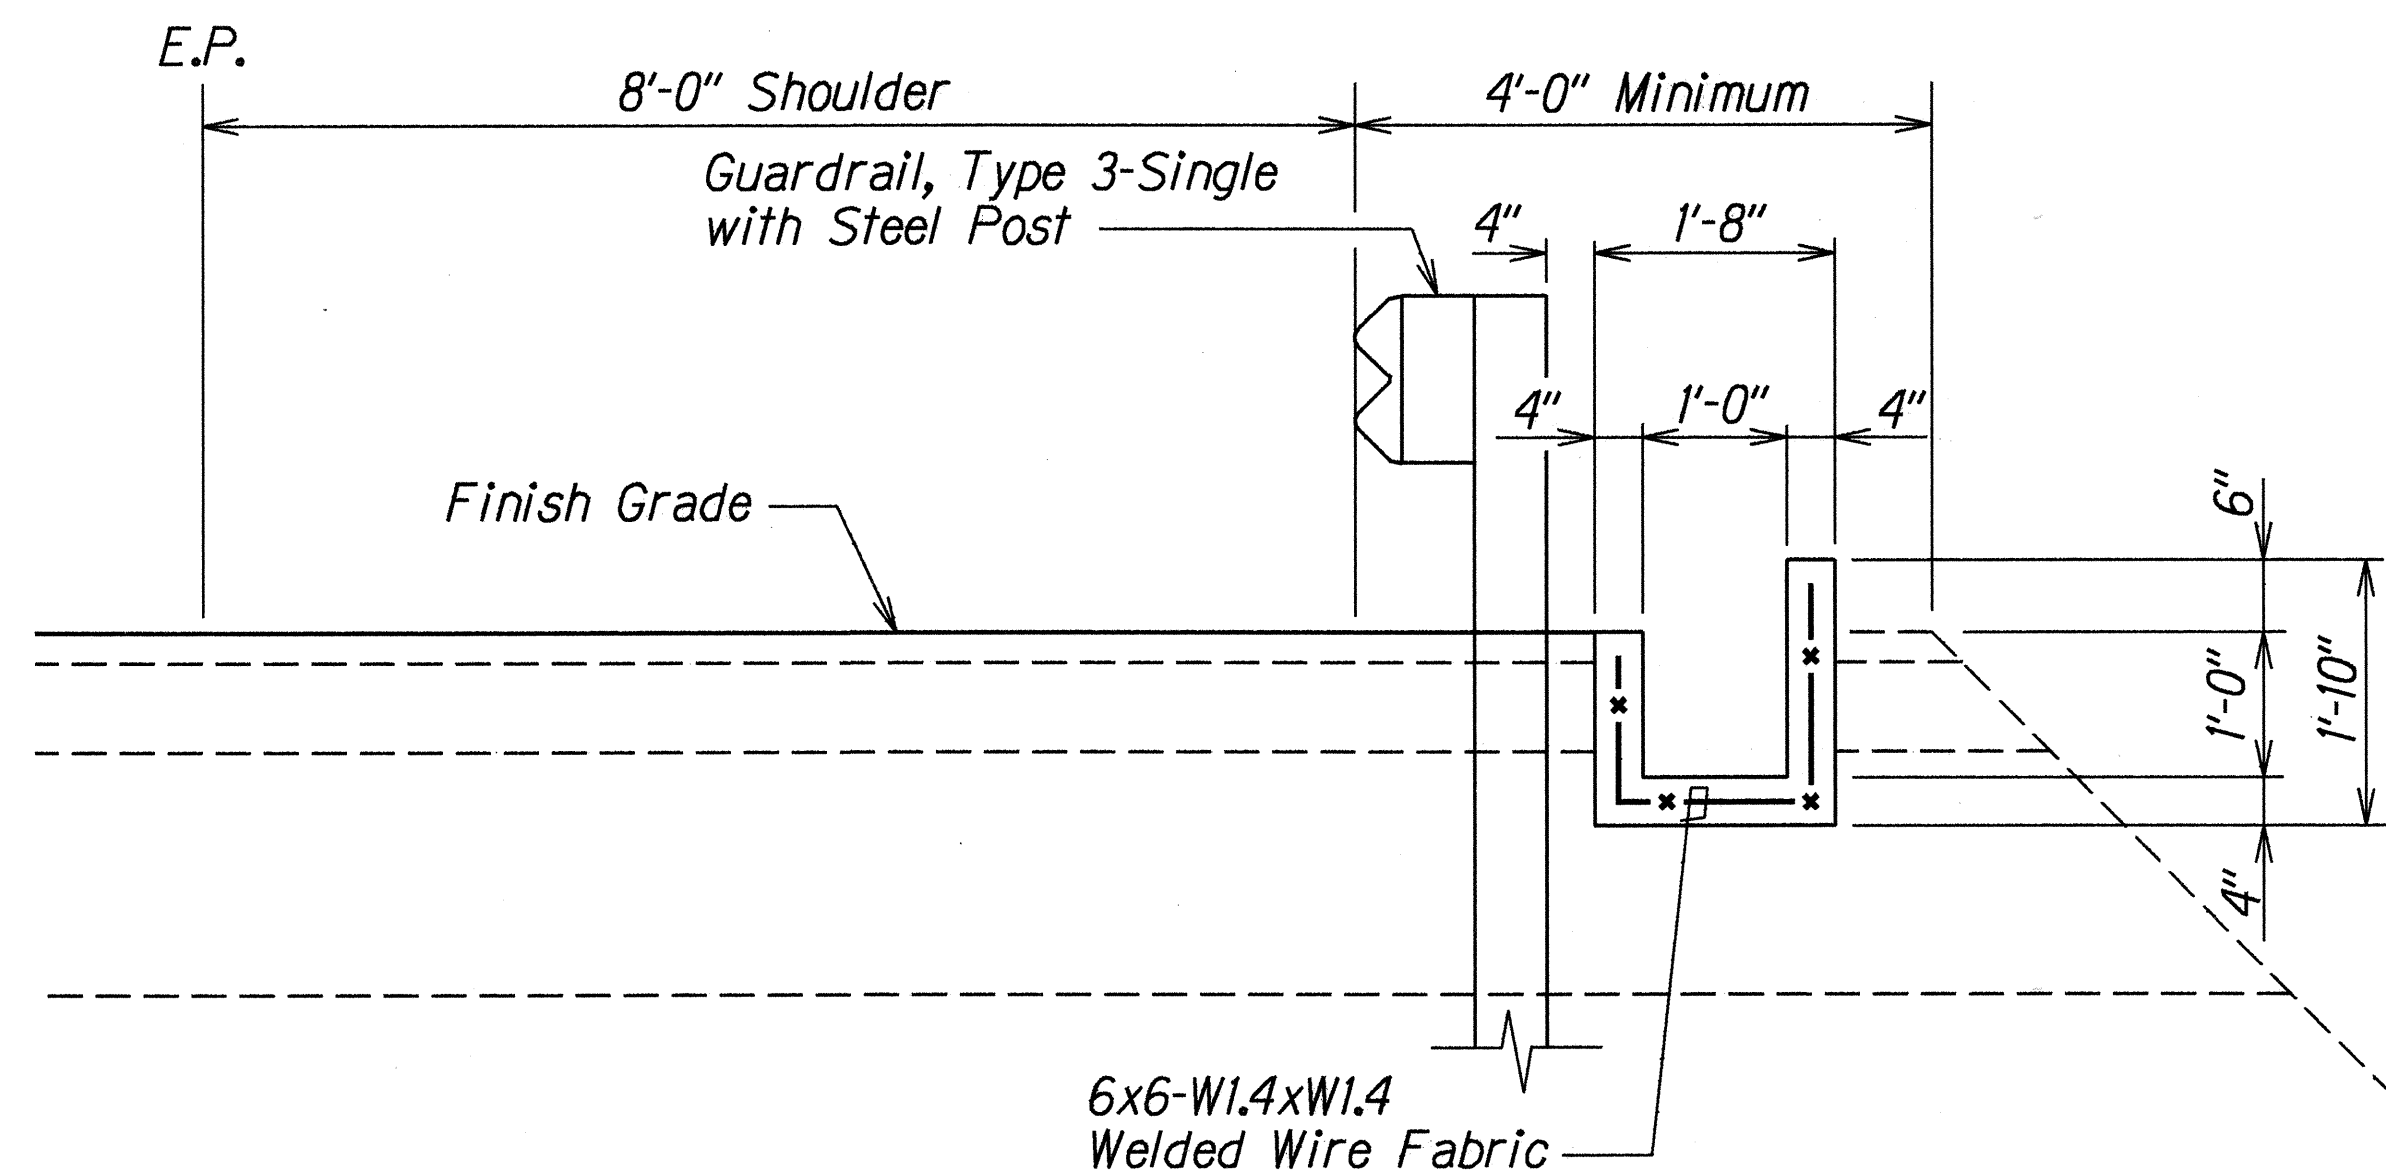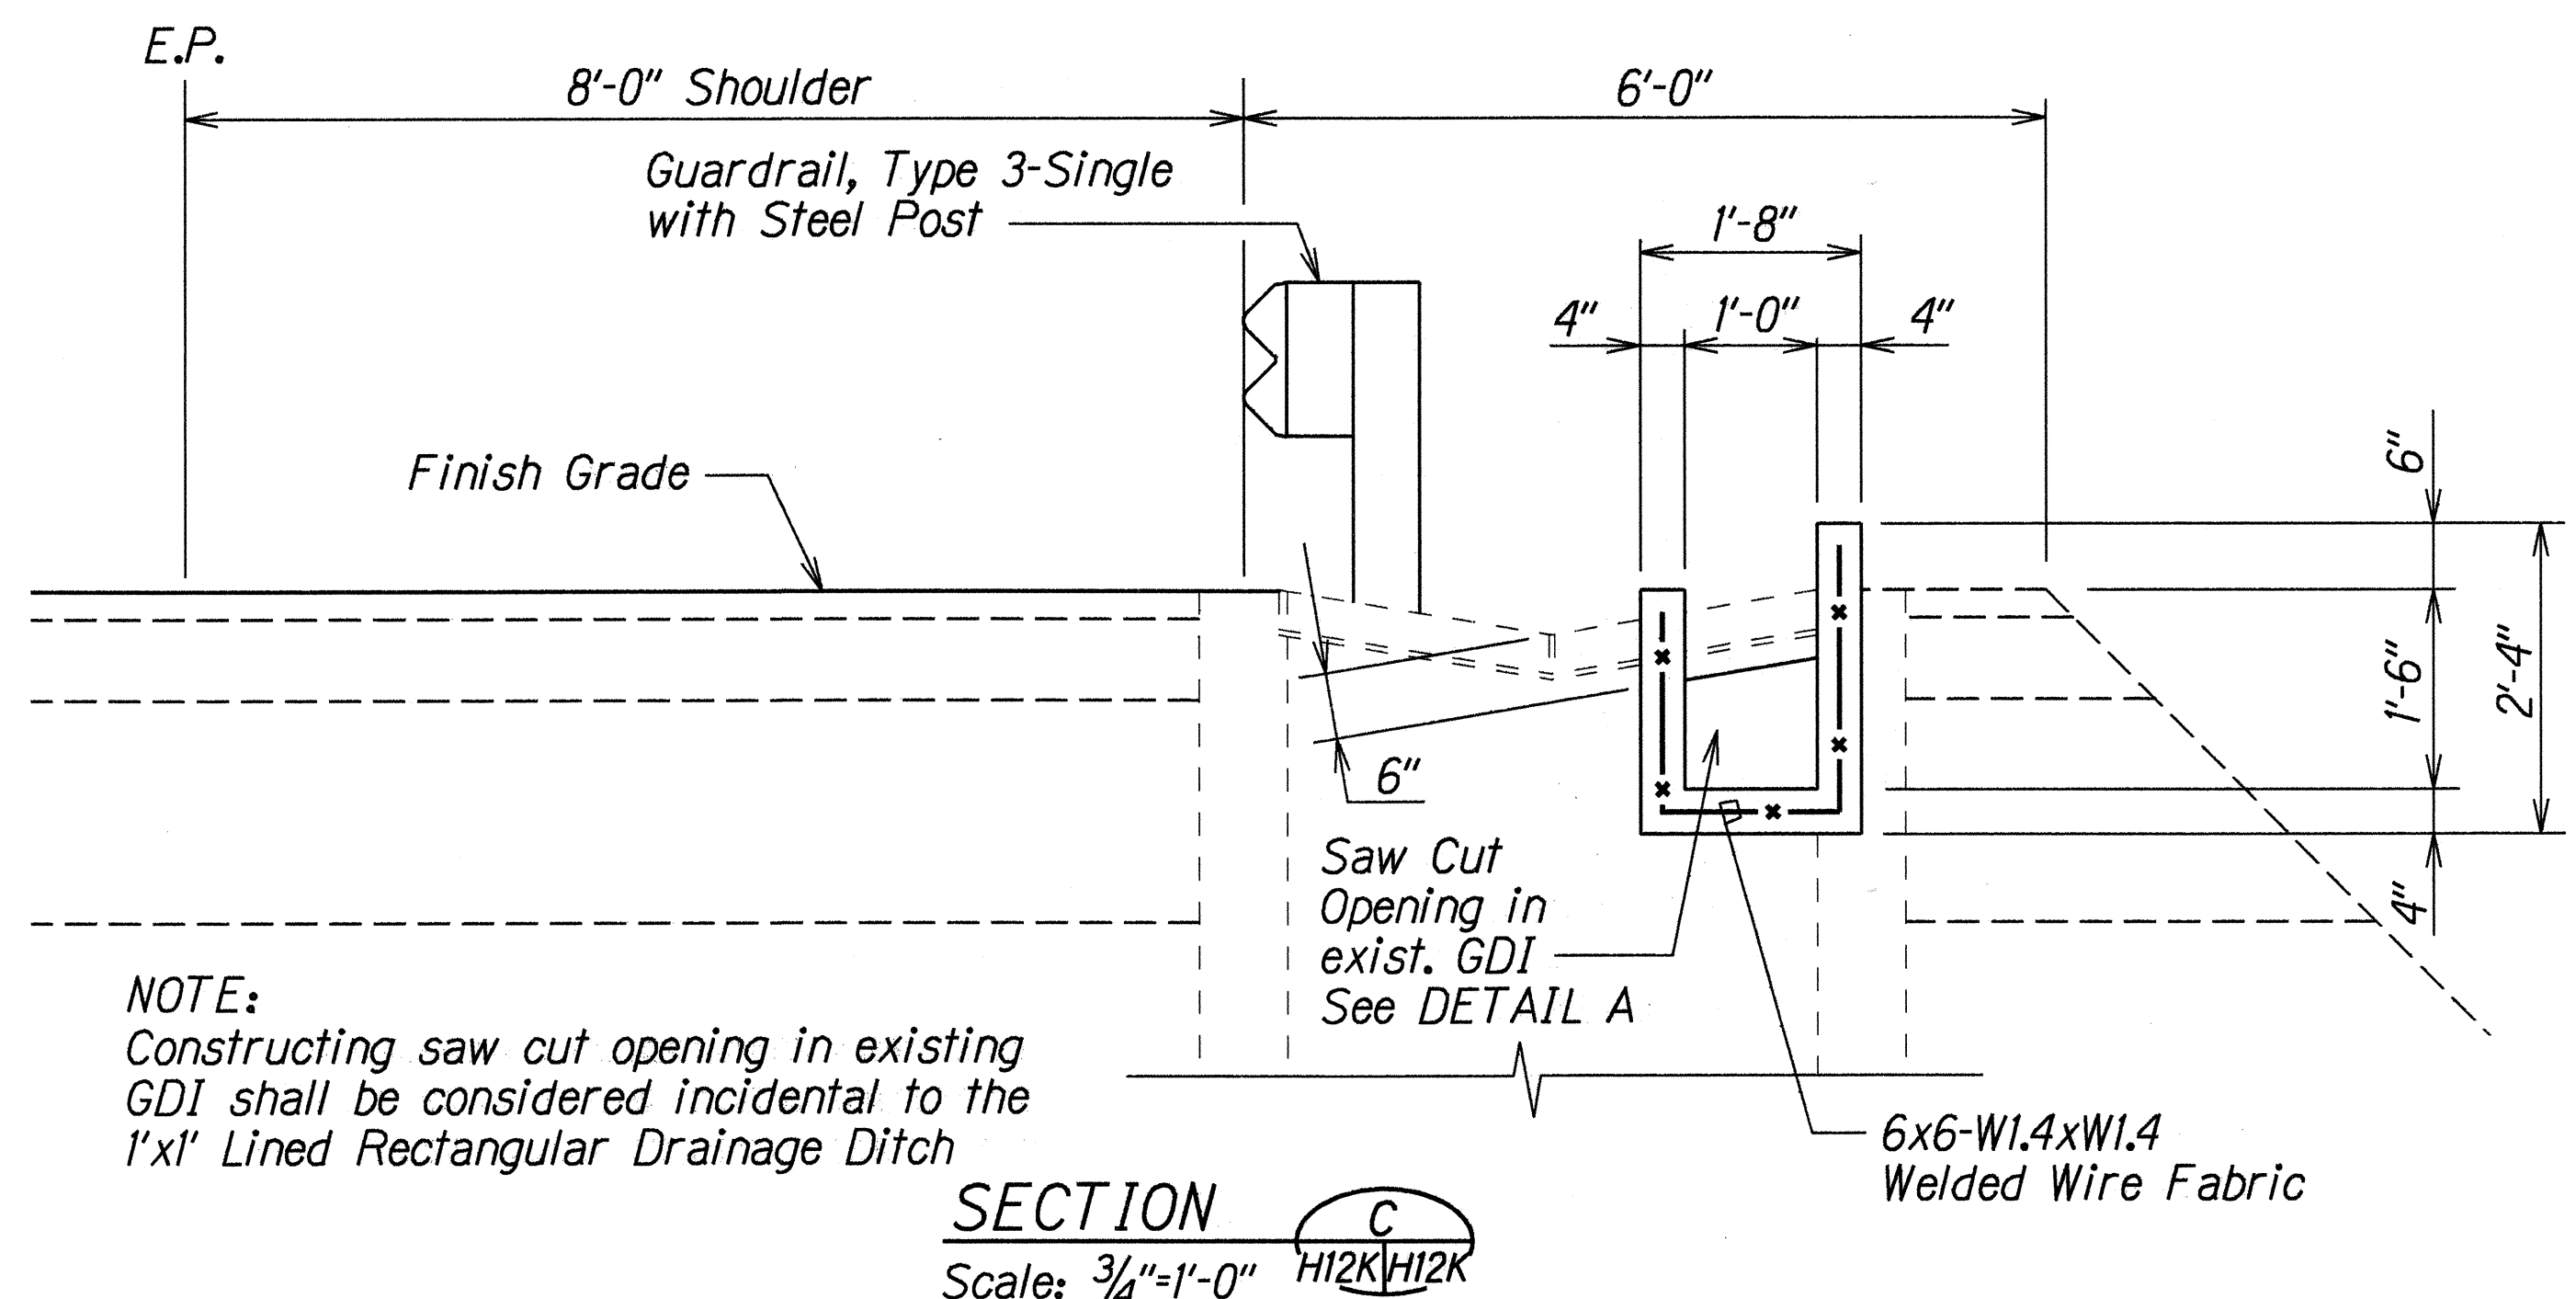
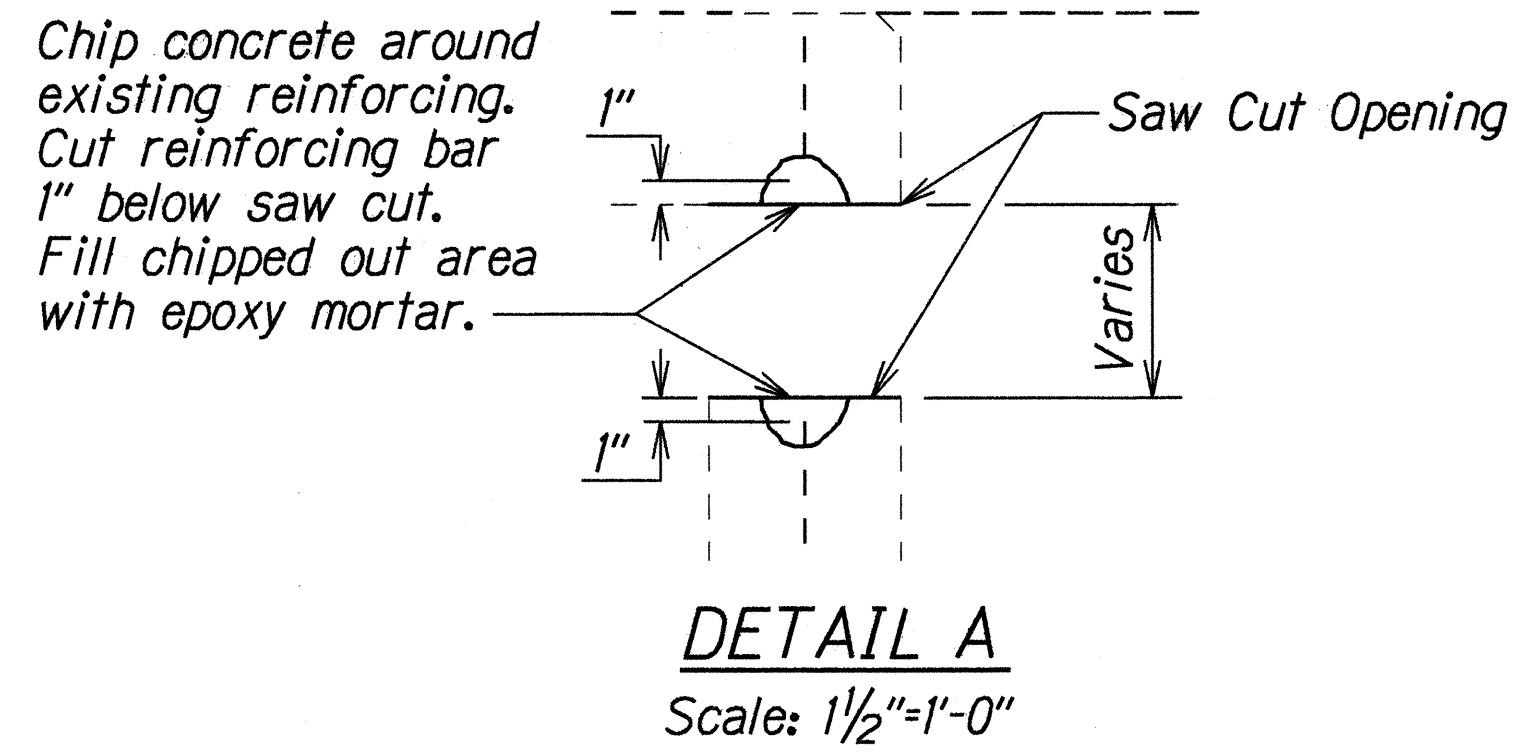
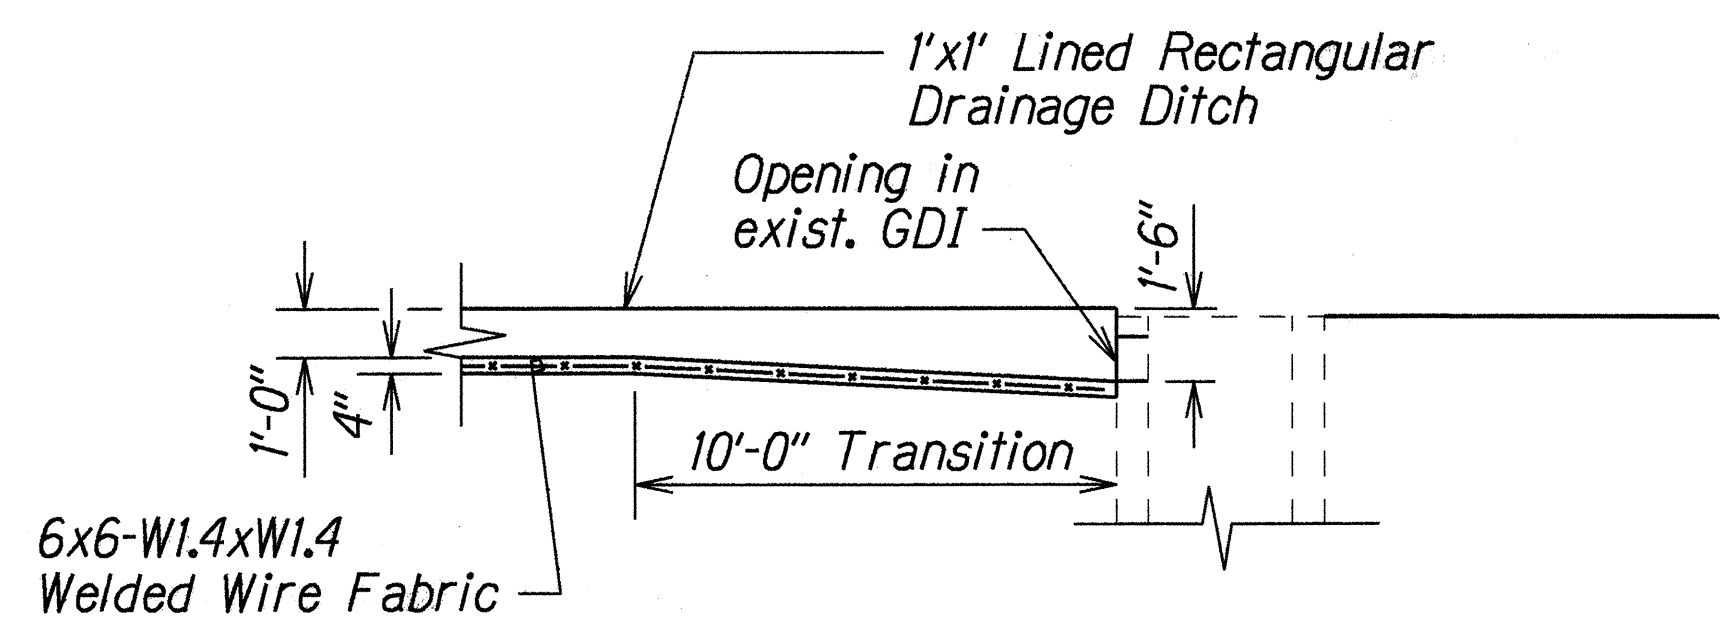
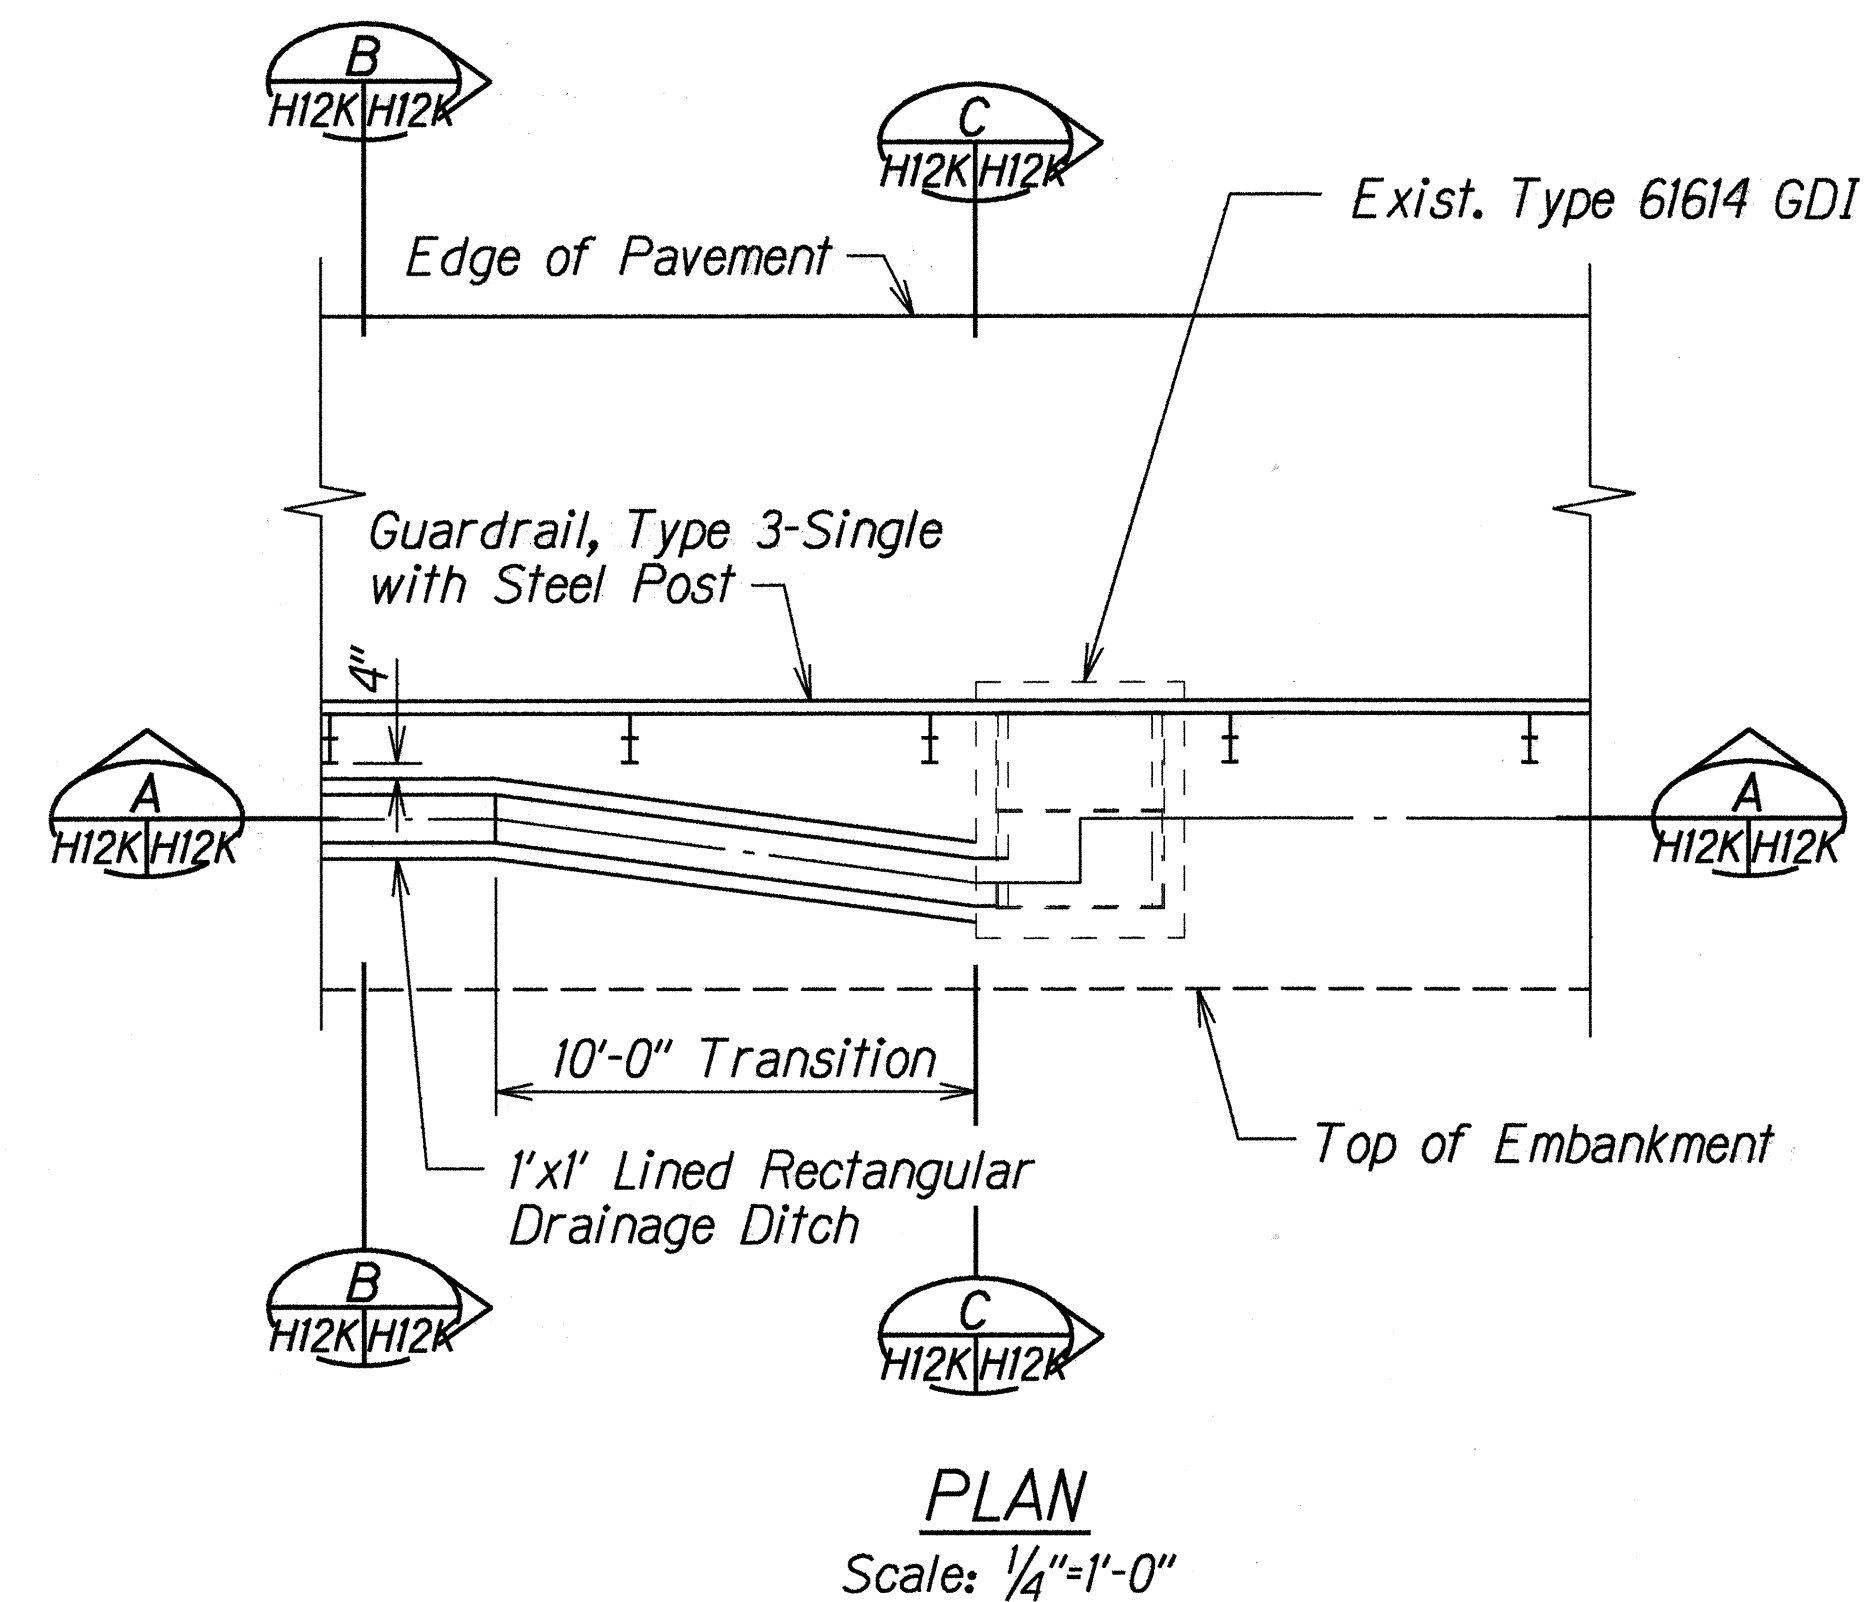


12/5/96	Delete Portion of 1'x1' Lined Rectangular Drainage Ditch.
9/13/96	Sheet added to show details of 1'x1' Lined Rectangular Drainage Ditch.
DATE	REVISION
STATE OF HAWAII DEPARTMENT OF TRANSPORTATION HIGHWAYS DIVISION DRAINAGE DETAILS KALANIANA'OLE HIGHWAY RESURFACING Kailua Rd. to Hilu St. Project No. 72A-01-96M Scale: As Shown Date: Jul. 1996 SHEET No. H12K OF 12 SHEETS	

SURVEY PLOTTED BY	DATE
DESIGNED BY	7/24/96
CHECKED BY	
NOTED BY	
QUANTITIES BY	
CHECKED BY	

DETAIL OF 1' x 1' LINED RECTANGULAR DRAINAGE DITCH

FED. ROAD DIST. NO.	STATE	FED. AID PROJ. NO.	FISCAL YEAR	SHEET NO.	TOTAL SHEETS
HAWAII	HAW.	72A-01-96M	1997	C.O. 55S-12	55

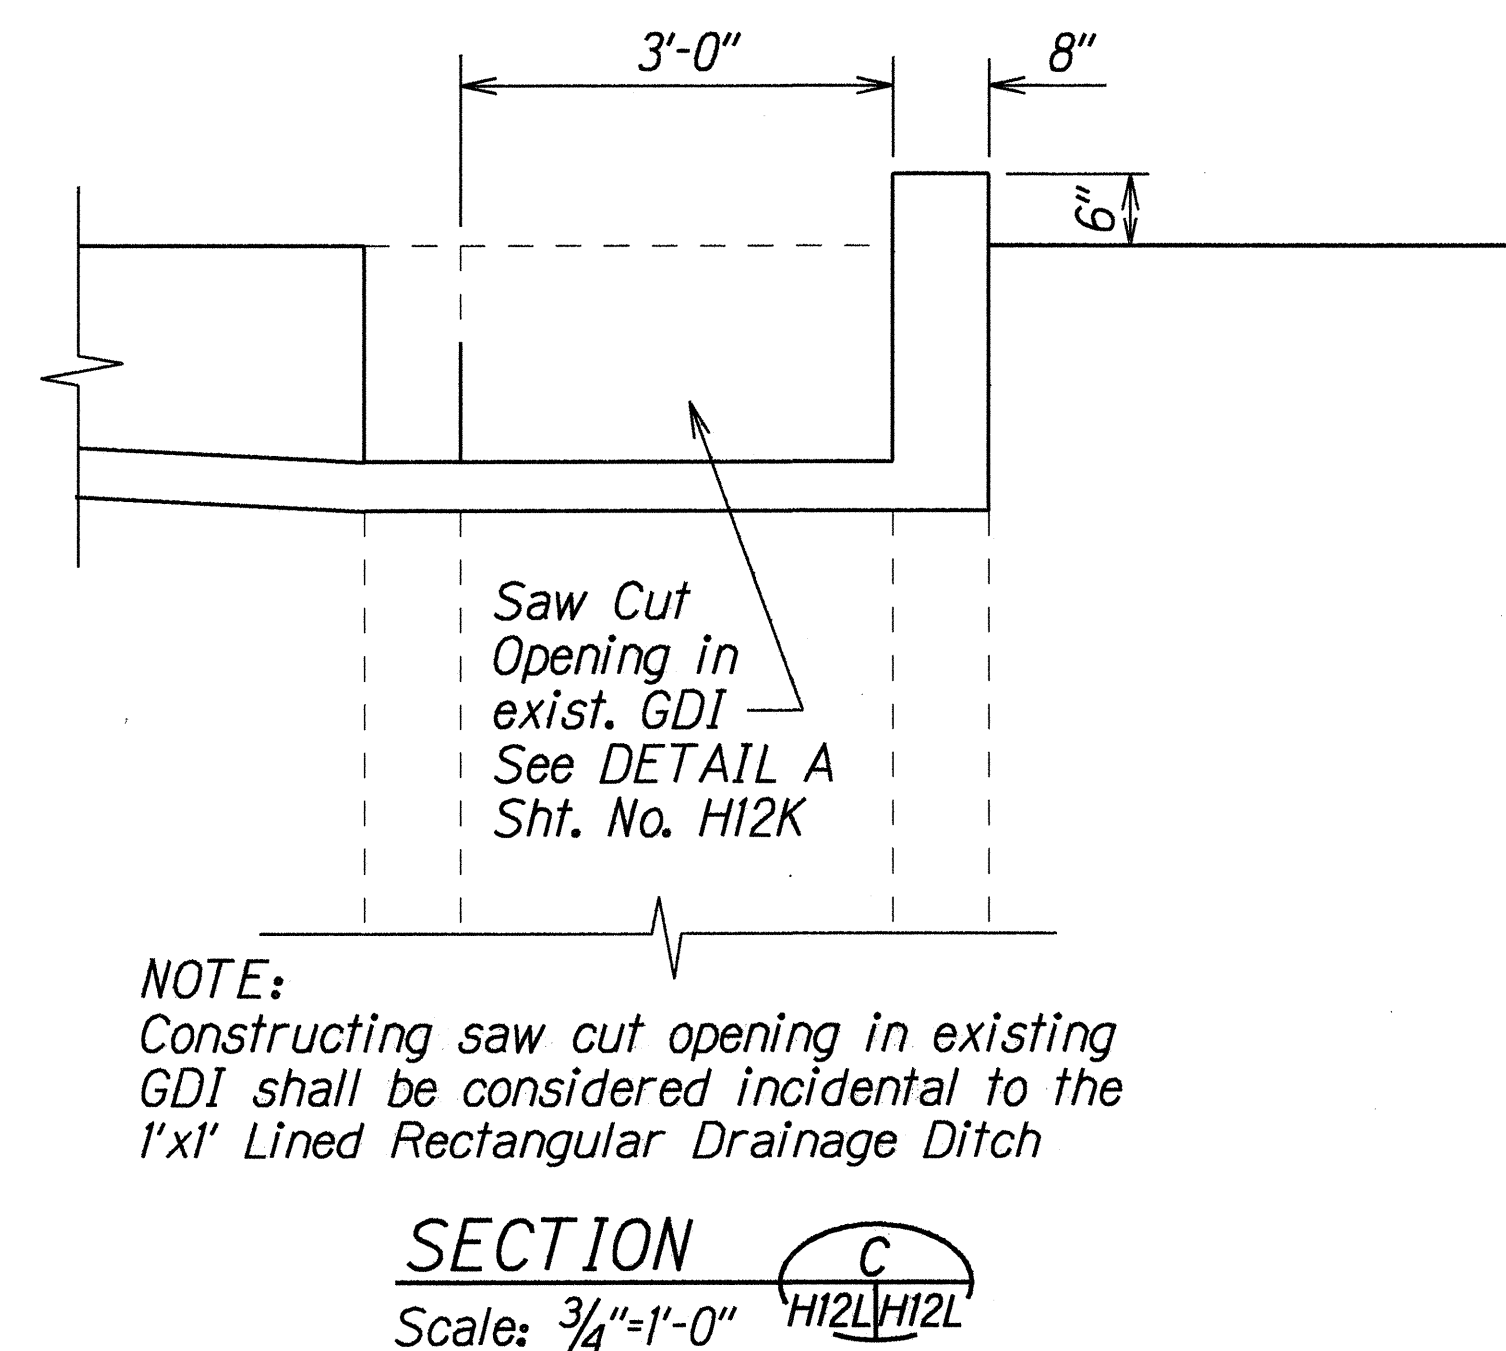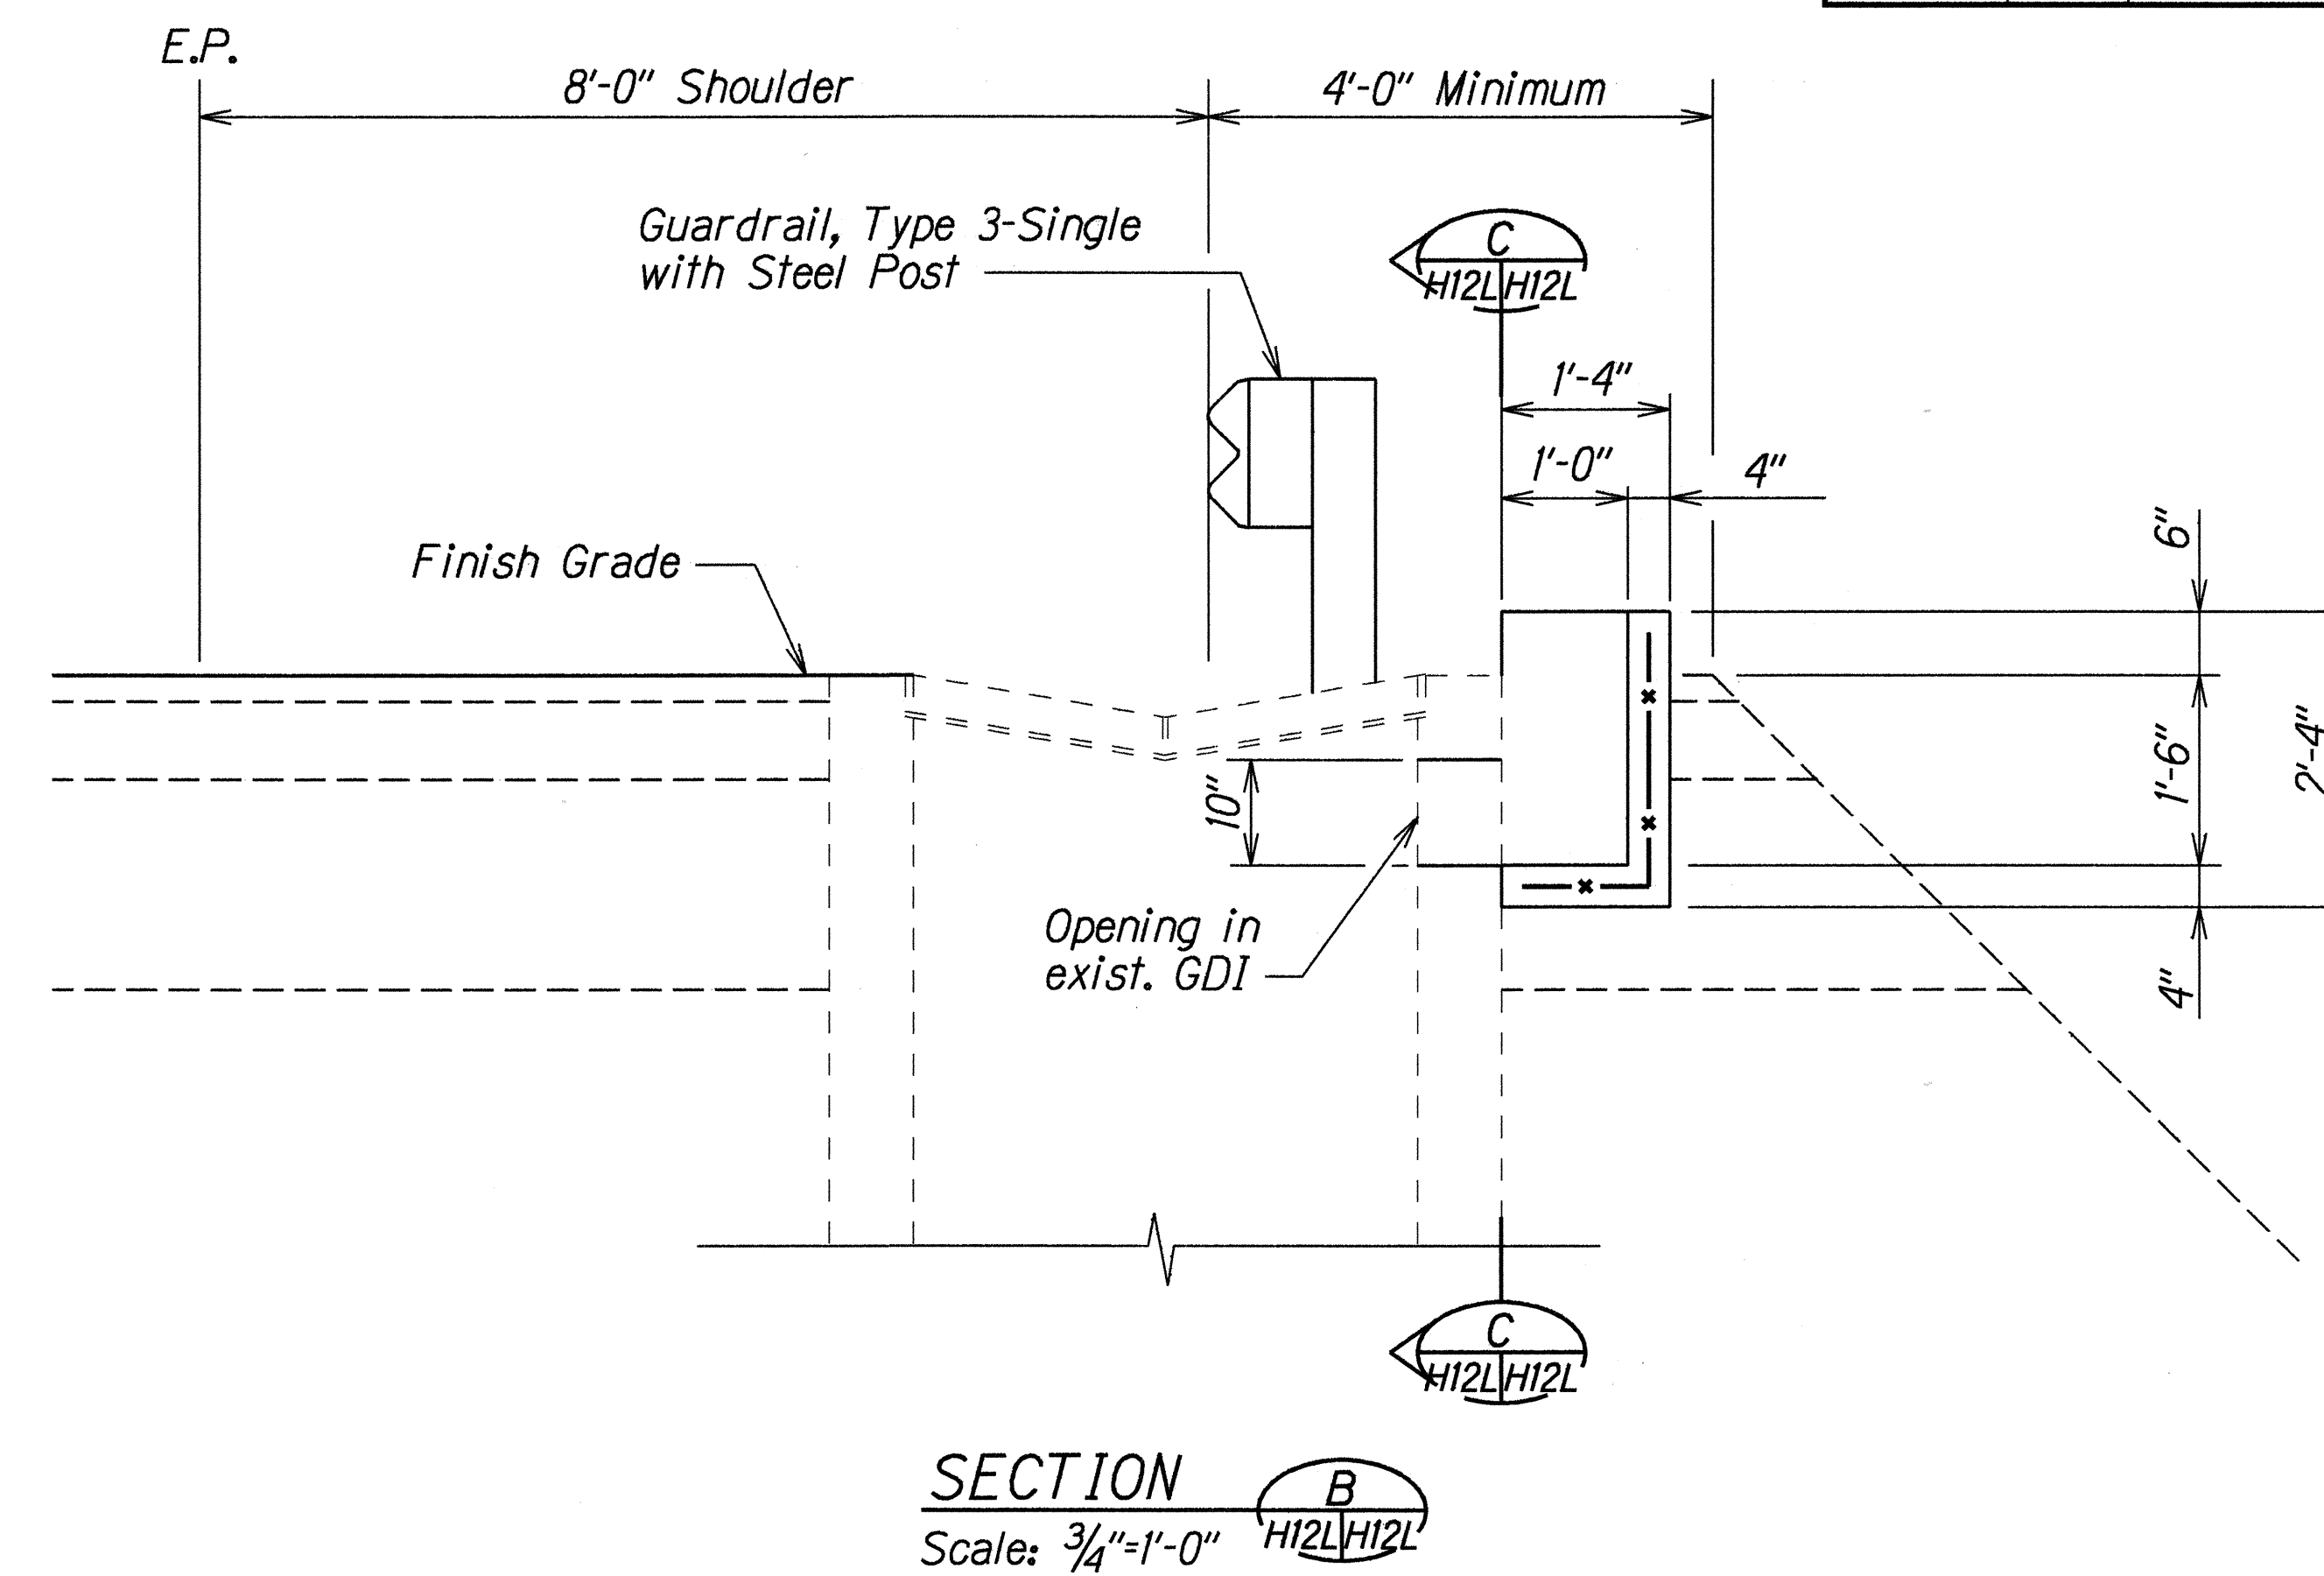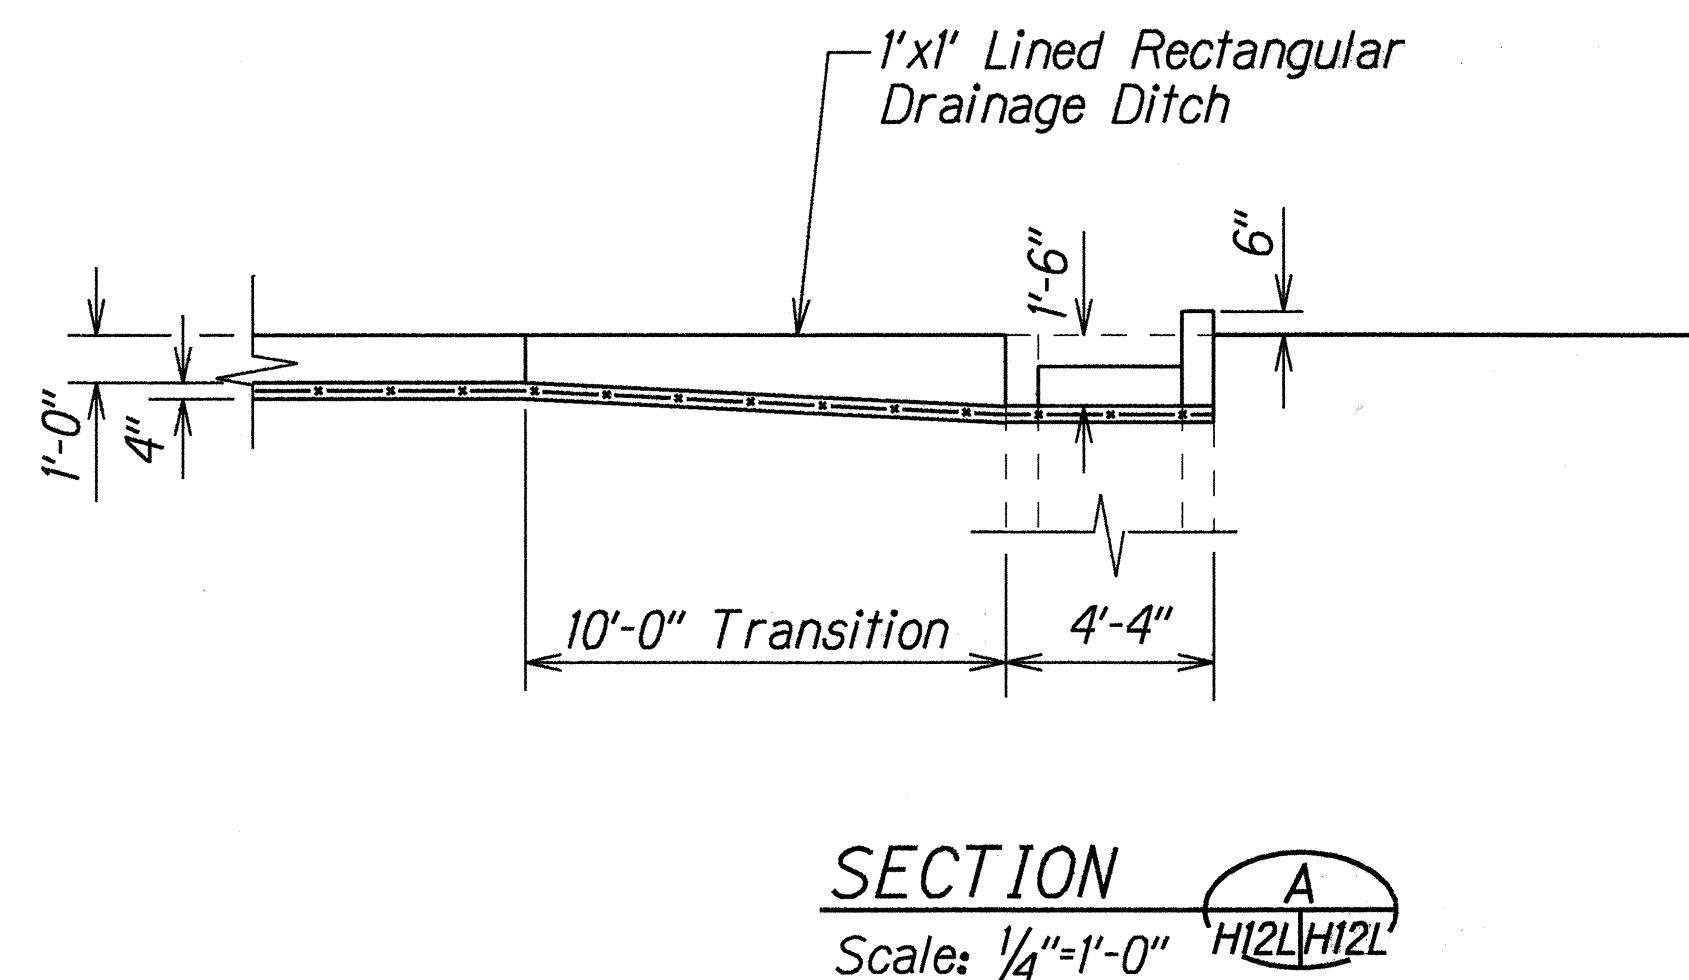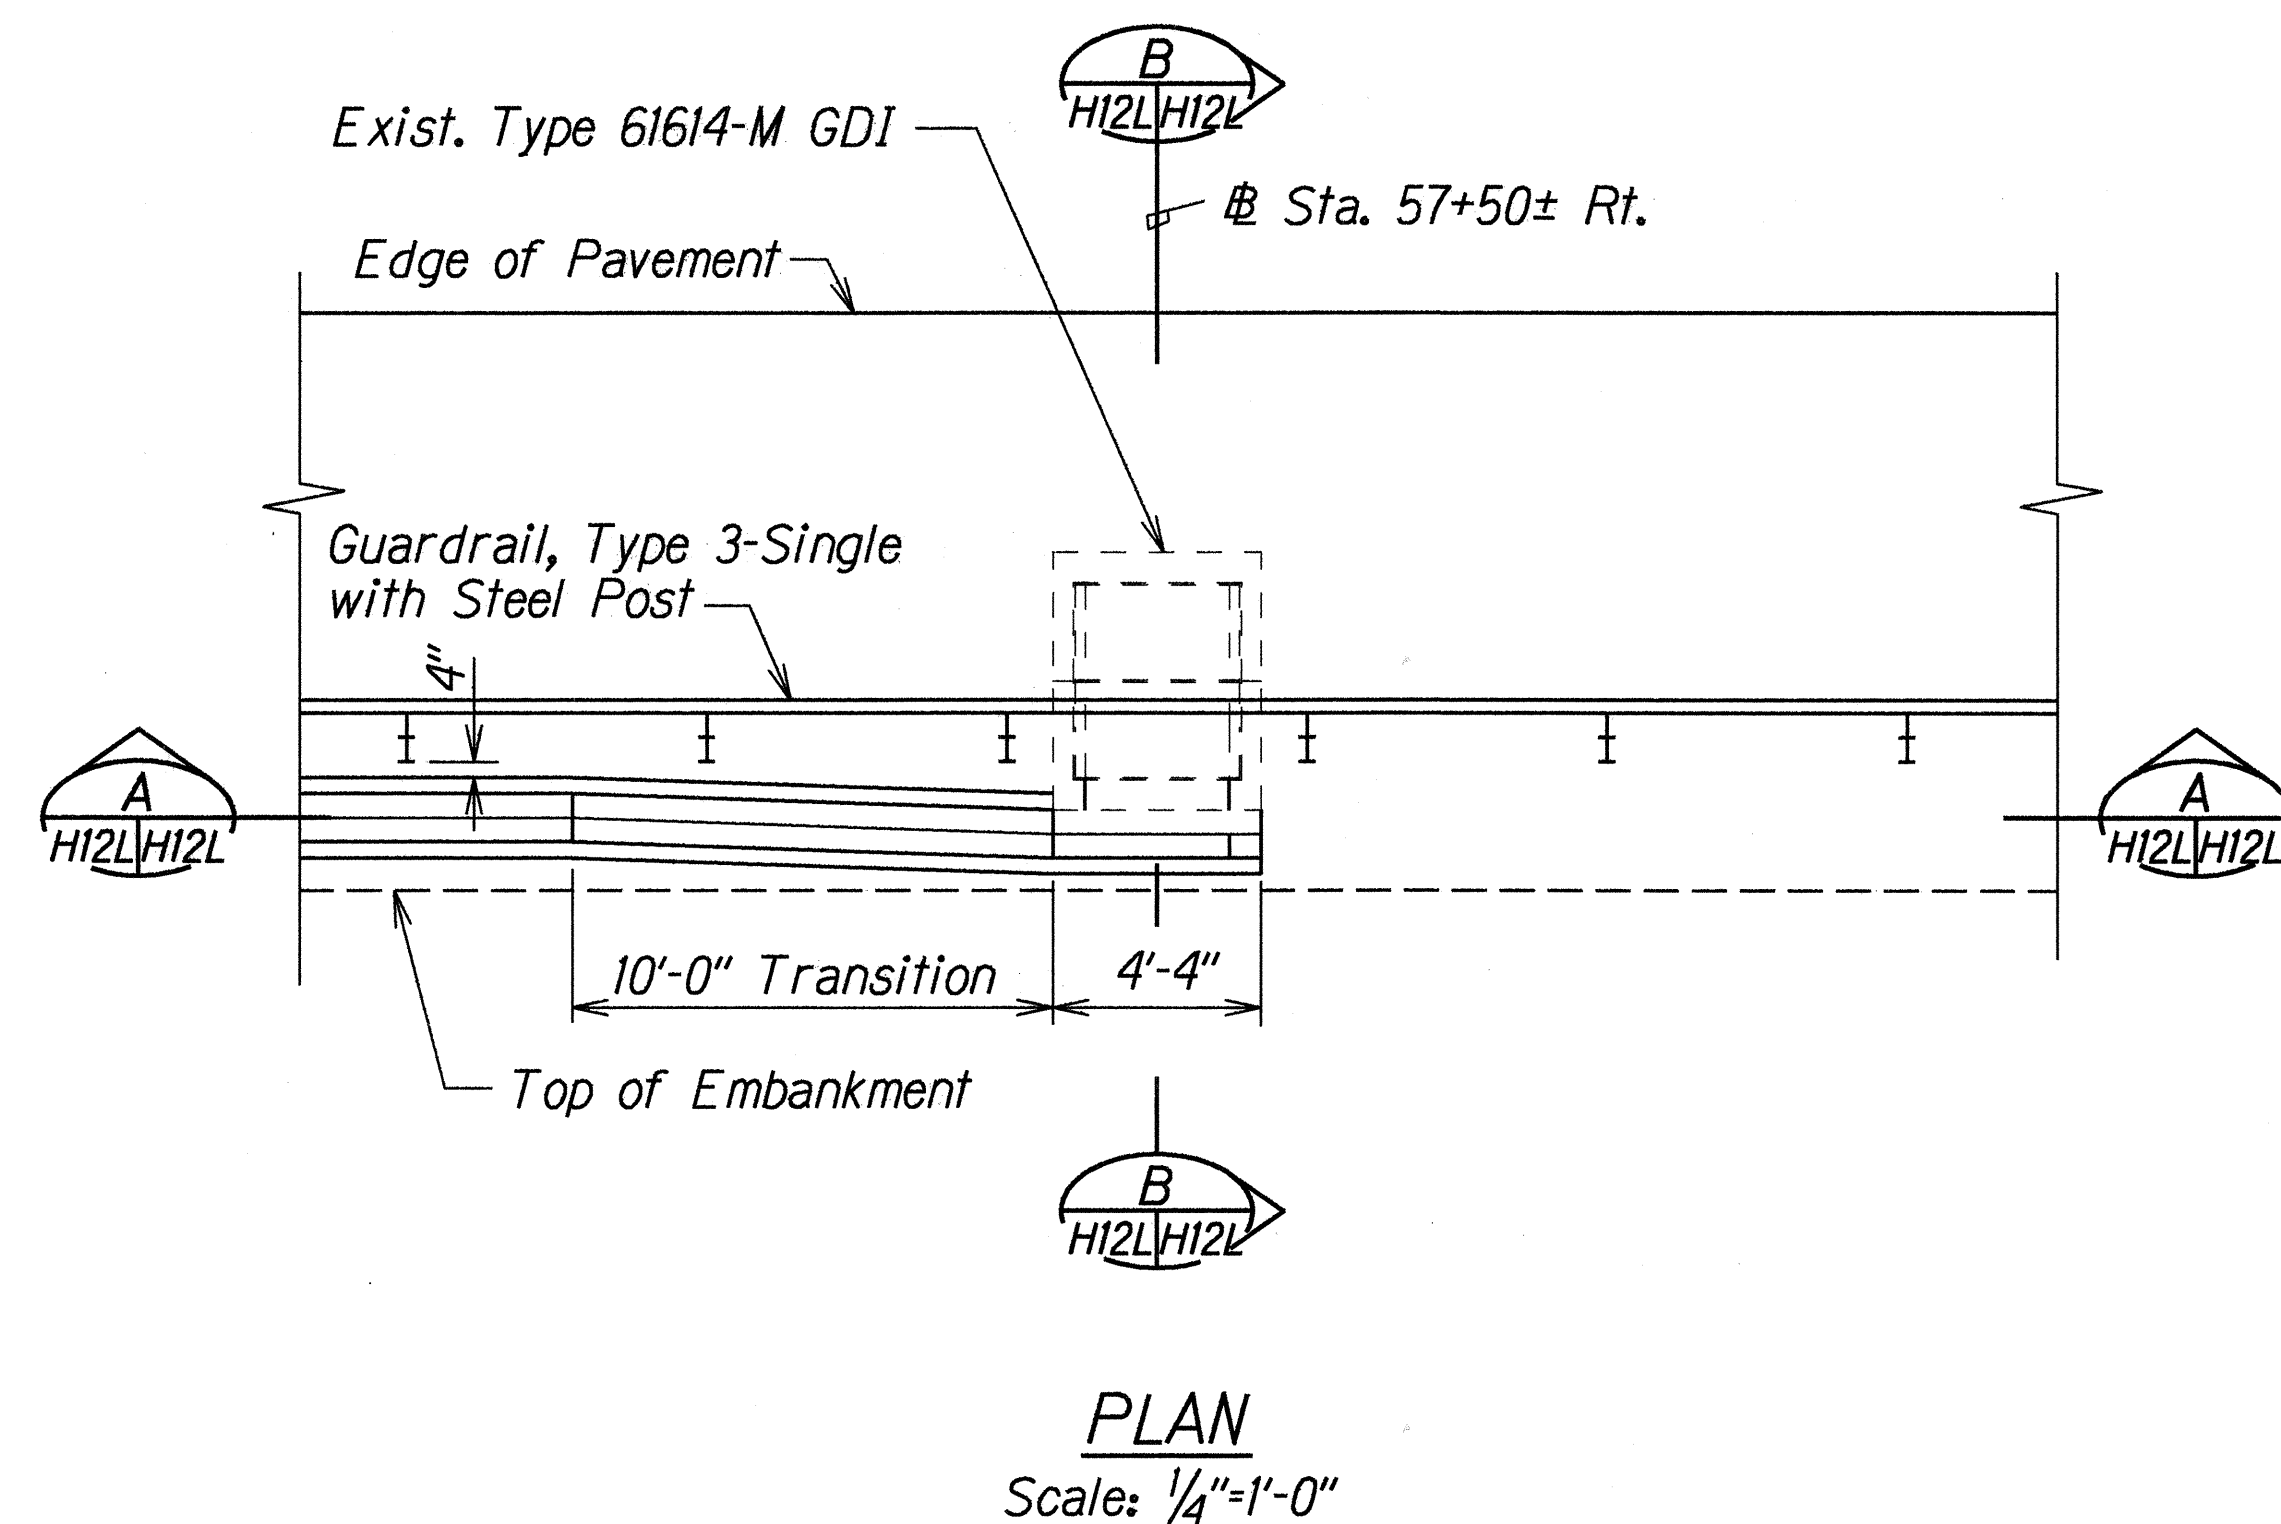

NOTE:
Constructing saw cut opening in existing GDI shall be considered incidental to the 1'x1' Lined Rectangular Drainage Ditch


DETAILS OF 1' x 1' LINED RECTANGULAR DRAINAGE DITCH TRANSITION AT STA. 57+50± RT.

ORIGINAL PLAN	DATE
NOTED BY	7/24/96
DESIGNED BY	
CHECKED BY	

12/5/96	Revised Transition of 1'x1' Lined Rectangular Drainage Ditch.
9/13/96	Sheet added to show details of 1'x1' Lined Rectangular Drainage Ditch Transition at Sta. 57+50± Rt.
DATE	REVISION
STATE OF HAWAII DEPARTMENT OF TRANSPORTATION HIGHWAYS DIVISION	
<u>DRAINAGE DETAILS</u>	
KALANIANA'OLE HIGHWAY RESURFACING	
Kailua Rd. to Hilu St.	
Project No. 72A-01-96M	
Scale: As Shown	Date: Jul. 1996
SHEET No. H12L OF 12 SHEETS	
C.O. 55S-12	

FED. ROAD DIST. NO.	STATE	PROJ. NO.	FISCAL YEAR	SHEET NO.	TOTAL SHEETS
HAWAII	HAW.	72A-01-96M	1997	C.O. 55S-13	55

TRUE NORTH
SCALE: 1" = 40'






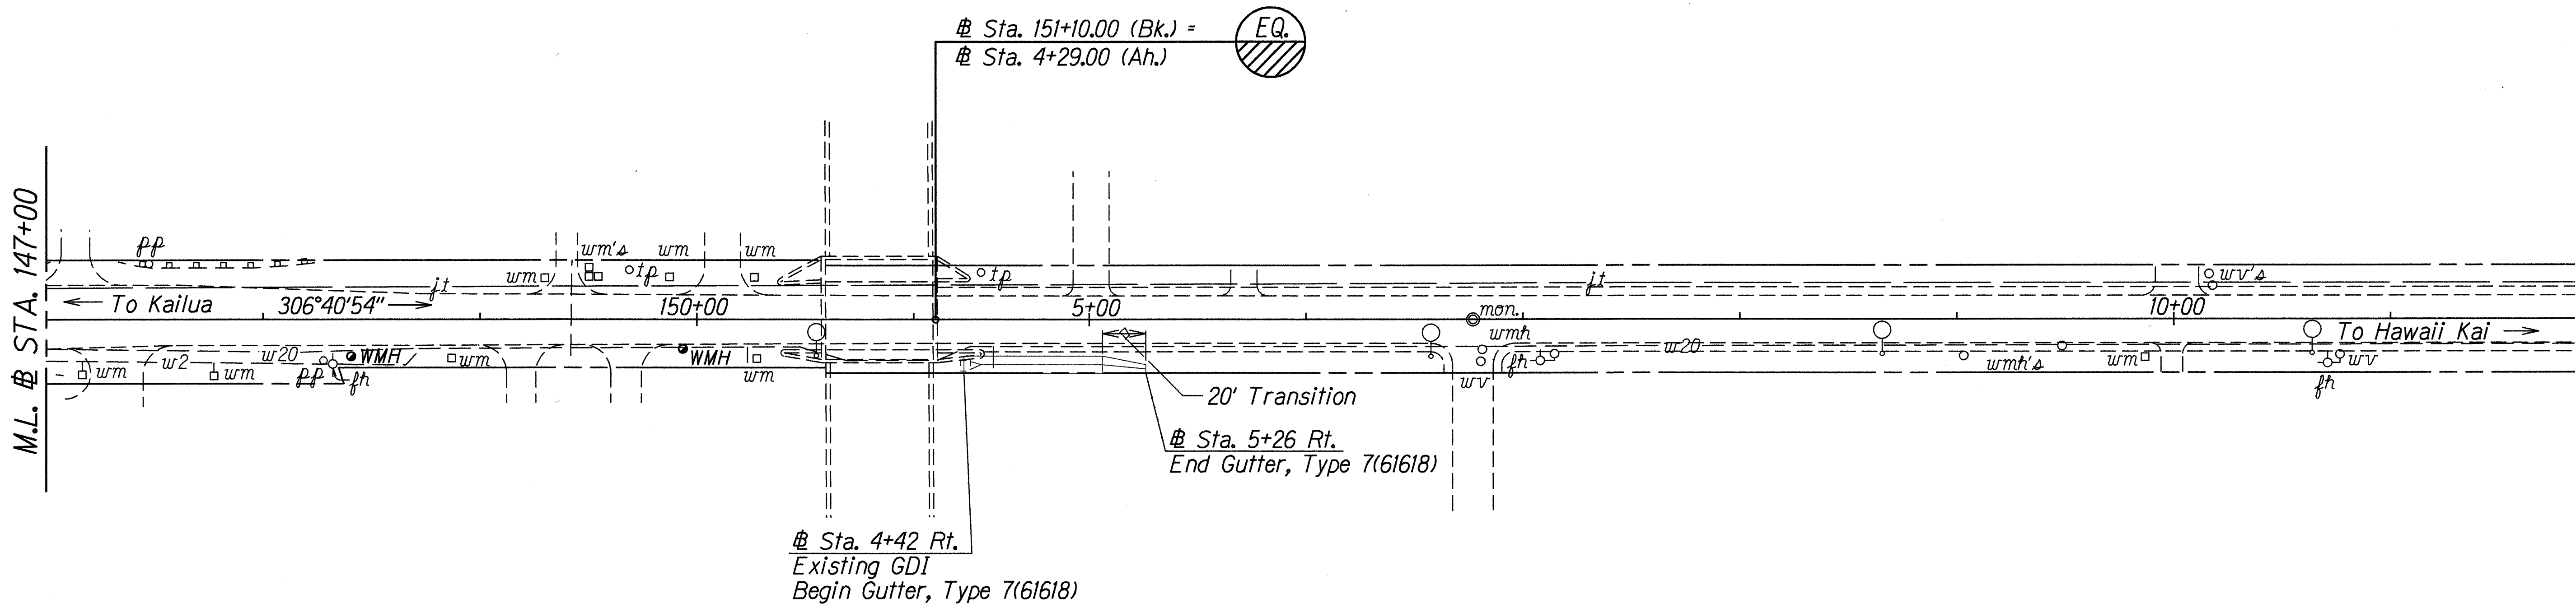


Sta. 4+42 Rt. to # Sta. 5+26 Rt.
 Construct: Gutter, Type 7(61618)
 (For Details see Sht. No. H120)
 Estimated Quantities
 Gutter, Type 7(61618) = 84 L.F.

ORIGINAL PLAN	SURVEY PLOTTED BY	DATE
NOTE BOOK	DRAWN BY A. Kama	9/13/96
DESIGNED BY R. Salgado		
QUANTITIES BY		
CHECKED BY		

9/13/96	Added Drainage Plan
DATE	REVISION
STATE OF HAWAII DEPARTMENT OF TRANSPORTATION HIGHWAYS DIVISION DRAINAGE PLAN KALANIANA'OLE HIGHWAY RESURFACING Kailua Rd. to Hilo St. Project No. 72A-01-96M Scale: 1"=40' Date: Aug. 1996	
SHEET No. H12M OF 12 SHEETS	

FED. ROAD DIST. NO.	STATE	PROJ. NO.	FISCAL YEAR	SHEET NO.	TOTAL SHEETS
HAWAII	HAW.	72A-01-96M	1997	C.O. 55S-14	55

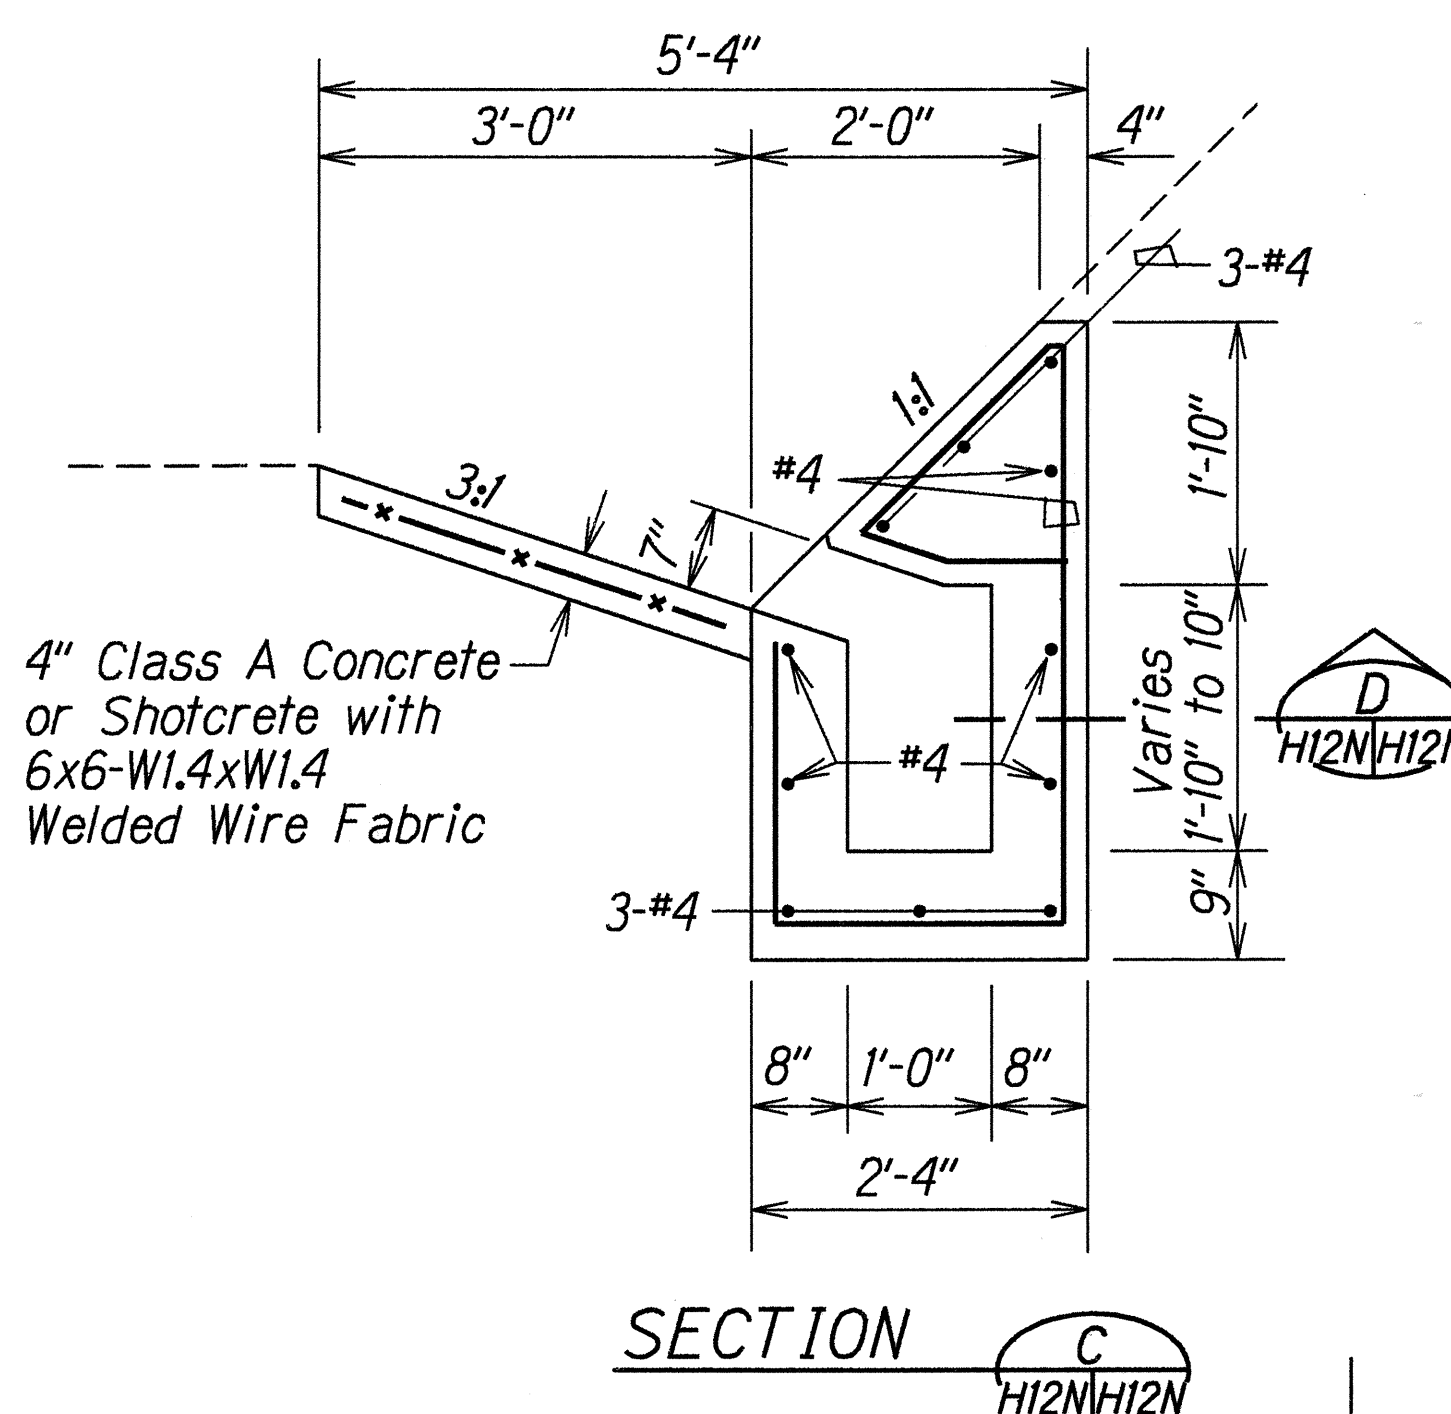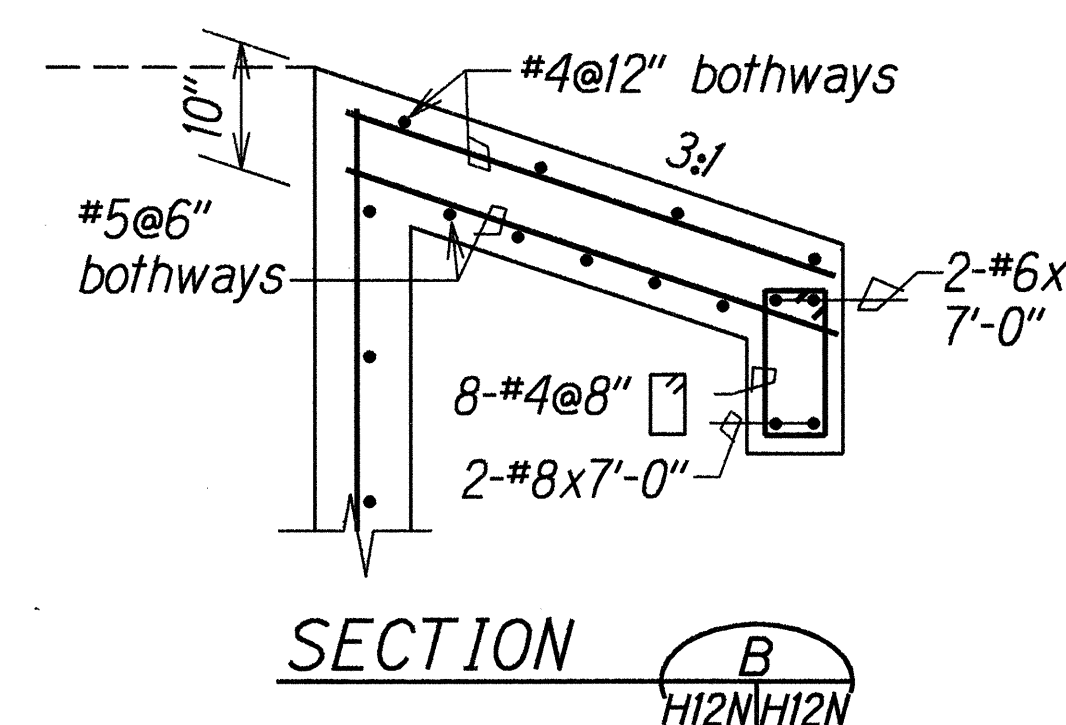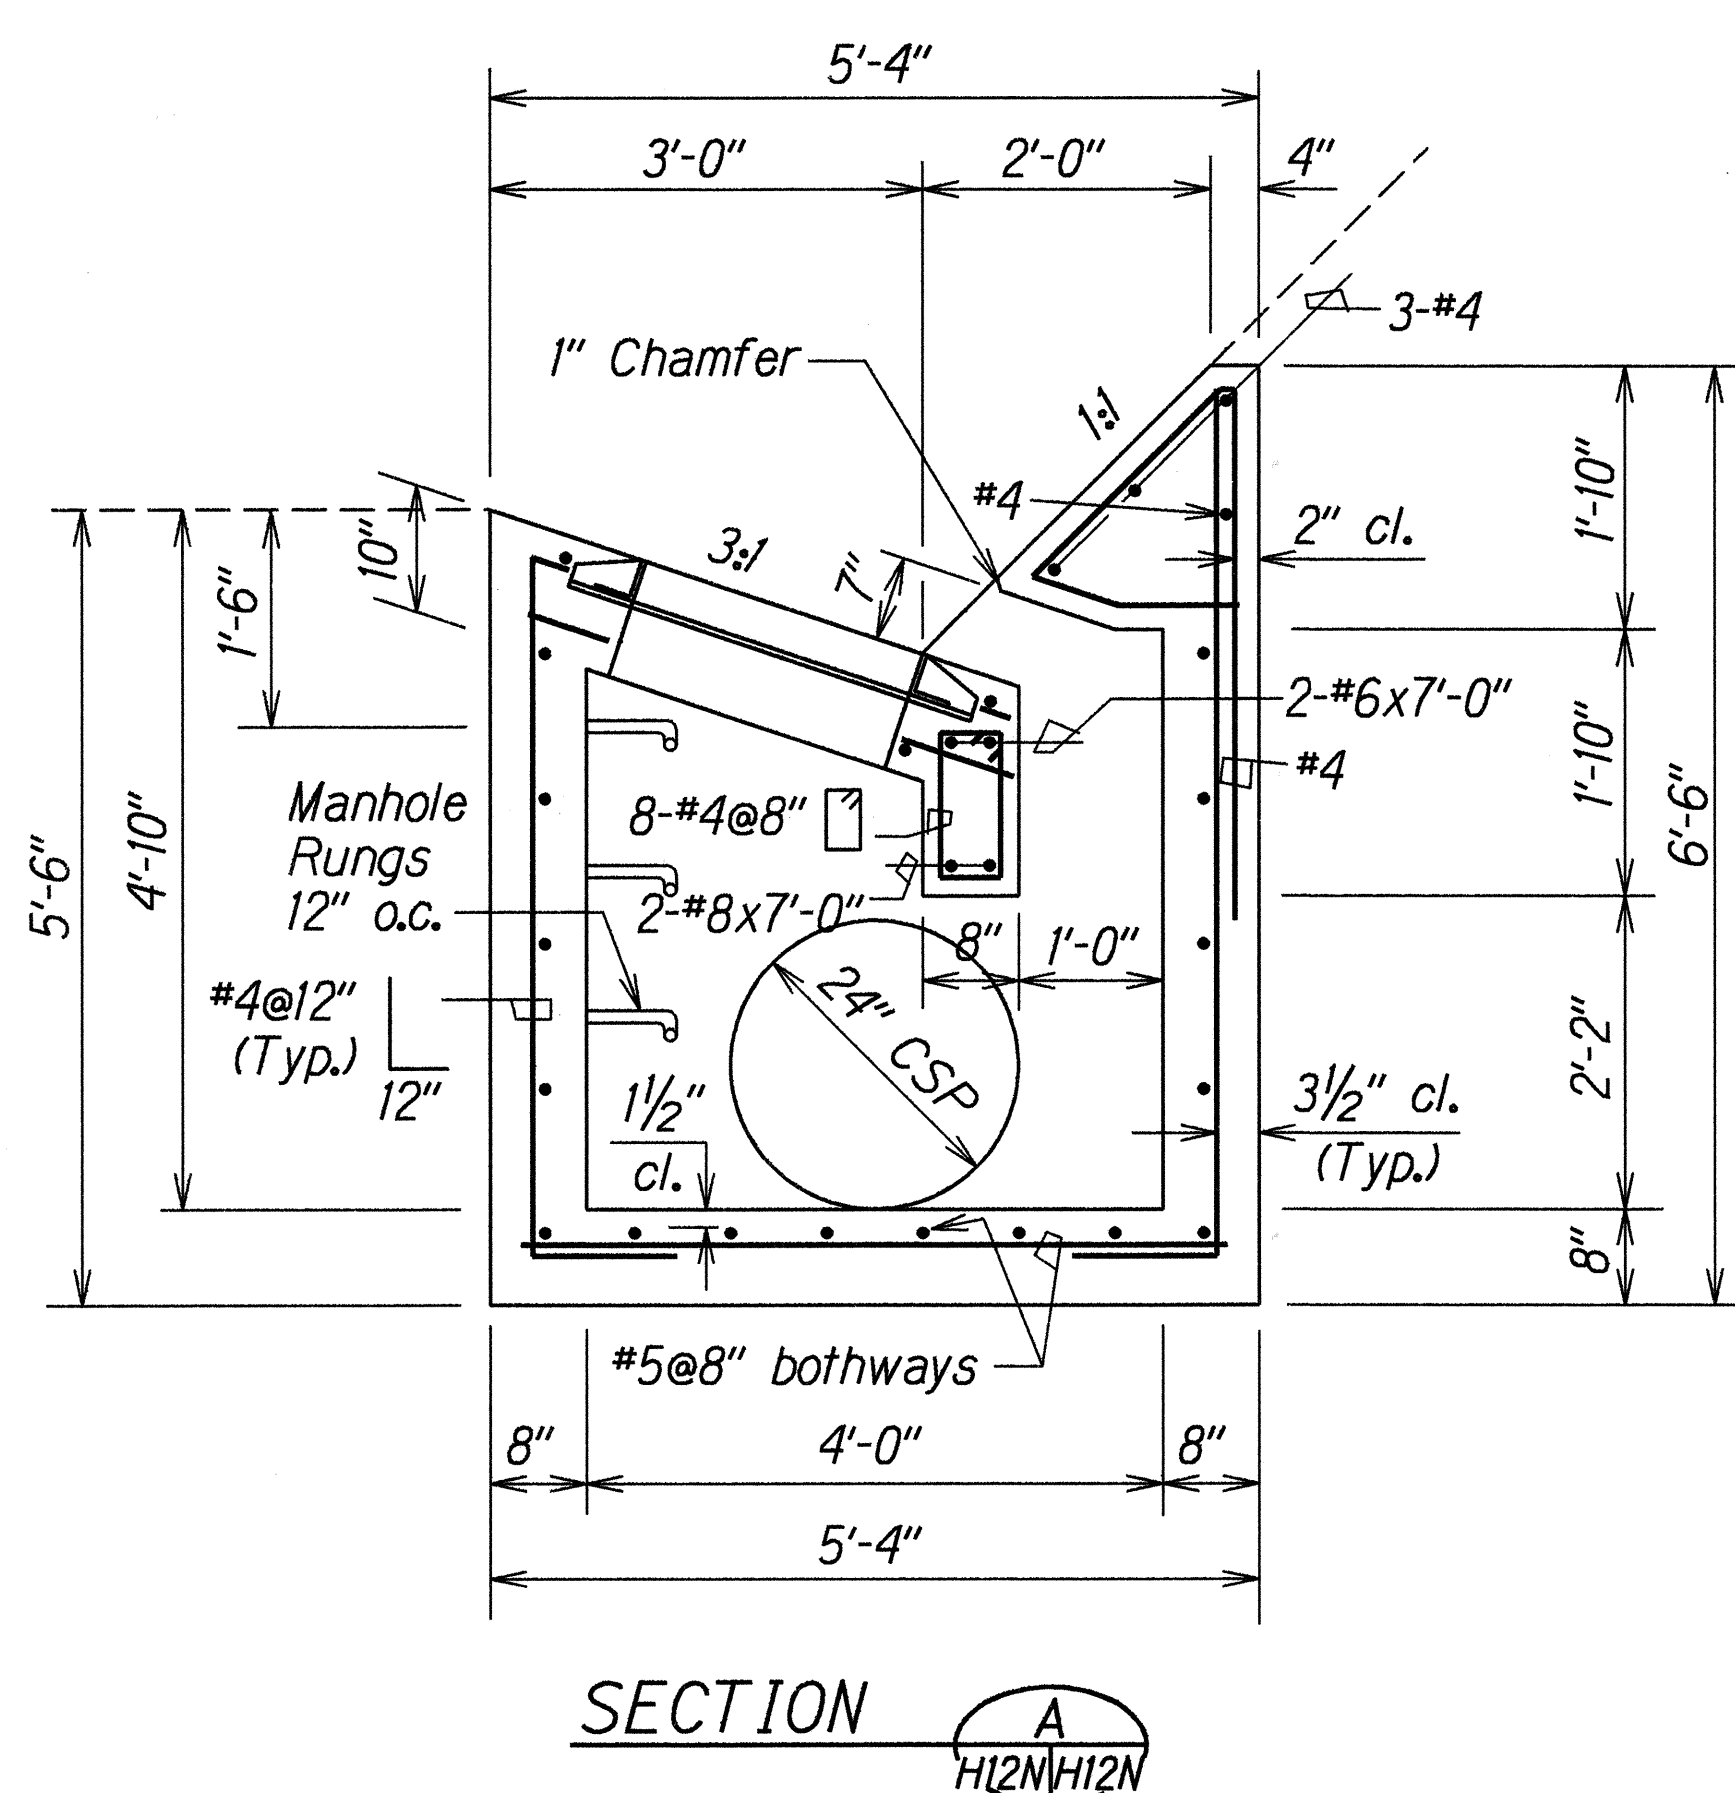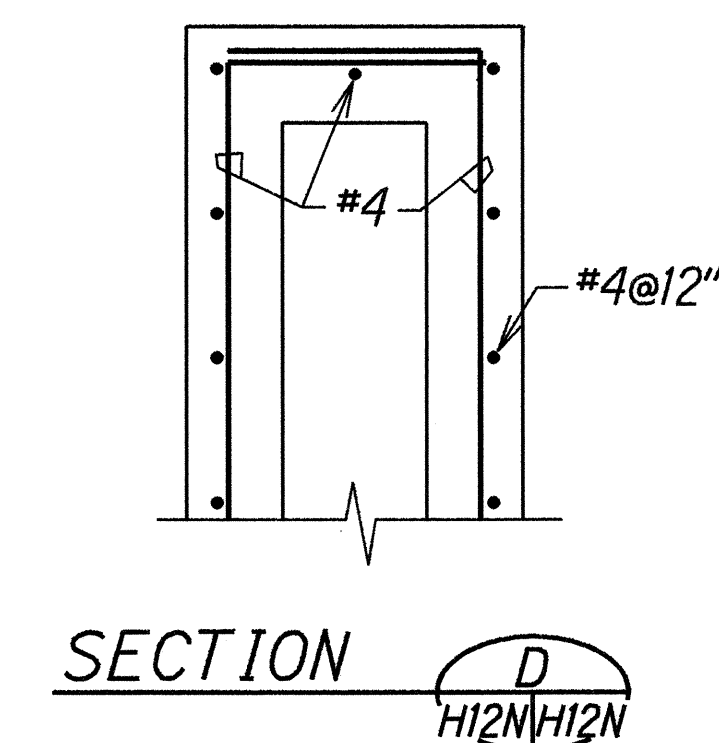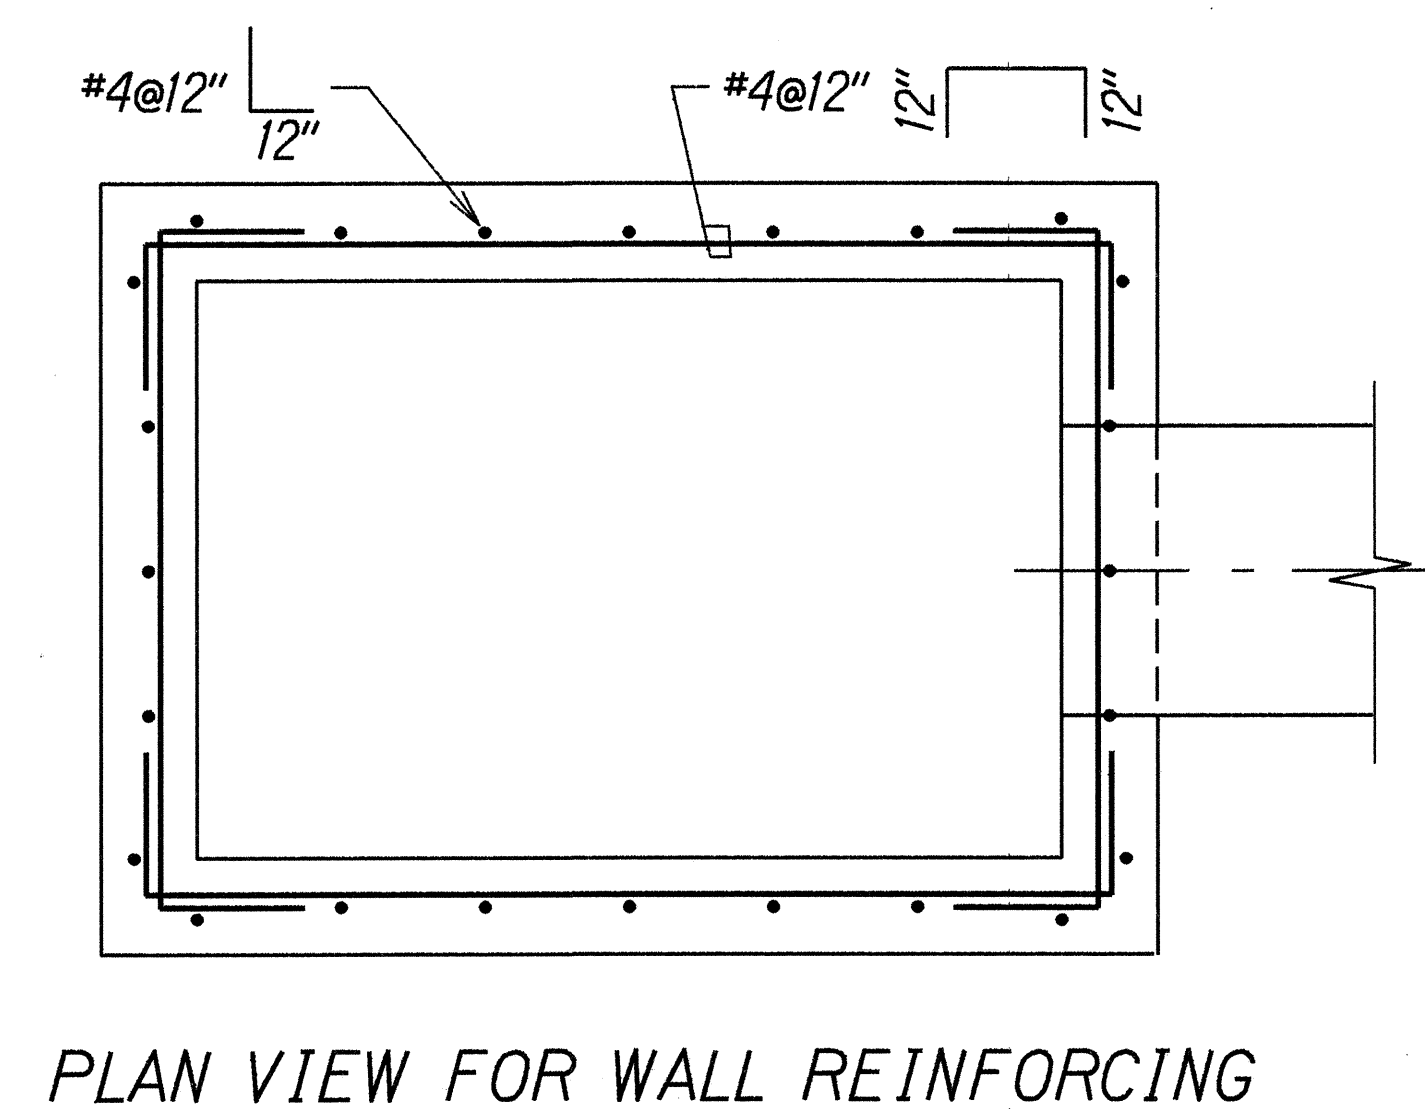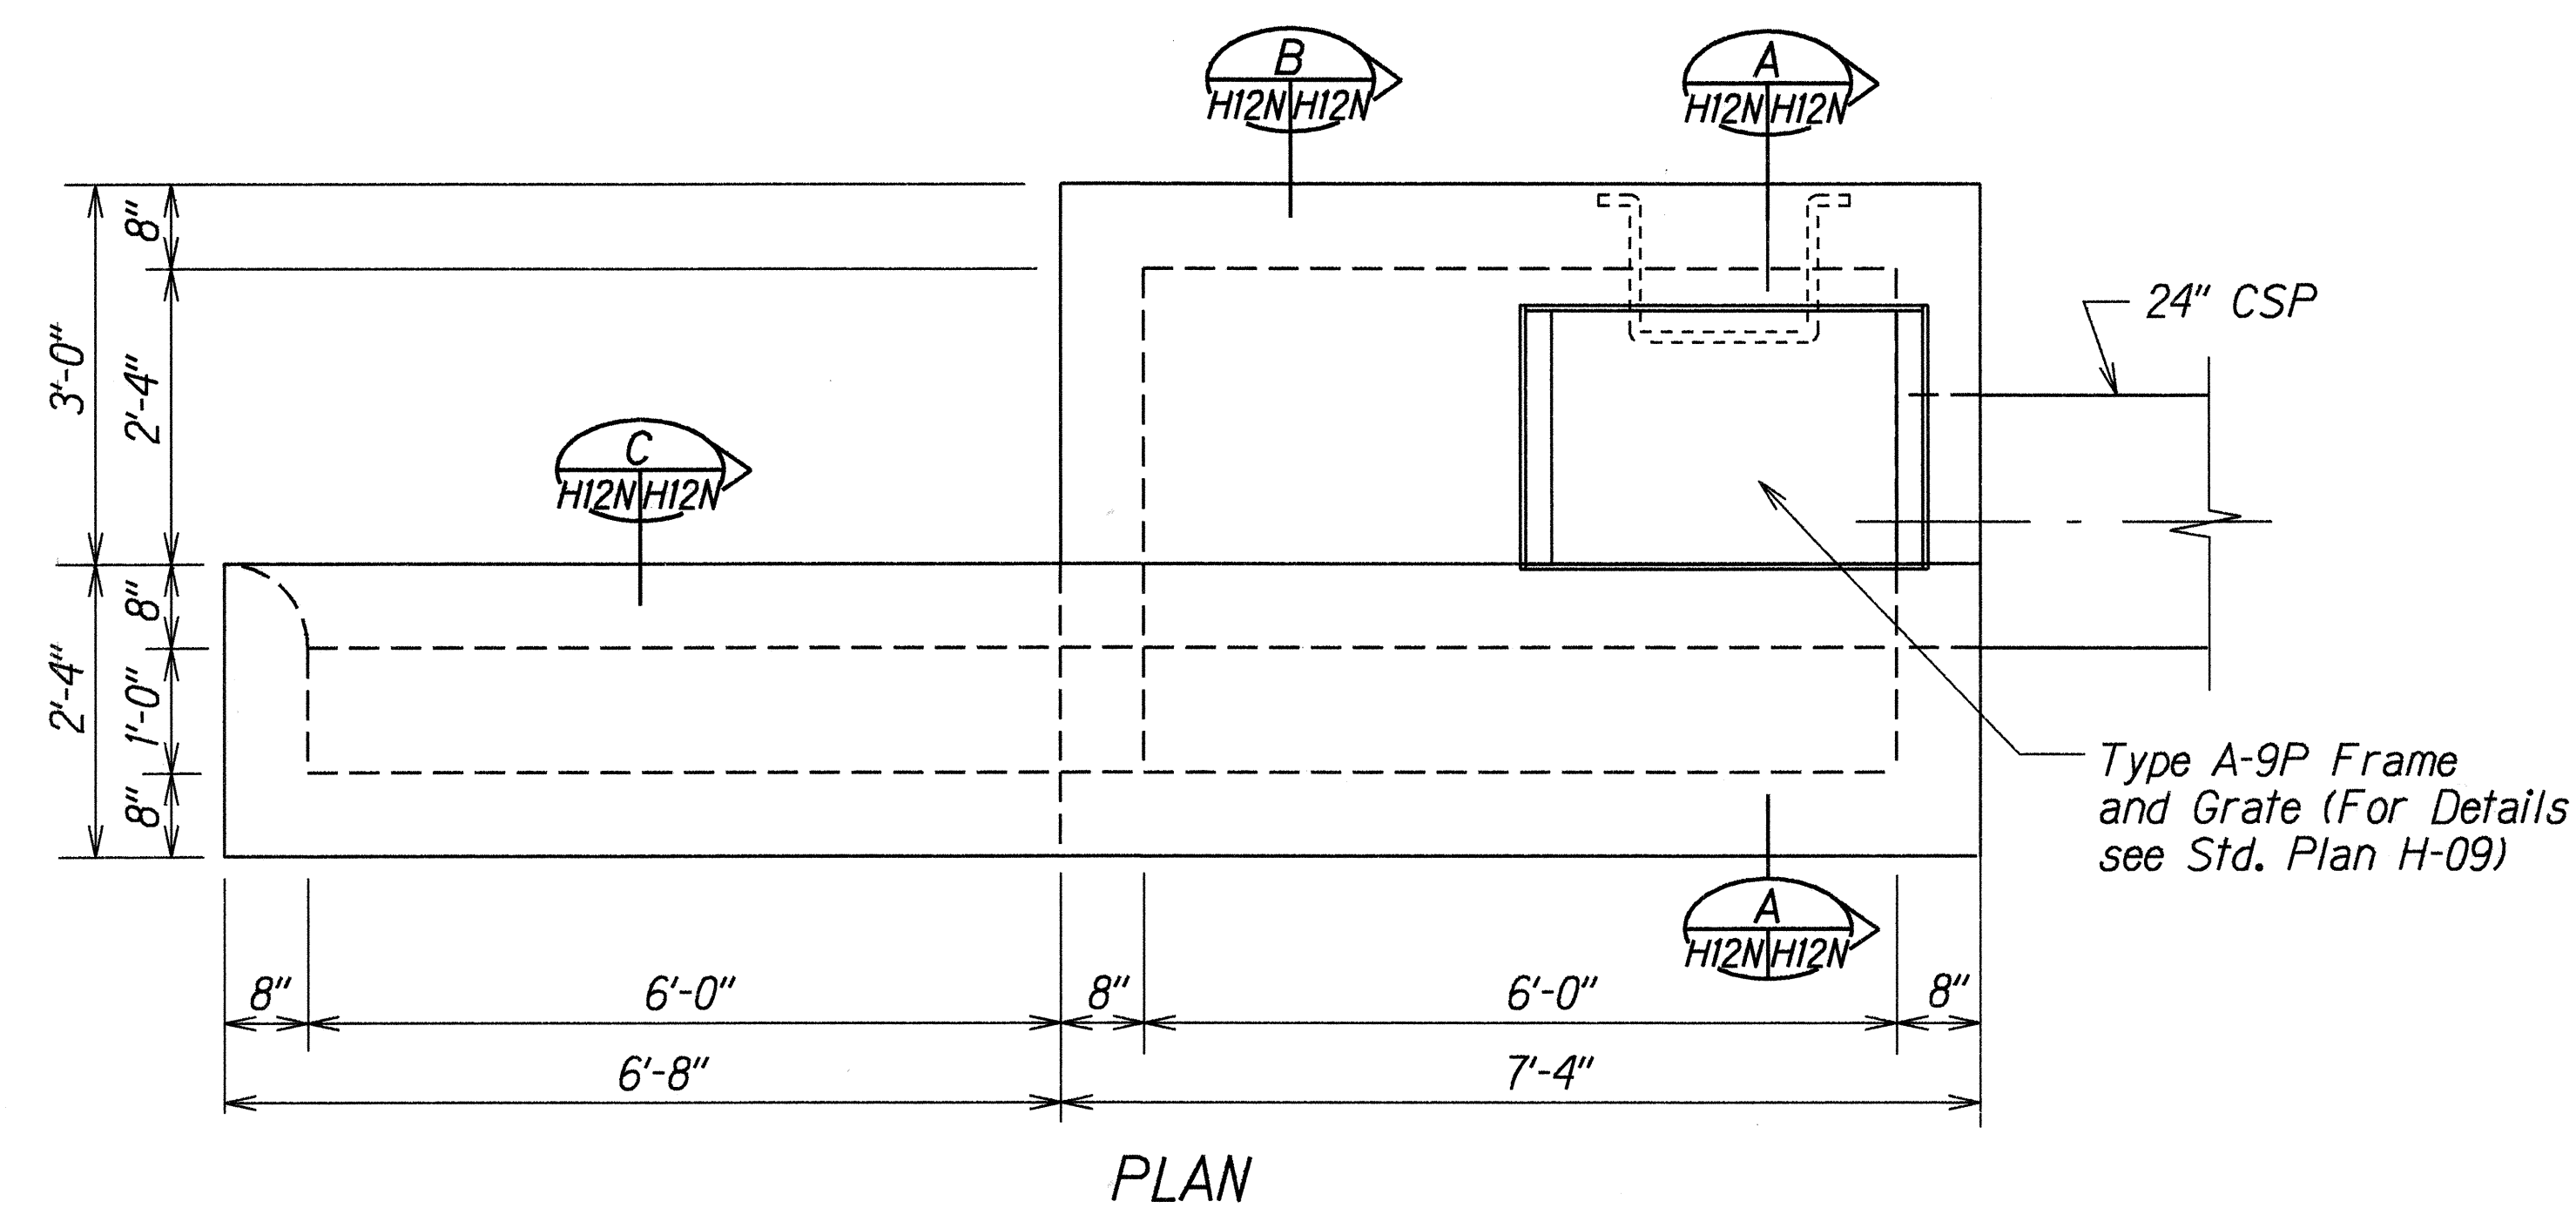


DETAILS OF TYPE "CX" C.B. AT STA. 53+25 RT.


ORIGINAL PLAN	DATE
NOTE BOOK	8/12/96
DESIGNED BY	
QUANTITIES BY	
CHECKED BY	

9/13/96	Added Details of Type "CX" C.B.
DATE	REVISION
STATE OF HAWAII DEPARTMENT OF TRANSPORTATION HIGHWAYS DIVISION	
DRAINAGE DETAILS	
KALANIANA'OLE HIGHWAY RESURFACING	
Kailua Rd. to Hilu St.	
Project No. 72A-01-96M	
Scale: 3/4"=1'-0"	Date: Aug. 1996
SHEET No. HI2N OF 12 SHEETS	


FED. ROAD DIST. NO.	STATE	PROJ. NO.	FISCAL YEAR	SHEET NO.	TOTAL SHEETS
HAWAII	HAW.	72A-01-96M	1997	C.O. 55S-15	55

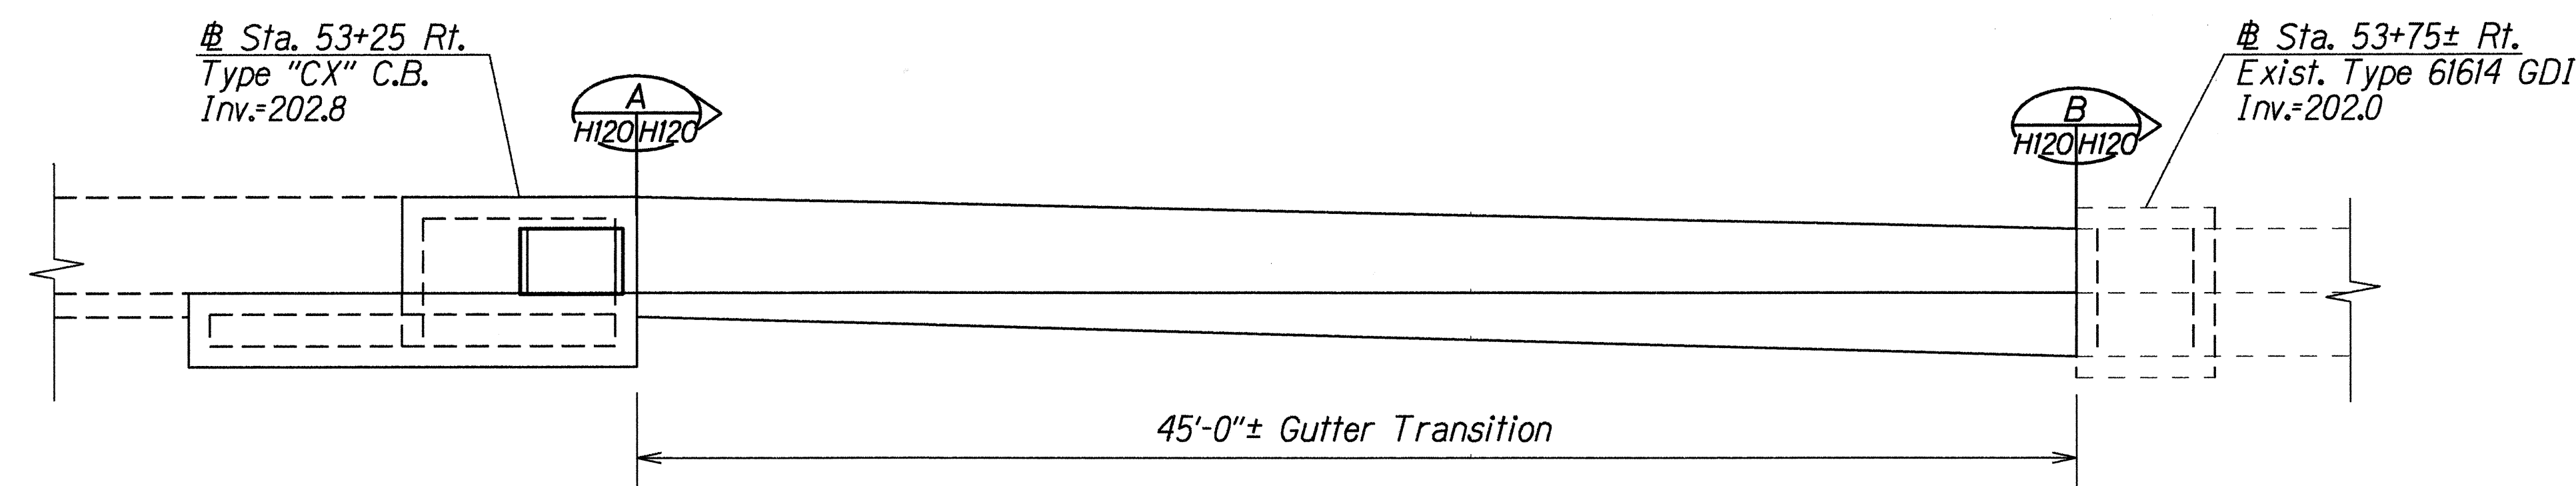

PLAN
Scale: 1/4"=1'-0"

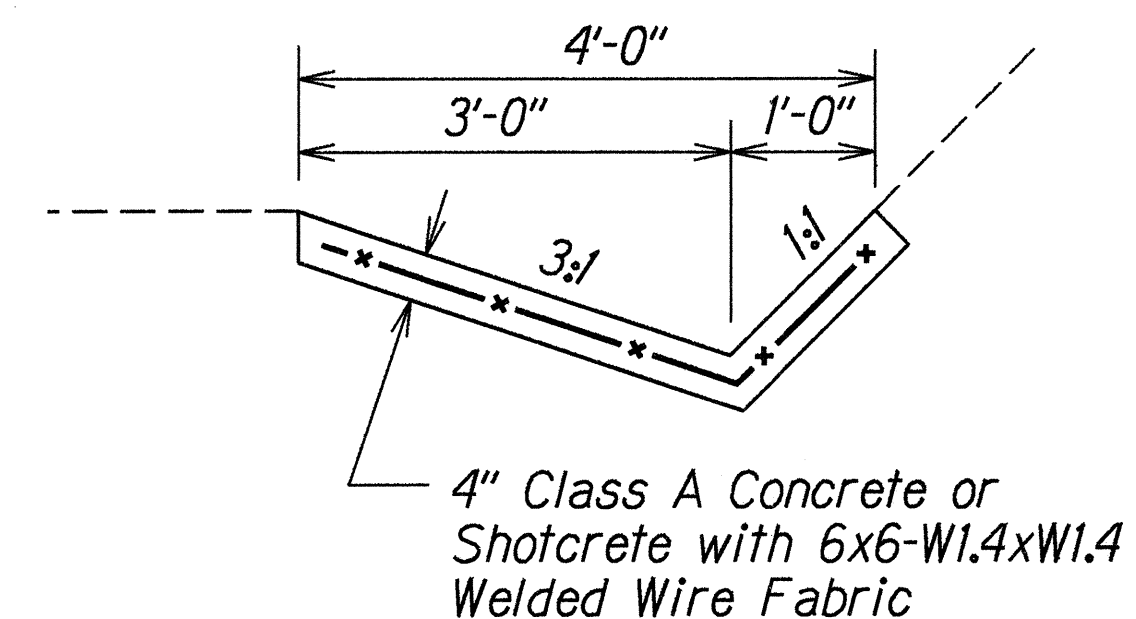


SECTION A
Scale: 3/4"=1'-0" H120/H120

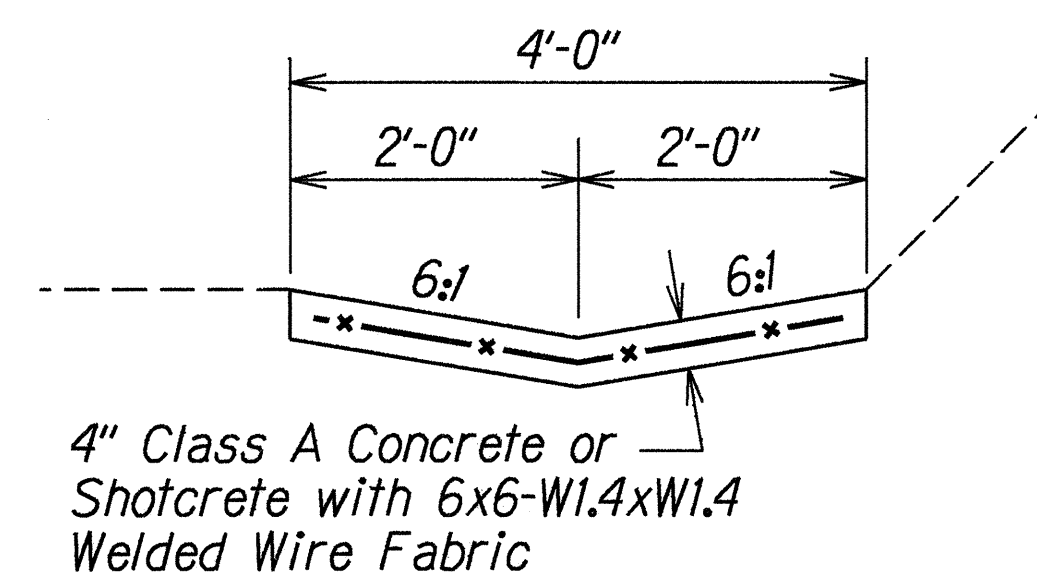


SECTION B
Scale: 3/4"=1'-0" H120/H120


GUTTER RECONSTRUCTION DETAILS

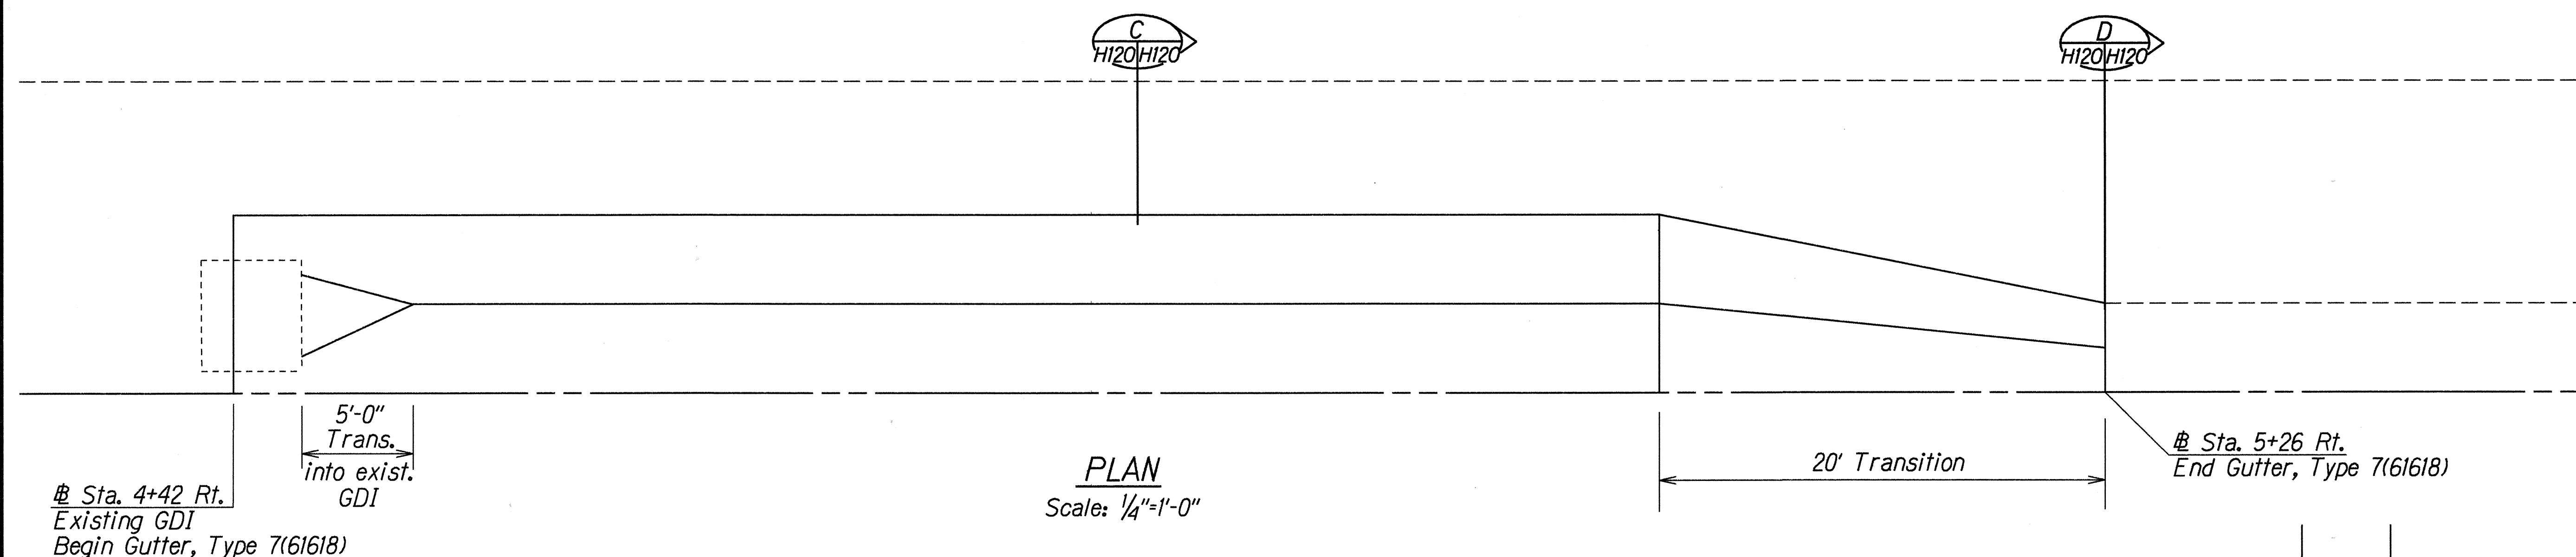

PLAN
Scale: 1/4"=1'-0"

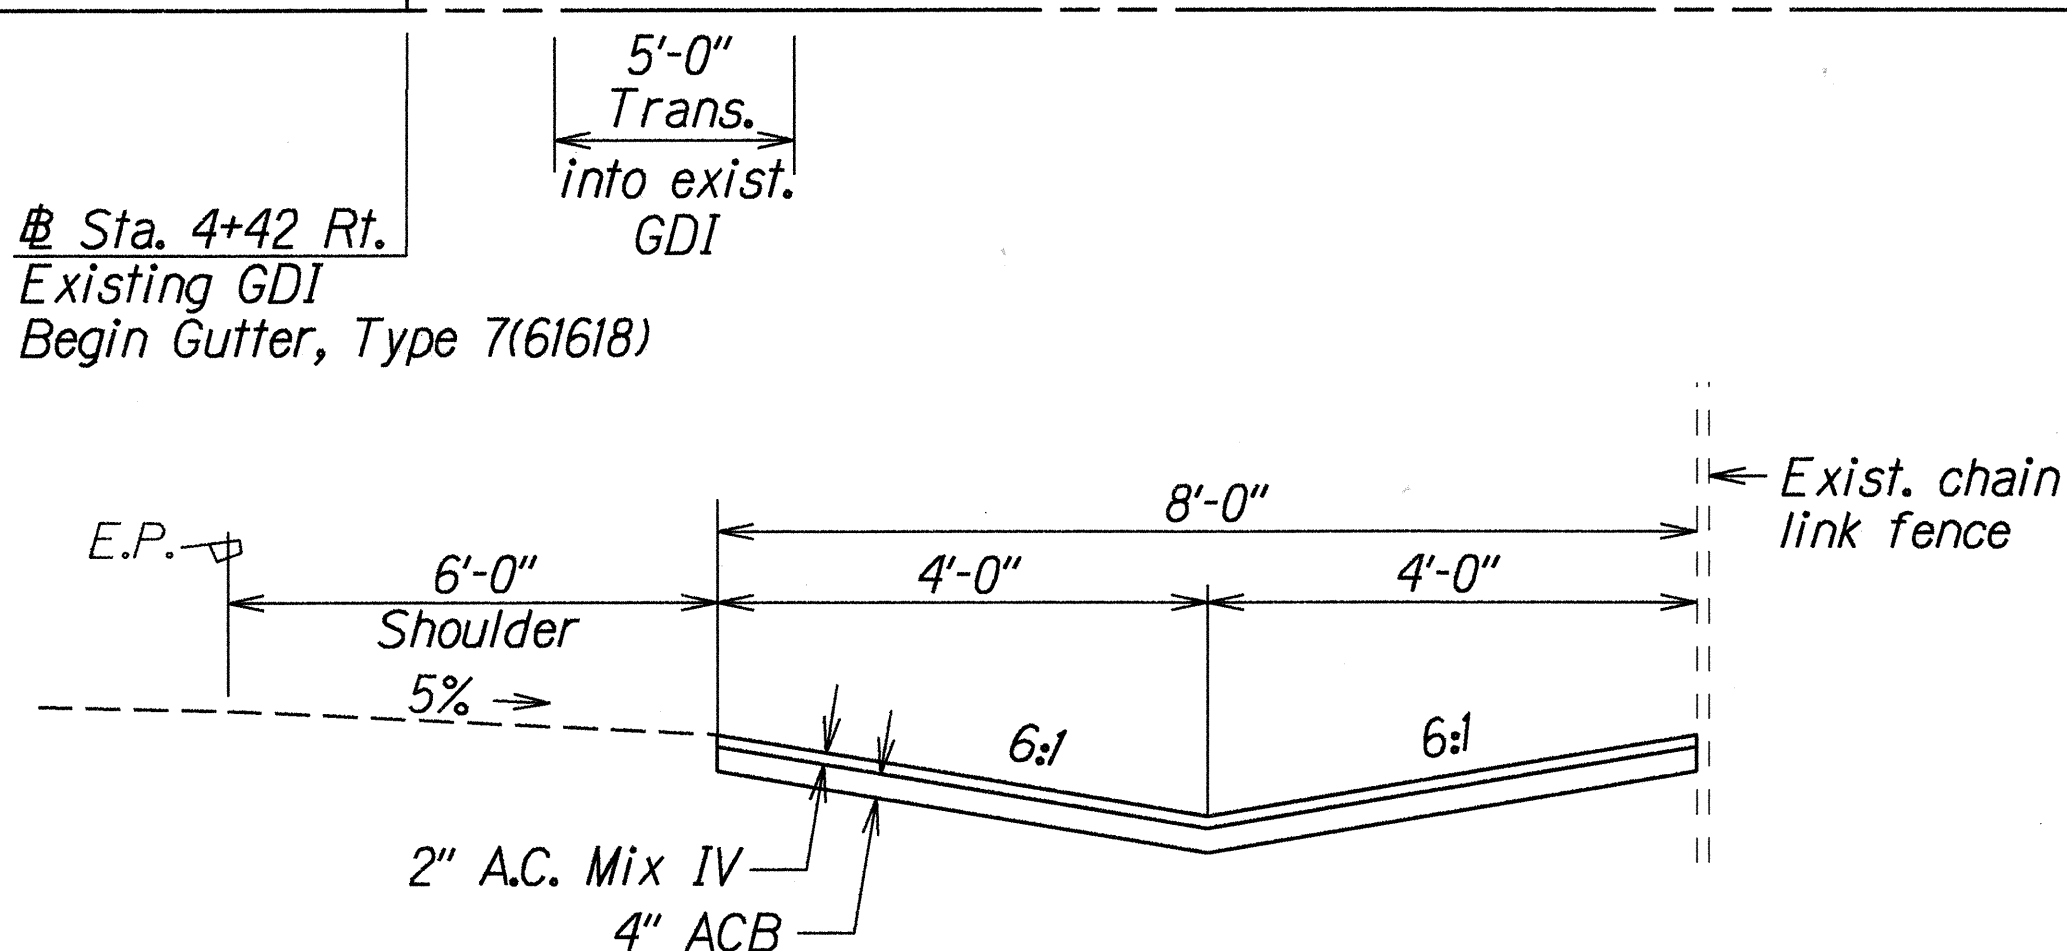

SECTION C
Scale: 3/8"=1'-0" H120/H120

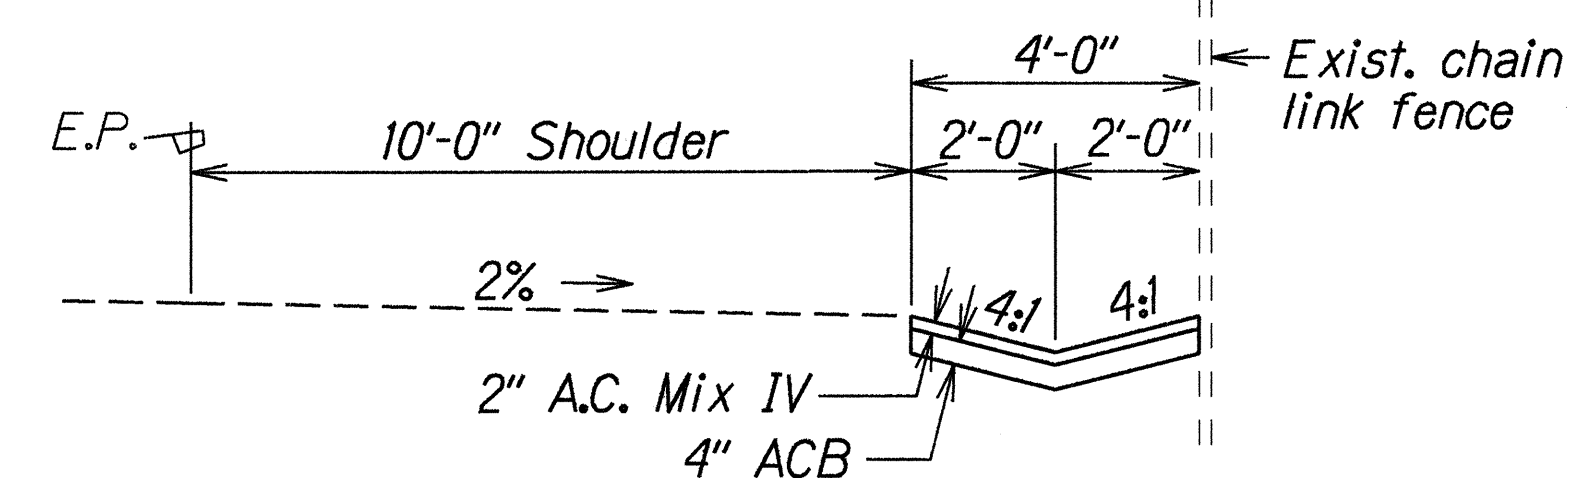

SECTION D
Scale: 3/8"=1'-0" H120/H120

GUTTER, TYPE 7(61618) DETAILS

ORIGINAL PLAN	DATE	9/12/96
NOTE BOOK	DRAWN BY	A. KIMURA
QUANTITIES BY	DESIGNED BY	B. SAKAMOTO
CHECKED BY	REVIEWED BY	S. CHEN/H. CHEN

9/13/96 Added Gutter Reconstruction Details

DATE REVISION

STATE OF HAWAII
DEPARTMENT OF TRANSPORTATION
HIGHWAYS DIVISION

DRAINAGE DETAILS

KALANIANA'OLE HIGHWAY RESURFACING

Kailua Rd. to Hilu St.

Project No. 72A-01-96M





Scale: As Shown

Date: Aug. 1996

SHEET No. H120 OF 12 SHEETS

C.O. 55S-15

FED. ROAD DIST. NO.	STATE	PROJ. NO.	FISCAL YEAR	SHEET NO.	TOTAL SHEETS
HAWAII	HAW.	72A-01-96M	1996	C.O. 55S-16	55

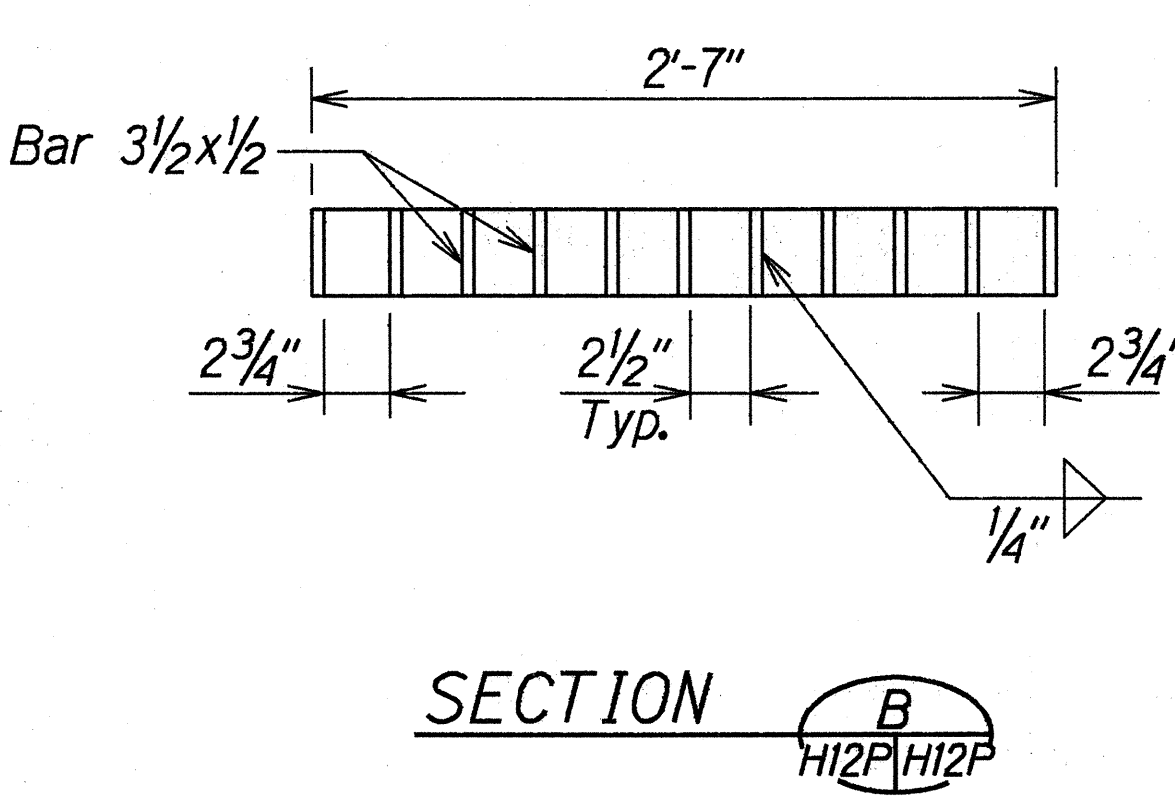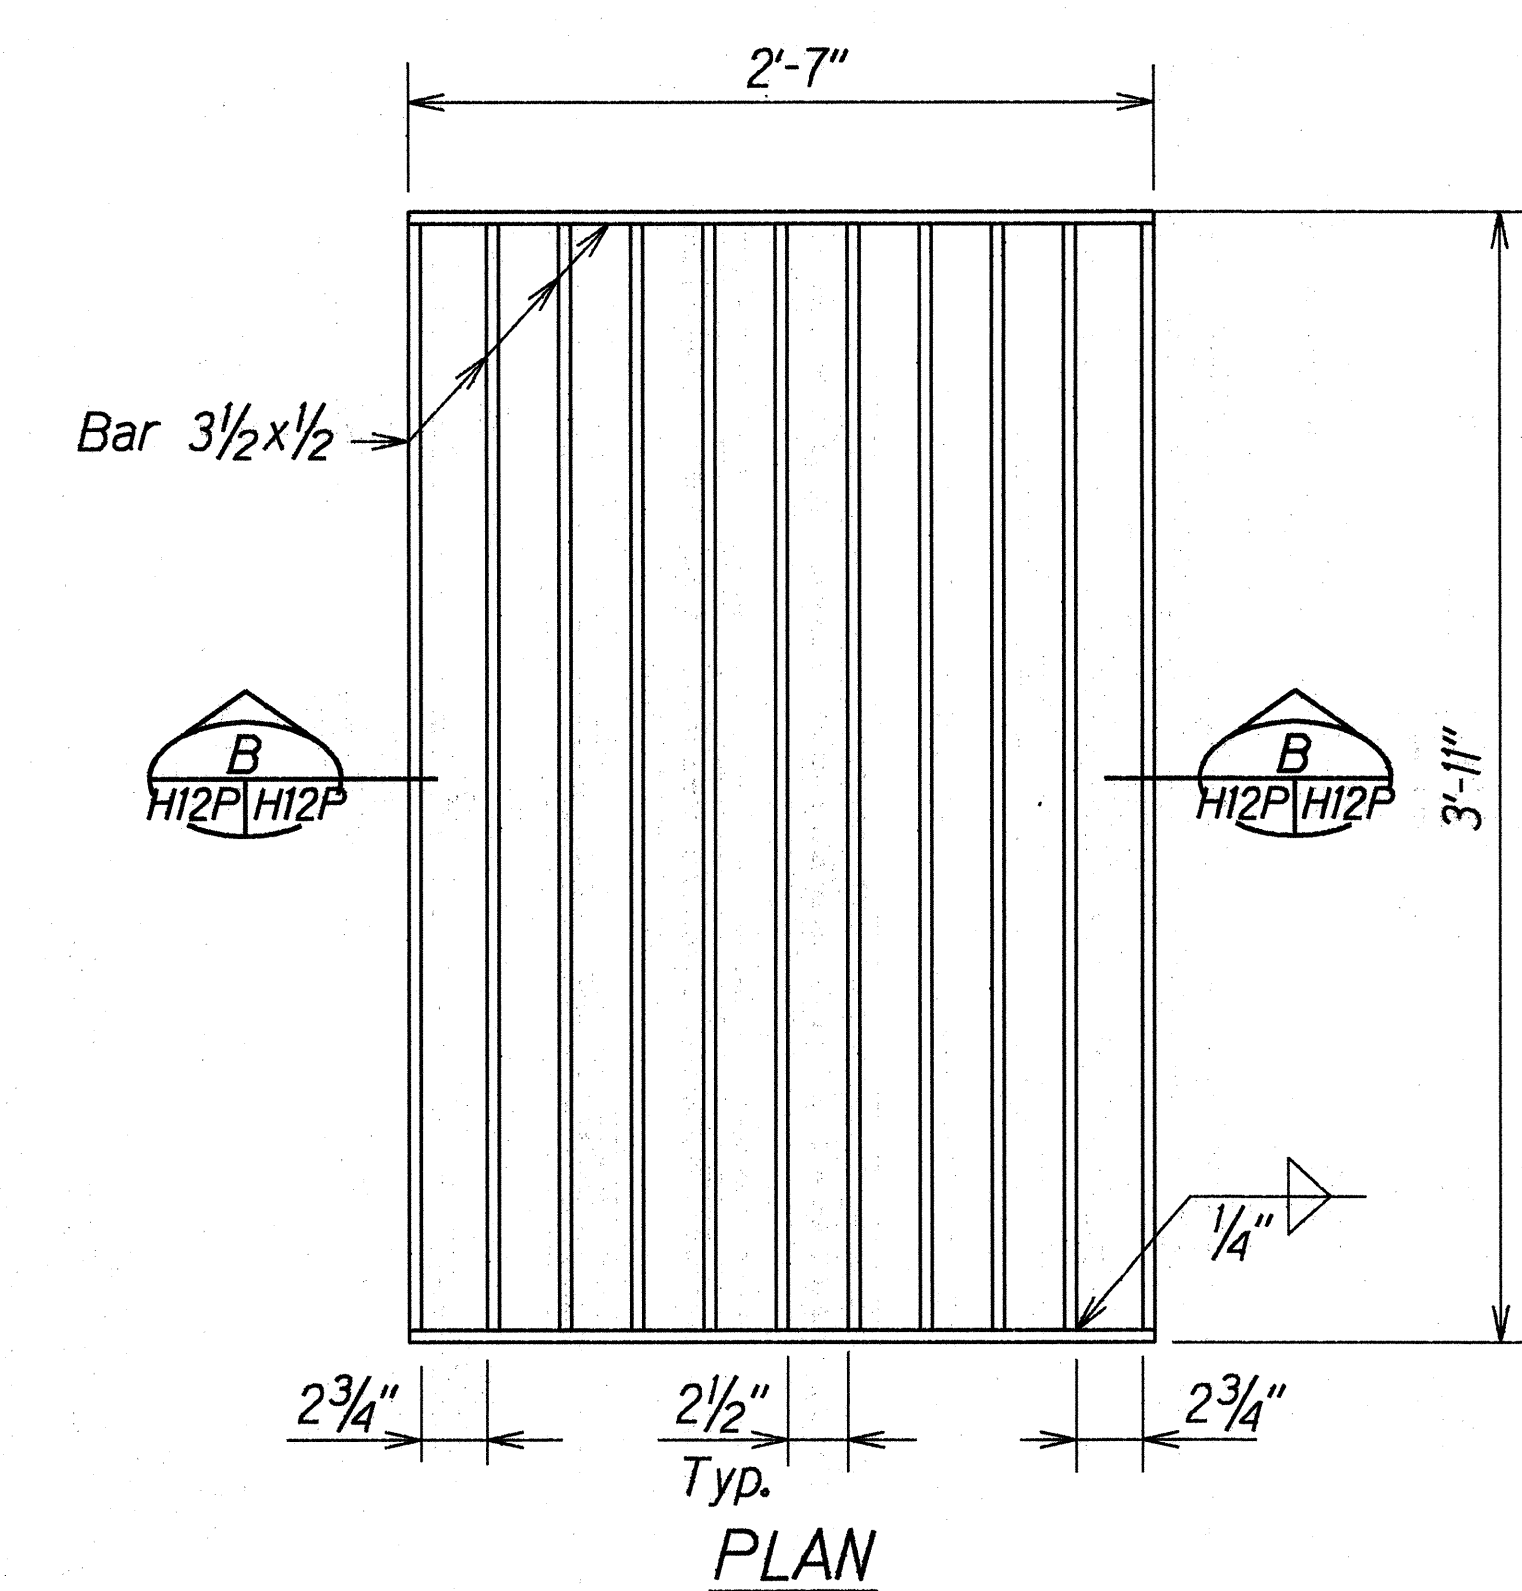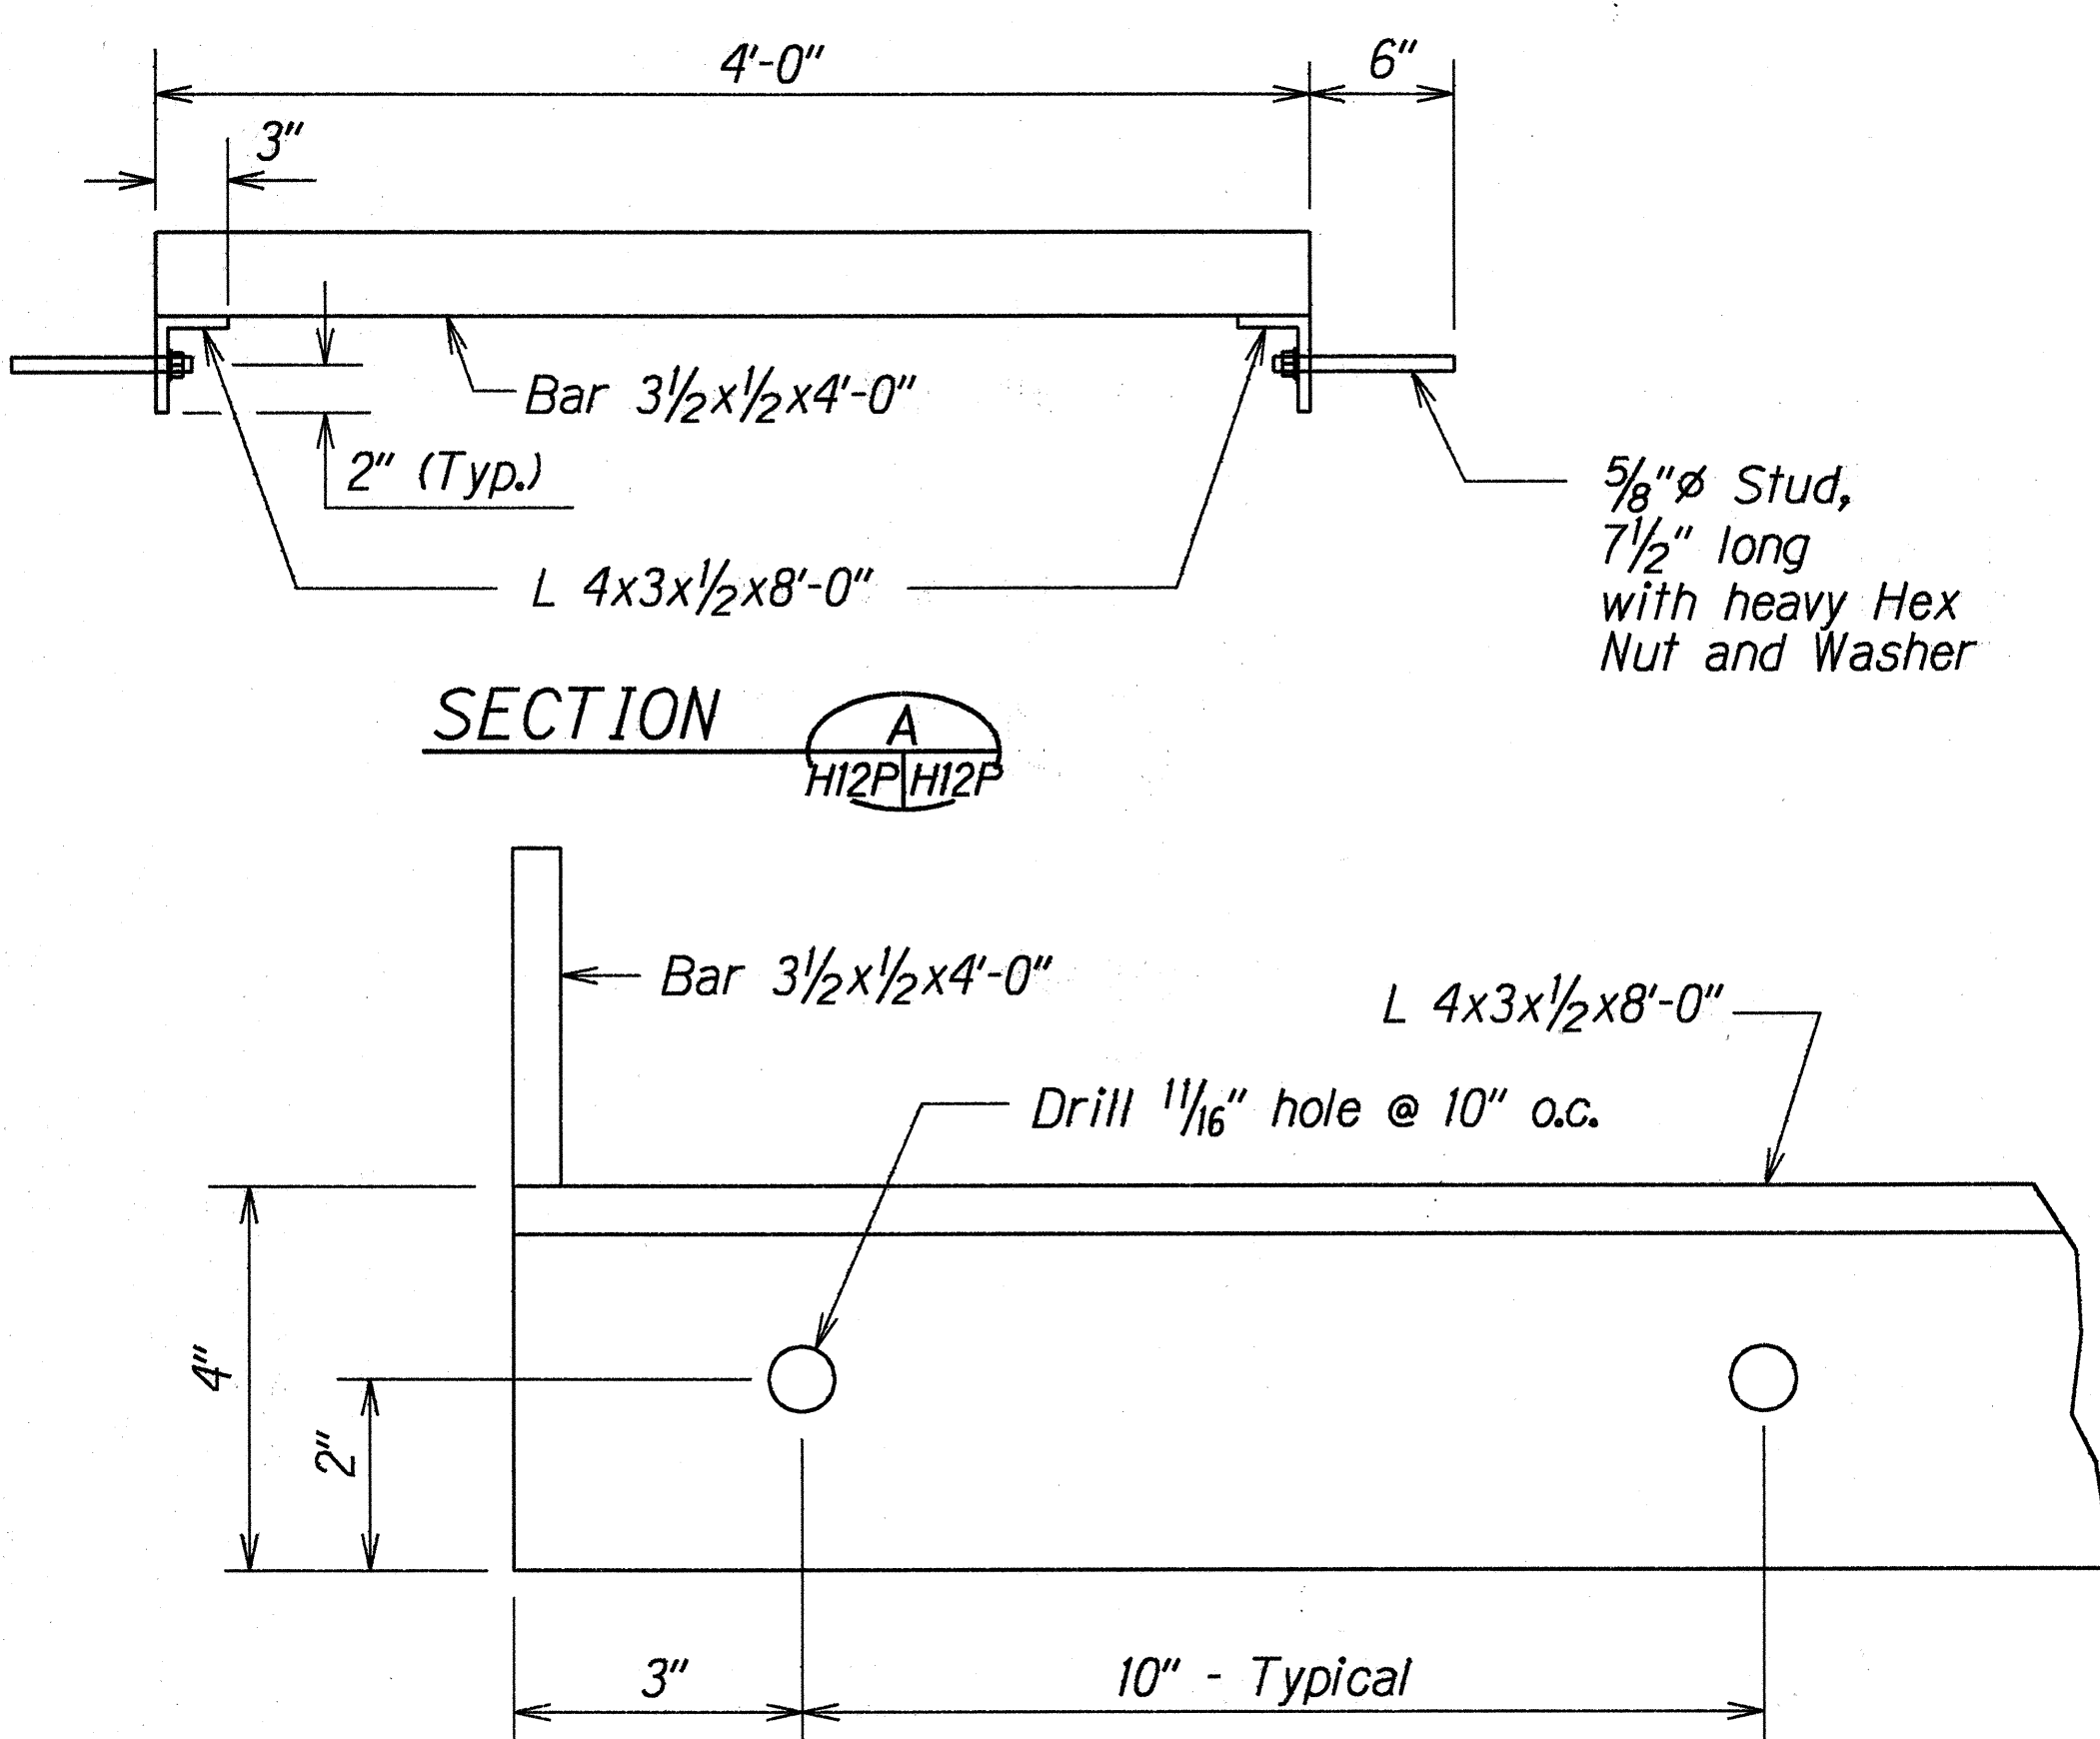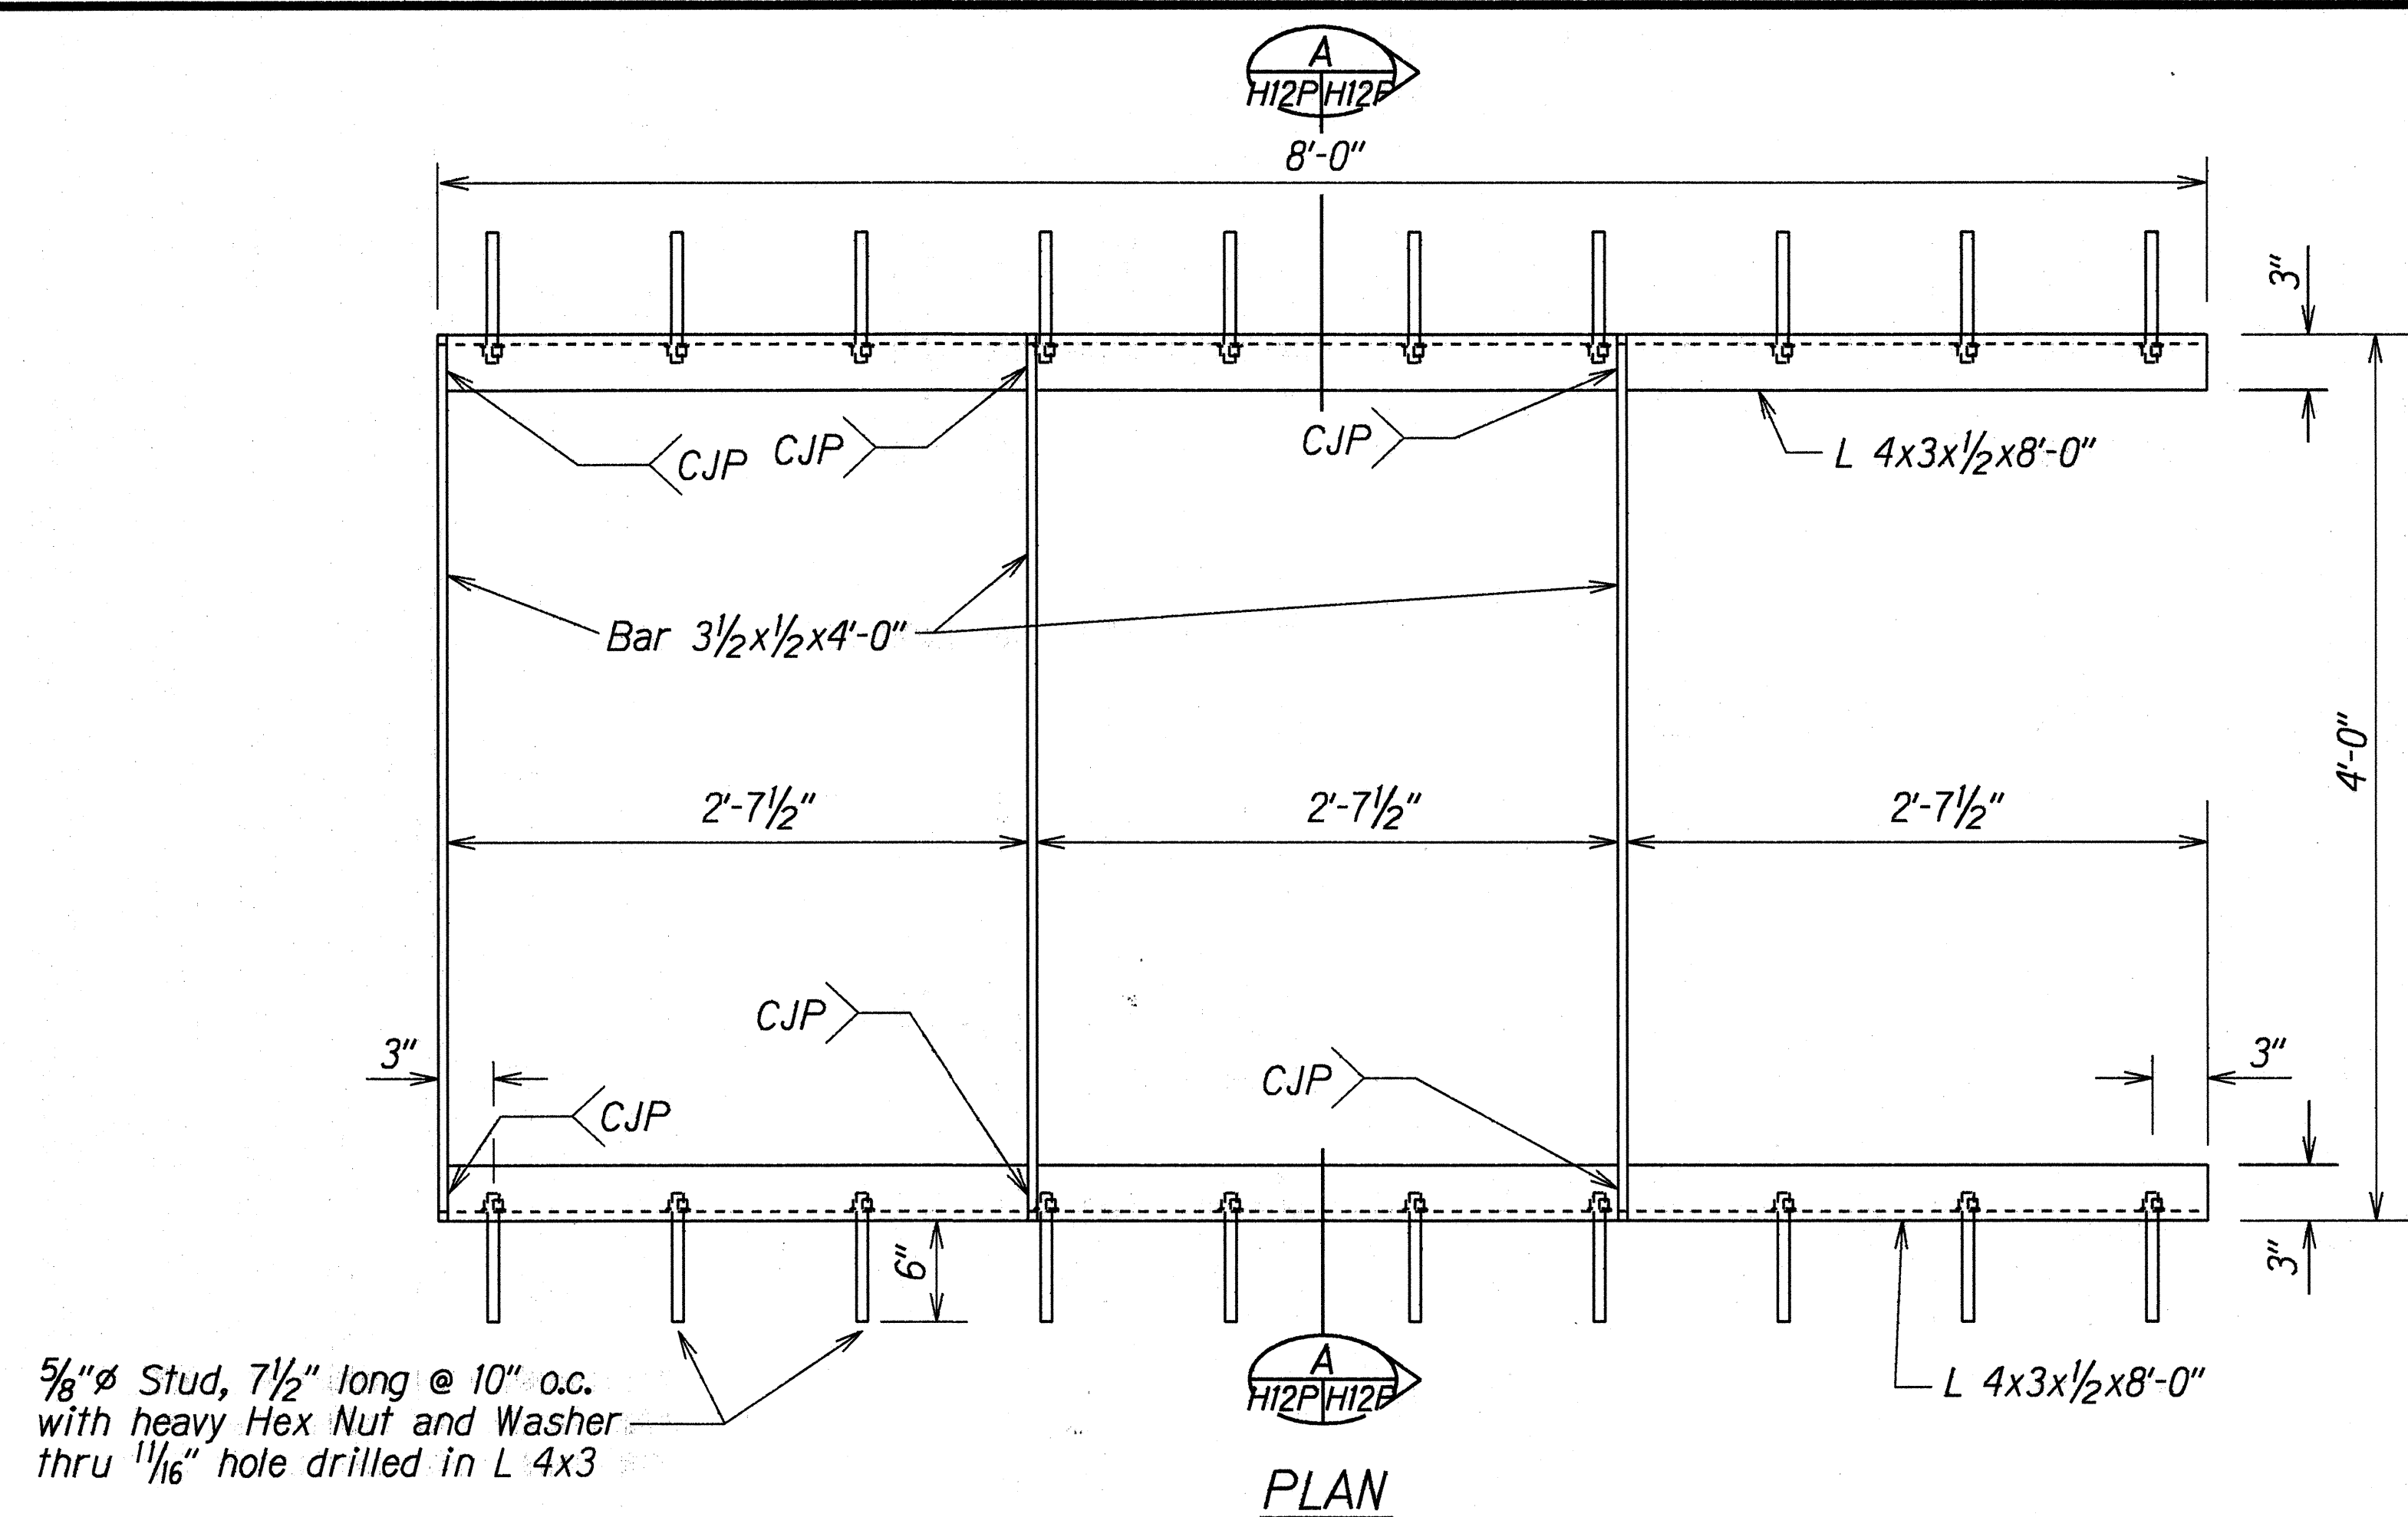

DETAILS OF STEEL FRAME

DETAIL OF STUD HOLE
Half Size

DETAILS OF STEEL GRATES

DETAILS OF TYPE A-11 STEEL FRAME AND GRATES

NOTE
Frames and grates shall be hot dip galvanized after fabrication.

ORIGINAL PLAN	DATE	4/14/97
SURVEY PLOTTED BY		
DRAWN BY		
CHECKED BY		
NOTED BY		
DESIGNED BY		
QUANTITIES BY		
CHECKED BY		

4/15/97	Details added to complete drainage plan.
DATE	REVISION
STATE OF HAWAII DEPARTMENT OF TRANSPORTATION HIGHWAYS DIVISION	
DRAINAGE DETAILS	
KALANIANA'OLE HIGHWAY RESURFACING	
Kailua Rd. to Hilo St.	
Project No. 72A-01-96M	
Scale: 1/2"=1'-0"	Date: Apr. 1997
SHEET No. HI2P OF 12 SHEETS	