

INDEX TO DRAWINGS	
SHEET NO.	DESCRIPTION
1	TITLE SHEET
2	STANDARD PLANS SUMMARY
3	GENERAL NOTES & LEGEND
4-6	TYPICAL SECTIONS & DETAILS
7	UTILITY & MONUMENT ADJUSTMENT SCHEDULES
8-20	PLANS
21-24	RETAINING WALL NOTES & DETAILS
25-43	PAVEMENT MARKING & SIGNING PLANS, DETAILS & NOTES
44-55 (1)	DRAINAGE PLANS & DETAILS

(1) Plan Sht. Nos. C.O.ADD.55 S-I through C.O.55 S-16 are supplemental to this project.
Total sheet count after AS-BUILT posting = 71

STATE OF HAWAII

DEPARTMENT OF TRANSPORTATION

HIGHWAYS DIVISION

HONOLULU, HAWAII

"AS-BUILT"

PLANS FOR

KALANIANA'OLE HIGHWAY

RESURFACING




KAILUA ROAD TO HILU STREET

PROJECT NO. 72A-01-96M

DISTRICT OF KOOLAUPOKO

ISLAND OF OAHU

FED. ROAD DIST. NO.	STATE	PROJ. NO.	FISCAL YEAR	SHEET NO.	TOTAL SHEETS
HAWAII	HAW.	72A-01-96M	1996	1	55

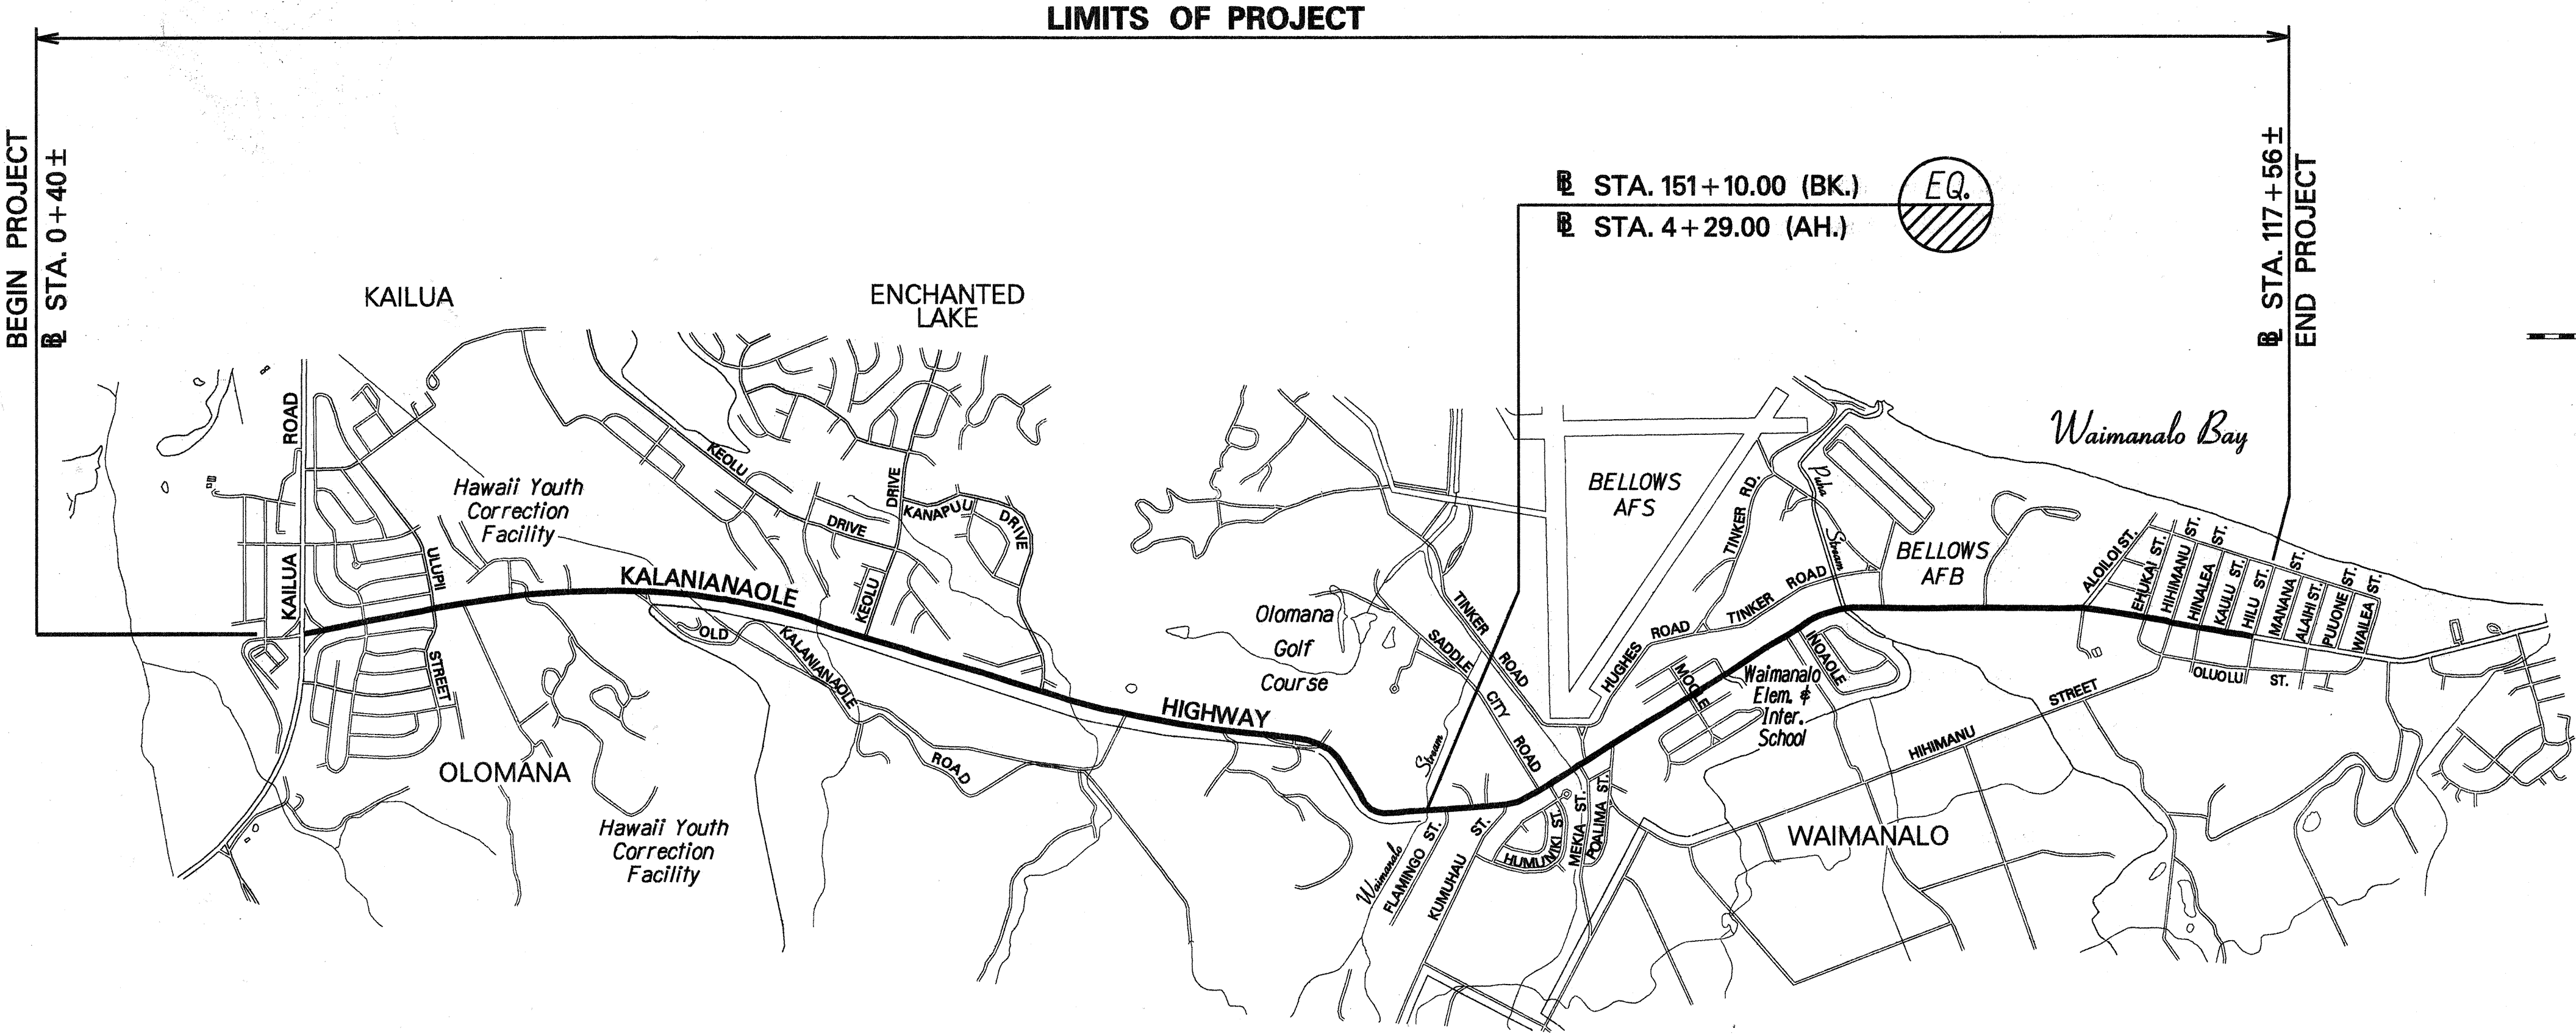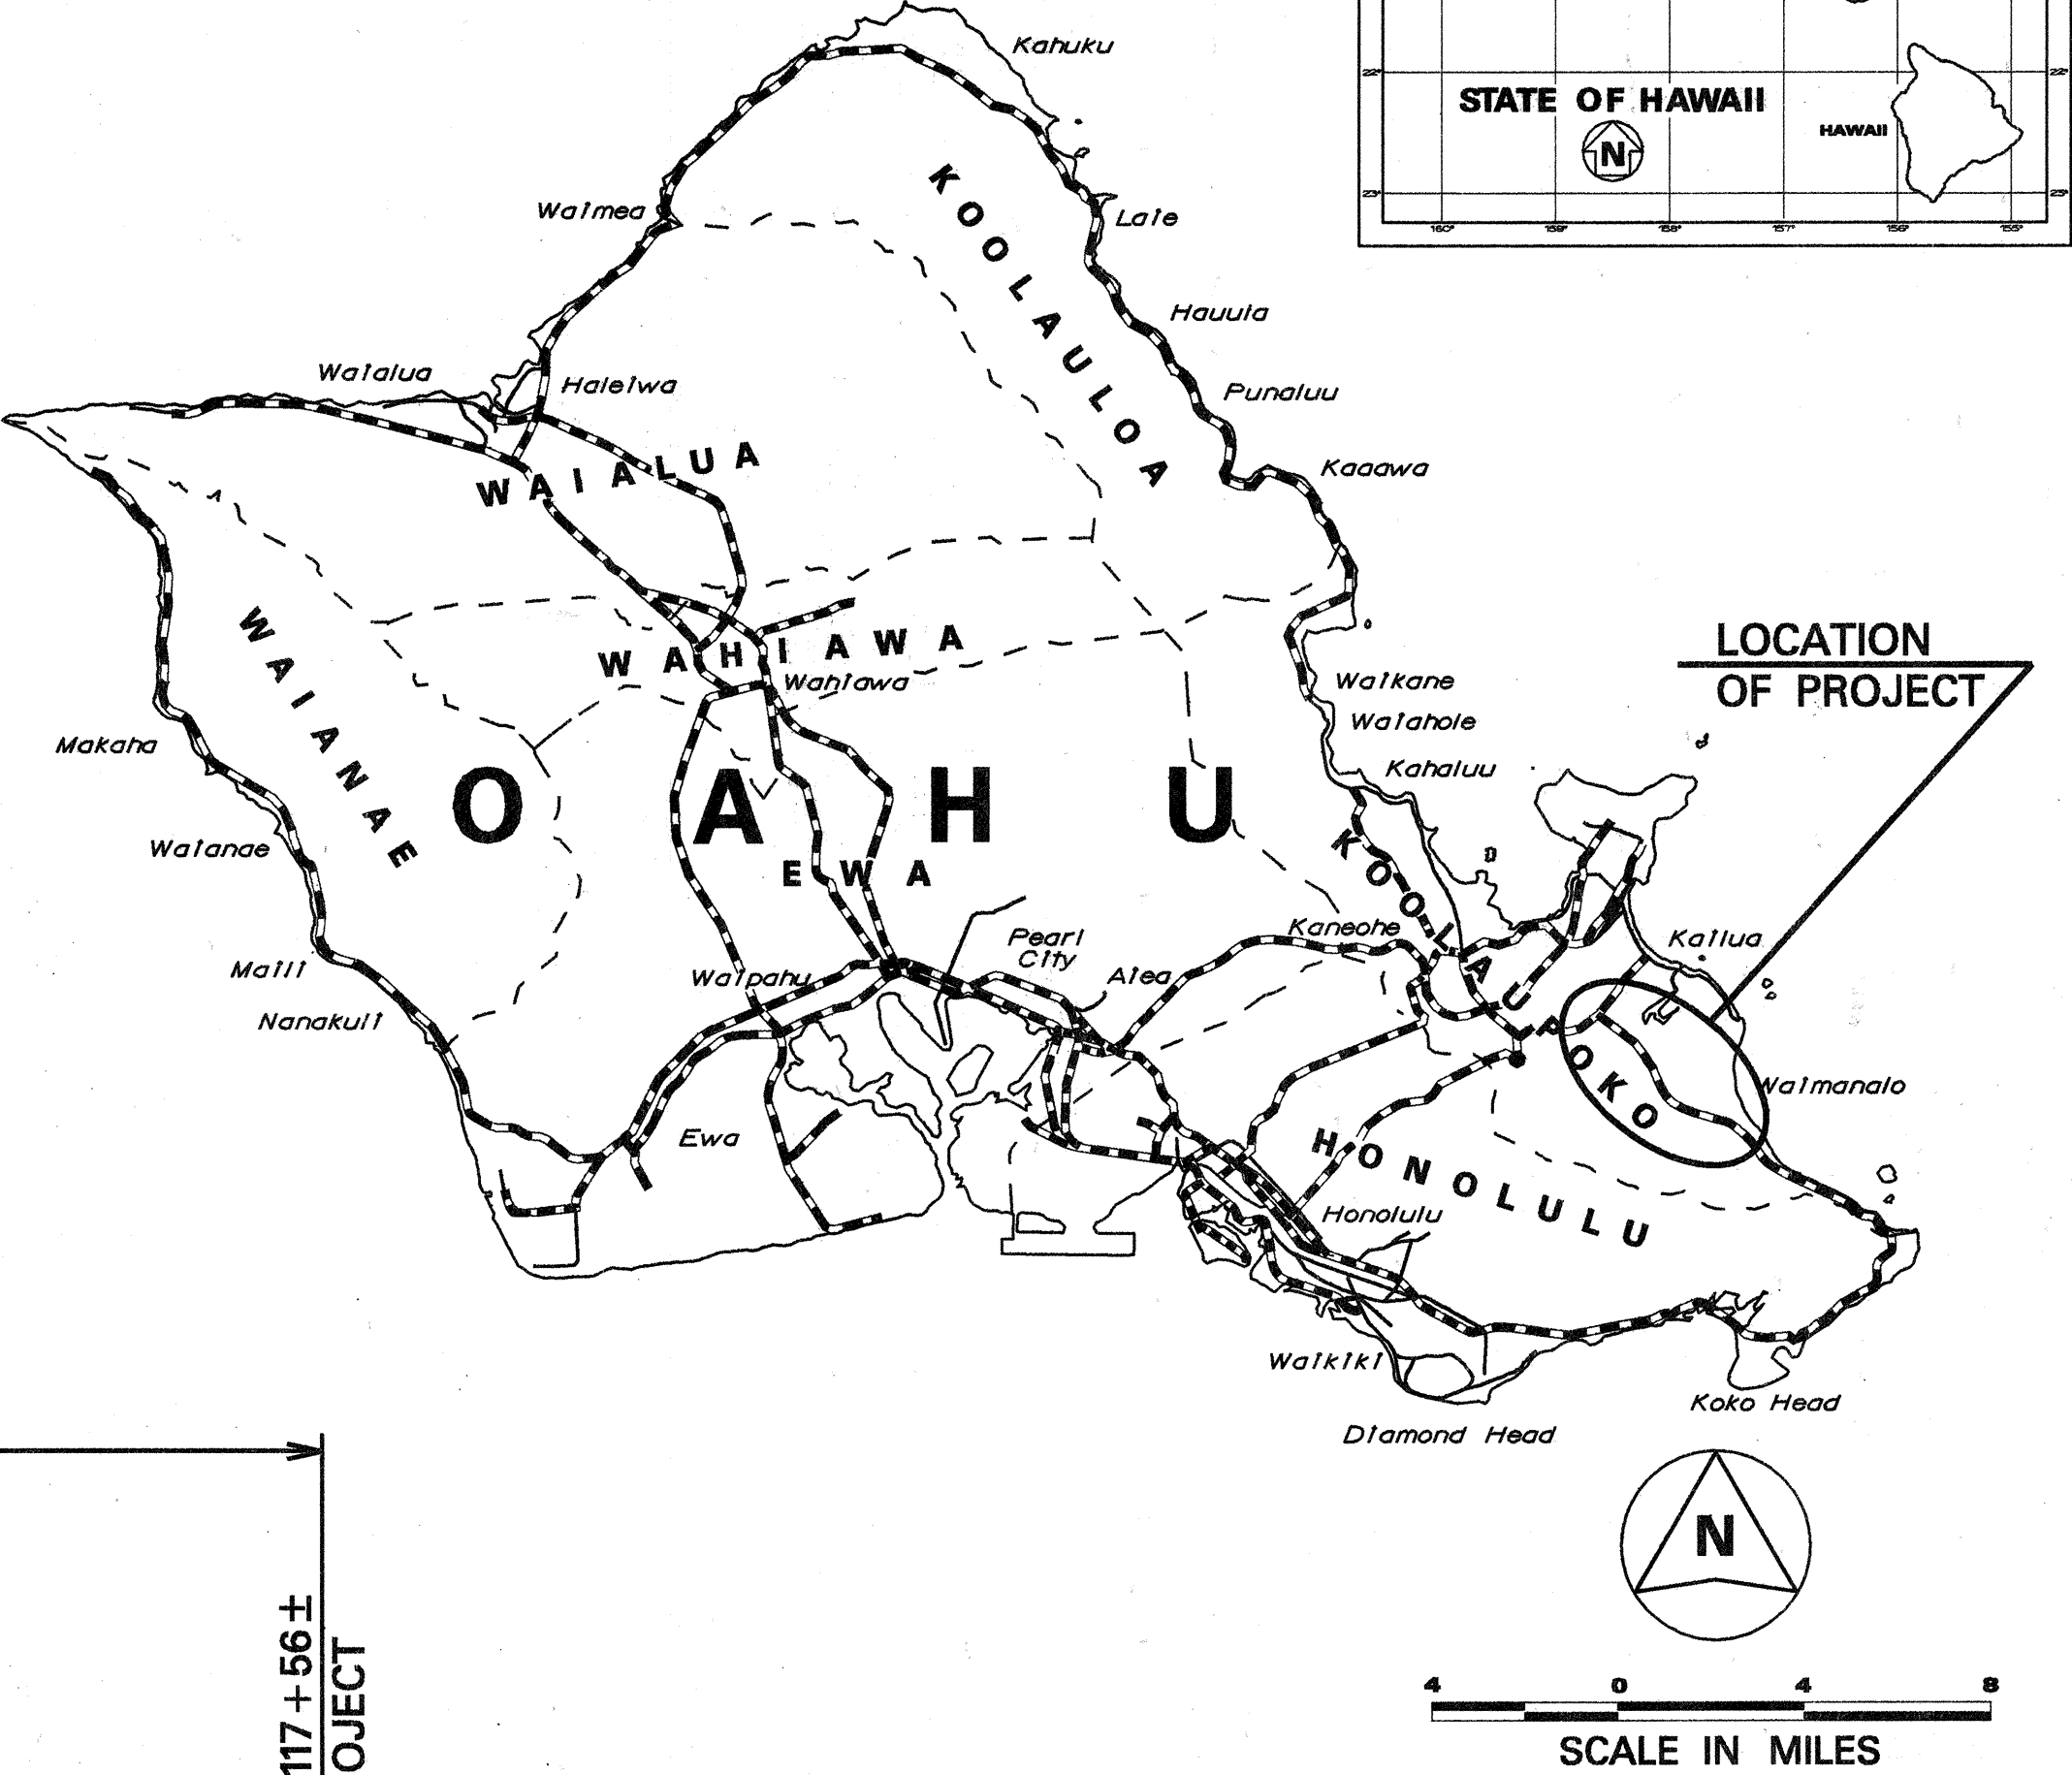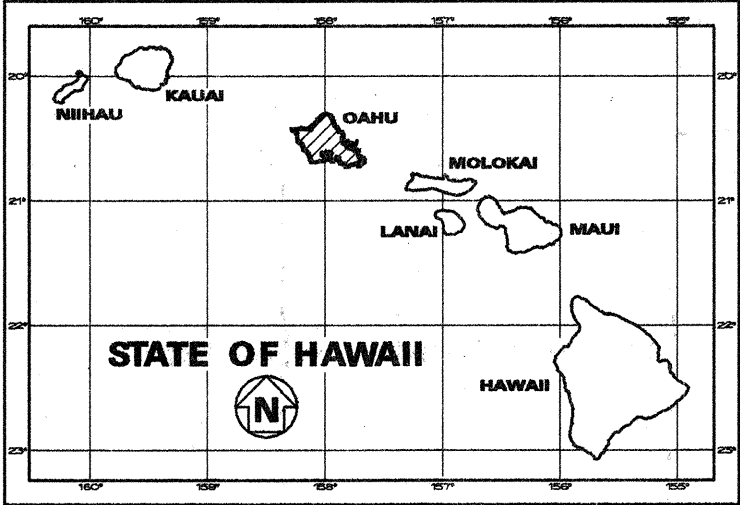

----- FEDERAL AID PROJECTS PREVIOUSLY CONSTRUCTED OR UNDER CONSTRUCTION

MILE POST 0.00 TO MILE POST 4.99

CHANGES MADE DURING CONSTRUCTION HAVE BEEN INCORPORATED ON THESE PLANS EXCEPT CHANGES IN THE ORIGINAL THEORETICAL QUANTITIES. FOR ACTUAL QUANTITIES, REFER TO PROJECT LEDGER AND/OR COMPUTATION BOOK.

RESIDENT ENGINEER

DATE

DEPARTMENT OF TRANSPORTATION STATE OF HAWAII	
APPROVED:	
<i>Lesyn Bayarshid</i>	5/29/96
DIR. OF TRANSPORTATION	DATE

DESIGN UNIT "A" DESIGNED BY JULIUS B. FRONDA P.S. & E. BY MAY 1996 DATE 587-2246 PHONE

LAYOUT PLAN
LENGTH OF PROJECT..... 4.99 MILES