



INDEX TO DRAWINGS	
SHEET NO.	DESCRIPTION
1	TITLE SHEET
2	STANDARD PLANS SUMMARY
3	GENERAL NOTES AND LEGEND
4 - 6	TYPICAL SECTIONS AND DETAILS
7 - 11	ROADWAY PLAN
12 - 13	CURB RAMP DETAILS
14 - 21	DRAINAGE DETAILS
22 - 32	PAVEMENT MARKING AND SIGNING PLAN

STATE OF HAWAII
DEPARTMENT OF TRANSPORTATION
HIGHWAYS DIVISION
HONOLULU, HAWAII


PLANS FOR
KALANIANA'OLE HIGHWAY RESURFACING
KEAHOLE STREET TO HANAUMA BAY
PROJECT NO. 72BC-01-97M

DISTRICT OF HONOLULU
ISLAND OF OAHU

FED. ROAD DIST. NO.	STATE	PROJ. NO.	FISCAL YEAR	SHEET NO.	TOTAL SHEETS
HAWAII	HAW.	72BC-01-97M	1997	1	32

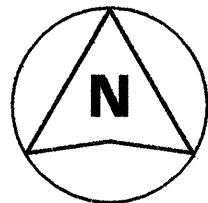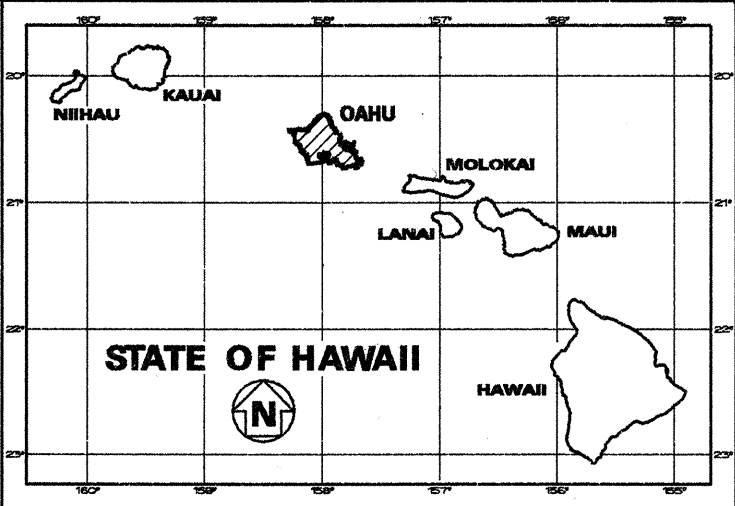

SCALE IN MILES

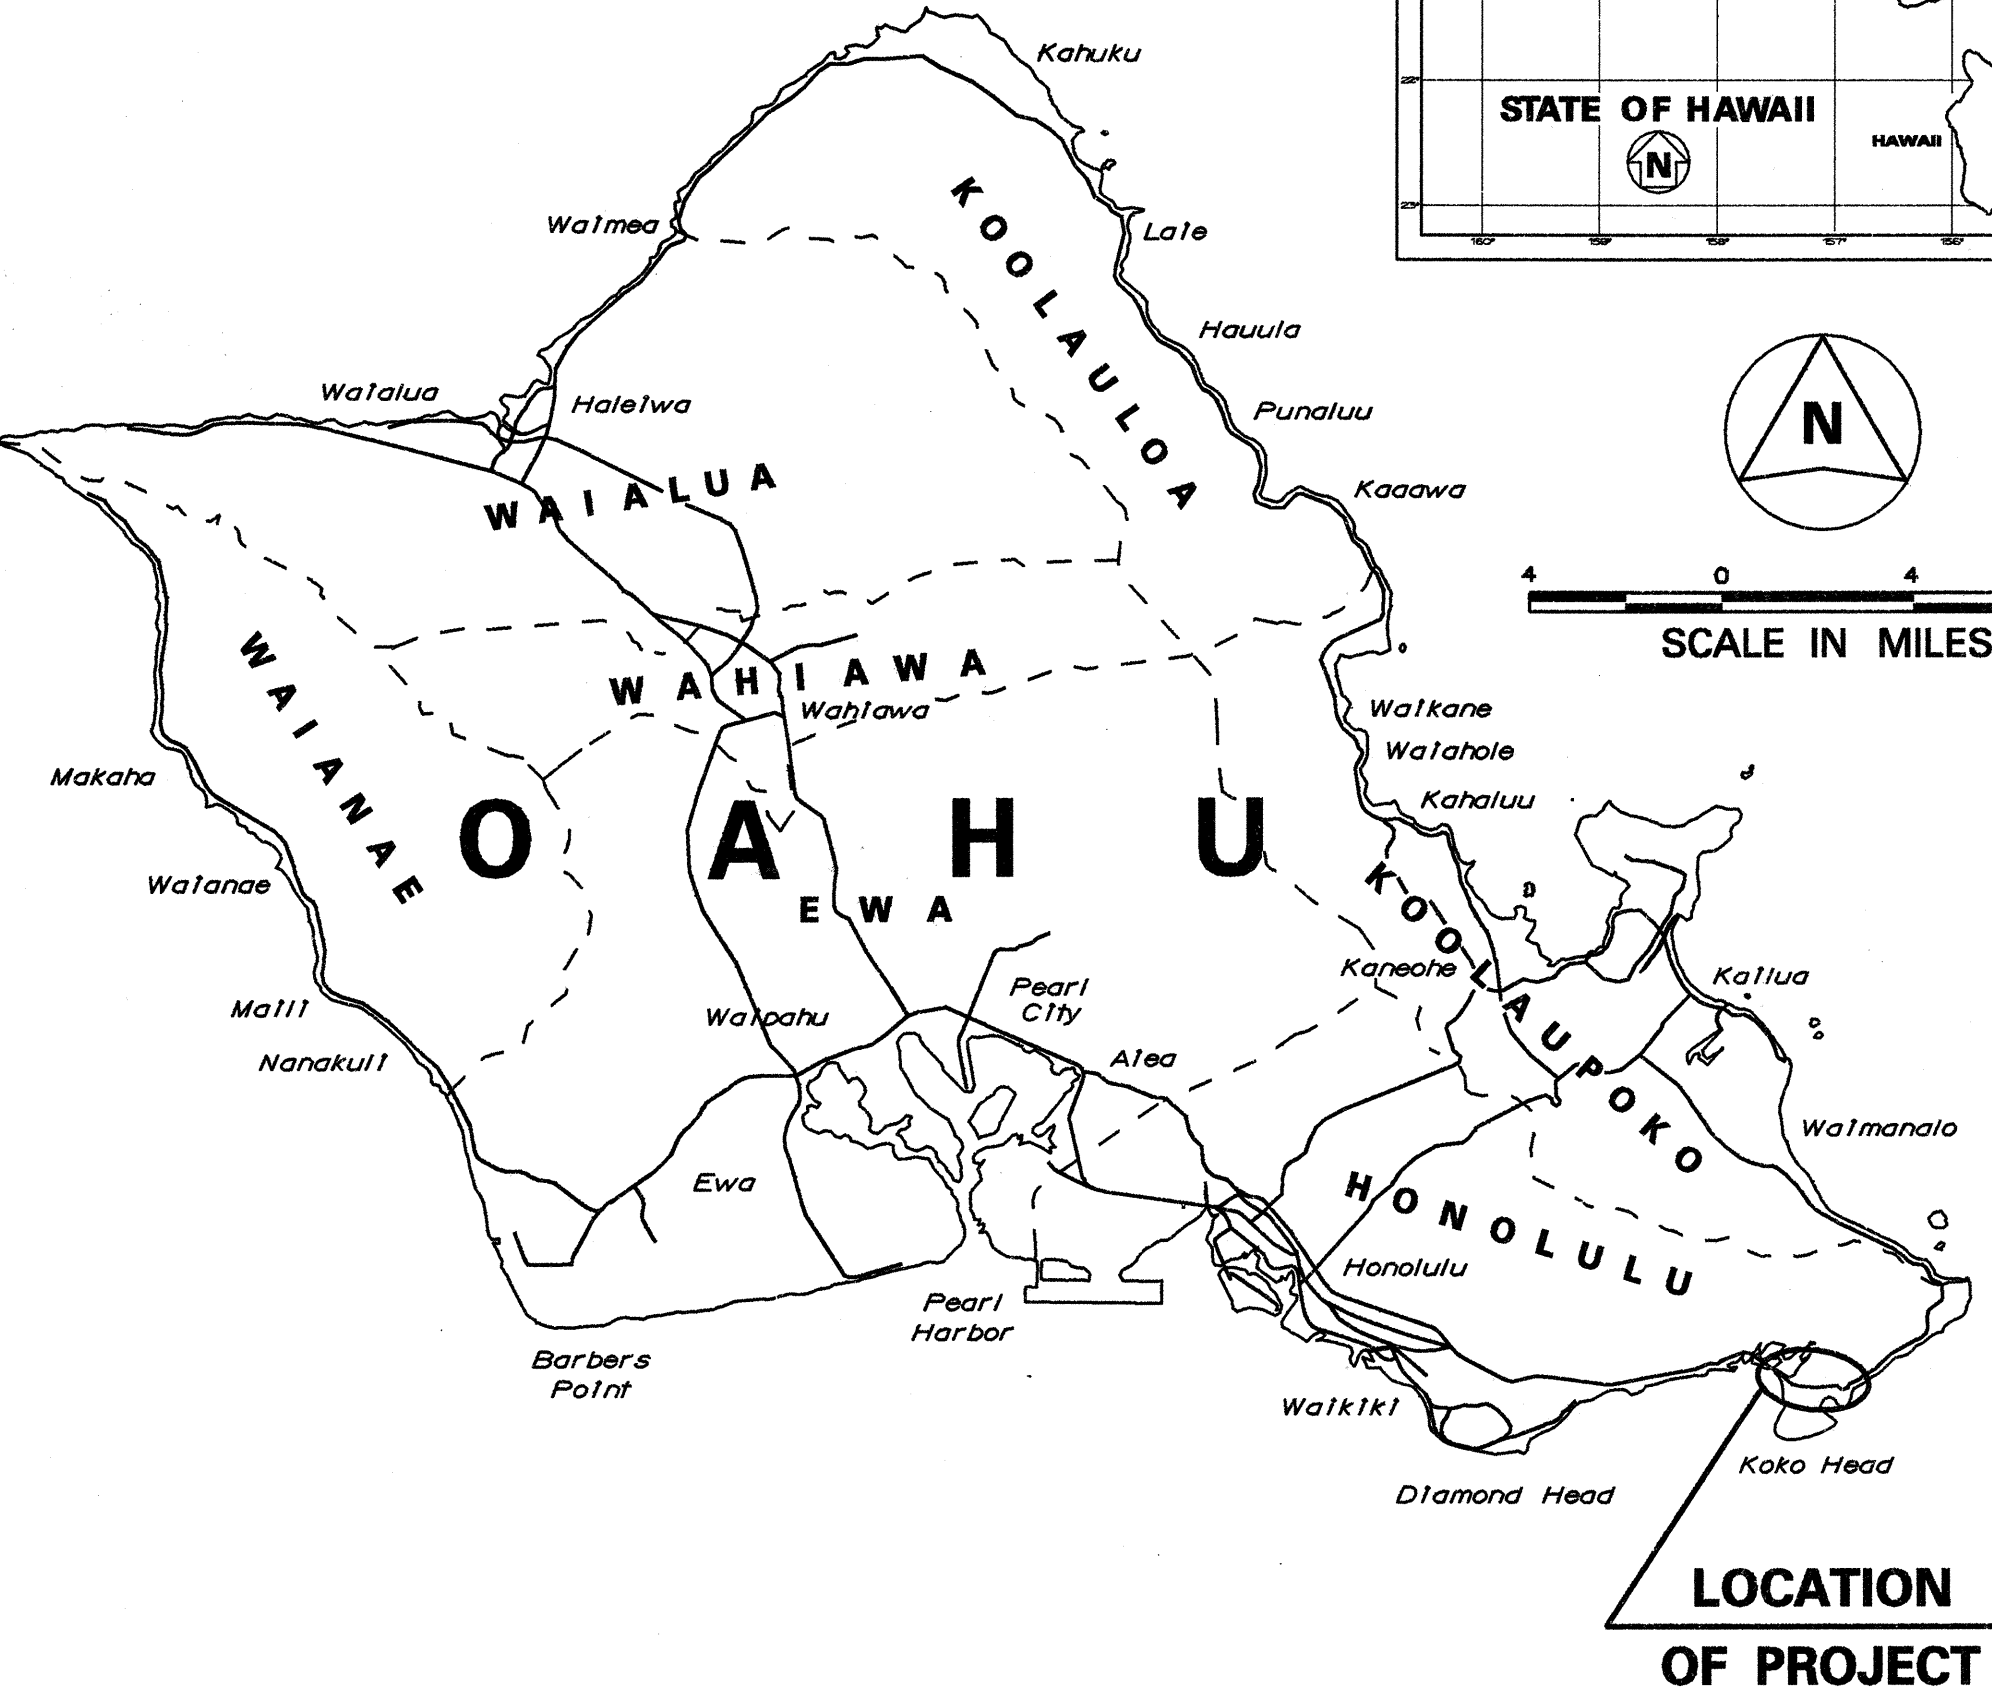


MILE POST 13.98 TO MILE POST 12.49

CHANGES MADE DURING CONSTRUCTION HAVE BEEN INCORPORATED ON THESE PLANS EXCEPT CHANGES IN THE ORIGINAL THEORETICAL QUANTITIES. FOR ACTUAL QUANTITIES, REFER TO PROJECT LEDGER AND/OR COMPUTATION BOOK.

Signature 4/5/02
RESIDENT ENGINEER DATE

DEPARTMENT OF TRANSPORTATION
STATE OF HAWAII
APPROVED:
Signature 6/4/97
DIR. OF TRANSPORTATION DATE

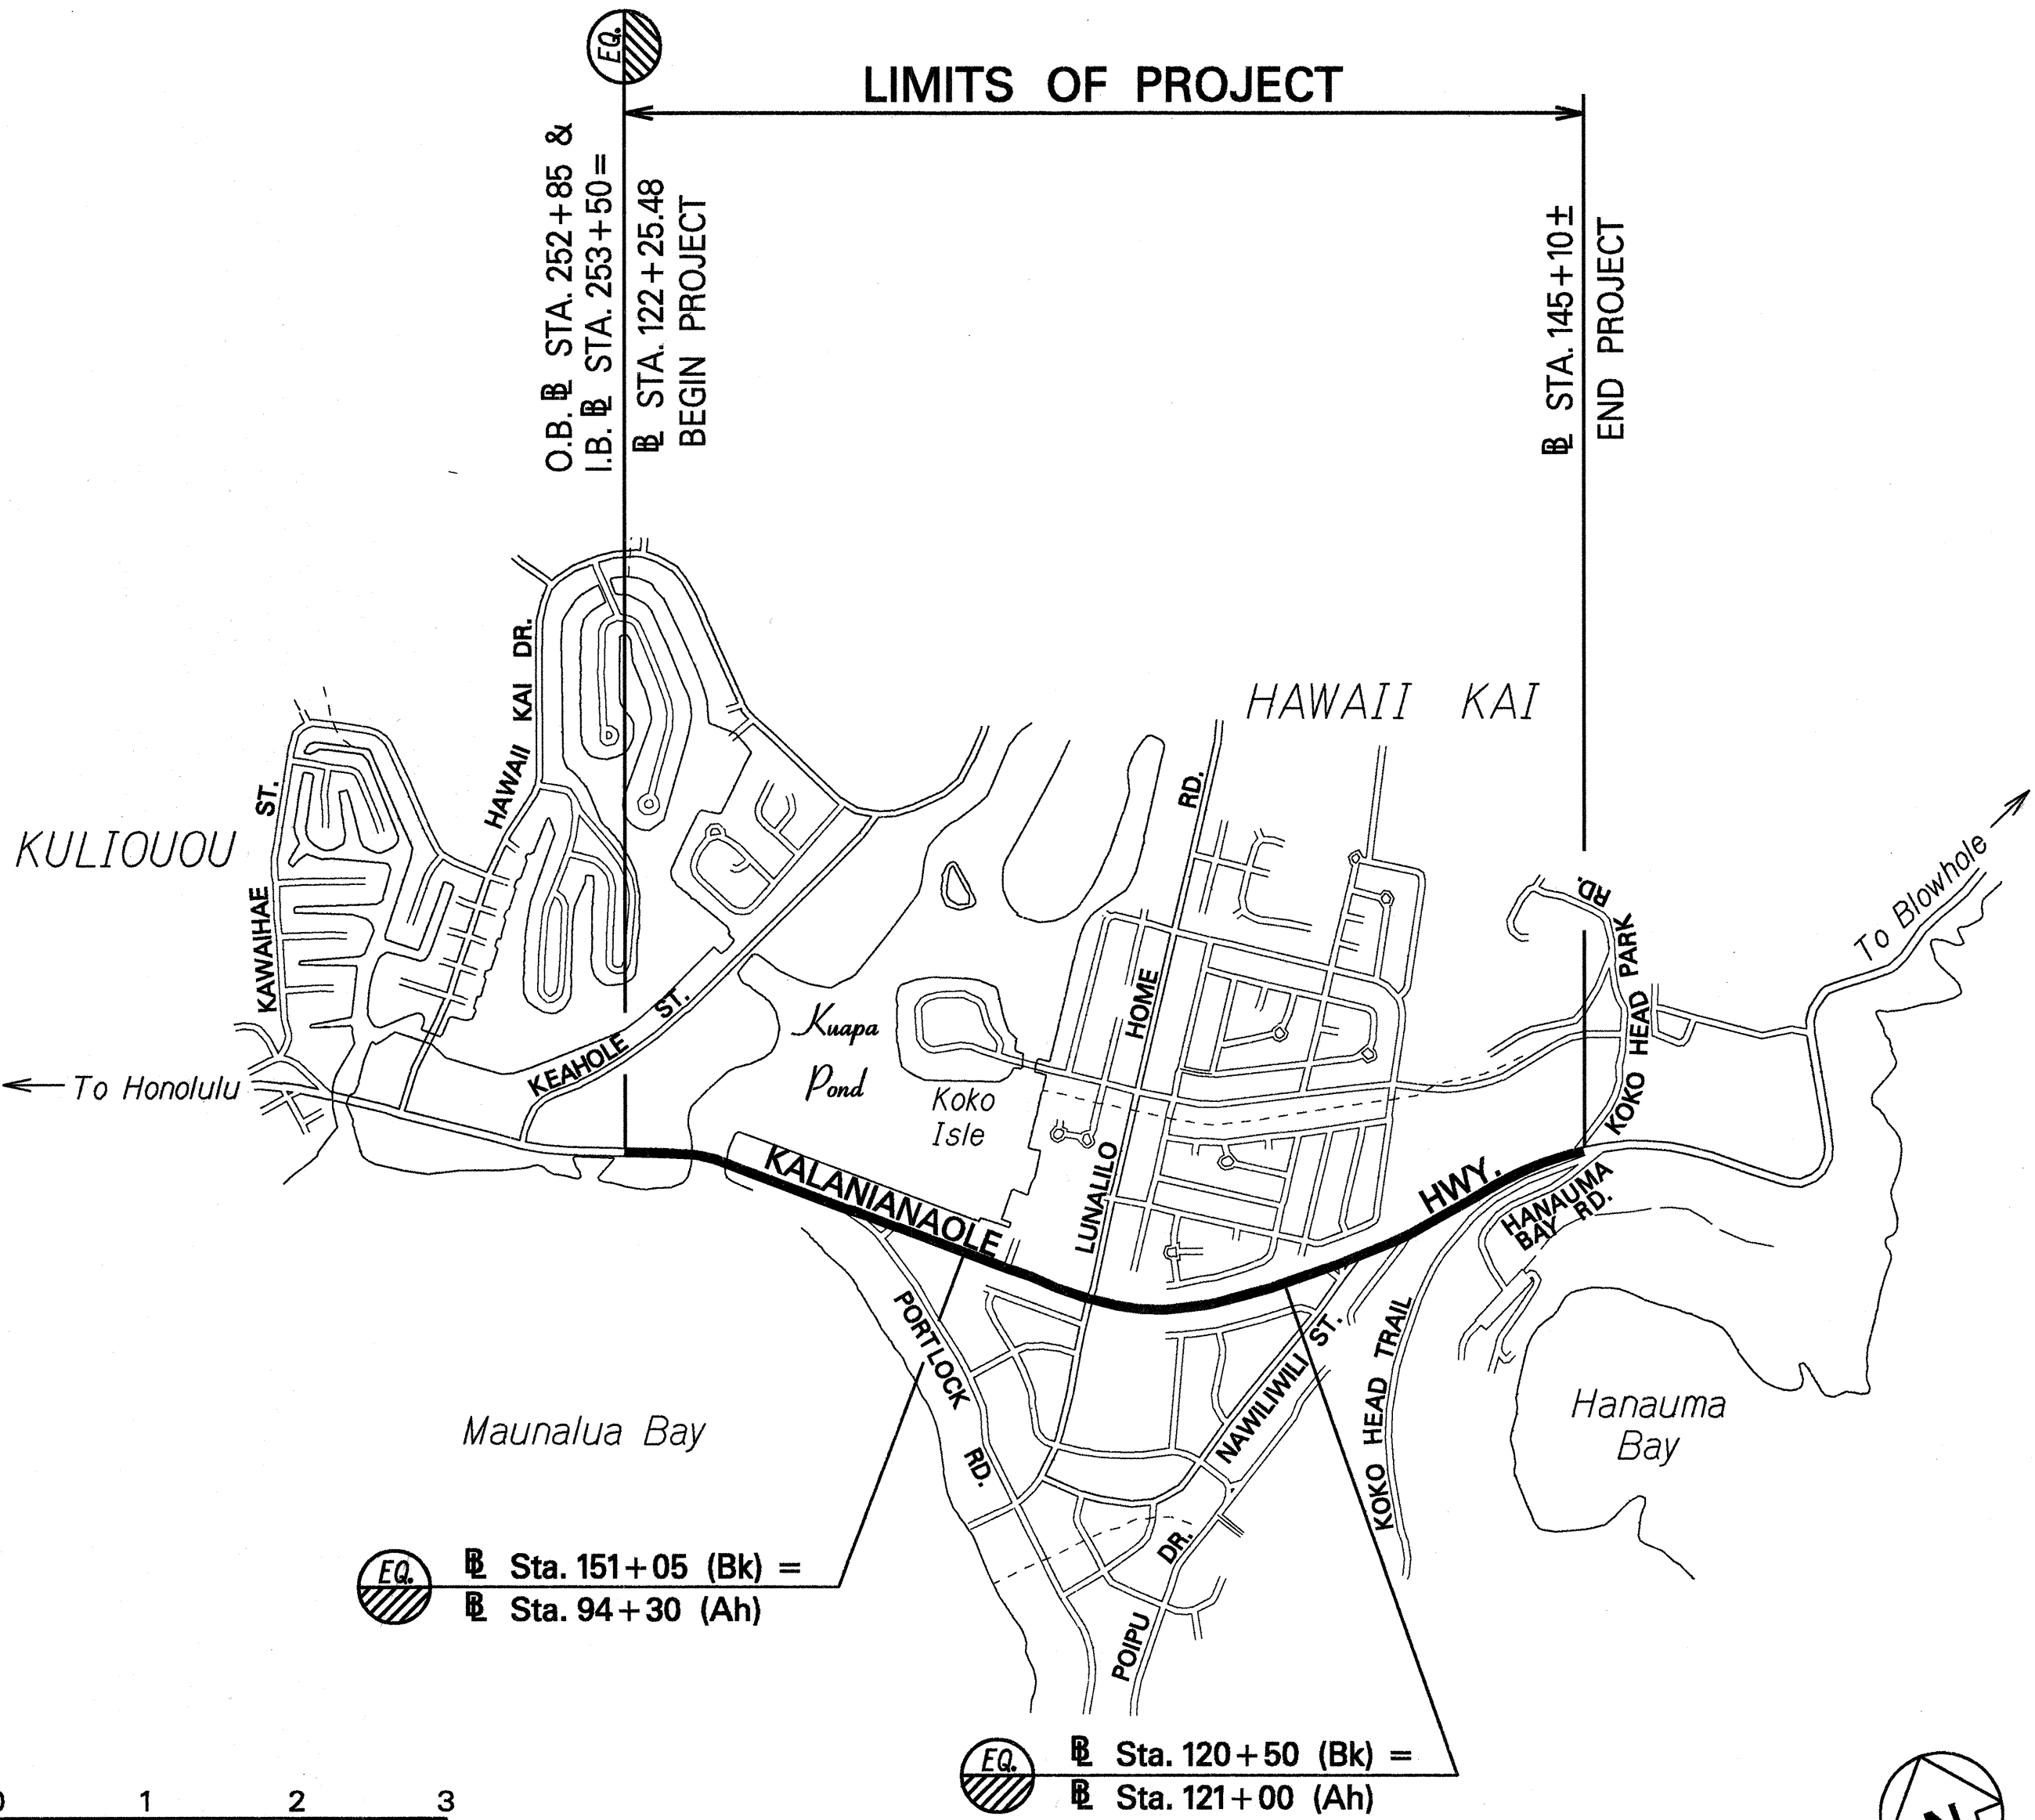

LOCATION PLAN

LENGTH OF PROJECT.....1.49 MILES

HWY-DD DESIGNED BY KEVIN ITO P.S. & E. BY 587-2238 PHONE MAY 1997 DATE