
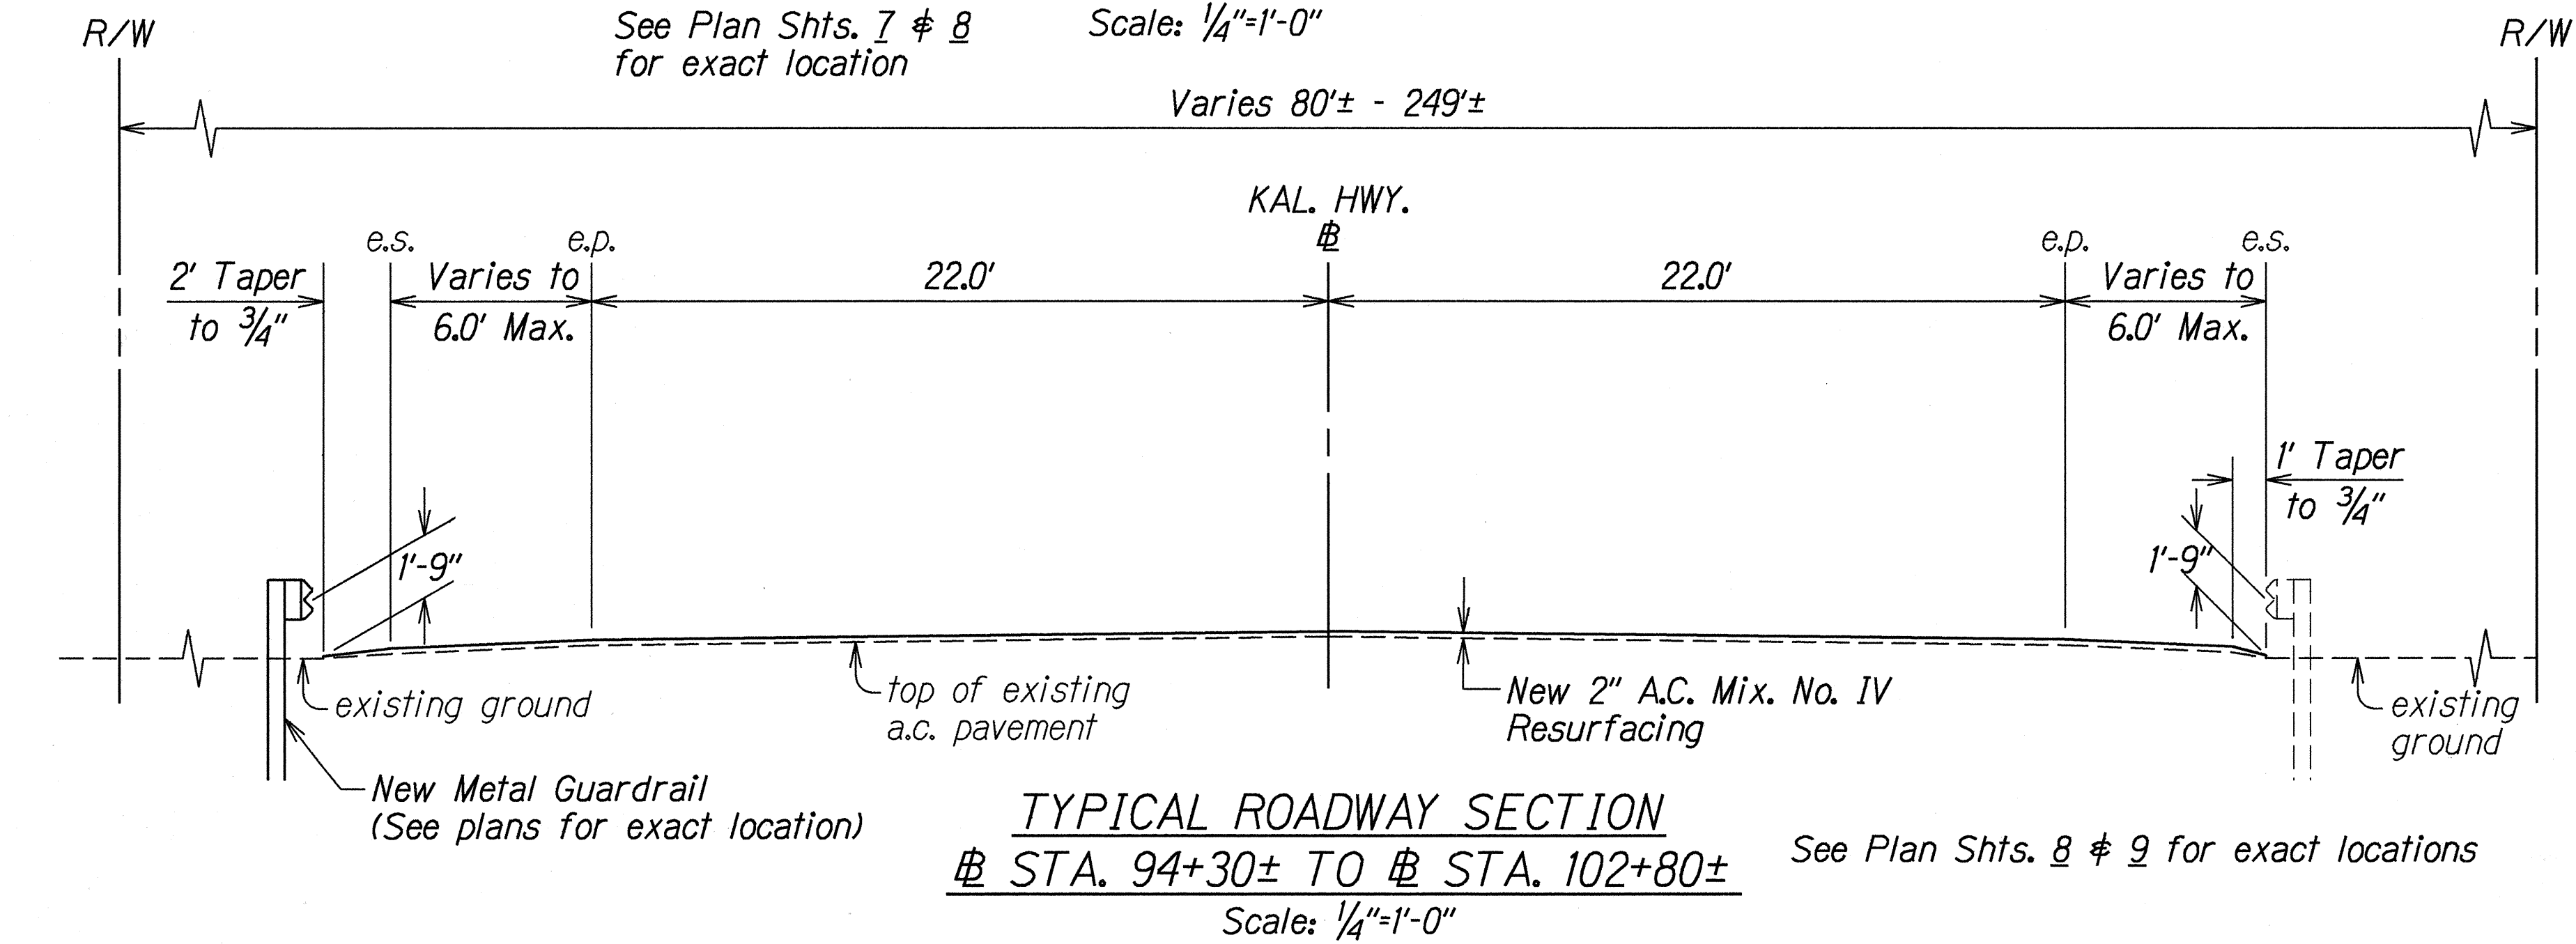
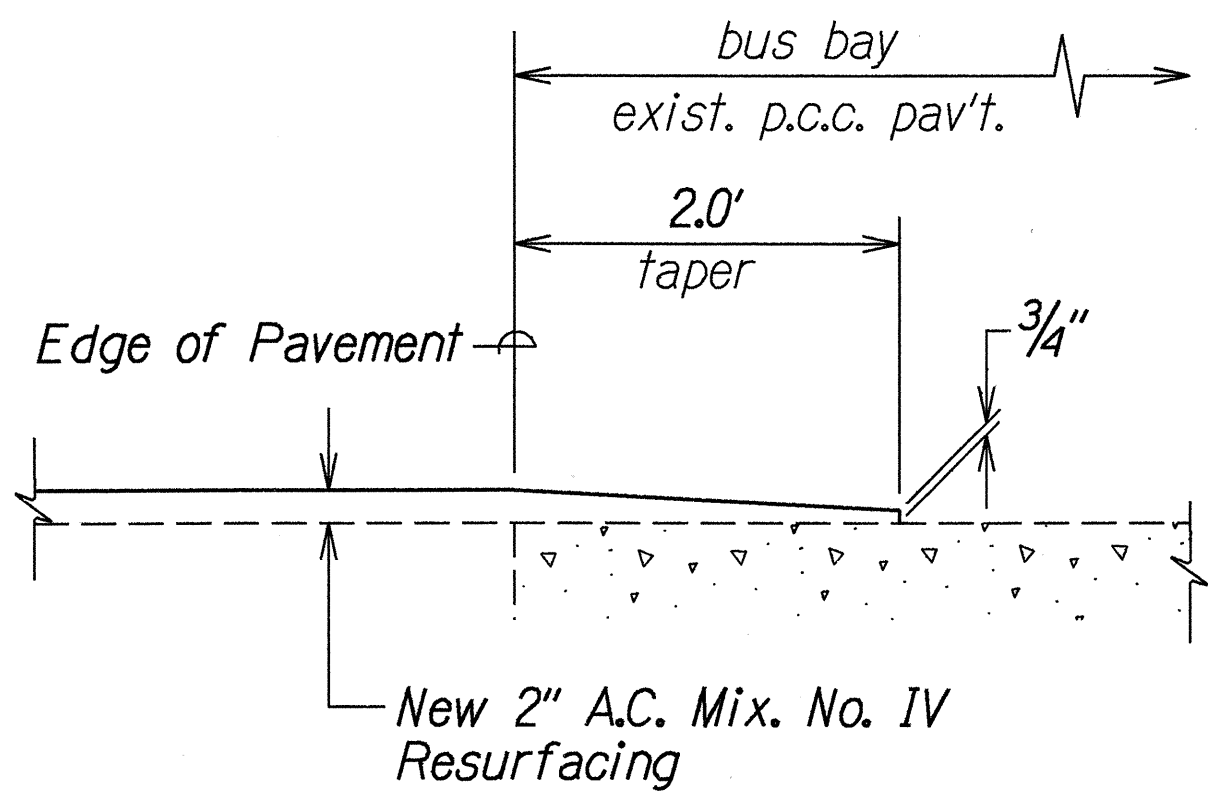
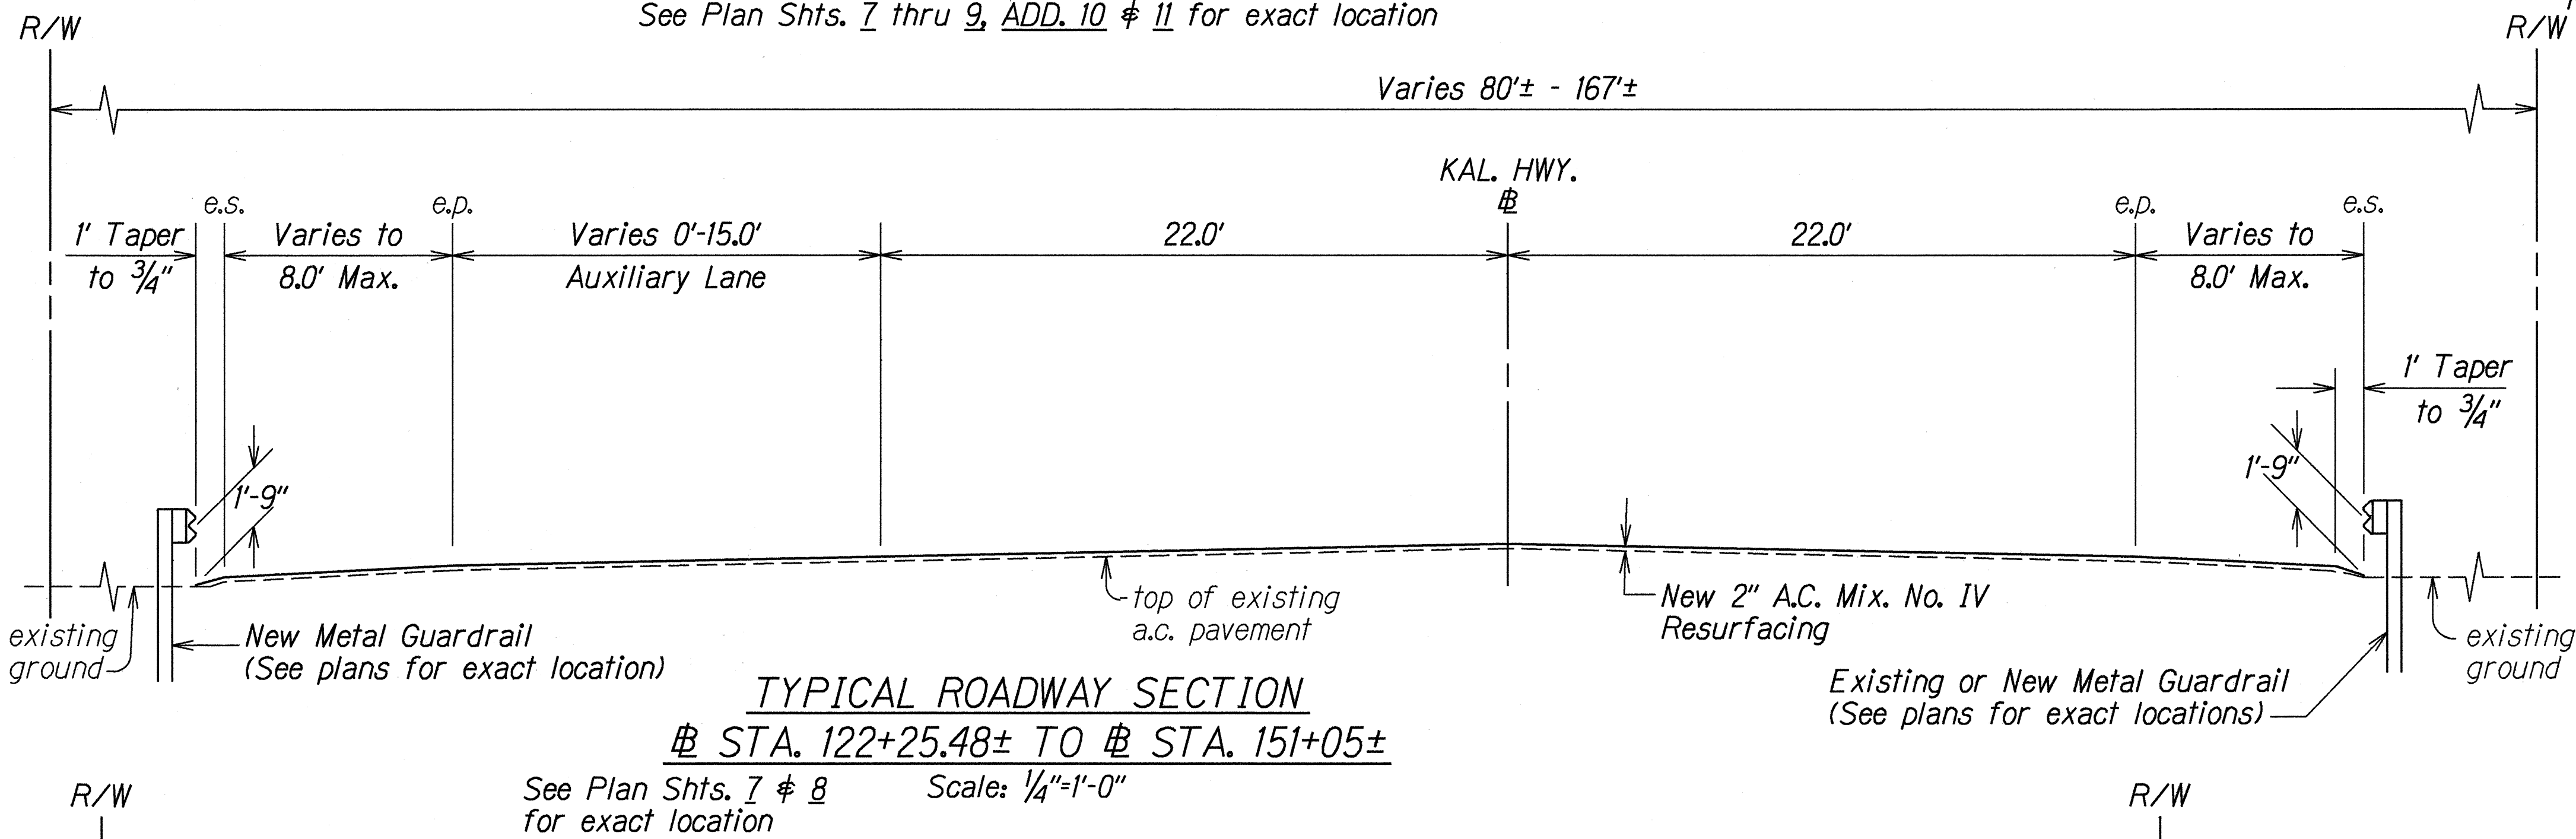
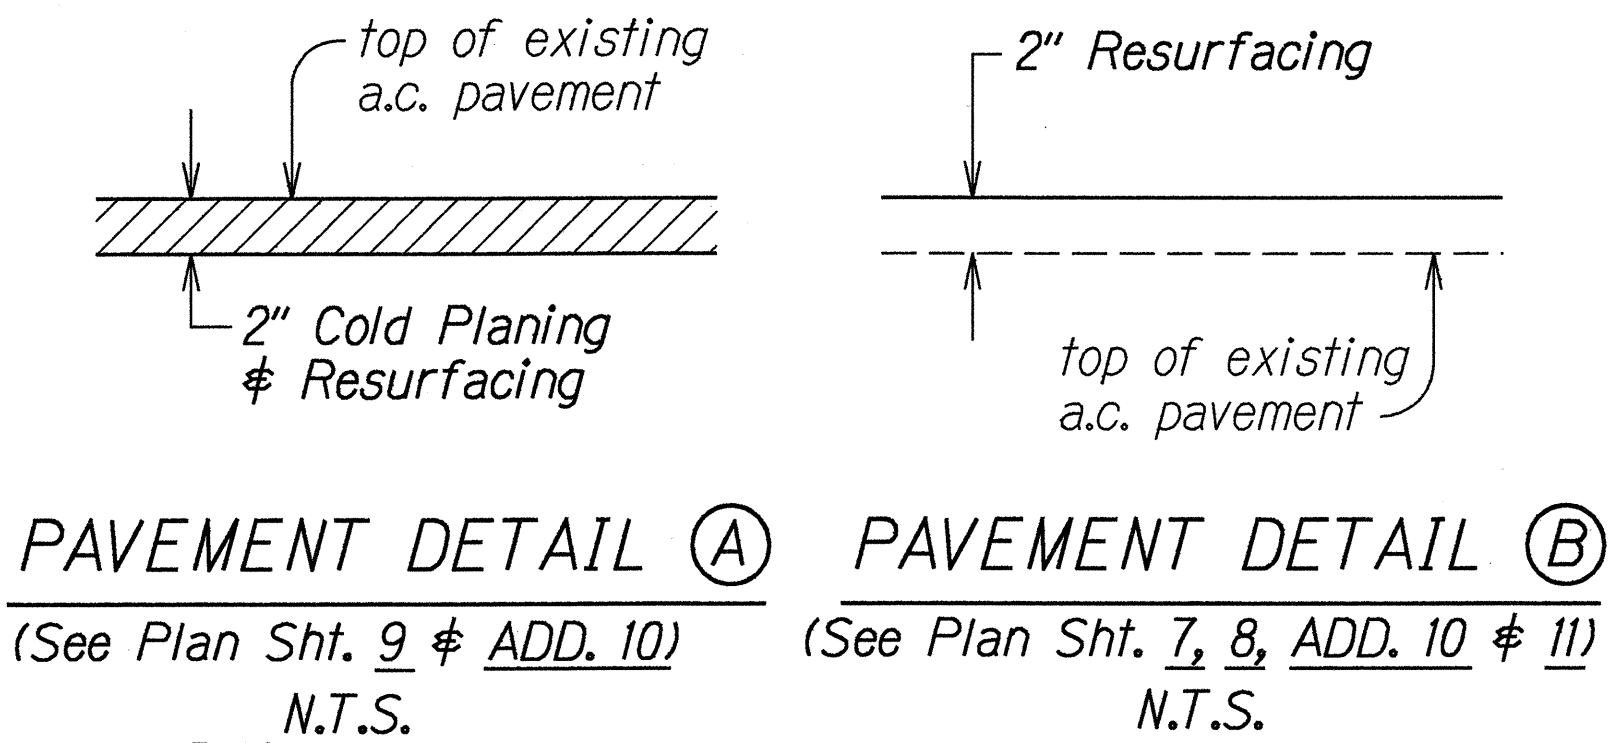


FED. ROAD DIST. NO.	STATE	PROJ. NO.	FISCAL YEAR	SHEET NO.	TOTAL SHEETS
HAWAII	HAW.	72BC-01-97M	1997	4	32

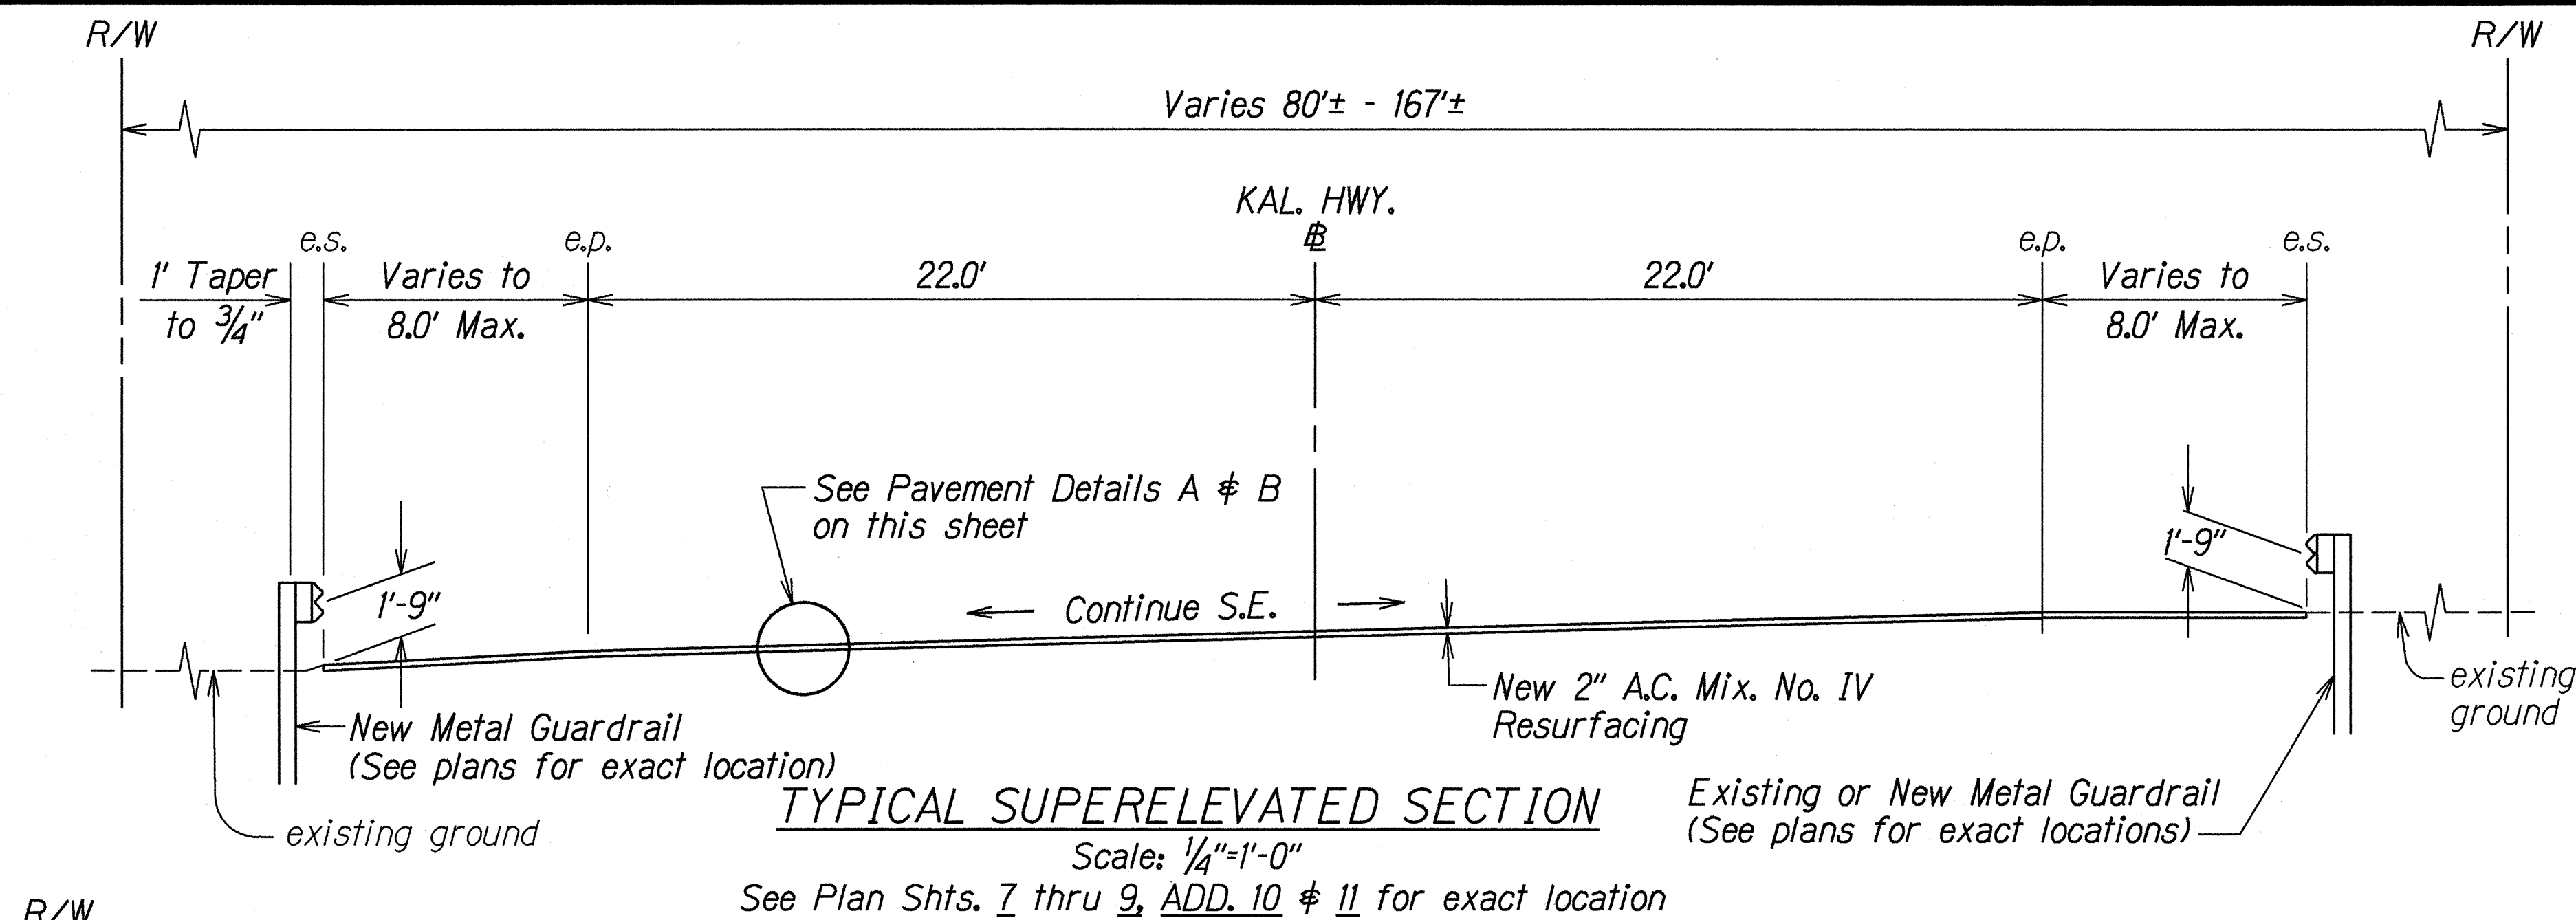

DATE	REVISION
7-18-97	Revised Typical Section to show auxiliary lane per Addendum No. 1
7-18-97	Revised two shoulder dimensions per Addendum No. 1
7-18-97	Revised notes per Addendum No. 1

STATE OF HAWAII
 DEPARTMENT OF TRANSPORTATION
 HIGHWAYS DIVISION

TYPICAL SECTIONS & DETAILS



KALANIANA'OLE HWY. RESURFACING
 Keahole St. to Hanauma Bay
 Proj. No. 72BC-01-97M

Scale: As Shown Date: May, 1997

SHEET No. 1 OF 3 SHEETS

ORIGINAL PLAN	DATE
SURVEY PLOTTED BY	7-22-97
DRAWN BY	J. Matsunaga/L.P. Wong, M.H.
DESIGNED BY	K. Chun
CHECKED BY	N. Gleditsia
NOTED BY	

FED. ROAD DIST. NO.	STATE	PROJ. NO.	FISCAL YEAR	SHEET NO.	TOTAL SHEETS
HAWAII	HAW.	72BC-01-97M	1997	5	32

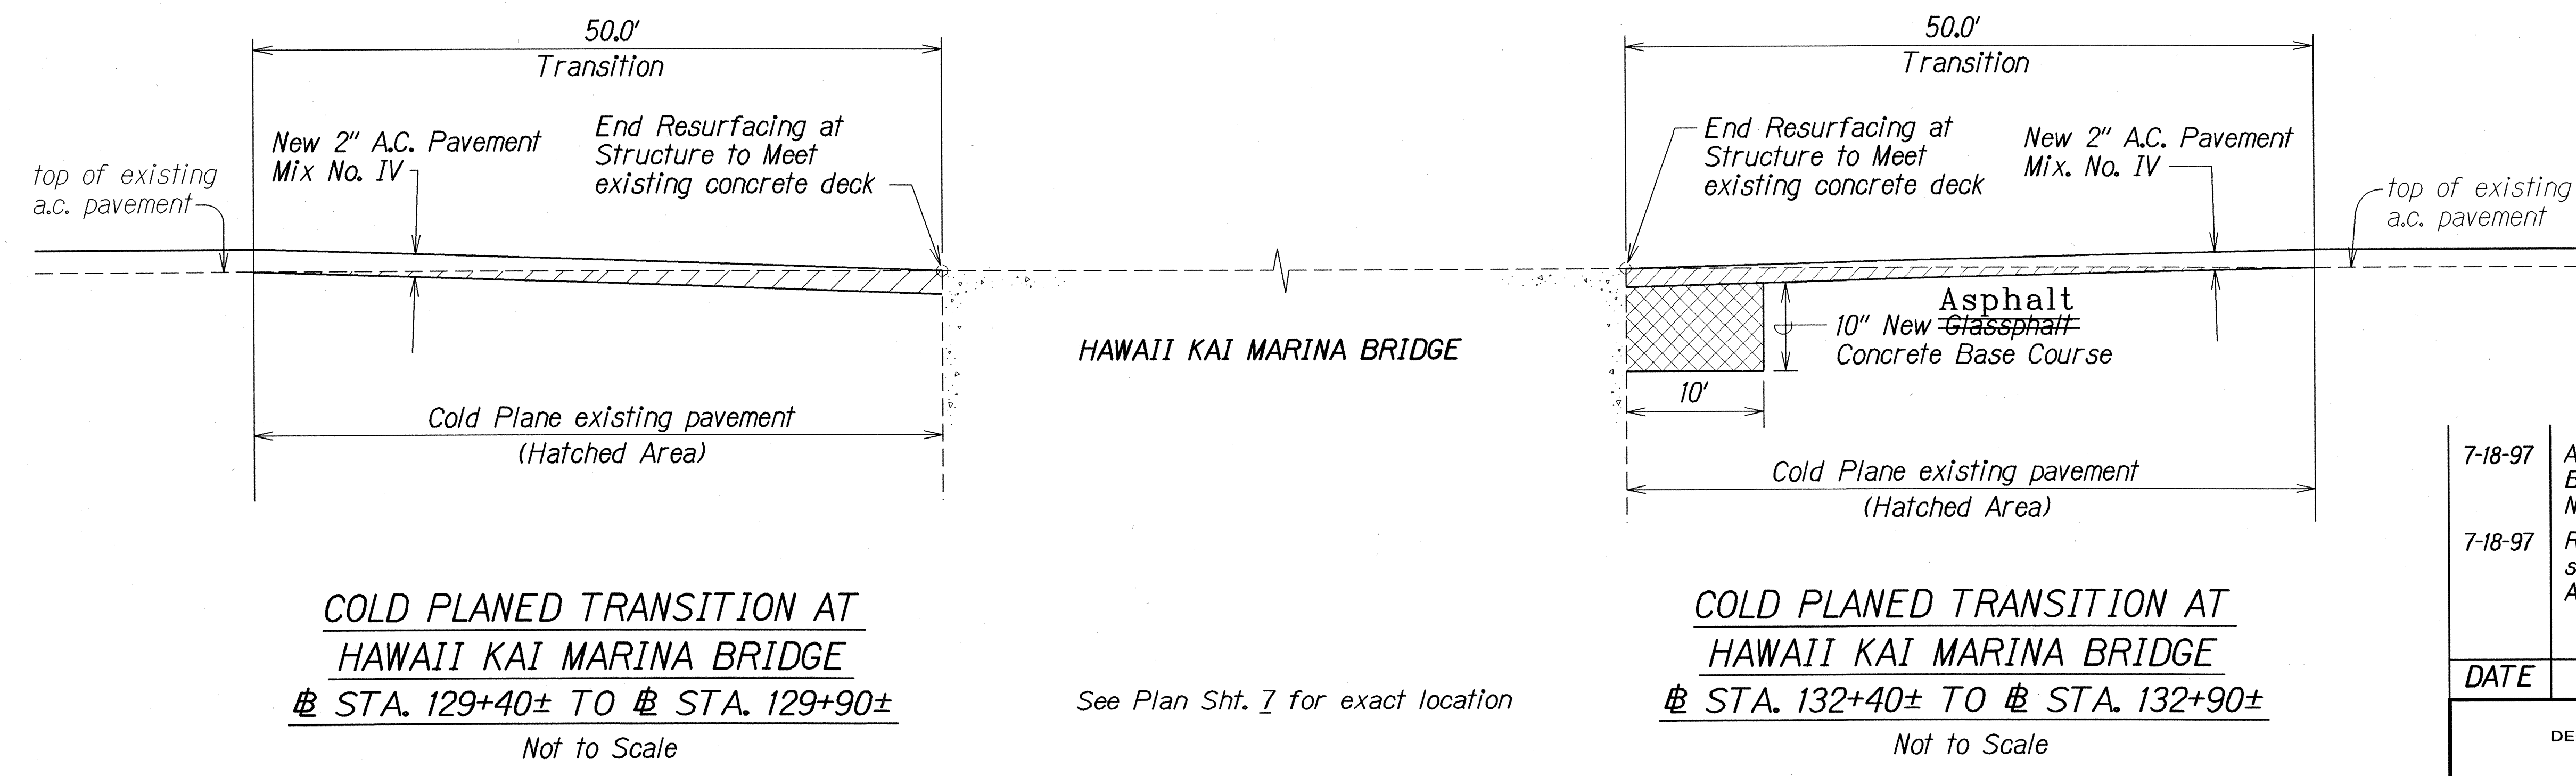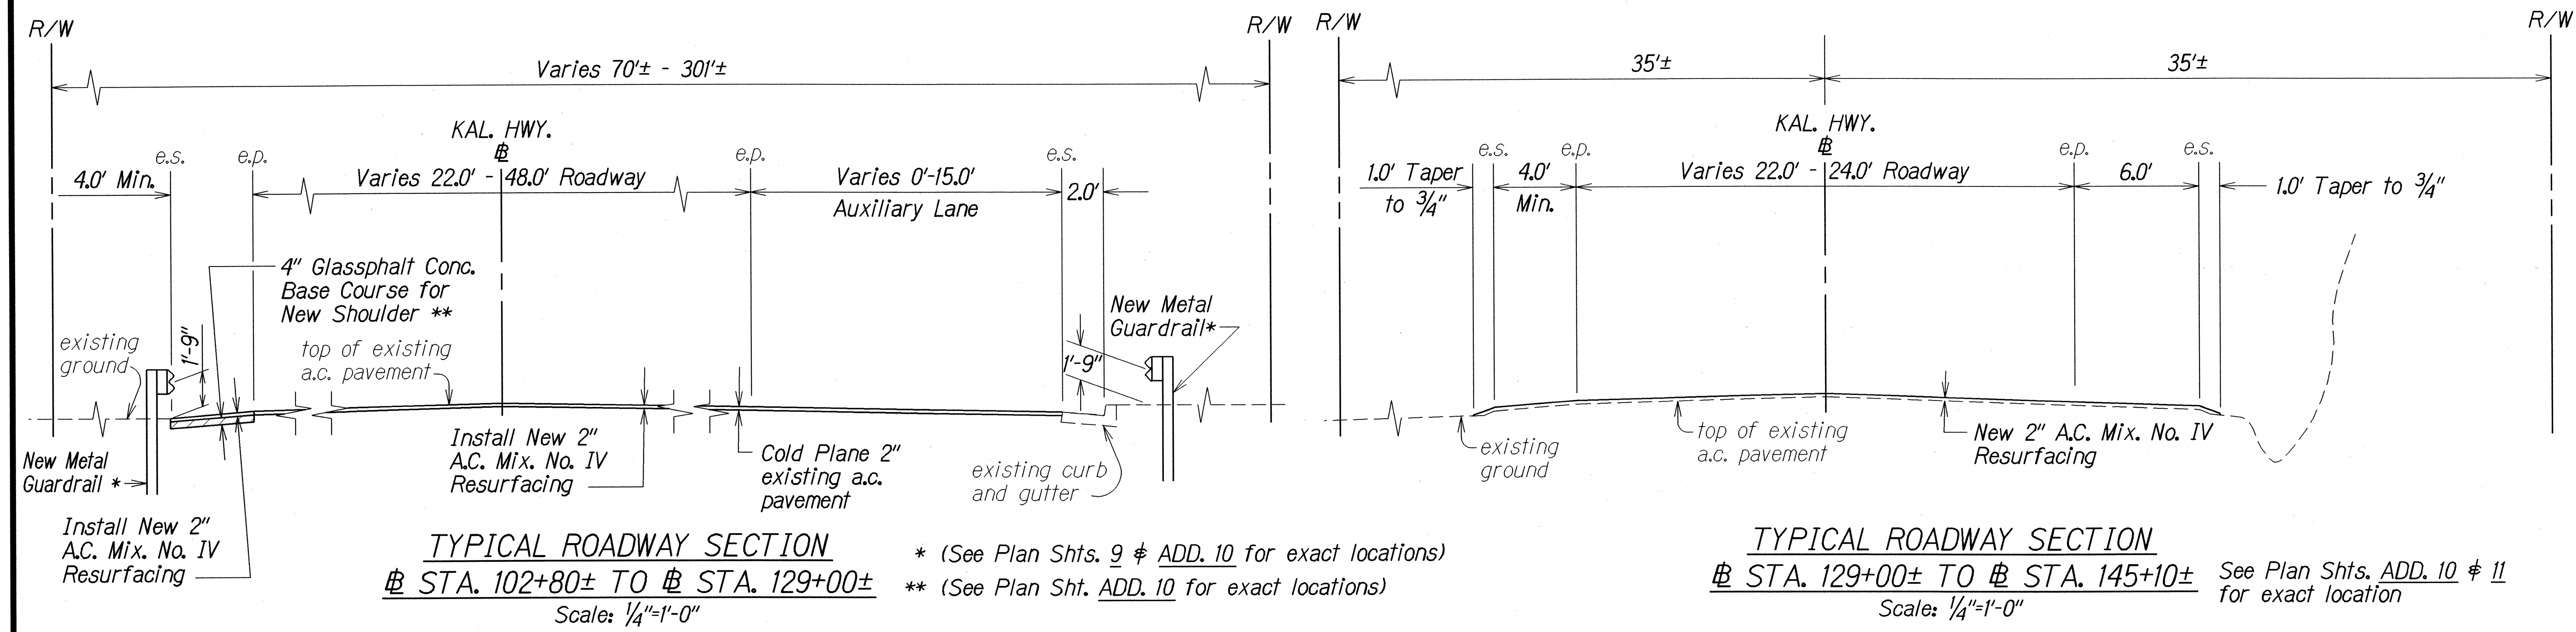


ORIGINAL PLAN	DATE
NOTED BY	DATE
DESIGNED BY	DATE
CHECKED BY	DATE

7-18-97	Add detail of 4" Glassphalt Concrete Base for new shoulder per Addendum No. 1
7-18-97	Revised roadway width dimension, shoulder dimension and notes per Addendum No. 1


DATE	REVISION
STATE OF HAWAII DEPARTMENT OF TRANSPORTATION HIGHWAYS DIVISION	
TYPICAL SECTIONS & DETAILS	
KALANIANA'OLE HWY. RESURFACING	
Keahole St. to Hanauma Bay	
Proj. No. 72BC-01-97M	
Scale: As Shown	Date: May, 1997
SHEET No. 2 OF 3 SHEETS	

LEGEND FOR AS-BUILT POSTINGS	
	Squiggly line for as-built deletion
	Double line for as-built deletion
Roadway	Text for as-built posting


FED. ROAD DIST. NO.	STATE	PROJ. NO.	FISCAL YEAR	SHEET NO.	TOTAL SHEETS
HAWAII	HAW.	72BC-01-97M	1997	6	32

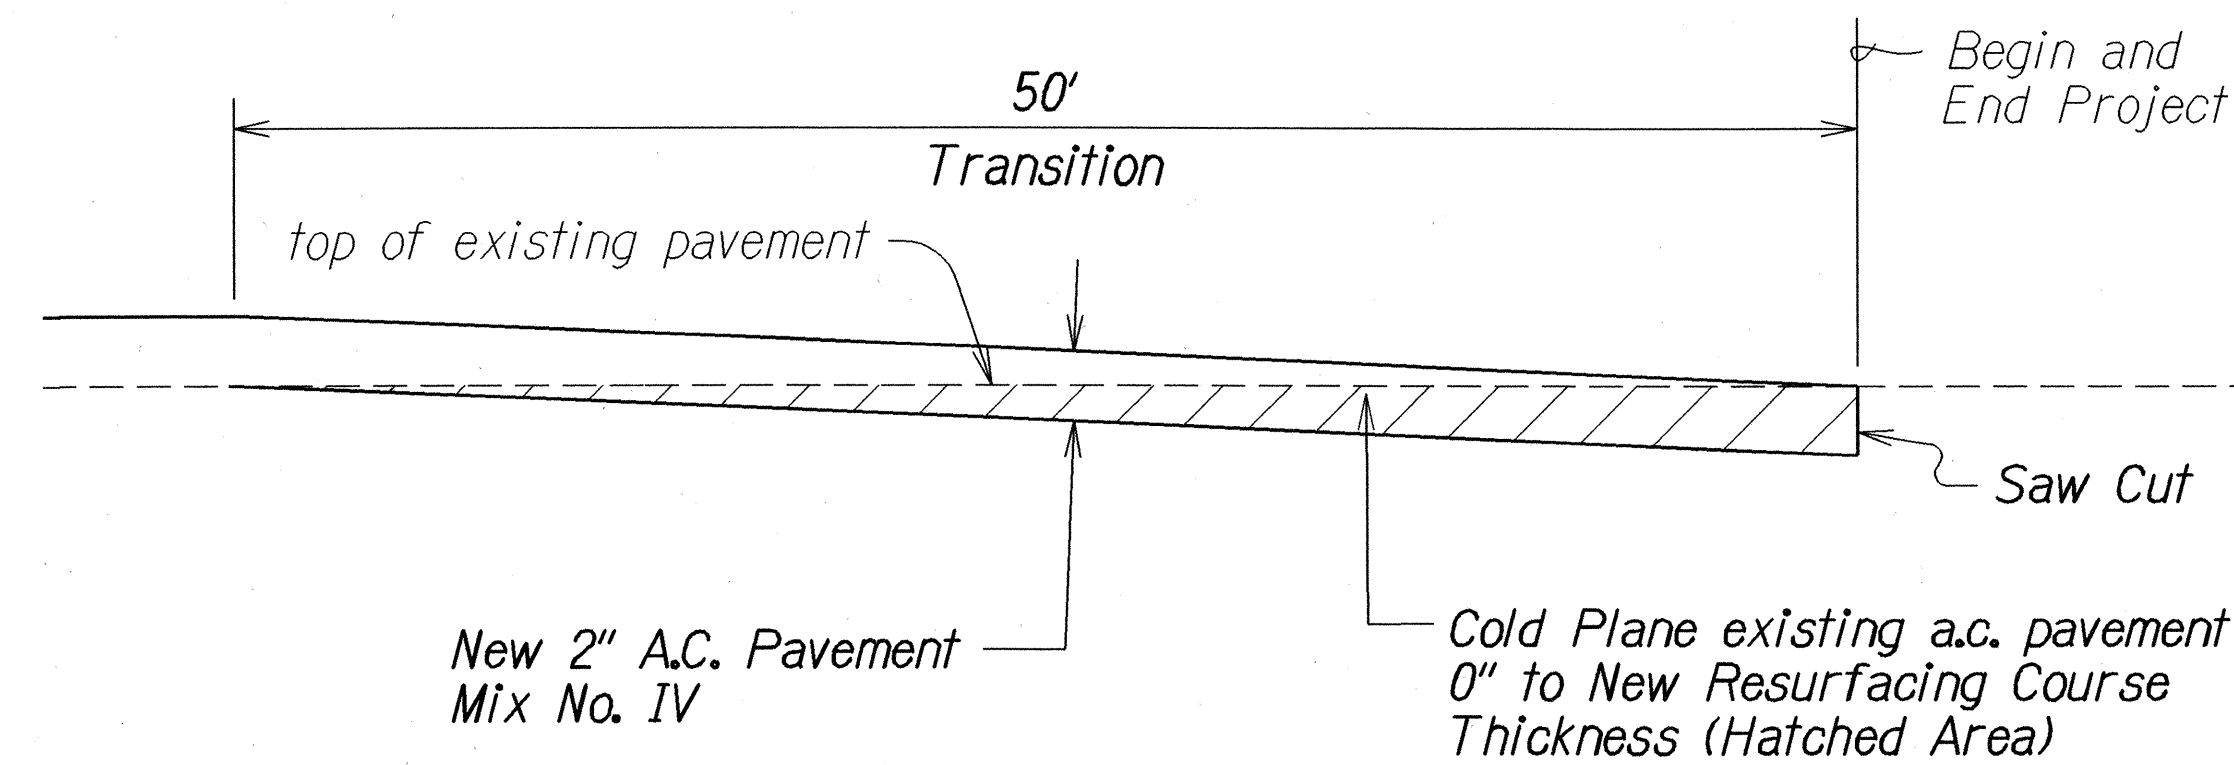


**COLD PLANED TRANSITION
TO EXISTING A.C. PAVEMENT**
Not To Scale

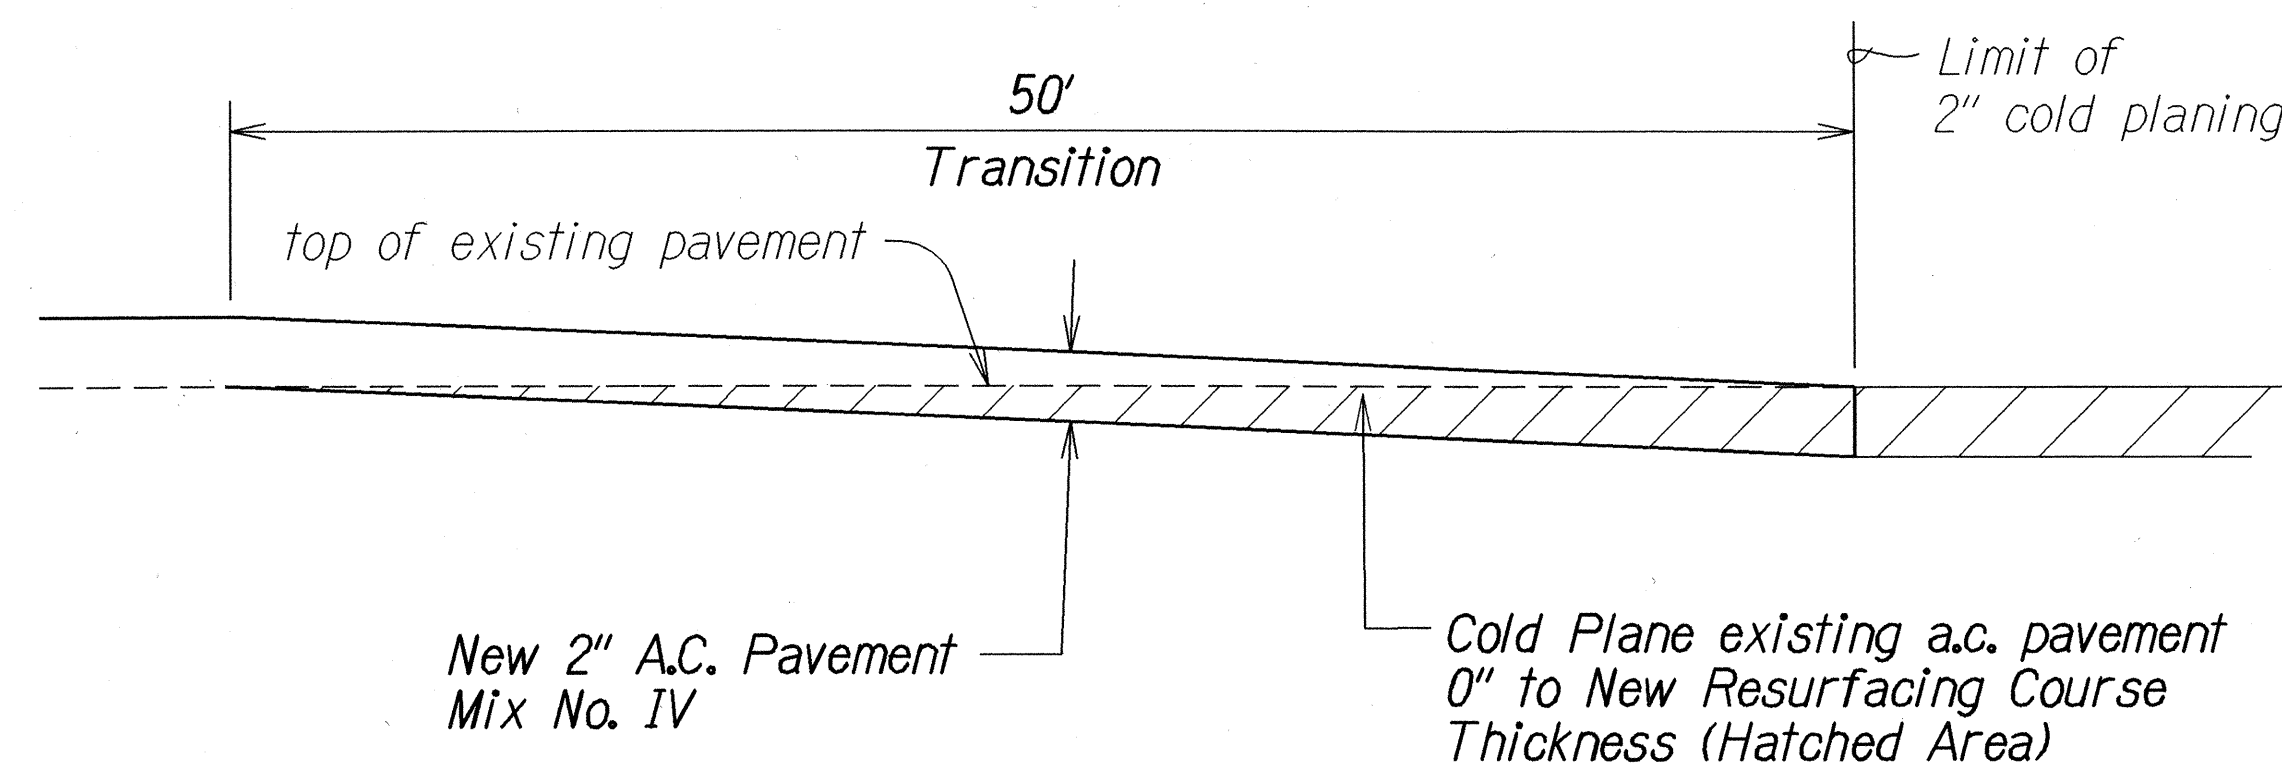


**COLD PLANED TRANSITION
FROM 2" COLD PLANED AREAS**
Not To Scale

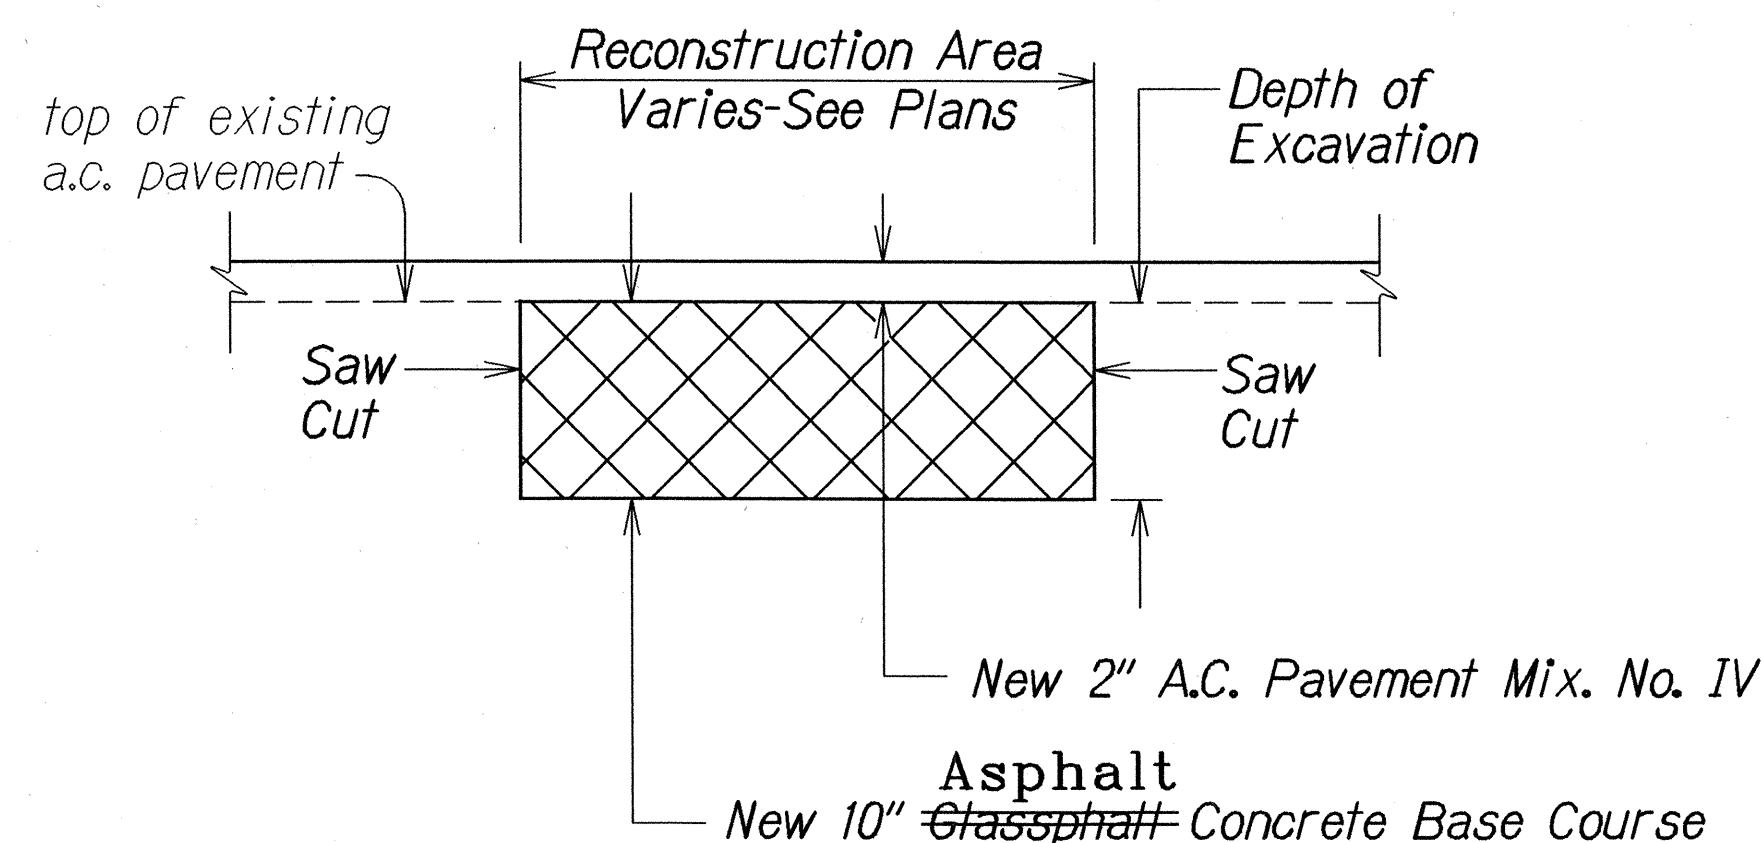

A.C. PAVEMENT RECONSTRUCTION DETAIL
Not To Scale

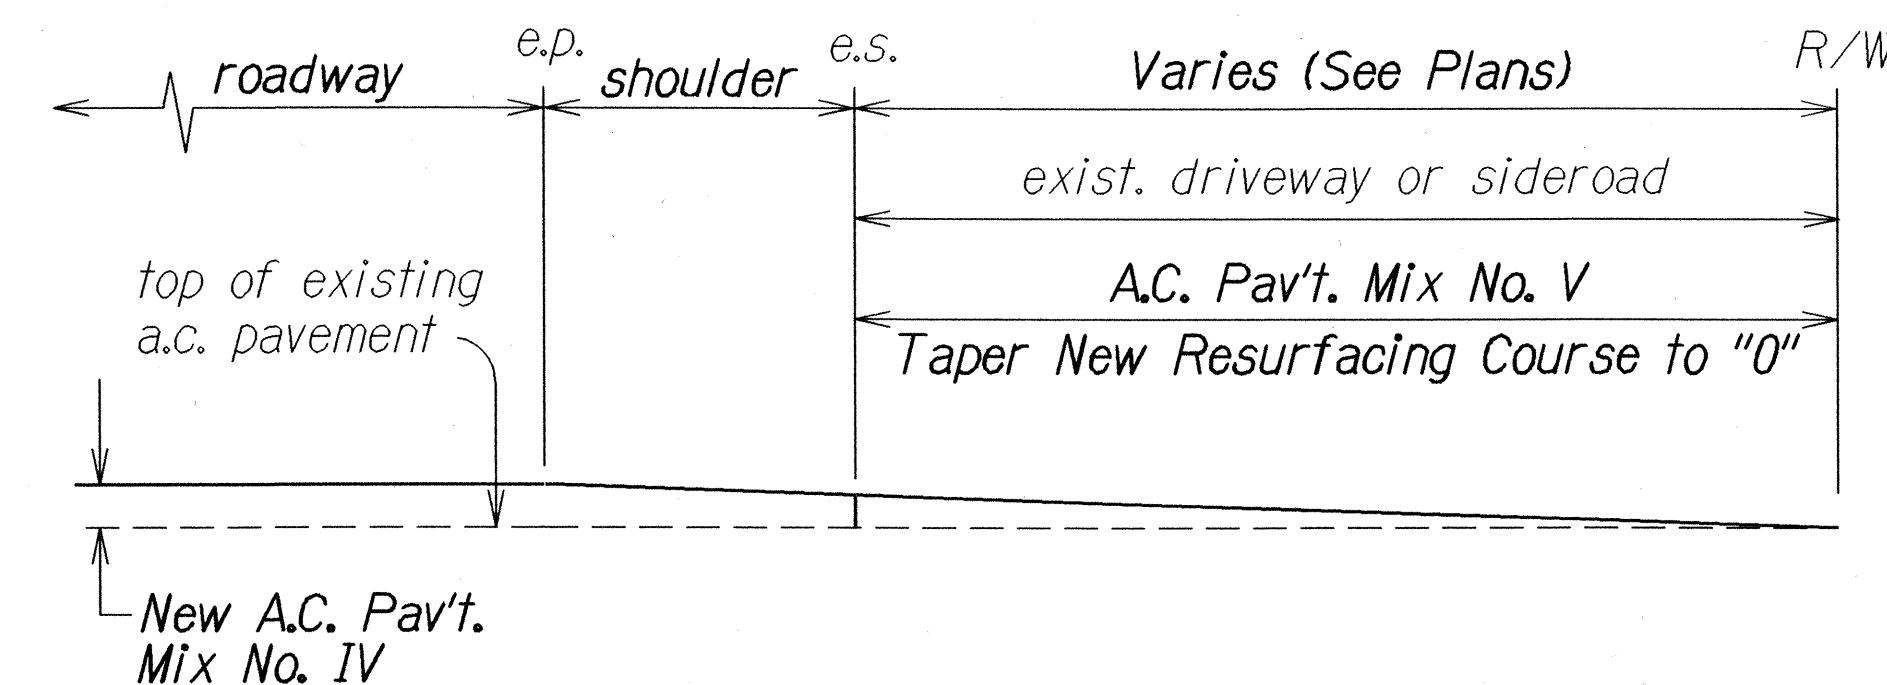

**TYPICAL DETAIL AT DRIVEWAY
OR SIDEROAD CONNECTIONS**
Not to Scale

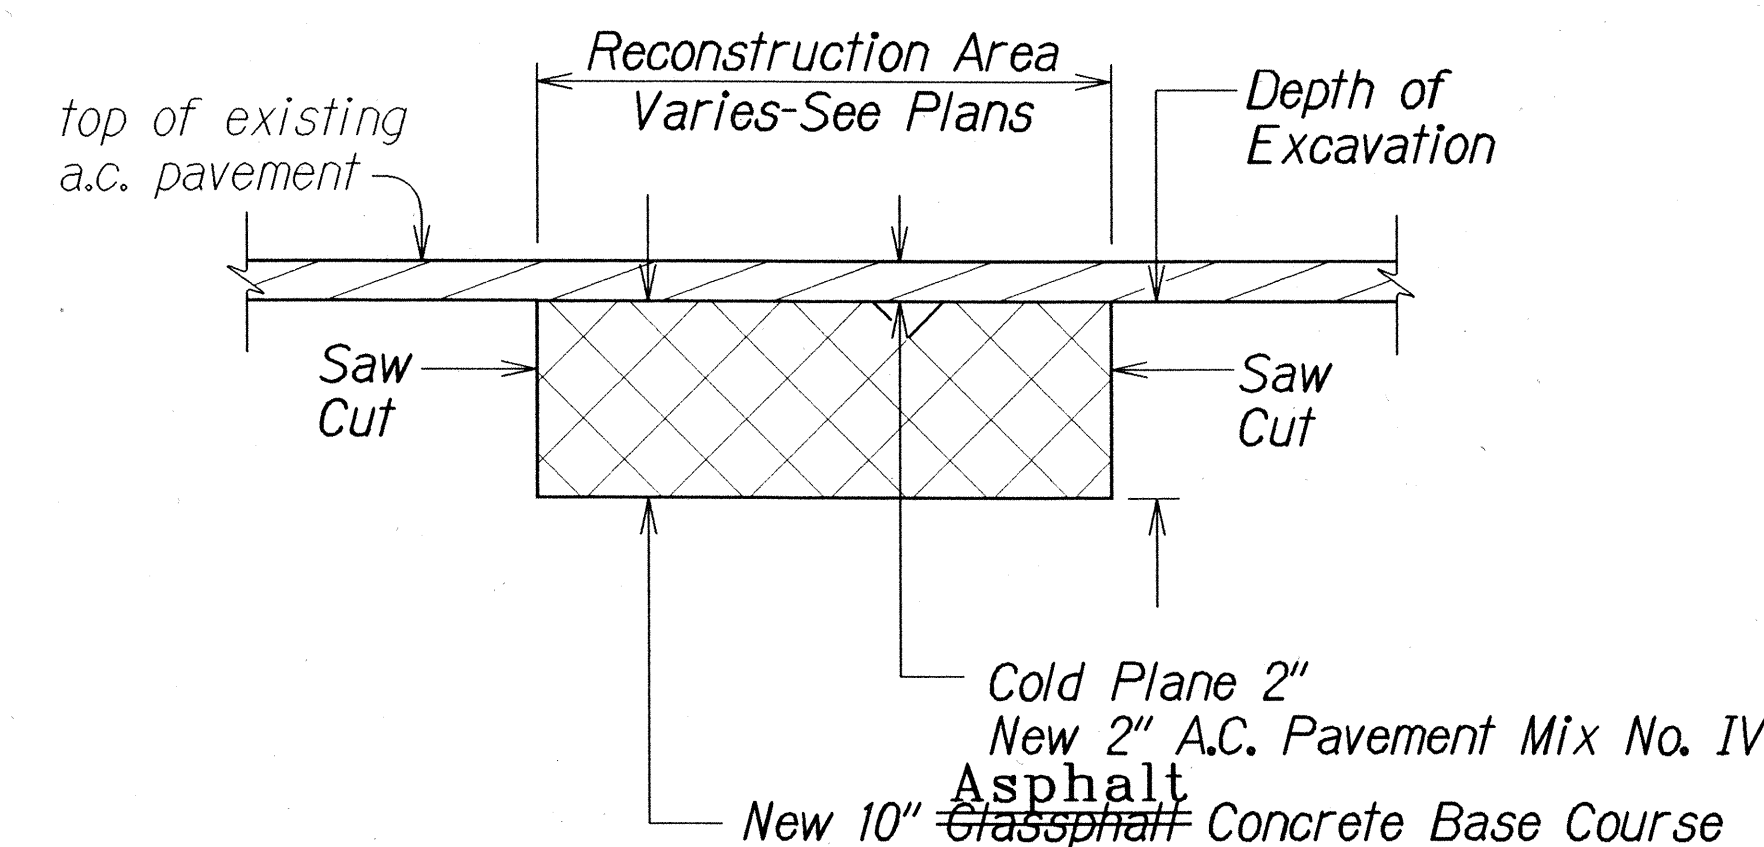

**A.C. PAVEMENT RECONSTRUCTION DETAIL
AT 2" COLD PLANED AREA**
Not To Scale

LEGEND FOR AS-BUILT POSTINGS	
~~~~~	Squiggly line for as-built deletion
====	Double line for as-built deletion
Roadway	Text for as-built posting

STATE OF HAWAII DEPARTMENT OF TRANSPORTATION HIGHWAYS DIVISION
<b>TYPICAL SECTIONS &amp; DETAILS</b>
<b>KALANIANA'OLE HWY. RESURFACING</b>
<b>Keahole St. to Hanauma Bay</b>
<b>Proj. No. 72BC-01-97M</b>
Scale: As Shown Date: May, 1997
SHEET No. 3 OF 3 SHEETS

"AS-BUILT"

DESIGNED BY	DATE
DRAWN BY	5-20-97
CHECKED BY	5-20-97
NOTED BY	5-20-97
QUANTITIES BY	5-20-97
CHECKED BY	5-20-97