
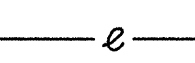



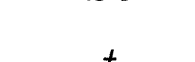


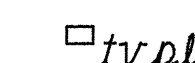
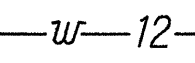
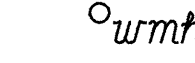

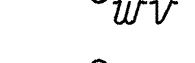
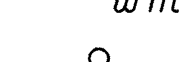
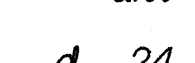


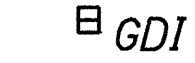
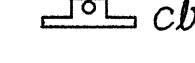
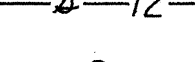
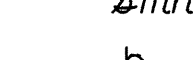

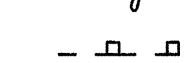






GENERAL NOTES

1. The scope of work for this project consists of widening paved shoulders; upgrading bridge end posts and railings; cold planing; adjusting utilities; and installing pavement striping, marking and signing.
2. The Contractor is reminded of the requirements of Subsection 108.01 - Subletting of Contract, which requires him to perform work amounting to not less than 50 percent of the total contract cost less deductible items. Non-compliance with this Subsection may be grounds for rejection of bid.
3. The Contractor's attention is directed to the following Sections of the Special Provisions : Subsection 107.13 - Public Convenience and Safety; Subsection 107.21 - Contractor's Responsibility For Utility Property And Services; and Section 645 -Traffic Control.
4. At the end of each day's work, the Contractor shall remove all equipment and other obstructions to permit free and safe passage of public traffic.
5. The existence and location of underground utilities, manholes, monuments and structures as shown on the plans are from the latest available data but the accuracy is not guaranteed. The encountering of other obstacles during the course of work is possible. The Contractor shall be held liable for any damages incurred to the existing facilities and/or improvements as a result of his operations.
6. The Contractor shall notify in writing, the Oahu Transit Services, Inc. Roads Supervision Office, 811 Middle St., Hon., HI 96819 (ph. #848-4571) seven (7) days prior to any paving operations.
7. The Contractor shall notify the Engineer in writing, two (2) weeks prior to starting paving operations.
8. Smooth riding connections shall be constructed at all limits of shoulder improvements, including the beginning and end of project, connecting approaches, side streets and driveways as shown on the plans and/or as directed by the Engineer.
9. Shoulder dressing shall be constructed in accordance with Special Provision Section 210 - Dressing of Shoulder.
10. Existing drainage system will be functional at all times during construction. The Contractor is to furnish materials, equipment, labor, tools and incidentals necessary to maintain flow and protect the drainage system from silt runoff. This work shall be considered incidental to various contract items.
11. The contractor shall provide for access to and from all existing side streets at all times.
12. All saw cutting work shall be considered incidental to the various contract items.

LEGEND

-  New Pavement Areas
-  Existing Electrical Line
-  Existing Power Pole
-  Existing Hawaiian Electric Co. Manhole
-  Existing Hawaiian Electric Co. Pull Box
-  Existing Signal Corps Line
-  Existing Telephone Line
-  Existing Hawaiian Telephone Co. Manhole
-  Adjusted Hawaiian Telephone Co. Manhole
-  Existing TV Cable Box
-  Existing 12" Water Line
-  Existing Water Manhole
-  Adjusted Water Manhole
-  Existing Water Valve Box
-  Existing Water Meter Box
-  Existing Water Air Valve
-  Existing 24" Drain Line
-  Existing Storm Drain Manhole
-  Existing Grated Drop Inlet
-  Adjusted Grated Drop Inlet
-  Existing Catch Basin
-  Existing Sewer Line
-  Existing Sewer Manhole
-  Existing Traffic Sign With 1 Post
-  Existing Highway Lighting Standard
-  Existing Single Metal Guardrail
-  Existing Monument

FED. ROAD DIST. NO.	STATE	FED. AID PROJ. NO.	FISCAL YEAR	SHEET NO.	TOTAL SHEETS
HAWAII	HAW.	STP-072-1(45)	1999	3R	33

ORIGINAL PLAN	SURVEY PLOTTED BY	DATE
NOTE BOOK	DESIGNED BY	
QUANTITIES BY	CHECKED BY	

3-23-99	Revised Gen. Note No. 9 per Addendum No. 1.
DATE	REVISION
STATE OF HAWAII DEPARTMENT OF TRANSPORTATION HIGHWAYS DIVISION GENERAL NOTES AND LEGEND KALANIANA'OLE HIGHWAY SHOULDER IMPROVEMENTS Makapuu Lookout to Kealahou Street Fed. Aid Project No. STP-072-1(45) Date: August, 1997	
SHEET No. 1 OF 1 SHEETS	