

INDEX TO DRAWINGS	
SHEET NO.	DESCRIPTION
1	TITLE SHEET
2	STANDARD PLANS SUMMARY
3	GENERAL NOTES AND LEGEND
4	BWS AND HECO NOTES
5 - 6	TYPICAL SECTIONS
7	TYPICAL DETAILS
8 - 11	ROADWAY PLANS
12	DRAINAGE PLANS
13 - 17	TRAFFIC PLANS
18	SRT 350 DETAILS
① 19 - 20	ET 2000 DETAILS
21 - 29	BRIDGE DETAILS
② 30 - 33	EXISTING STRUCTURE

SHEET NOS. ① ADD. 205-1 THROUGH ADD. 206-3, AND SHEET NOS. ② C.O. 335-1 ARE SUPPLEMENTARY SHEETS TO THIS PROJECT. TOTAL SHEET COUNT AFTER "AS-BUILT" POSTING 37 SHEETS.

STATE OF HAWAII

DEPARTMENT OF TRANSPORTATION

HIGHWAYS DIVISION

HONOLULU, HAWAII

"AS-BUILT"

PLANS FOR

KALANIANAOLE HIGHWAY

SHOULDER IMPROVEMENTS



MAKAPUU LOOKOUT TO KEALAHOU STREET

FEDERAL AID PROJECT NO. STP-072-1(45)

DISTRICT OF HONOLULU

ISLAND OF OAHU

FED. ROAD DIST. NO.	STATE	FED. AID PROJ. NO.	FISCAL YEAR	SHEET NO.	TOTAL SHEETS
HAWAII	HAW.	STP-072-1(45)	1999	1	33

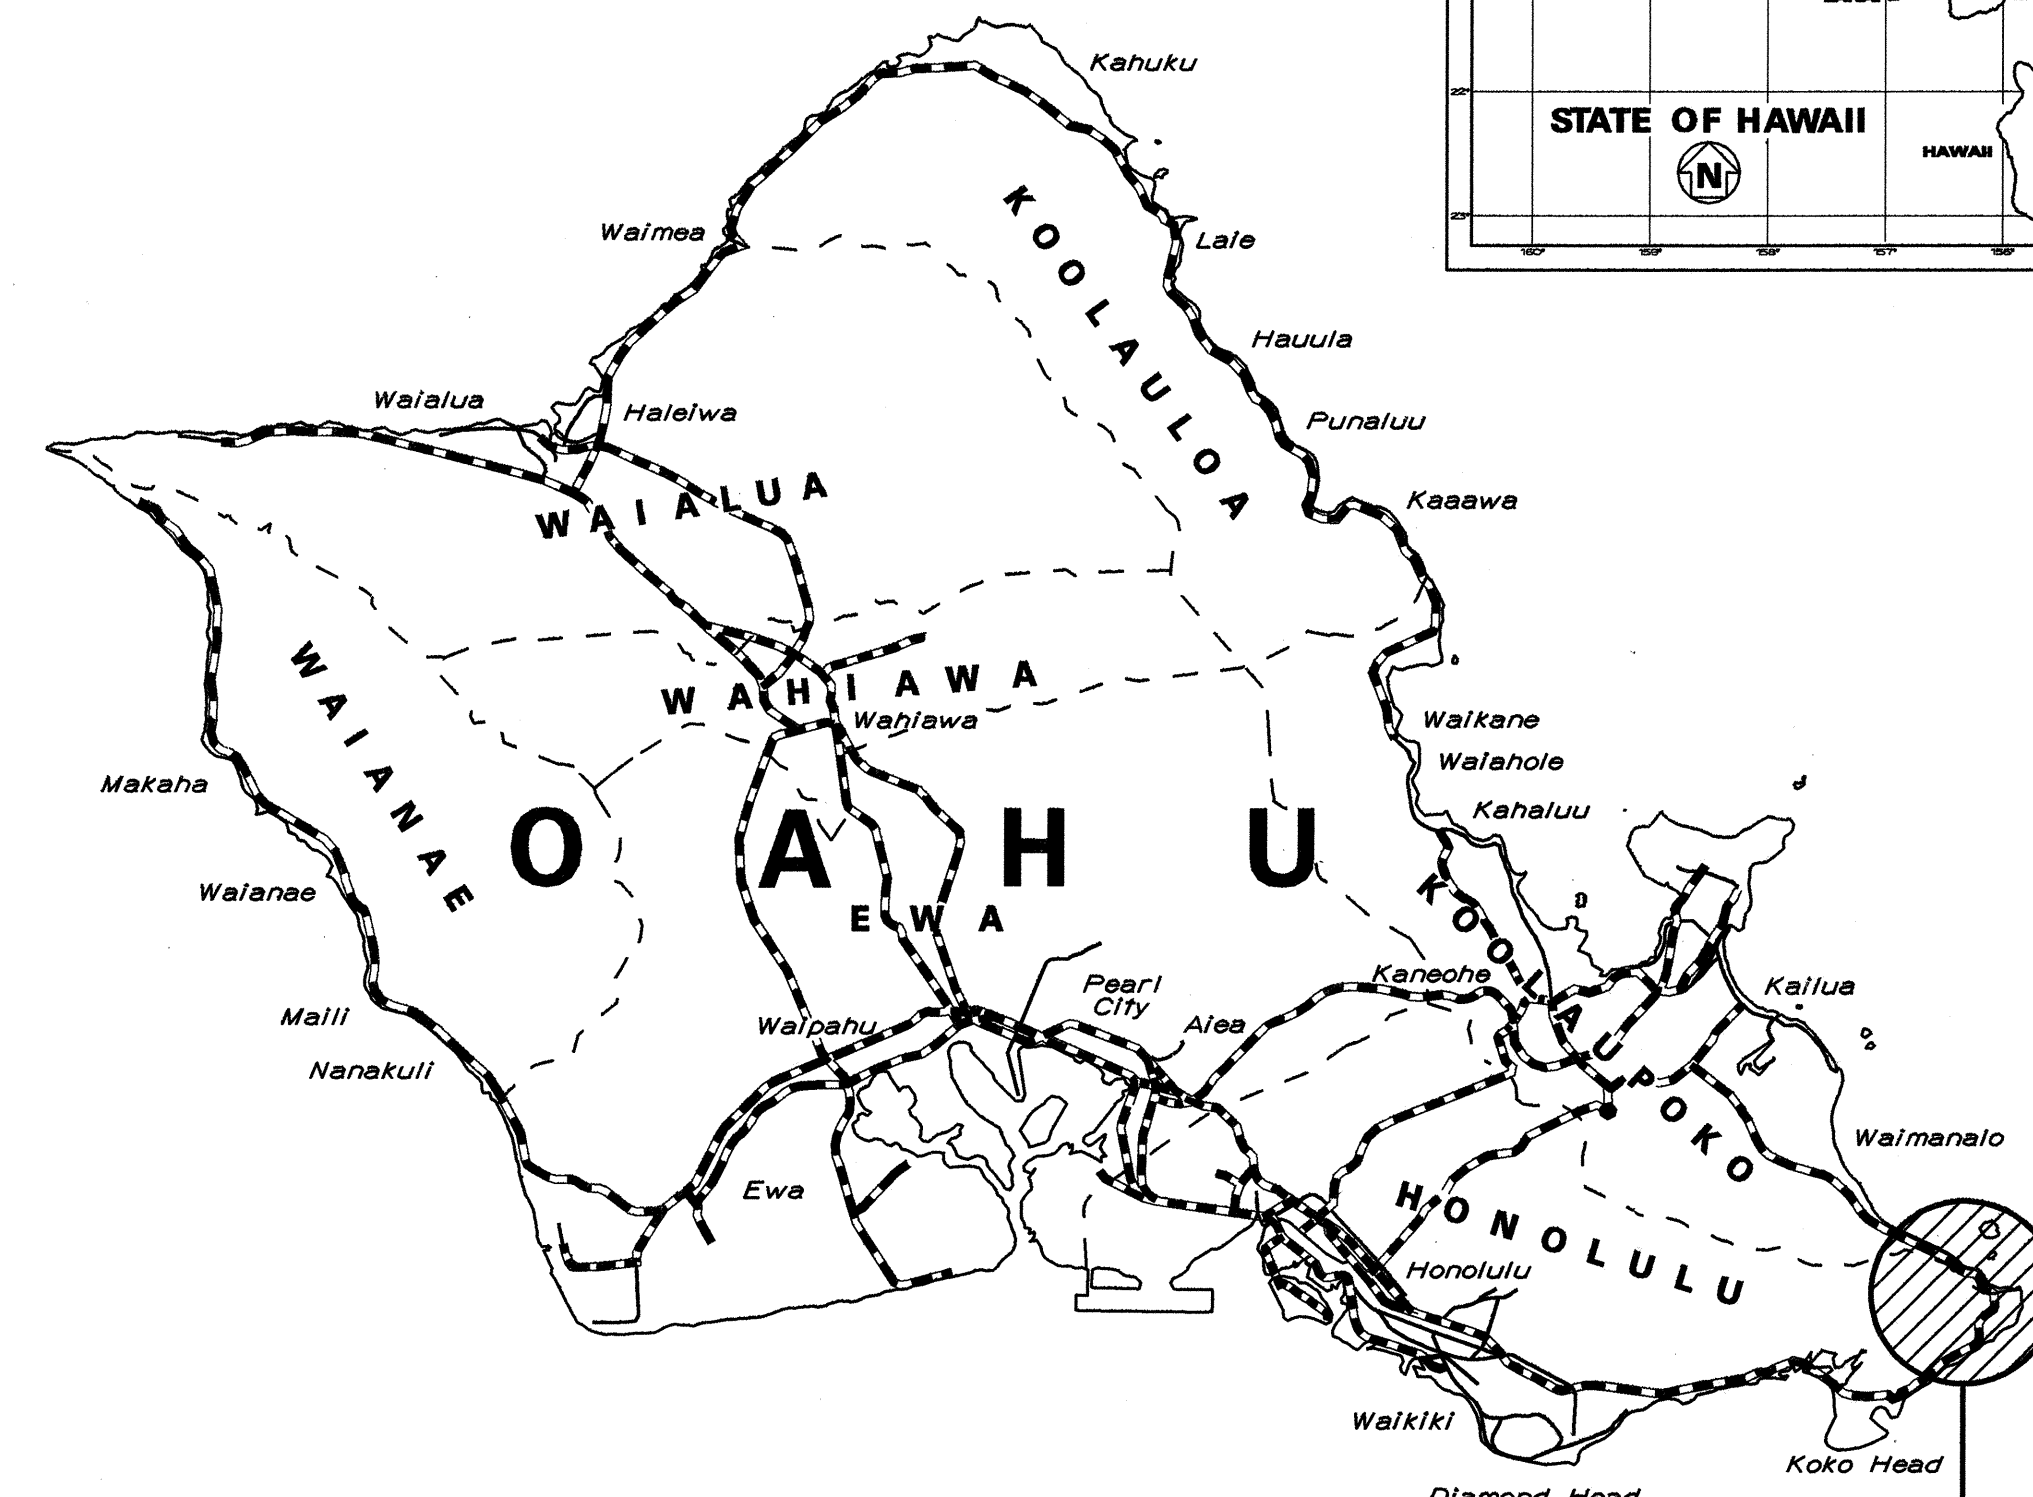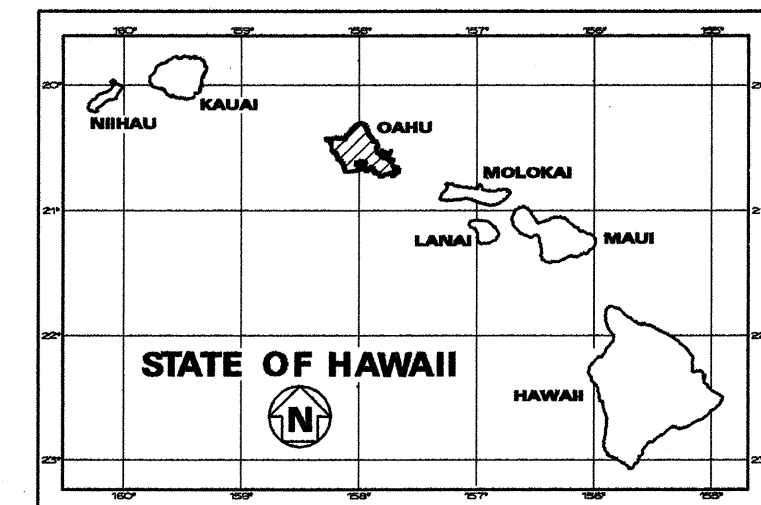

LOCATION OF PROJECT



SCALE IN MILES

----- FEDERAL AID PROJECTS PREVIOUSLY CONSTRUCTED OR UNDER CONSTRUCTION

MILE POST 8.48 TO MILE POST 10.02



DESIGN DESIGNATION

ADT (1998)	11,400
ADT (2018)	15,900
DHV	1,350
D	55/45
T	3.0 %
V	35 M.P.H.

CHANGES MADE DURING CONSTRUCTION HAVE BEEN INCORPORATED ON THESE PLANS EXCEPT CHANGES IN THE ORIGINAL THEORETICAL QUANTITIES. FOR ACTUAL QUANTITIES, REFER TO PROJECT LEDGER AND/OR COMPUTATION BOOK.

RESIDENT ENGINEER DATE


DEPARTMENT OF TRANSPORTATION STATE OF HAWAII	
APPROVED:	
DIR. OF TRANSPORTATION	DATE

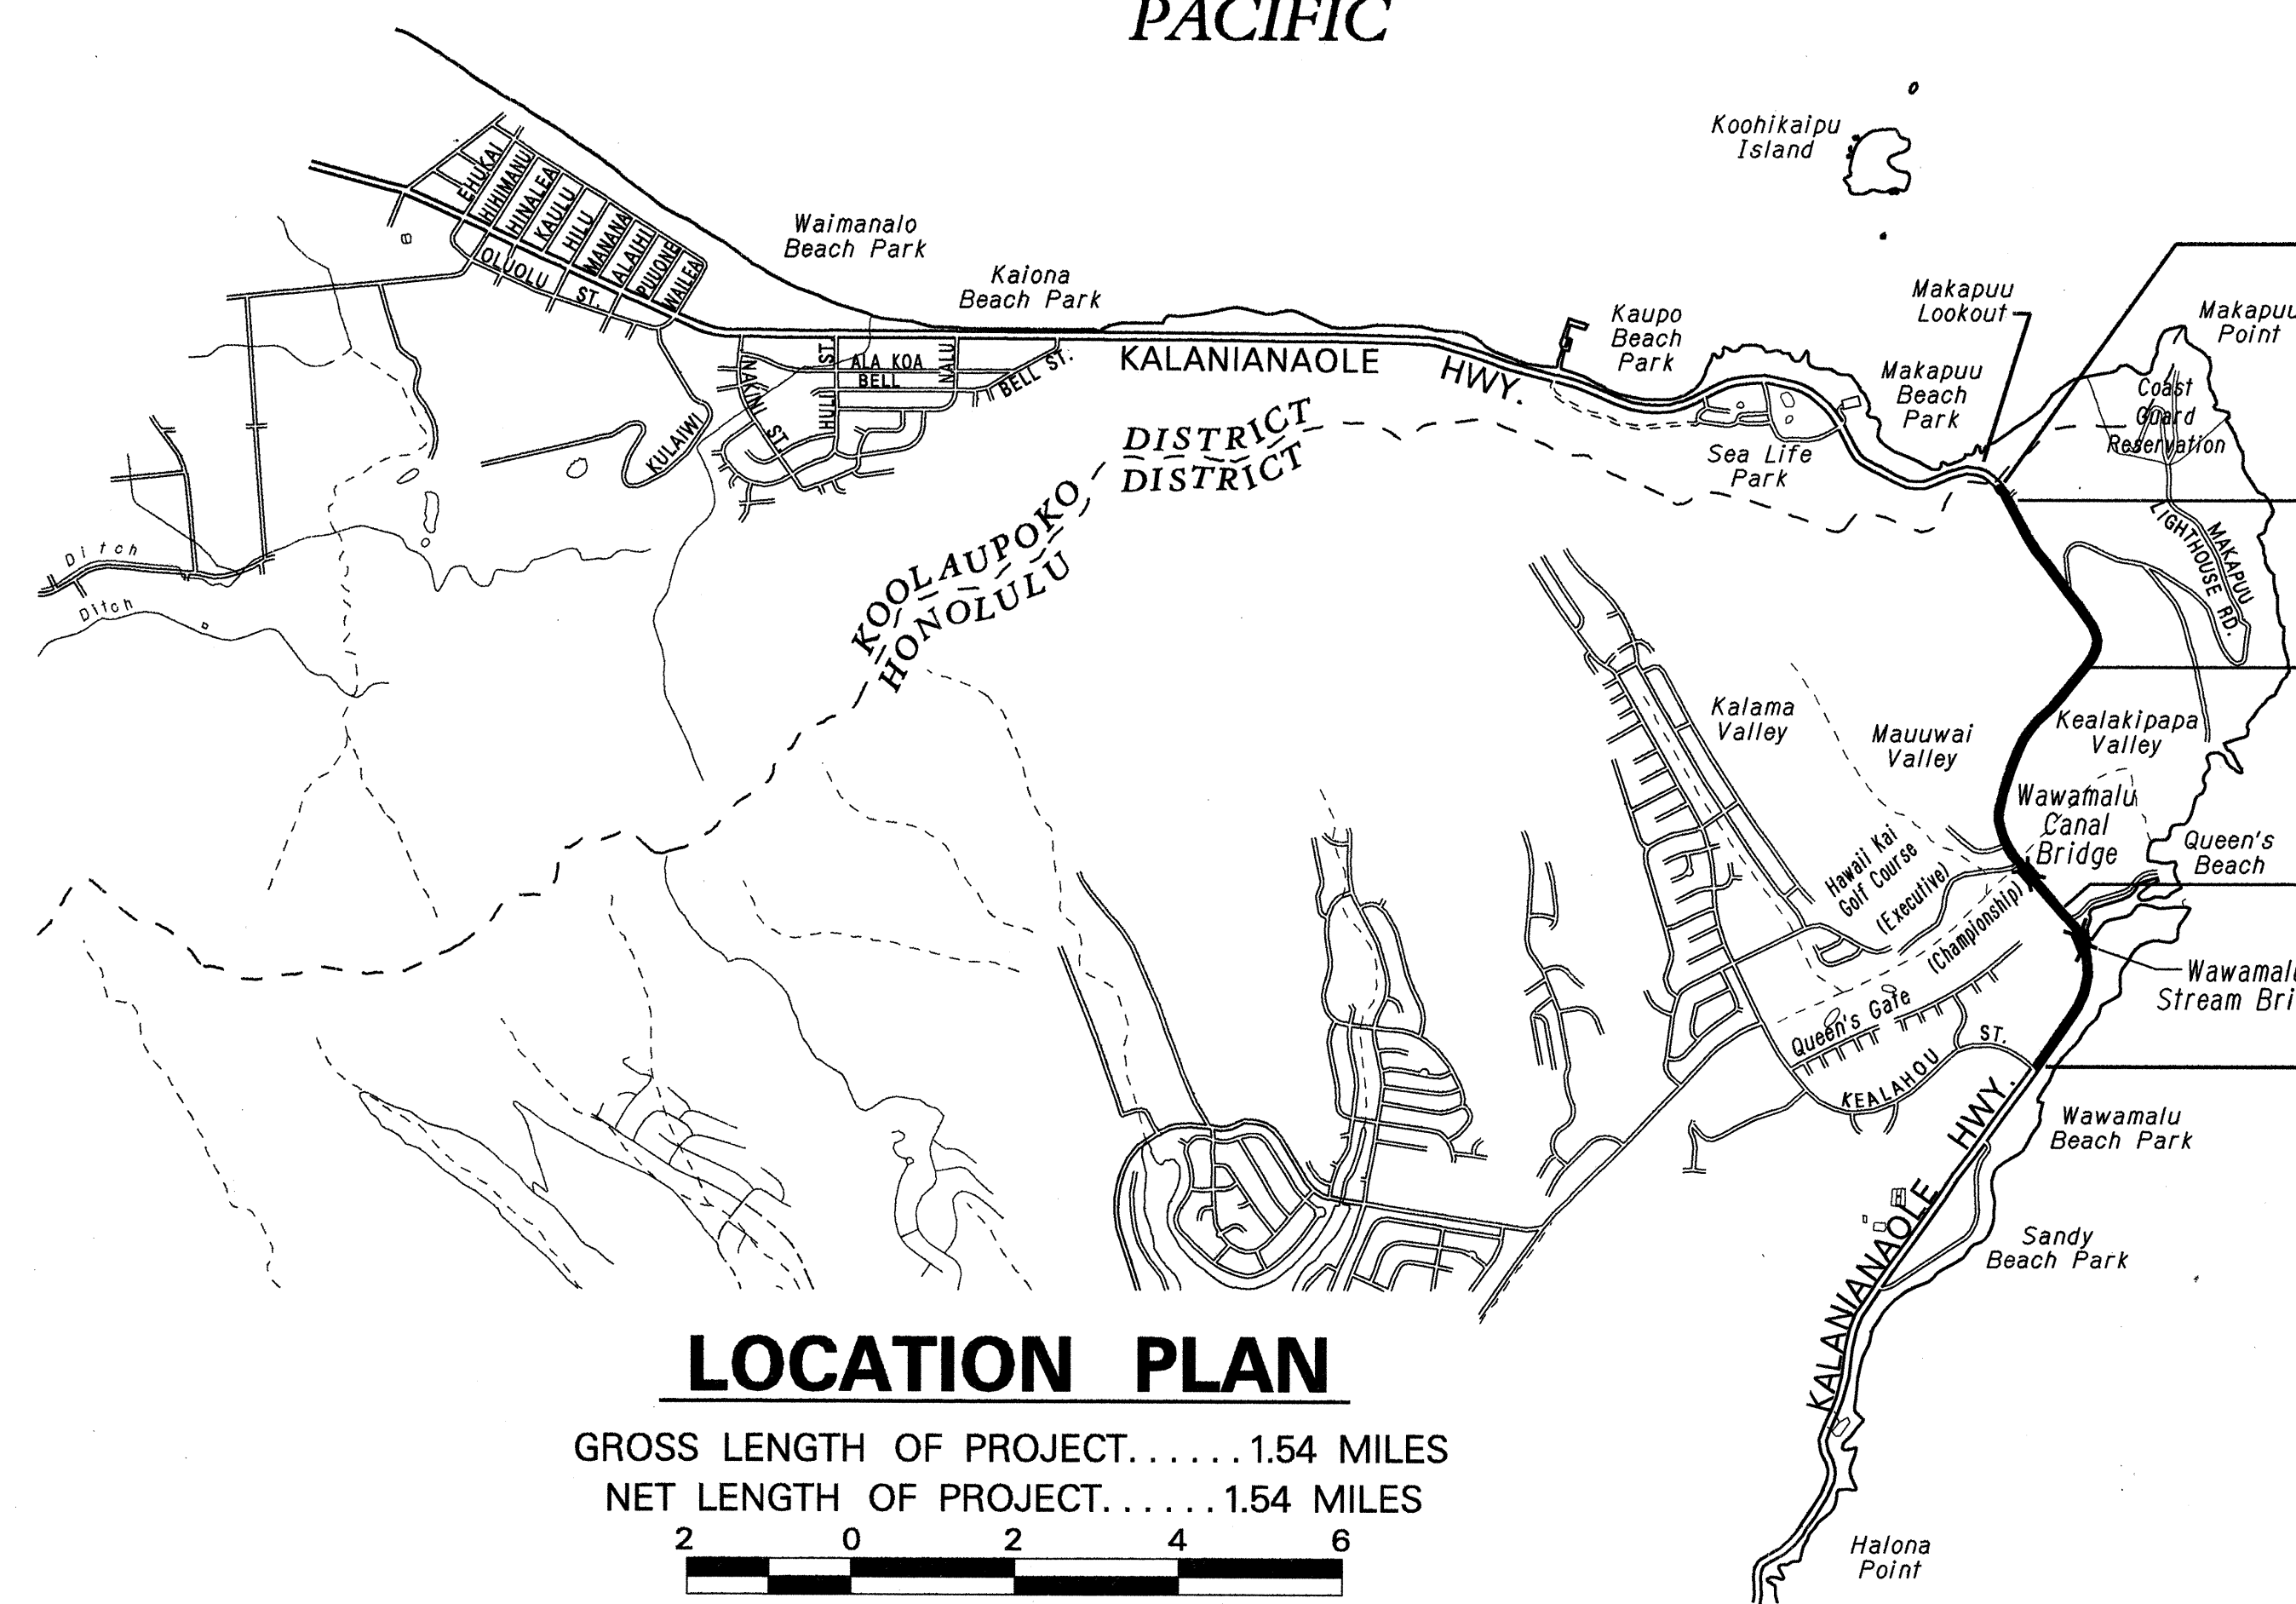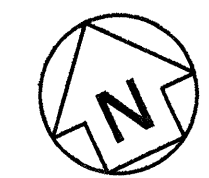

LOCATION PLAN

GROSS LENGTH OF PROJECT.....1.54 MILES

NET LENGTH OF PROJECT.....1.54 MILES

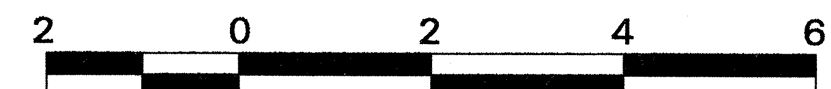

SCALE IN THOUSAND FEET

OCEAN

STA. 168+00±
BEGIN PROJECT

STA. 168+99.45 =
P.T. STA. 168+52.05

STA. 193+27.26 =
P.T. STA. 193+25.64

STA. 230+48.39 =
P.T. STA. 60+80.27

STA. 42+00±
END PROJECT

UNIT "C" DESIGNED BY R. HIRONAKA P.S. & E.B.Y. OCT. 1998 DATE 692-7575 PHONE