

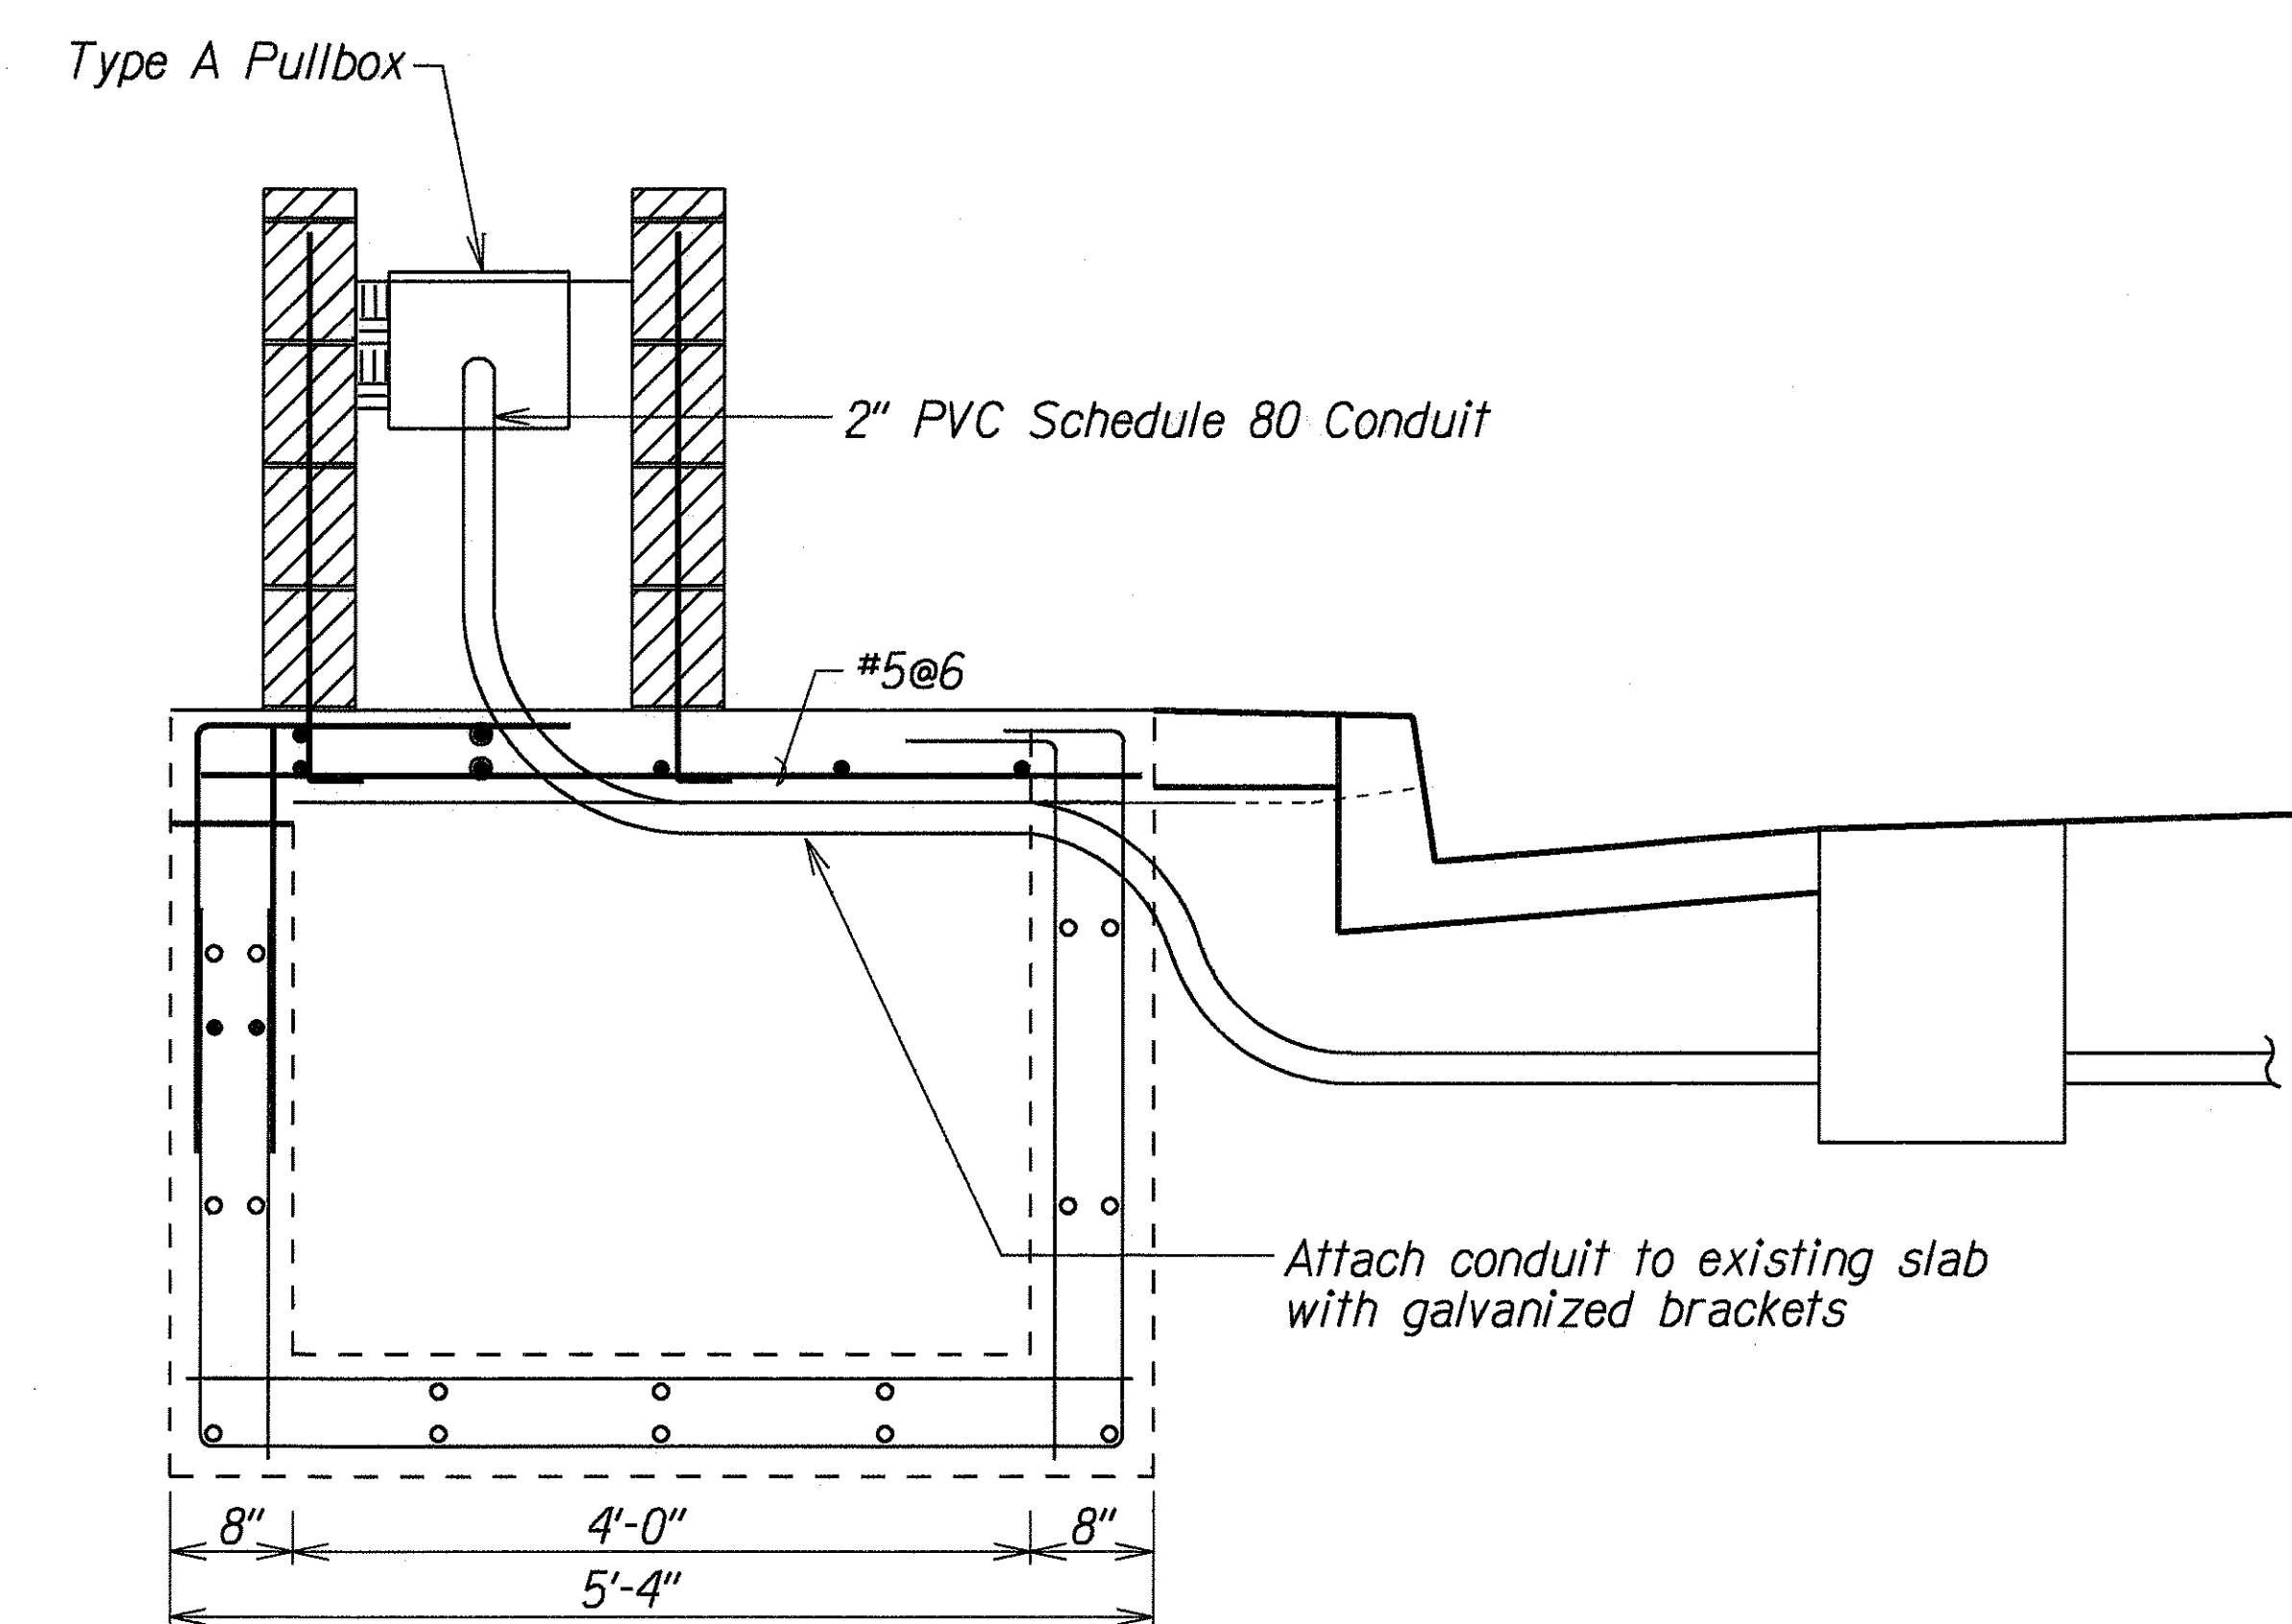


FED. ROAD DIST. NO.	STATE	PROJ. NO.	FISCAL YEAR	SHEET NO.	TOTAL SHEETS
HAWAII	HAW.	72C-01-00	2000	10	16

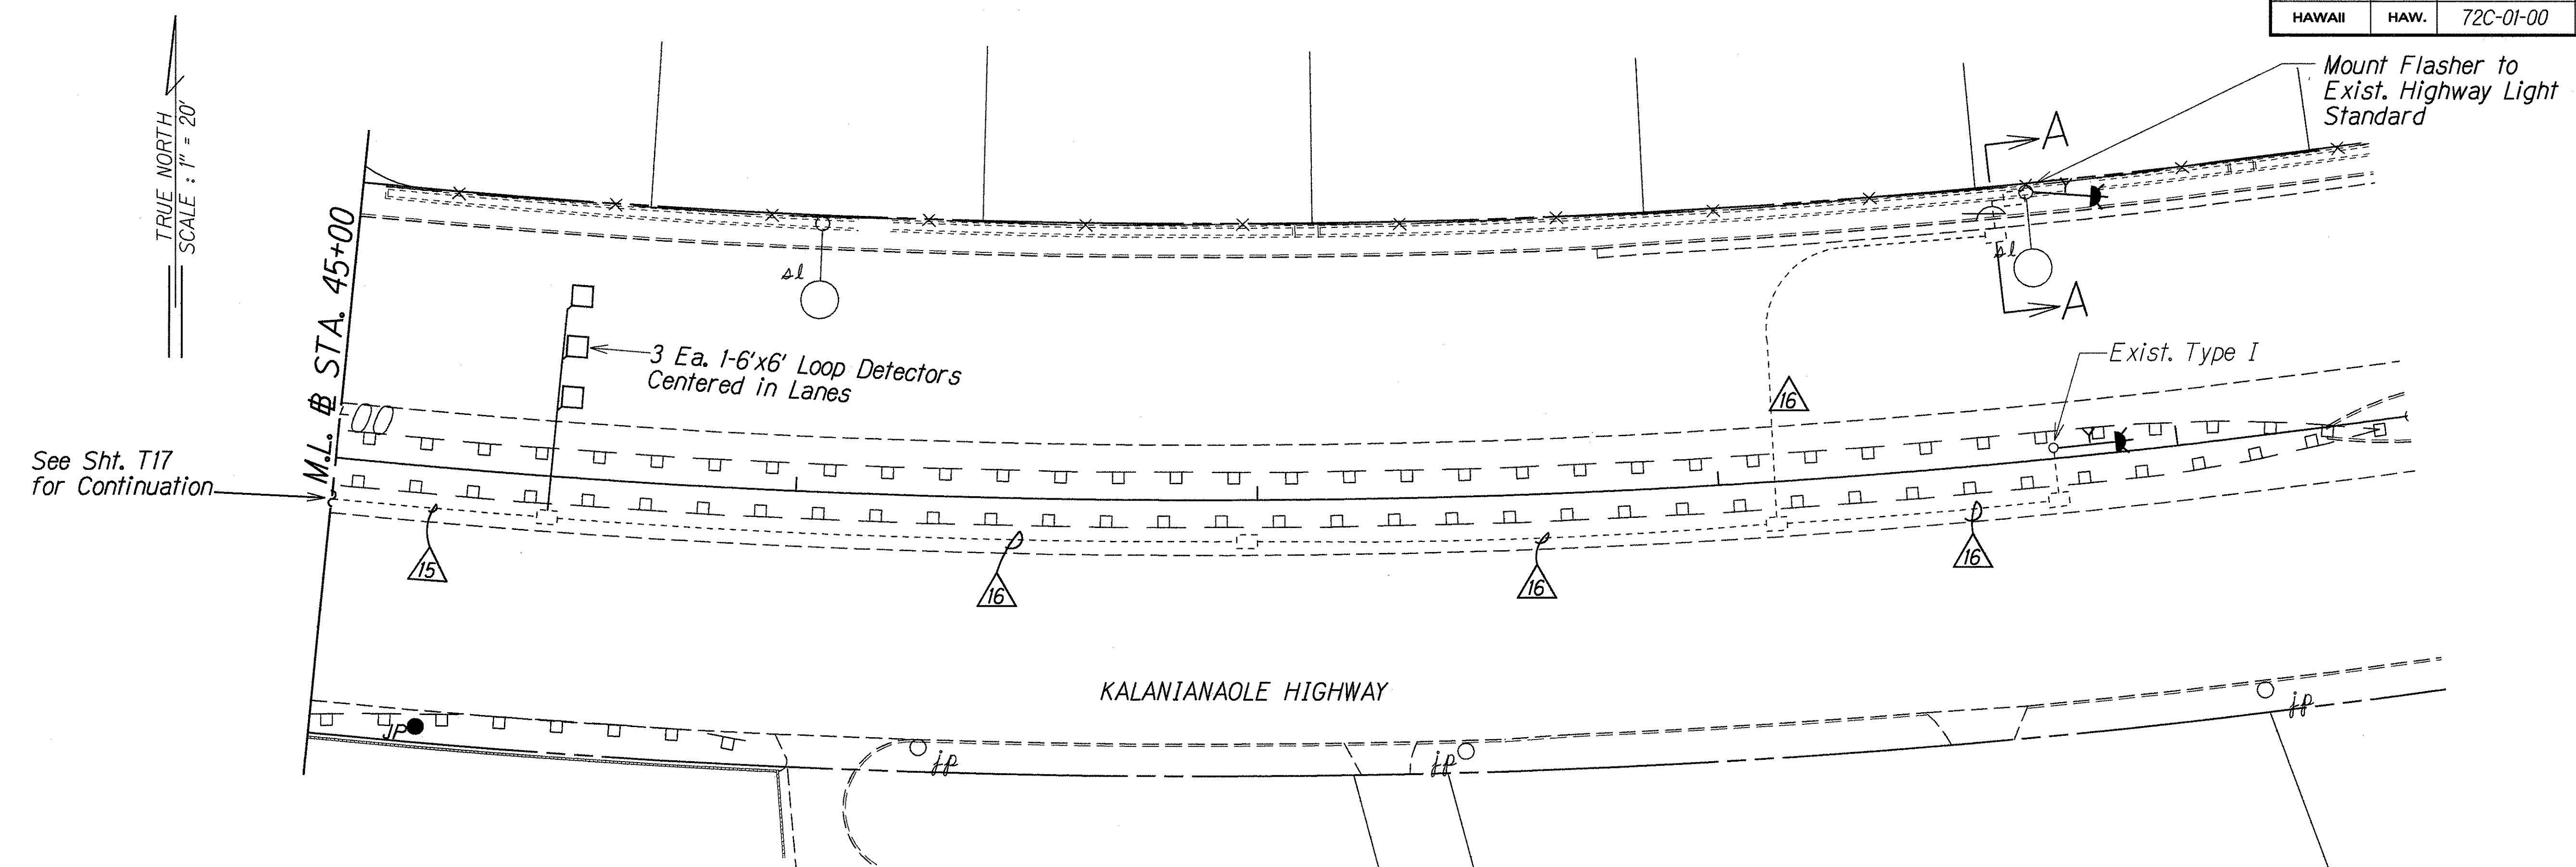

SECTION A-A
For Reference Only

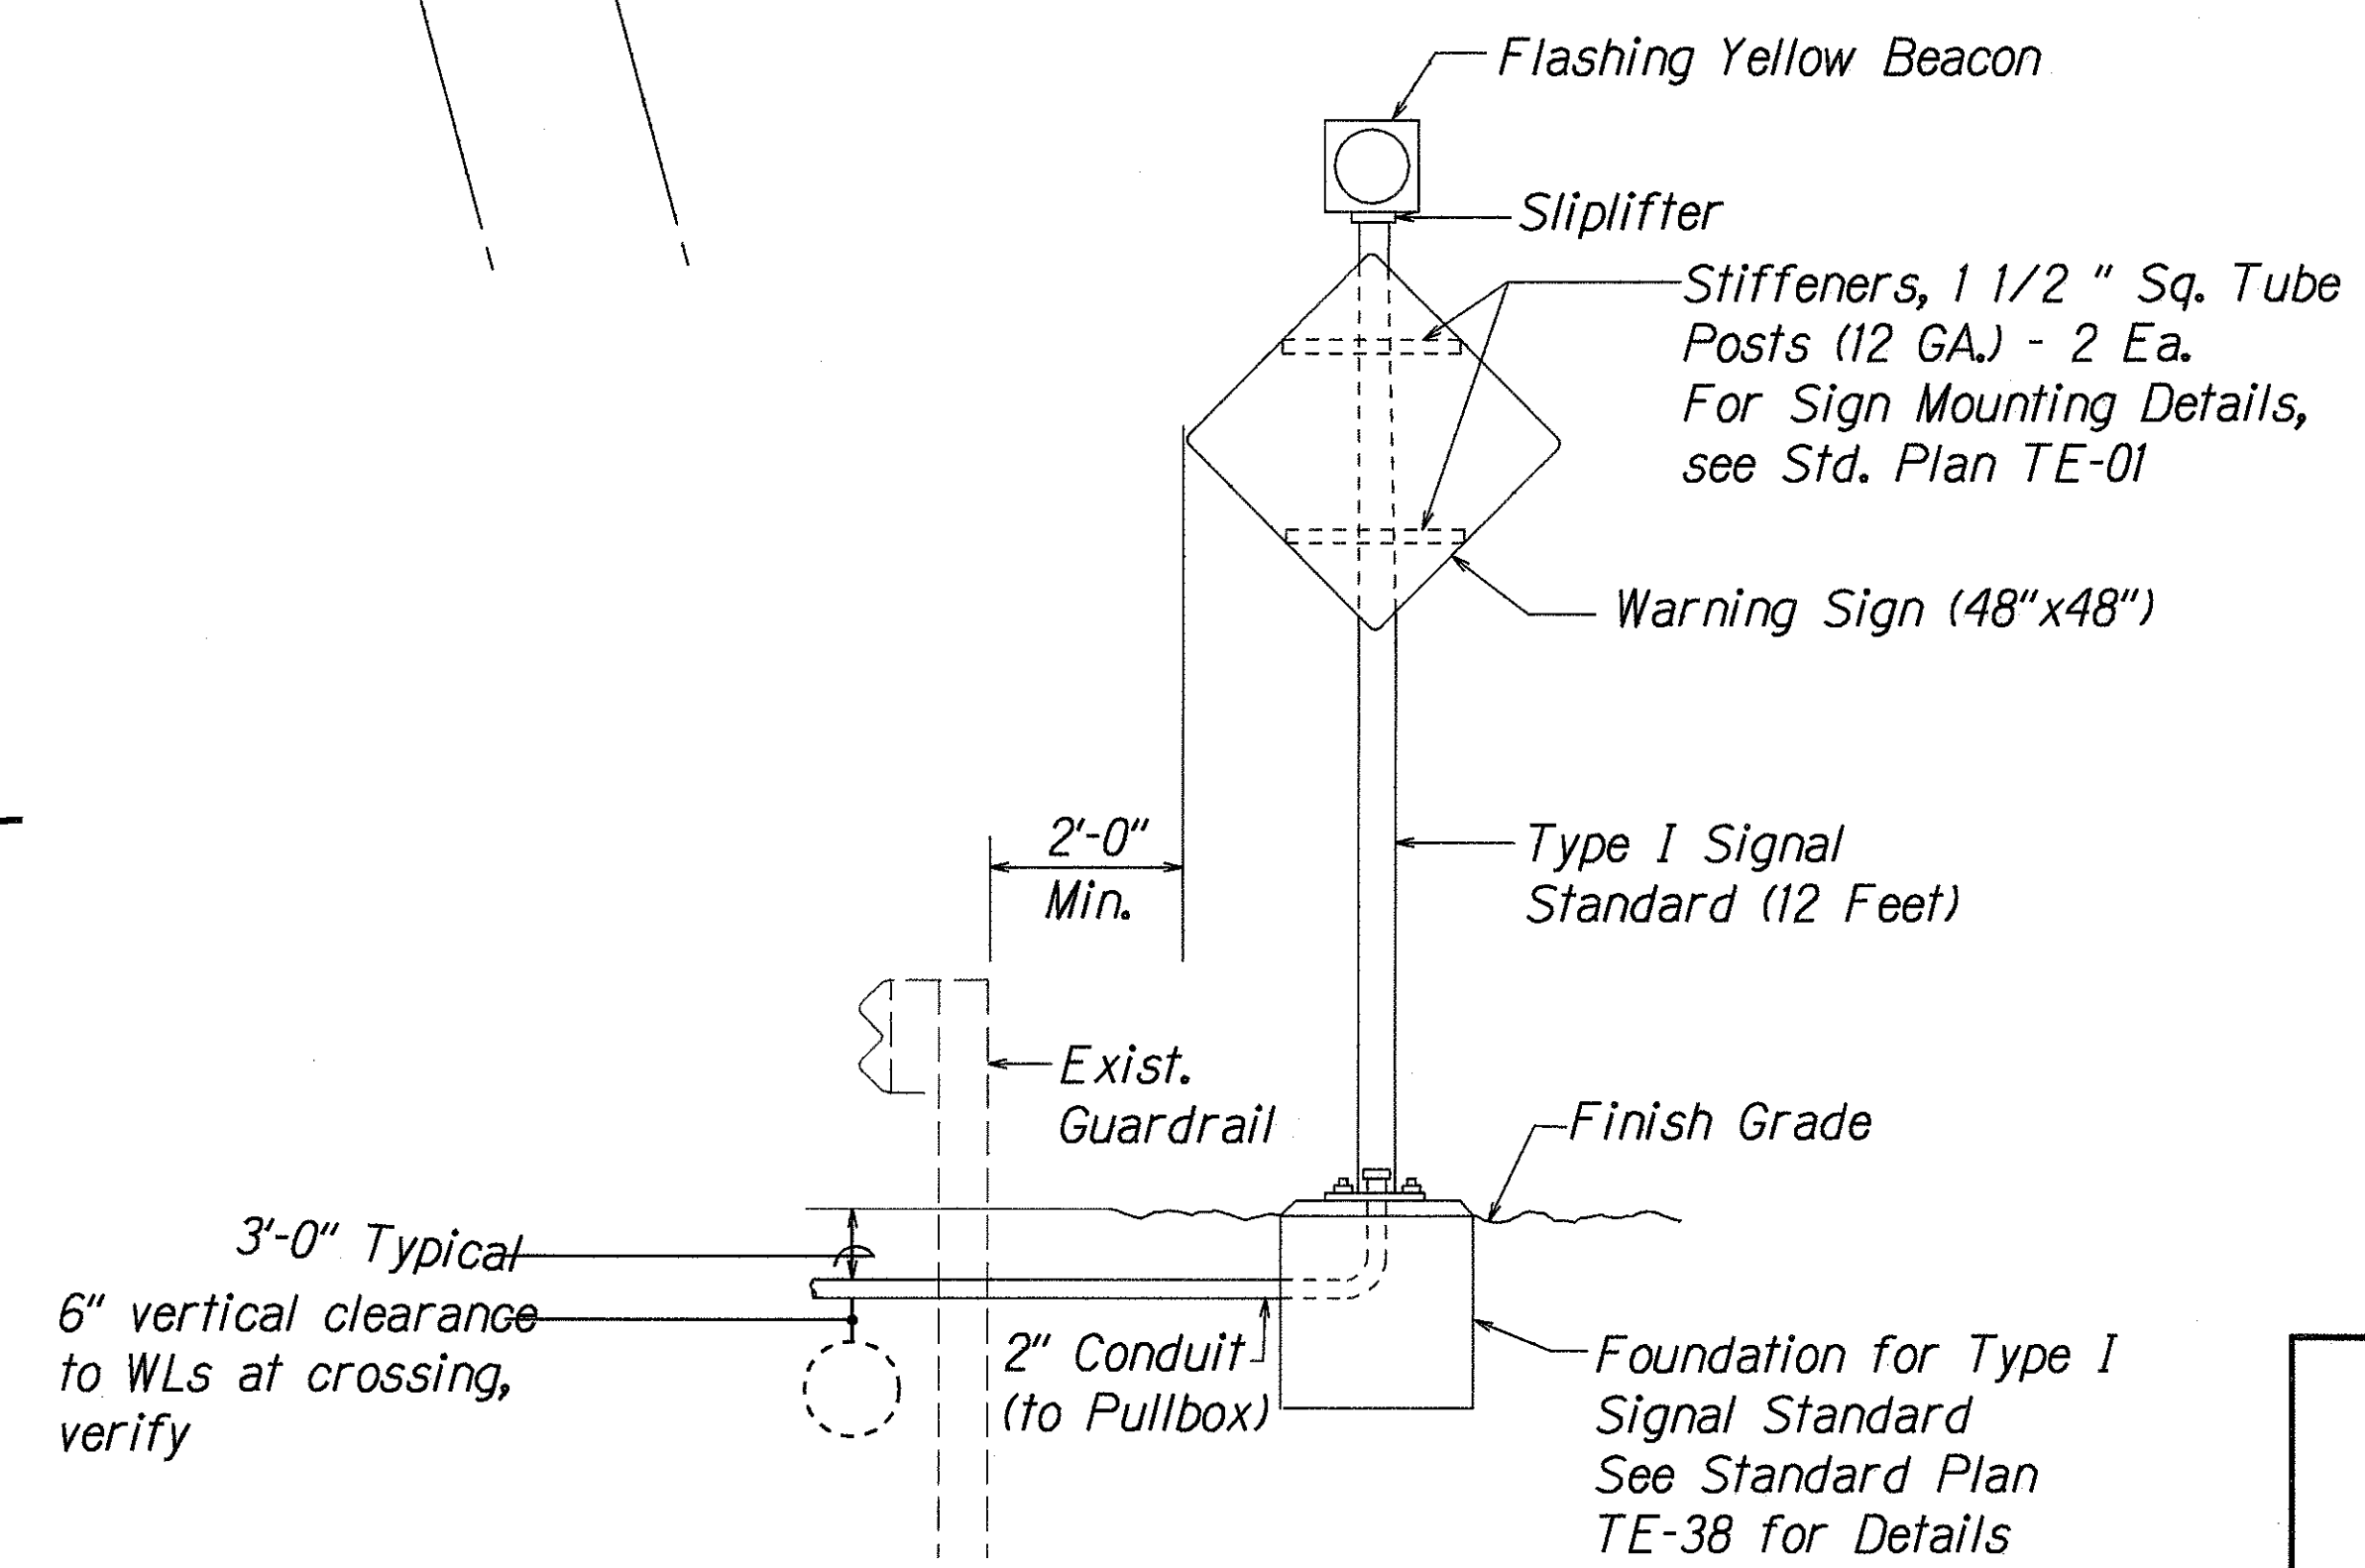

WARNING SIGN w/FLASHING
YELLOW BEACON
Not to Scale

ORIGINAL PLAN	DATE
SURVEY PLOTTED BY	
DRAWN BY	
CHECKED BY	
NOTED BY	
DATE	

STATE OF HAWAII
DEPARTMENT OF TRANSPORTATION
HIGHWAYS DIVISION


TRAFFIC SIGNAL PLAN

KALANIANA'OLE HIGHWAY
Installation of Traffic Signals
at Anali Street
Project No. 72C-01-00

Scale: 1"=20' Date: Jan., 2000

SHEET No. 2 OF 2 SHEETS

FED. ROAD DIST. NO.	STATE	PROJ. NO.	FISCAL YEAR	SHEET NO.	TOTAL SHEETS
HAWAII	HAW.	72C-01-00	2000	ADD. 10S-1	16

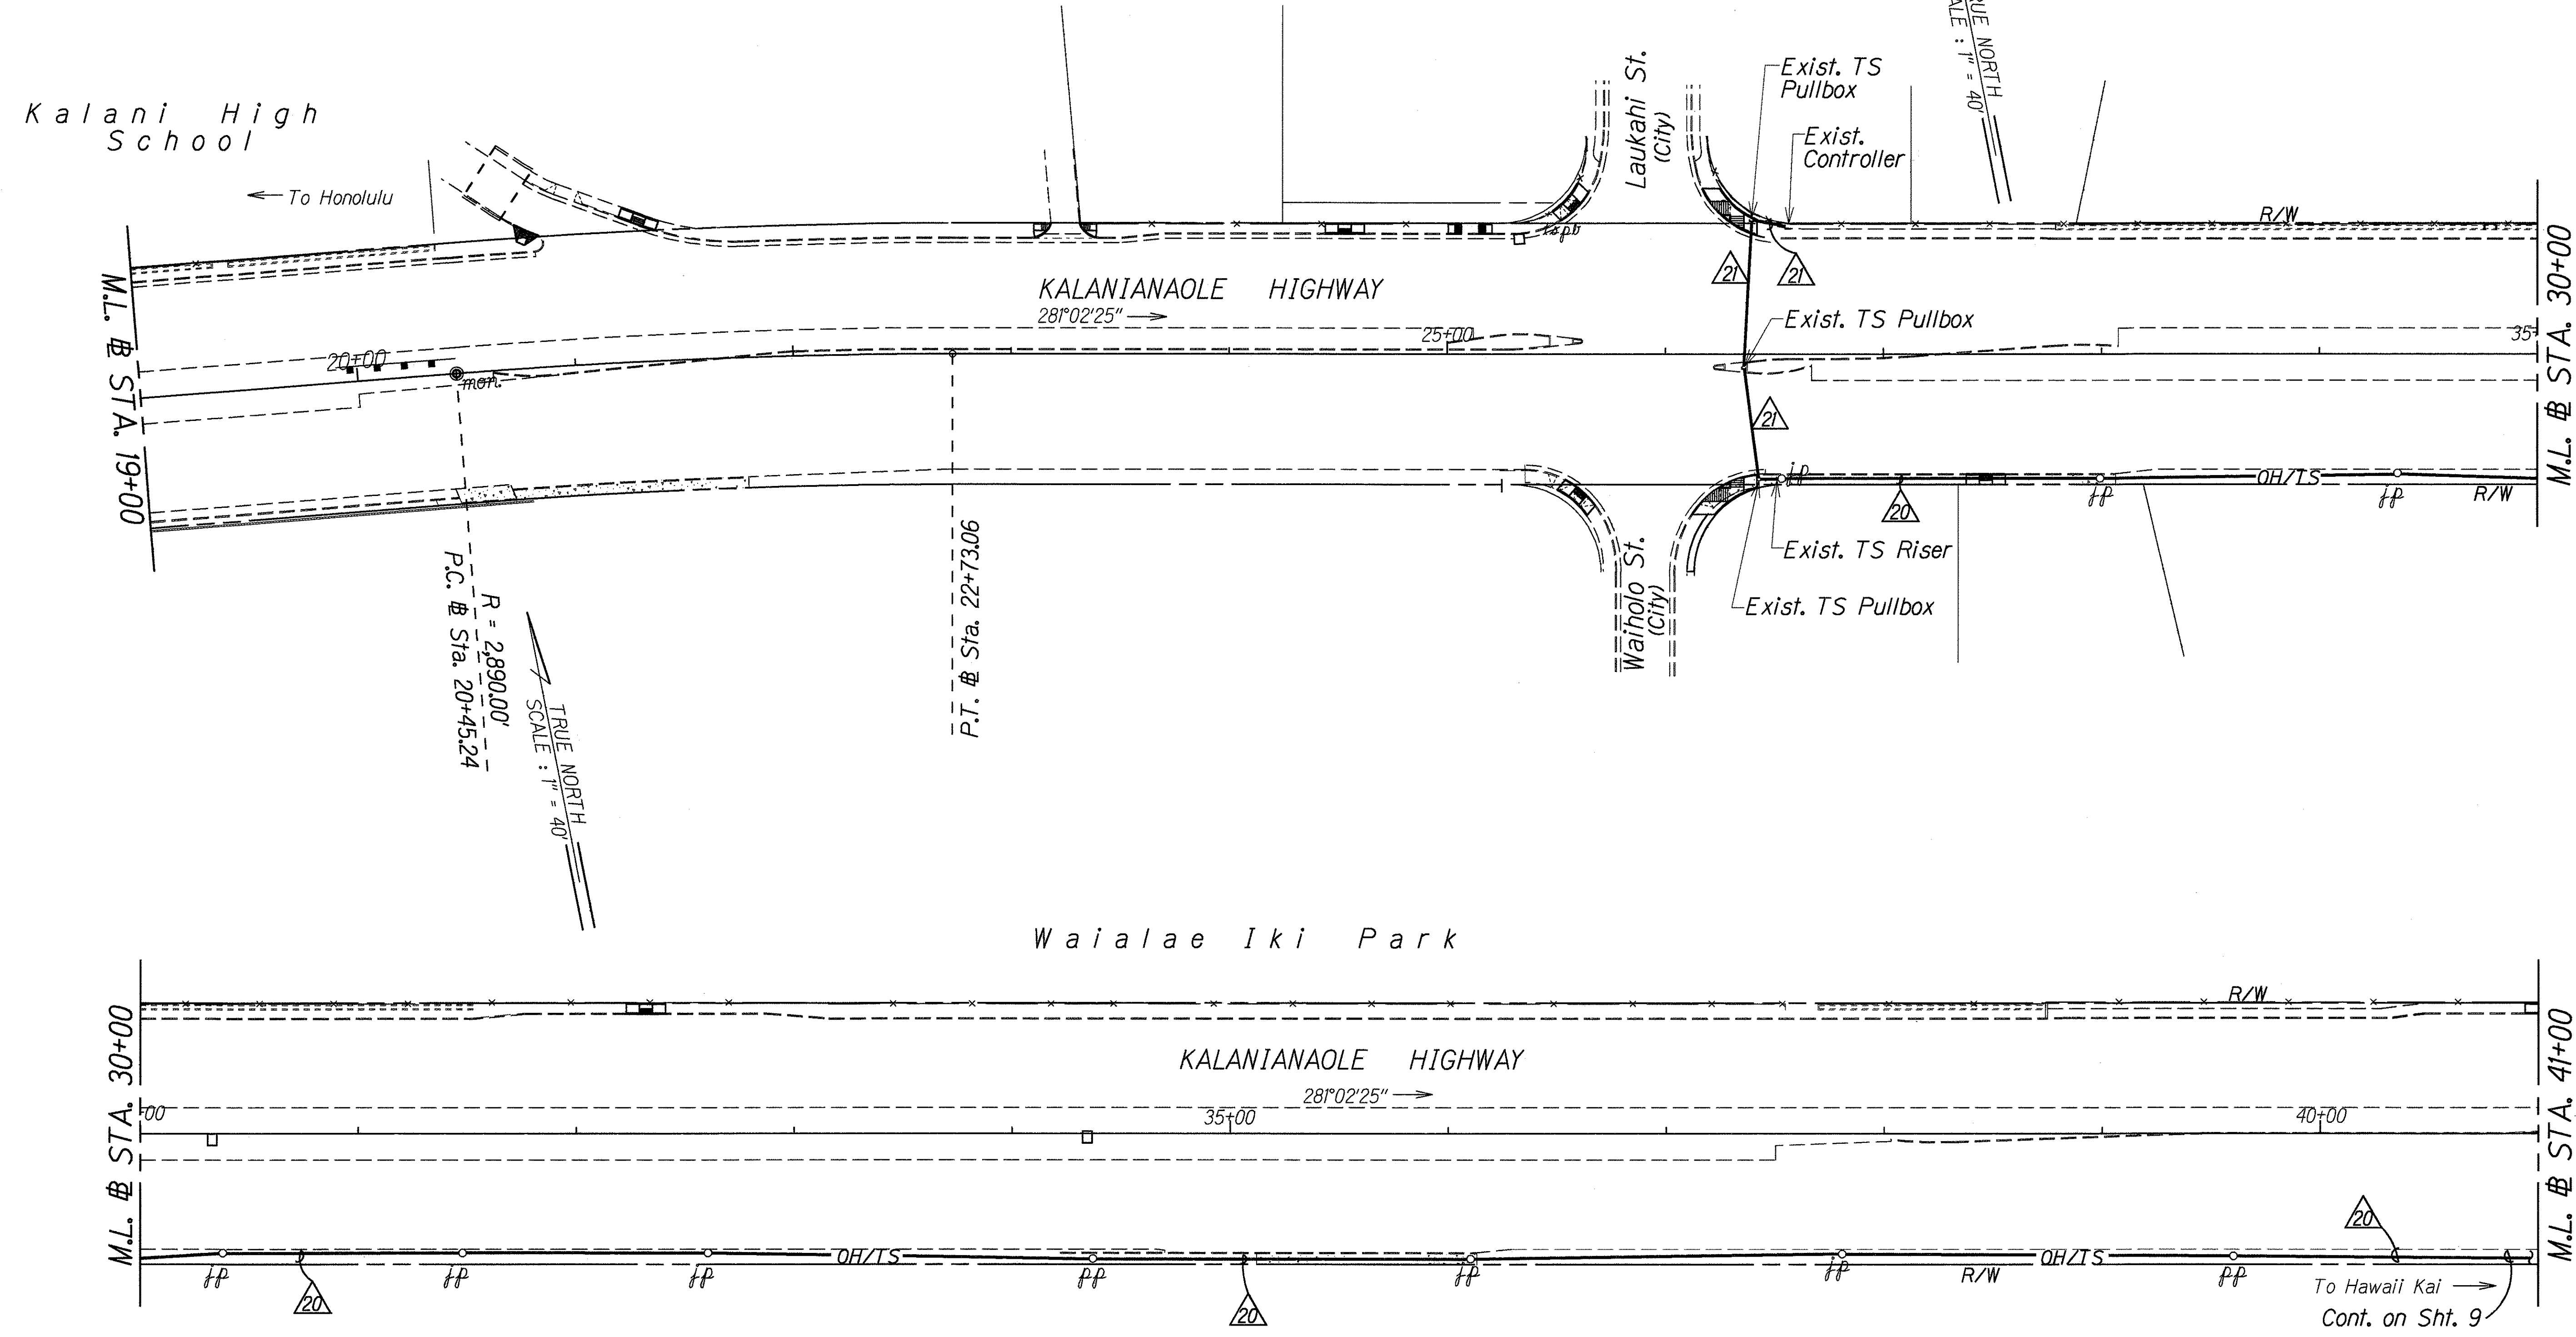

ORIGINAL PLAN	SURVEY PLOTTED BY	DATE
NOTE BOOK	DRAWN BY M. Takalili	
10/2/00	DESIGNED BY Steven Yoshida	
NA. ekalls03	CHECKED BY	

5/15/00	Add CCTV Fiberoptic Interconnect Cable Run 20
DATE	REVISION

STATE OF HAWAII
DEPARTMENT OF TRANSPORTATION
HIGHWAYS DIVISION

TRAFFIC SIGNAL PLAN
KALANIANA'OLE HIGHWAY
Installation of Traffic Signals
at Analii Street
Project No. 72C-01-00

Scale: 1"=40'
SHEET No. 1 OF 1 SHEETS

Date: Jan., 2000