


FED. ROAD DIST. NO.	STATE	PROJ. NO.	FISCAL YEAR	SHEET NO.	TOTAL SHEETS
HAWAII	HAW.	72C-02-98	1997	5	8

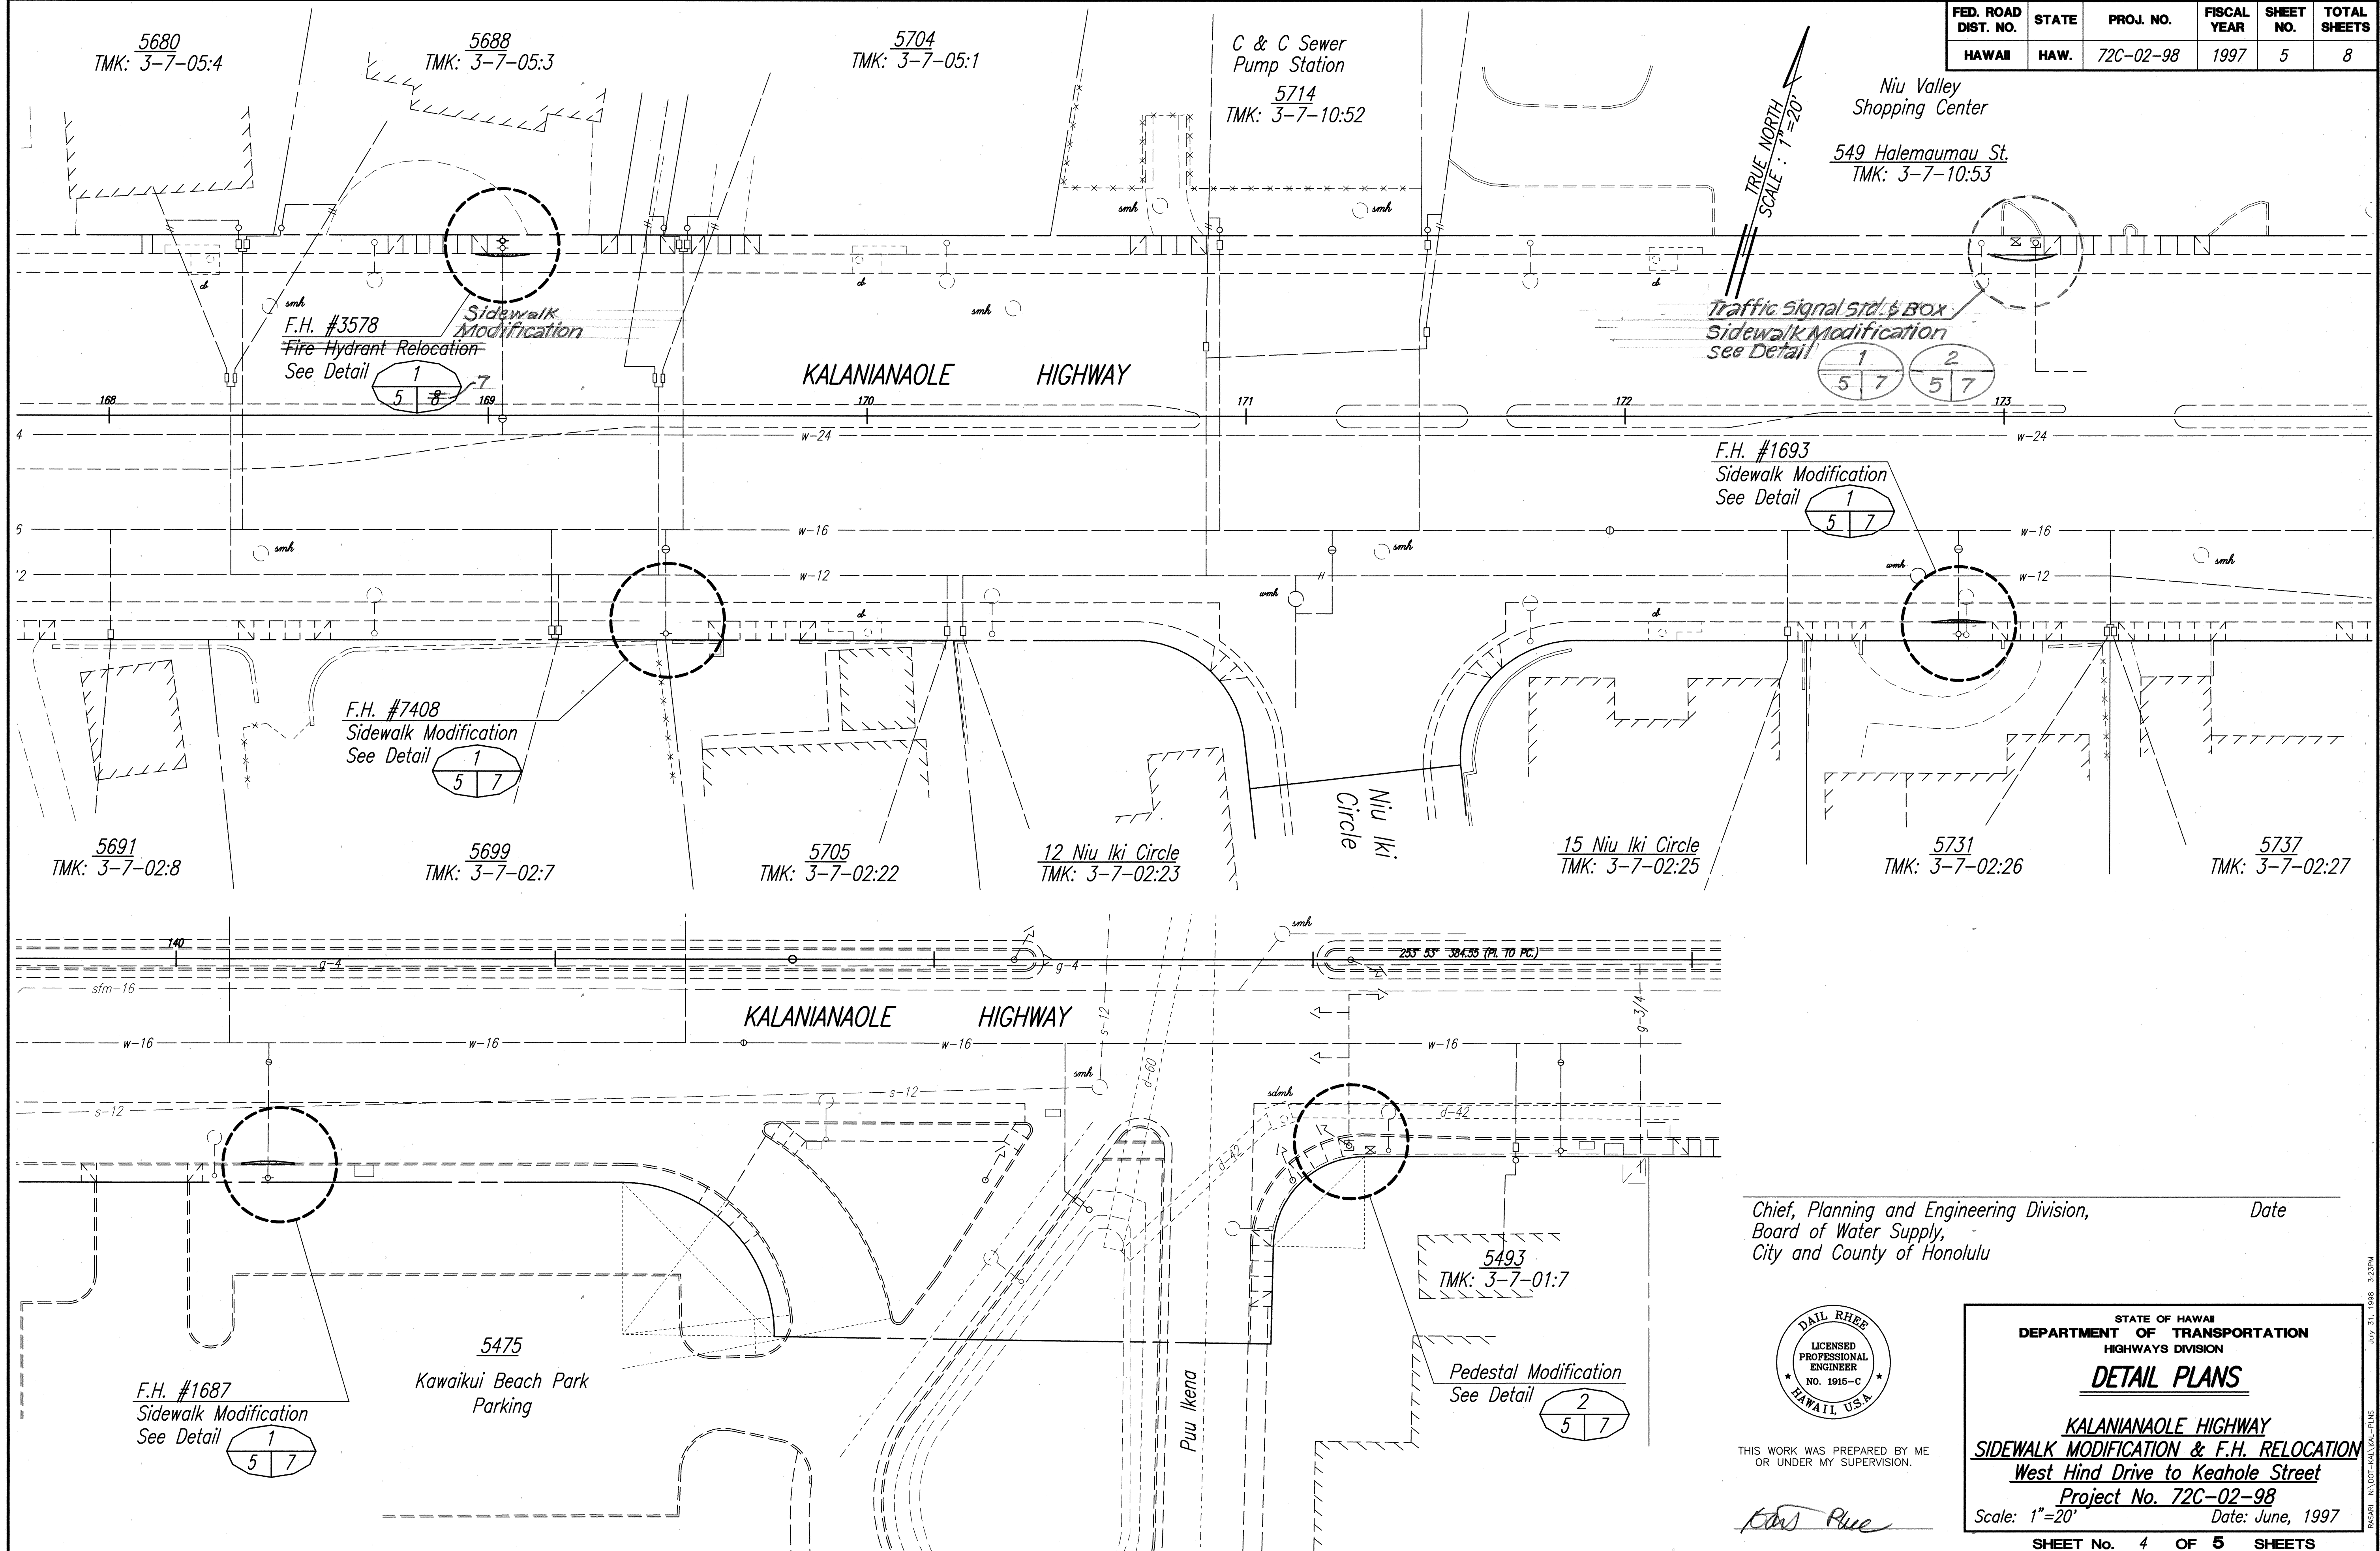

Chief, Planning and Engineering Division,
Board of Water Supply,
City and County of Honolulu



THIS WORK WAS PREPARED BY ME
OR UNDER MY SUPERVISION.


Dail Rhee

STATE OF HAWAII
DEPARTMENT OF TRANSPORTATION
HIGHWAYS DIVISION
DETAIL PLANS
KALANIANA'OLE HIGHWAY
SIDEWALK MODIFICATION & F.H. RELOCATION
West Hind Drive to Keahole Street
Project No. 72C-02-98
Scale: 1"=20'
Date: June, 1997
SHEET No. 4 OF 5 SHEETS

Date

ORIGINAL PLAN	SURVEY PLOTTED BY	DATE
TRACED BY		
NOTE BOOK		
QUANTITIES BY		
CHECKED BY		
No.		

FED. ROAD DIST. NO.	STATE	PROJ. NO.	FISCAL YEAR	SHEET NO.	TOTAL SHEETS
HAWAII	HAW.	72C-02-98	1997	6	8

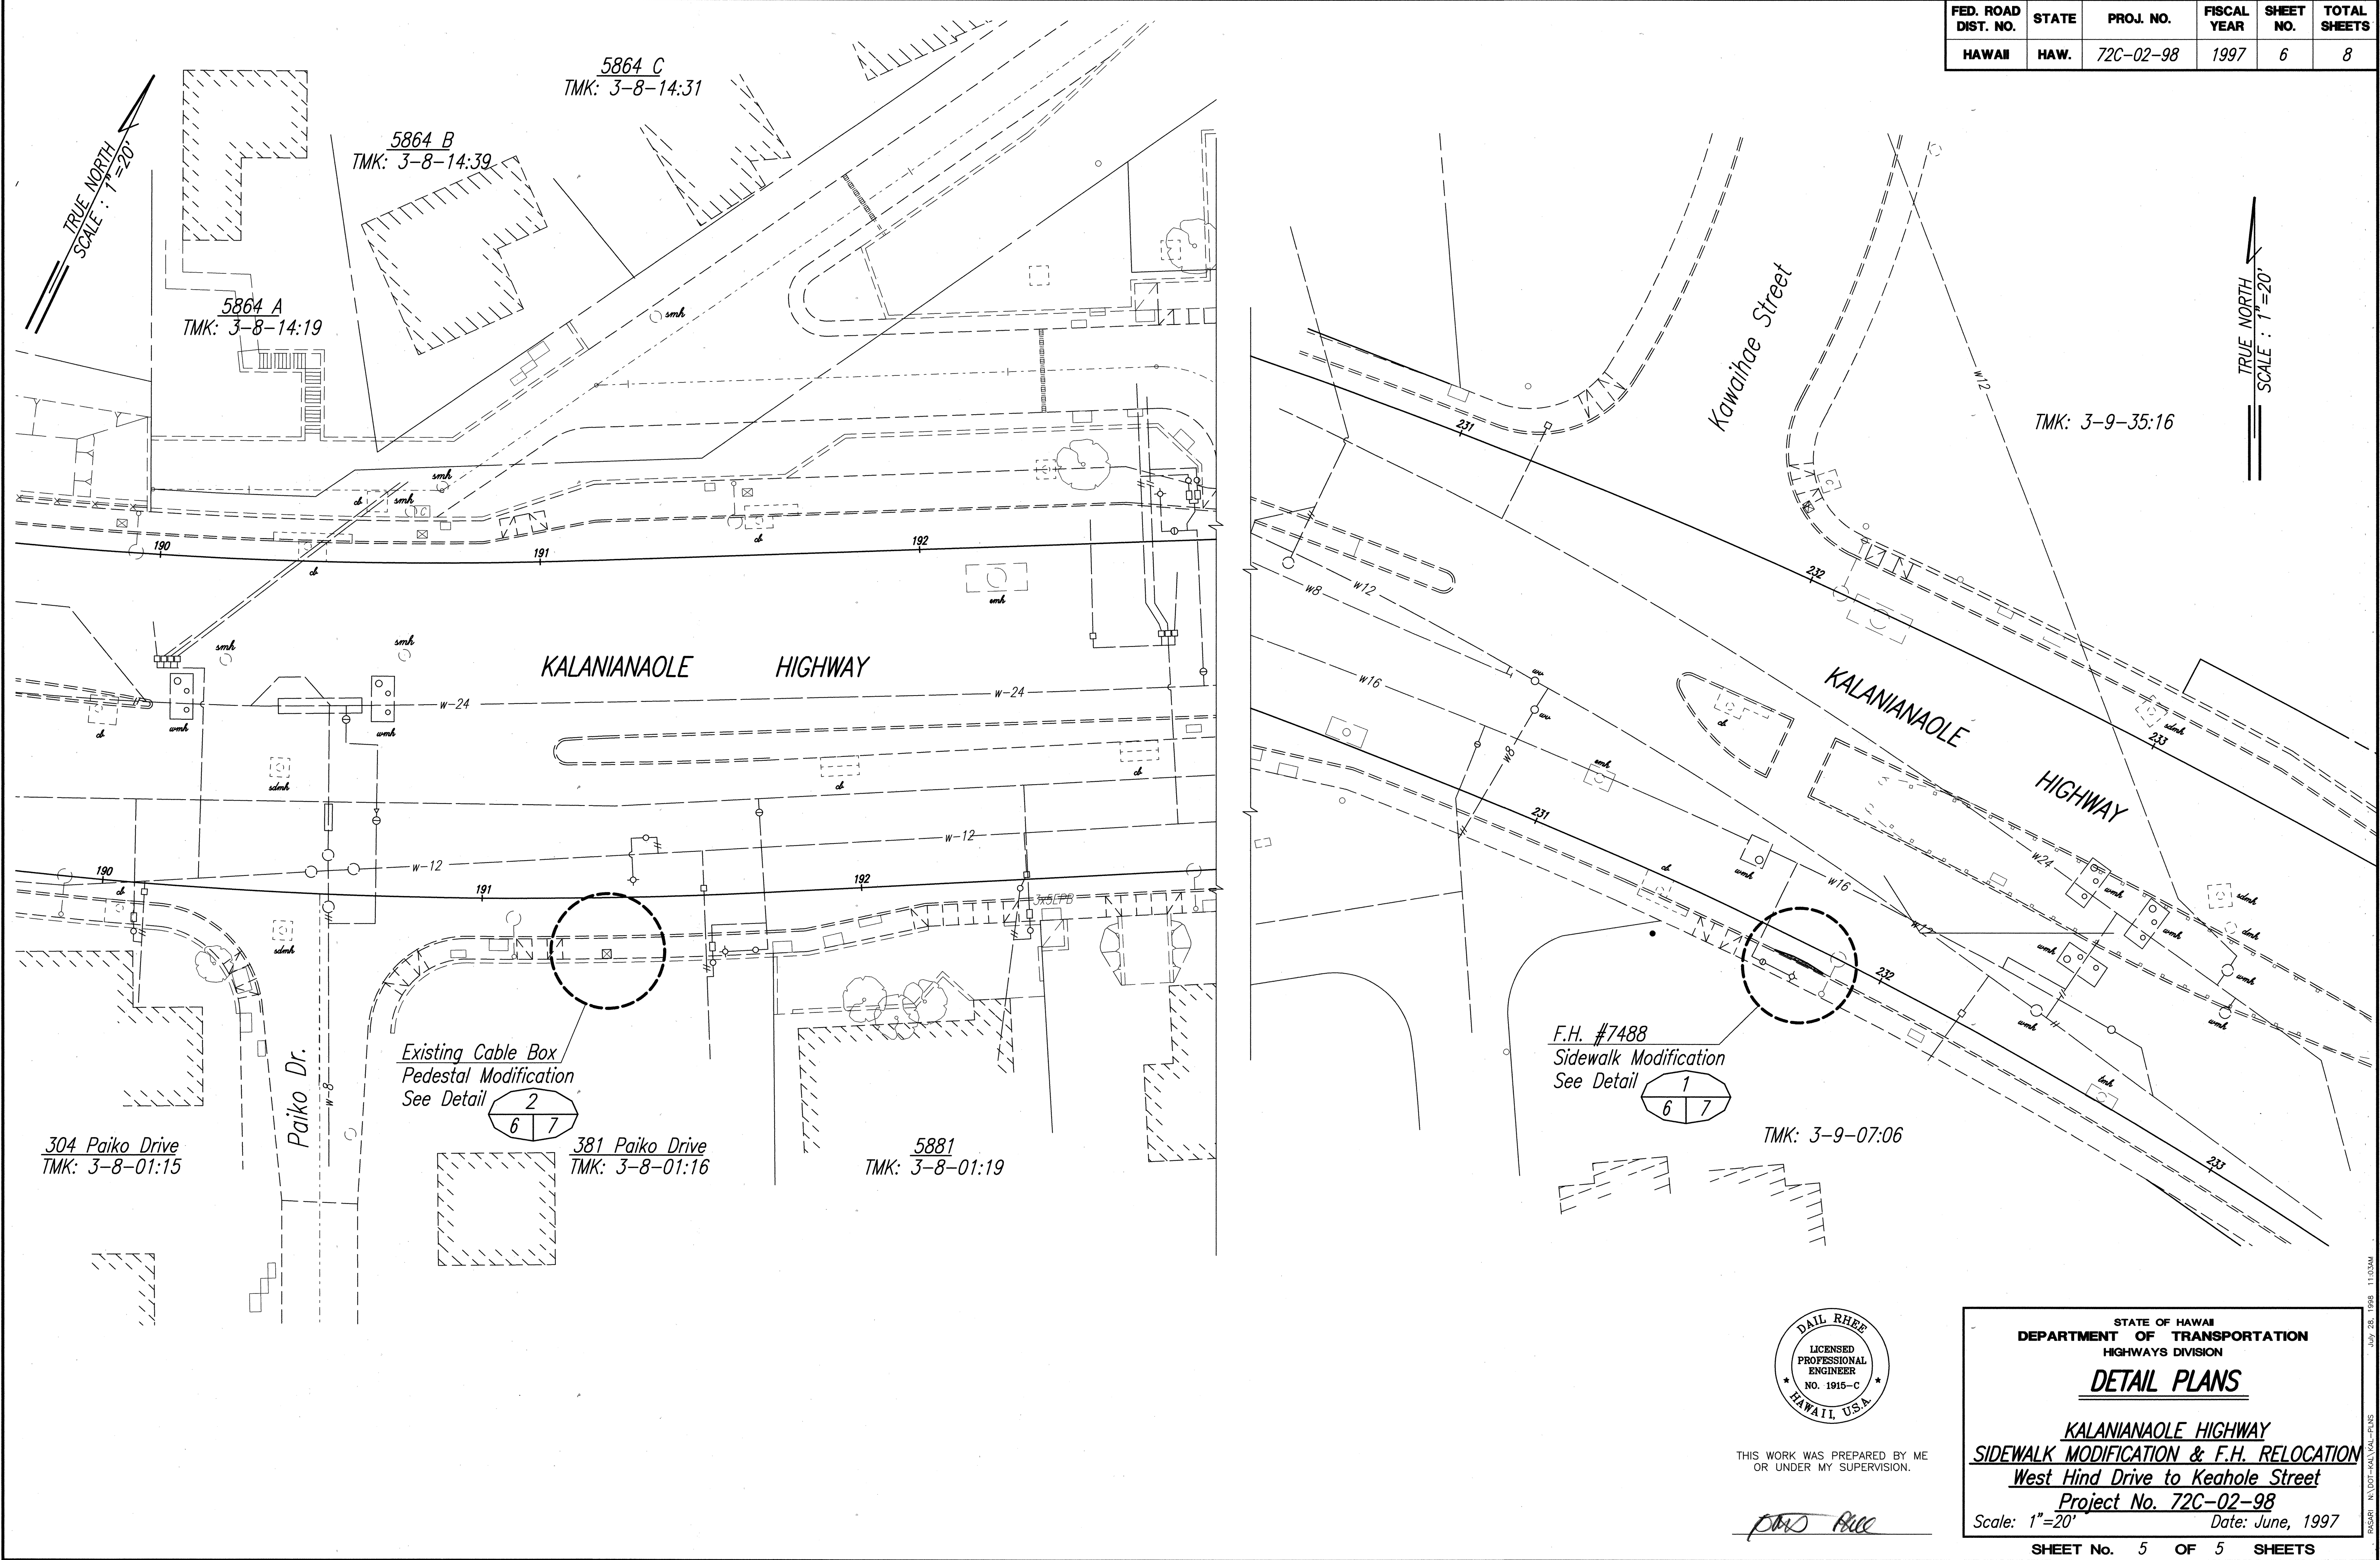

ORIGINAL PLAN	DATE
DRAWN BY	
TRACED BY	
NOTED BY	
CHECKED BY	
NO.	