

INDEX TO DRAWINGS	
SHEET NO.	DESCRIPTION
1	TITLE SHEET
2-6	DETAIL PLANS
7	SIDEWALK MODIFICATION DETAIL
8	FIRE HYDRANT RELOCATION DETAIL

STATE OF HAWAII

DEPARTMENT OF TRANSPORTATION

HIGHWAYS DIVISION

HONOLULU, HAWAII

"AS-BUILT"

PLANS FOR

KALANIANA'OLE HIGHWAY

SIDEWALK MODIFICATION

& FIRE HYDRANT RELOCATION




WEST HIND DRIVE TO KEAHOLE STREET

PROJECT NO. 72C-02-98

DISTRICT OF HONOLULU

ISLAND OF OAHU

FED. ROAD DIST. NO.	STATE	FED. AID PROJ. NO.	FISCAL YEAR	SHEET NO.	TOTAL SHEETS
HAWAII	HAW.	72C-02-98	1997	1	8

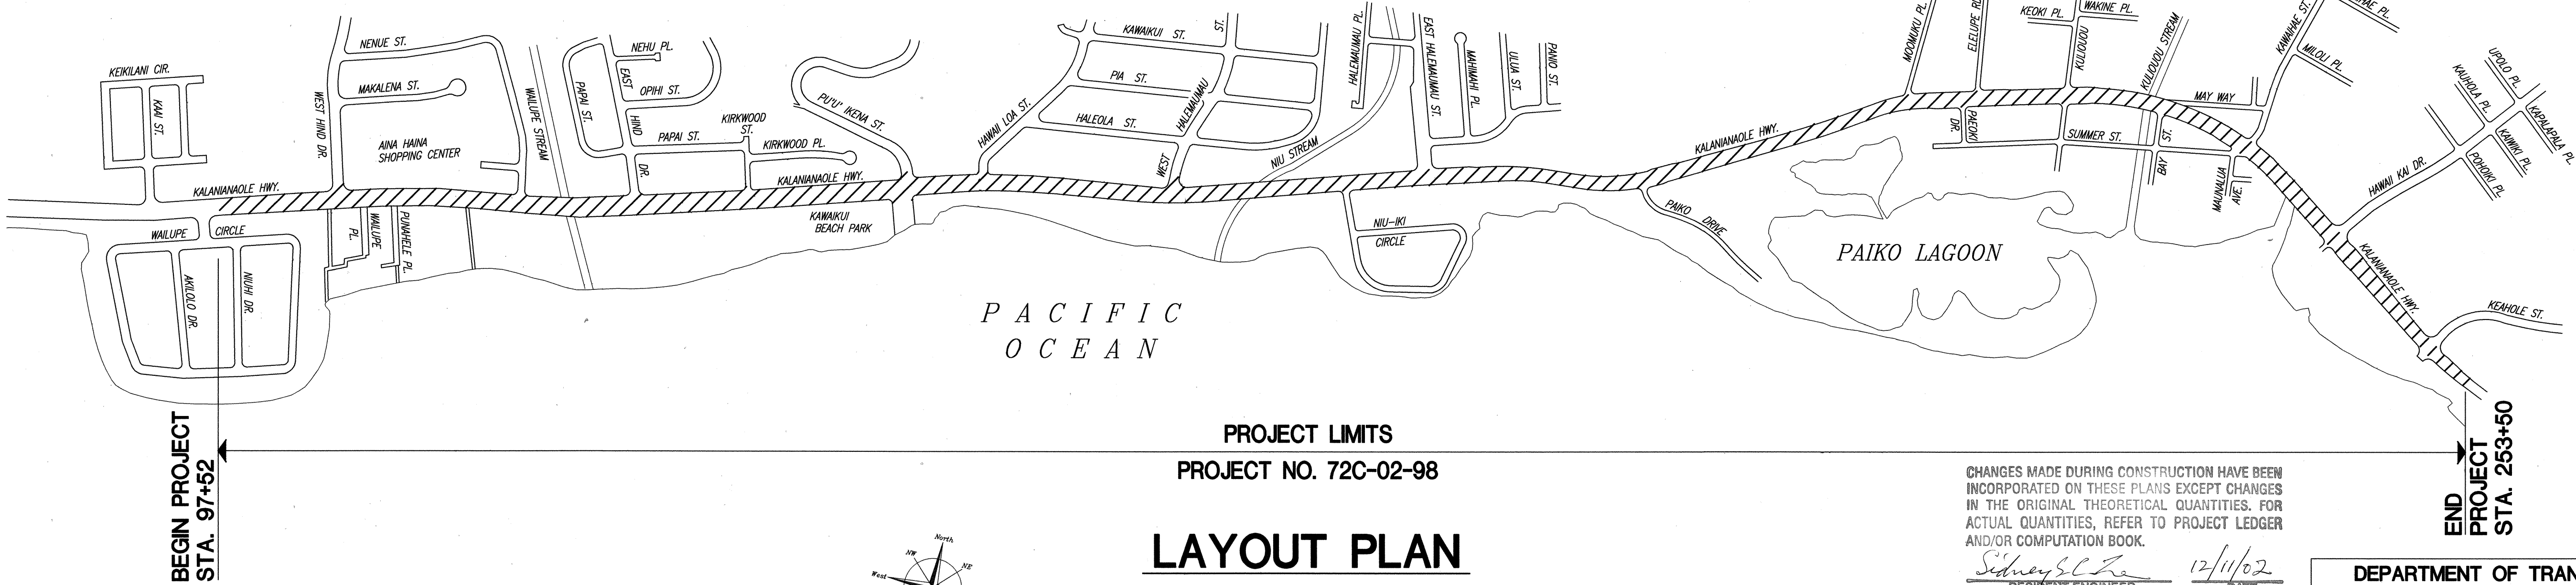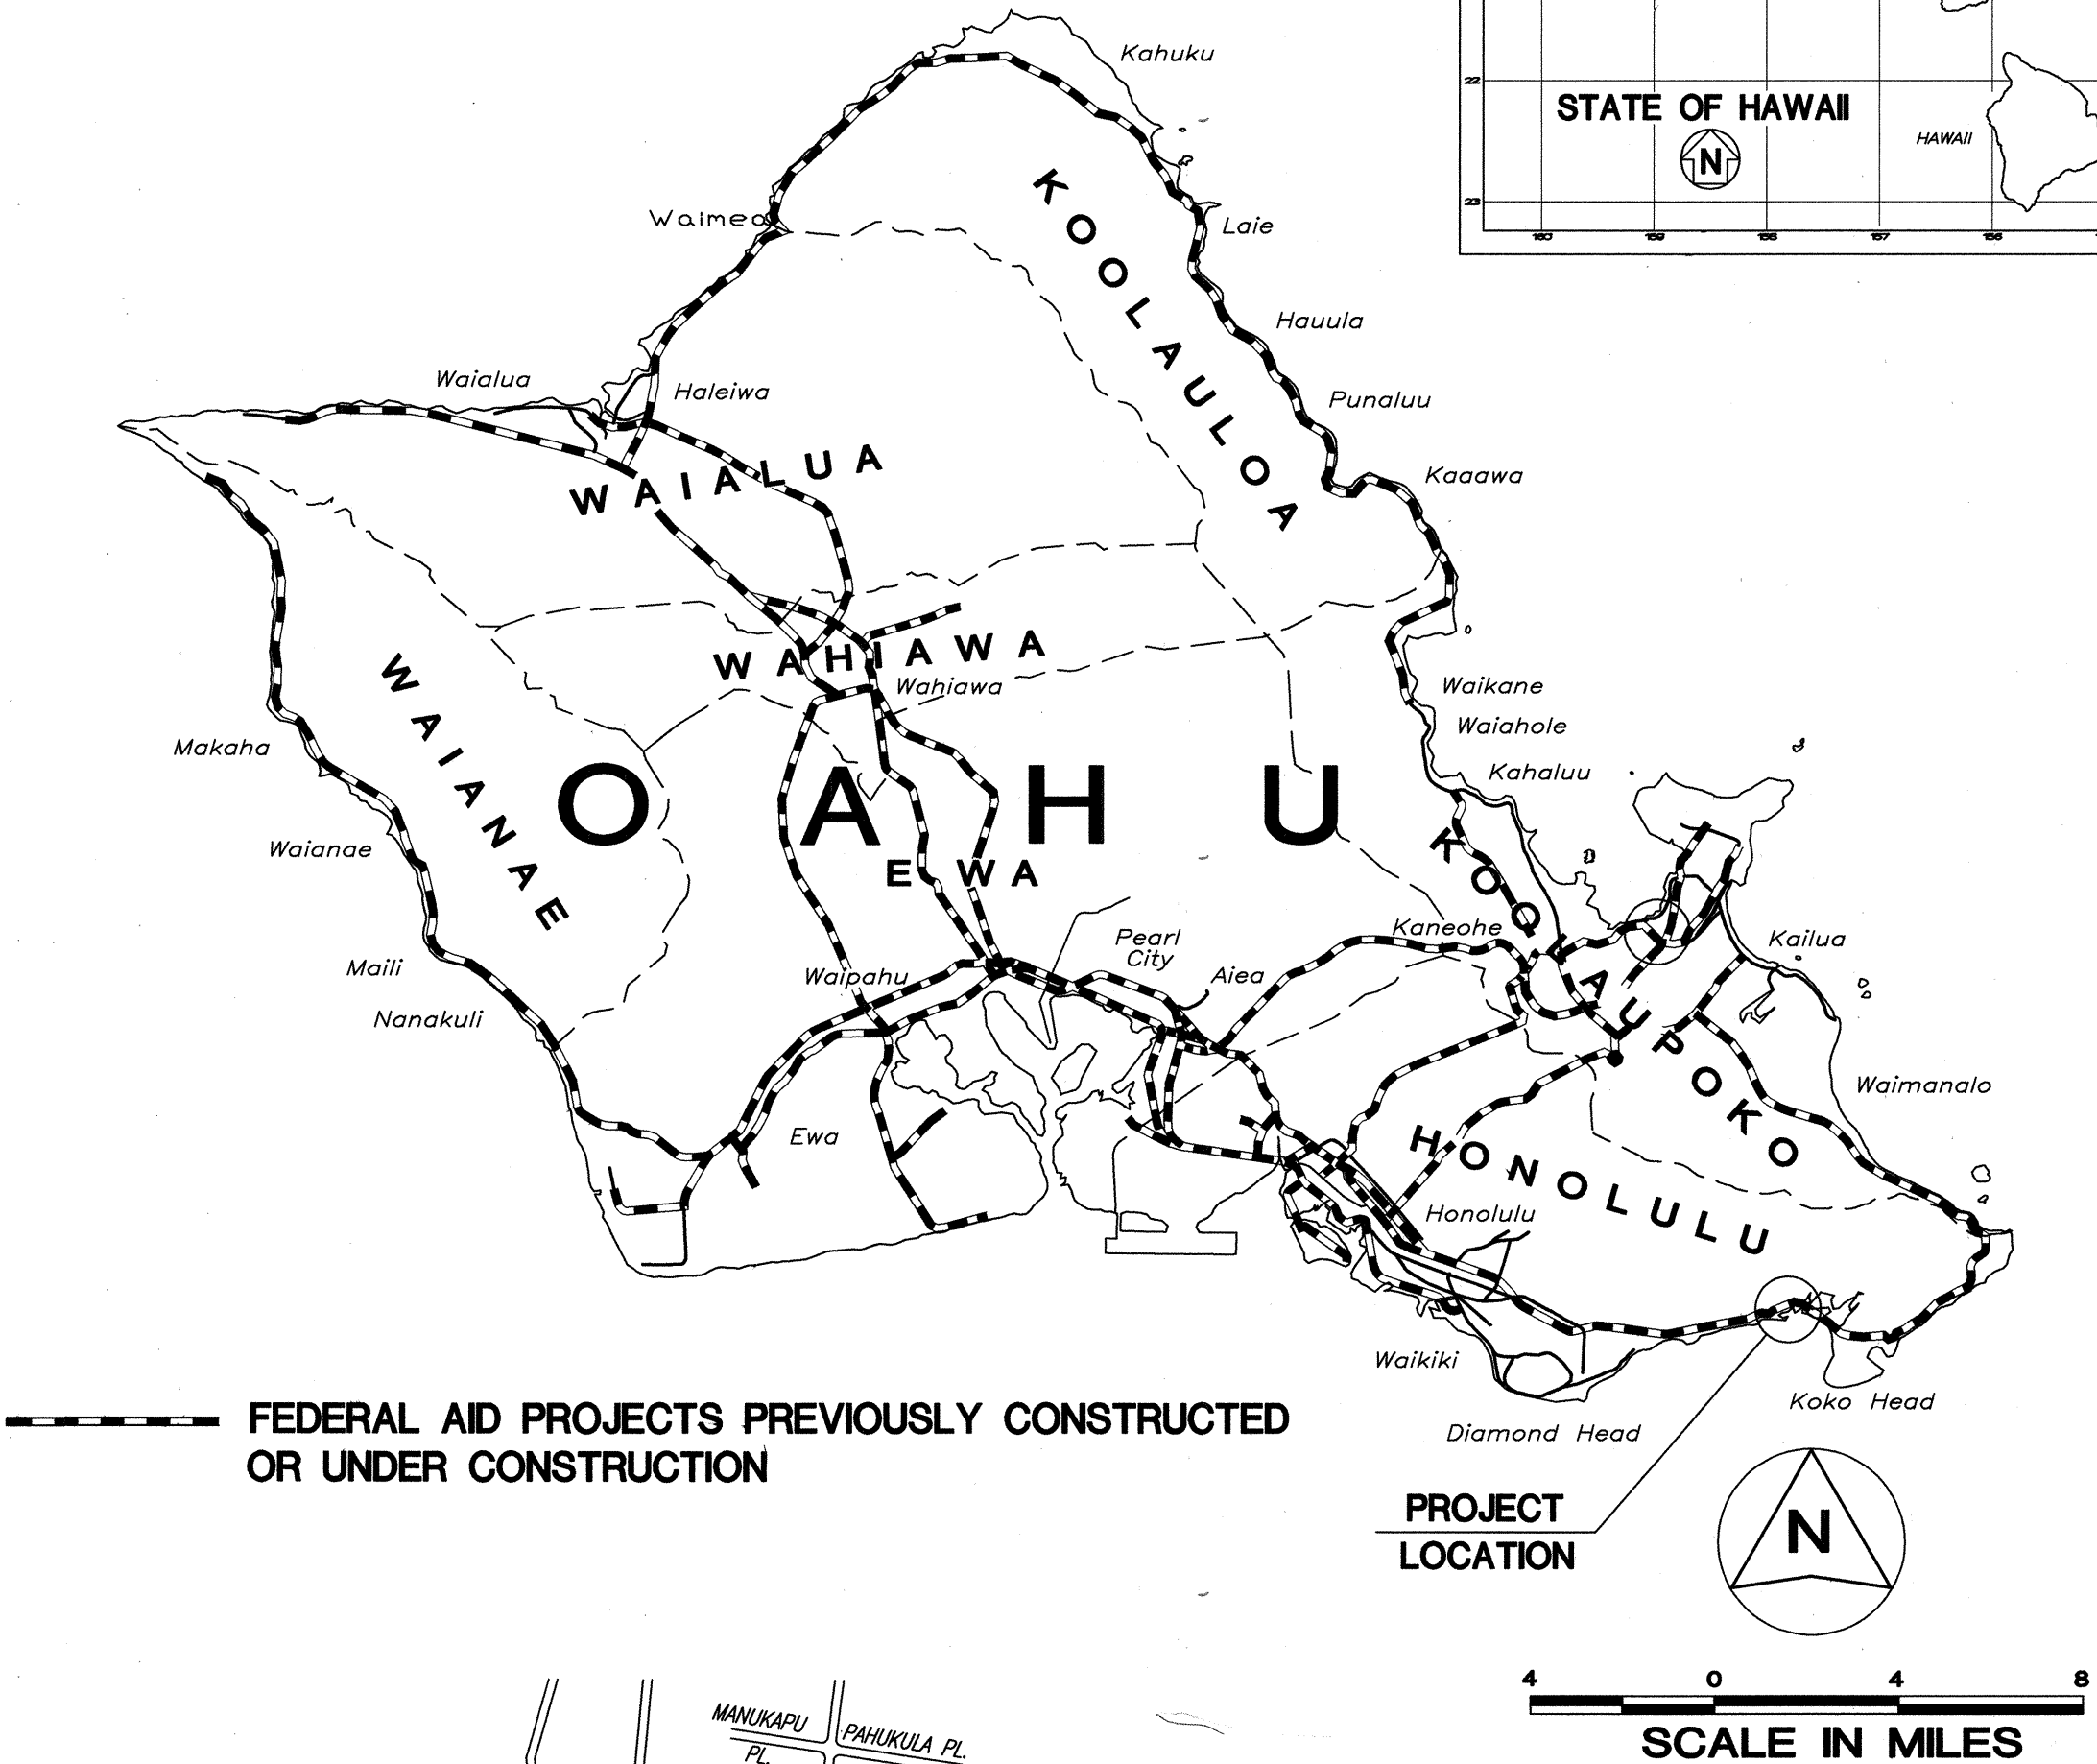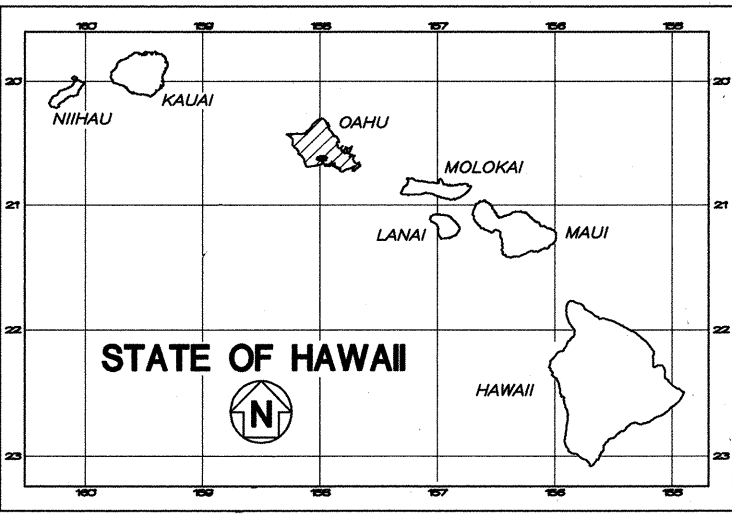

M&E Pacific, Inc.

DESIGNED BY

Greg Watanabe


587-2124

Oct., 1997

DATE

P. S. & E. BY

PHONE

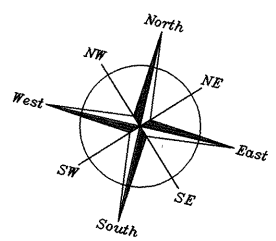

GROSS LENGTH OF PROJECT

BRIDGES OVER 2000' SPAN

NET LENGTH OF ROADWAY

- 2.954 MILES

- 0

- 2.954 MILES



CHANGES MADE DURING CONSTRUCTION HAVE BEEN INCORPORATED ON THESE PLANS EXCEPT CHANGES IN THE ORIGINAL THEORETICAL QUANTITIES. FOR ACTUAL QUANTITIES, REFER TO PROJECT LEDGER AND/OR COMPUTATION BOOK.

Sidney S. Lee

RESIDENT ENGINEER

12/11/02

DATE

DEPARTMENT OF TRANSPORTATION

STATE OF HAWAII

APPROVED:

Merrill M. Bennett

10/22/97

DATE

DIR. OF TRANSPORTATION