


FED. ROAD DIST. NO.	STATE	FED. AID PROJ. NO.	FISCAL YEAR	SHEET NO.	TOTAL SHEETS
HAWAII	HAW.	NH-072-1(47)	2000	C.O.33	89

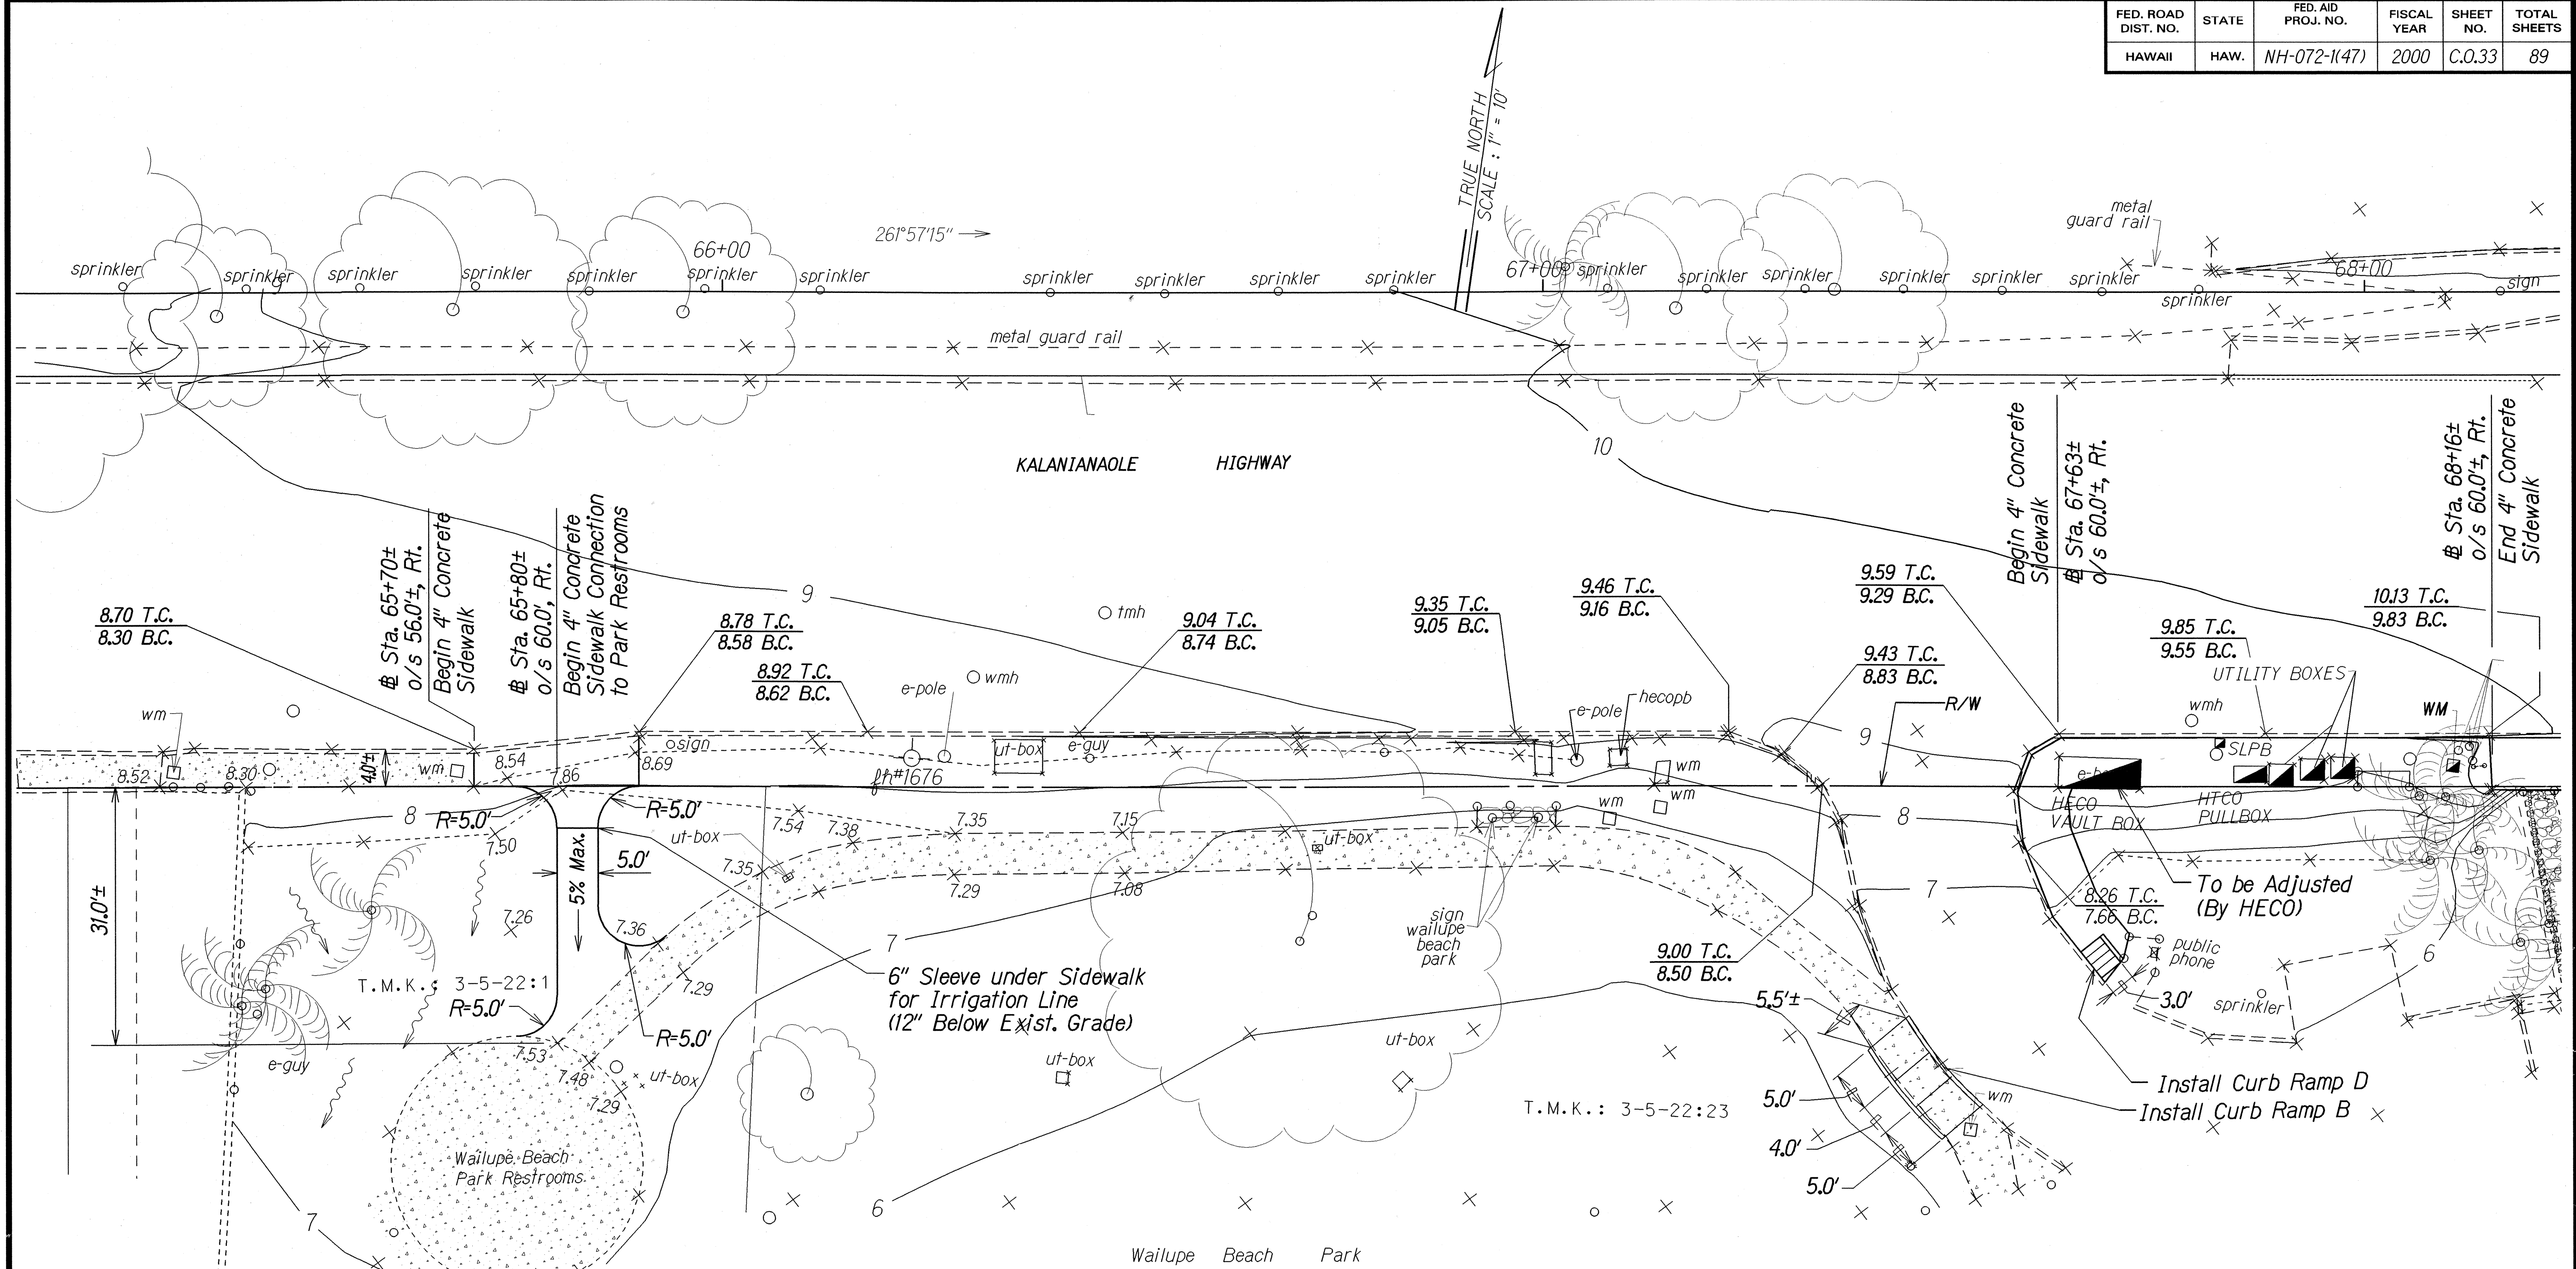

SURVEY PLOTTED BY	DATE
DESIGNED BY	5/28/02
QUANTITIES BY	
CHECKED BY	

APPROVED:

[Signature] 5/3/02

DIRECTOR, DEPARTMENT OF
DESIGN AND CONSTRUCTION
CITY AND COUNTY OF HONOLULU

APPROVED:

[Signature] 5/6/02

DIRECTOR, DEPARTMENT OF
PARKS AND RECREATION
CITY AND COUNTY OF HONOLULU

3/28/02	Revise sidewalk and curb ramps.
DATE	REVISION
STATE OF HAWAII DEPARTMENT OF TRANSPORTATION HIGHWAYS DIVISION DETAIL PLAN AT WAILUPE BEACH PARK KALANIANA'OLE HIGHWAY RESURFACING Ainakoa Avenue to West Hind Drive Federal-Aid Project No. NH-072-1(47) Scale: 1"=10' Date: Aug., 1999	
SHEET No. 1 OF 1 SHEETS	