


CURVE DATA															
	1	2	3	4	5	6	7	8	9	10	11	12	13	14	15
Δ	134°24'11"	90°00'00"	151°01'47"	07°03'24"	06°11'20"	02°11'43"	90°00'00"	132°43'50"	160°26'08"	06°14'52"	05°29'48"	11°26'04"	97°30'05"	16°39'19"	70°00'32"
Δ/2	67°12'05.5"	45°00'00"	75°30'53.5"	03°31'42"	03°05'40"	01°05'51.5"	45°00'00"	66°21'55"	80°13'04"	03°07'26"	02°44'54"	05°43'02"	48°45'02.5"	08°19'39.5"	35°00'16.0"
R	0.50'	0.50'	0.50'	66.50'	66.50'	66.50'	0.50'	0.50'	0.50'	75.00'	75.00'	75.00'	6.00'	75.00'	43.00'
T	1.20'	0.50'	1.94'	4.10'	3.60'	1.27'	0.50'	1.14'	2.90'	4.09'	3.60'	7.50'	6.84'	10.98'	30.41'
C	0.92'	0.71'	0.97'	8.20'	7.20'	2.55'	0.71'	0.92'	0.99'	8.17'	7.19'	14.94'	9.02'	21.73'	49.65'
Lc	1.17'	0.79'	1.32'	8.19'	7.18'	2.55'	0.79'	1.16'	1.40'	8.19'	7.20'	14.97'	10.21'	21.80'	52.93'

*Removal of Existing Island
Shall be Considered Incidental
to Varies Contract Items.

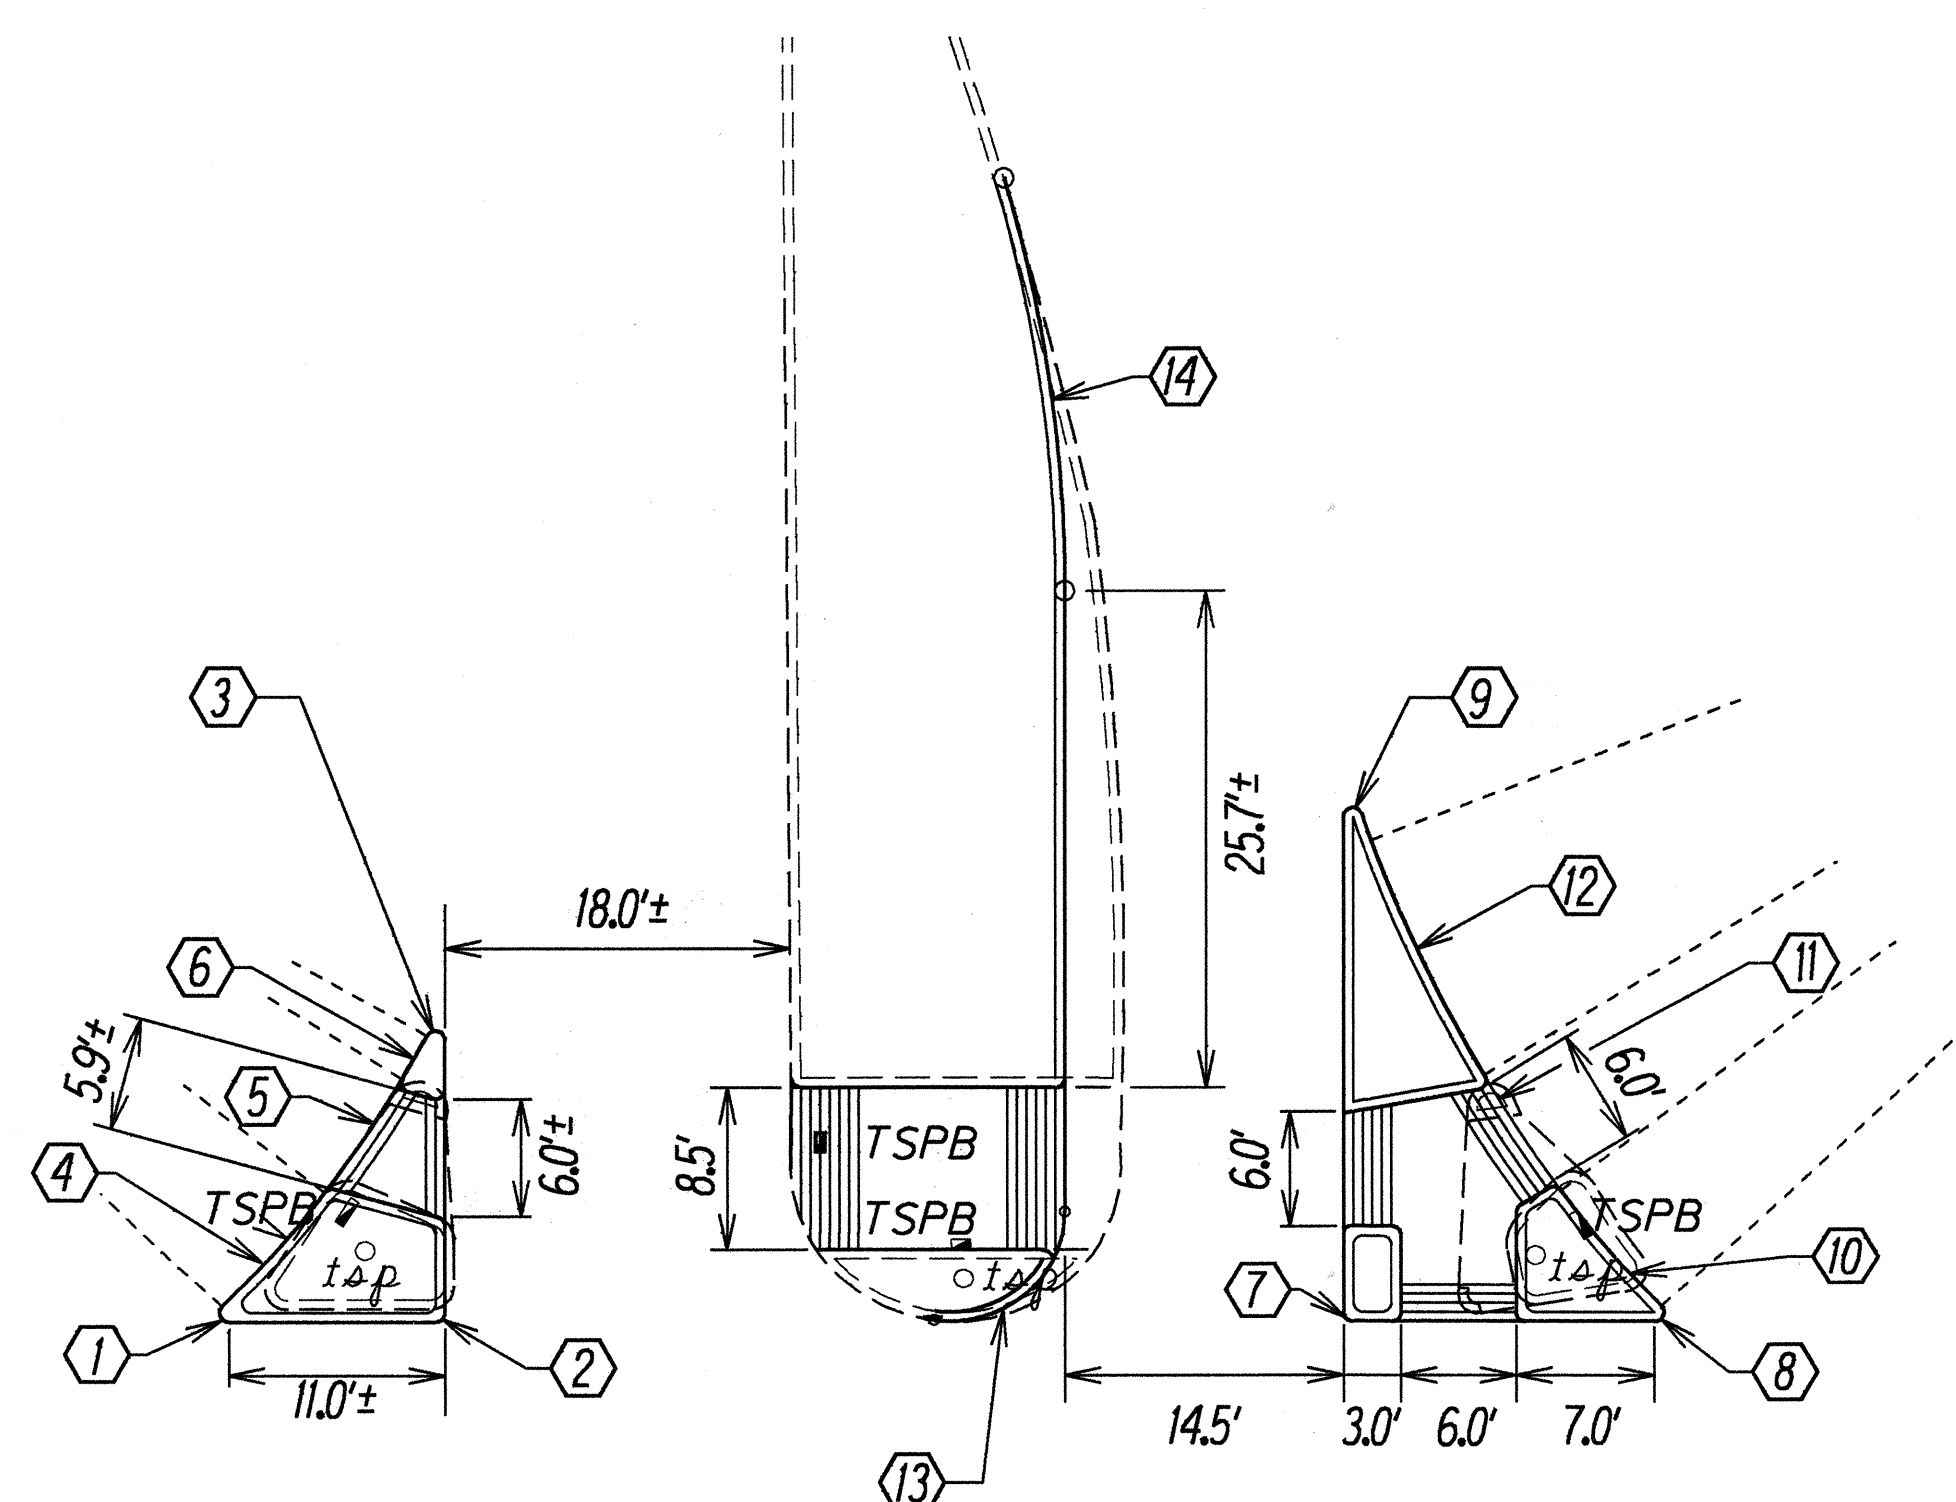

INSET
Scale: 1"=10'

ORIGINAL PLAN	SURVEY PLOTTED BY _____	DATE <u>11/10/98</u>
NOTE BOOK <u>ddg.980 ge</u>	DRAWN BY <u>GA</u>	
	TRACED BY _____	
	DESIGNED BY <u>JF</u>	
	QUANTITIES BY _____	
	CHECKED BY _____	

STATE OF HAWAII
DEPARTMENT OF TRANSPORTATION
HIGHWAYS DIVISION

DETAIL ROADWAY PLAN

KALANIANA'OLE HIGHWAY RESURFACING
Ainako'a Avenue to West Hind Drive
Federal-Aid Project No. NH-072-1(K47)

Scale: 1"=10' Date: Aug., 1999

SHEET No. 1 OF 1 SHEETS