

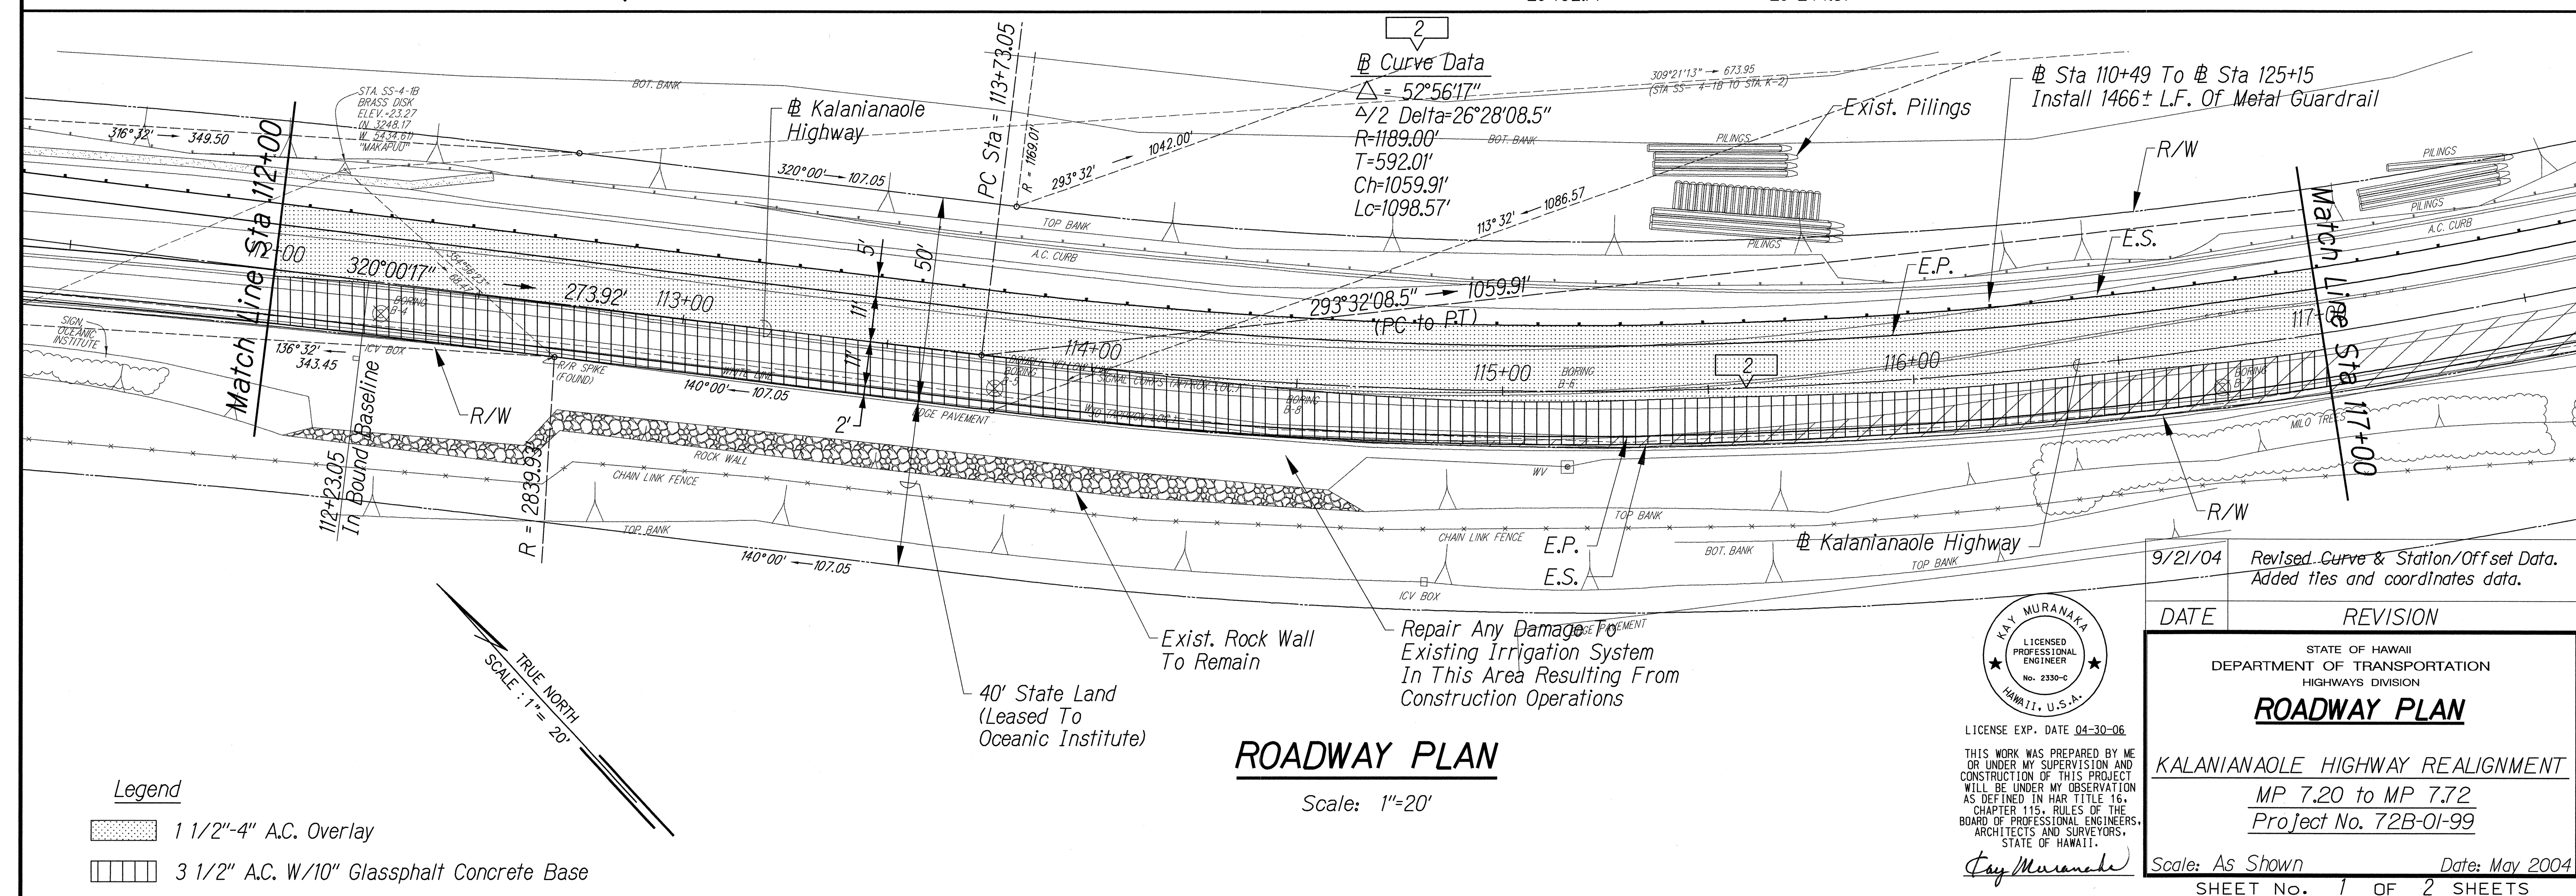


FED. ROAD DIST. NO.	STATE	FED. AID PROJ. NO.	FISCAL YEAR	SHEET NO.	TOTAL SHEETS
HAWAII	HAW.	72B-01-99	2004	10	22

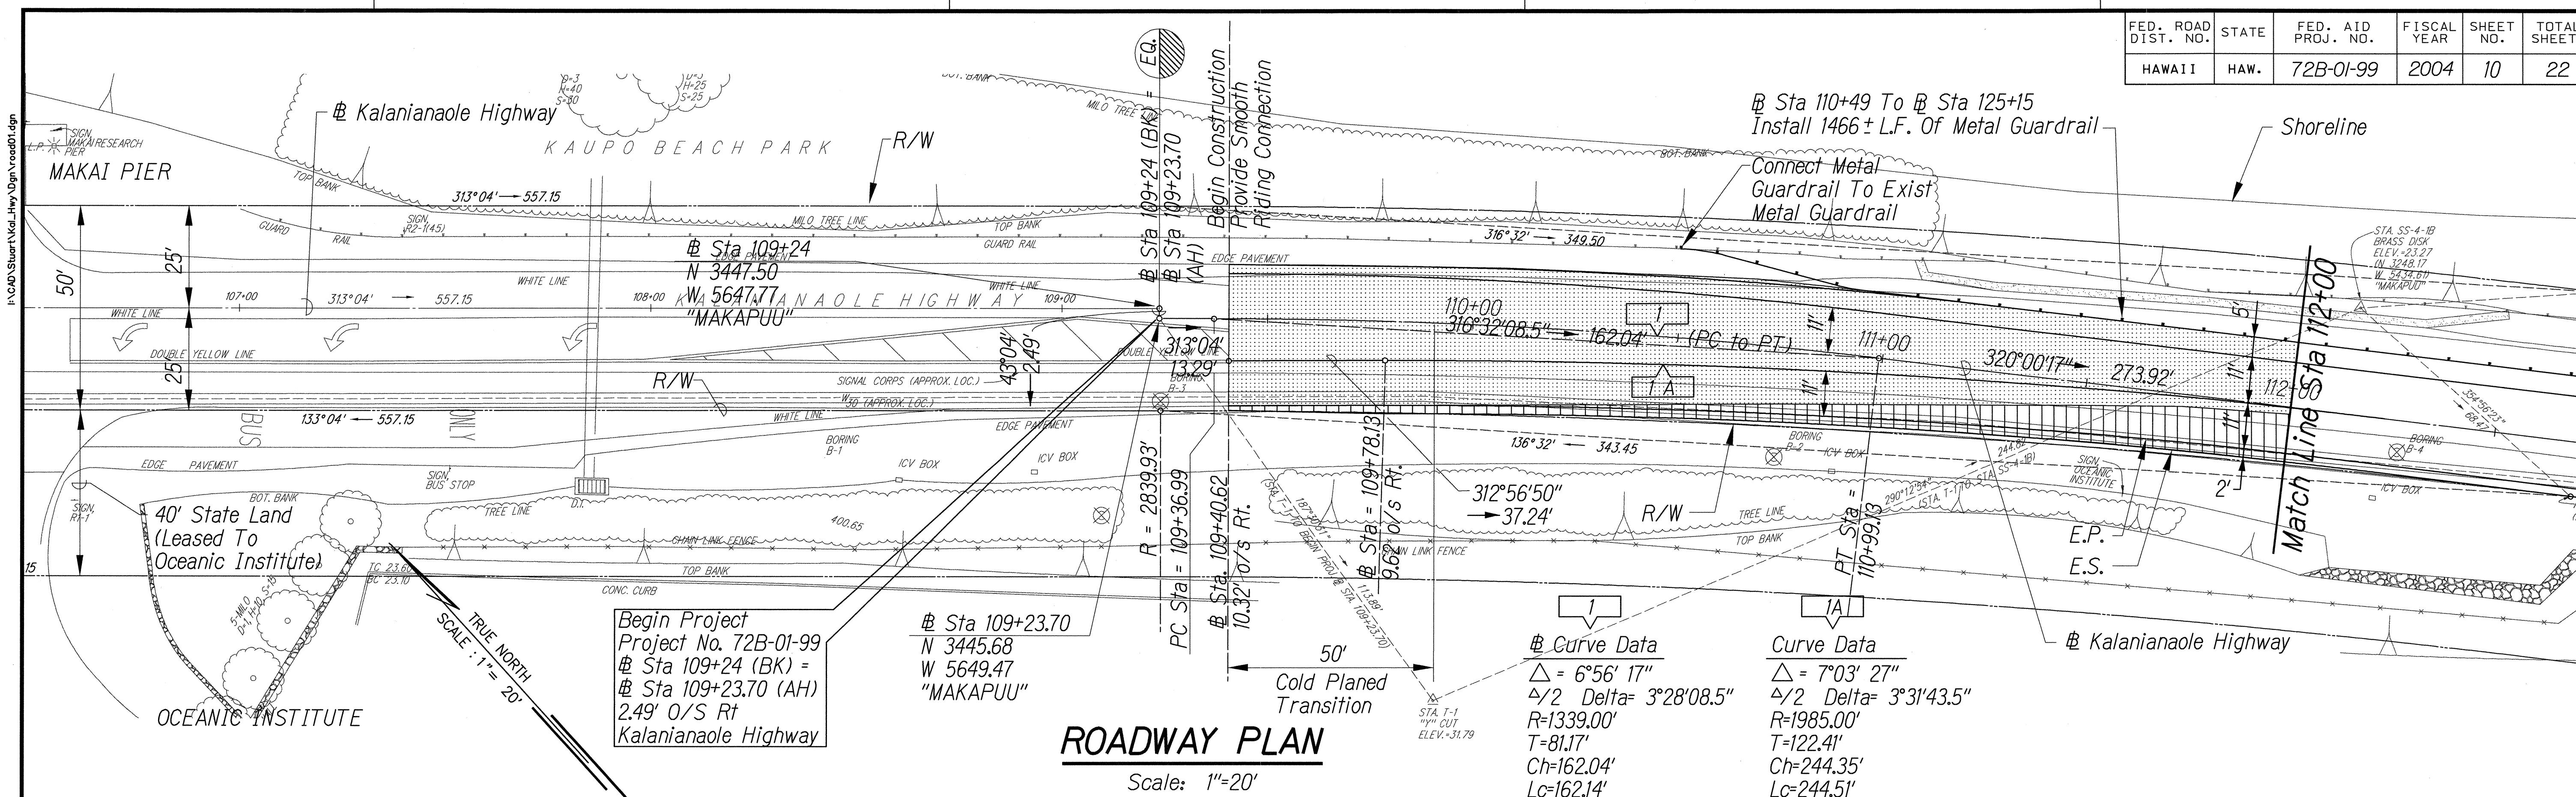

Legend

- 1 1/2"-4" A.C. Overlay
- 3 1/2" A.C. W/10" Glassphalt Concrete Base

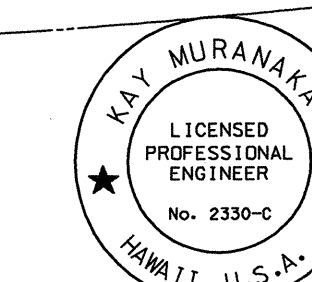

LICENSE EXP. DATE 04-30-06

THIS WORK WAS PREPARED BY ME OR UNDER MY SUPERVISION AND CONSTRUCTION OF THIS PROJECT WILL BE UNDER MY OBSERVATION AS DEFINED IN HAWAII TITLE 16, CHAPTER 115, RULES OF THE BOARD OF PROFESSIONAL ENGINEERS, ARCHITECTS AND SURVEYORS, STATE OF HAWAII.

Kay Muranaka

9/21/04 Revised Curve & Station/Offset Data. Added ties and coordinates data.

DATE REVISION

STATE OF HAWAII
DEPARTMENT OF TRANSPORTATION
HIGHWAYS DIVISION

ROADWAY PLAN

KALANIANA'OLE HIGHWAY REALIGNMENT

MP 7.20 to MP 7.72



Project No. 72B-01-99

Scale: As Shown Date: May 2004

SHEET No. 1 OF 2 SHEETS

C.O. 10

FED. ROAD DIST. NO.	STATE	FED. AID PROJ. NO.	FISCAL YEAR	SHEET NO.	TOTAL SHEETS
HAWAII	HAW.	72B-01-99	2004	11	22

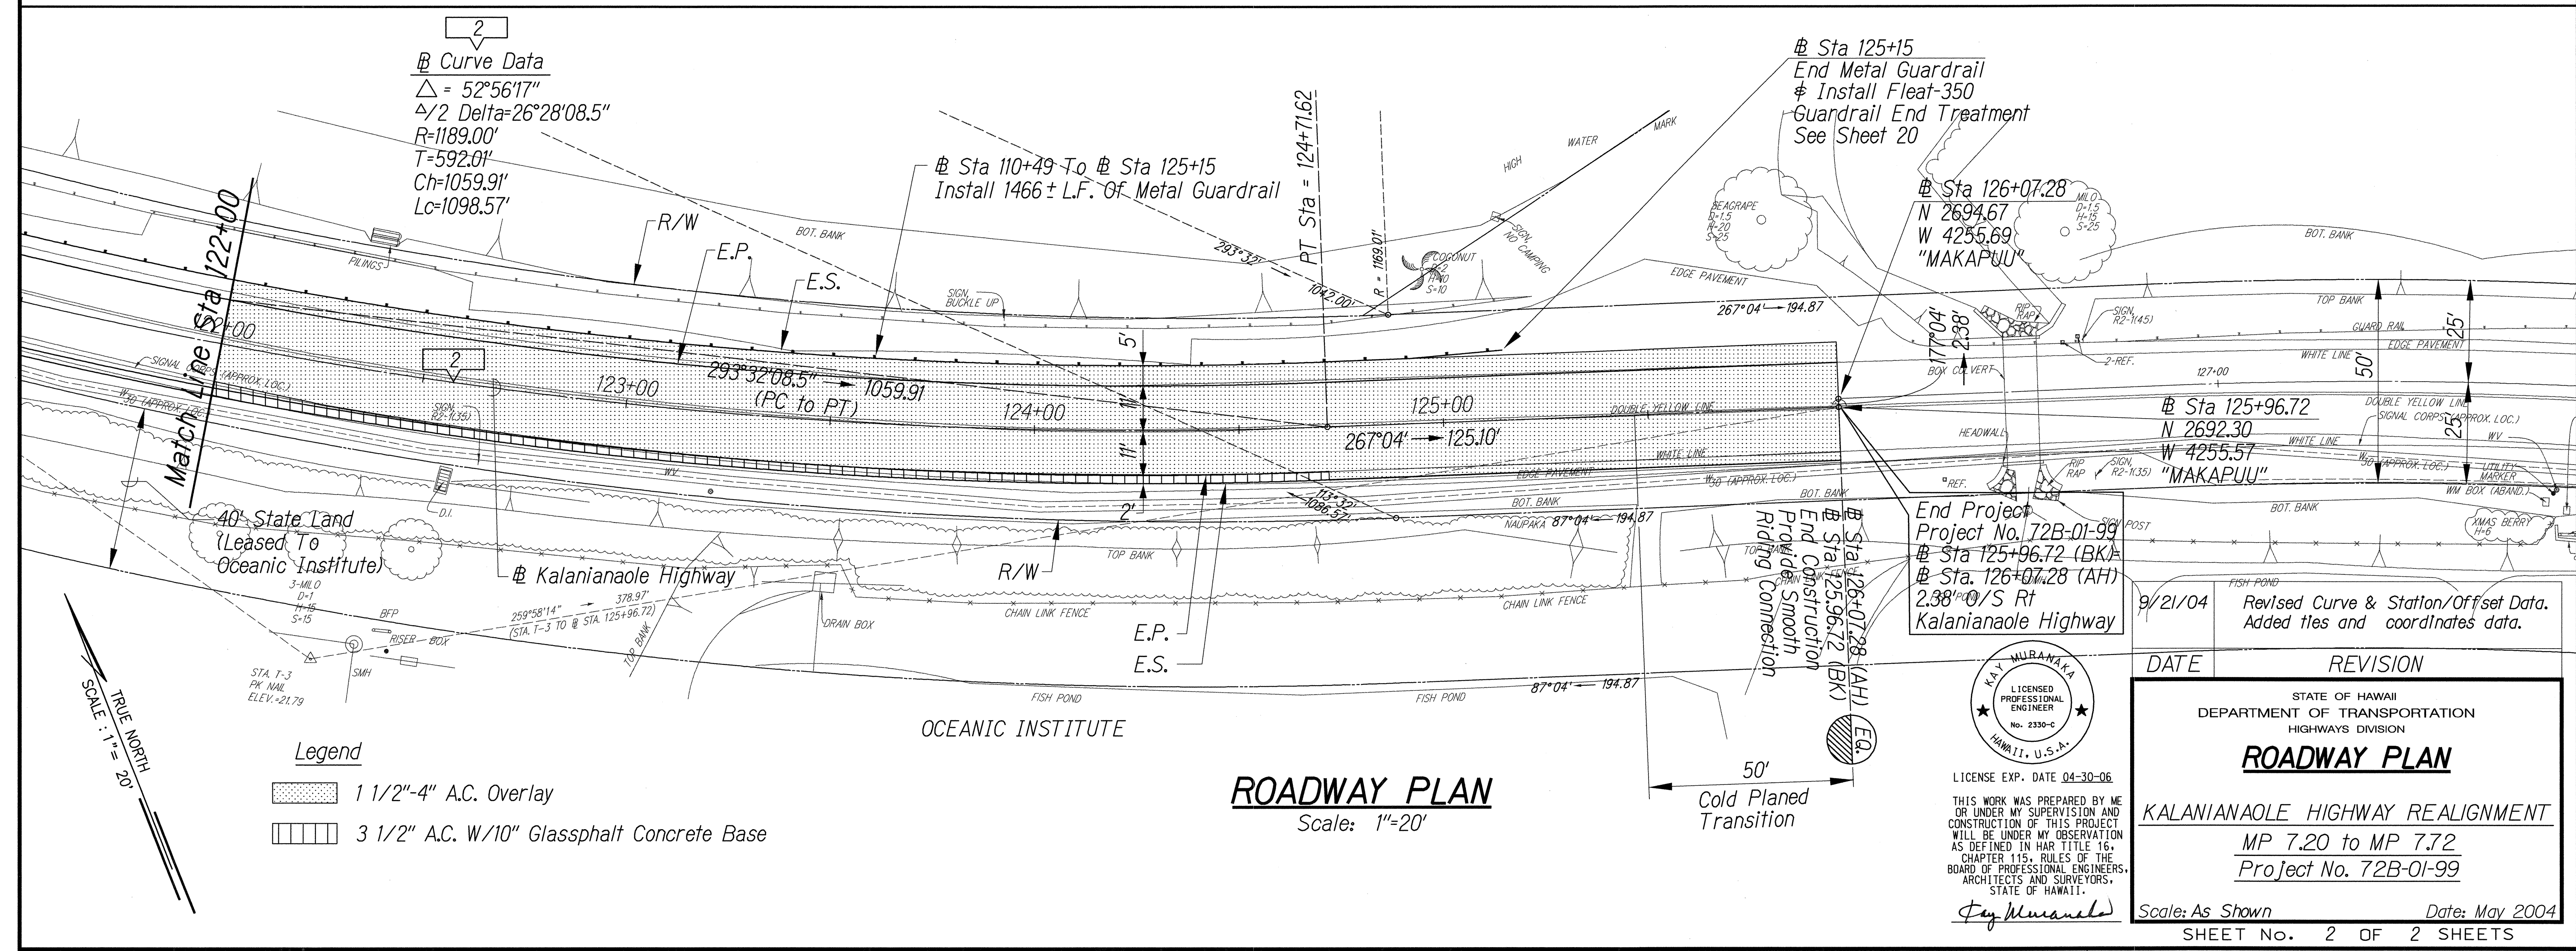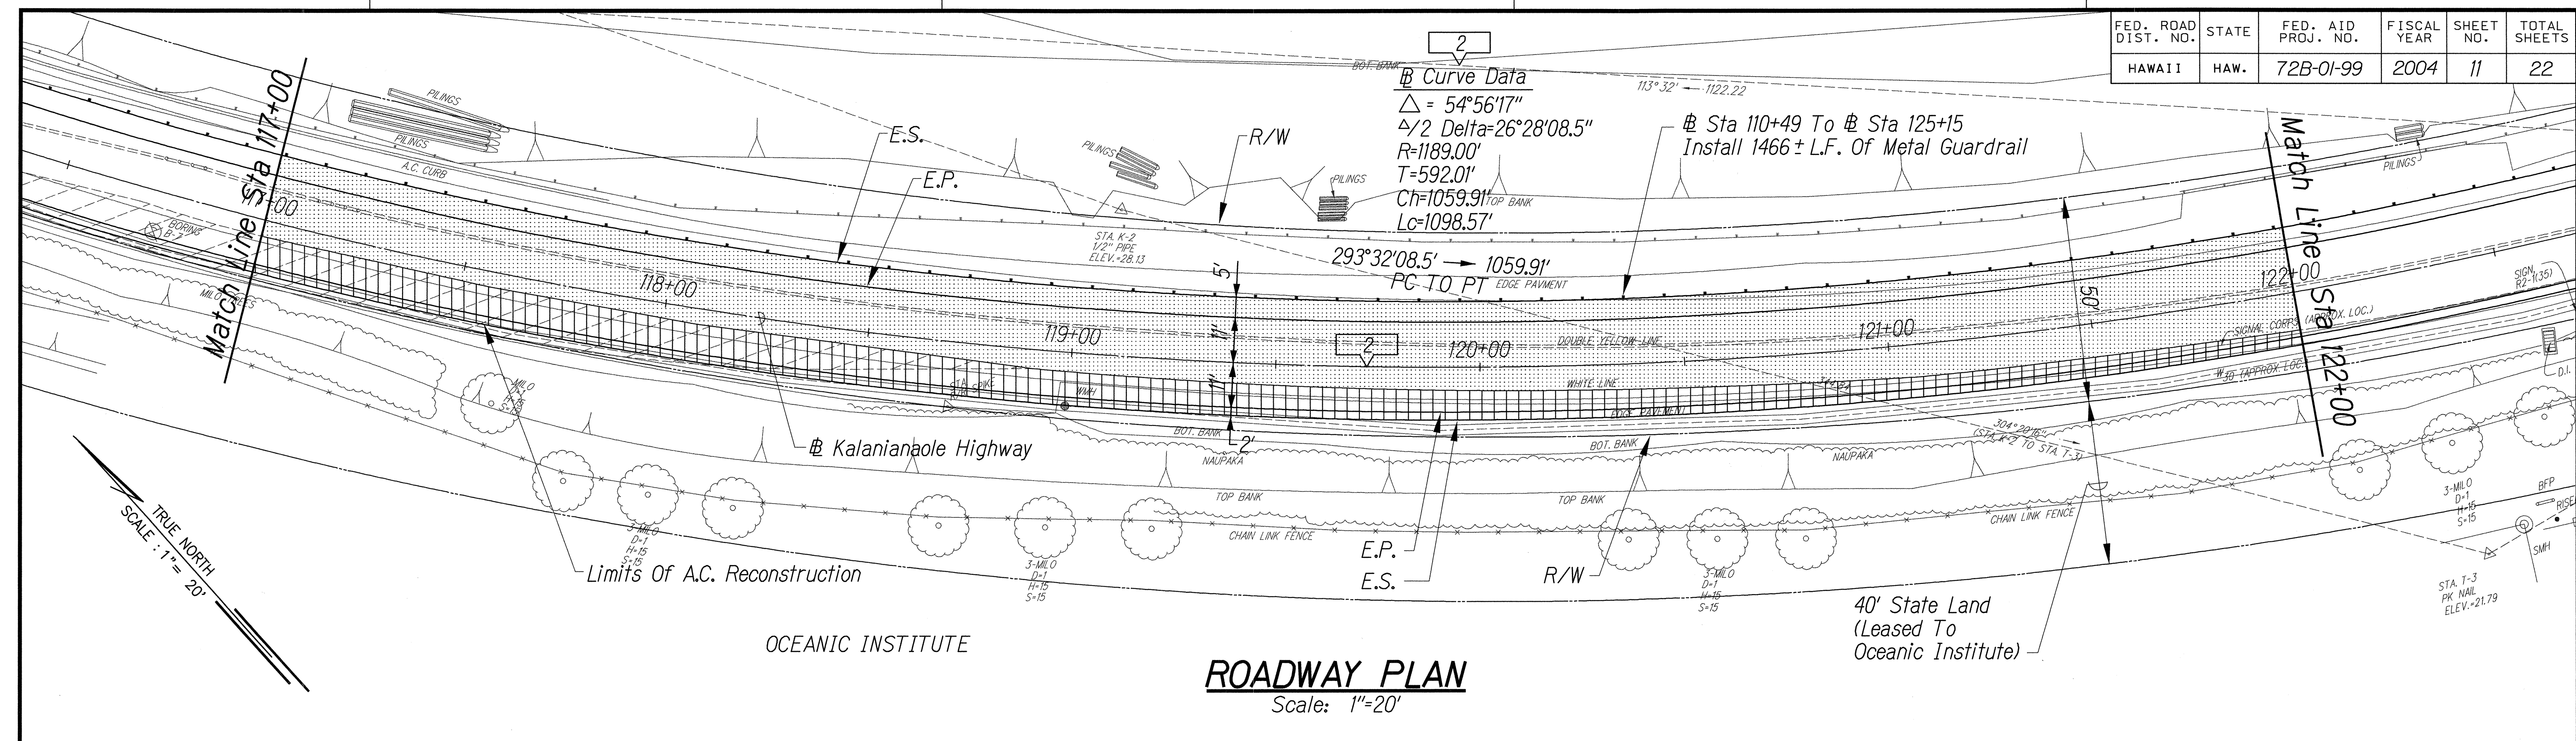

DATE	
SURVEY PLOTTED BY	
DESIGNED BY	
NOTED BY	
CHECKED BY	
.....	