
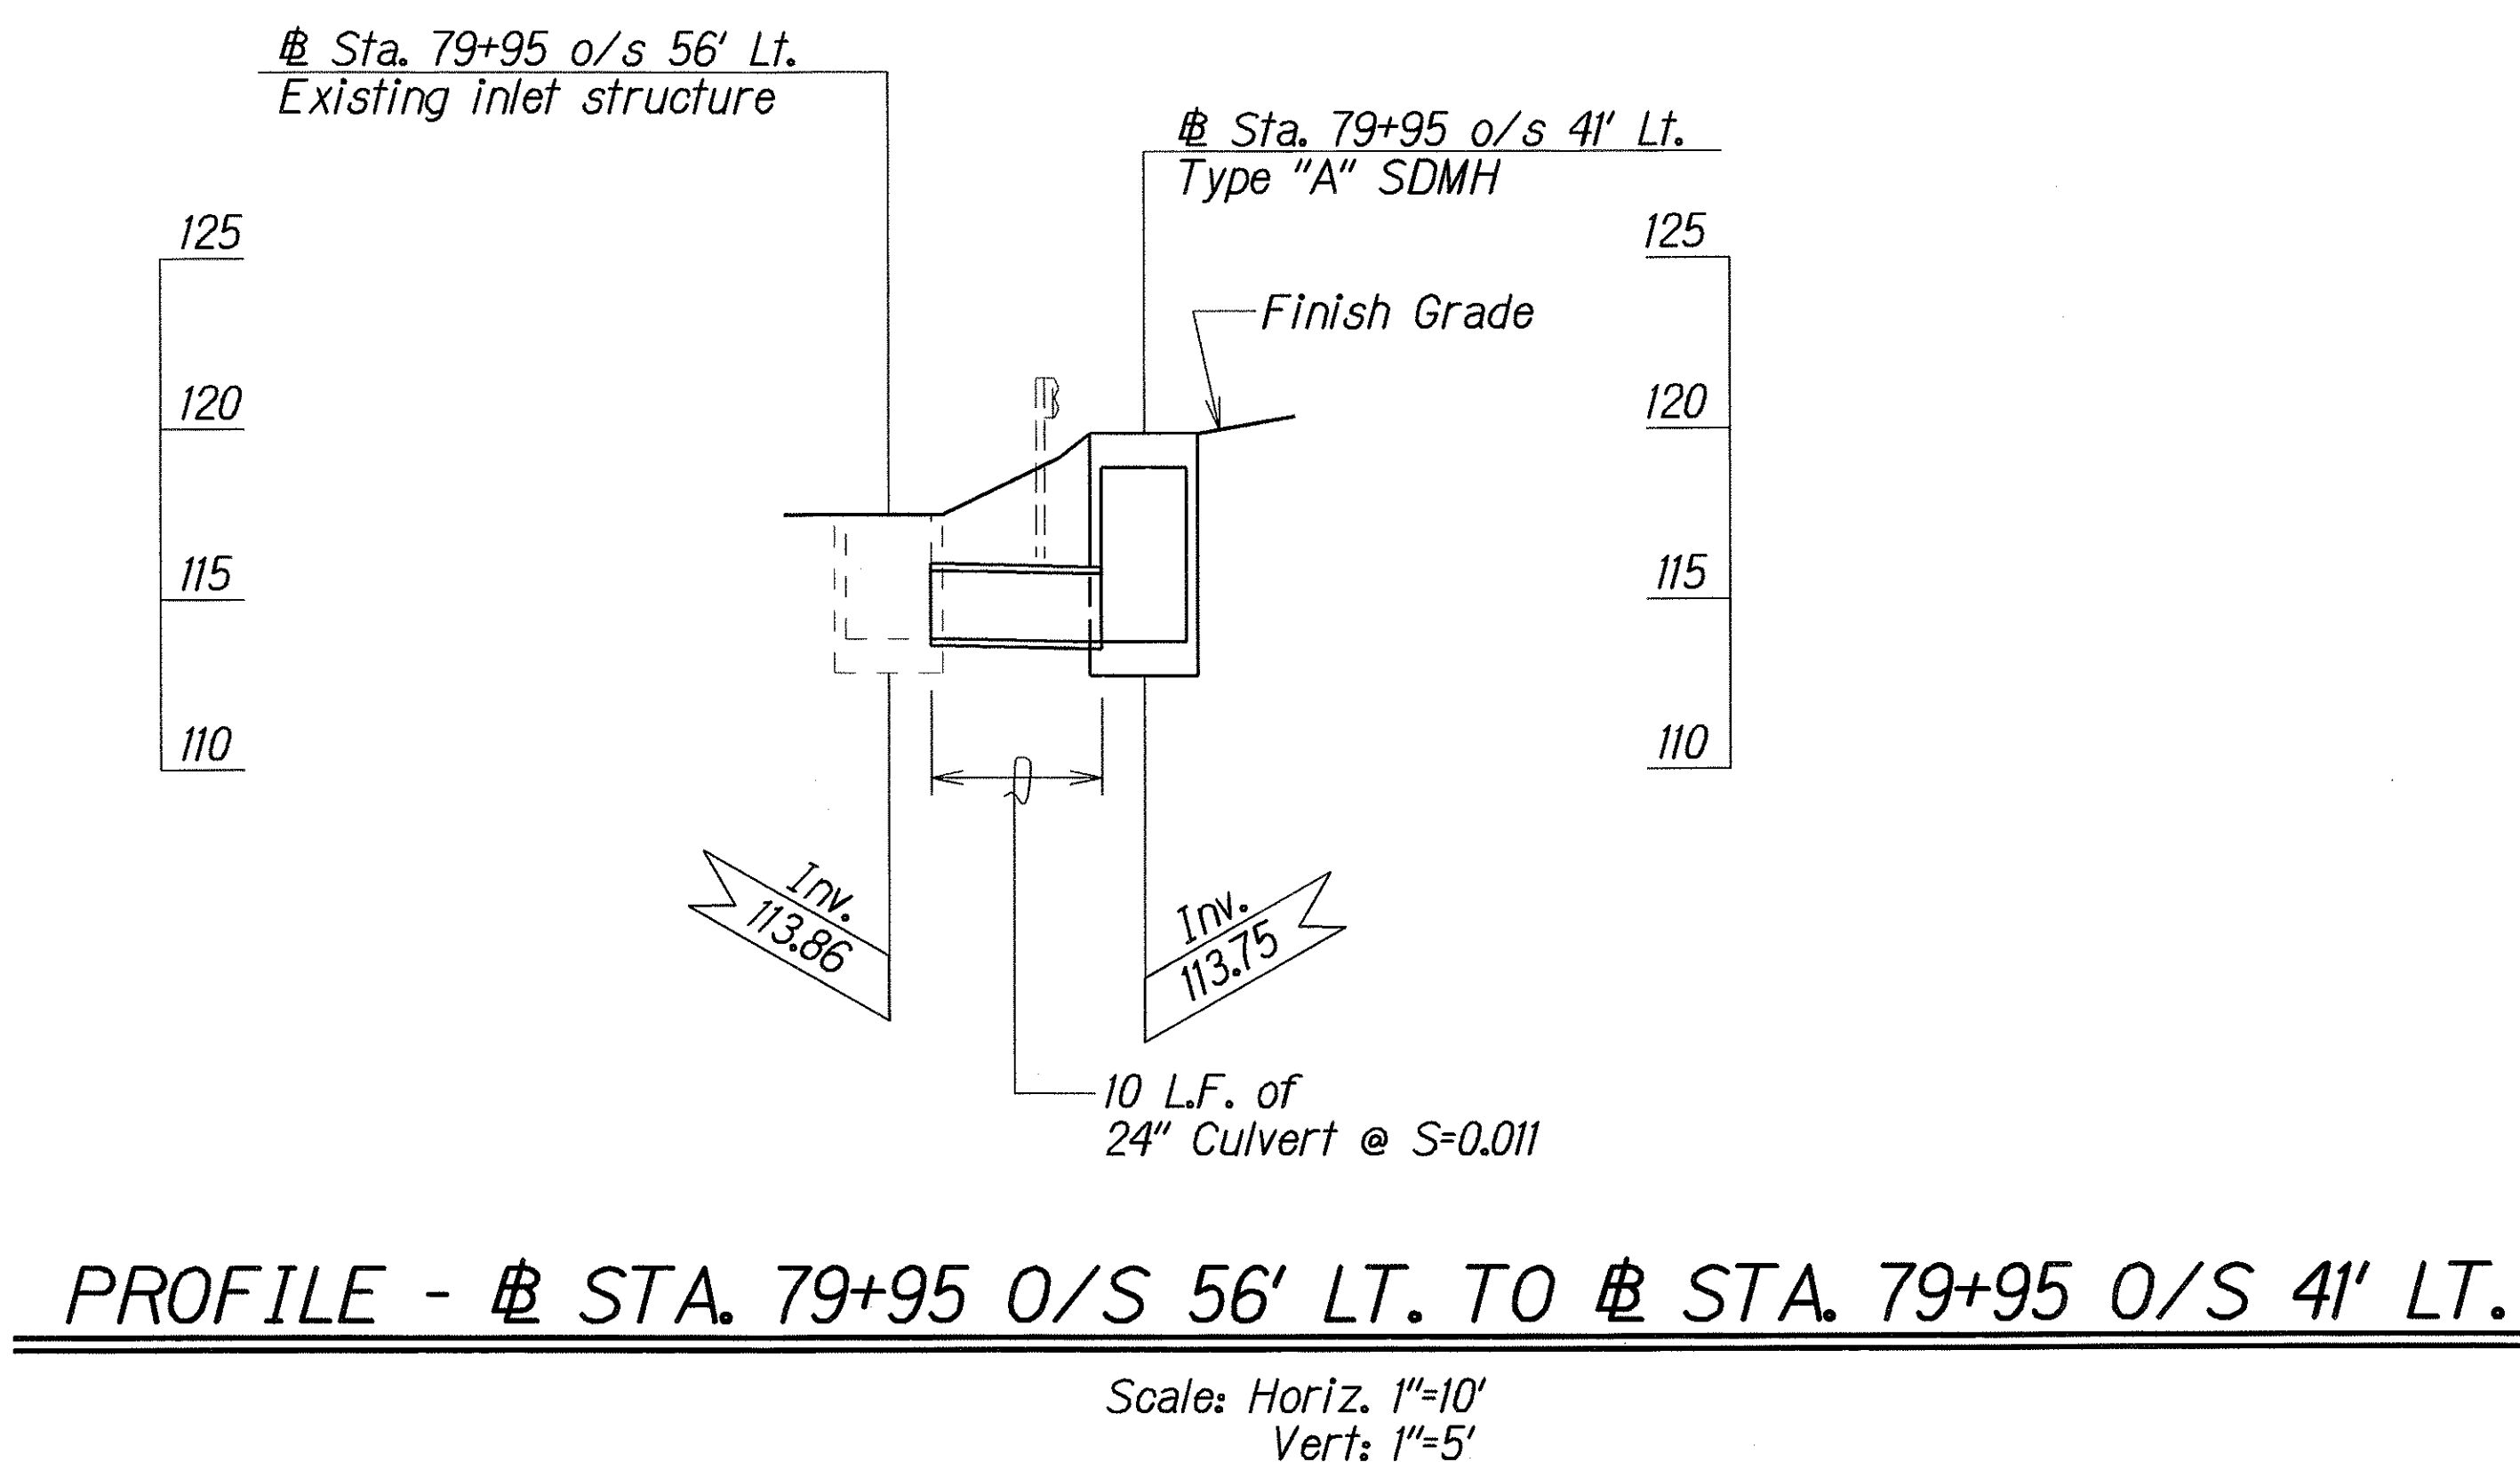


FED. ROAD DIST. NO.	STATE	FED. AID PROJ. NO.	FISCAL YEAR	SHEET NO.	TOTAL SHEETS
HAWAII	HAW.	DE-072-1(48)	2005	9	20

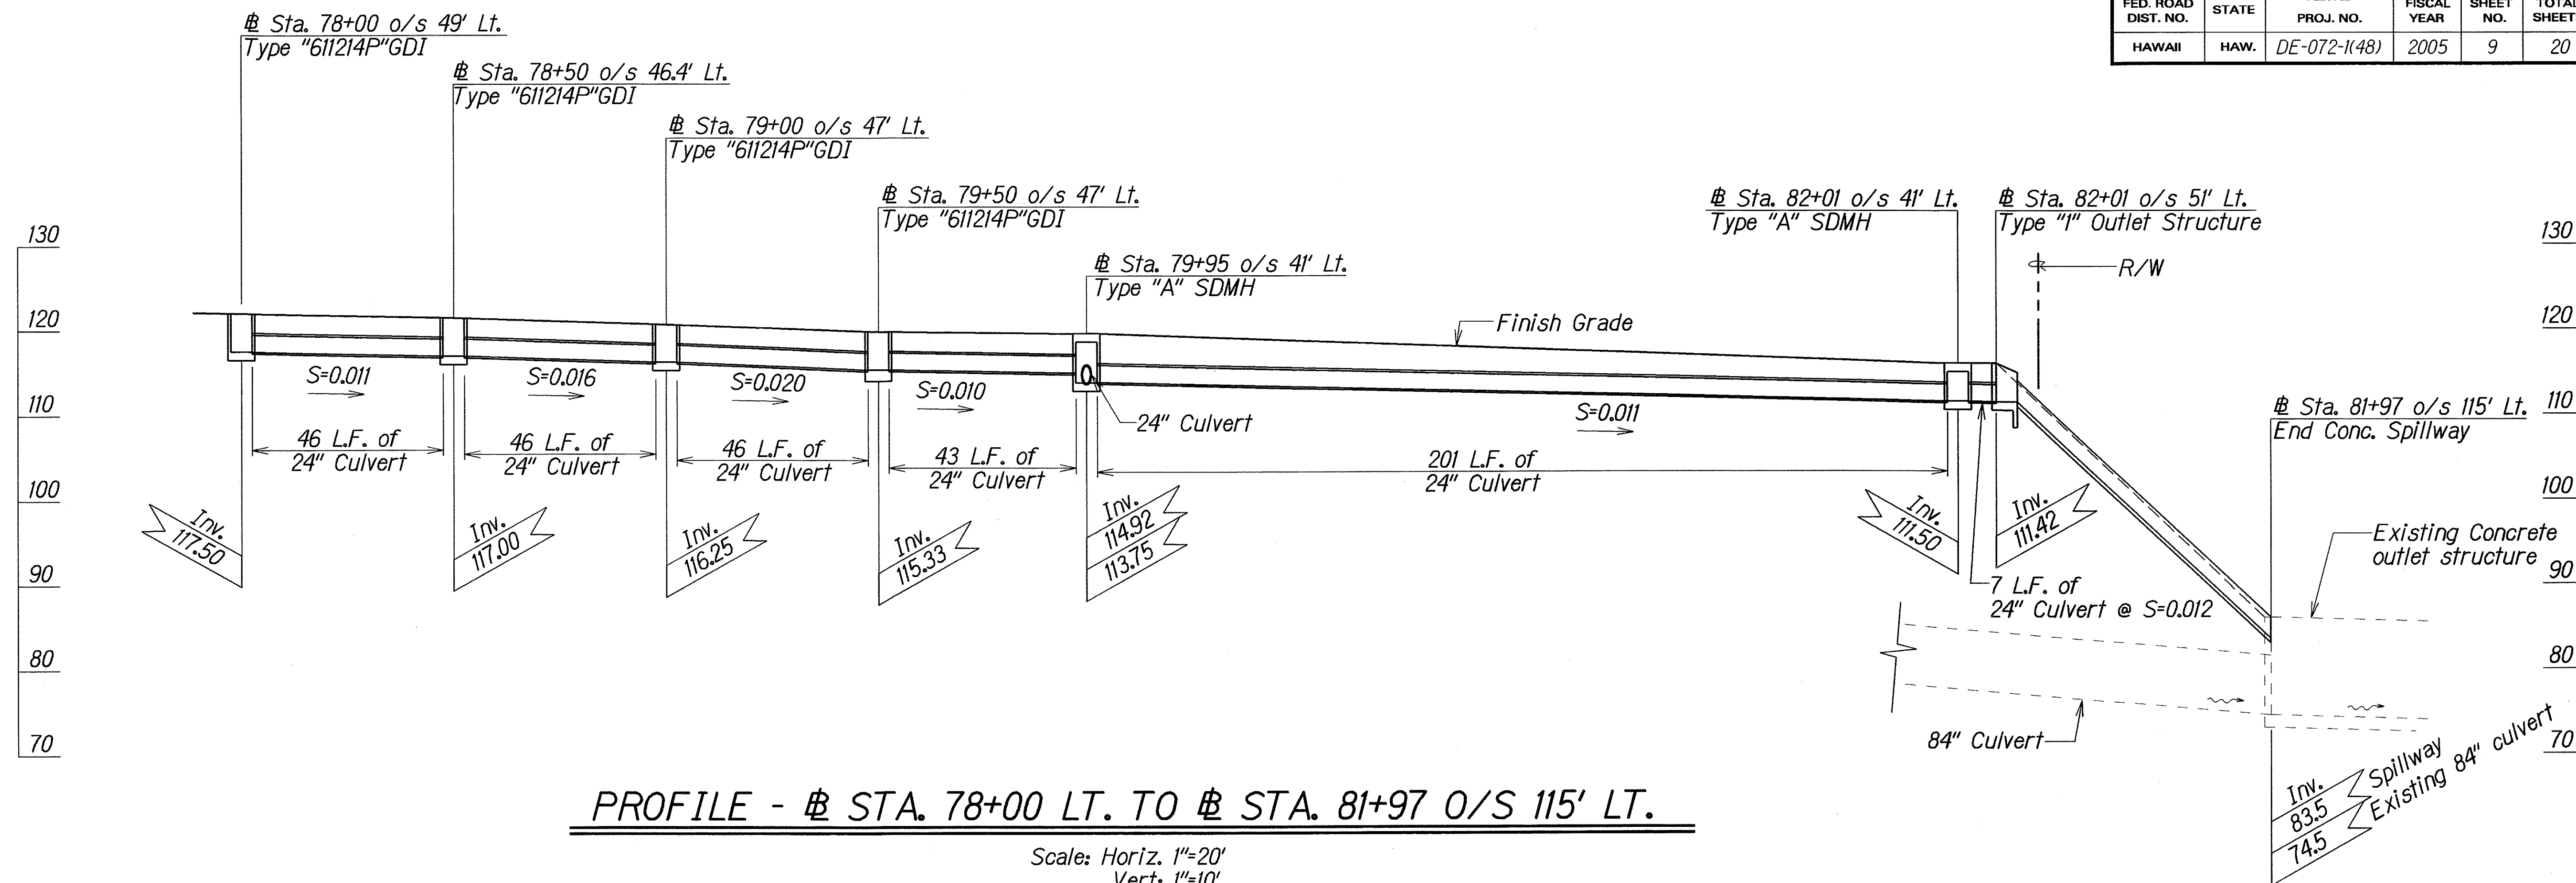

ORIGINAL PLAN	DATE	5-08-00
SURVEY PLOTTED BY		
DRAWN BY		
CHECKED BY		
NOTED BY		
DESIGNED BY		
QUANTITIES BY		
CHECKED BY		

STATE OF HAWAII
DEPARTMENT OF TRANSPORTATION
HIGHWAYS DIVISION

DRAINAGE PROFILE

KALANIANA'OLE HIGHWAY

DRAINAGE IMPROVEMENTS

Vicinity of Keolu Hills

Fed. Aid Project No. DE-072-1(48)

Scale: As shown Date: Sep, 2003

SHEET No. **H4** OF **10** SHEETS