


FED. ROAD DIST. NO.	STATE	FED. AID PROJ. NO.	FISCAL YEAR	SHEET NO.	TOTAL SHEETS
HAWAII	HAW.	NH-072-1(52)	2008	26	64

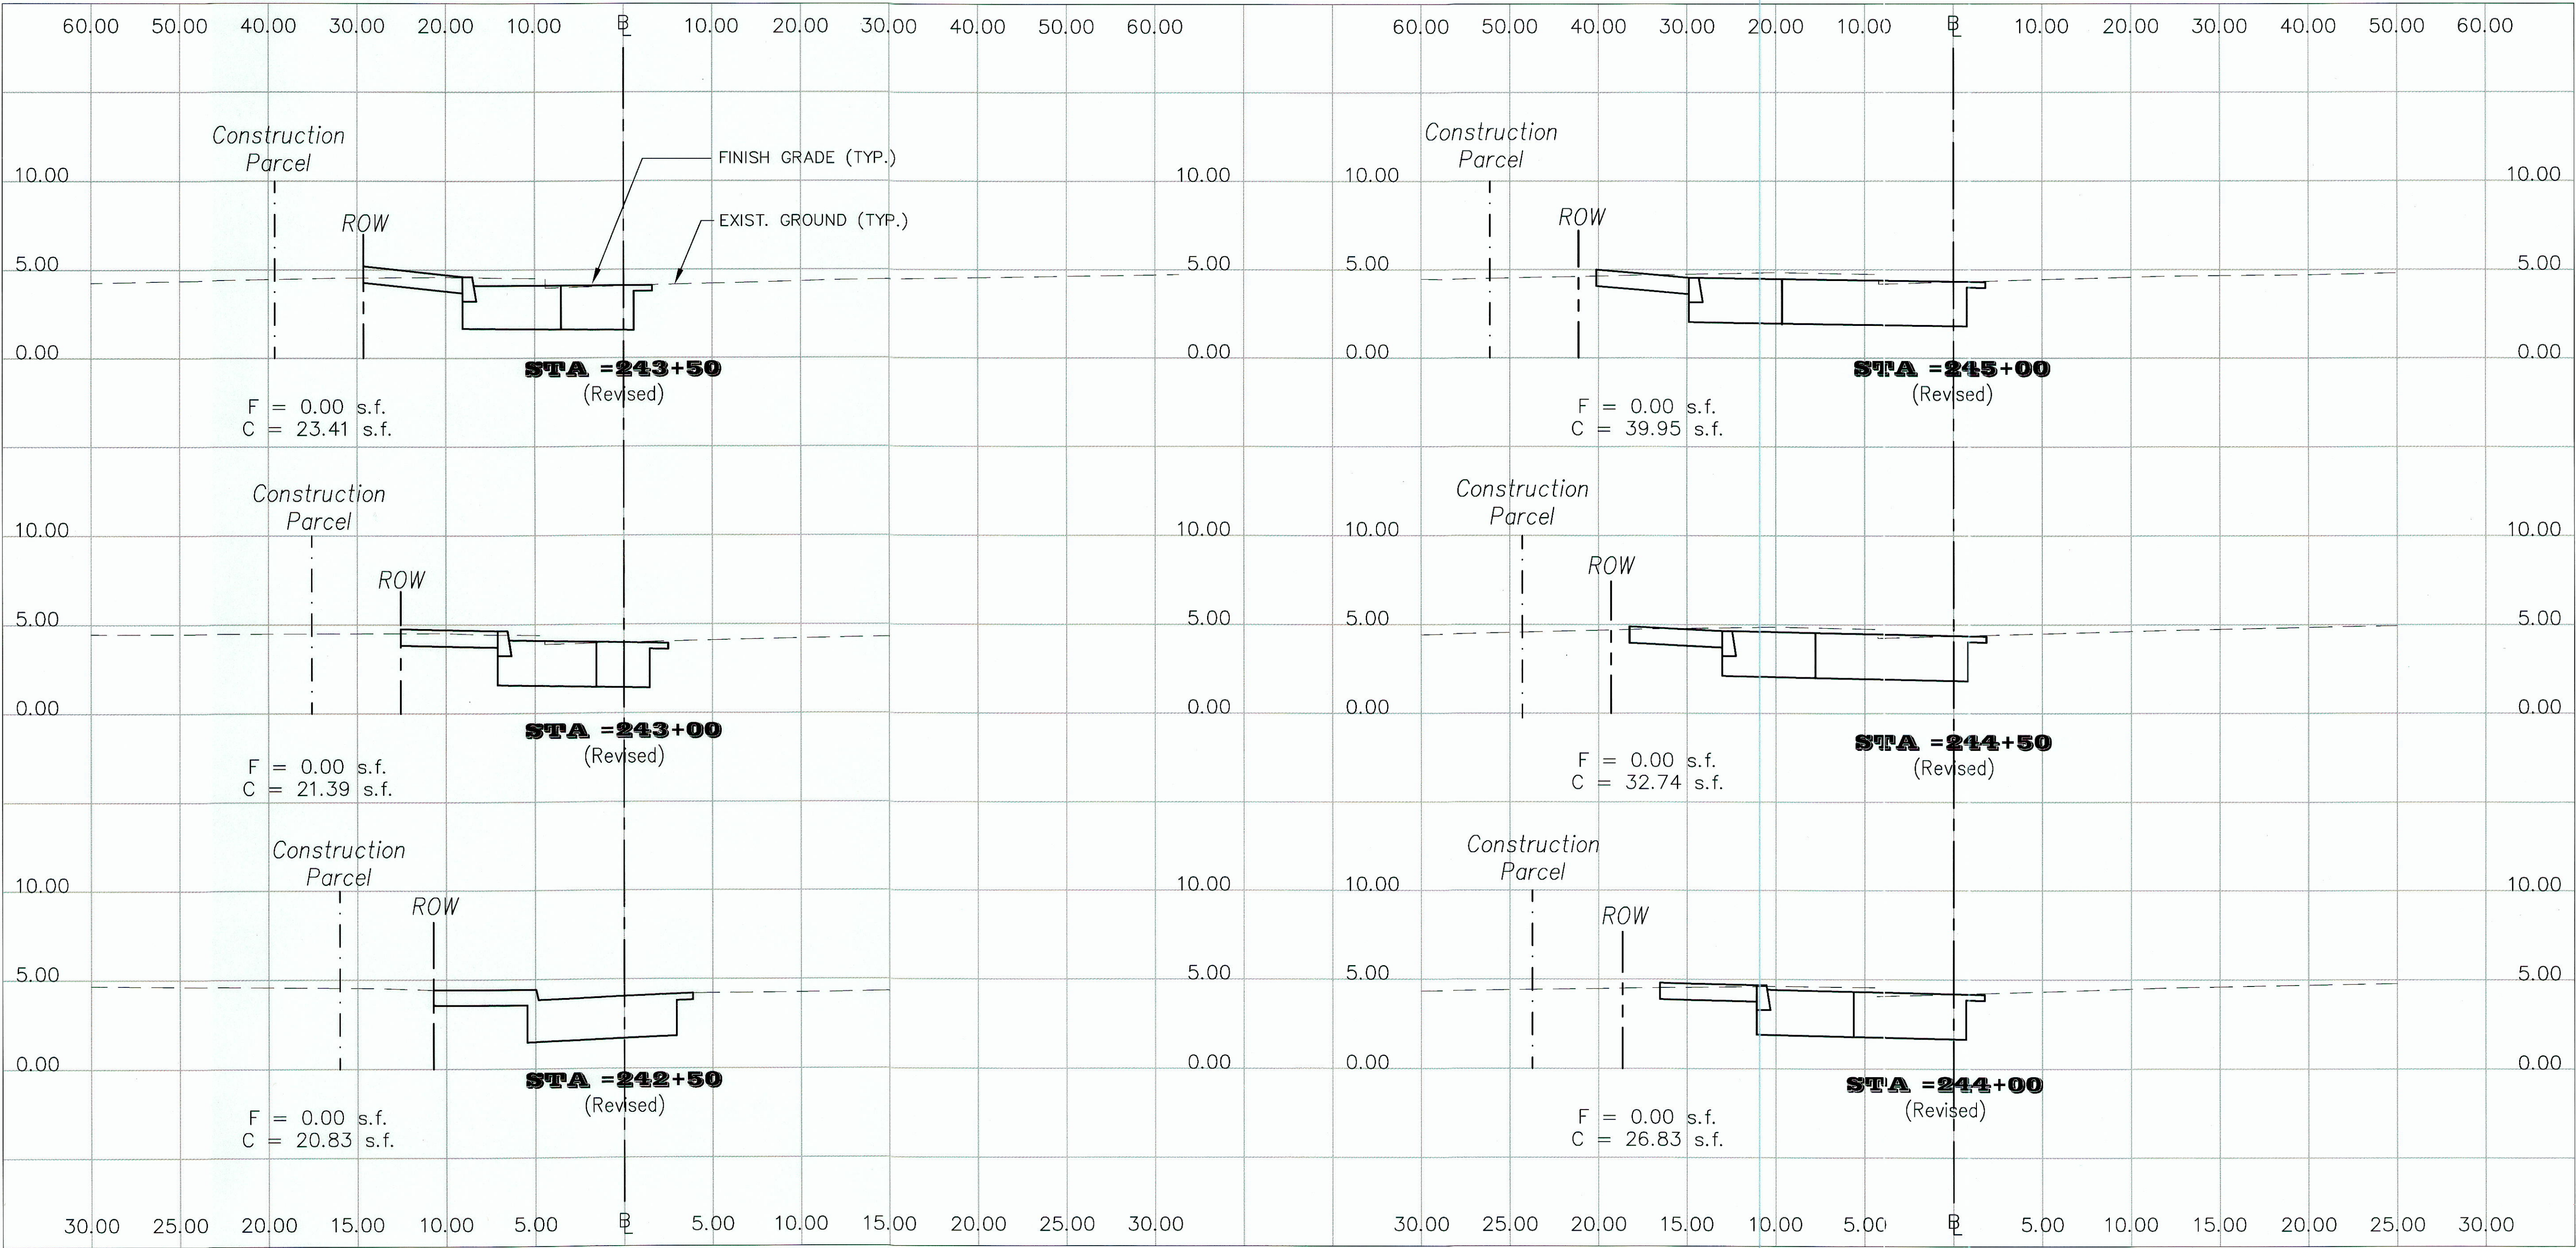

SURVEY PLOTTED BY	DATE
DRAWN BY	
TRACED BY	
QUANTITIES BY	
CHECKED BY	
ORIGINAL PLAN	
NOTE BOOK	
No.	

LEGEND FOR AS-BUILT POSTING

~~~~~ Squiggly line for as-built deletion

== Double line for as-built deletion

Roadway Text for as-built posting

KENNETH O. NAGAI  
LICENSED PROFESSIONAL ENGINEER  
No. 3265-C  
HAWAII, U.S.A.

SIGNATURE

APRIL 30, 2010  
EXPIRATION DATE OF LICENSE

THIS WORK WAS PREPARED BY ME OR UNDER MY SUPERVISION

STATE OF HAWAII  
DEPARTMENT OF TRANSPORTATION  
HIGHWAYS DIVISION

**KAL. HWY. CROSS SECTIONS**  
**STA. 242+50 TO 245+00**


**KALANIANA'OLE HIGHWAY IMPROVEMENTS**  
**VICINITY OF HAWAII KAI DRIVE**  
**TO KEAHOLE STREET**

**FEDERAL-AID PROJECT NO. NH-072-1(52)**  
**SCALE: No Scale** **DATE: November 2008**

SHEET No. C-21 OF 22 SHEETS



| FED. ROAD DIST. NO. | STATE | FED. AID PROJ. NO. | FISCAL YEAR | SHEET NO. | TOTAL SHEETS |
|---------------------|-------|--------------------|-------------|-----------|--------------|
| HAWAII              | HAW.  | NH-072-1(52)       | 2008        | 27        | 64           |

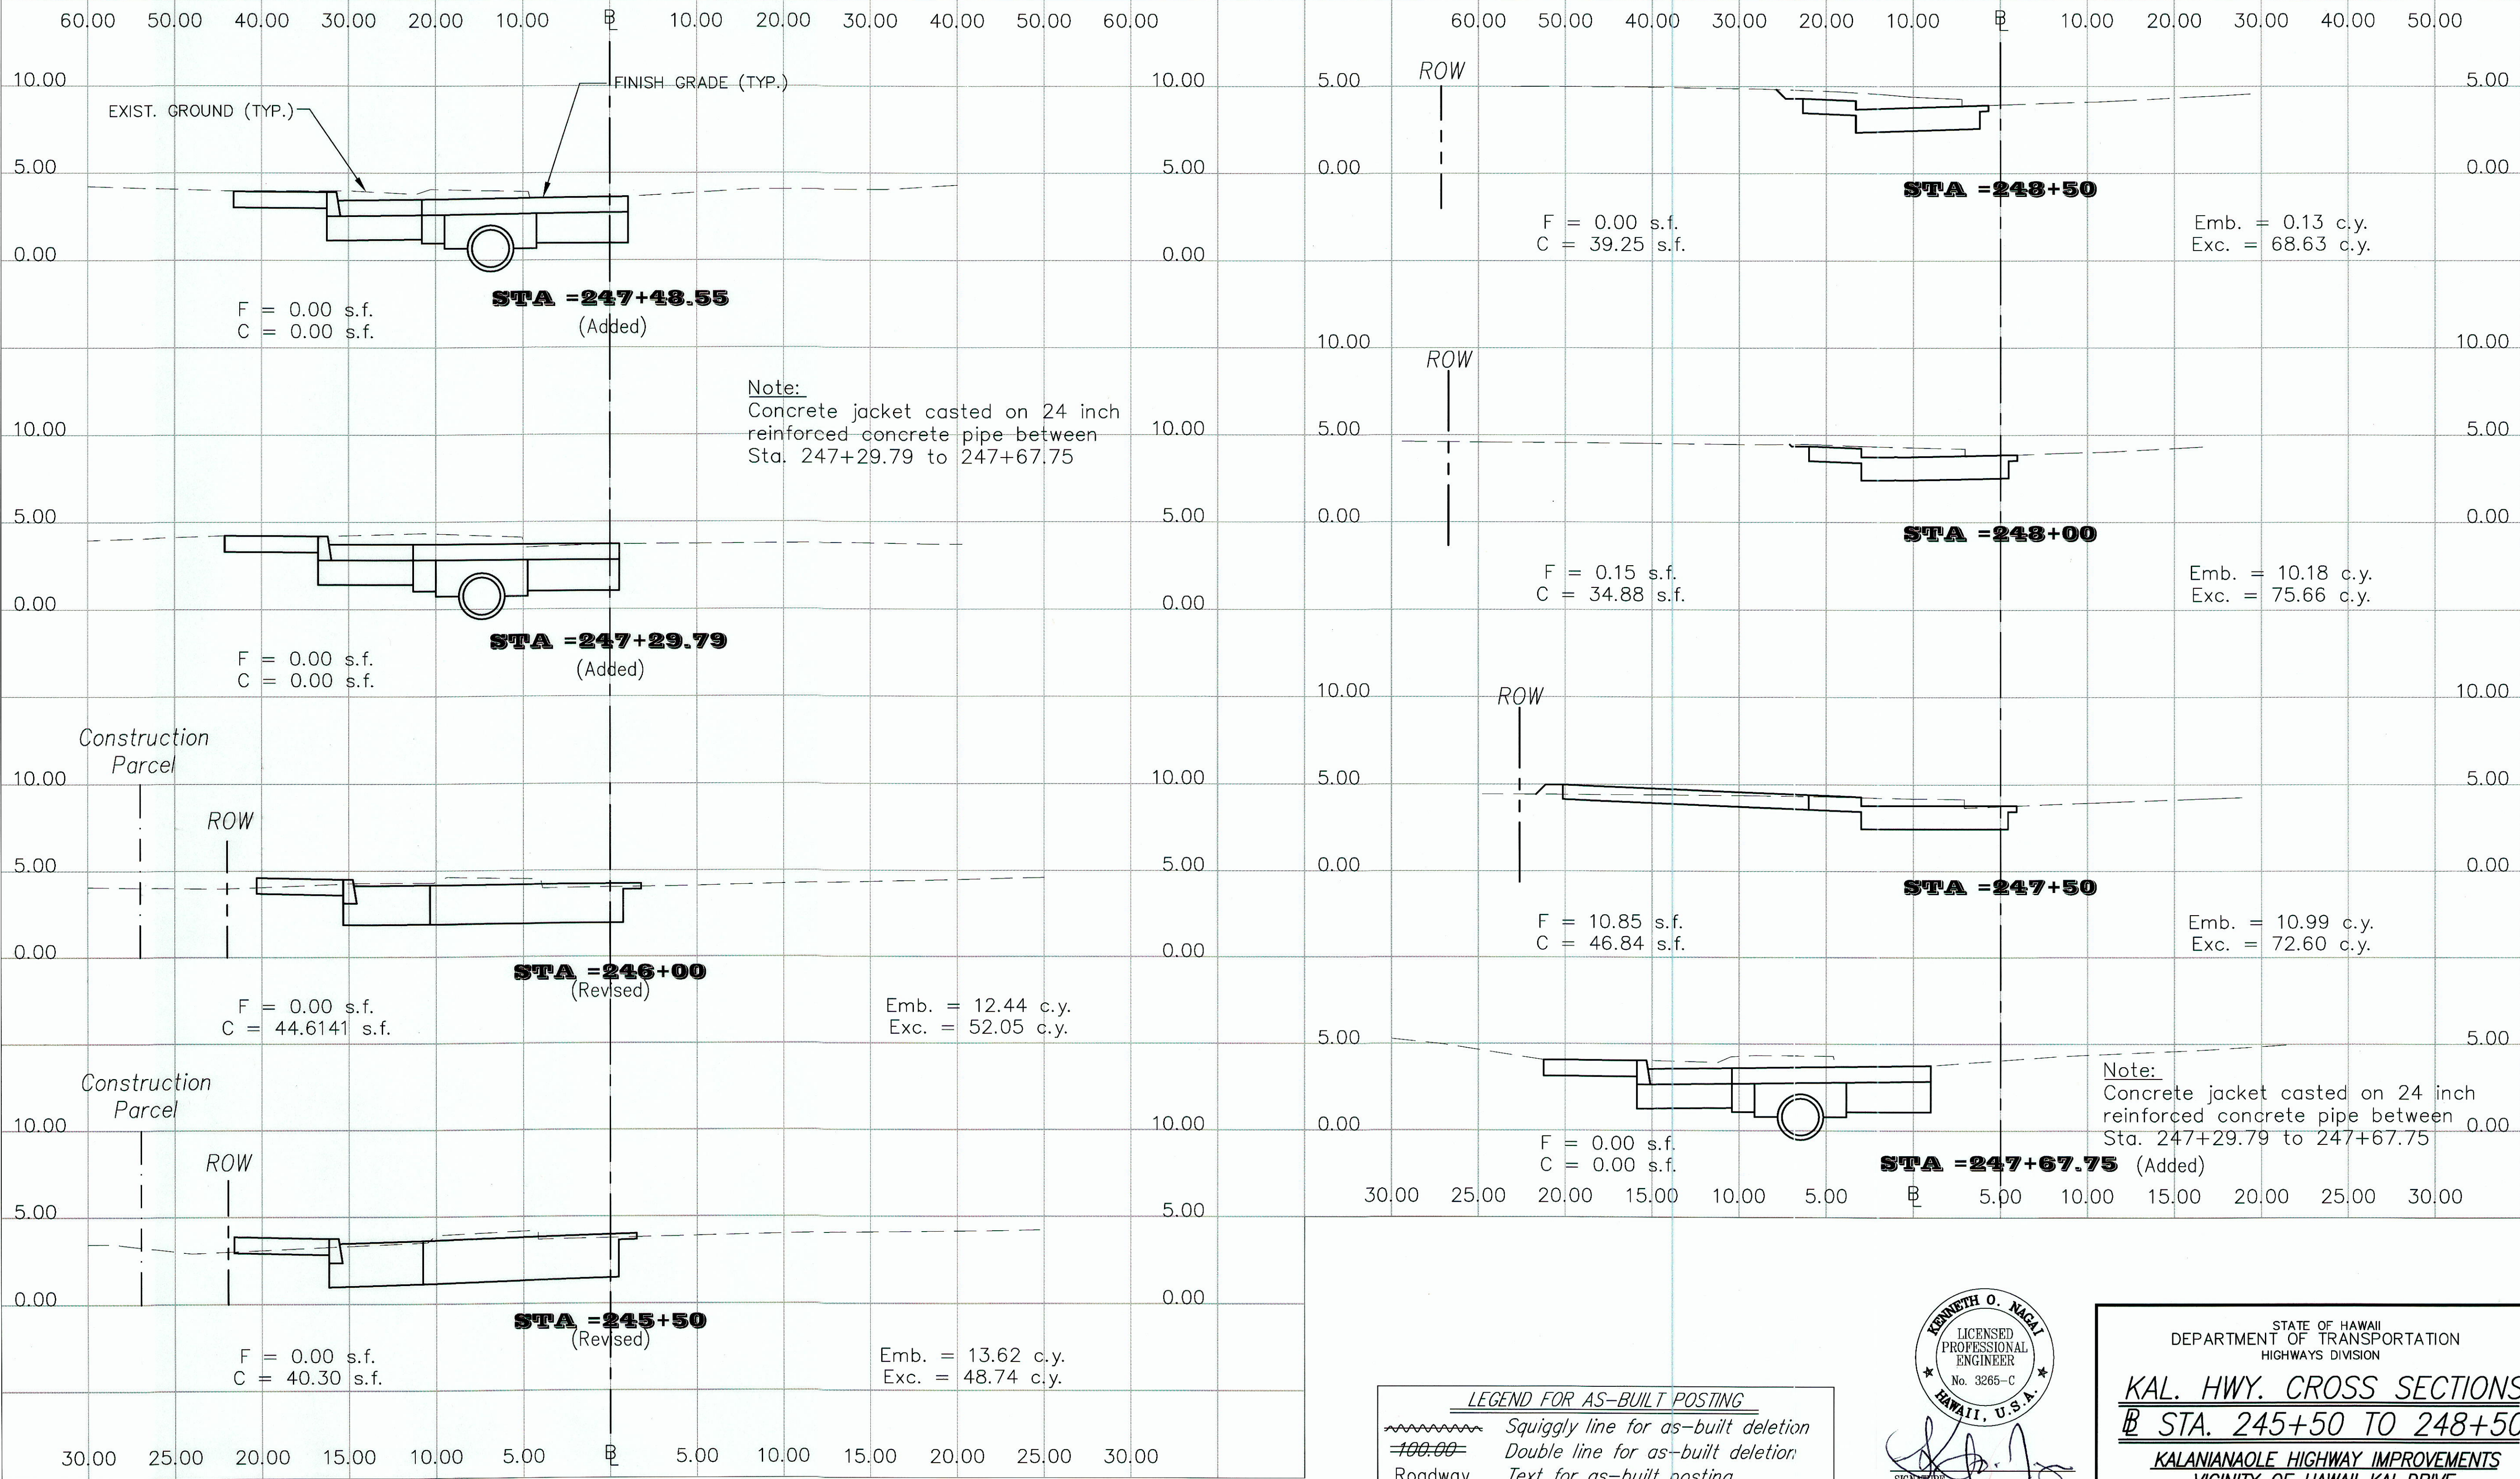

|               |      |
|---------------|------|
| ORIGINAL PLAN | DATE |
| DESIGNED BY   | DATE |
| TRACED BY     | DATE |
| DESIGNED BY   | DATE |
| QUANTITIES BY | DATE |
| CHECKED BY    | DATE |

**LEGEND FOR AS-BUILT POSTING**  
Squiggly line for as-built deletion  
Double line for as-built deletion  
Roadway Text for as-built posting

**KENNETH O. MAGAL**  
LICENSED PROFESSIONAL ENGINEER  
No. 3265-C  
HAWAII, U.S.A.  
APRIL 30, 2010  
EXPIRATION DATE OF LICENSE  
THIS WORK WAS PREPARED BY ME OR UNDER MY SUPERVISION

STATE OF HAWAII  
DEPARTMENT OF TRANSPORTATION  
HIGHWAYS DIVISION  
**KAL. HWY. CROSS SECTIONS**  
**@ STA. 245+50 TO 248+50**  
**KALANIANA'OLE HIGHWAY IMPROVEMENTS**  
**VICINITY OF HAWAII KAL DRIVE**  
**TO KEAHOE STREET**  
**FEDERAL-AID PROJECT NO. NH-072-1(52)**  
**SCALE: (H) 1"=10'; (V) 1"=5' DATE: November 2008**  
**SHEET No. C-22 OF 22 SHEETS**

**"AS-BUILT"**