


FED. ROAD DIST. NO.	STATE	FED. AID PROJ. NO.	FISCAL YEAR	SHEET NO.	TOTAL SHEETS
HAWAII	HAW.	NH-072-1(52)	2008	11	64

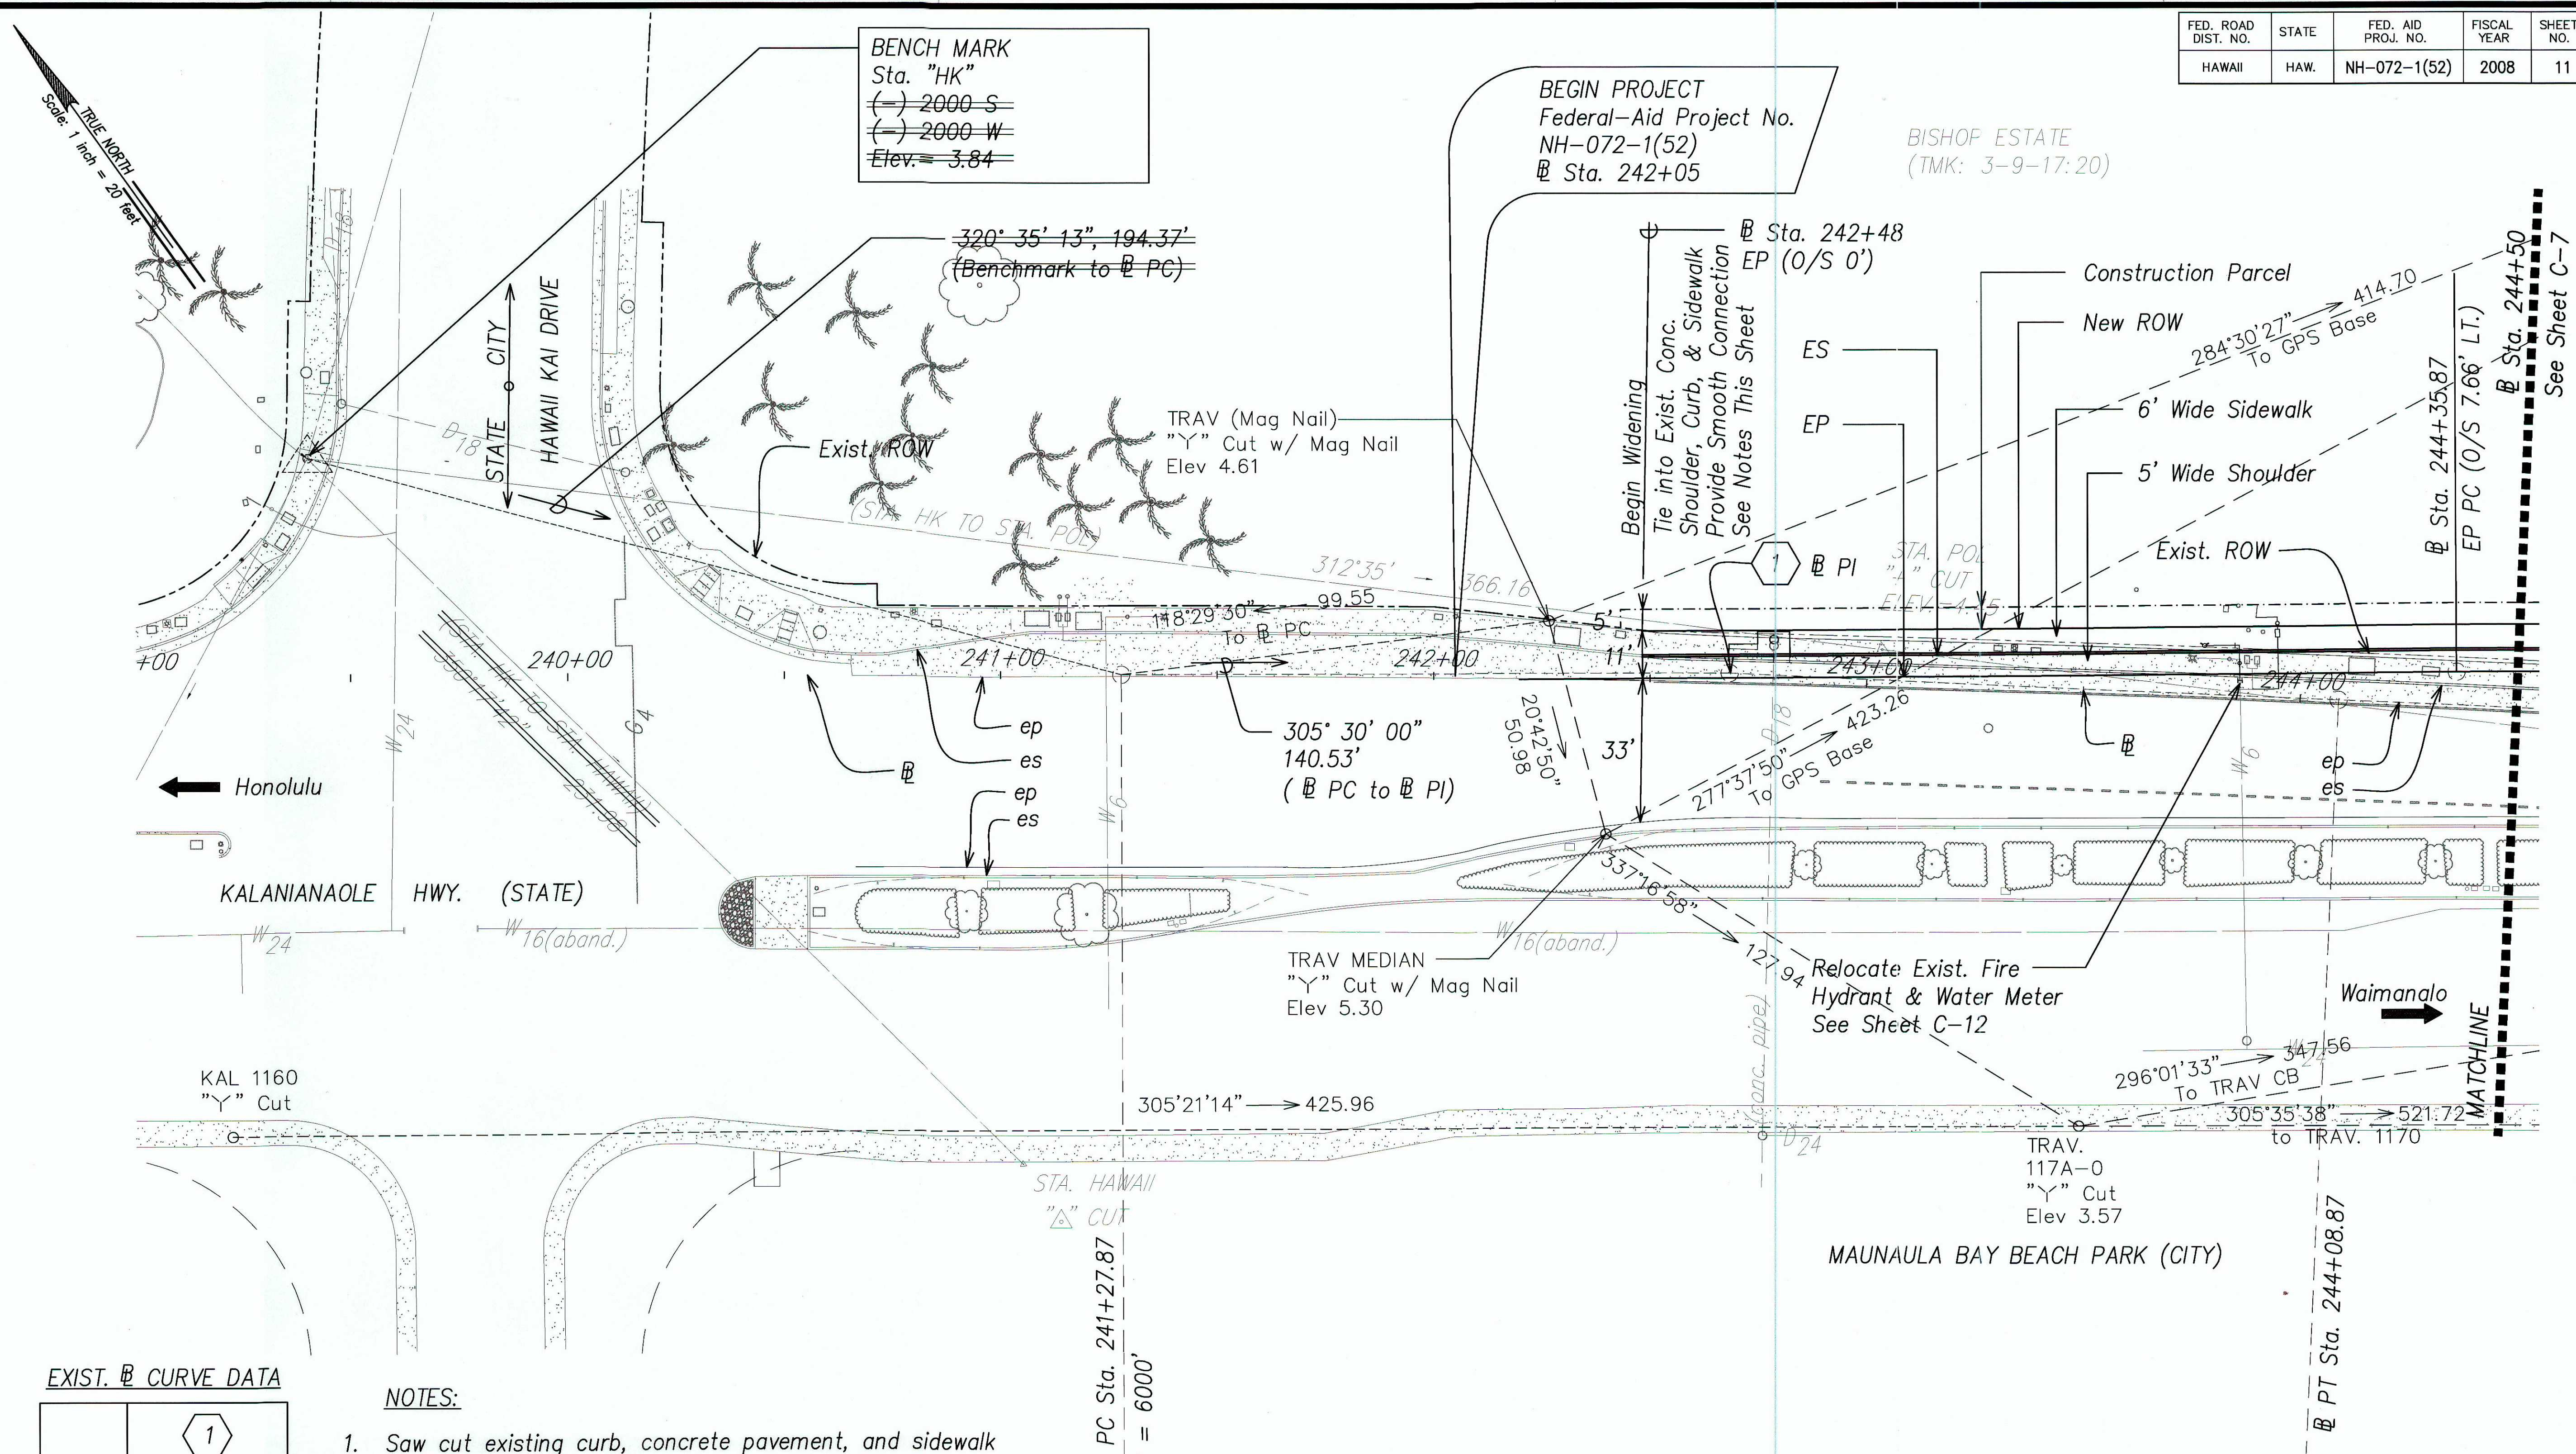

EXIST. @ CURVE DATA

	1
△	2° 41' 00"
△/2	1° 20' 30"
R	6000'
T	140.53'
C	280.97'
L	281.00'

NOTES:

1. Saw cut existing curb, concrete pavement, and sidewalk at the limits of removal. If limit is less than 4 feet from an existing expansion joint, remove existing curb, concrete pavement, or sidewalk to expansion joint.
2. See Sheet C-11 for construction joint details when connecting new to existing.
3. Drilling, furnishing and installing dowels will not be paid for separately and will be considered incidental to the cost of the curb or concrete pavement.

APPROVED:

CHIEF, CAPITAL PROJECTS DIVISION, BWS

DATE

LEGEND FOR AS-BUILT POSTING	
	Squiggly line for as-built deletion
	Double line for as-built deletion
	Text for as-built posting


KENNETH O. NAGI
LICENSED PROFESSIONAL ENGINEER
No. 3265-C
HAWAII, U.S.A.
SIGNATURE
APRIL 30, 2010
EXPIRATION DATE OF LICENSE
THIS WORK WAS PREPARED BY ME OR UNDER MY SUPERVISION

STATE OF HAWAII
DEPARTMENT OF TRANSPORTATION
HIGHWAYS DIVISION
ROADWAY PLAN - 1
KALANIANA'OLE HIGHWAY
KALANIANA'OLE HIGHWAY IMPROVEMENTS
VICINITY OF HAWAII KAI DRIVE
TO KEAHOE STREET
FEDERAL-AID PROJECT NO. NH-072-1(52)
SCALE: 1" = 20'
DATE: November 2008

SHEET No. C-6 OF 22 SHEETS
"AS-BUILT"

SURVEY PLOTTED BY	DATE
DRAWN BY	
TRACED BY	
CHECKED BY	
NOTED BY	
NO.	

FED. ROAD DIST. NO.	STATE	FED. AID PROJ. NO.	FISCAL YEAR	SHEET NO.	TOTAL SHEETS
HAWAII	HAW.	NH-072-1(52)	2008	12	64

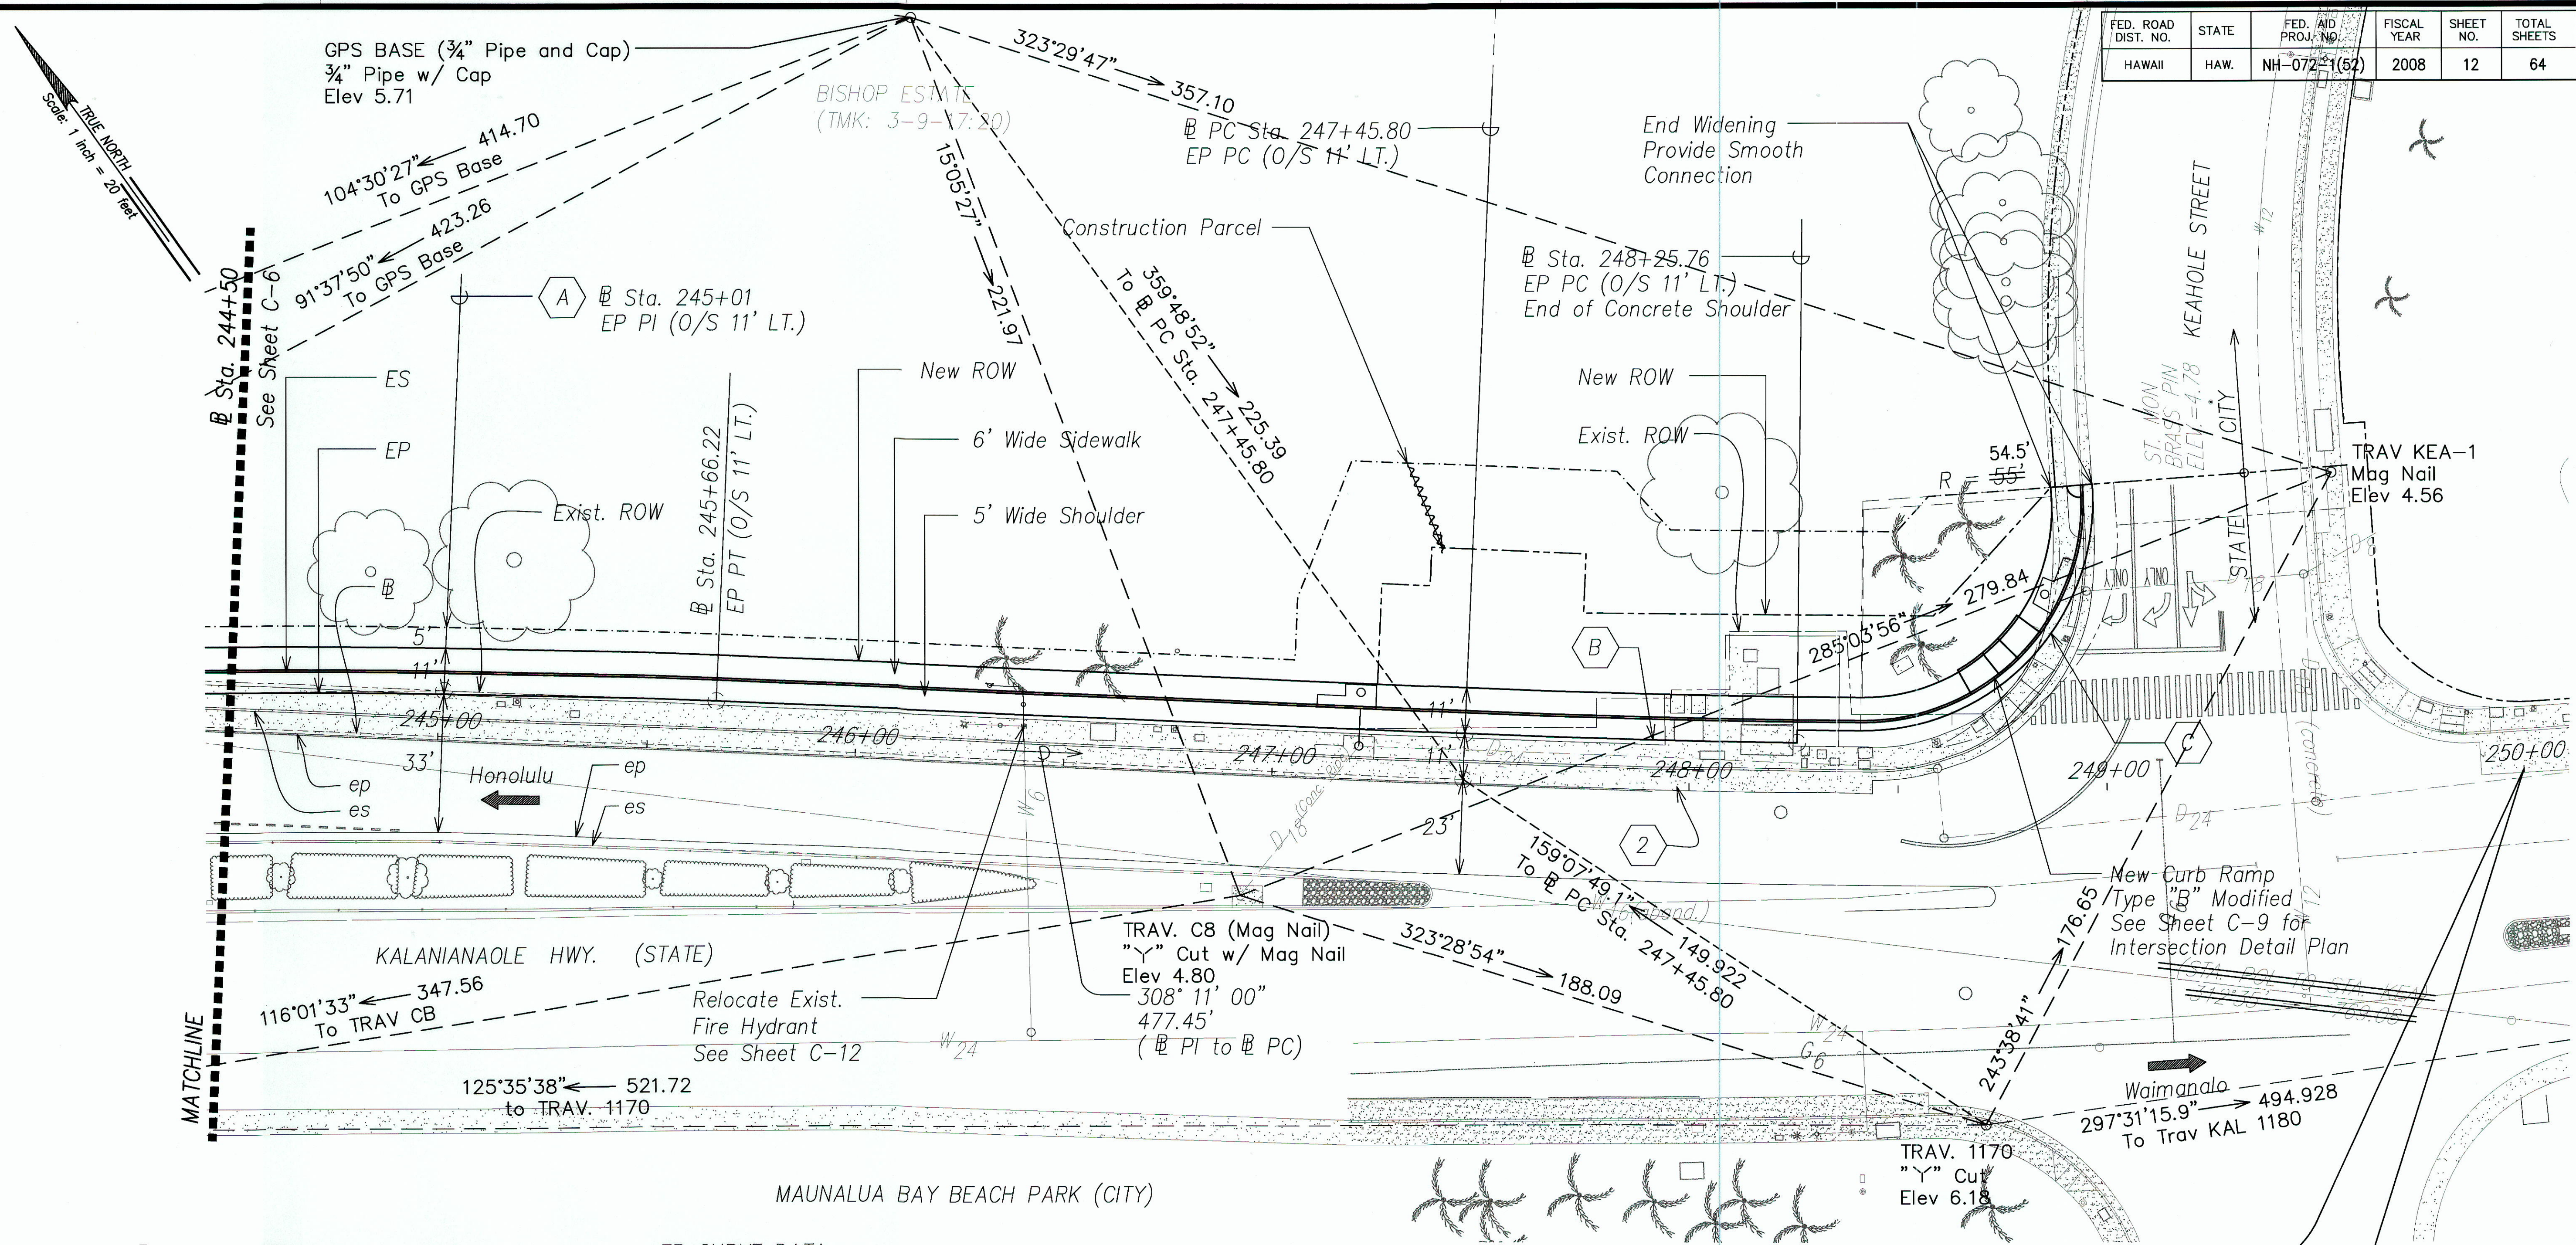

2 CURVE DATA

	2
△	13° 32' 00"
△/2	6° 46' 00"
R	2400'
T	284.77'
C	565.57'
L	566.88'

EP CURVE DATA

	A	B	C	
△	2° 59' 18.8"	1° 54' 32.5"	94° 45' 40.2"	94° 45' 40"
△/2	1° 29' 39.4"	0° 57' 16.3"	47° 22' 50.1"	47° 22' 50"
R	2500'	2389'	55'	54.55
T	65.21'	39.80'	59.77'	59.23
C	130.39'	79.60'	80.95'	80.21
L	130.40'	79.60'	90.96'	90.14

APPROVED:

CHIEF, CAPITAL PROJECTS DIVISION, BWS

DATE

LEGEND FOR AS-BUILT POSTING
 Squiggly line for as-built deletion
 Double line for as-built deletion
 Roadway Text for as-built posting

KENNETH O. NAGAI
 LICENSED PROFESSIONAL ENGINEER
 No. 3265-C
 HAWAII, U.S.A.
 SIGNATURE
 APRIL 30, 2010
 EXPIRATION DATE OF LICENSE
 THIS WORK WAS PREPARED BY ME OR UNDER MY SUPERVISION

END PROJECT
 Federal-Aid Project No.
 NH-072-1(52)
 Sta. 250+00

STATE OF HAWAII
 DEPARTMENT OF TRANSPORTATION
 HIGHWAYS DIVISION
ROADWAY PLAN - 2
KALANIANAʻOLE HIGHWAY
 KALANIANAʻOLE HIGHWAY IMPROVEMENTS
 VICINITY OF HAWAII KAI DRIVE
 TO KEAHOLE STREET
 FEDERAL-AID PROJECT NO. NH-072-1(52)
 SCALE: 1" = 20' DATE: November 2008

SHEET No. C-7 OF 22 SHEETS

"AS-BUILT"

12