




FED. ROAD DIST. NO.	STATE	FED. AID PROJ. NO.	FISCAL YEAR	SHEET NO.	TOTAL SHEETS
HAWAII	HAW.	NH-072-1(52)	2008	10	64

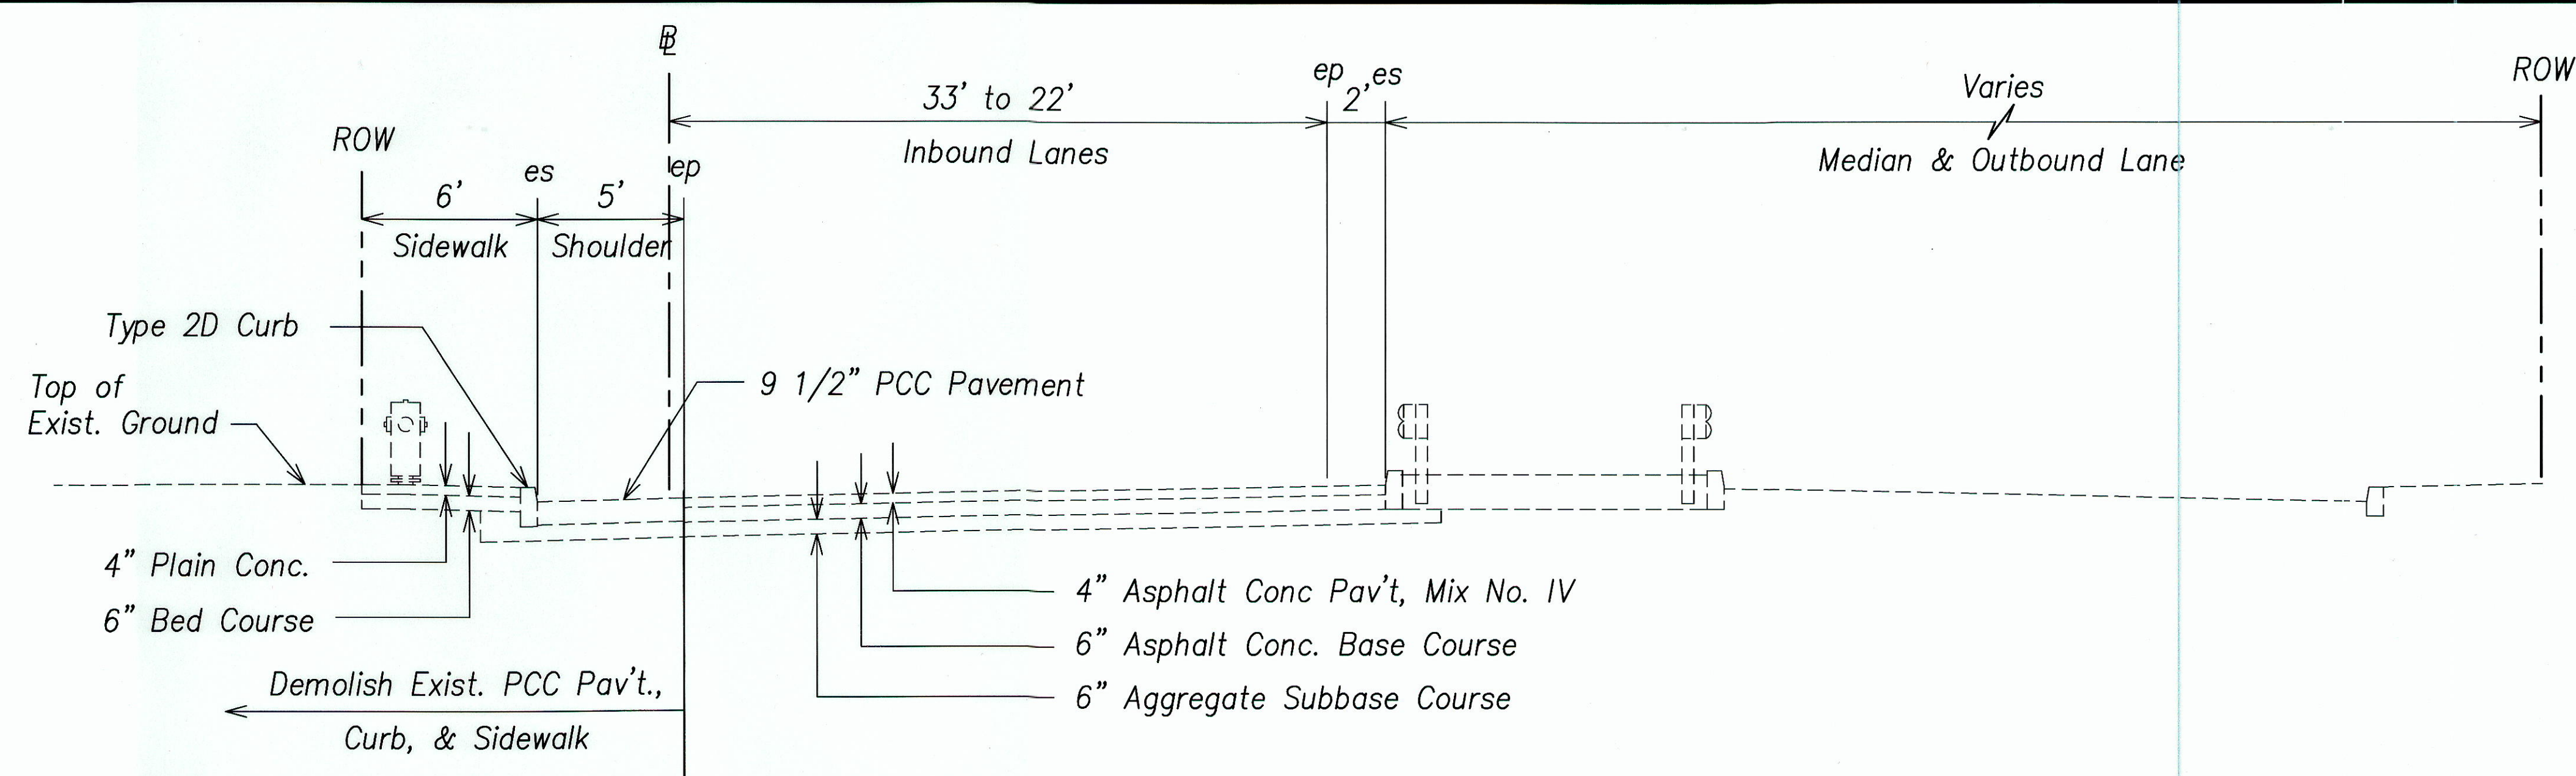


TYPICAL SECTION - EXISTING
Scale: 1" = 4'

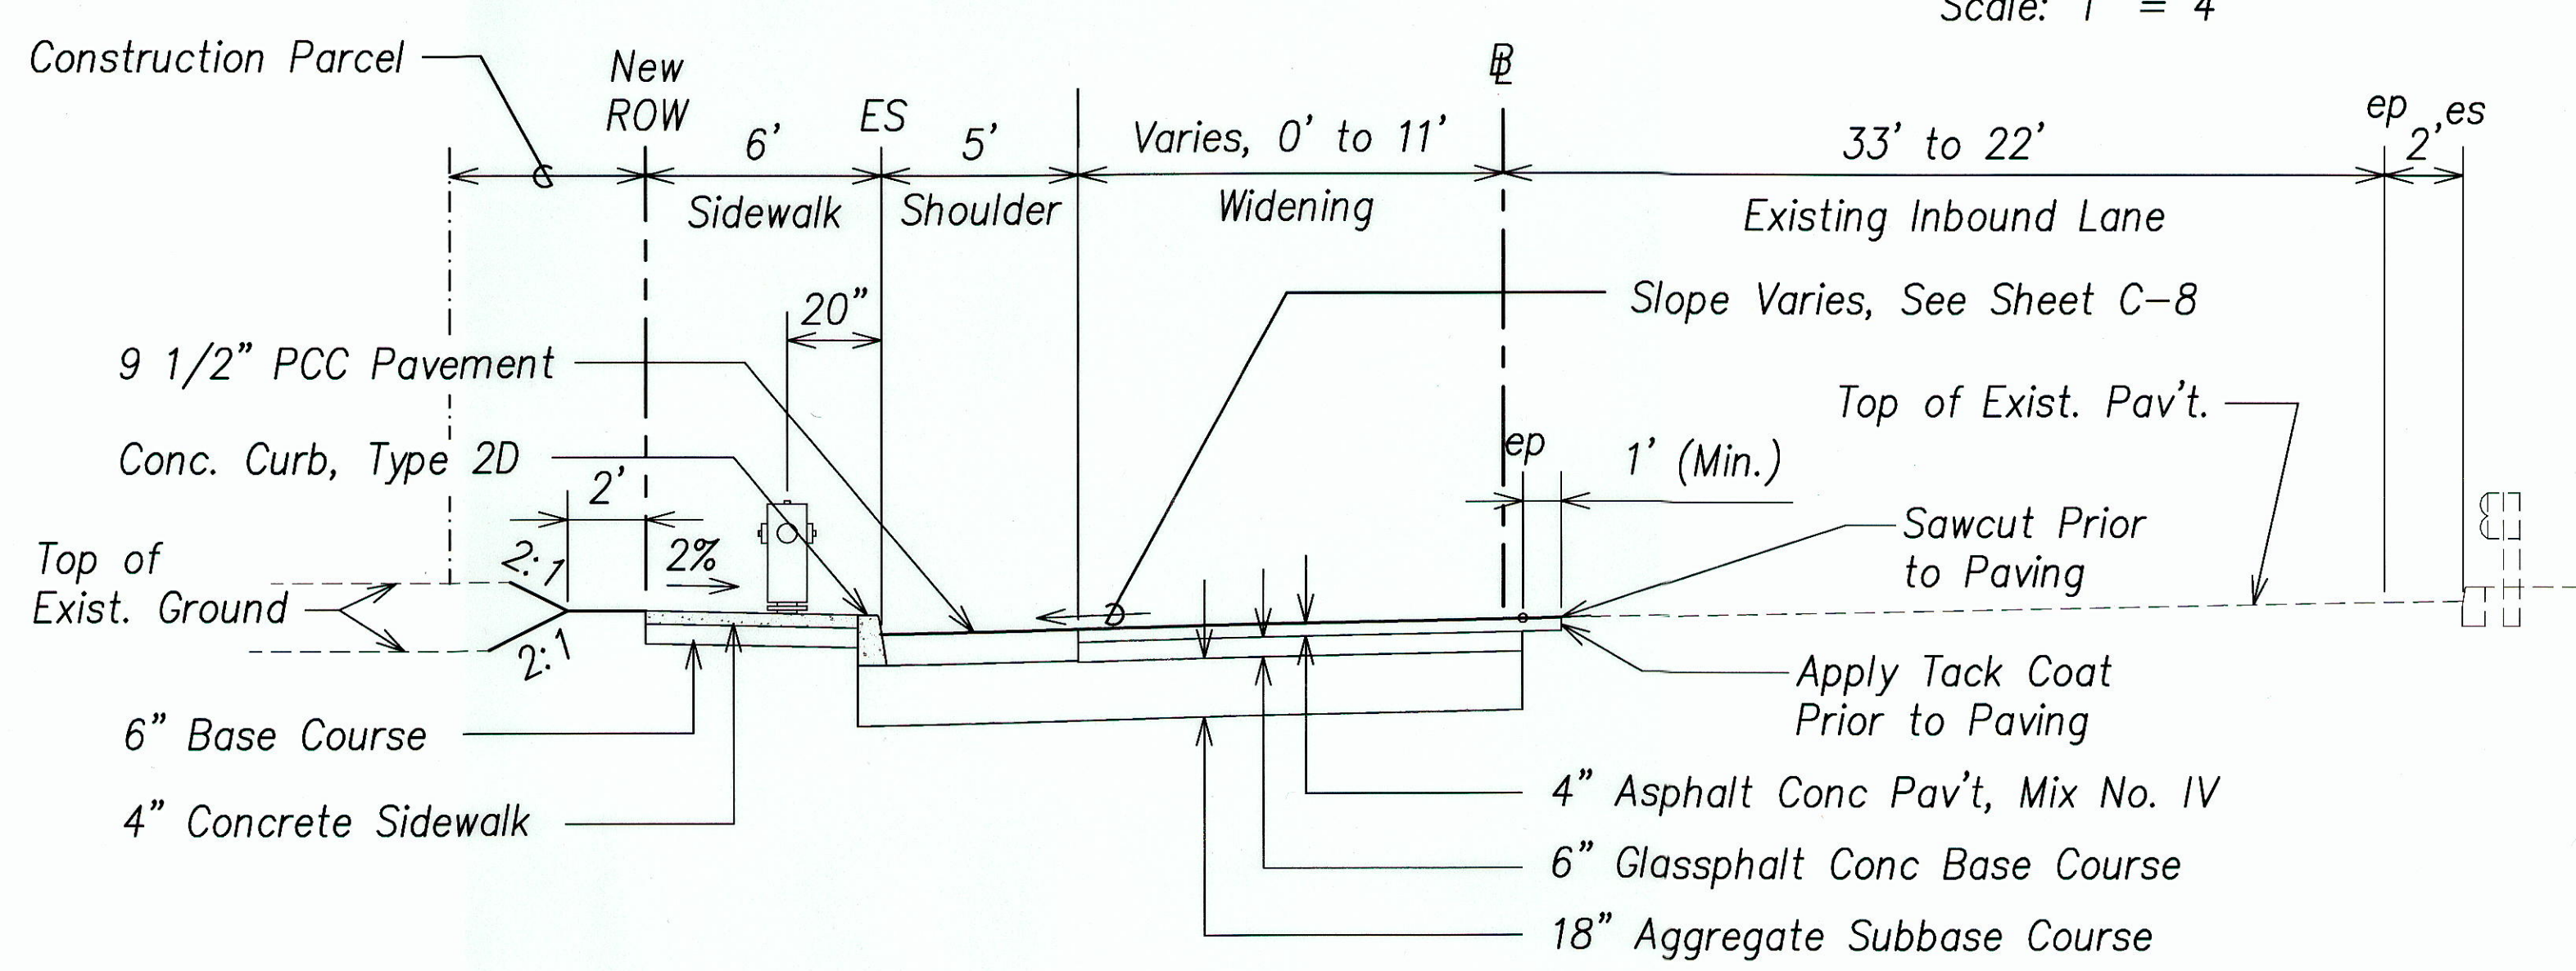


TYPICAL SECTION - WIDENING
Scale: 1" = 4'

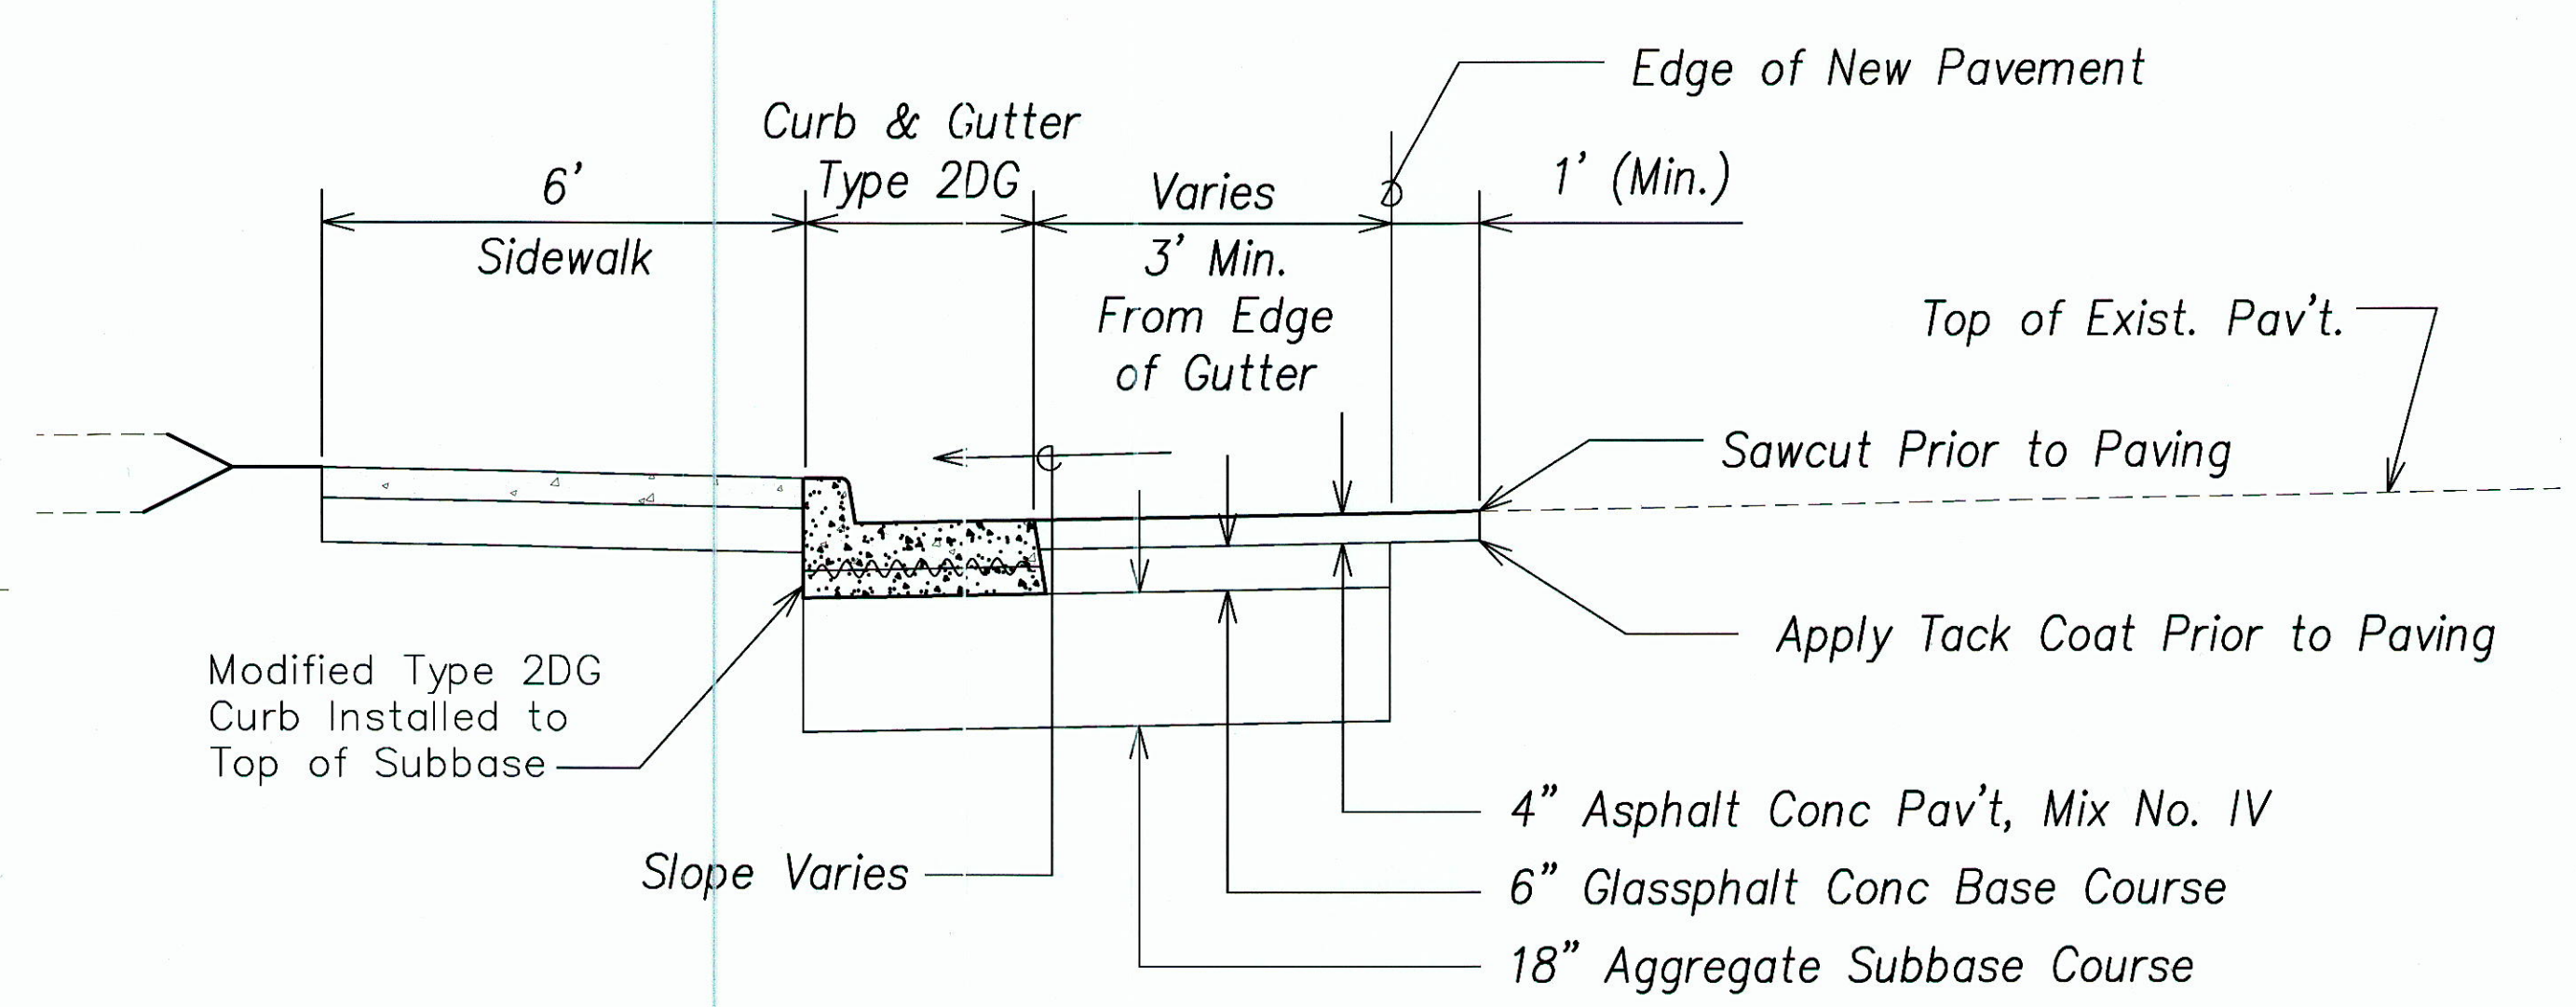

SECTION - CURB RETURN AT KEAHOLE STREET
Not to Scale

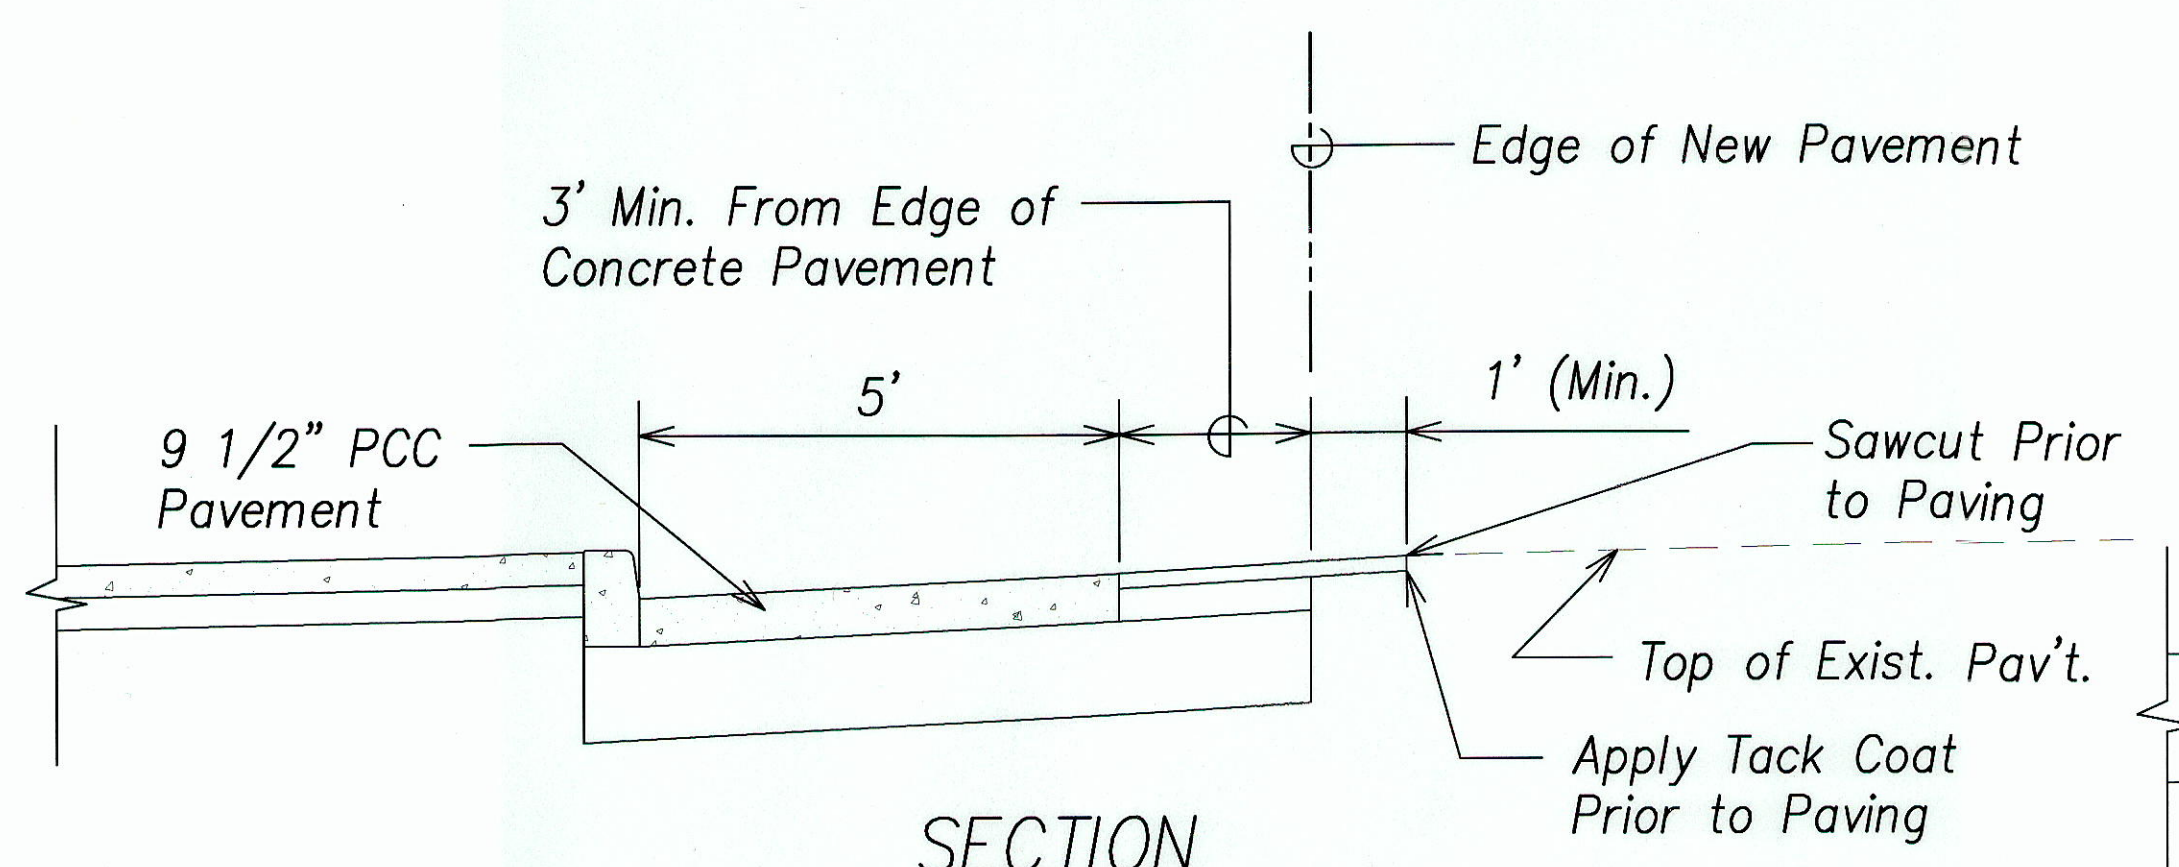

SECTION
Sta. 242+48 to Sta. 243+30±
Not to Scale

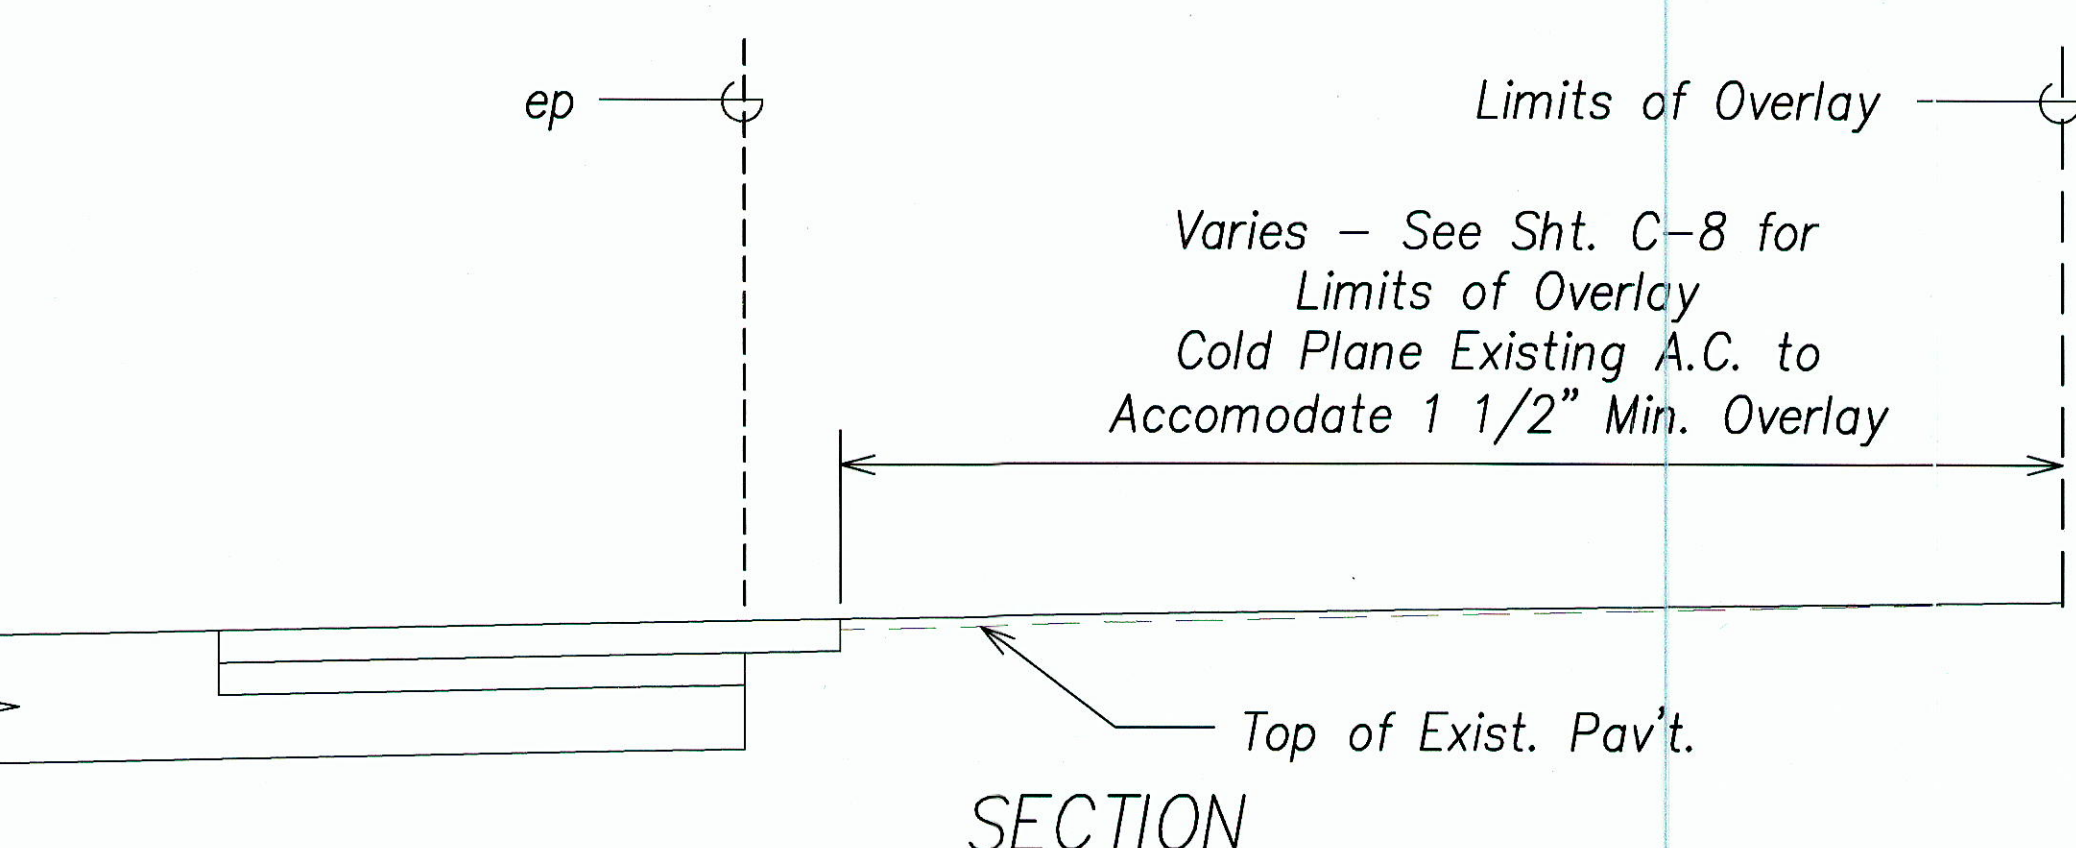

SECTION
Sta. 242+48± to Sta. 246+20±
Sta. 247+93± to Sta. 249+05±
Not to Scale

LEGEND FOR AS-BUILT POSTING	
	Squiggly line for as-built deletion
	Double line for as-built deletion
	Text for as-built posting

KENNETH O. NAGAI
LICENSED PROFESSIONAL ENGINEER
No. 3265-C
HAWAII, U.S.A.
APRIL 30, 2010
EXPIRATION DATE OF LICENSE
THIS WORK WAS PREPARED BY ME OR UNDER MY SUPERVISION

STATE OF HAWAII
DEPARTMENT OF TRANSPORTATION
HIGHWAYS DIVISION
TYPICAL SECTIONS
KALANIANA'OLE HIGHWAY
KALANIANA'OLE HIGHWAY IMPROVEMENTS
VICINITY OF HAWAII KAI DRIVE
TO KEAHOLE STREET
FEDERAL-AID PROJECT NO. NH-072-1(52)
SCALE: AS NOTED DATE: November 2008
SHEET No. C-5 OF 22 SHEETS