


|                 |           |  |
|-----------------|-----------|--|
| FINAL<br>SURVEY | DATE      |  |
|                 | BY        |  |
|                 | SURVEYED  |  |
|                 | NOTE BOOK |  |
|                 | NO.       |  |

|                    |           |  |
|--------------------|-----------|--|
| ORIGINAL<br>SURVEY | DATE      |  |
|                    | BY        |  |
|                    | SURVEYED  |  |
|                    | NOTE BOOK |  |
|                    | NO.       |  |


| FED. ROAD DIST. No. | STATE | PROJ. No.                | FISCAL YEAR | SHEET No. | TOTAL SHEETS |
|---------------------|-------|--------------------------|-------------|-----------|--------------|
| HAWAII              | HAW.  | A-70-02-60<br>A-75-01-60 | 1960        | 7         | 17           |

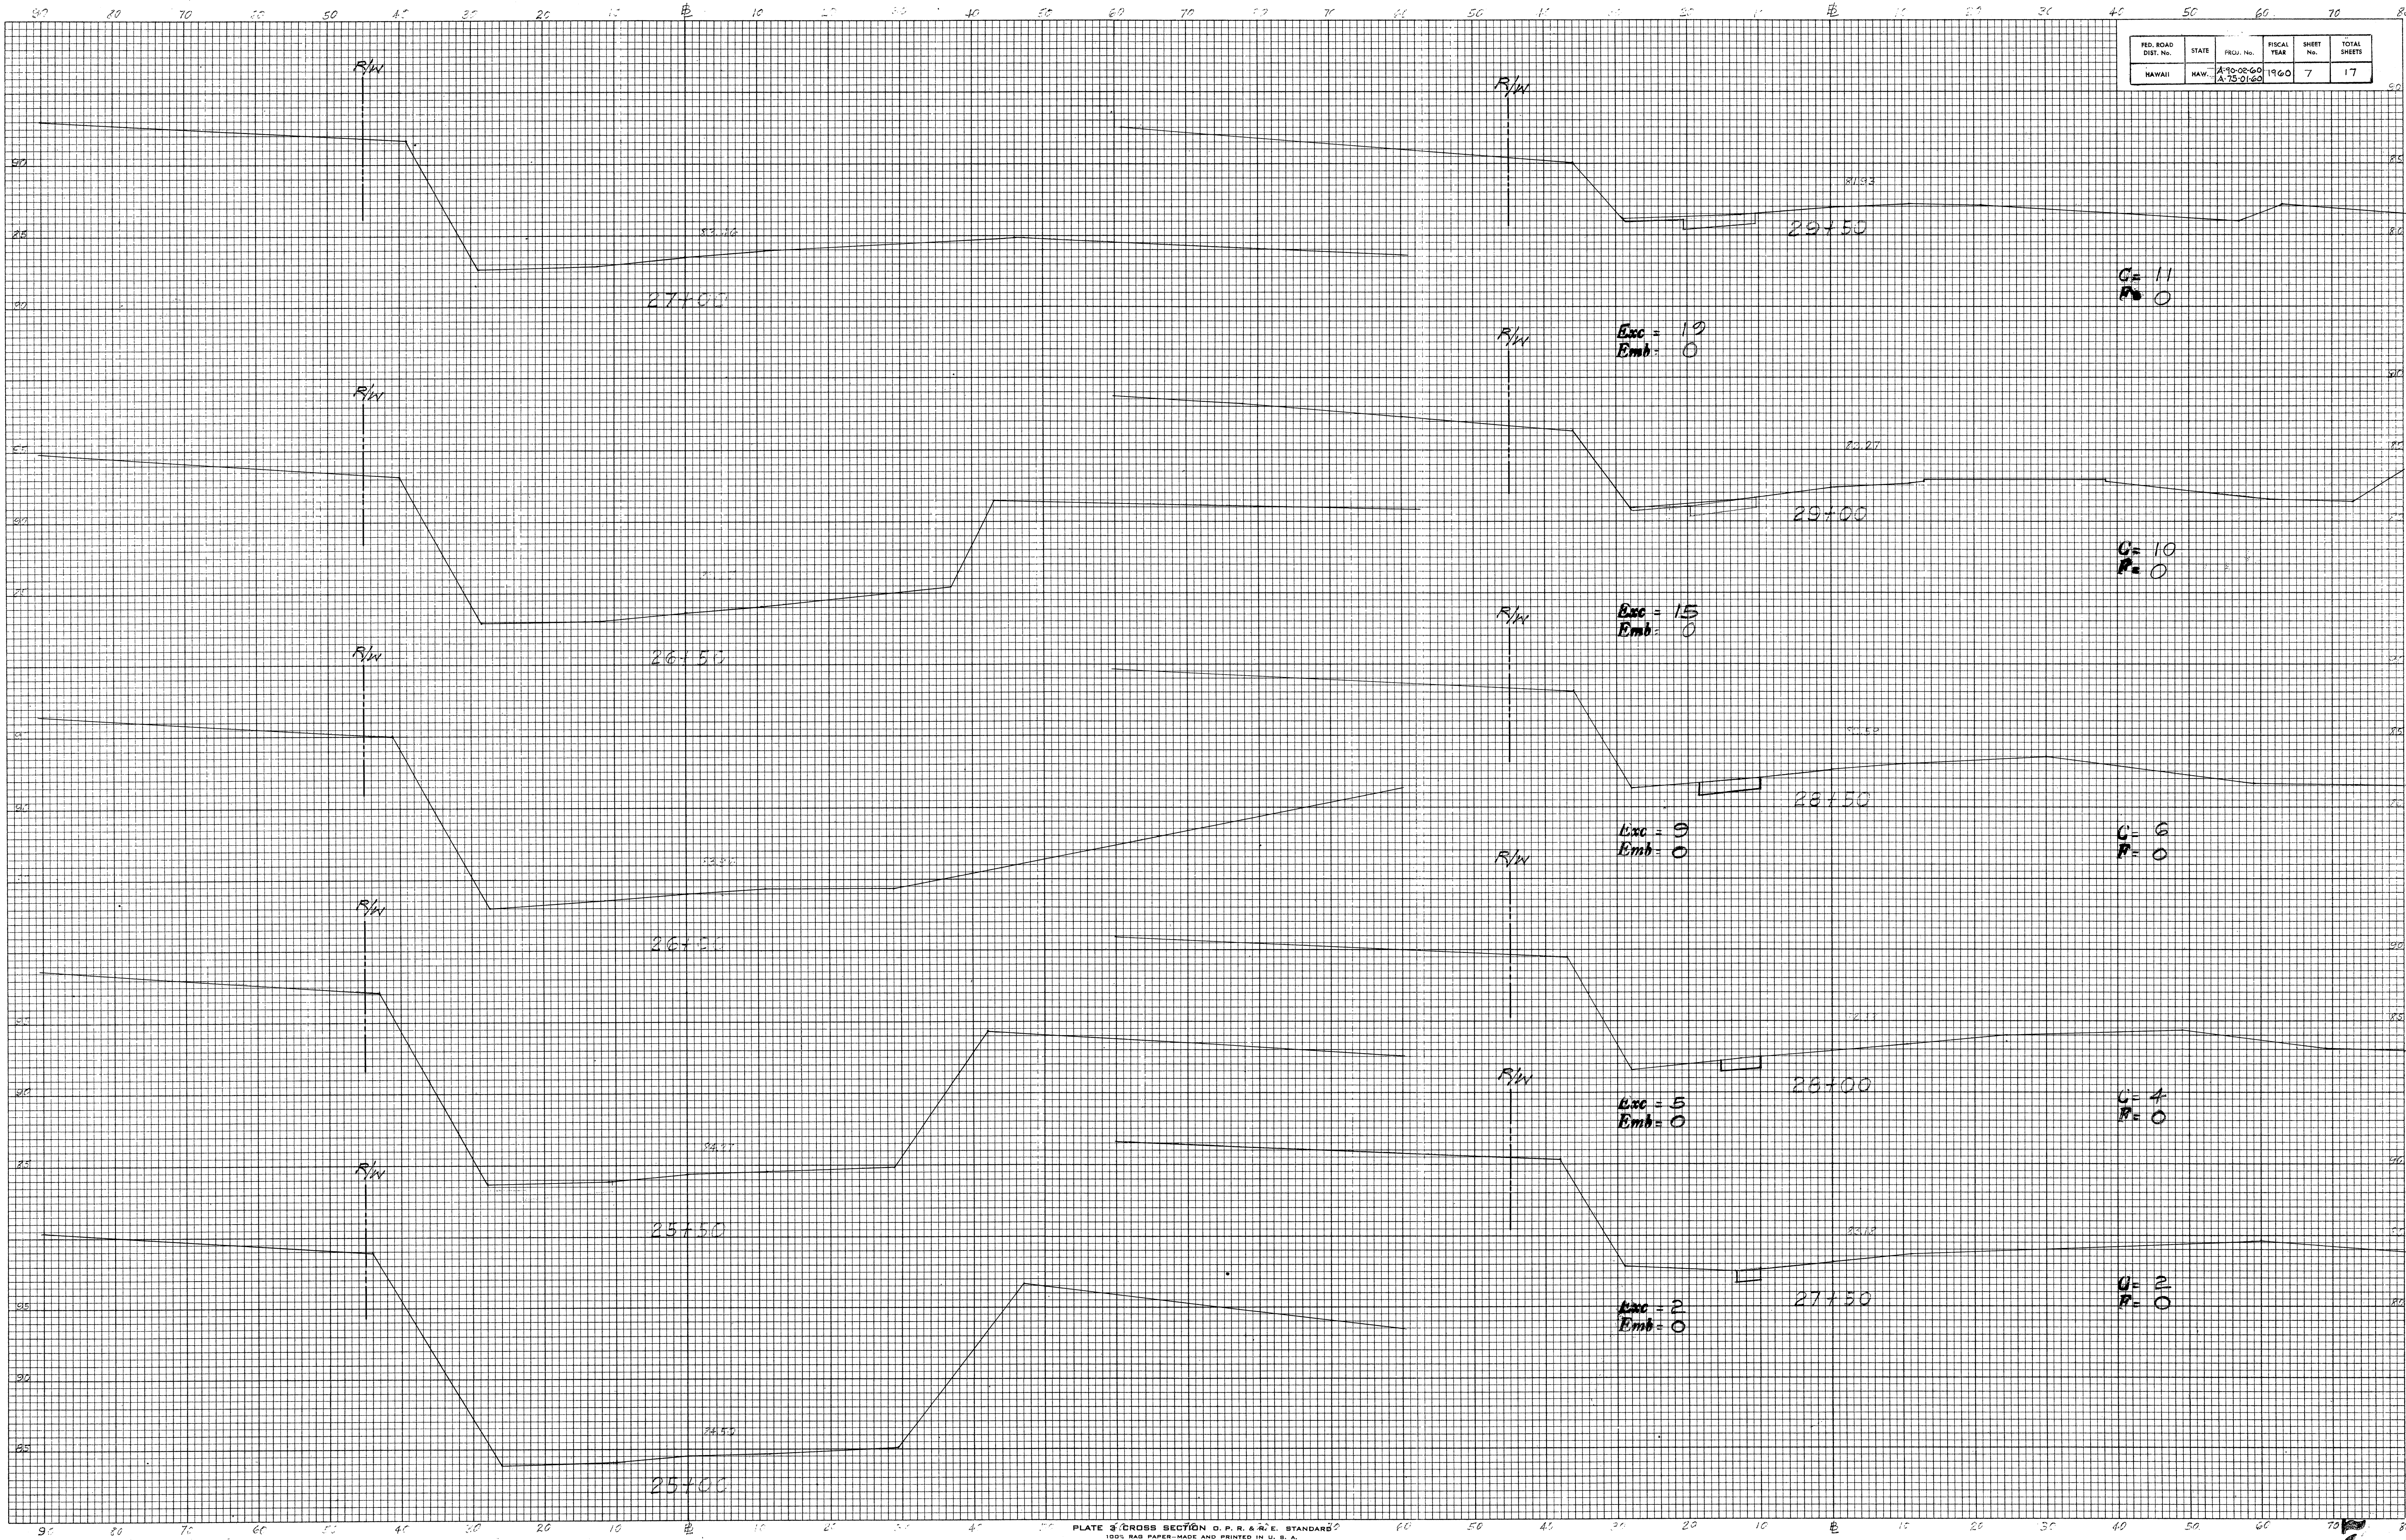

|               |    |
|---------------|----|
| DATE          | BY |
| SURVEYED      |    |
| PLOTTED       |    |
| NOTE BOOK     |    |
| AREAS CHECKED |    |
| NO.           |    |

|               |    |
|---------------|----|
| DATE          | BY |
| SURVEYED      |    |
| PLOTTED       |    |
| NOTE BOOK     |    |
| AREAS CHECKED |    |
| NO.           |    |


|                     |        |             |           |              |
|---------------------|--------|-------------|-----------|--------------|
| FED. ROAD DIST. No. | STATE  | FISCAL YEAR | SHEET No. | TOTAL SHEETS |
| HAWAII              | HAWAII | 1960        | 8         | 17           |

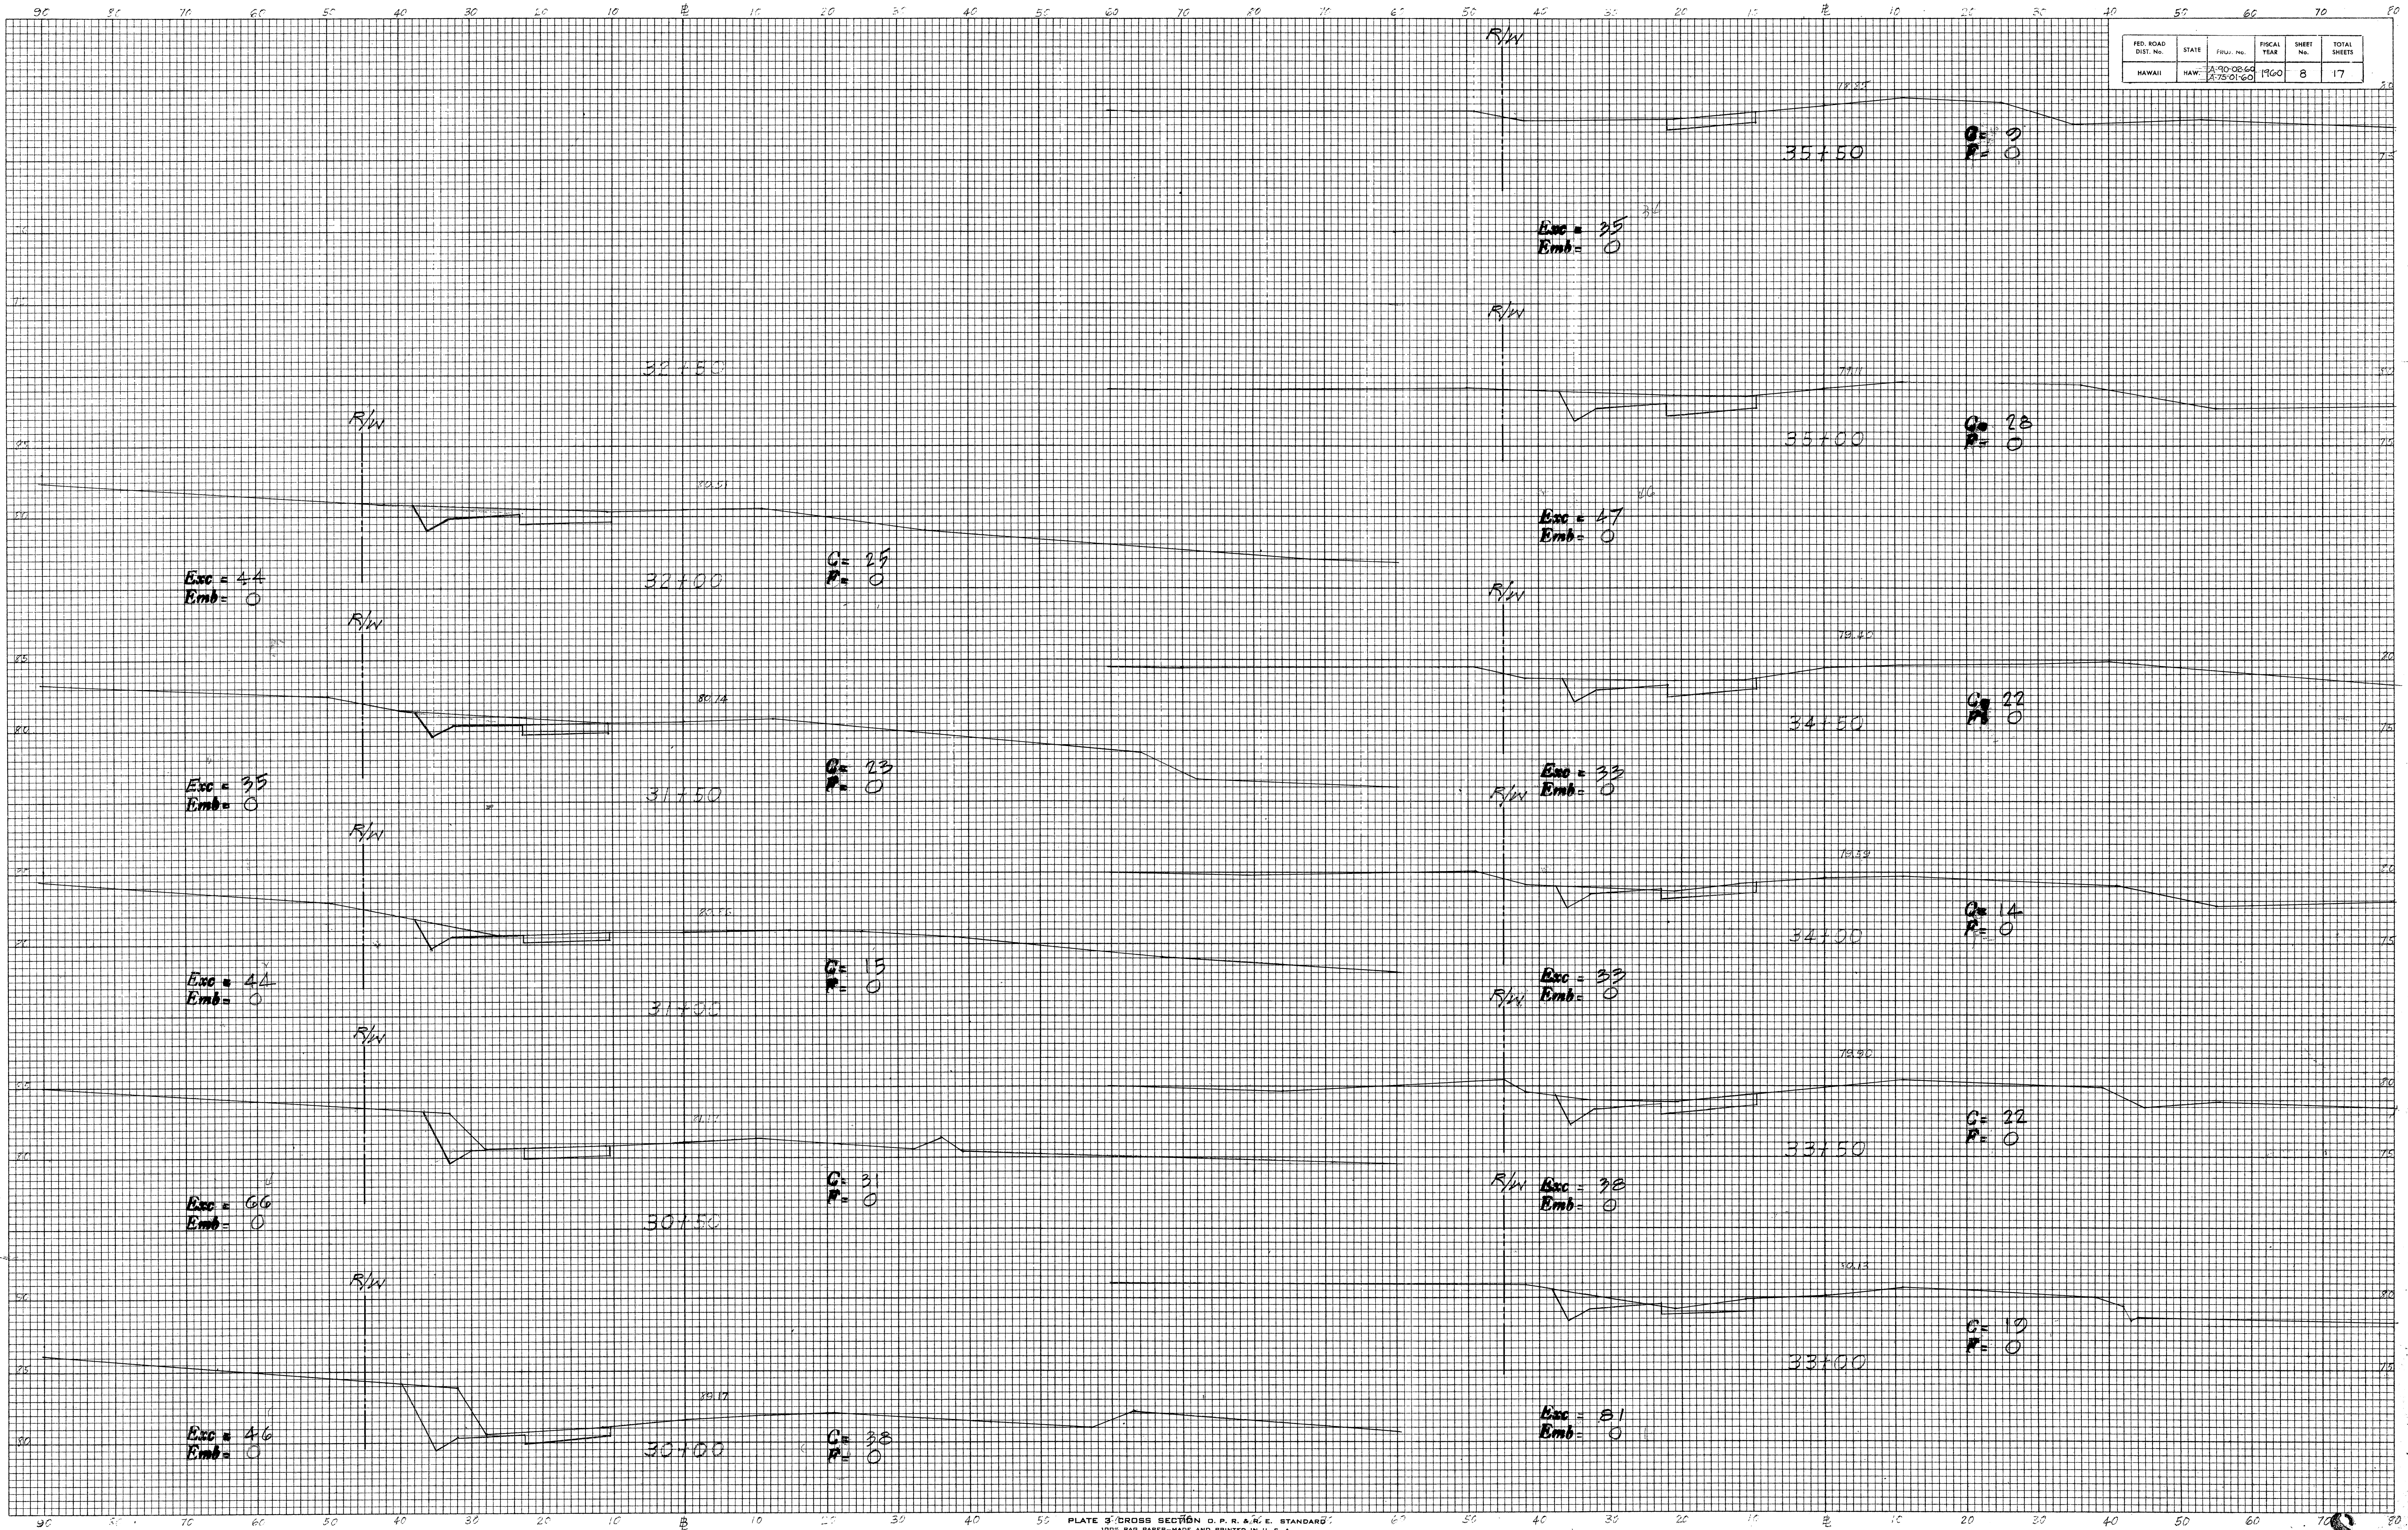

|                 |           |  |
|-----------------|-----------|--|
| FINAL<br>SURVEY | DATE      |  |
|                 | BY        |  |
|                 | SURVEYED  |  |
|                 | PLOTTED   |  |
|                 | NOTE BOOK |  |
|                 | AREAS     |  |
|                 | CHECKED   |  |
|                 | NO.       |  |

|                    |           |  |
|--------------------|-----------|--|
| ORIGINAL<br>SURVEY | DATE      |  |
|                    | BY        |  |
|                    | SURVEYED  |  |
|                    | PLOTTED   |  |
|                    | NOTE BOOK |  |
|                    | AREAS     |  |
|                    | CHECKED   |  |
|                    | NO.       |  |


| FED. ROAD DIST. No. | STATE | PROJ. No.                | FISCAL YEAR | SHEET No. | TOTAL SHEETS |
|---------------------|-------|--------------------------|-------------|-----------|--------------|
| HAWAII              | HAW.  | A-70-02-60<br>A-75-01-60 | 1960        | 9         | 17           |

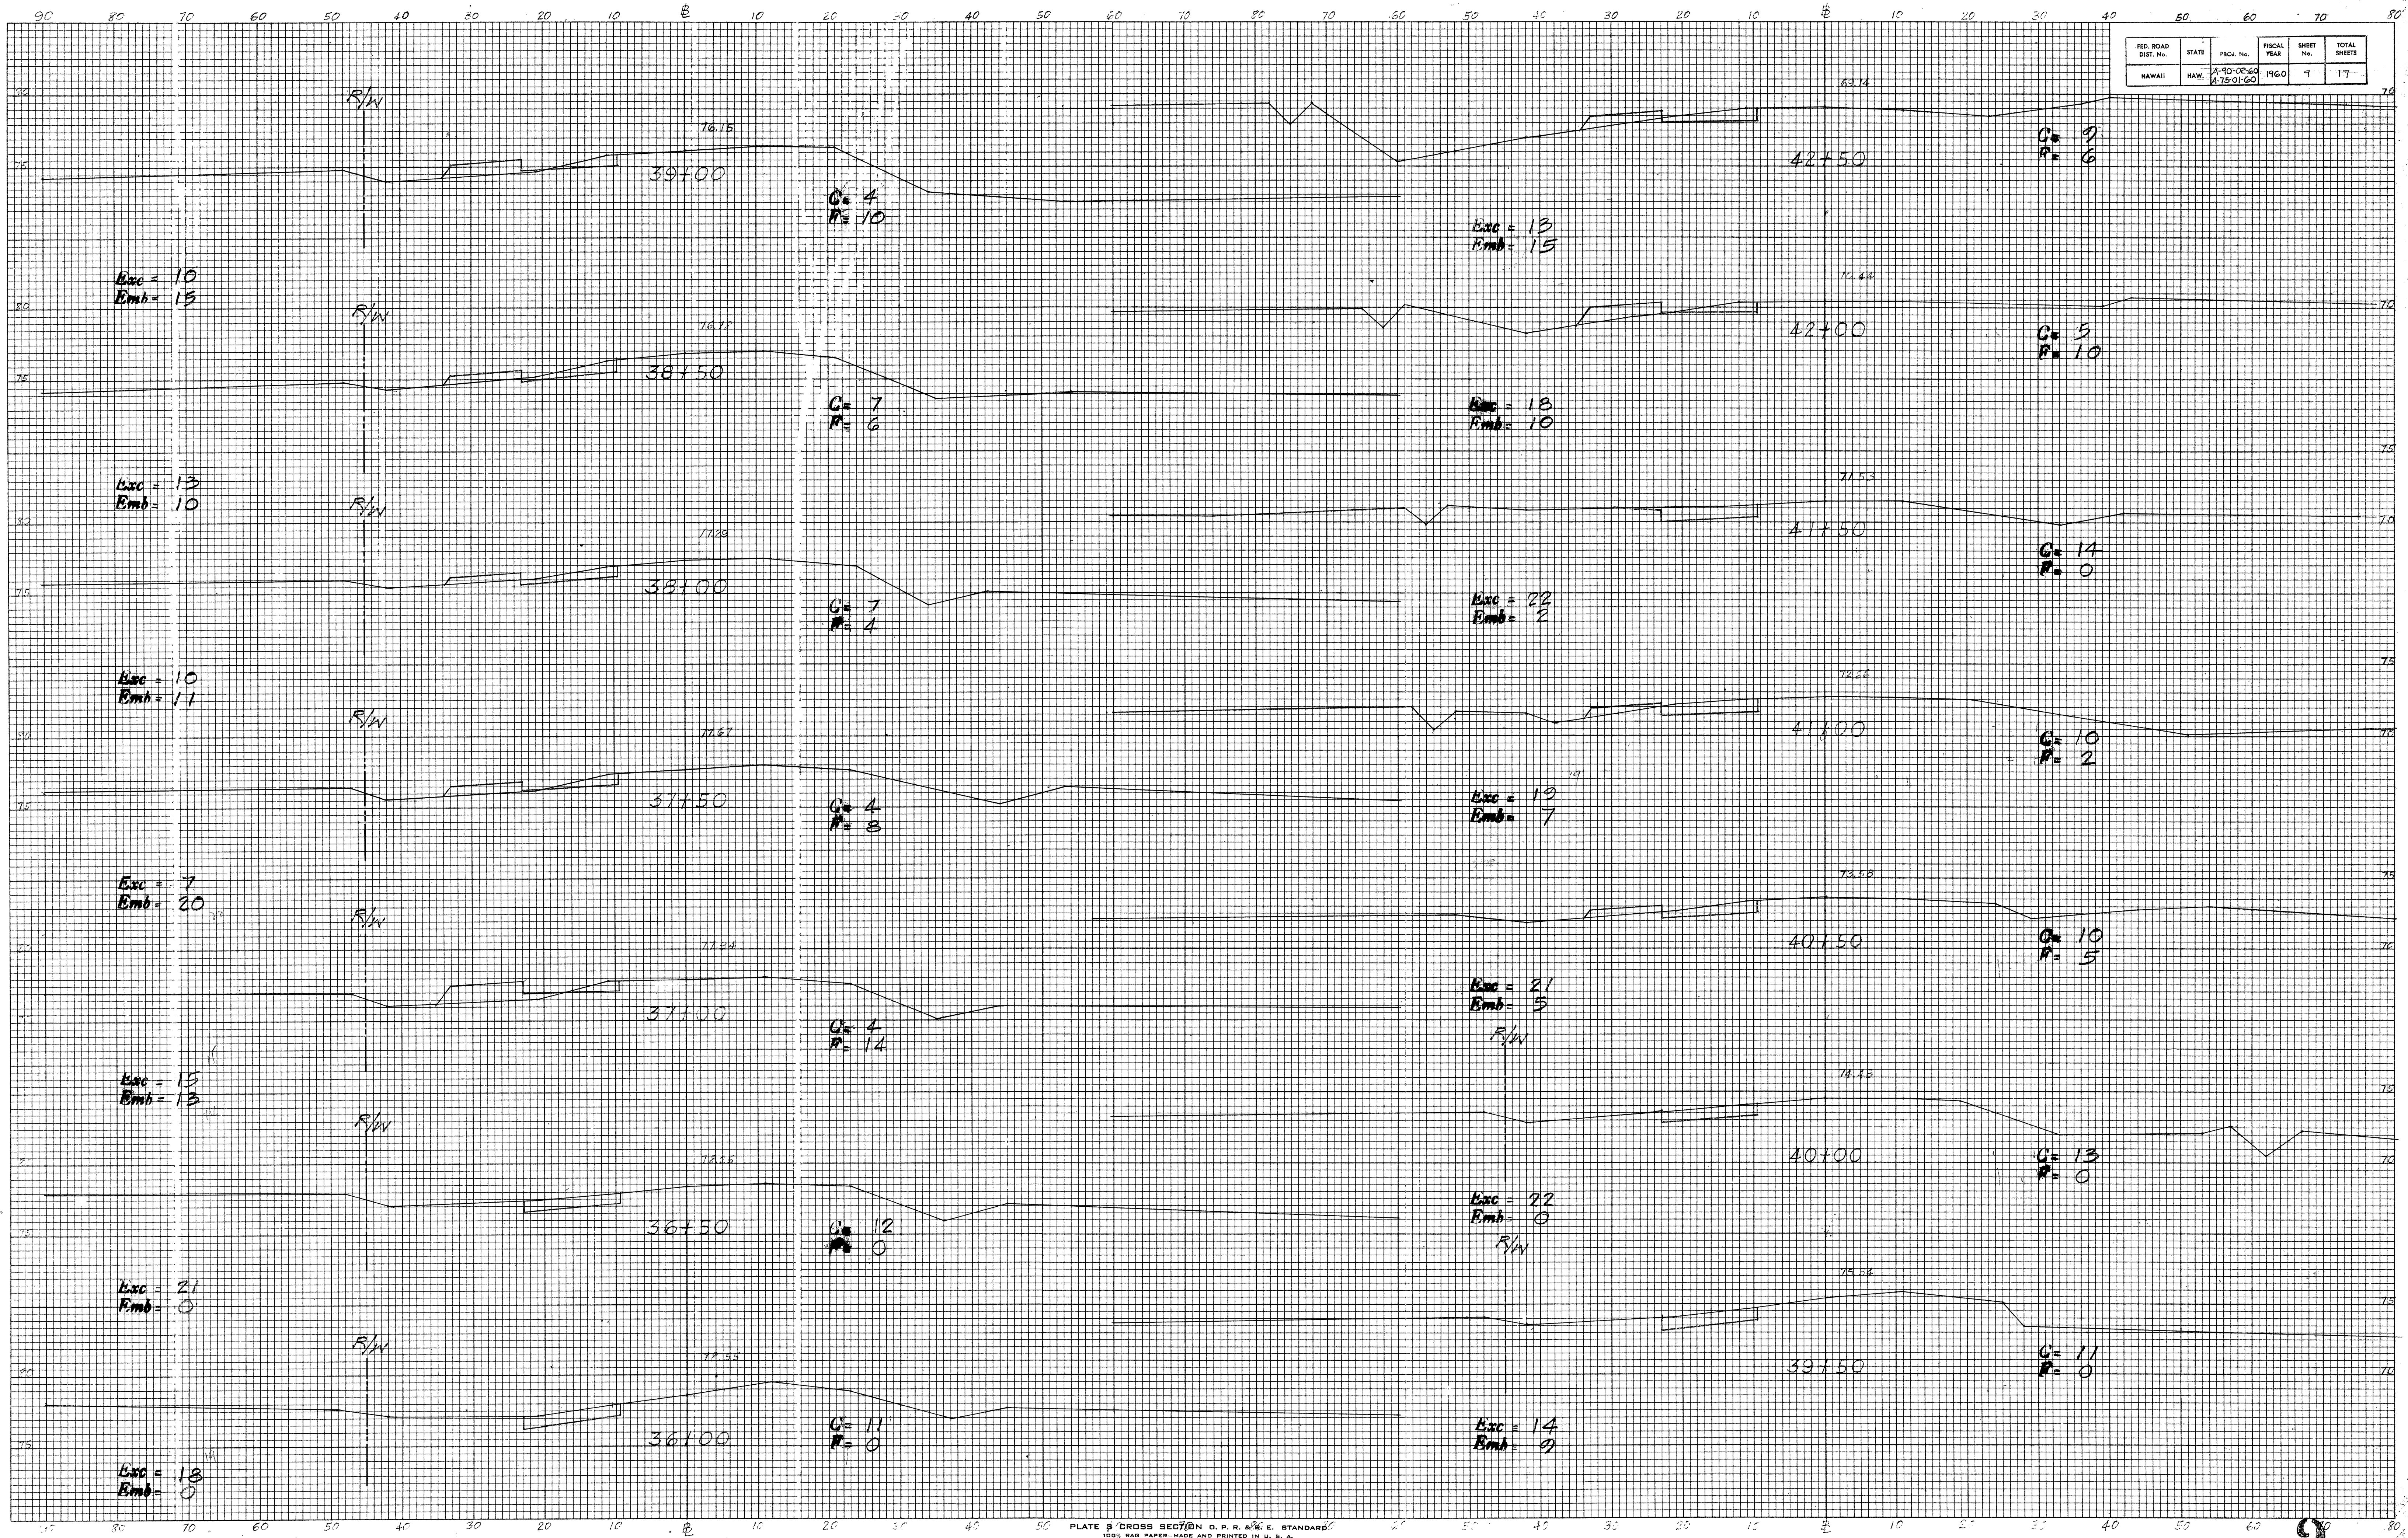

|                 |               |  |
|-----------------|---------------|--|
| FINAL<br>SURVEY | DATE          |  |
|                 | BY            |  |
|                 | SURVEYED      |  |
|                 | PLOTTED       |  |
|                 | NOTE BOOK     |  |
|                 | AREAS CHECKED |  |
|                 | NO.           |  |

|                    |               |  |
|--------------------|---------------|--|
| ORIGINAL<br>SURVEY | DATE          |  |
|                    | BY            |  |
|                    | SURVEYED      |  |
|                    | PLOTTED       |  |
|                    | NOTE BOOK     |  |
|                    | AREAS CHECKED |  |
|                    | NO.           |  |


| FED. ROAD DIST. No. | STATE | PROJ. No.  | FINANCIAL YEAR | SHEET No. | TOTAL SHEETS |
|---------------------|-------|------------|----------------|-----------|--------------|
| HAWAII              | HAW.  | A-75-01-60 | 1960           | 10        | 17           |

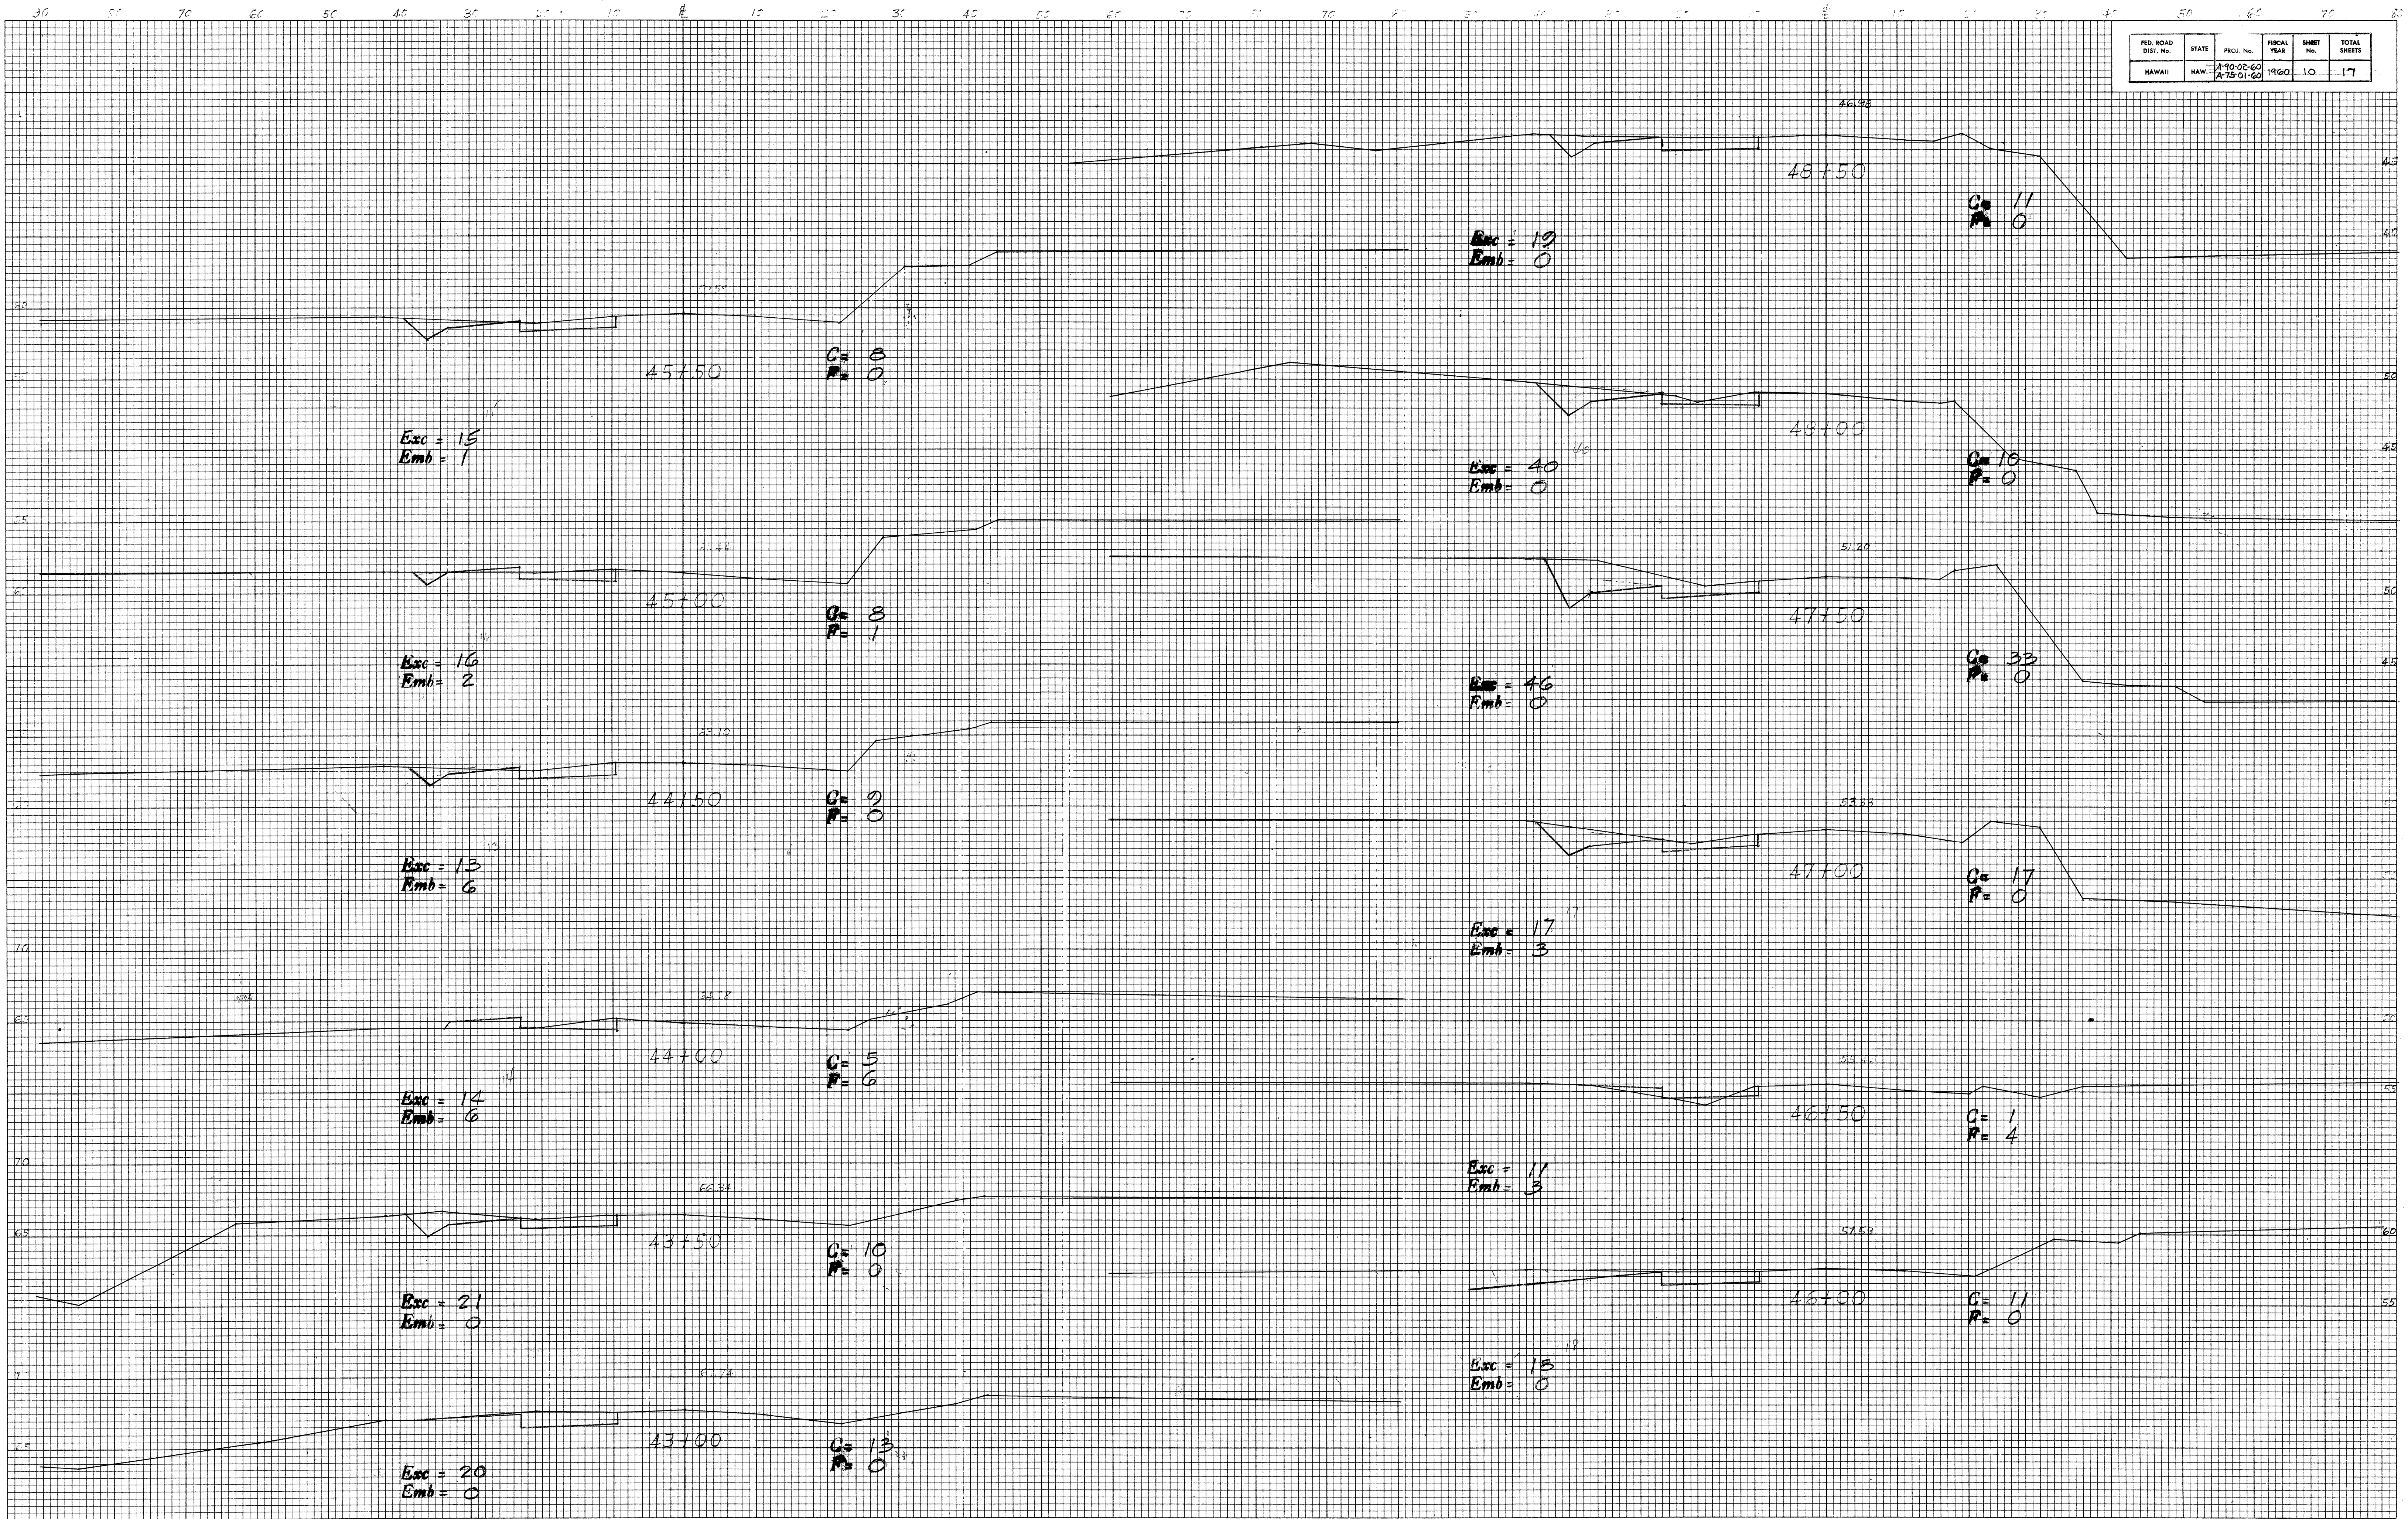

|                 |           |  |
|-----------------|-----------|--|
| FINAL<br>SURVEY | DATE      |  |
|                 | BY        |  |
|                 | SURVEYED  |  |
|                 | PLOTTED   |  |
|                 | NOTE BOOK |  |
|                 | NO.       |  |

|                    |           |  |
|--------------------|-----------|--|
| ORIGINAL<br>SURVEY | DATE      |  |
|                    | BY        |  |
|                    | SURVEYED  |  |
|                    | PLOTTED   |  |
|                    | NOTE BOOK |  |
|                    | NO.       |  |

| FED. ROAD DIST. No. | STATE | PROJ. No.               | FISCAL YEAR | SHEET No. | TOTAL SHEETS |
|---------------------|-------|-------------------------|-------------|-----------|--------------|
| HAWAII              | HAW.  | A-70-02-60<br>A-7501-60 | 1960        | 11        | 17           |

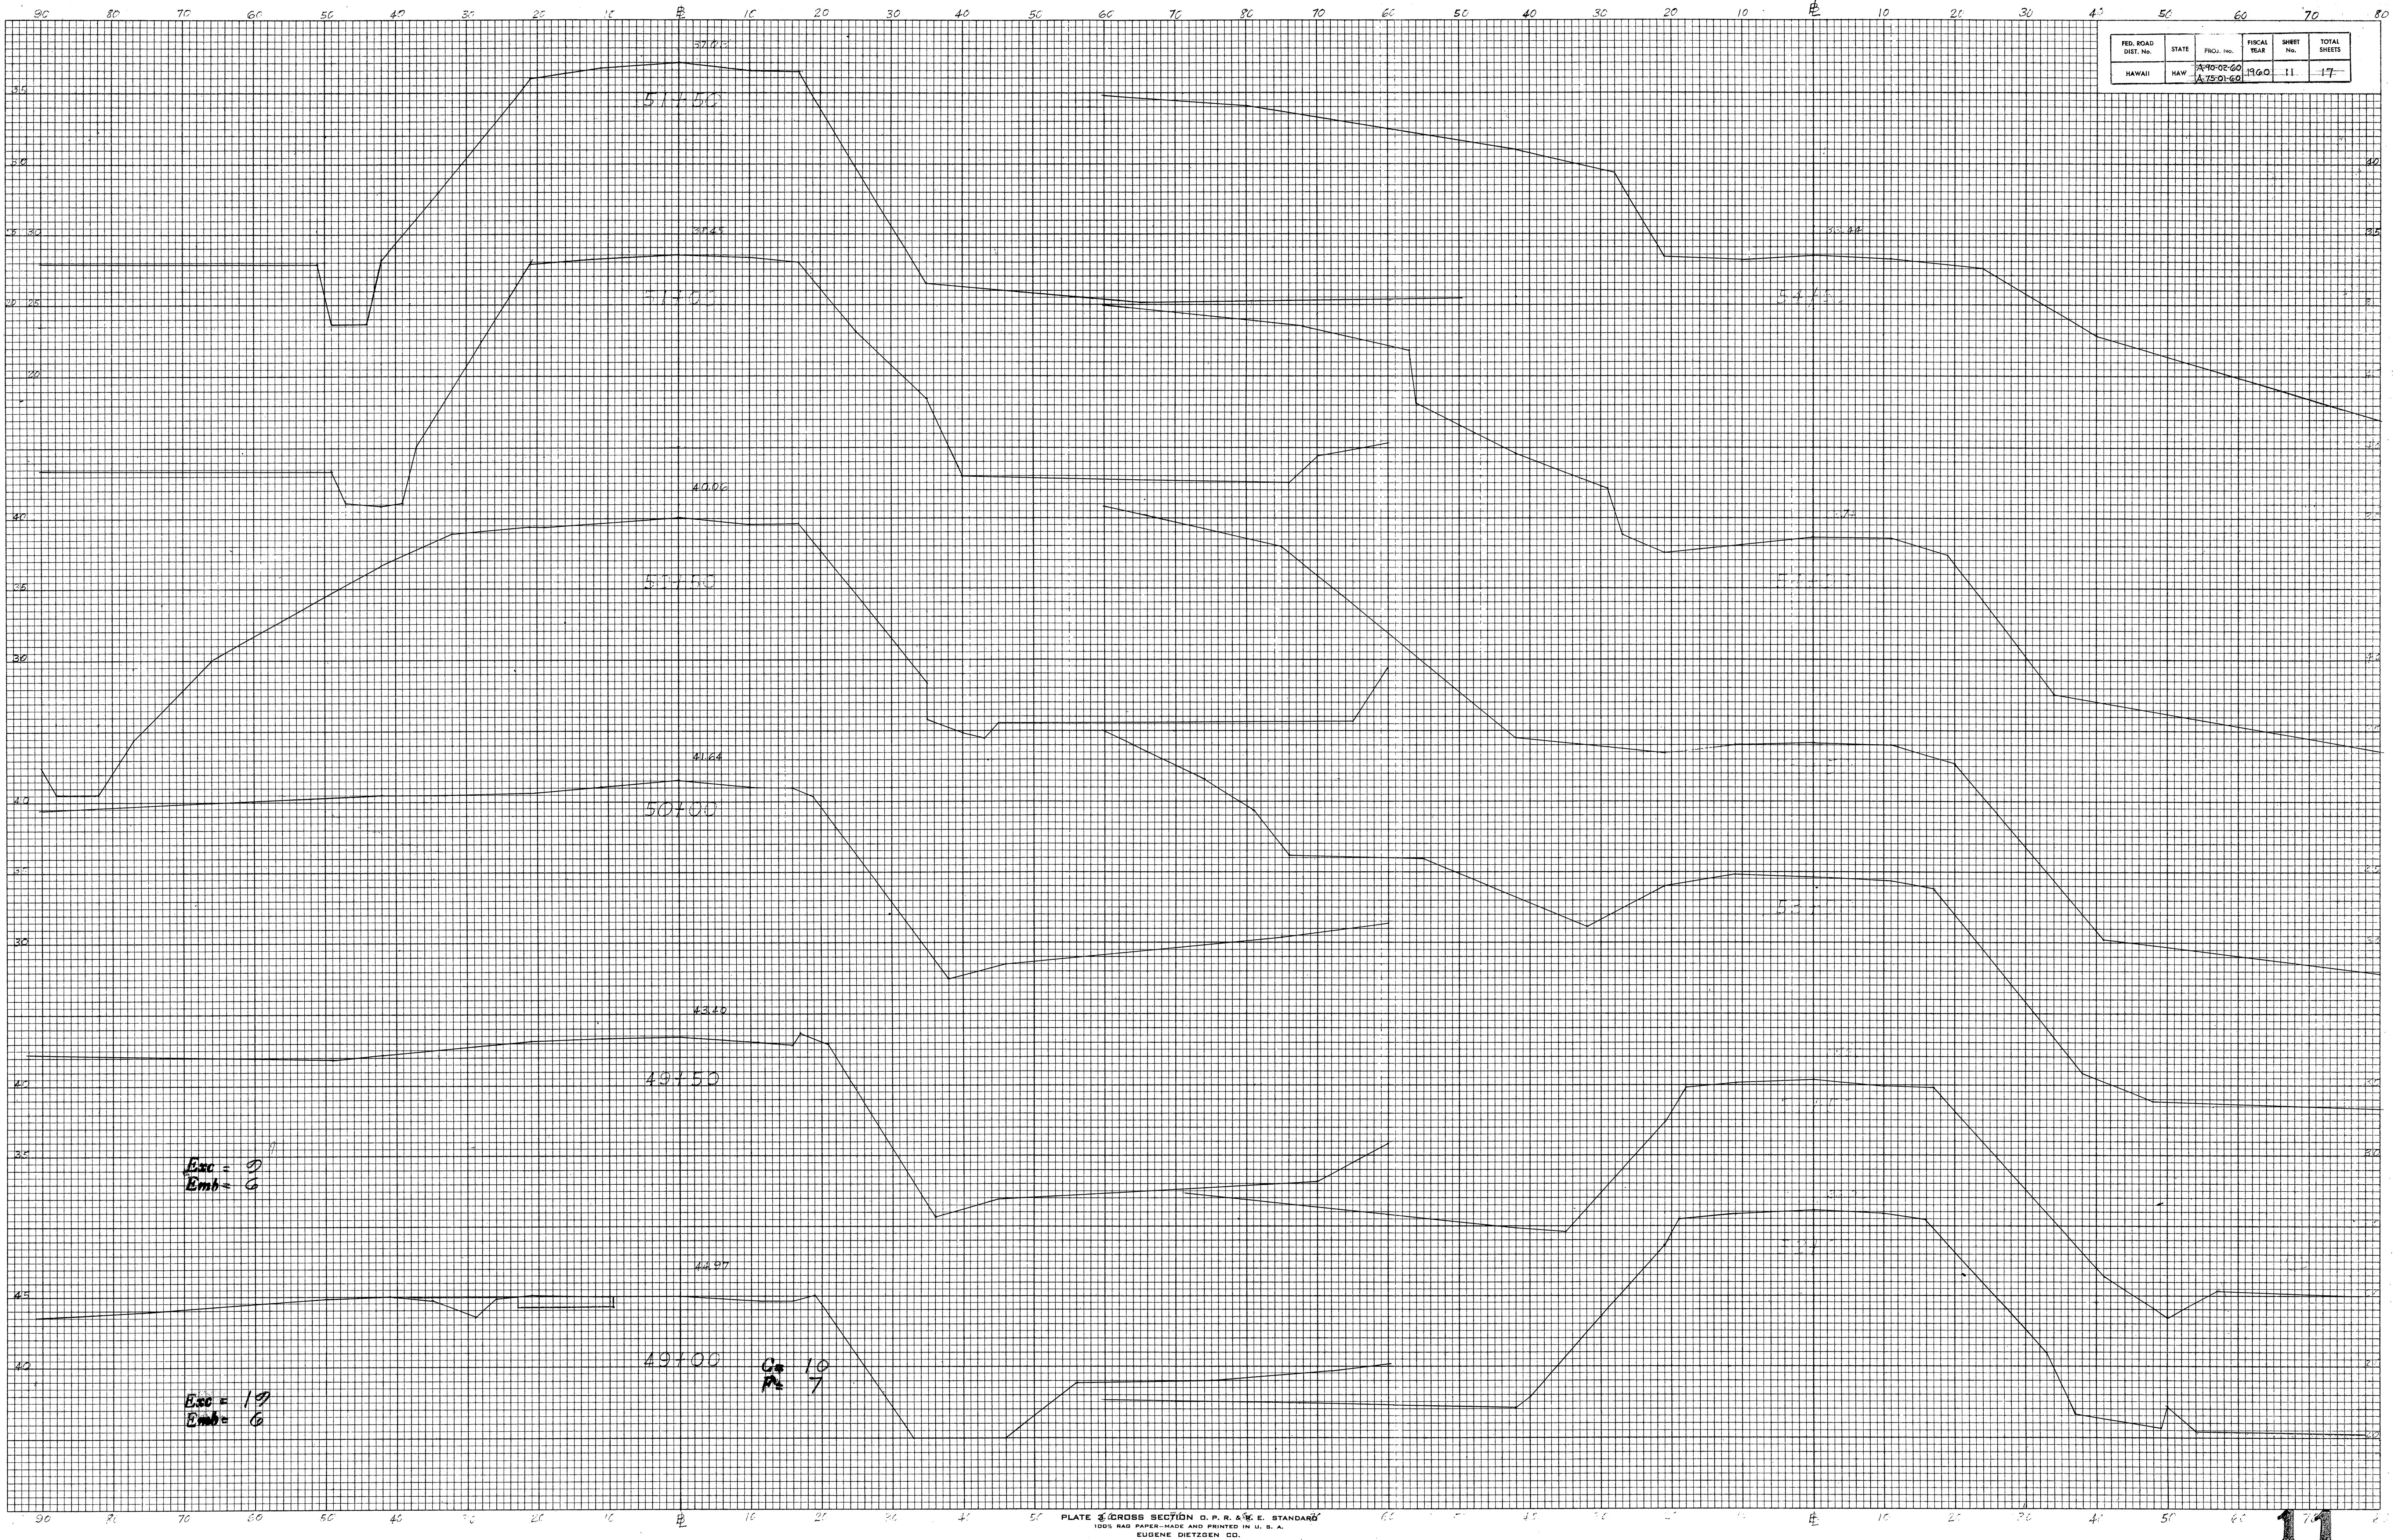

|      |    |              |          |         |              |               |
|------|----|--------------|----------|---------|--------------|---------------|
| DATE | BY | FINAL SURVEY | SURVEYED | PLOTTED | RECALCULATED | AREAS CHECKED |
|      |    |              |          |         |              |               |
|      |    |              |          |         |              |               |
|      |    |                 |          |         |              |               |
|------|----|-----------------|----------|---------|--------------|---------------|
| DATE | BY | ORIGINAL SURVEY | SURVEYED | PLOTTED | RECALCULATED | AREAS CHECKED |
|      |    |                 |          |         |              |               |
|      |    |                 |          |         |              |               |
