



INDEX TO DRAWINGS	
SHT. NO.	DESCRIPTION
1	TITLE SHEET
2	TYPICAL SECTION & NOTES
2 - 6	PLAN SHEETS

STATE OF HAWAII  
DEPARTMENT OF TRANSPORTATION  
HIGHWAYS DIVISION  
HONOLULU, HAWAII  
"AS BUILT"  
PLANS FOR  
  
RESURFACING A PORTION OF  
KUNIA ROAD  
  
WHEELER AIR FORCE BASE  
TO  
WAIPAHU STREET  
  
PROJECT NO. A-75-01-64

DISTRICTS OF WAHIAWA AND EWA  
ISLAND OF OAHU

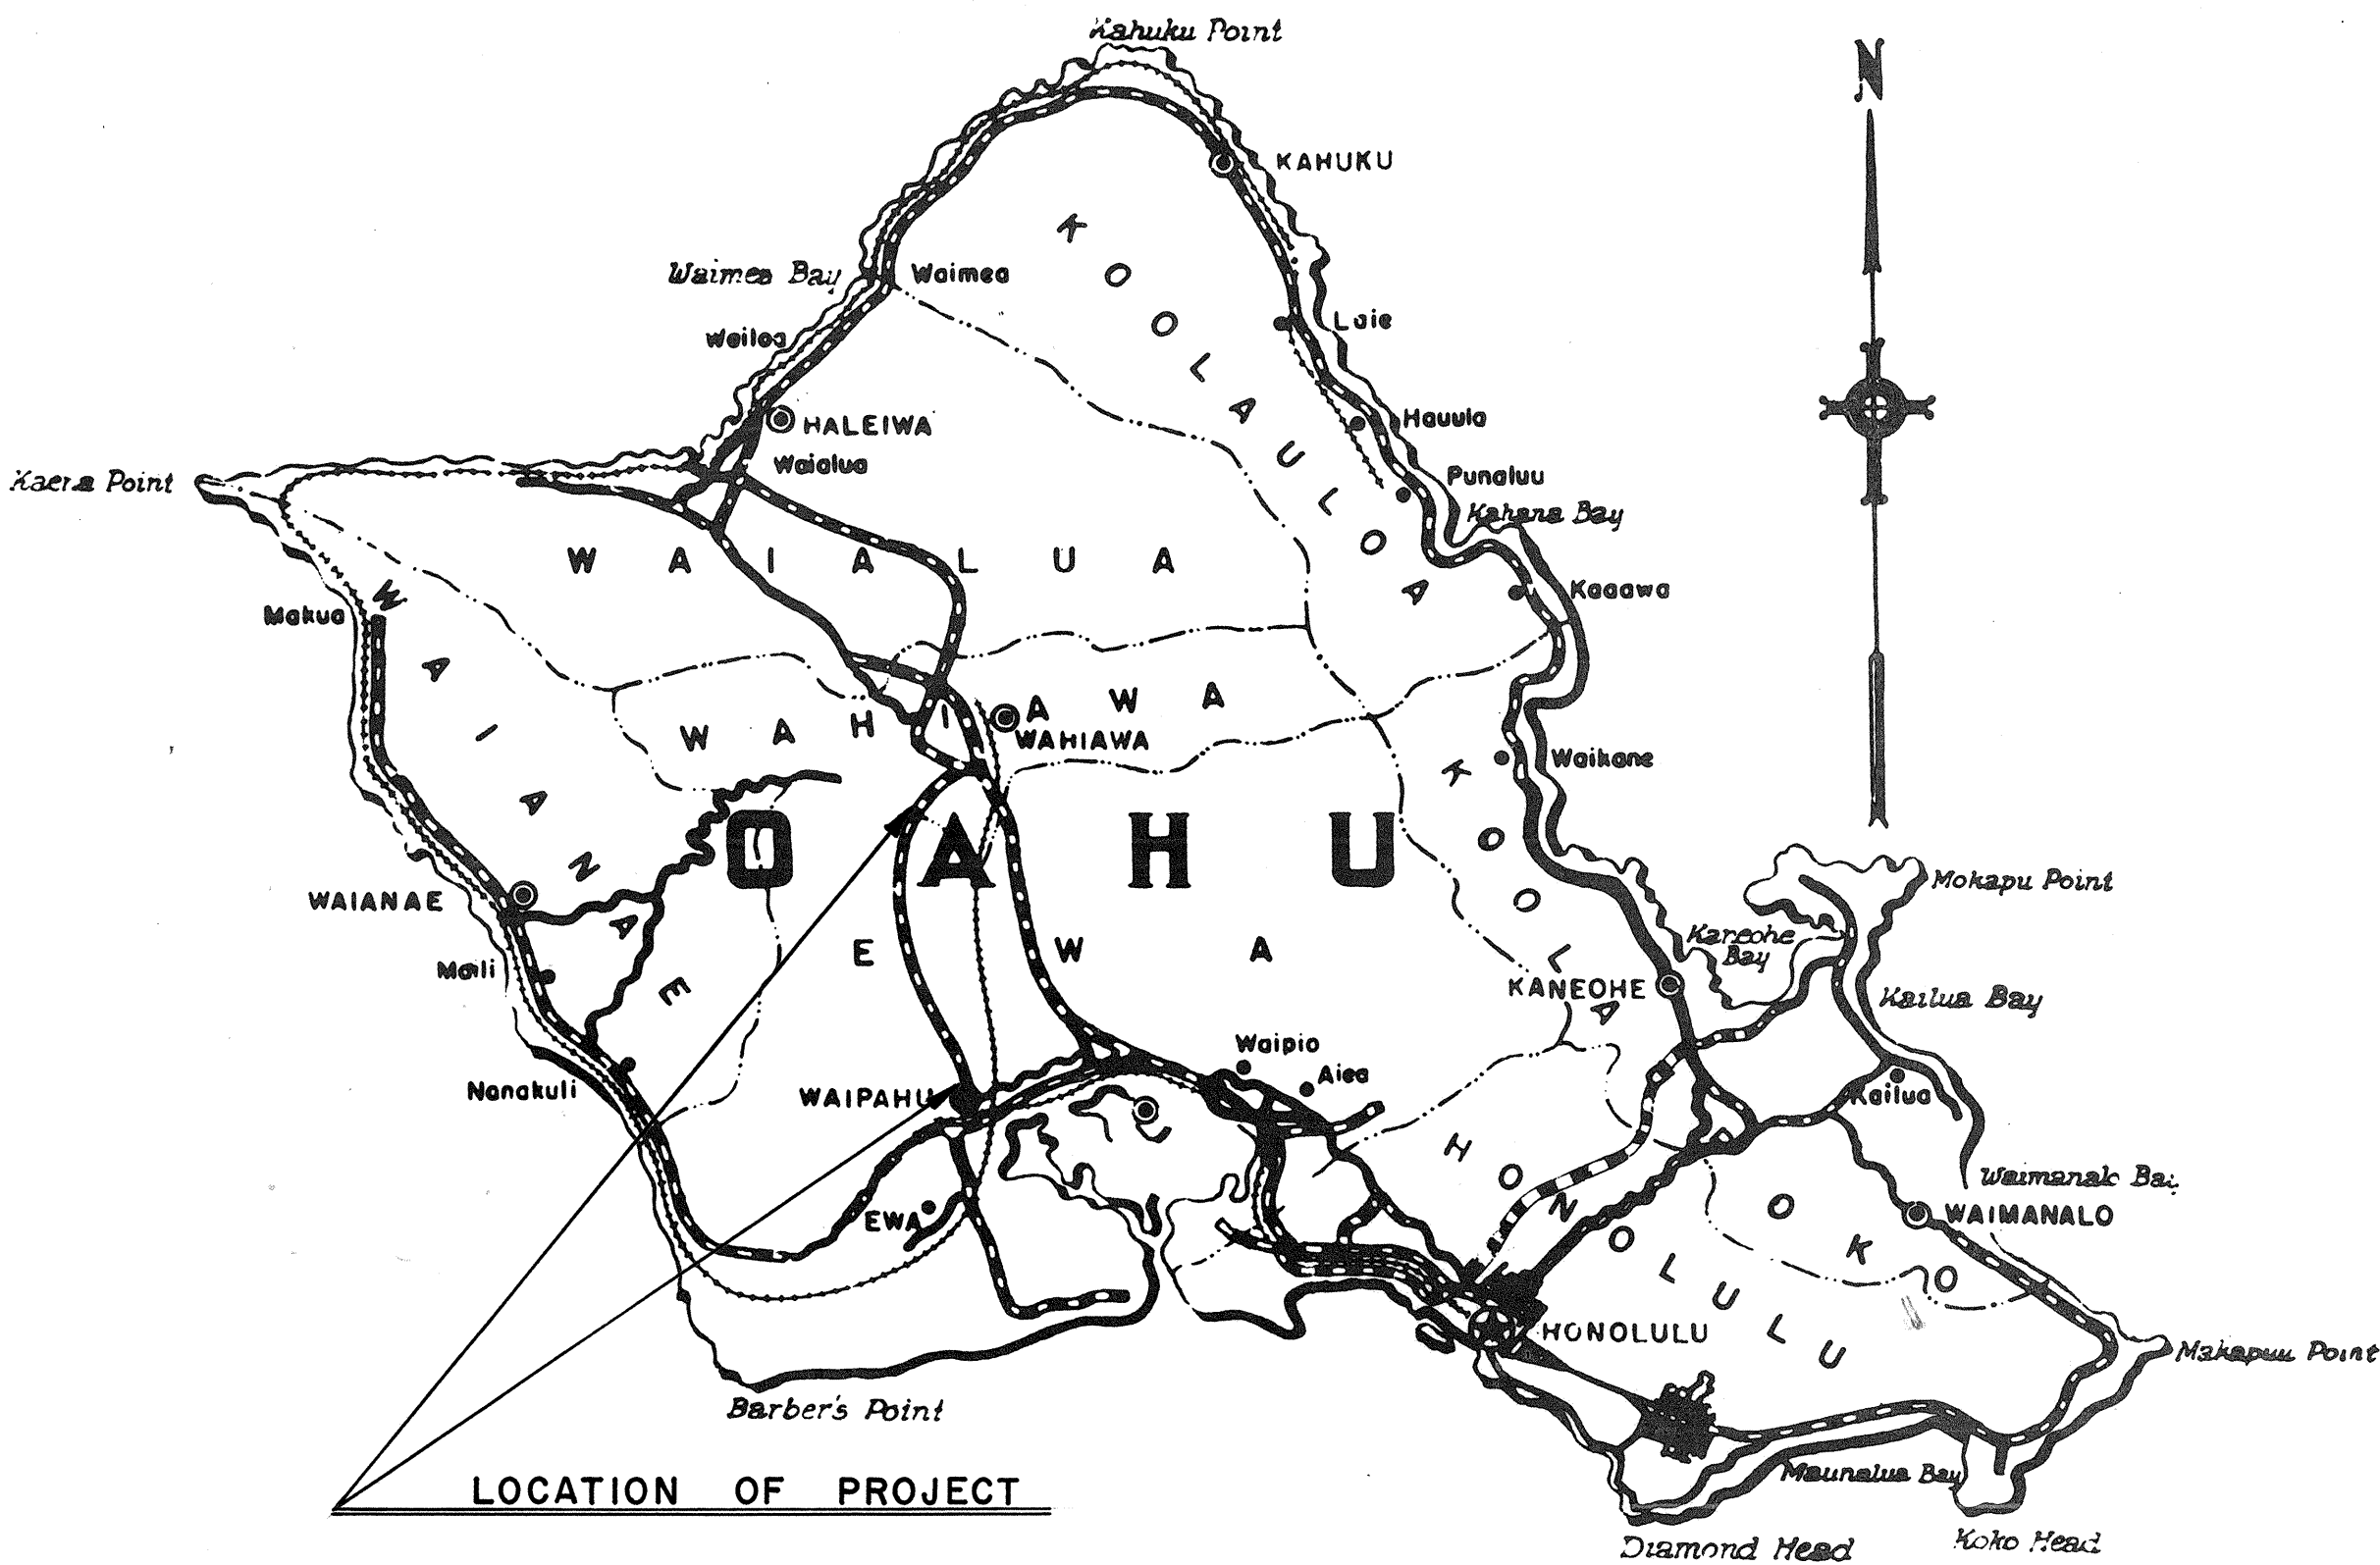

Federal Aid Projects Previously Constructed Or Under Construction

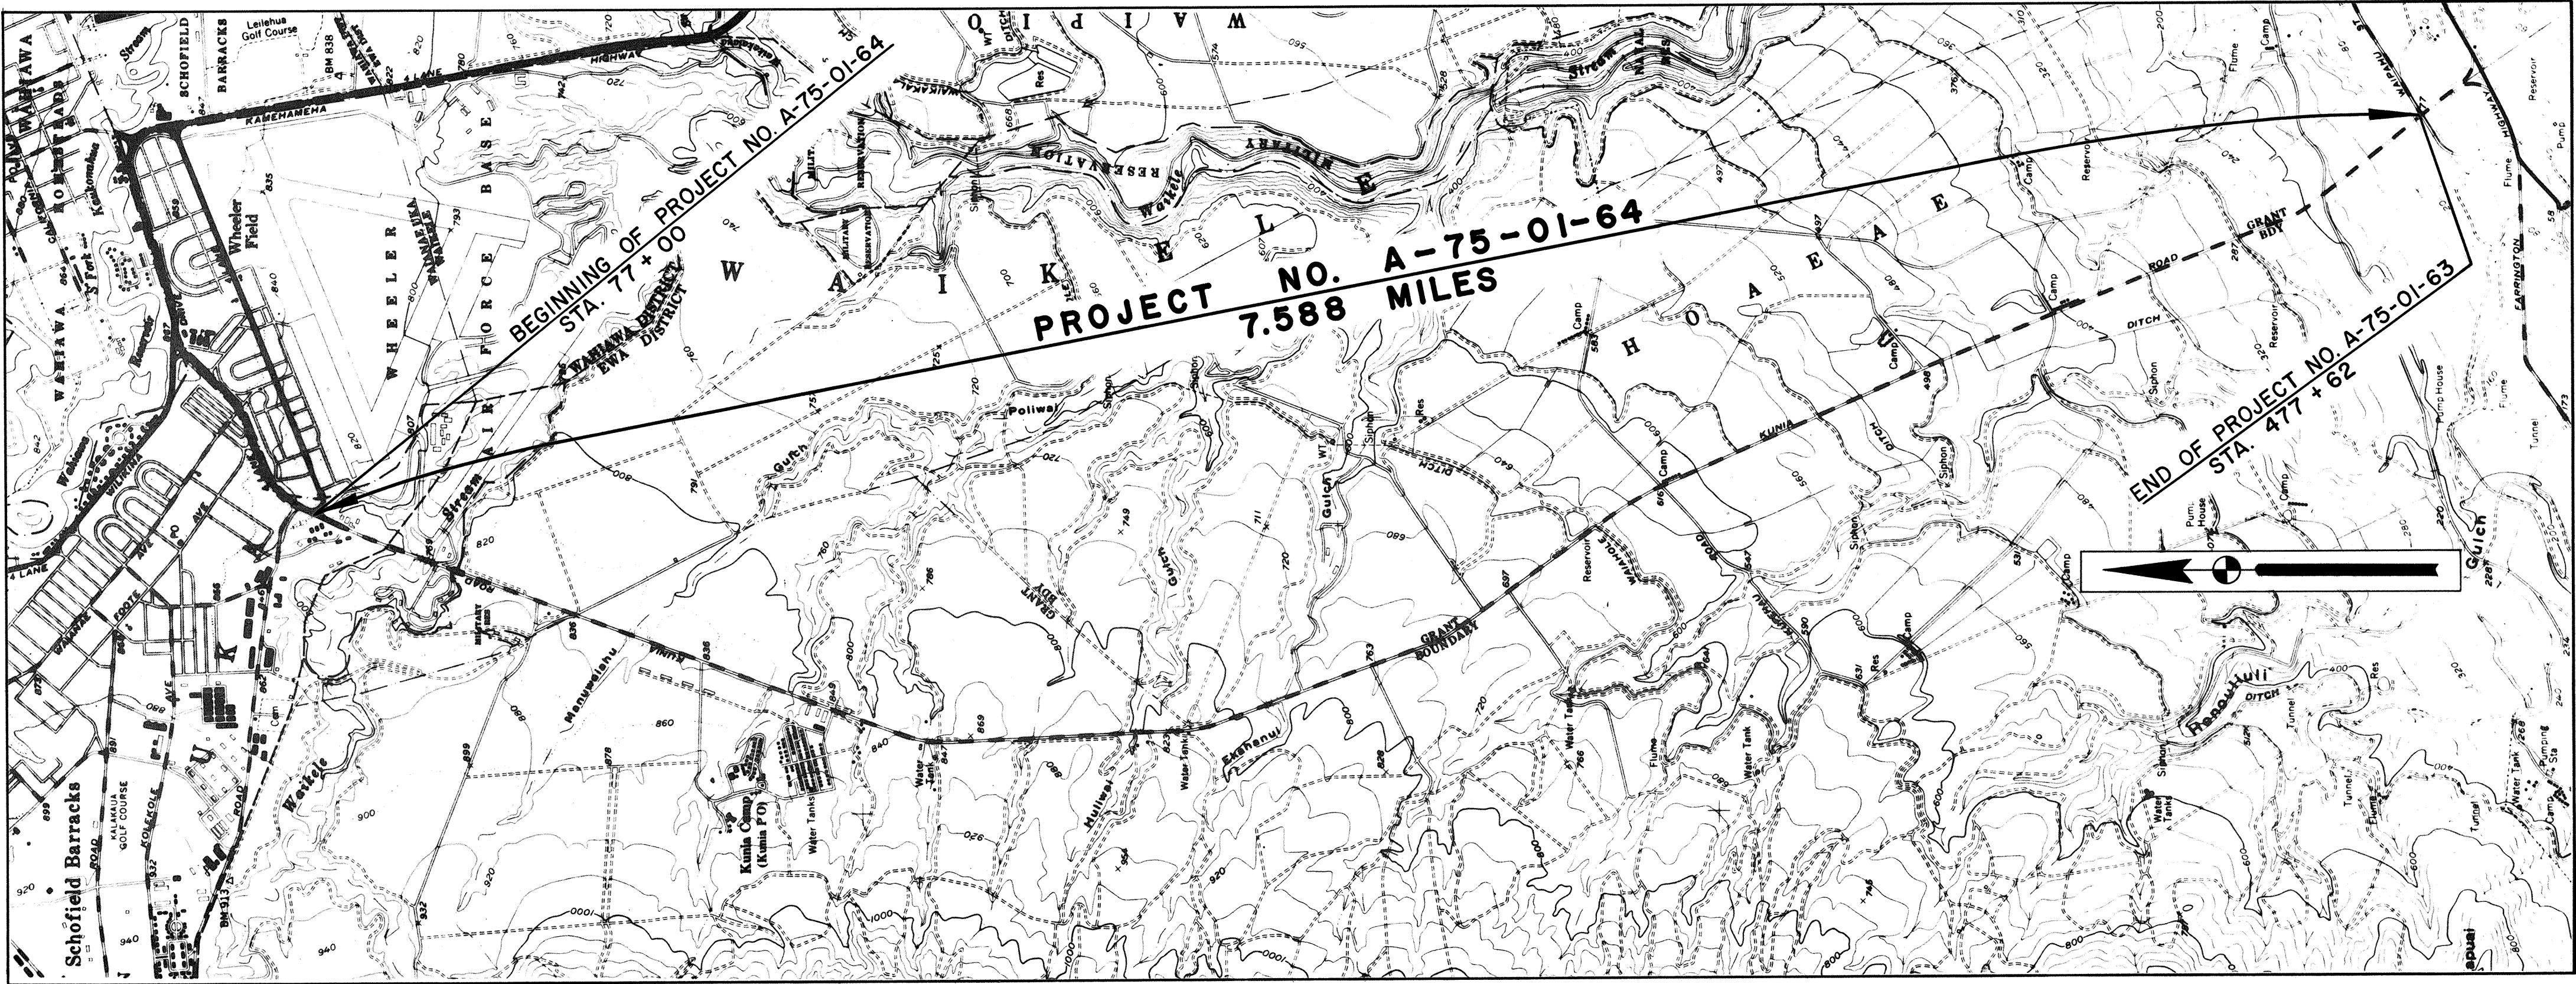

NOTE: ALL CHANGES MADE DURING  
CONSTRUCTION ARE SHOWN IN  
RED ON THESE TRACINGS AND  
ARE CHECKED BY



PROJECT ENGINEER

7/30/64
  
DATE

APPROVED:
  
  
DIRECTOR OF TRANSPORTATION

DATE: 30 Oct 65

ORIGINAL PLAN	DATE
DESIGNED BY	
TRACED BY	
QUANTITIES BY	
CHECKED BY	
NO.	

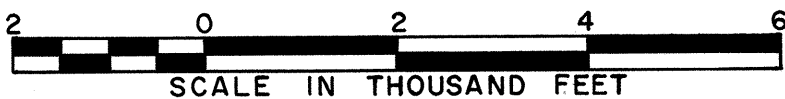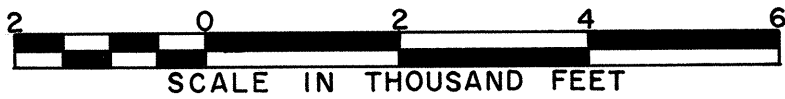

LAYOUT PLAN