
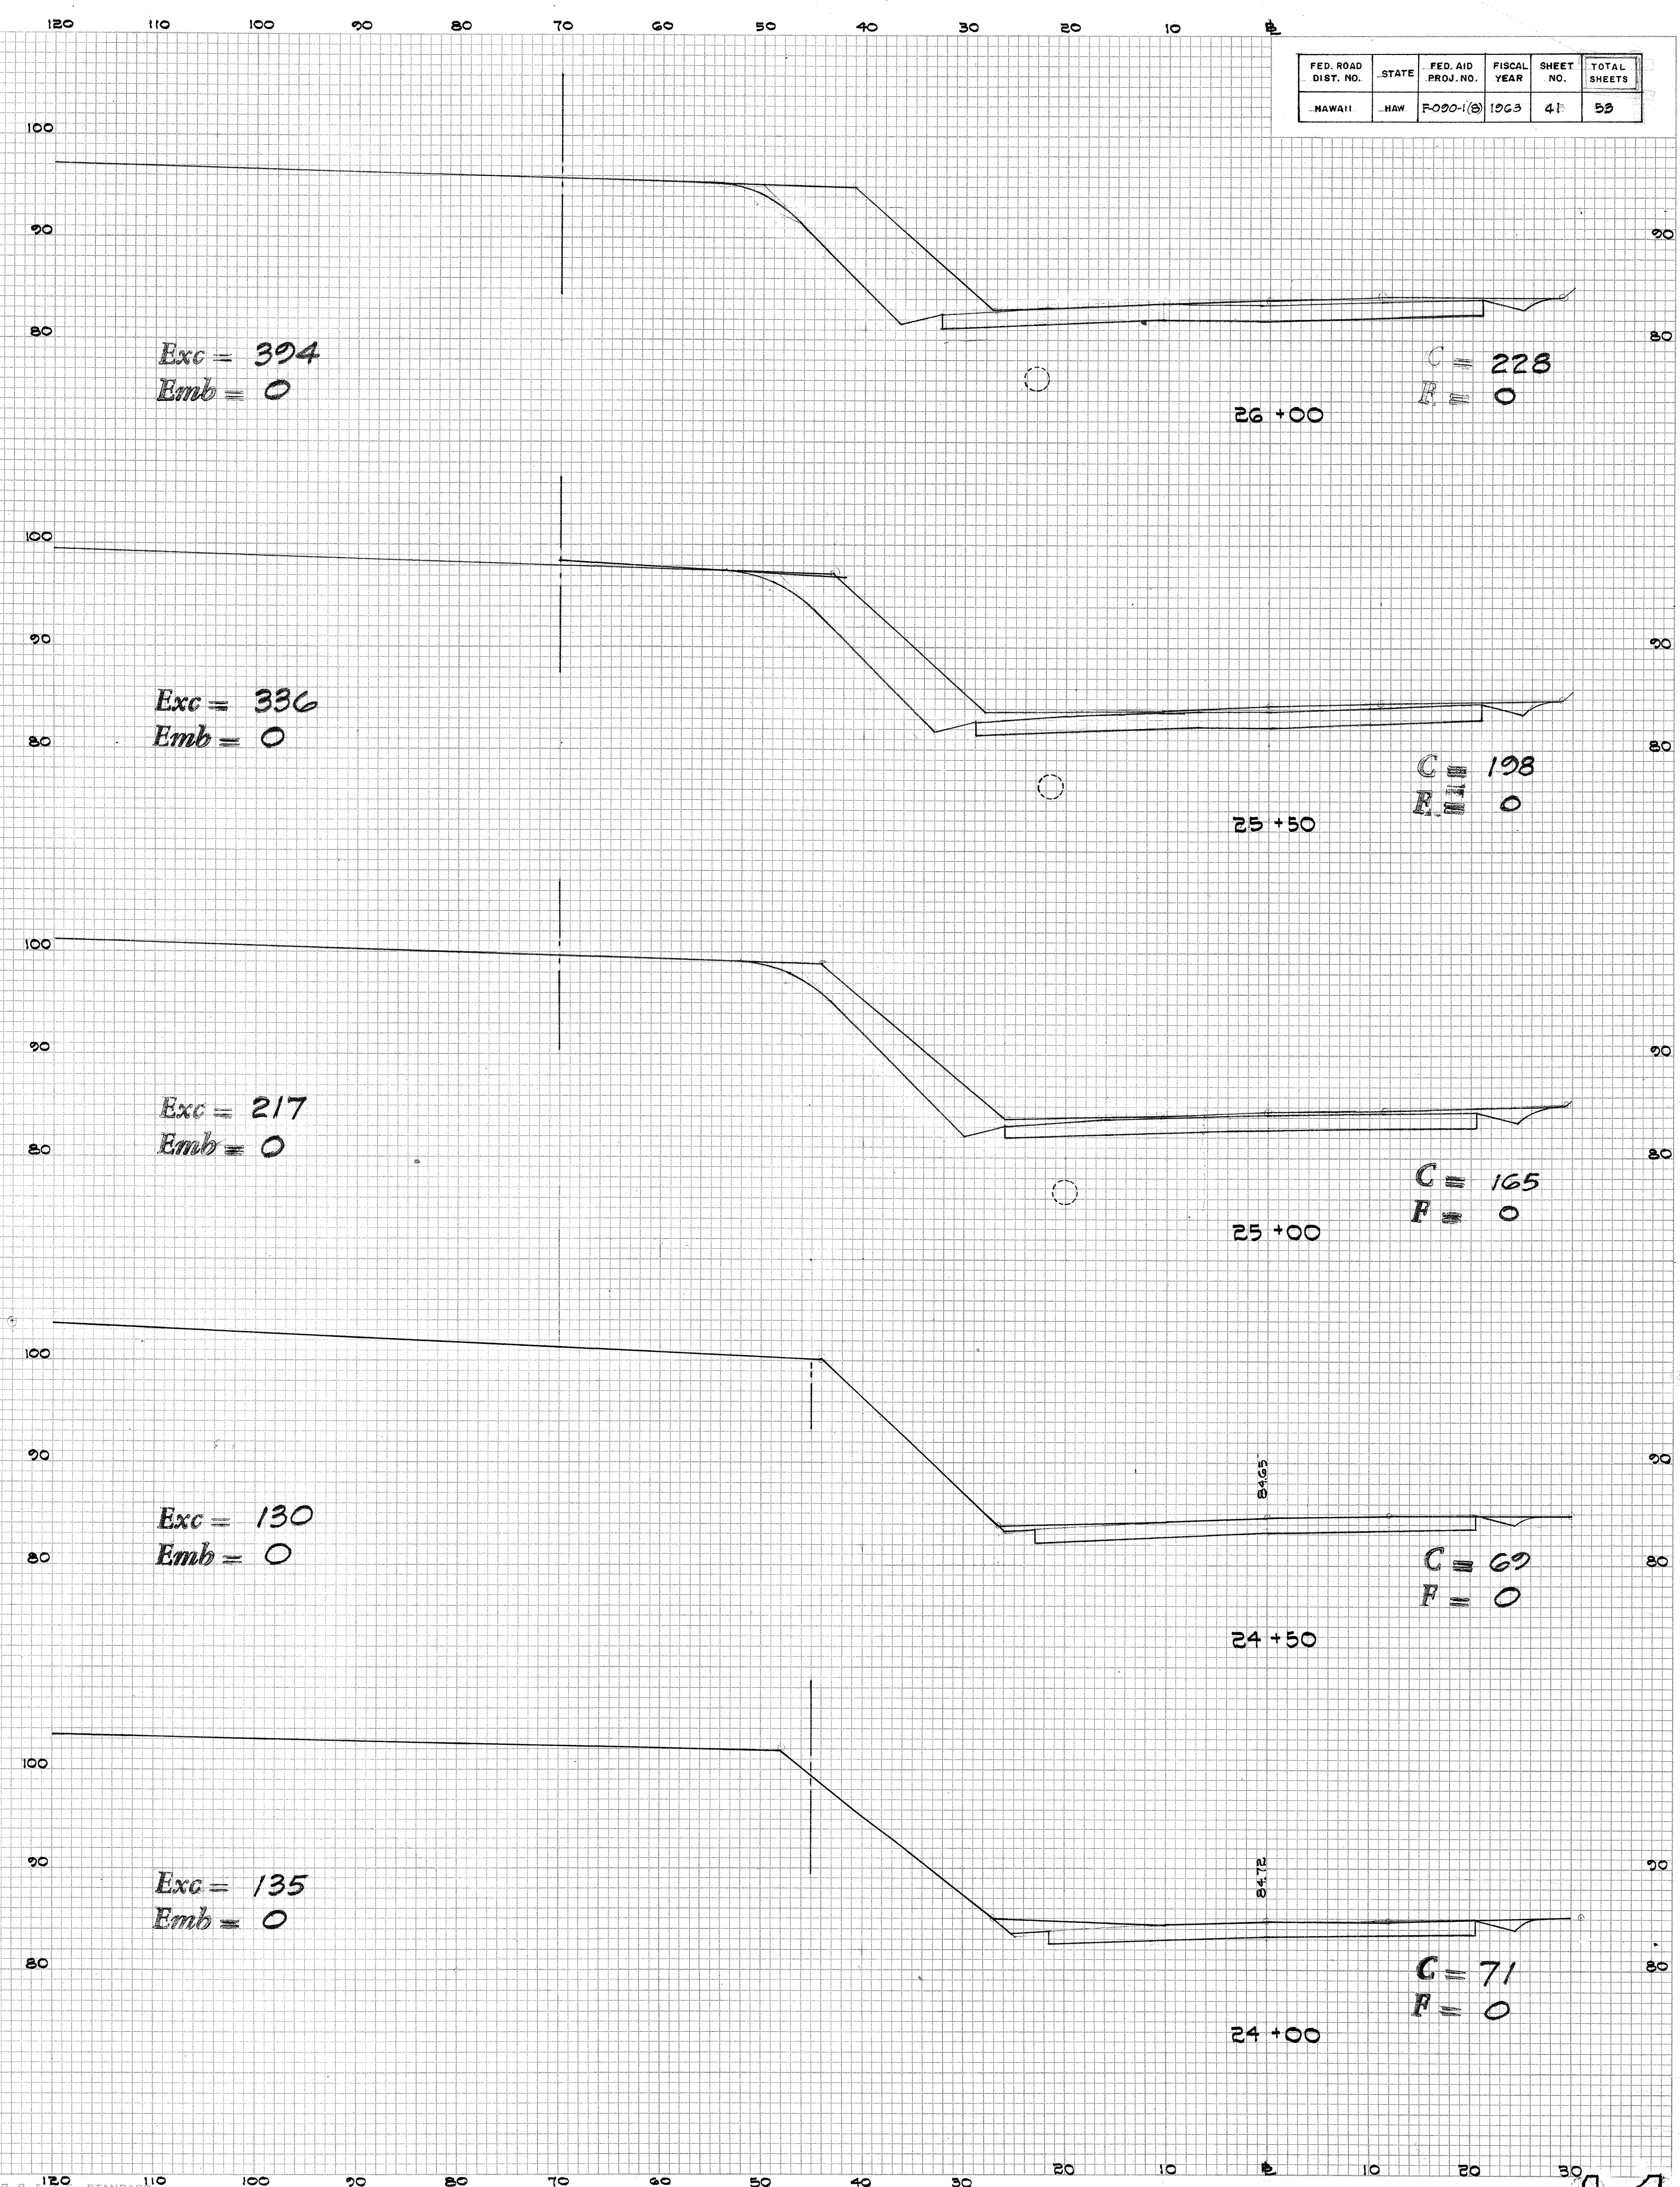




DATE	BY	REVIEWED	PLOTTED	TEMPLATE	NOTE BOOK	AREAS CHECKED
FINAL SURVEY						
NO.						

DATE	BY	REVIEWED	PLOTTED	TEMPLATE	NOTE BOOK	AREAS CHECKED
ORIGINAL SURVEY						
NO.						

FED. ROAD DIST. NO.	STATE	FED. AID PROJ. NO.	FISCAL YEAR	SHEET NO.	TOTAL SHEETS
HAWAII	HAW	F-000-1(8)	1963	41	53

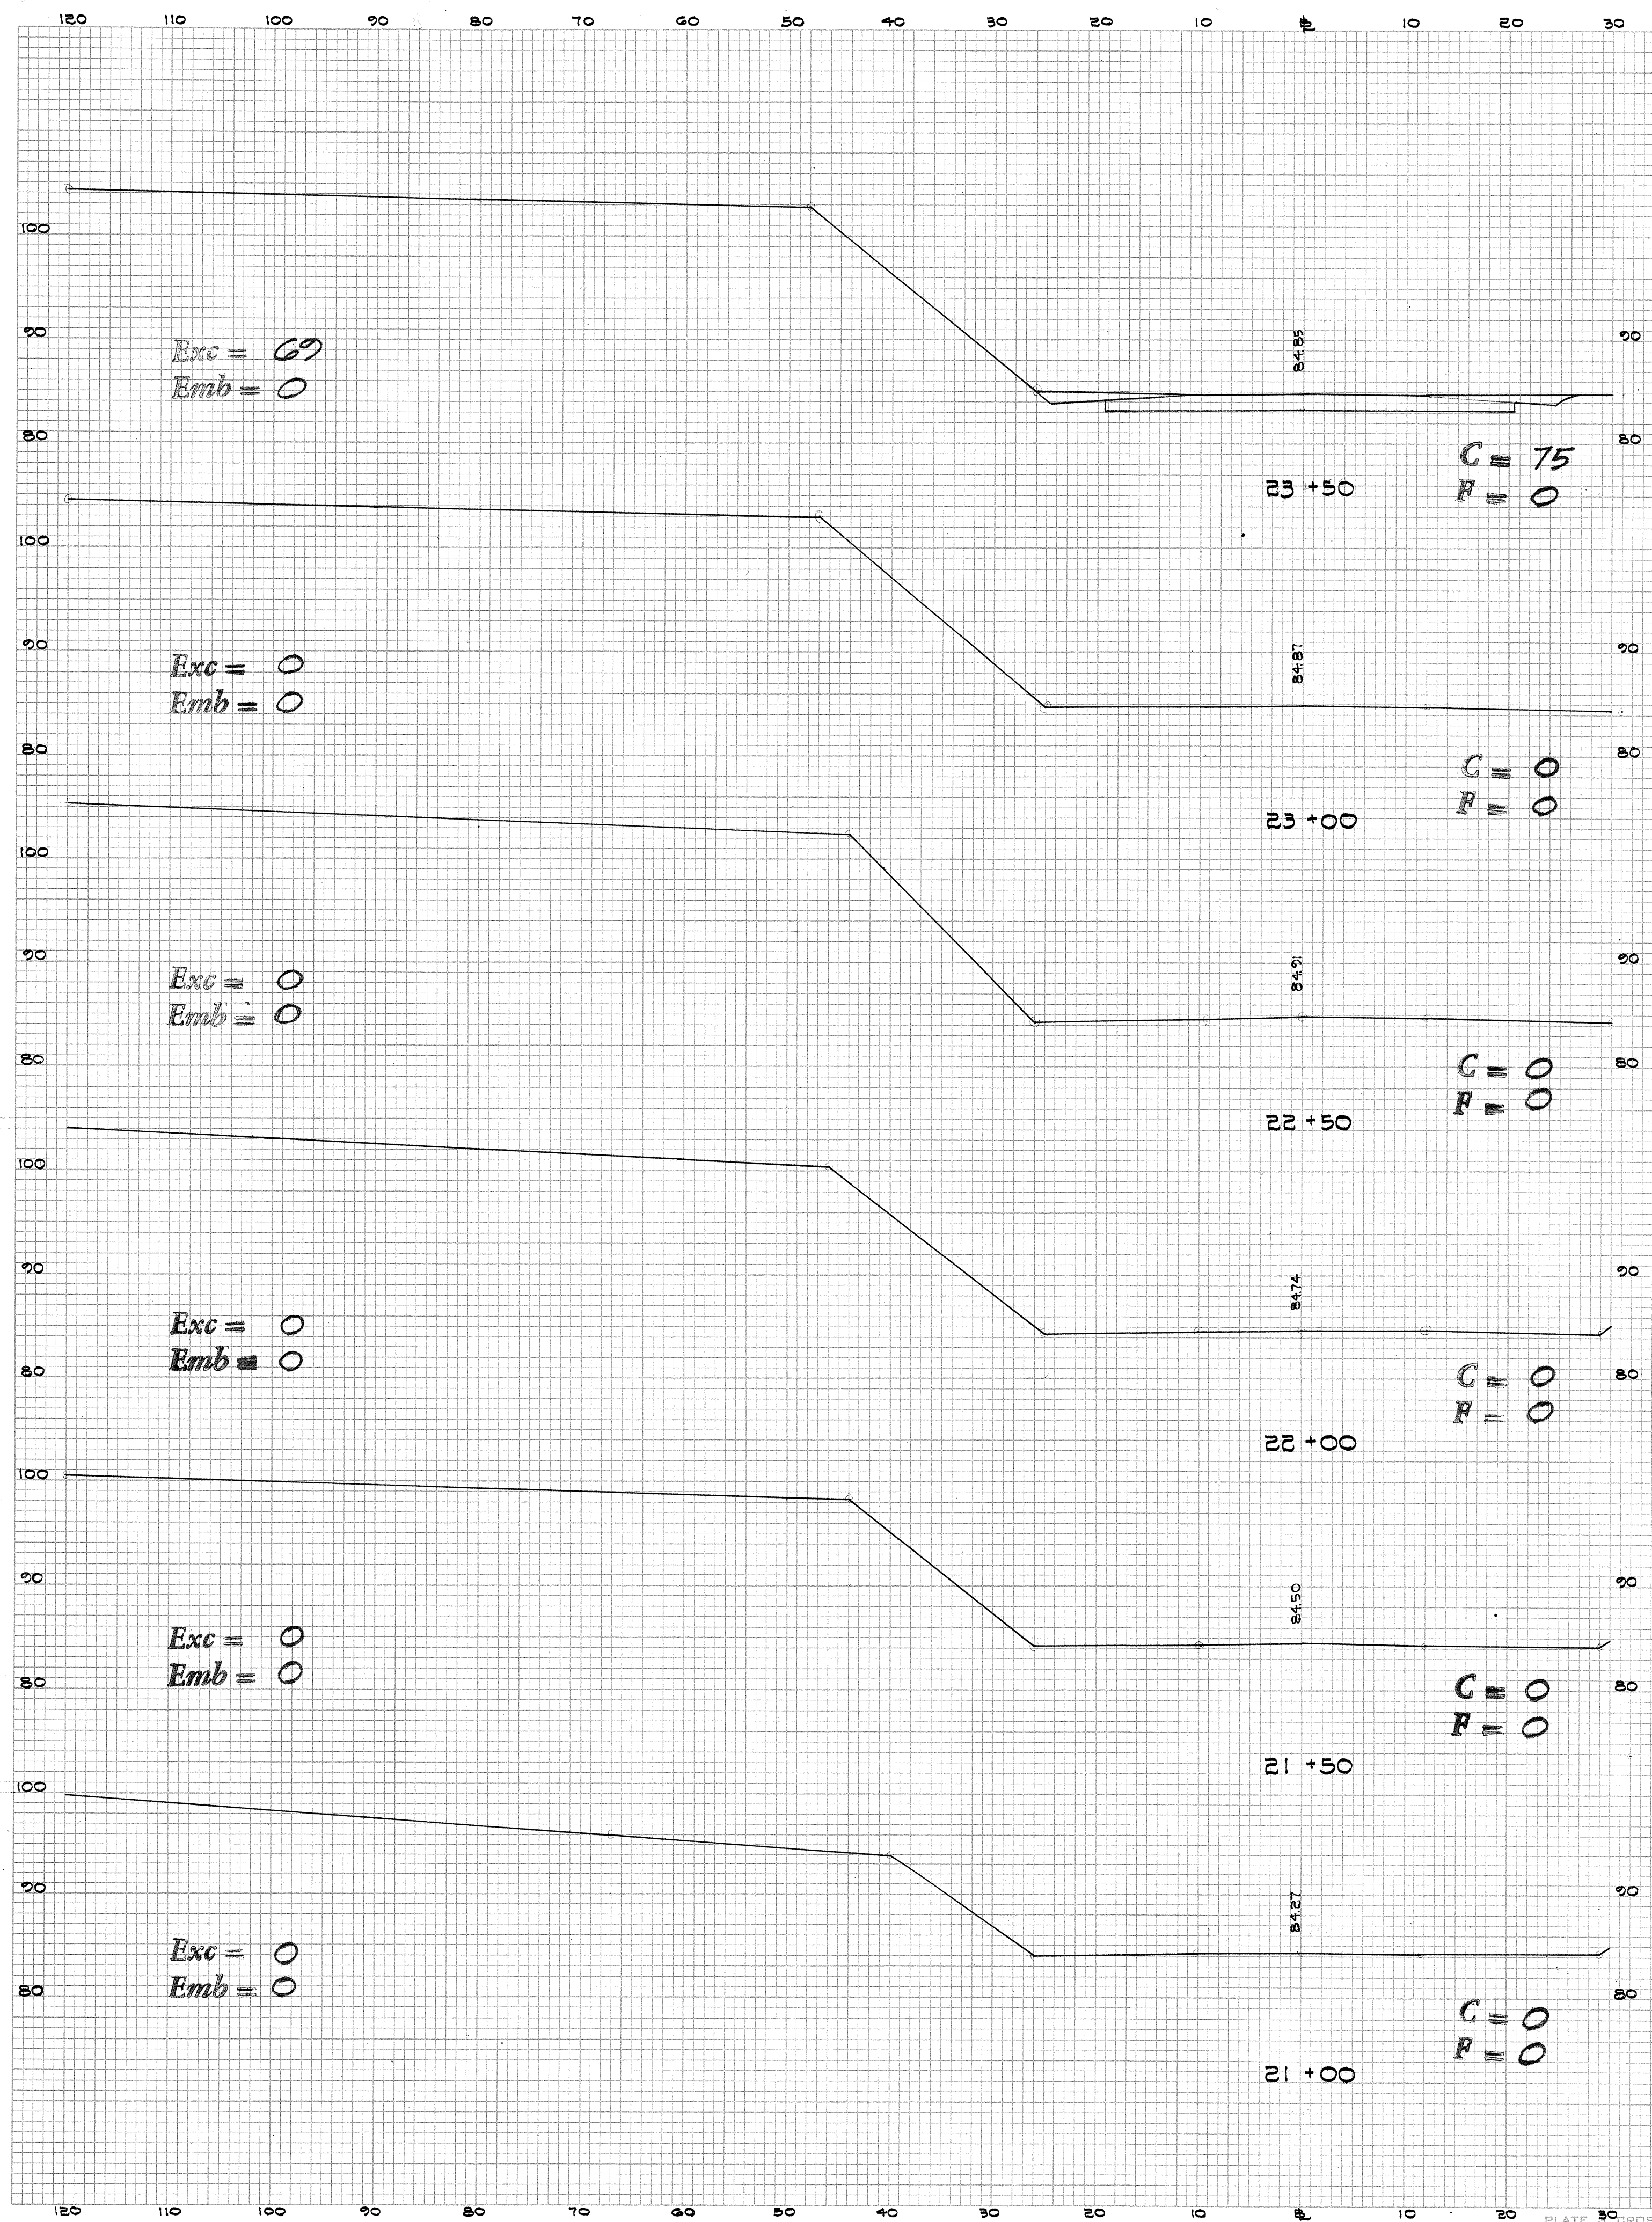



FED. ROAD DIST. NO.	STATE	FED. AID PROJ. NO.	FISCAL YEAR	SHEET NO.	TOTAL SHEETS
HAWAII	HAW	F090-1(2)	1963	42	55

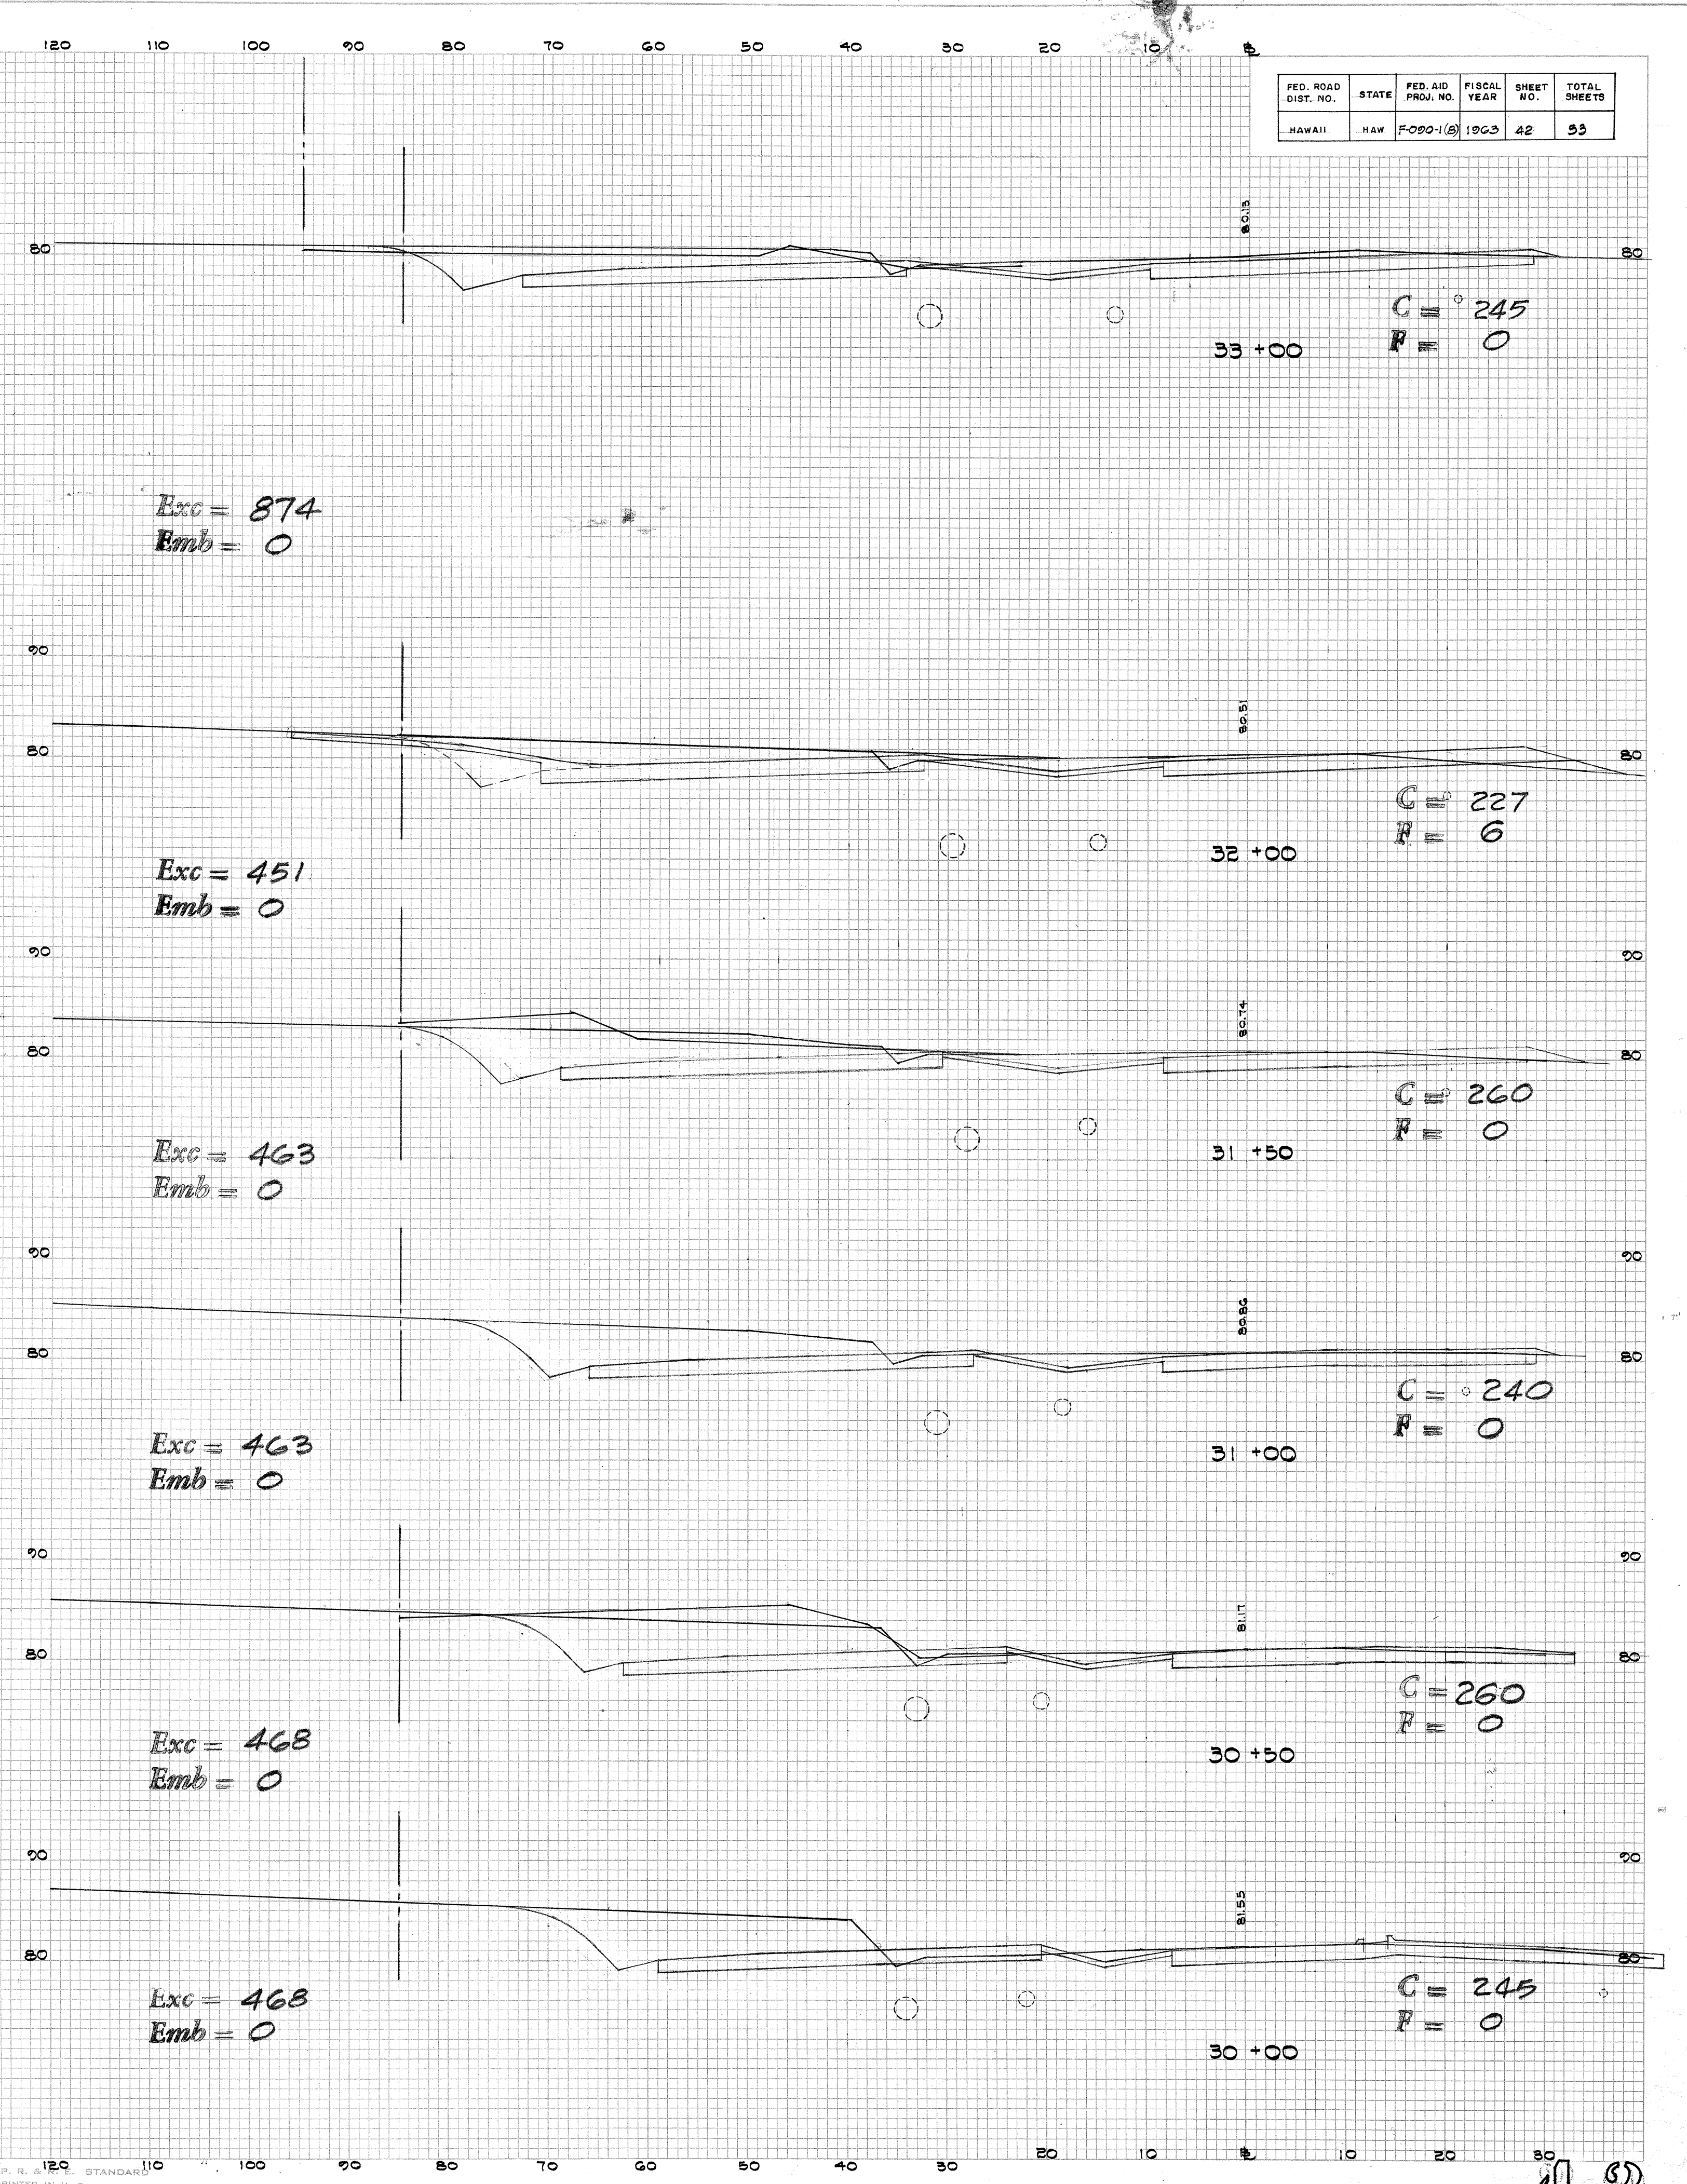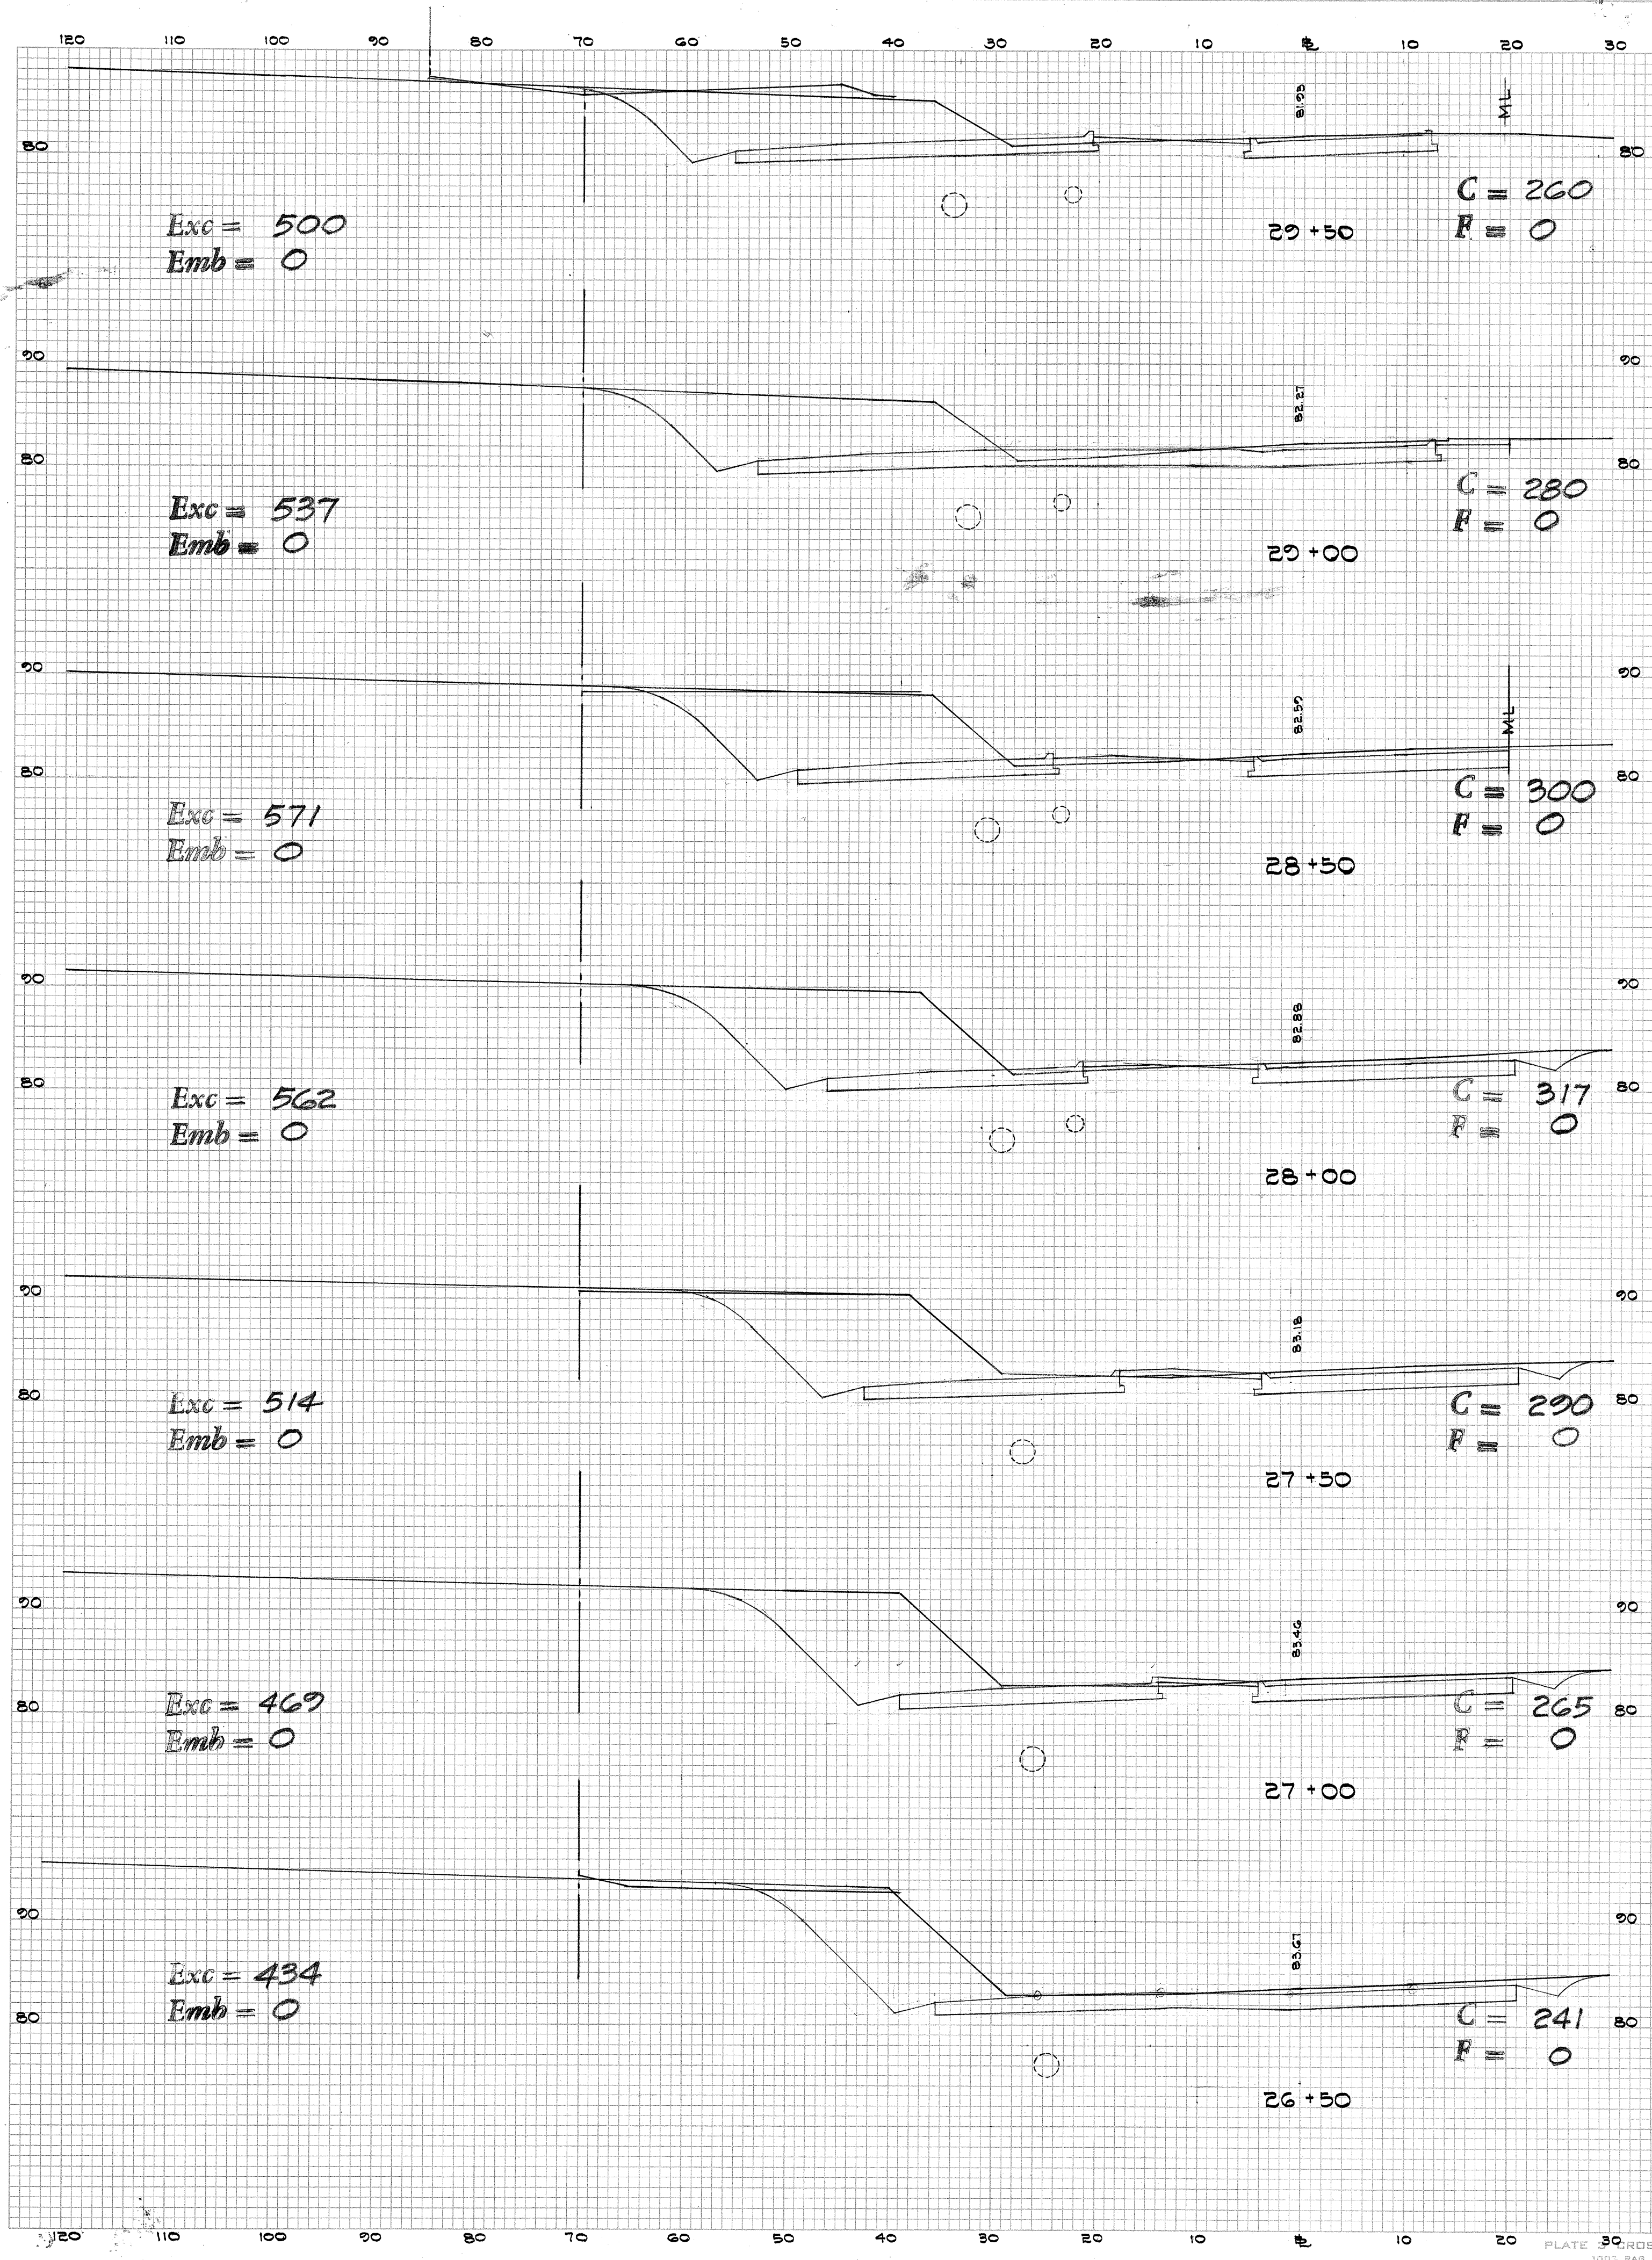

DATE	BY	NO.
FINAL SURVEY	SURVEYED	PLOTTED
	NOTE BOOK	TEMPLATE
	AREAS CHECKED	

DATE	BY	NO.
ORIGINAL SURVEY	SURVEYED	PLOTTED
	NOTE BOOK	TEMPLATE
	AREAS CHECKED	



FED. ROAD DIST. NO.	STATE	FED. AID PROJ. NO.	FISCAL YEAR	SHEET NO.	TOTAL SHEETS
HAWAII	HAW	F000-1(8)	1963	43	53

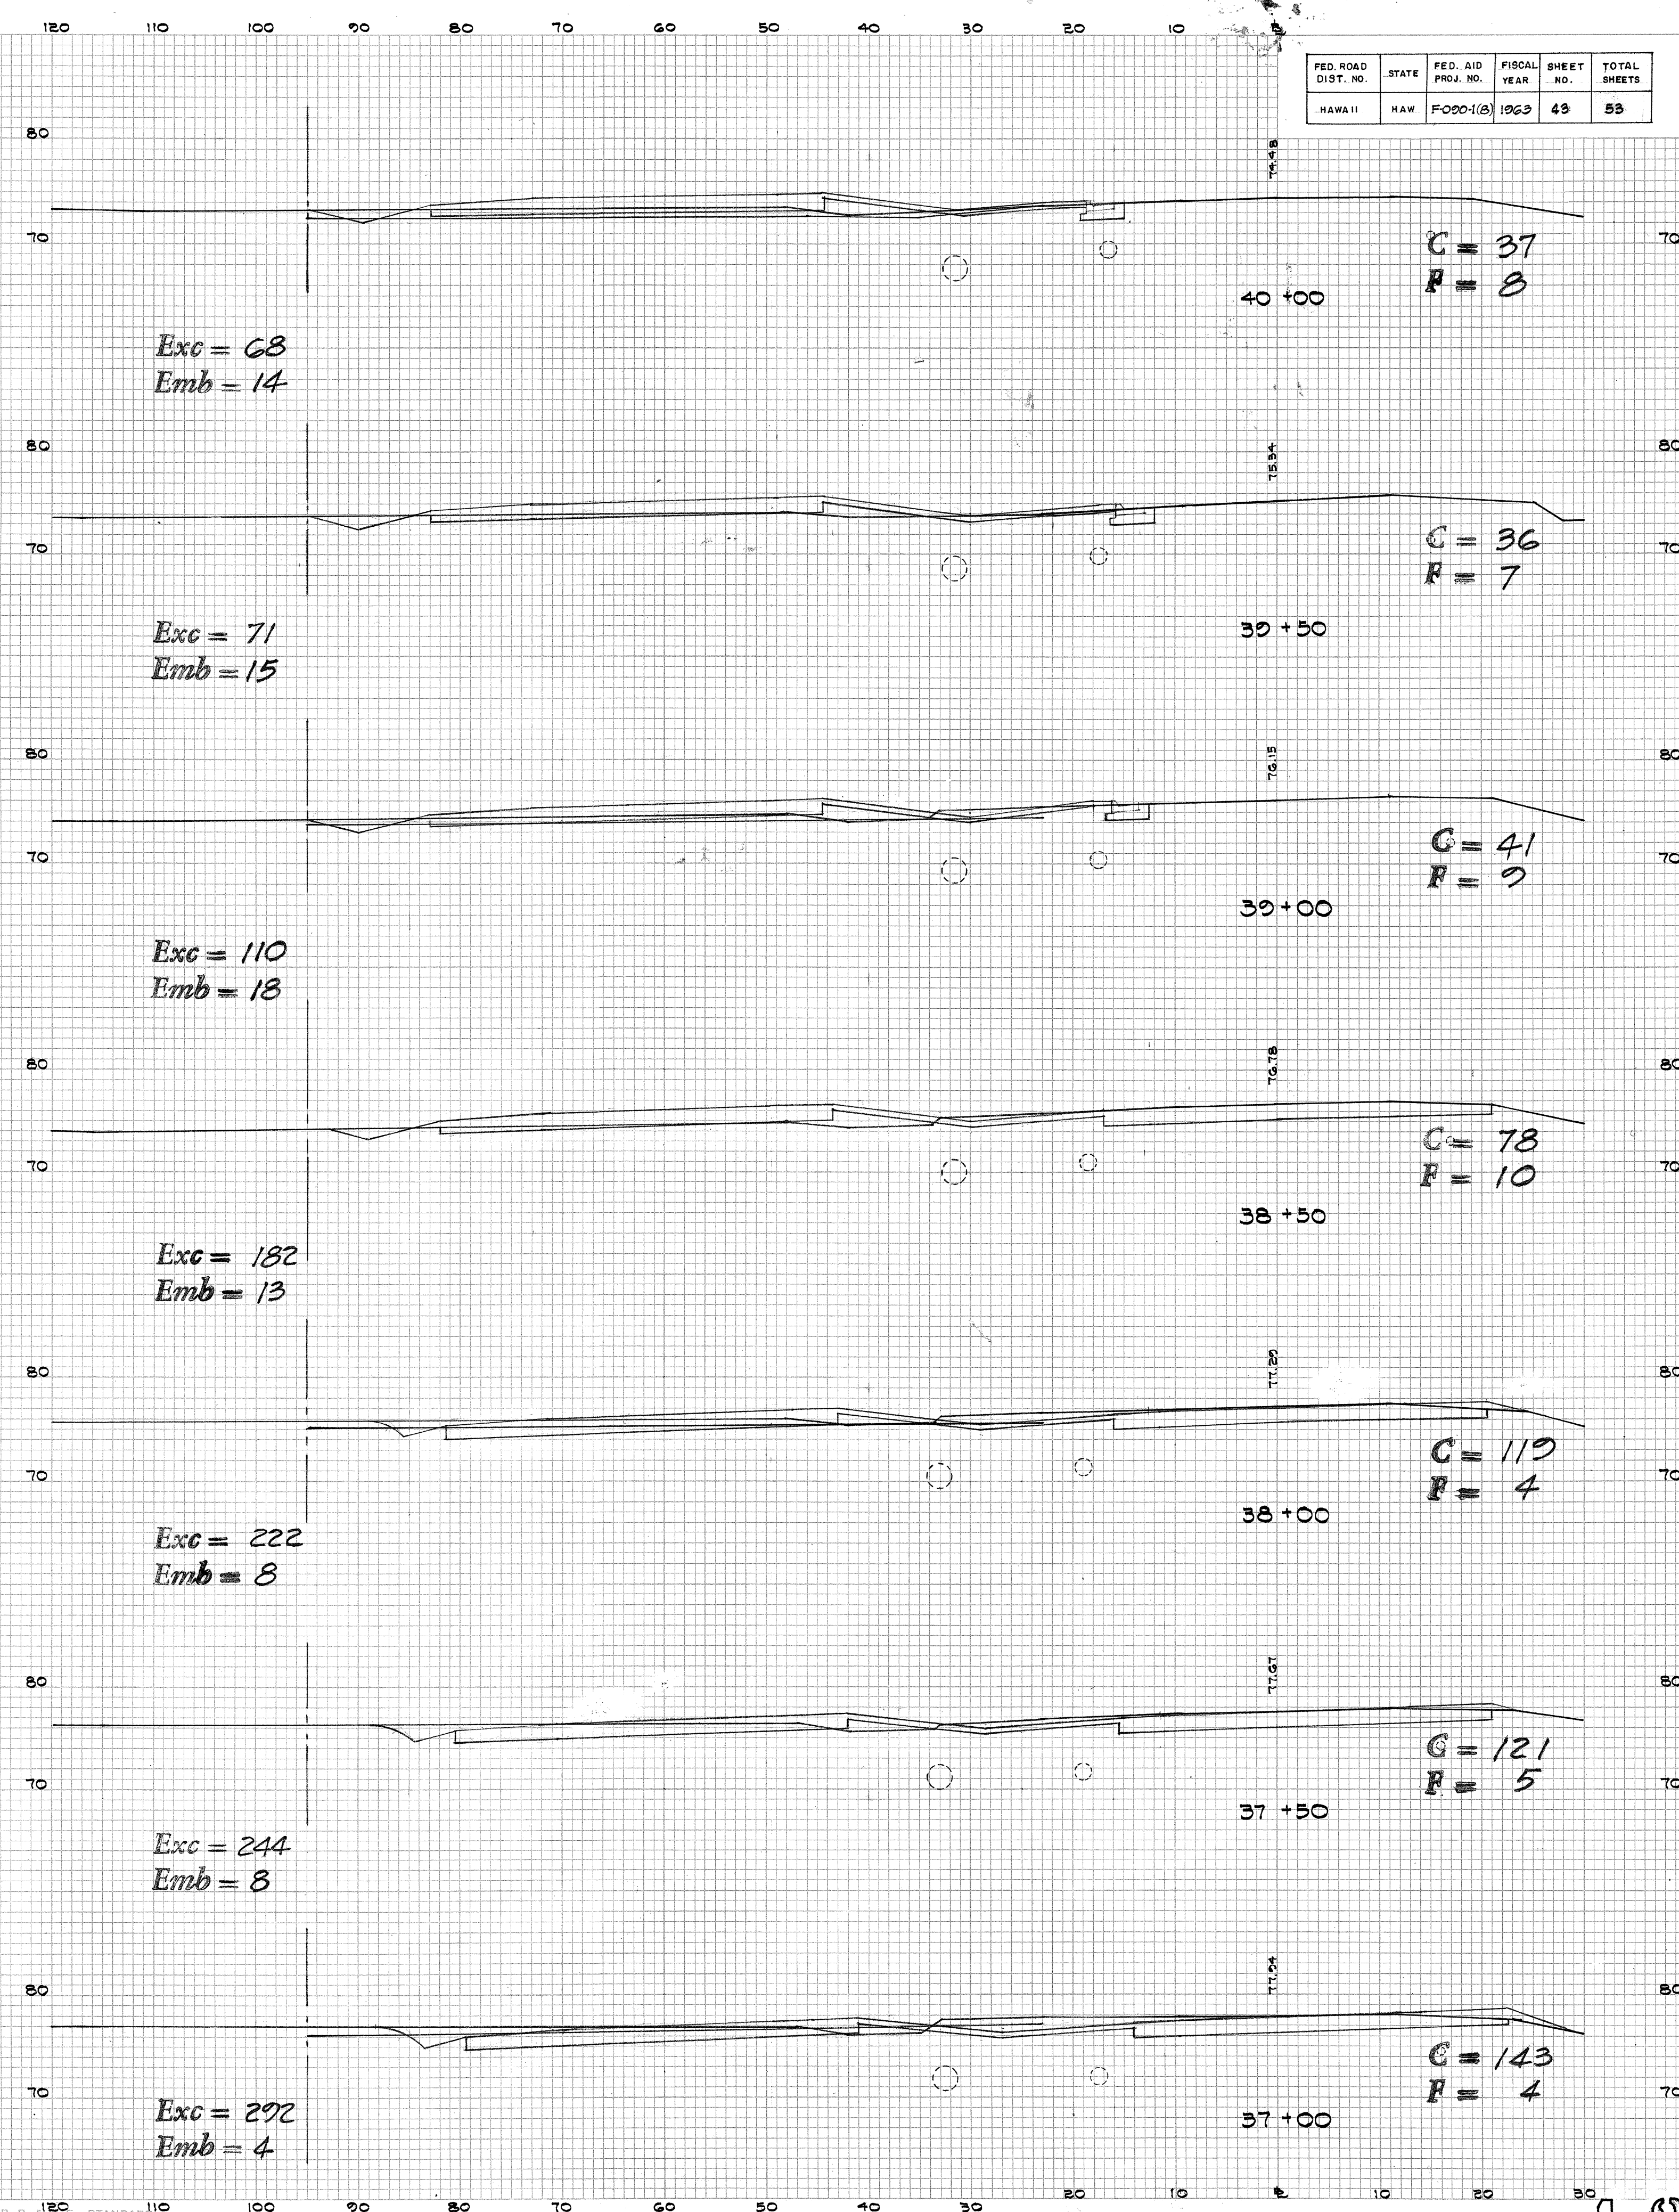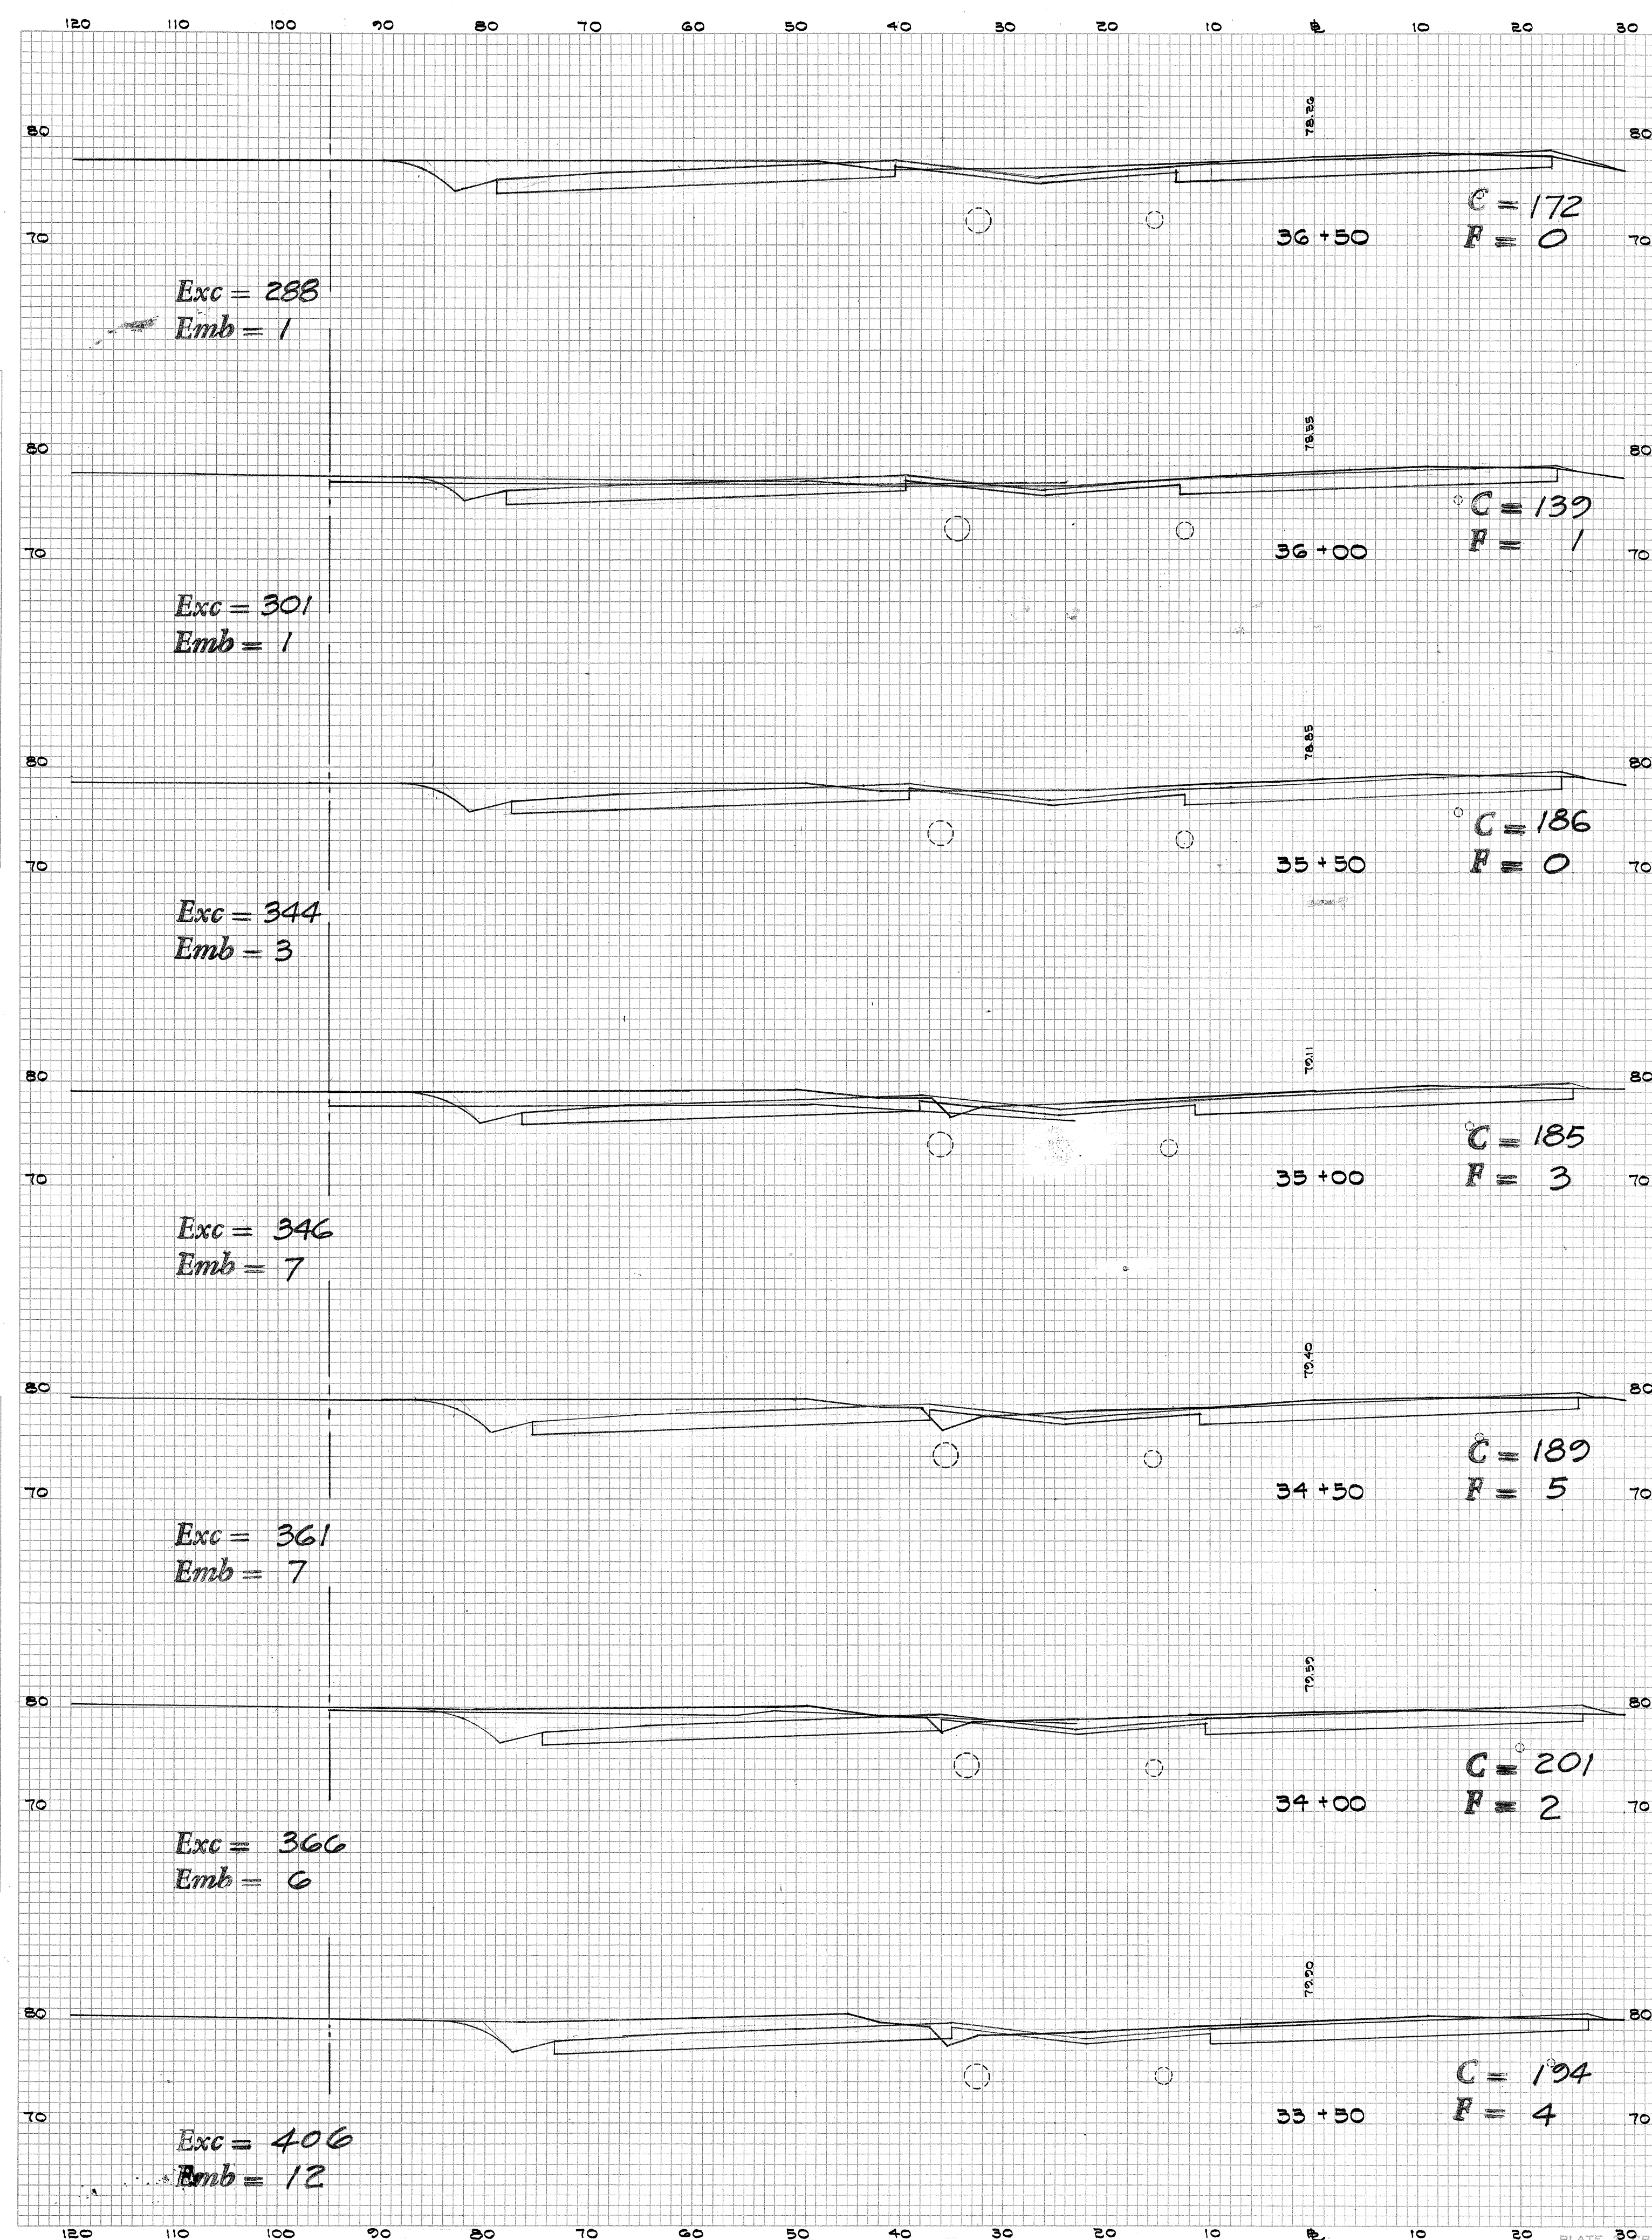

FED. ROAD DIST. NO.	STATE	FED. AID PROJ. NO.	FISCAL YEAR	SHEET NO.	TOTAL SHEETS
HAWAII	HAW	F-020-1(8)	1963	44	53

DATE	BY	FINAL SURVEY	REVIEWED	DATE	BY
		PLANNED	PLANNED		
		NOTED	NOTED		
		ASSESSED	ASSESSED		
		CHECKED	CHECKED		



DATE	BY	ORIGINAL SURVEY	REVIEWED	DATE	BY
		PLANNED	PLANNED		
		NOTED	NOTED		
		ASSESSED	ASSESSED		
		CHECKED	CHECKED		

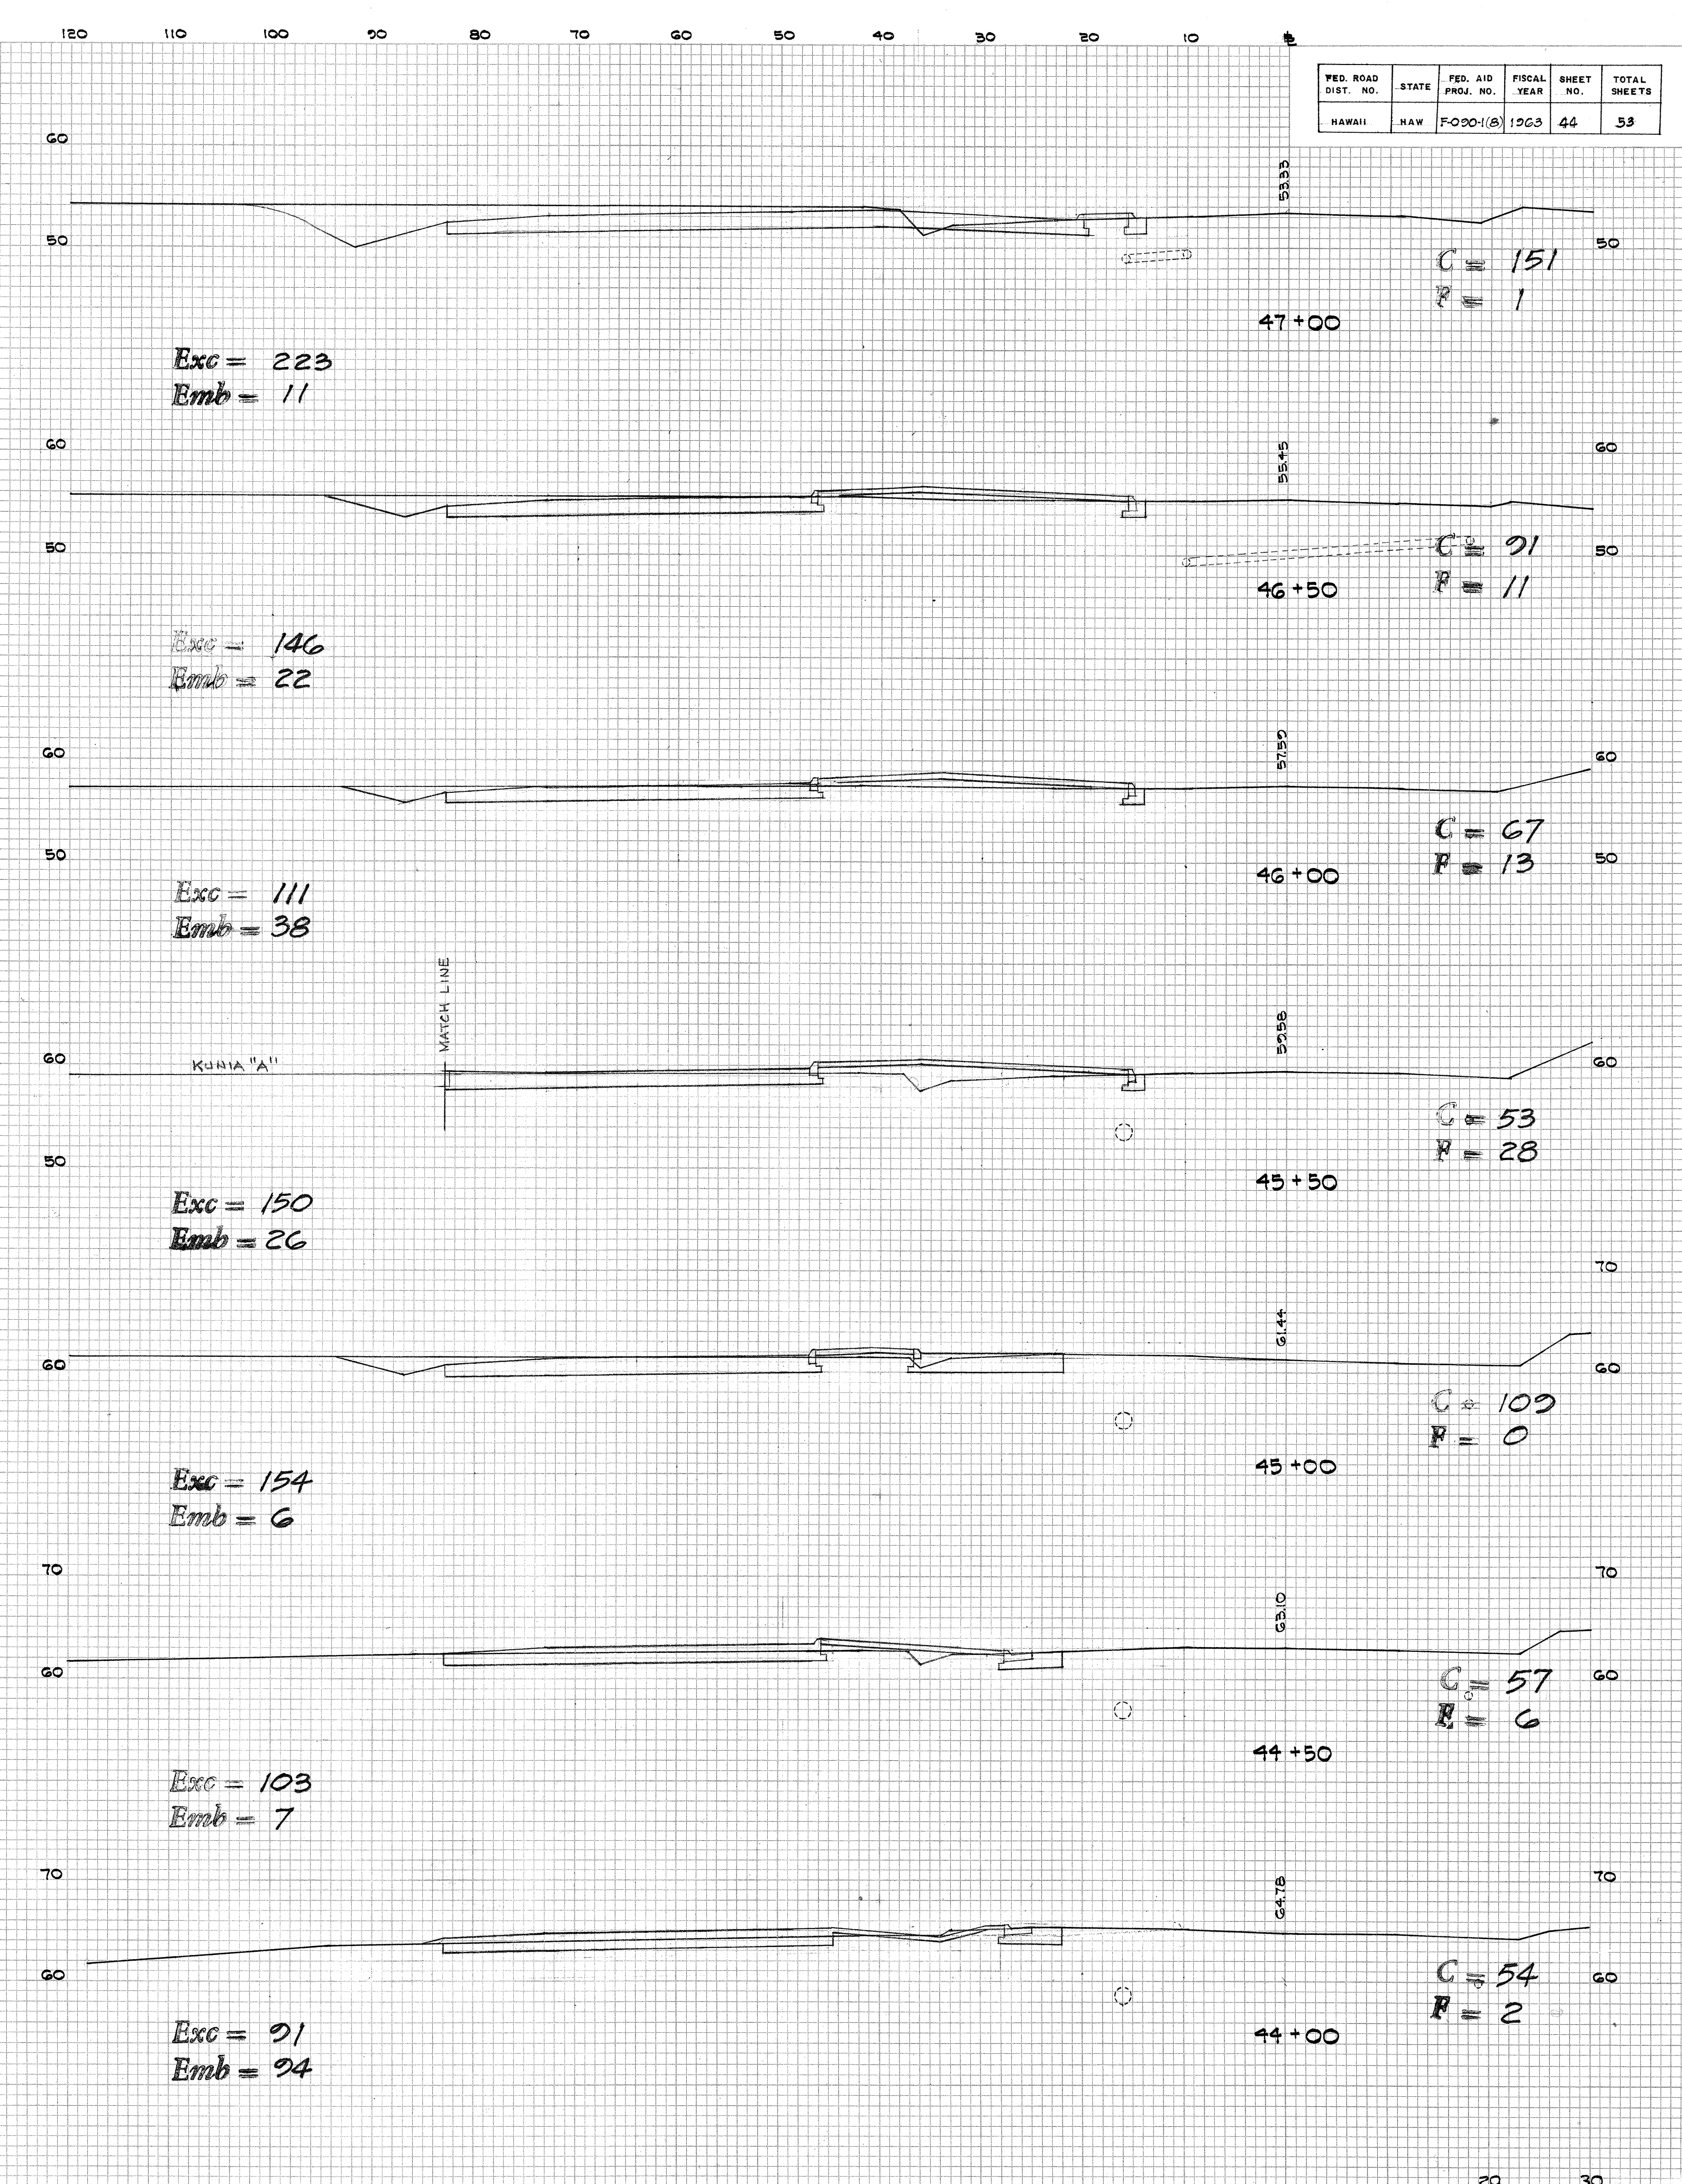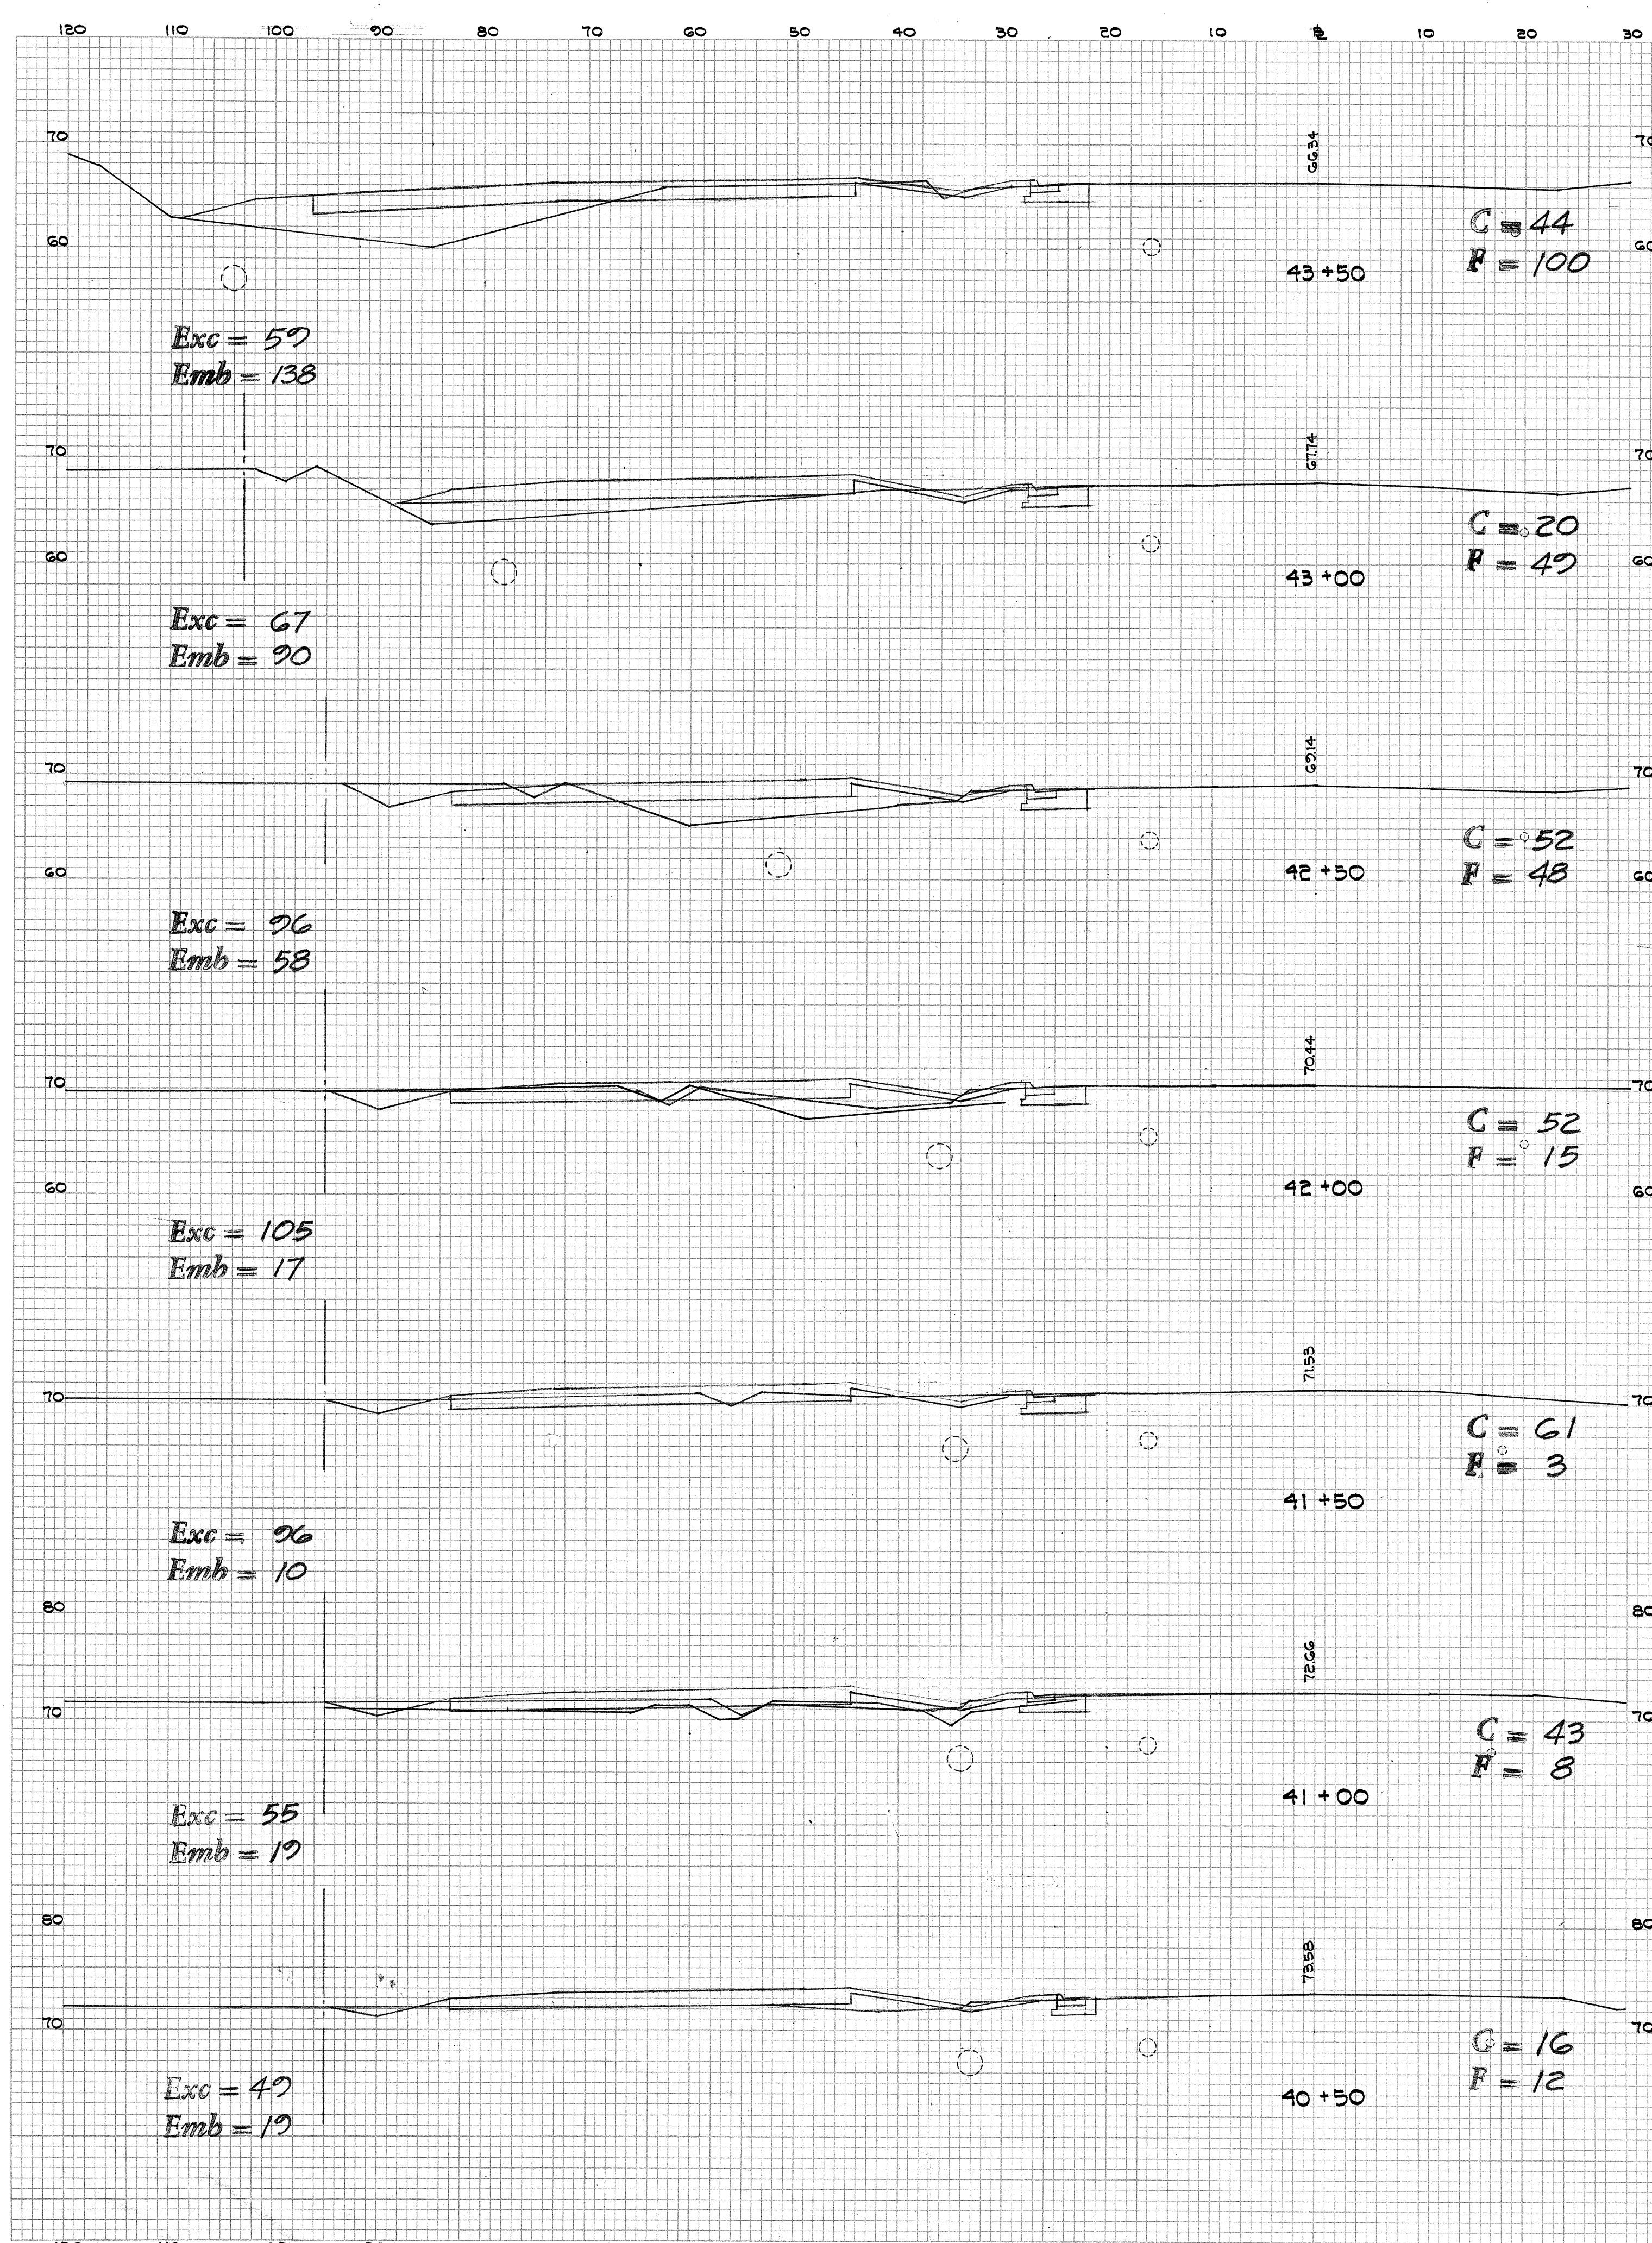

DATE	BY	SURVEYED	PLOTTED	TEMPERATURE	AREAS CHECKED
FINAL					
SURVEY					
NOTE BOOK					
NO.					

DATE	BY	SURVEYED	PLOTTED	TEMPERATURE	AREAS CHECKED
ORIGINAL					
SURVEY					
NOTE BOOK					
NO.					



FED. ROAD DIST. NO.	STATE	FED. AID PROJ. NO.	FISCAL YEAR	SHEET NO.	TOTAL SHEETS
HAWAII	HAW.	F000-1(8)	1963	43	53

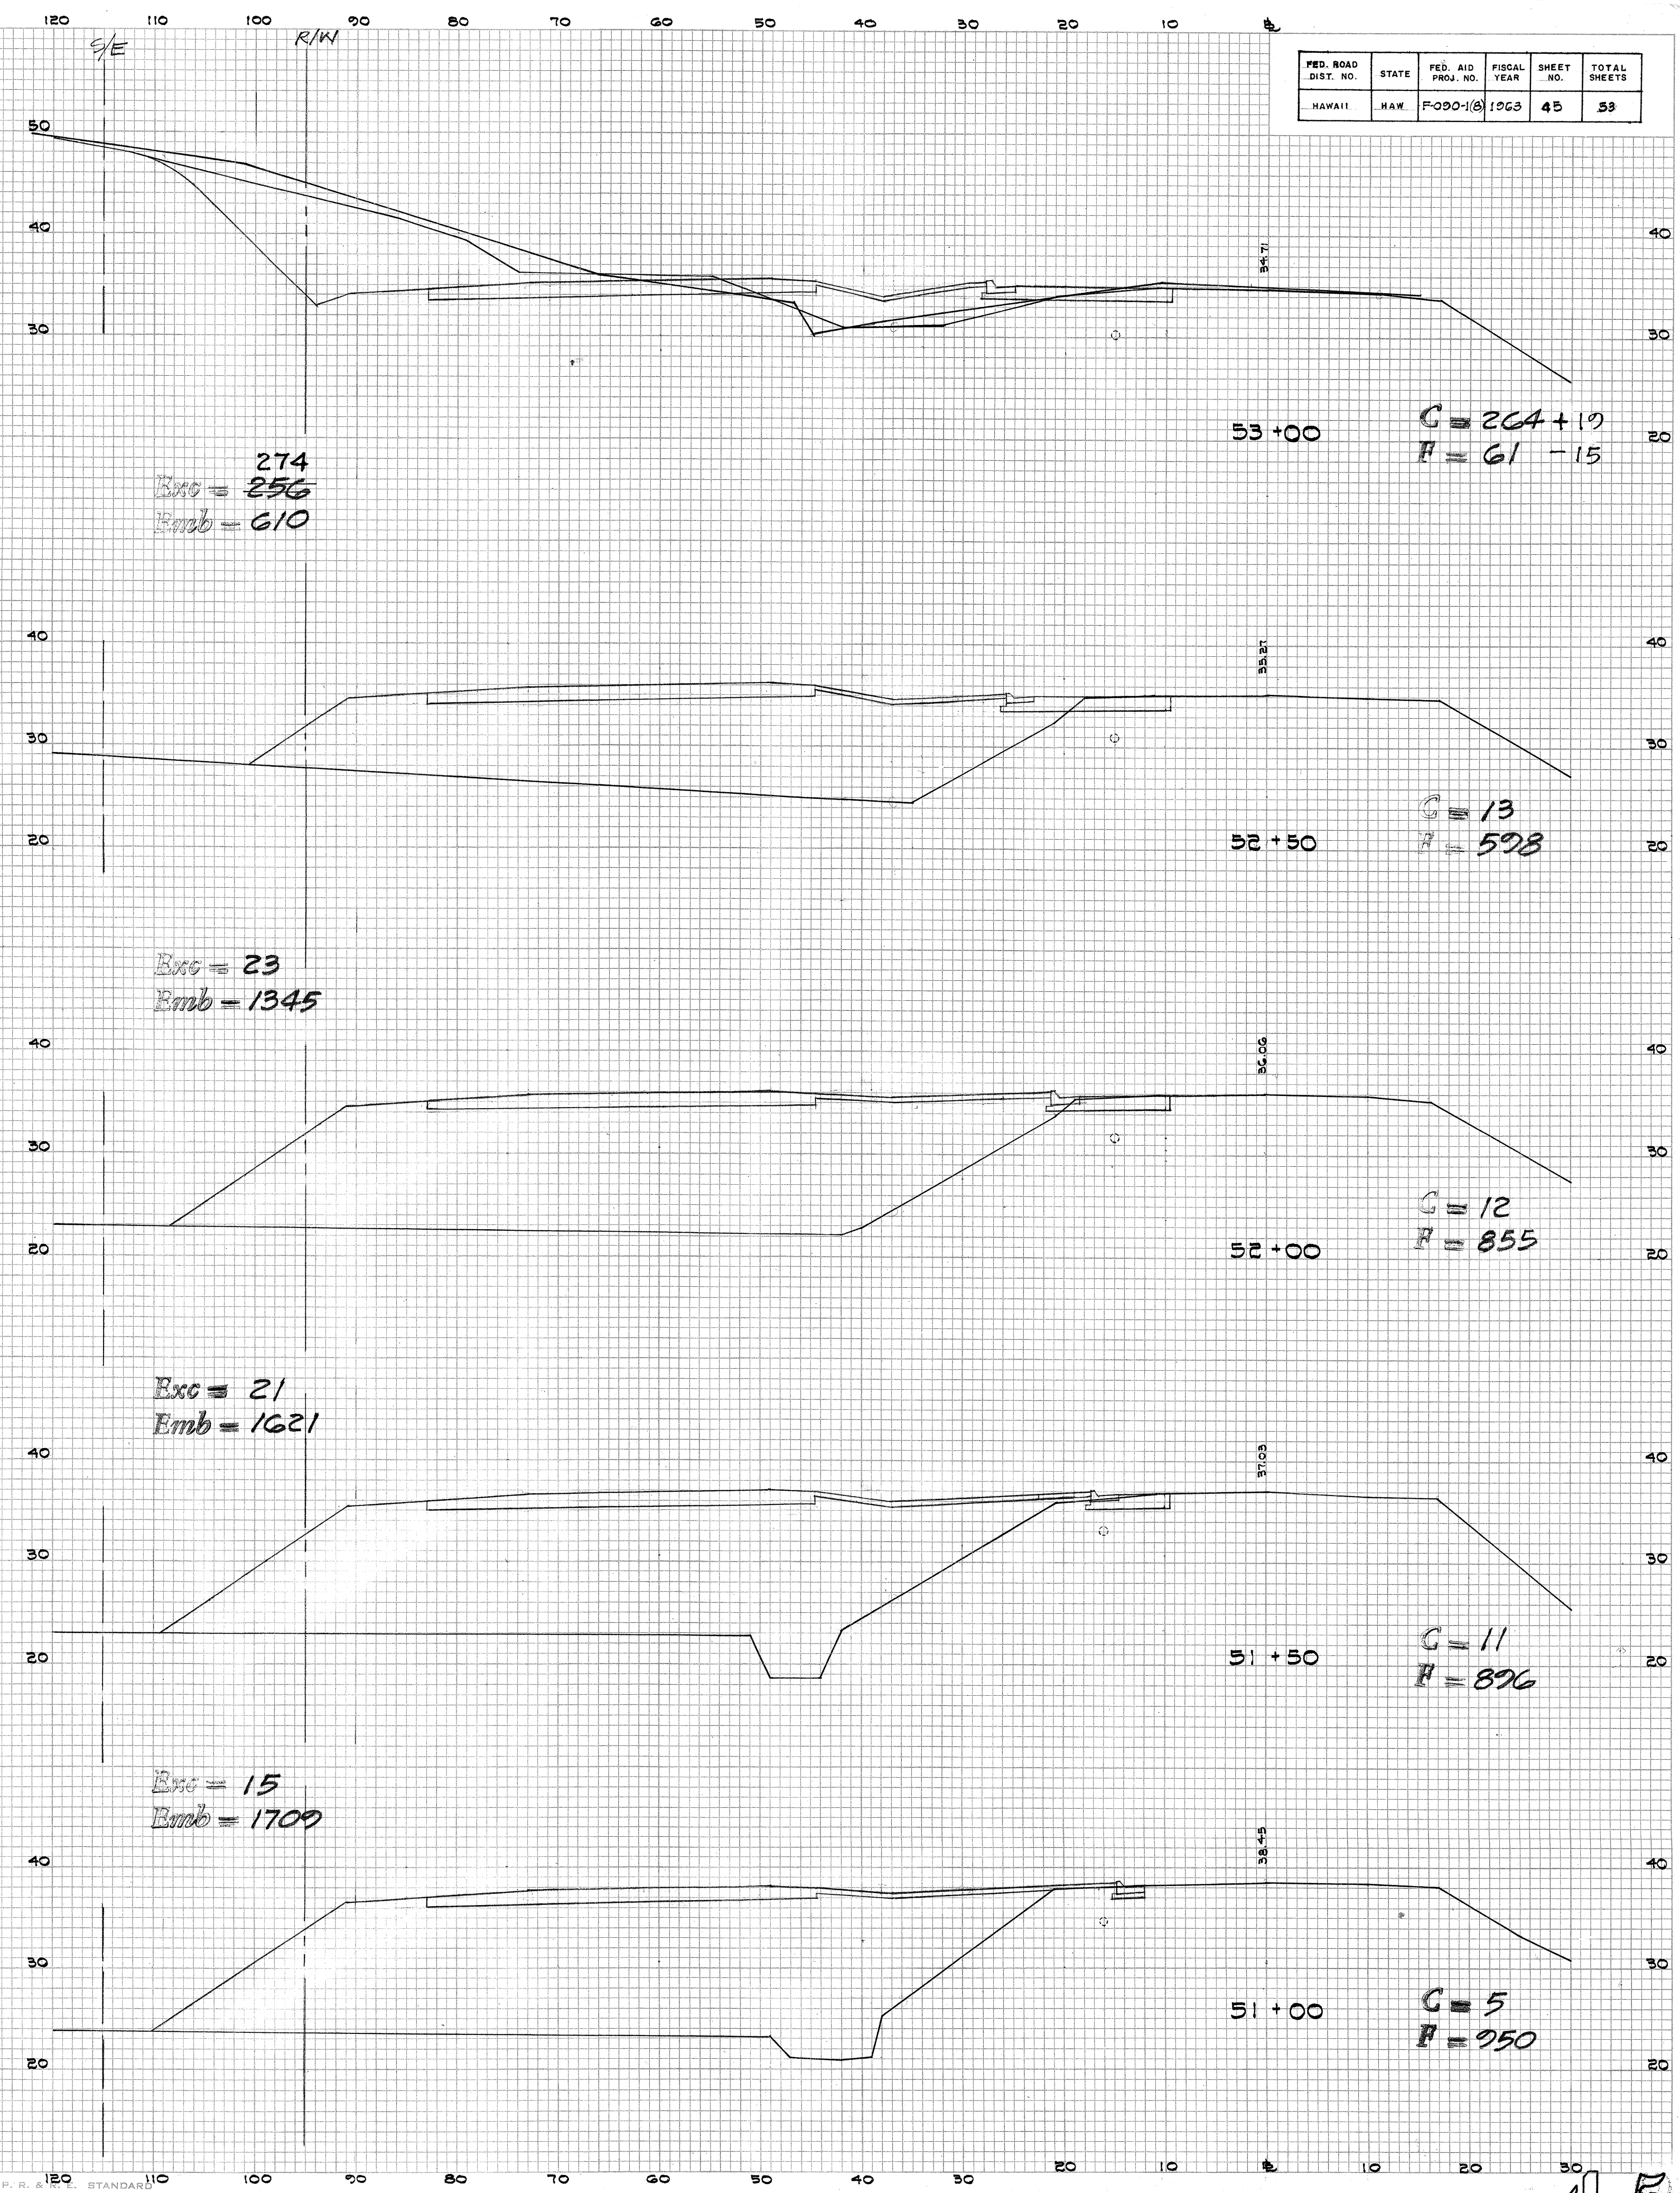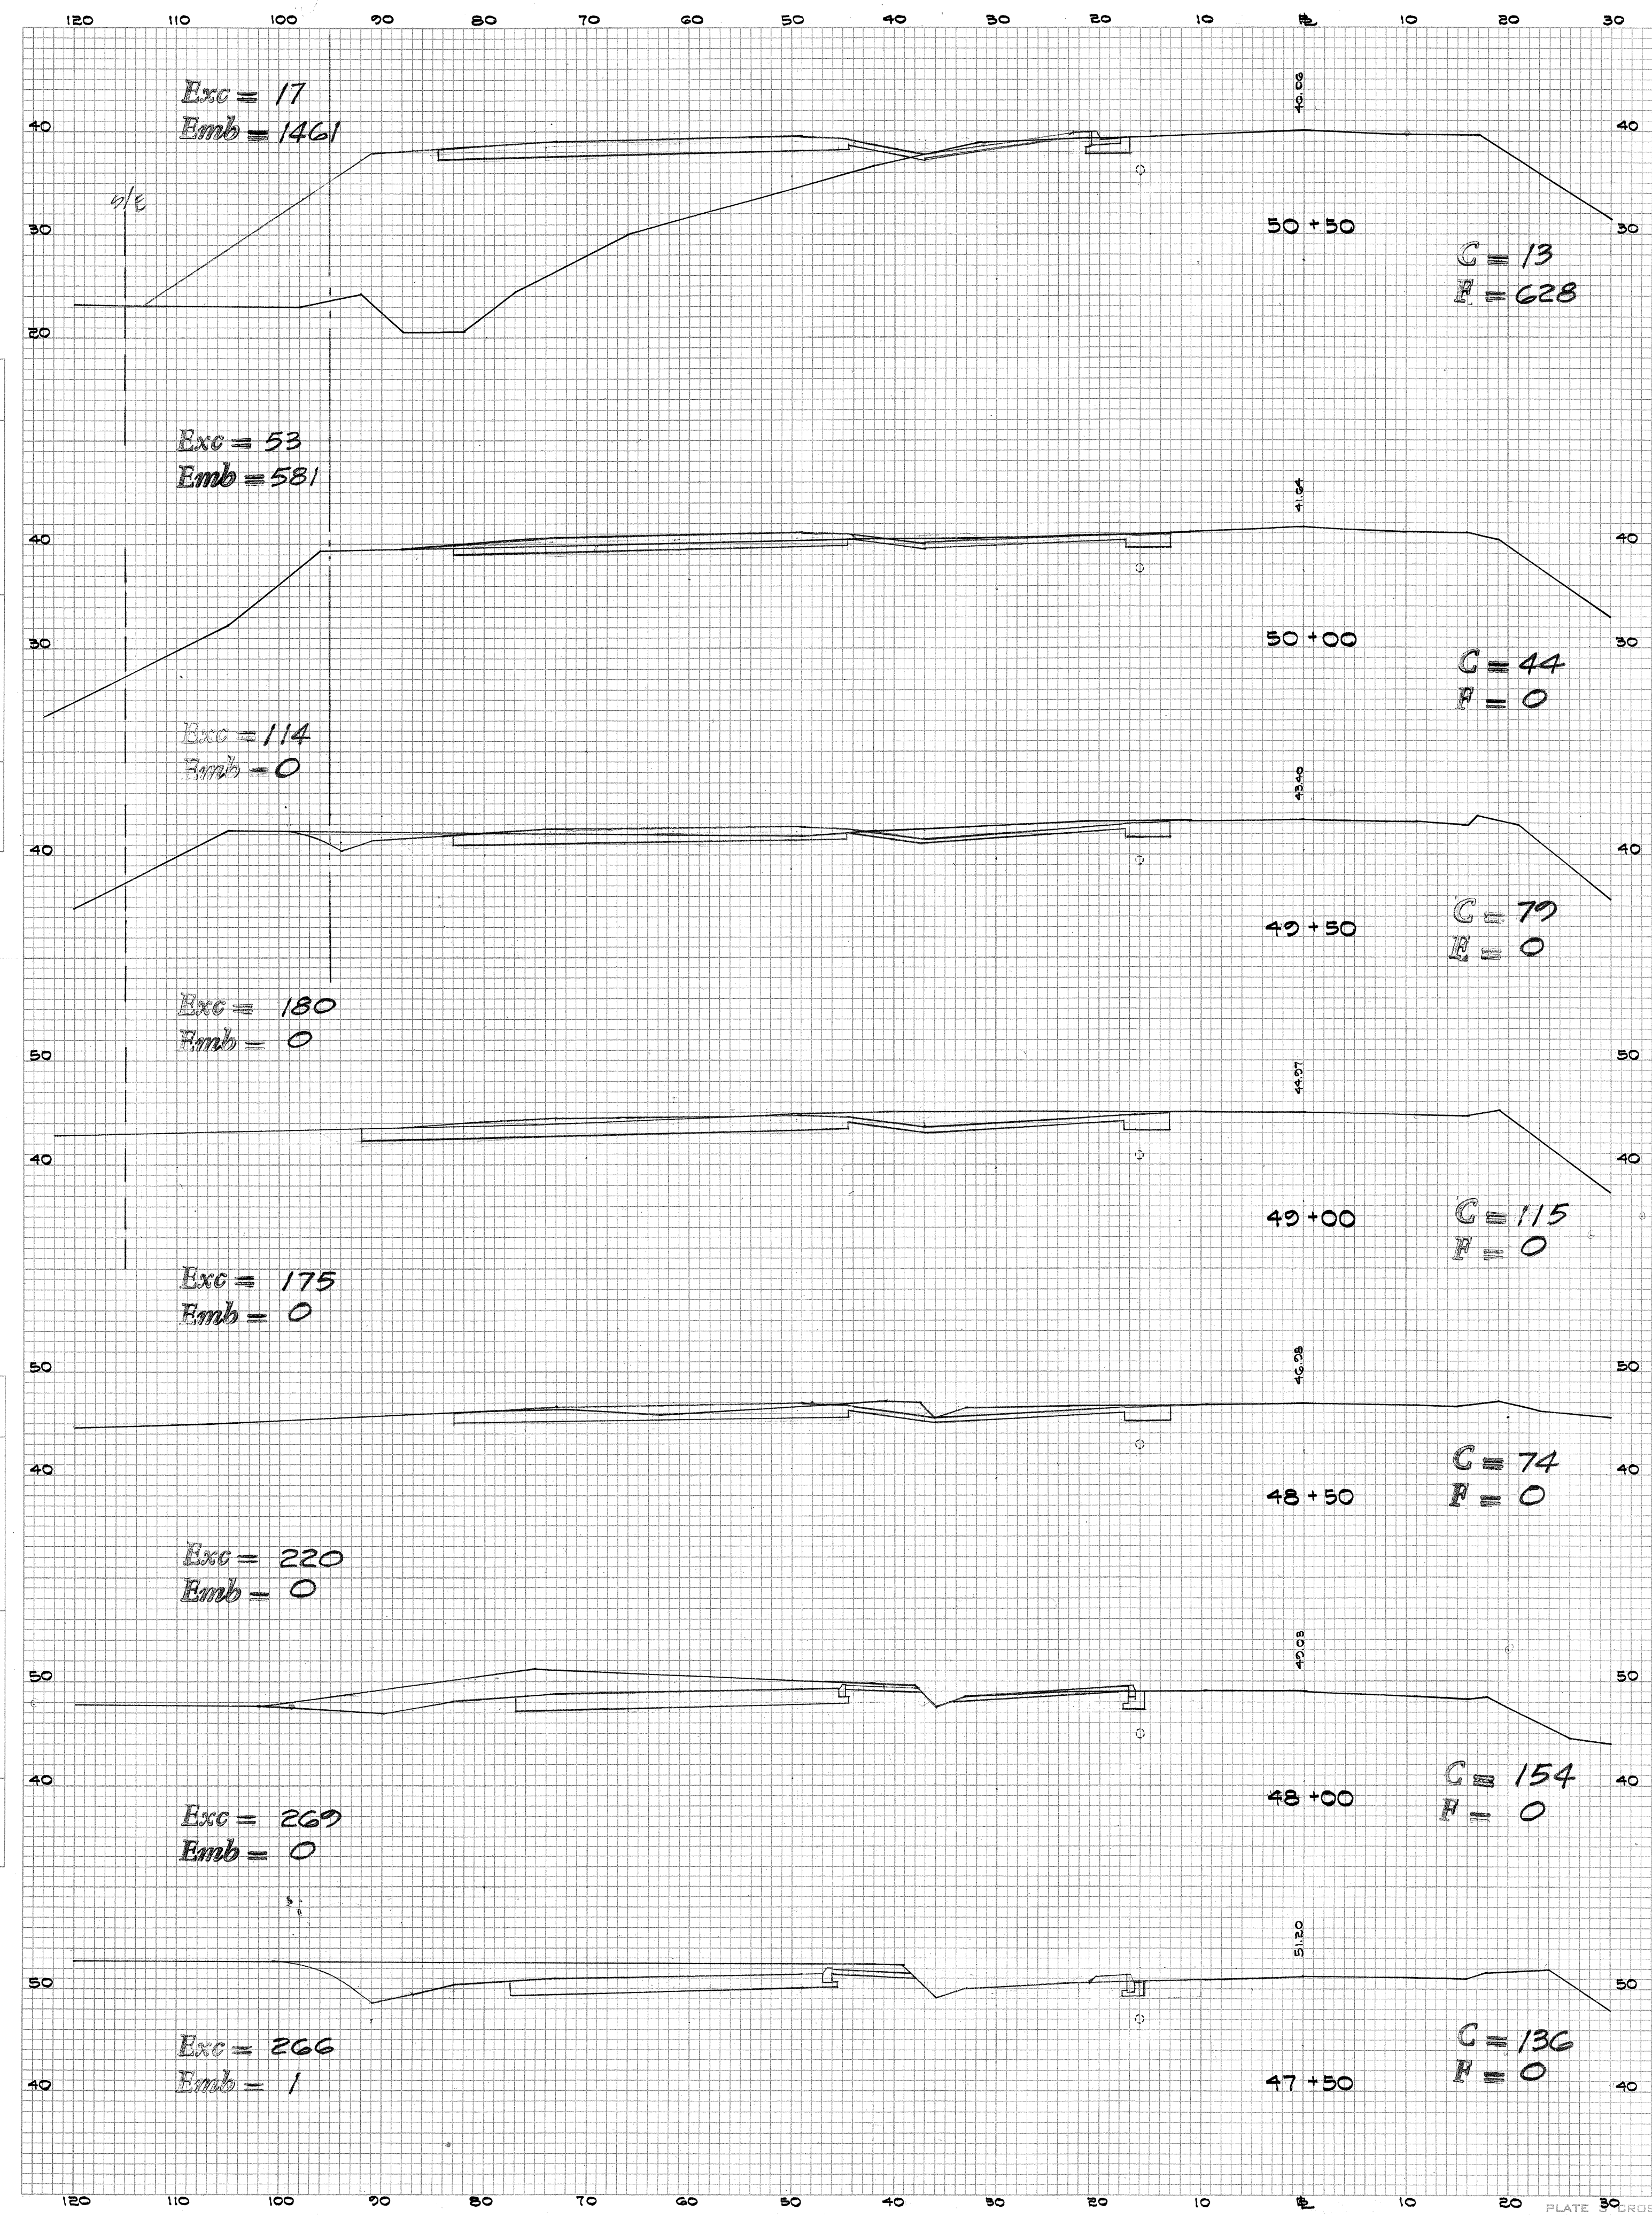



FED. ROAD DIST. NO.	STATE	FED. AID PROJ. NO.	FISCAL YEAR	SHEET NO.	TOTAL SHEETS
HAWAII	HAW	F000-18	1965	47	53

DATE	BY
FINAL SURVEY	
NOTE BOOK	
NO.	



DATE	BY
ORIGINAL SURVEY	
NOTE BOOK	
NO.	

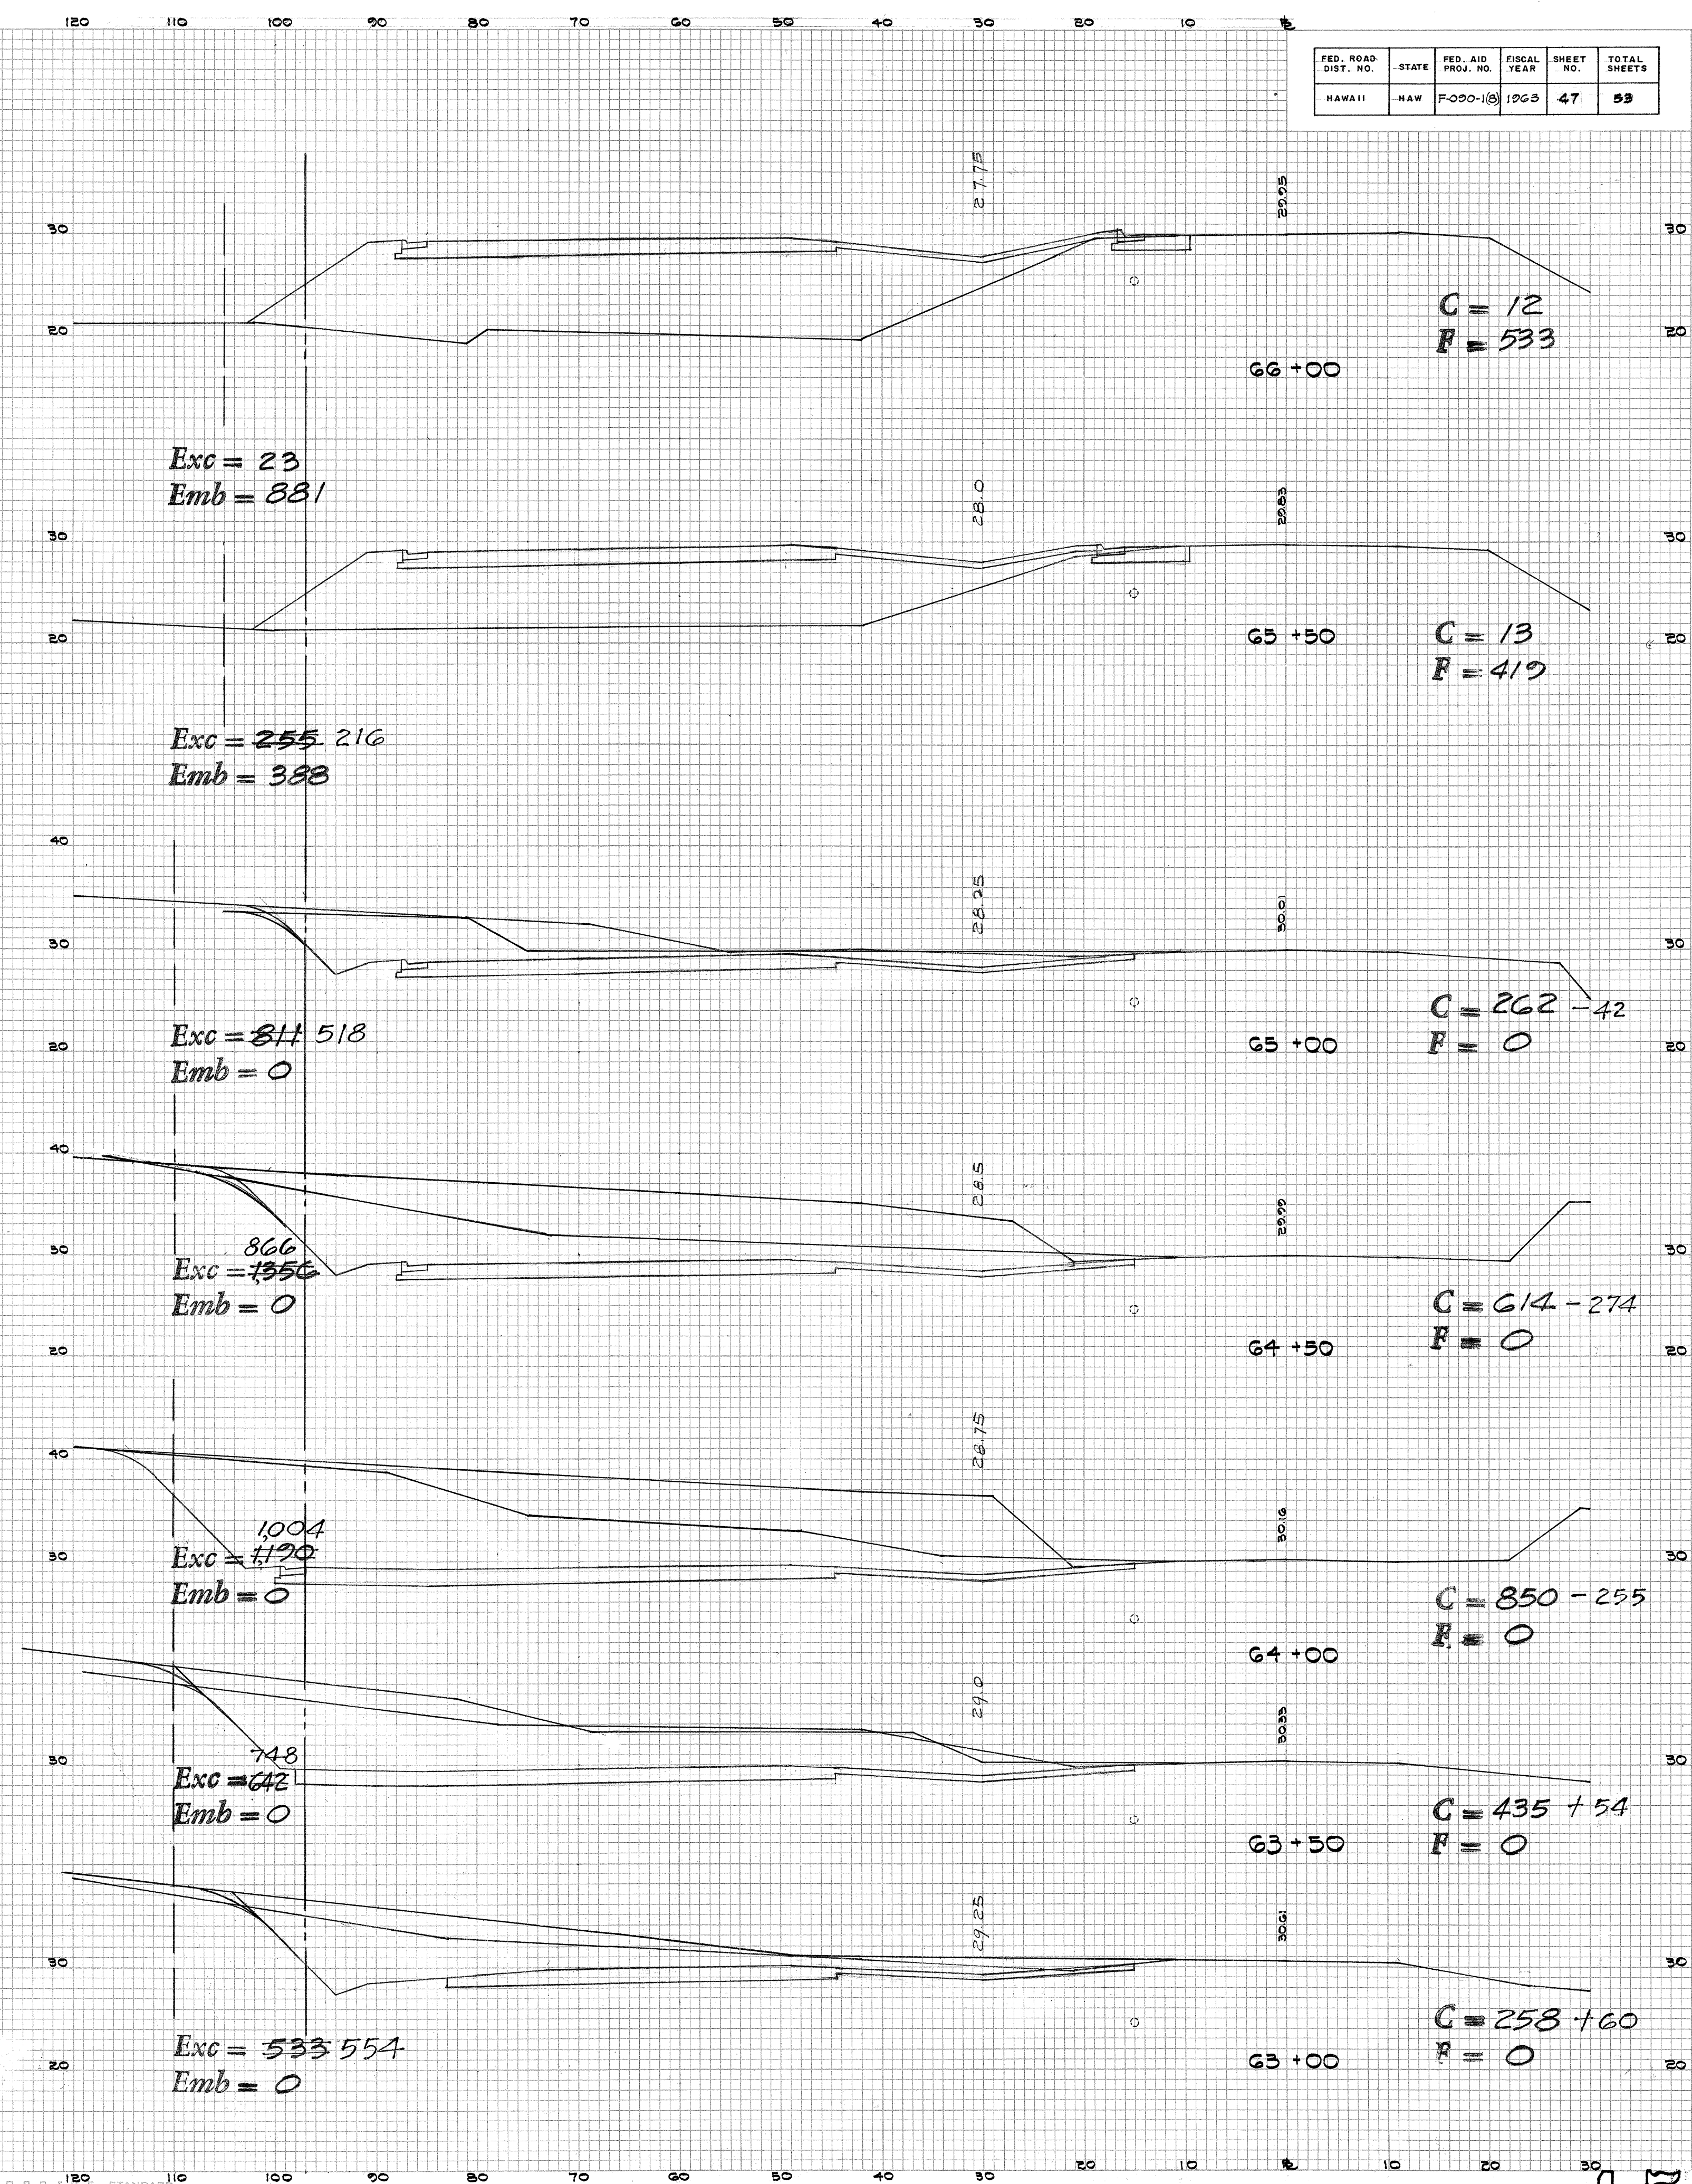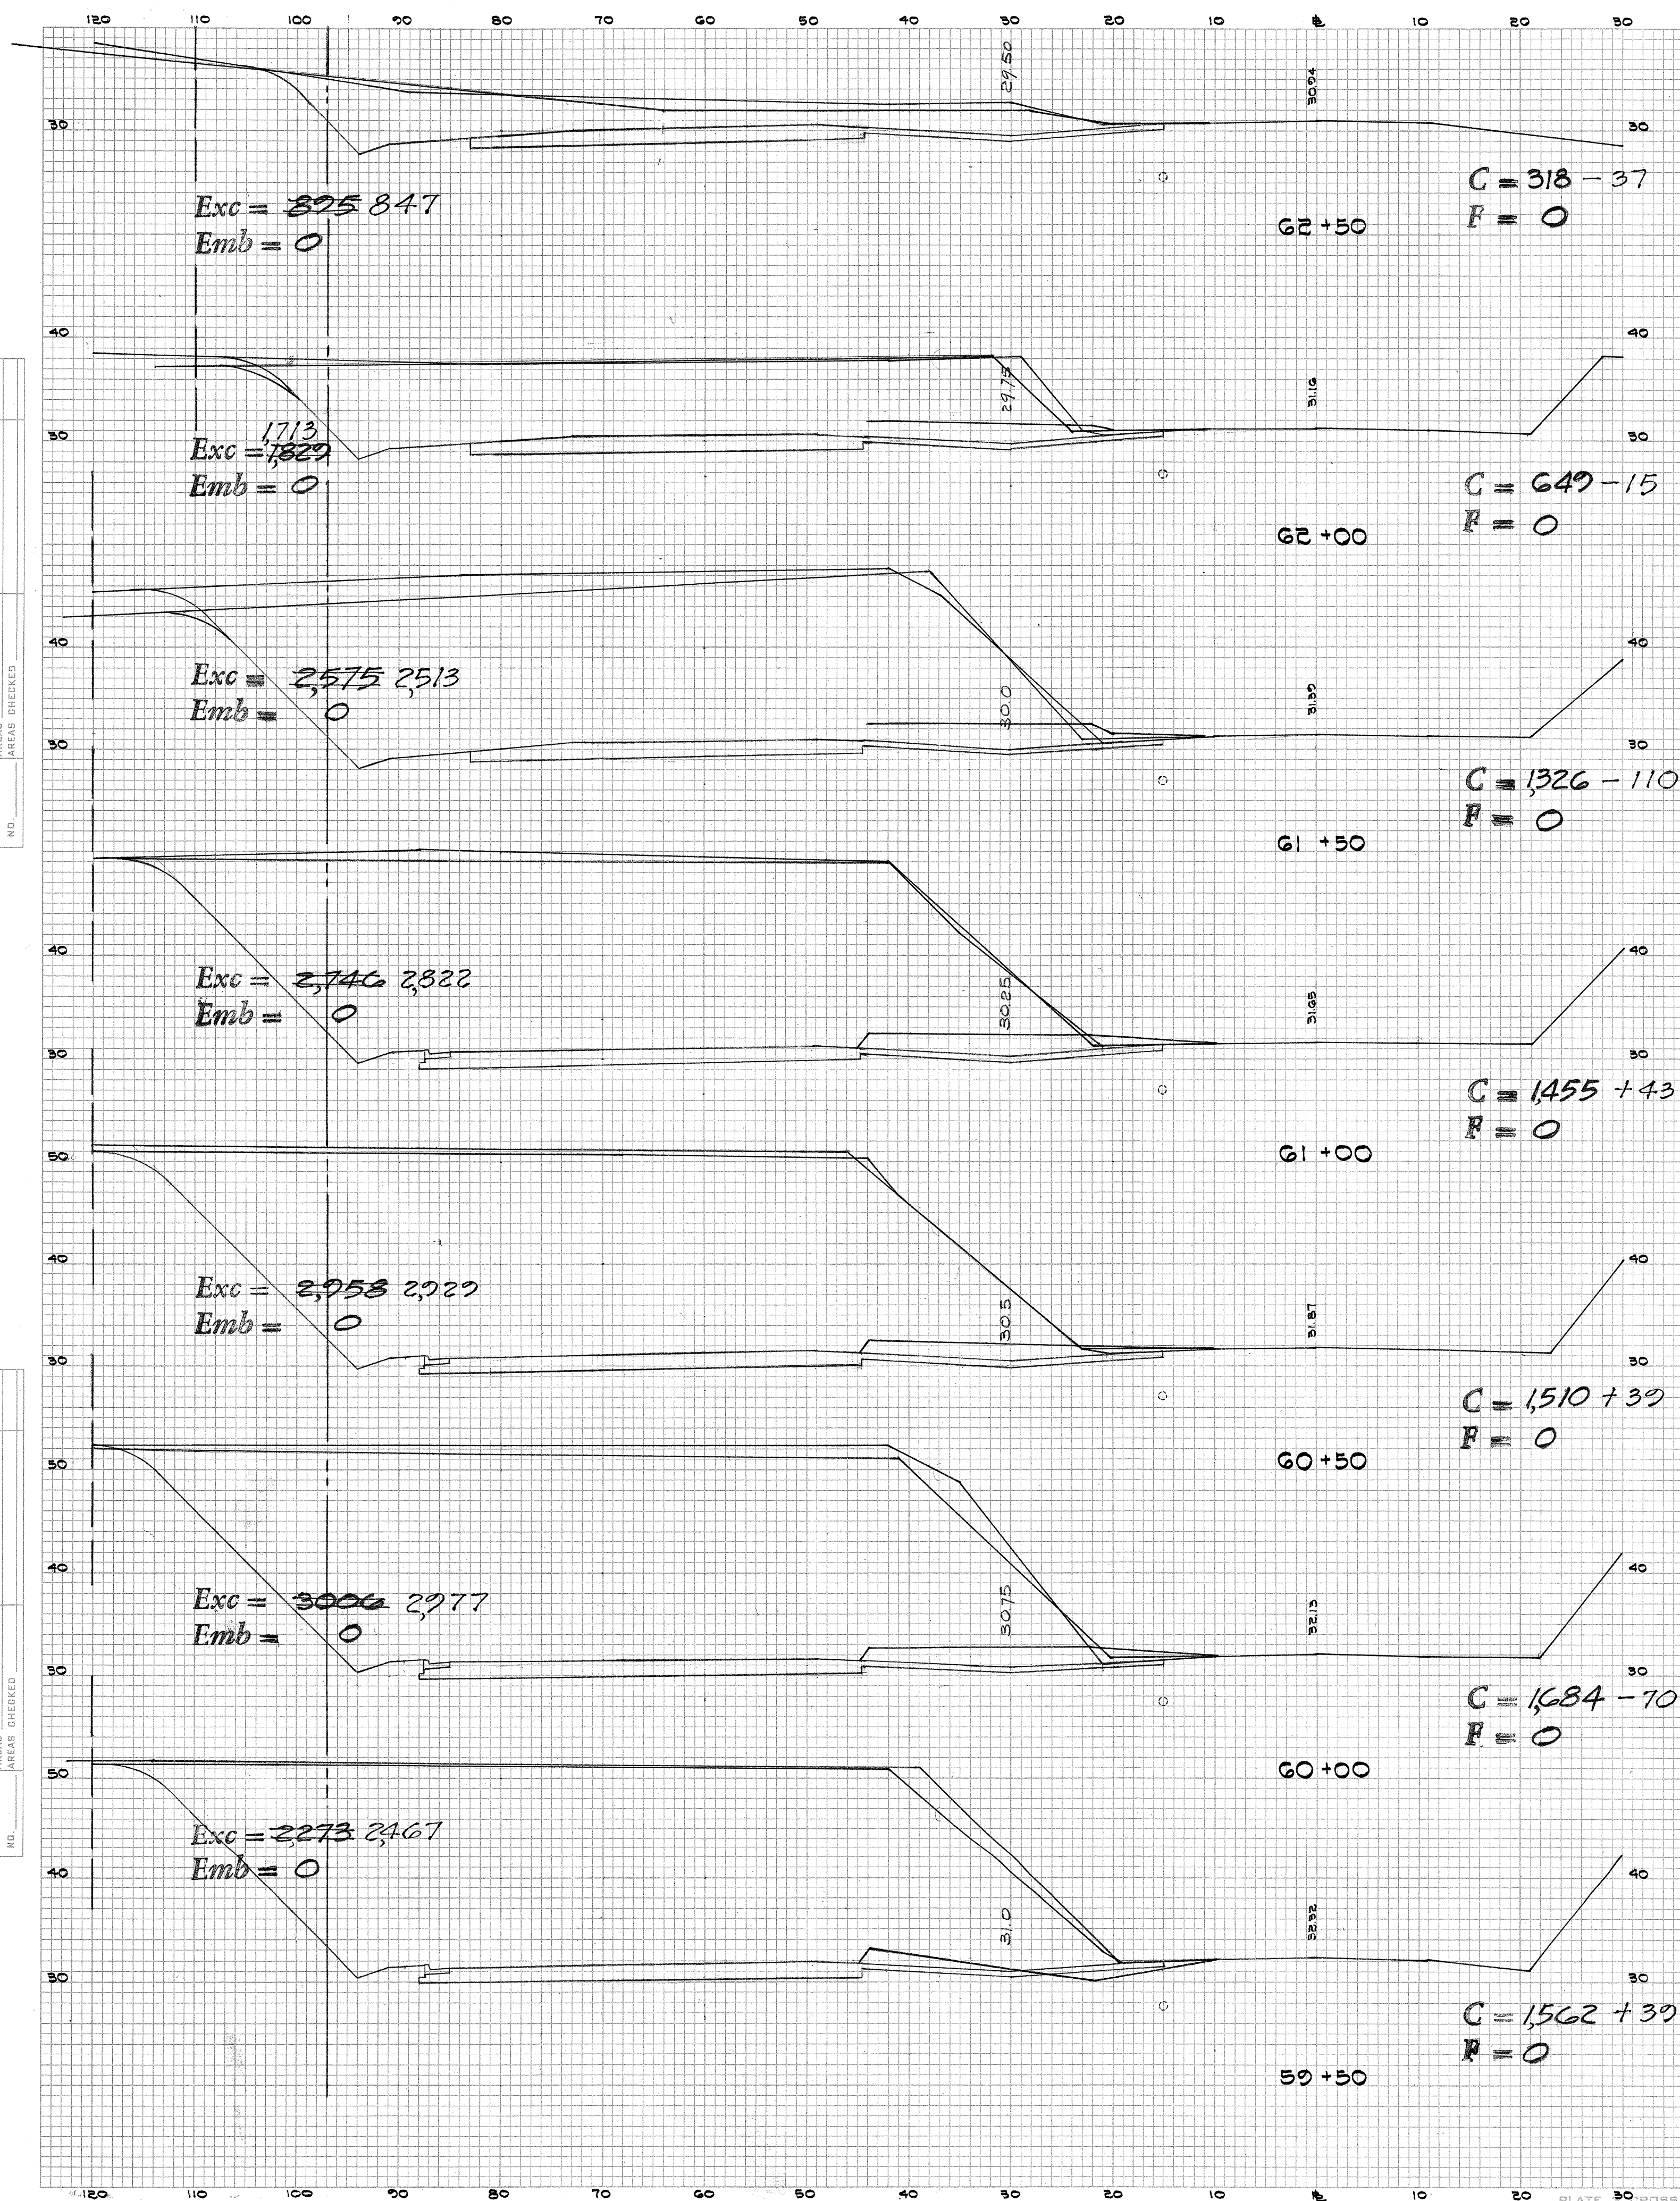

FED. ROAD DIST. NO.	STATE	FED. AID PROJ. NO.	FISCAL YEAR	SHEET NO.	TOTAL SHEETS
HAWAII	HAW	F-090-18	1963	42	58

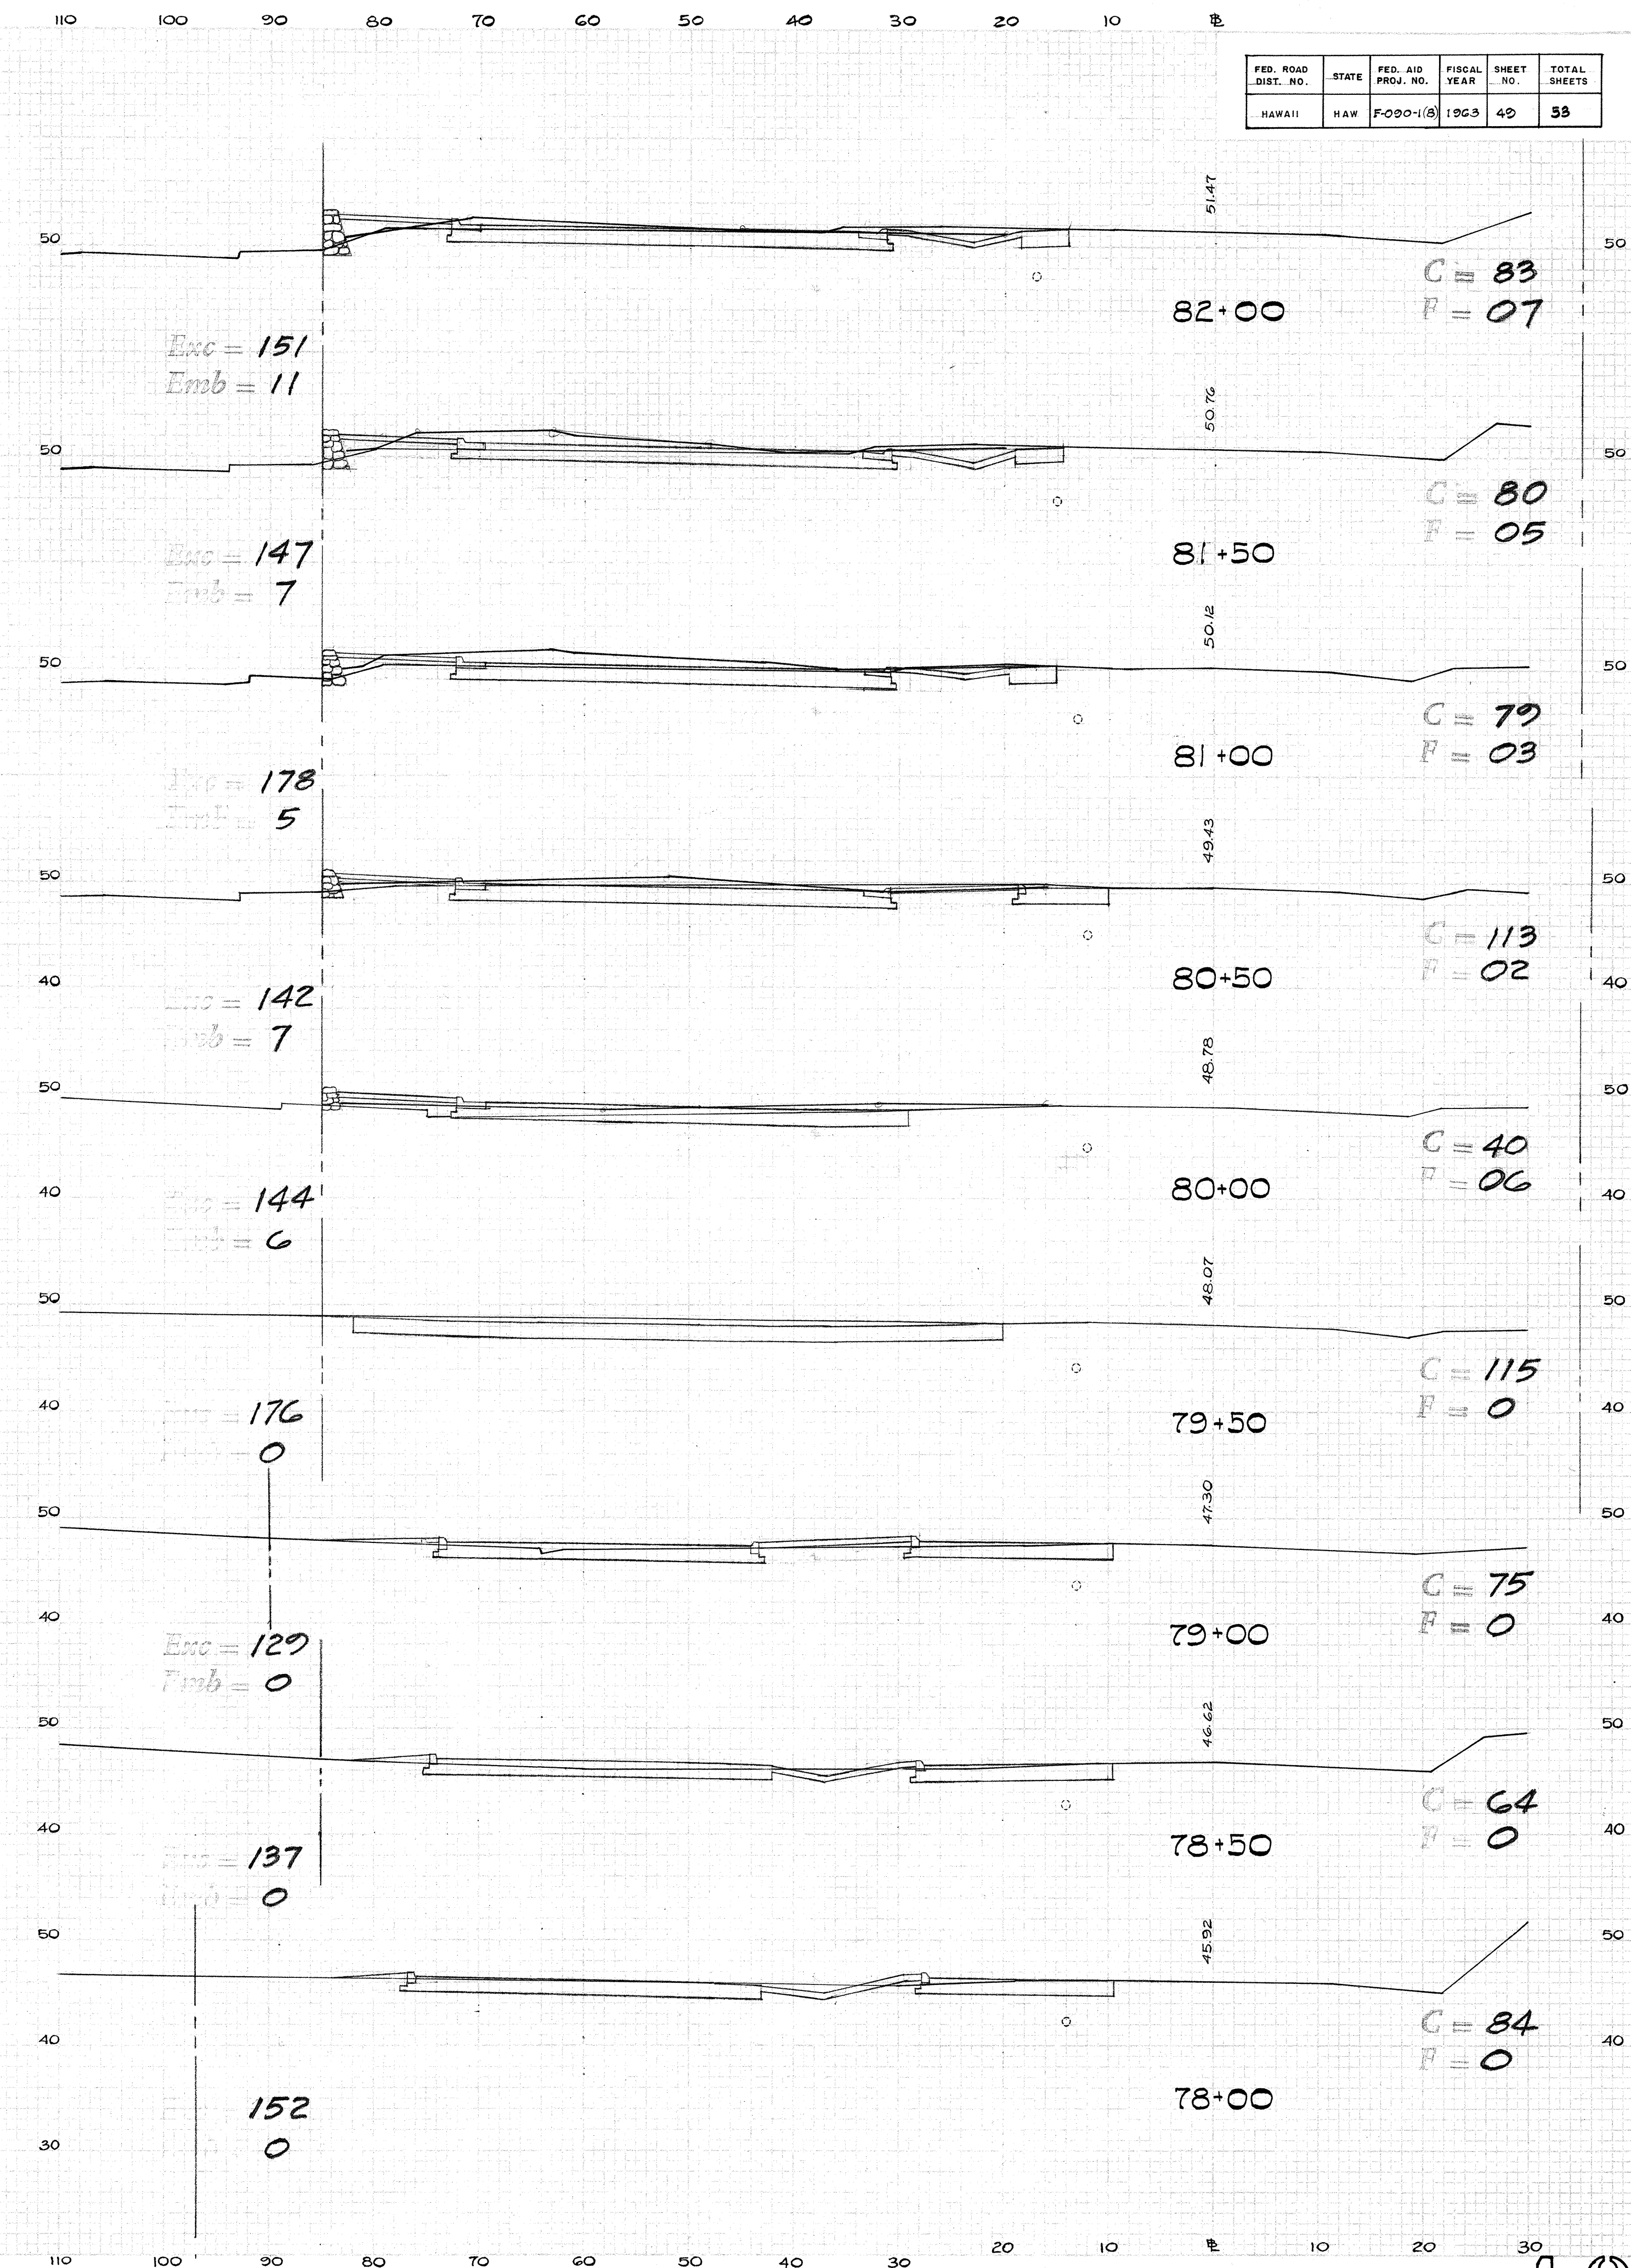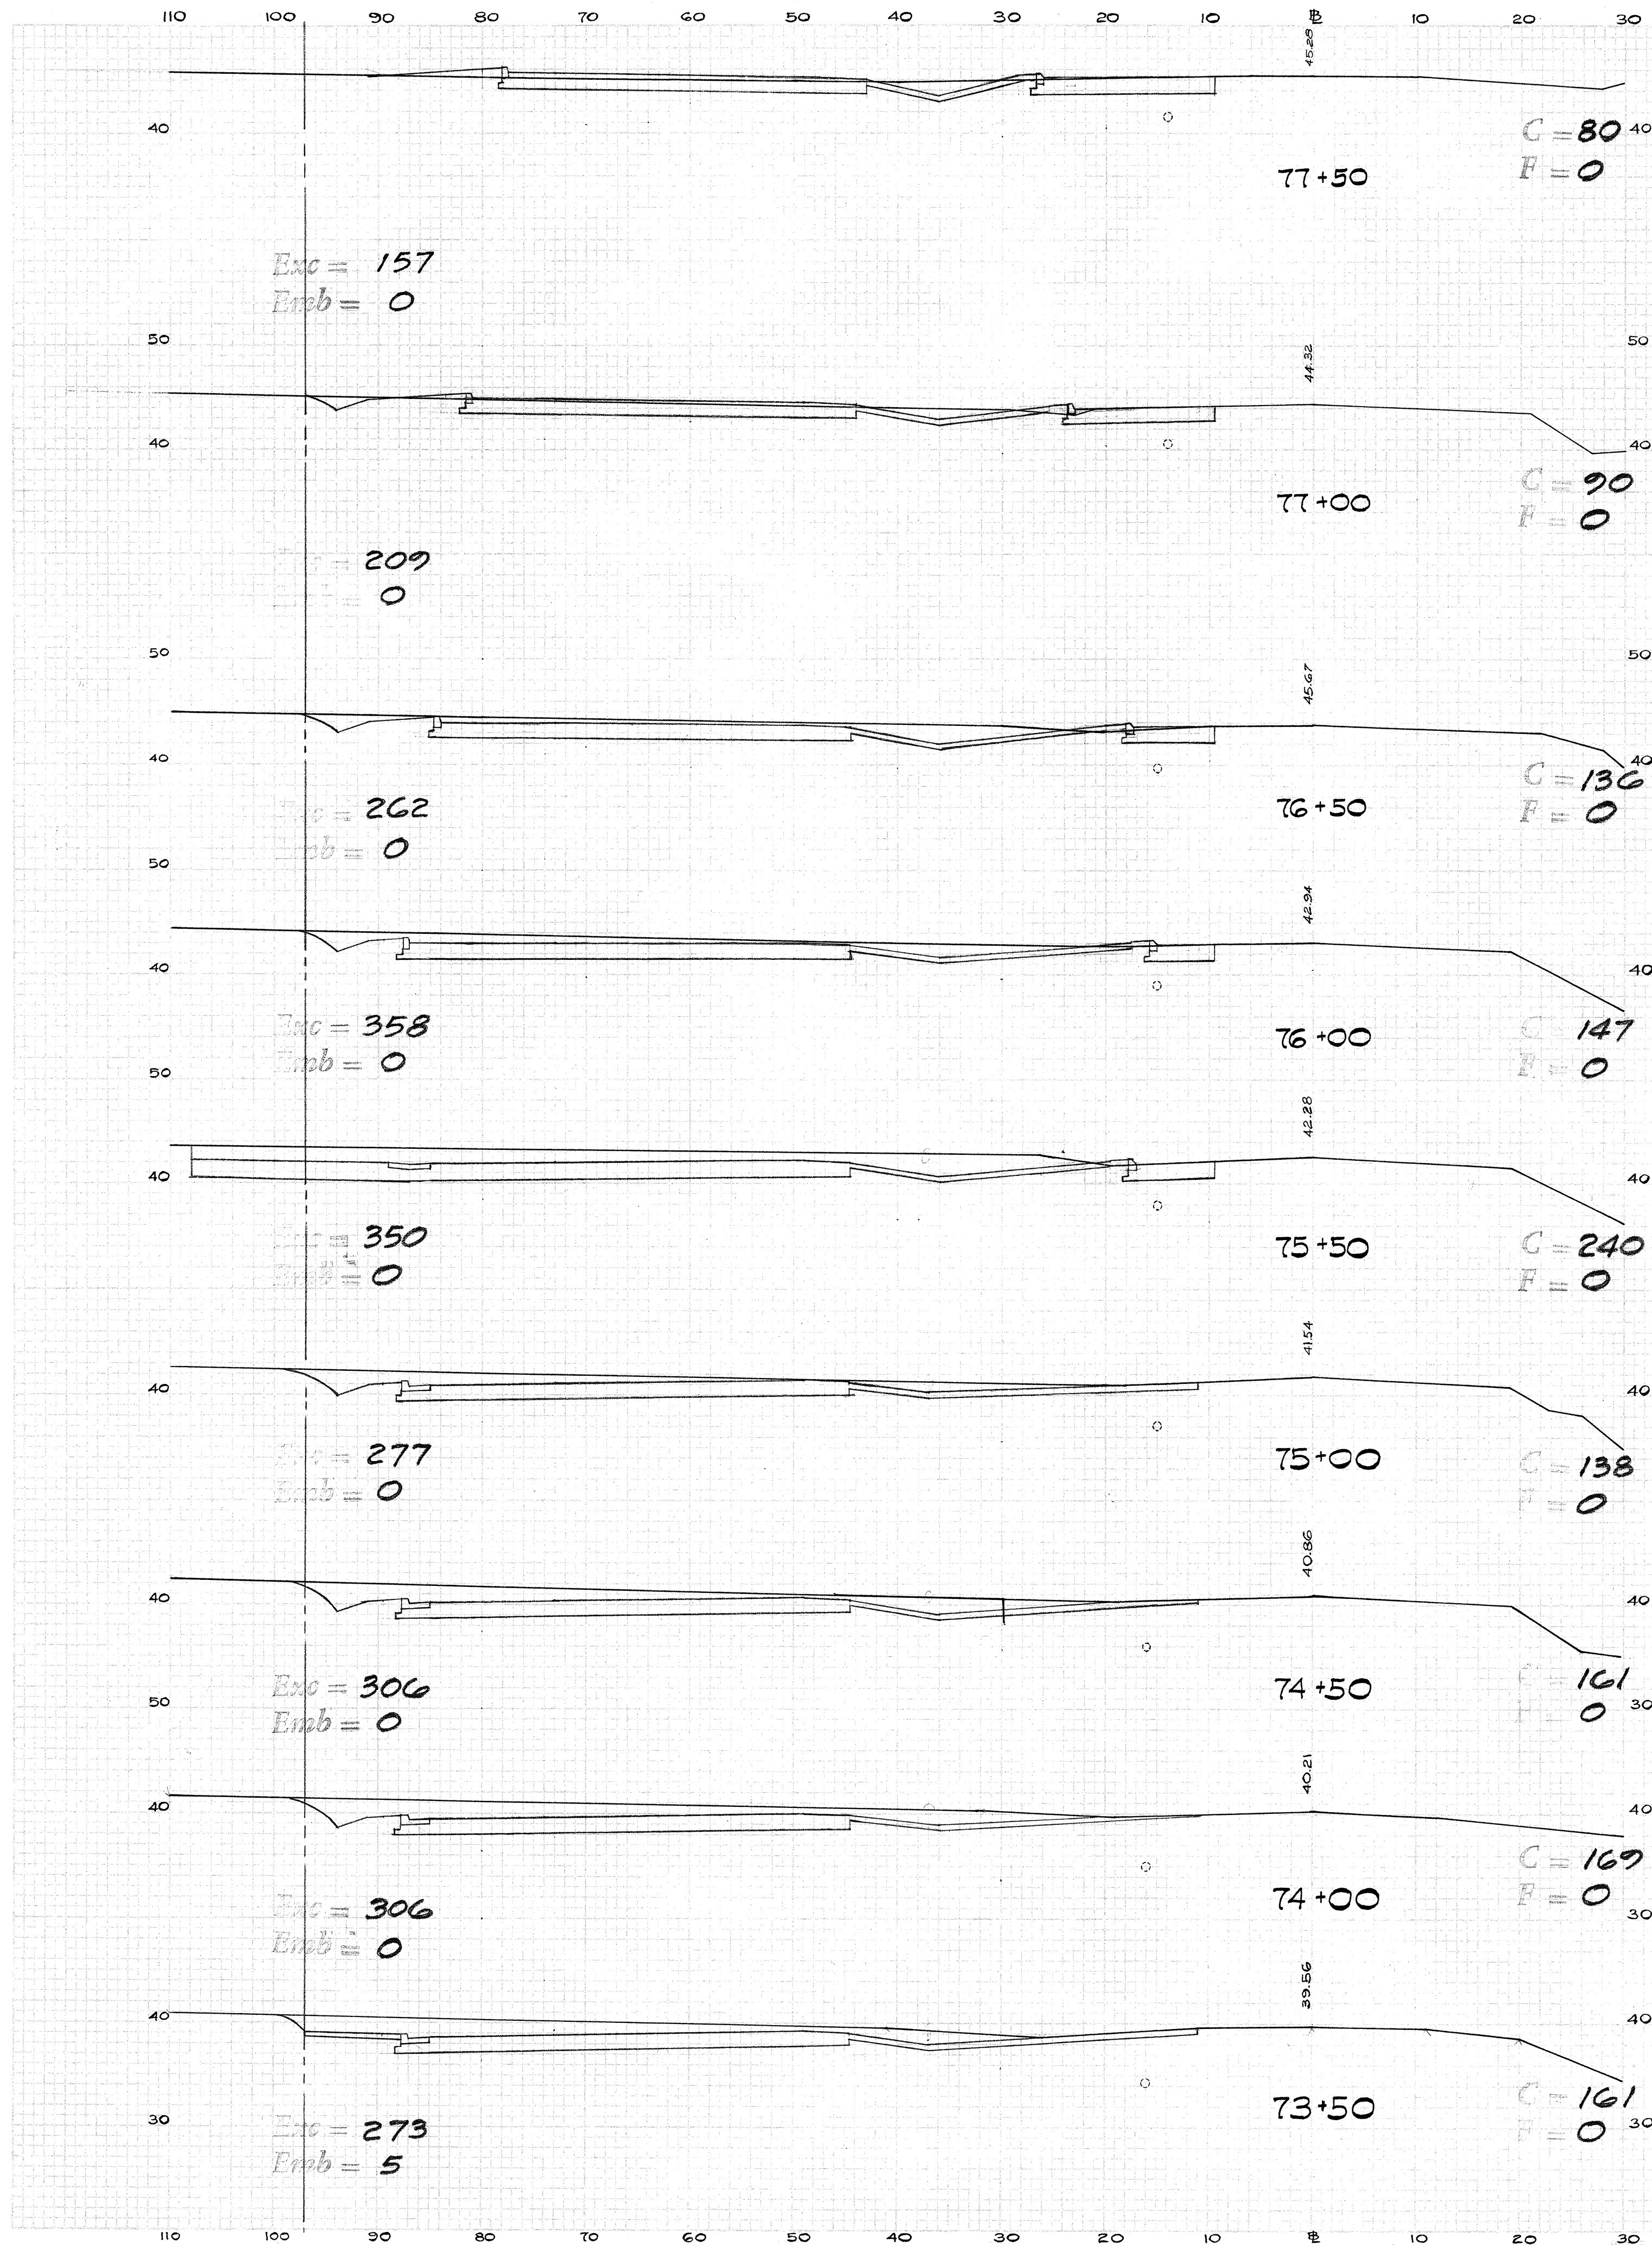

FED. ROAD DIST. No.	STATE	FED. AID PROJ. No.	FISCAL YEAR	SHEET No.	TOTAL SHEETS
HAWAII	HAW.	F000-118	1963	50	53

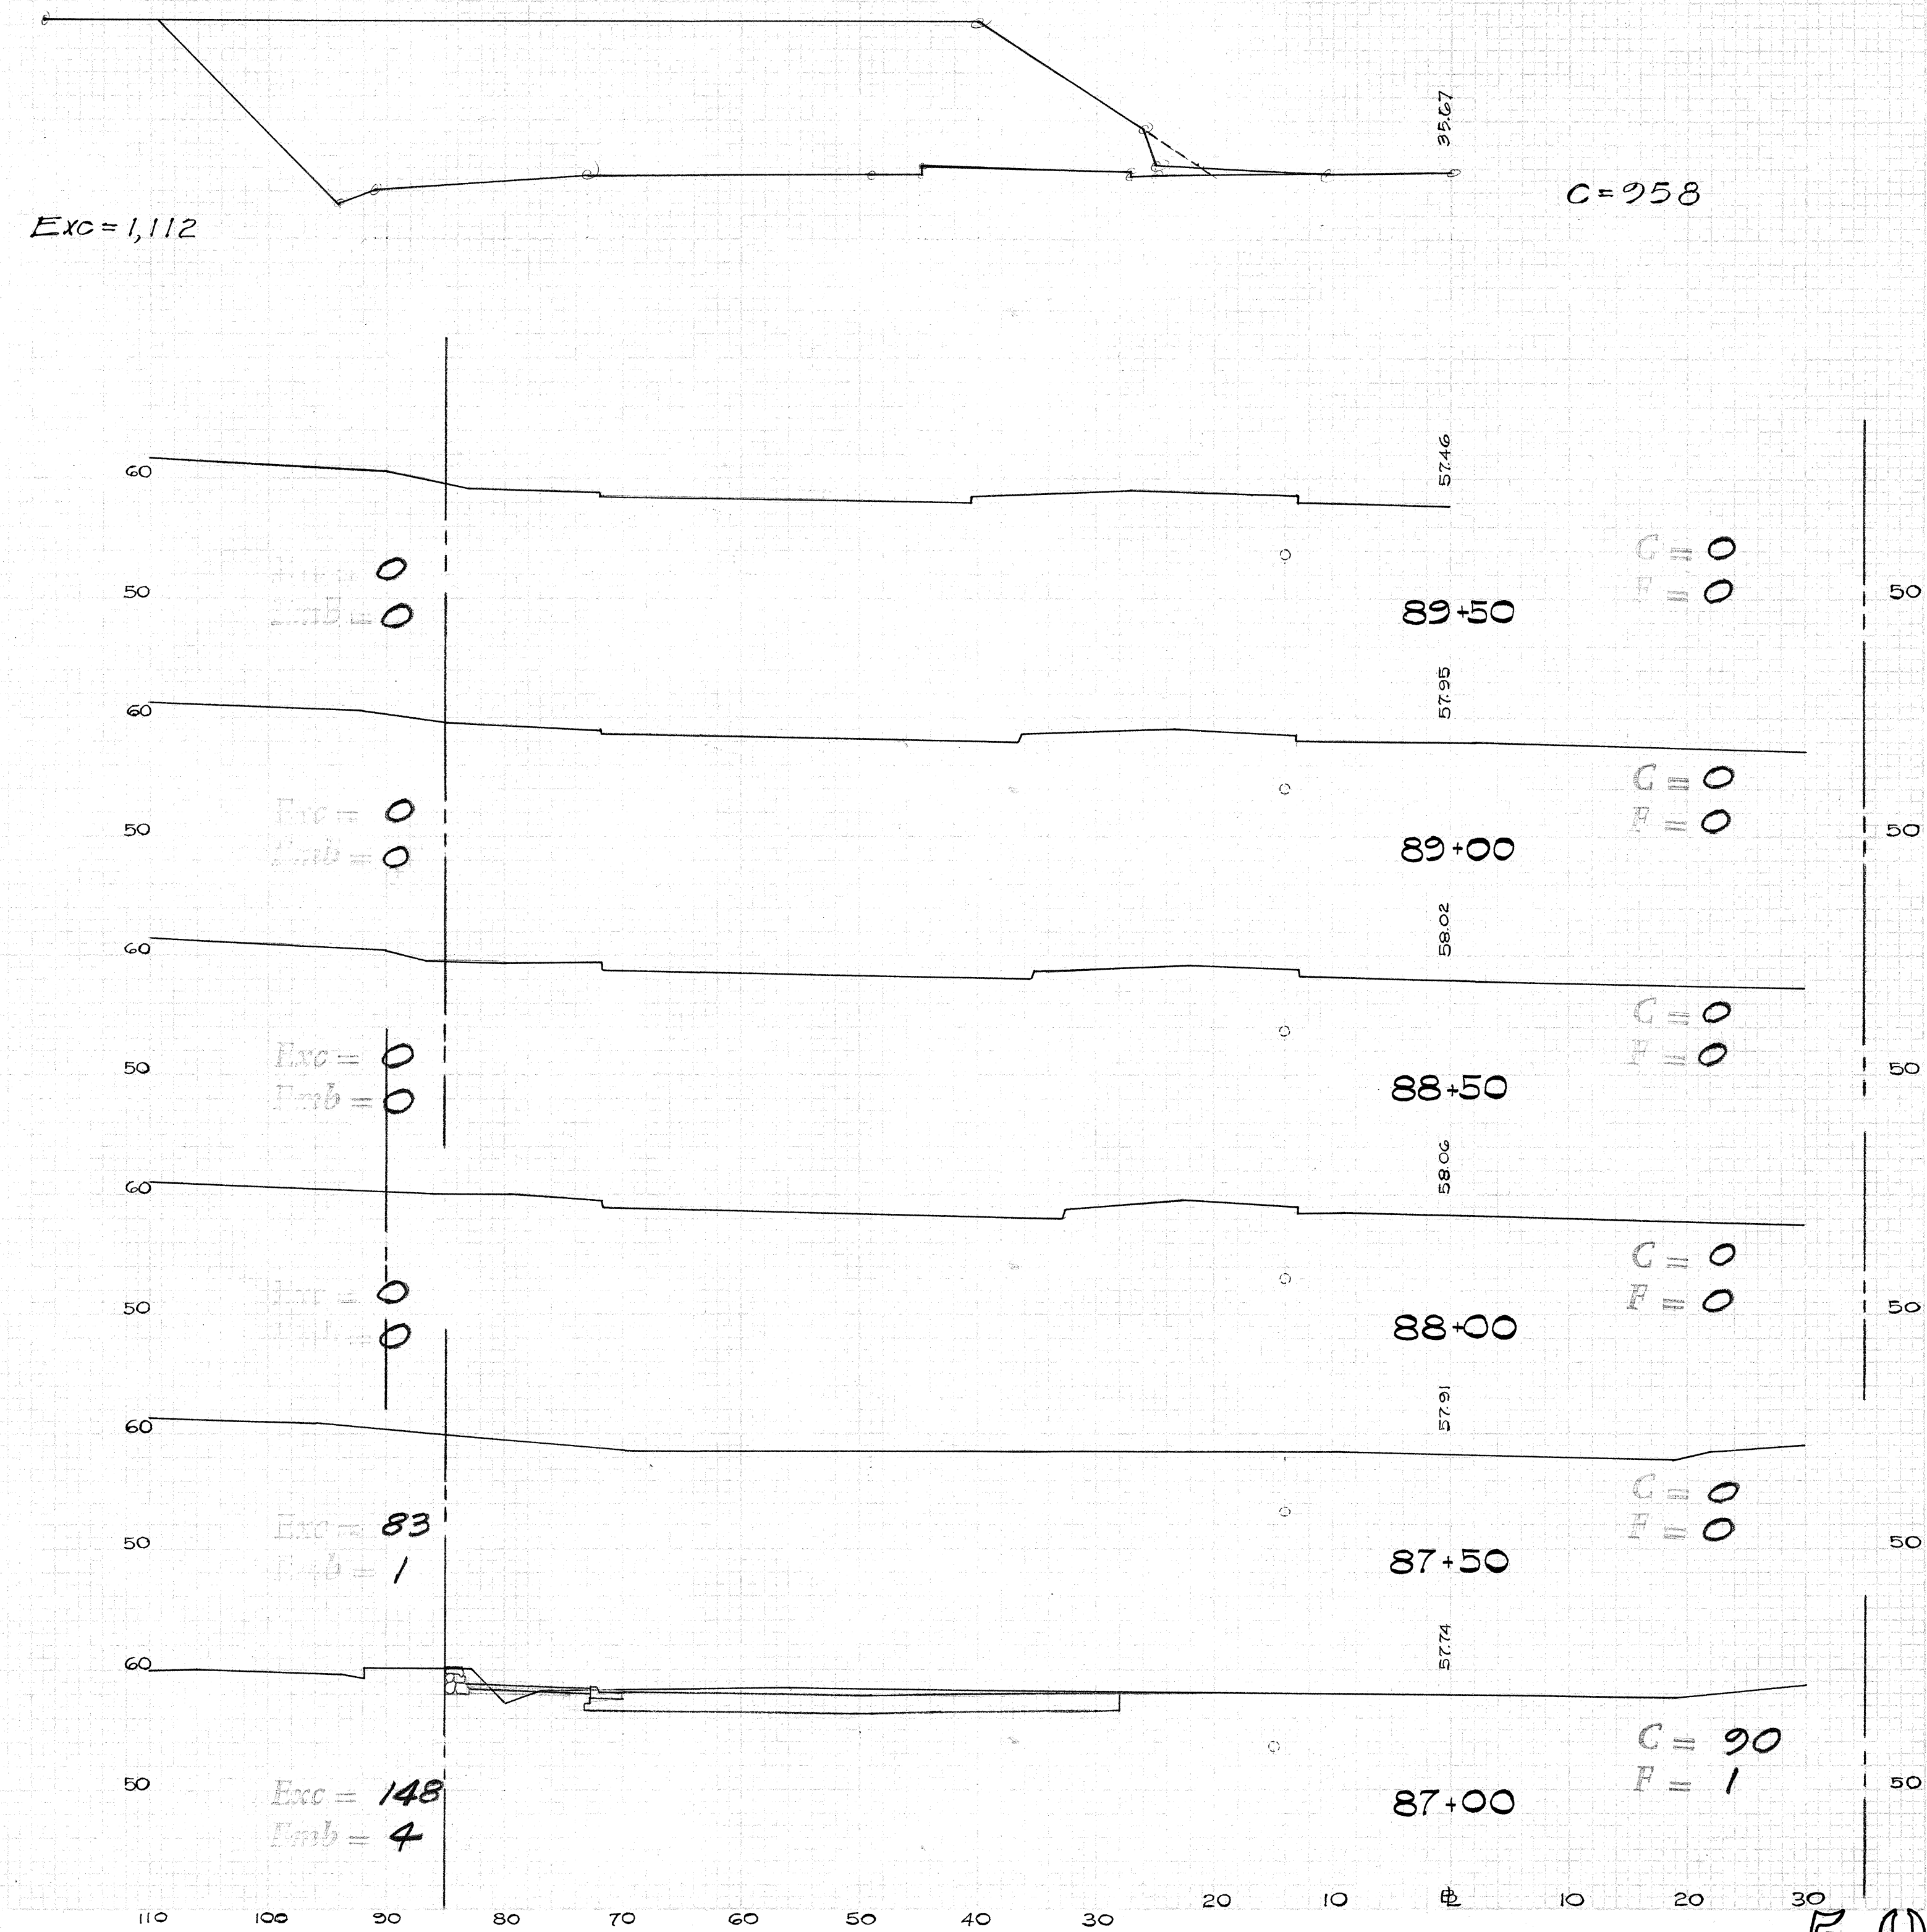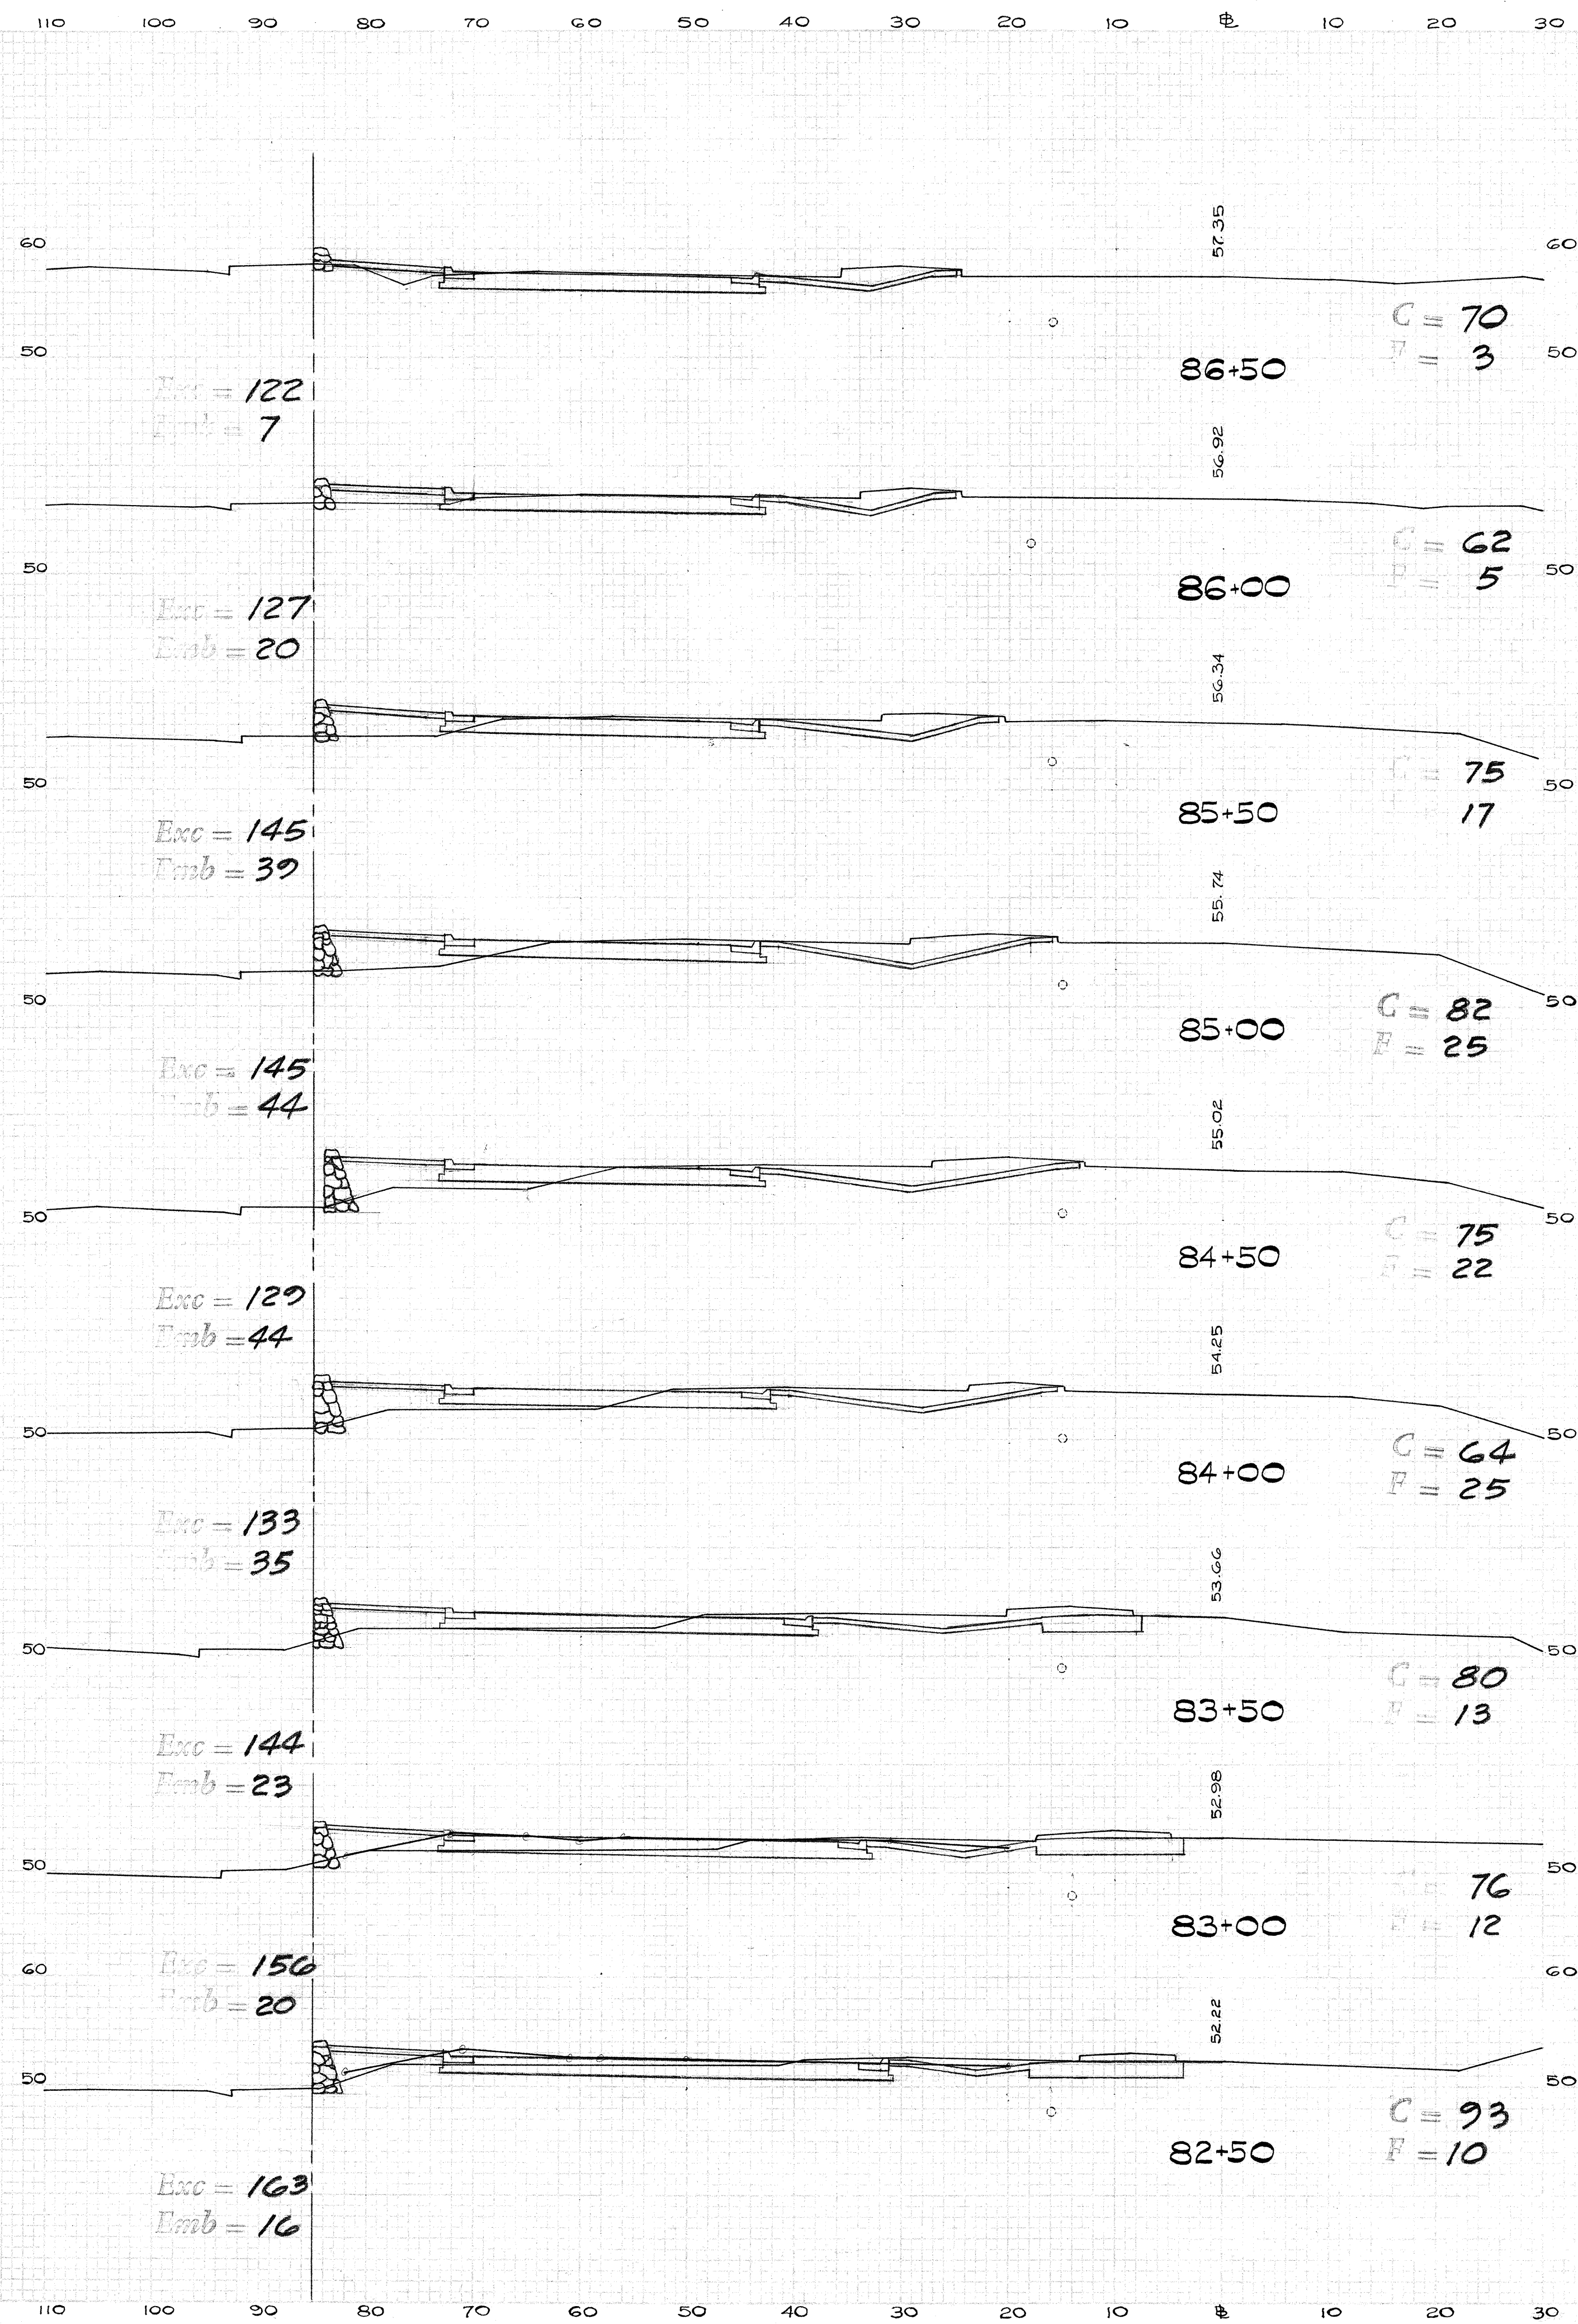


70 60 50 40 30 20 10 0 E.P. RIGHT 10 20

50 40 30 20 10 0 E.P. RIGHT 10 20


40 30 20 10 0 10 20

FED. ROAD DIST. NO.	STATE	FED. AID PROJ. NO.	FISCAL YEAR	SHEET NO.	TOTAL SHEETS
HAWAII	HAW	F-030-115	1963	51	53


Exc = 59
Emb = 8

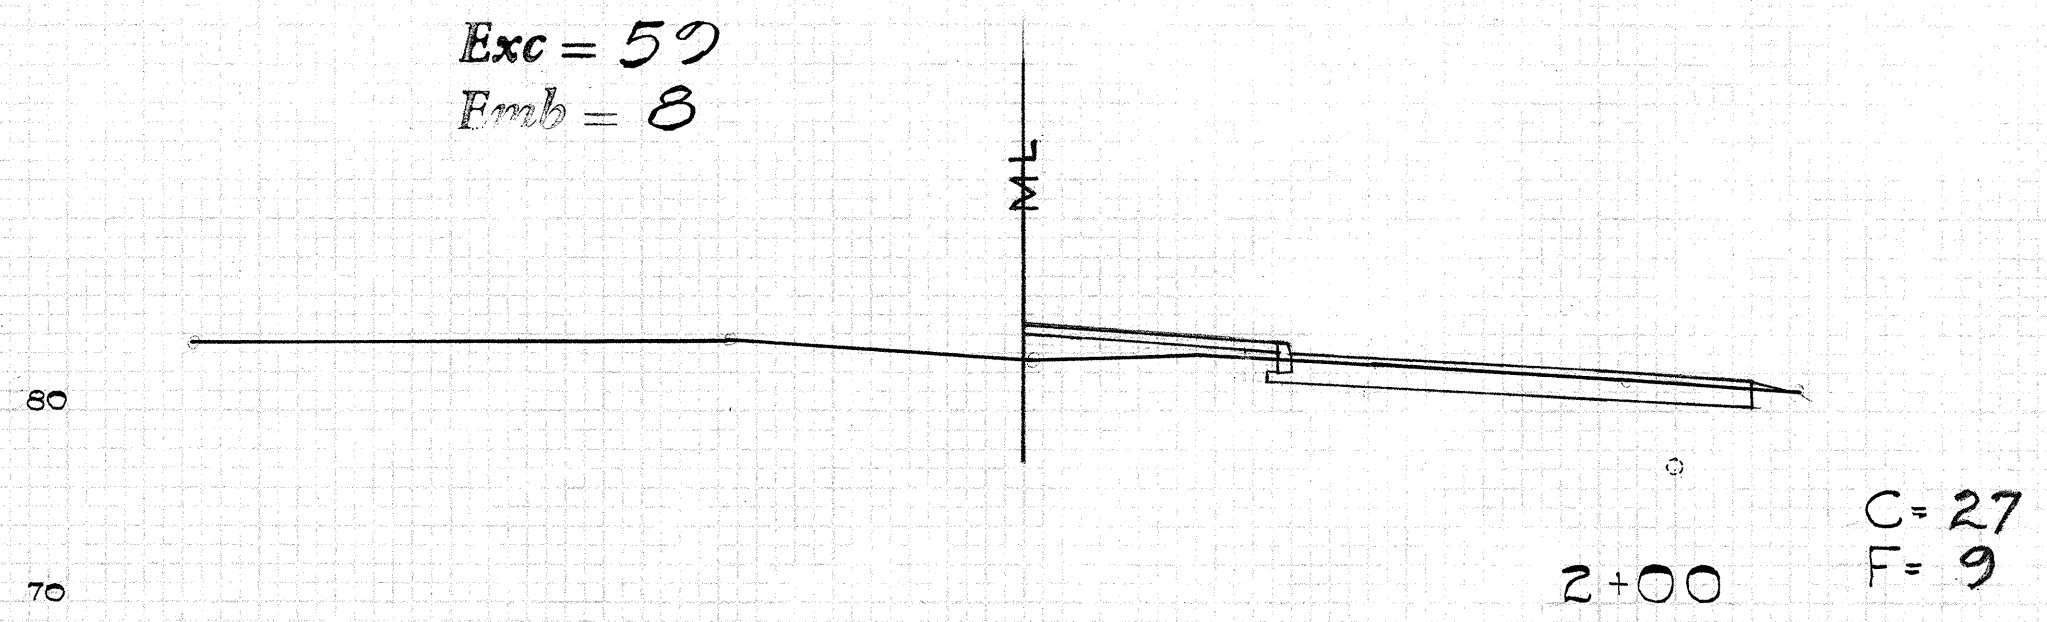


Exc = 49
Emb = 11

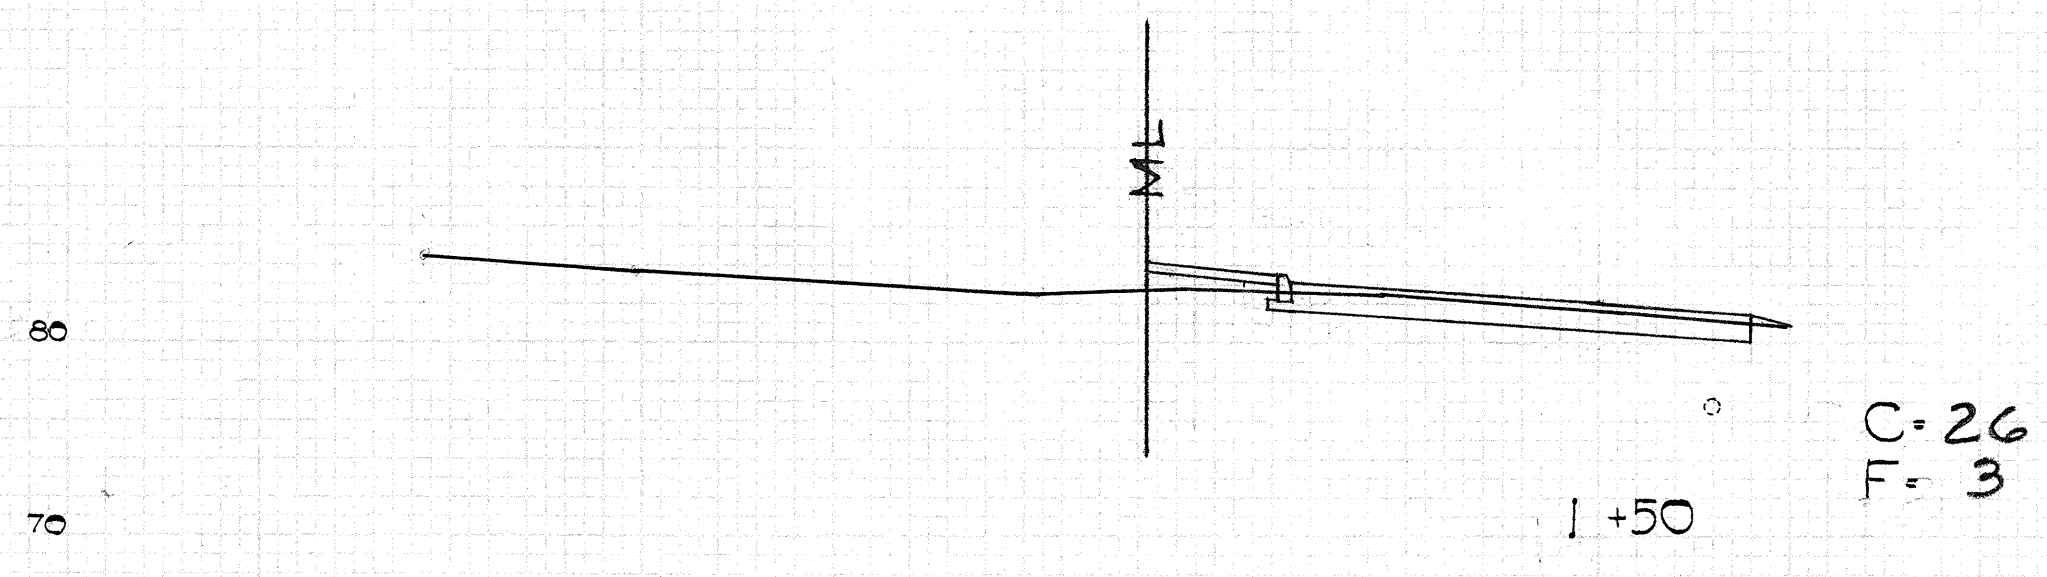


Exc = 51
Emb = 3

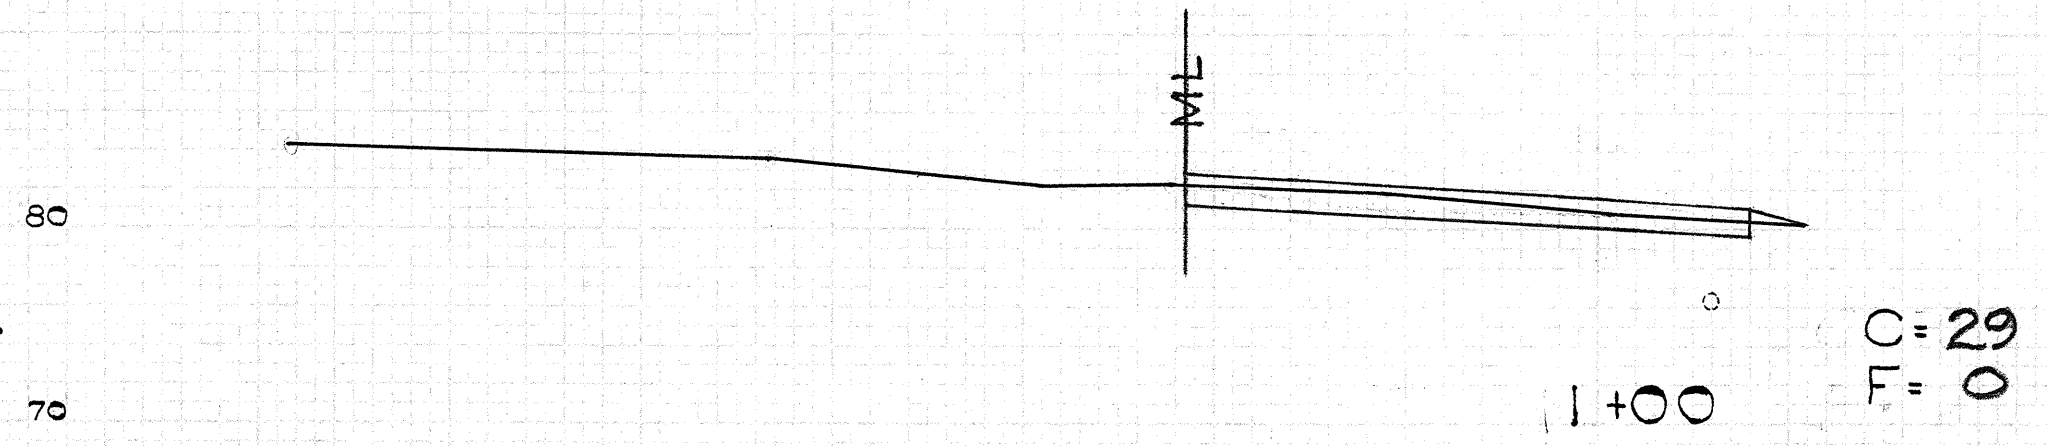

Exc = 50
Emb = 0

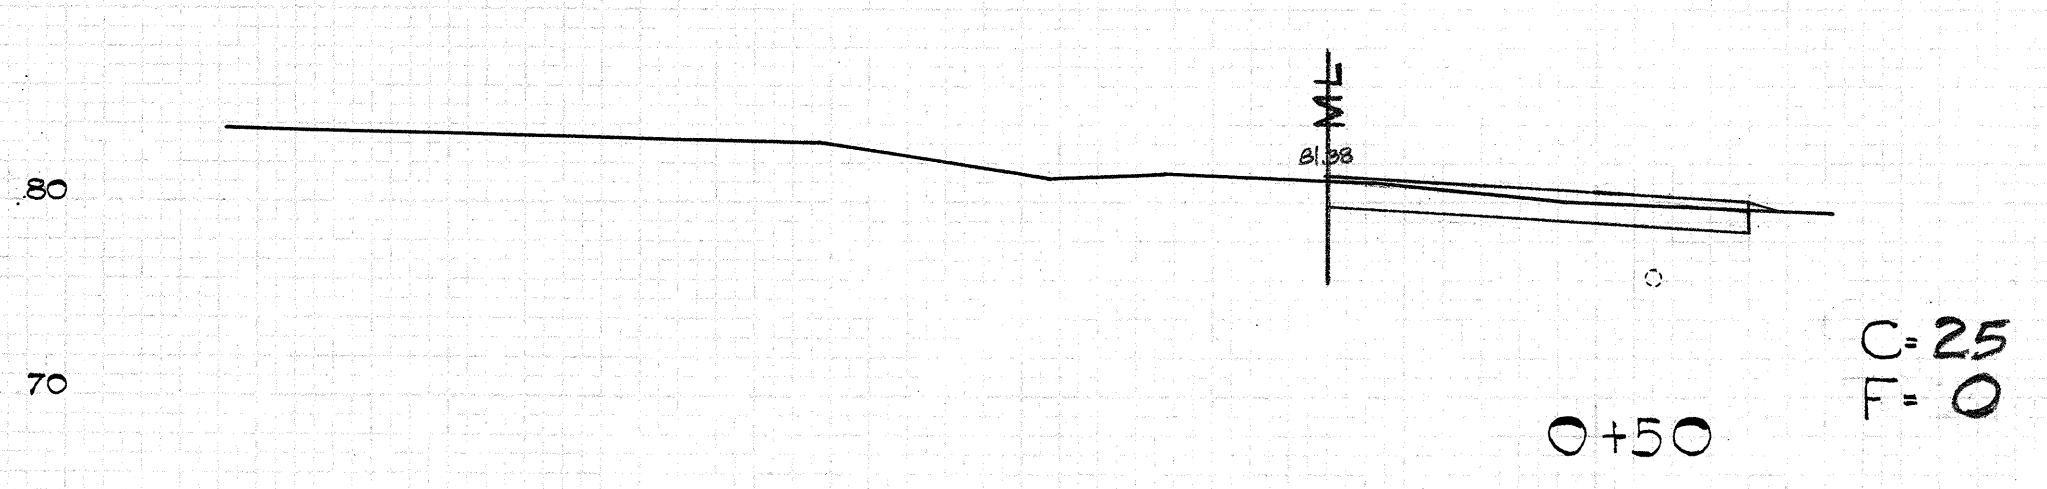


Exc = 23
Emb = 0

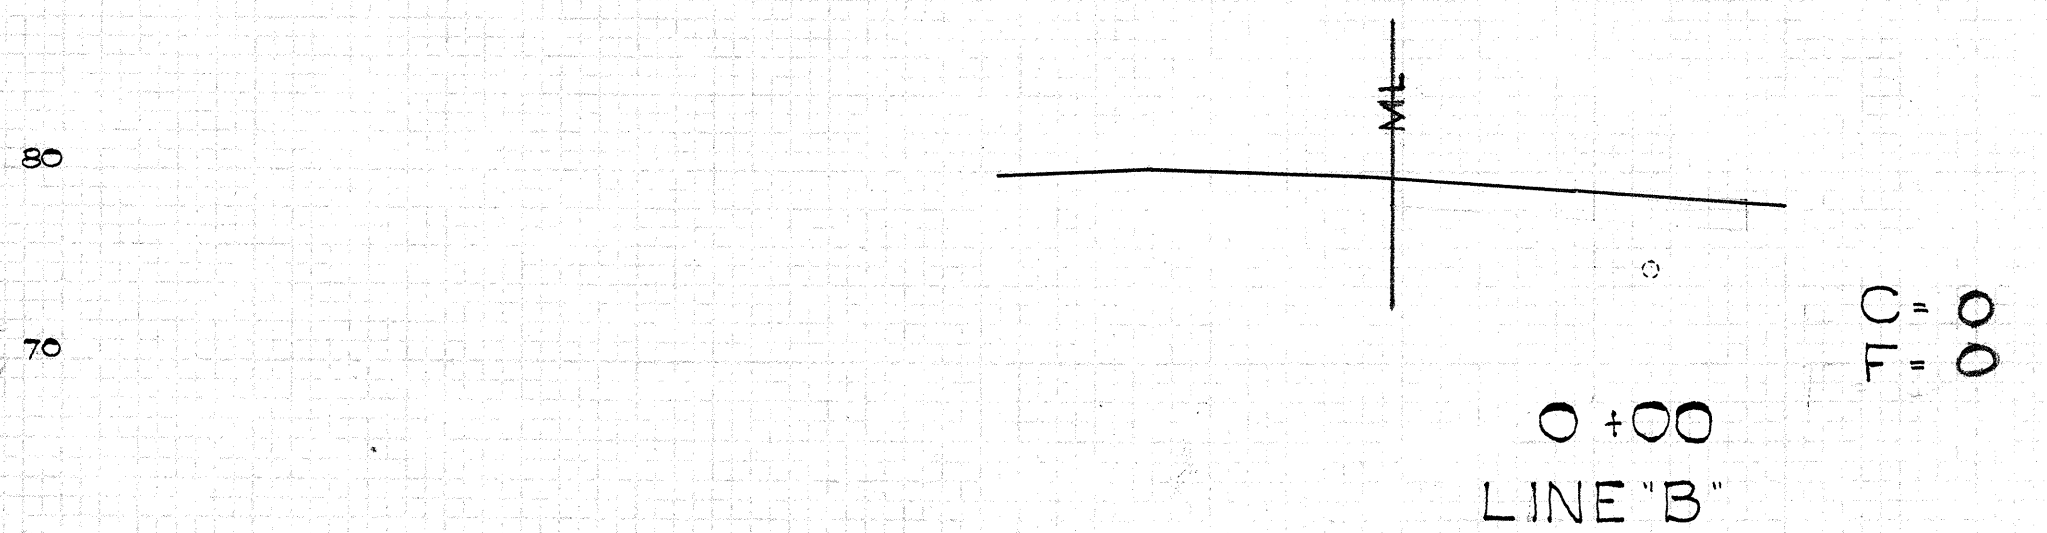


0+00
LINE "B"

70 60 50 40 30 20 10 0 E.P. RIGHT 10 20


Exc =
Emb =

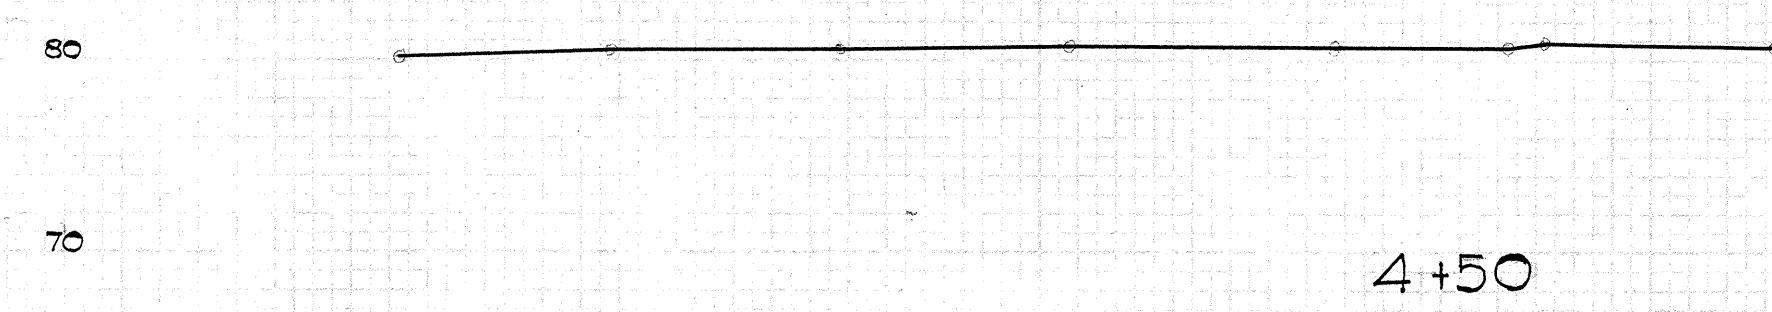



Exc =
Emb =

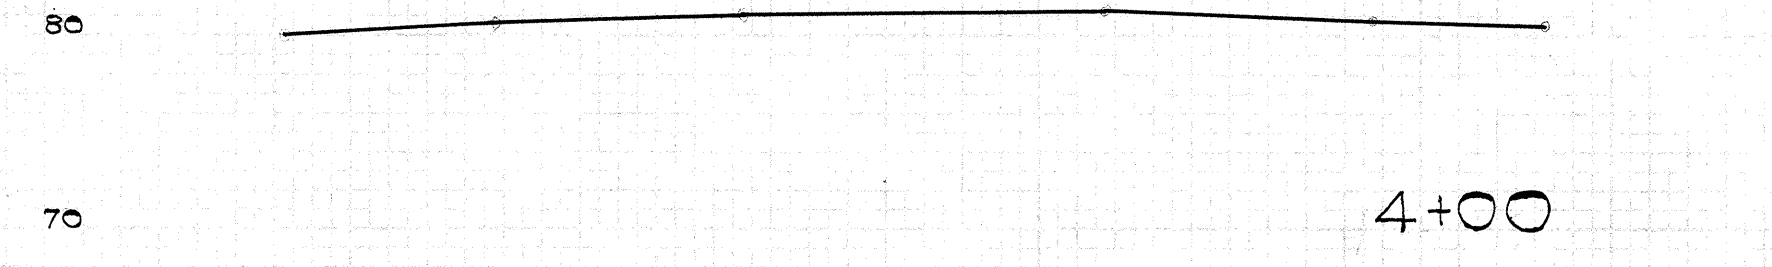

Exc = 61
Emb = 0

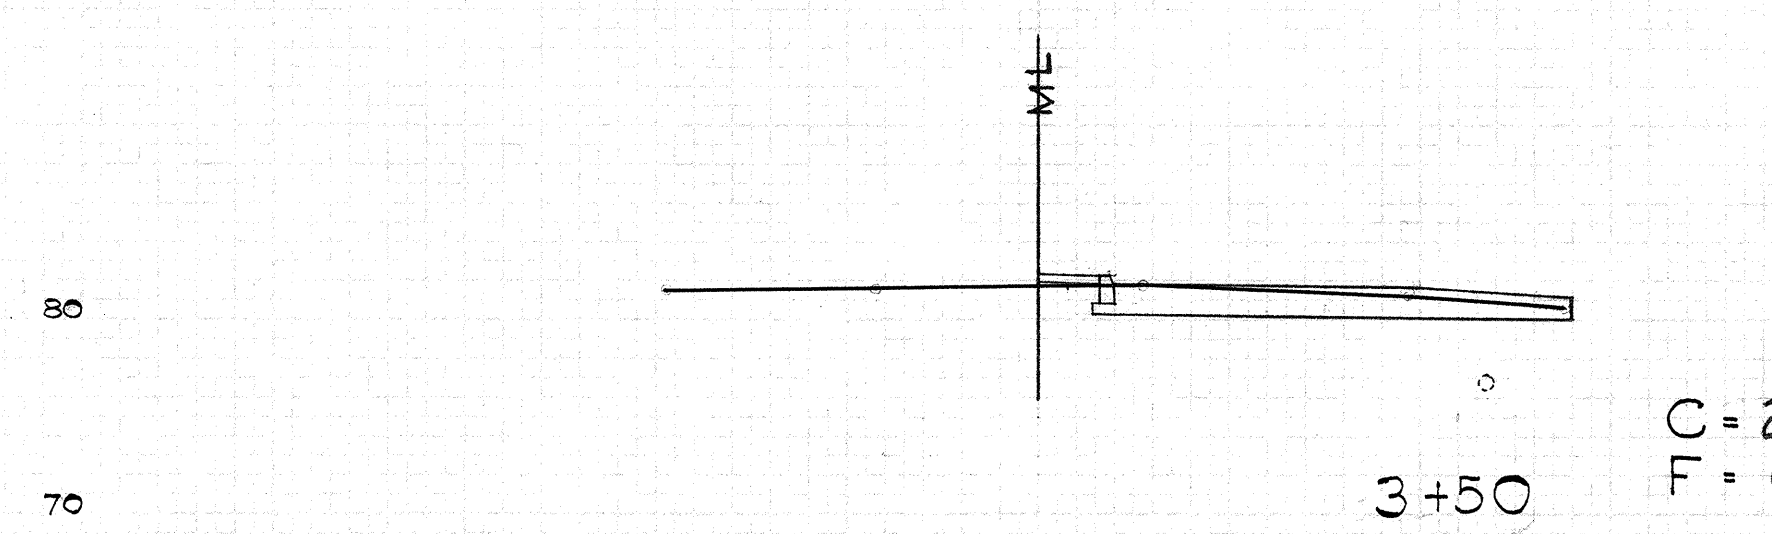


Exc = 69
Emb = 0

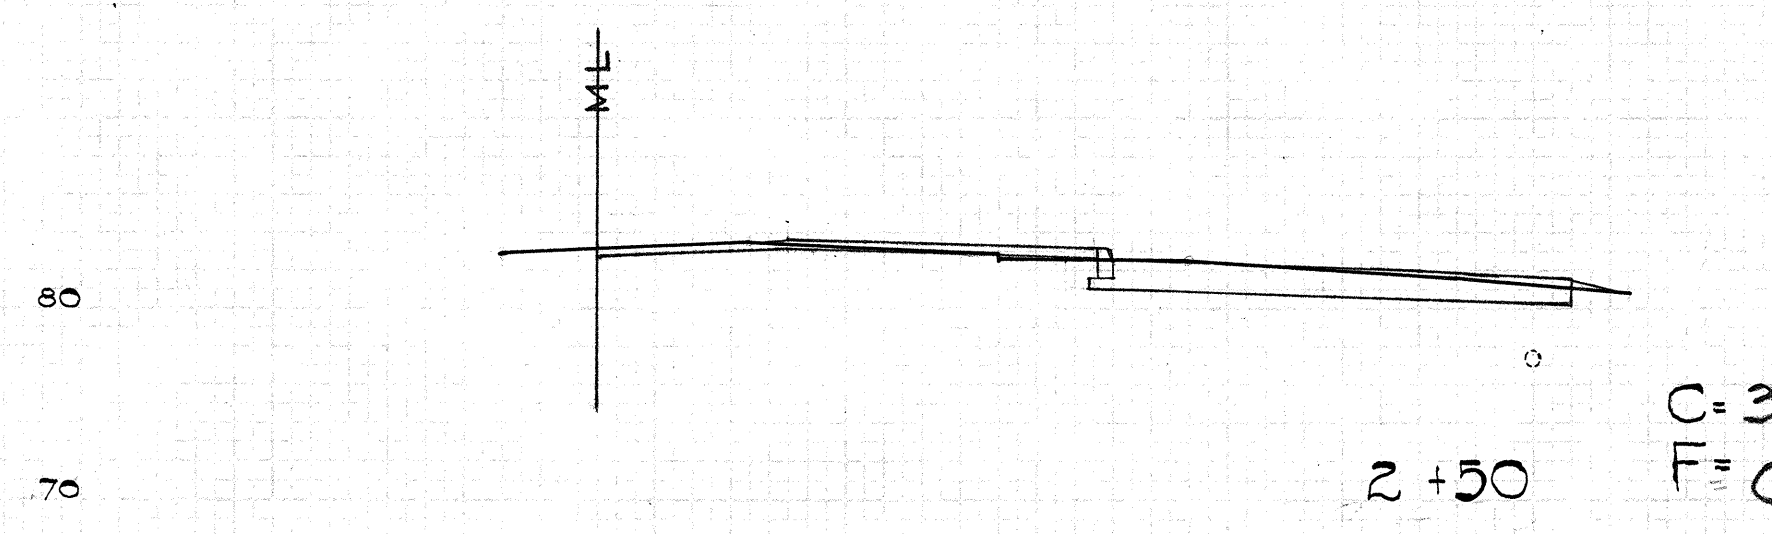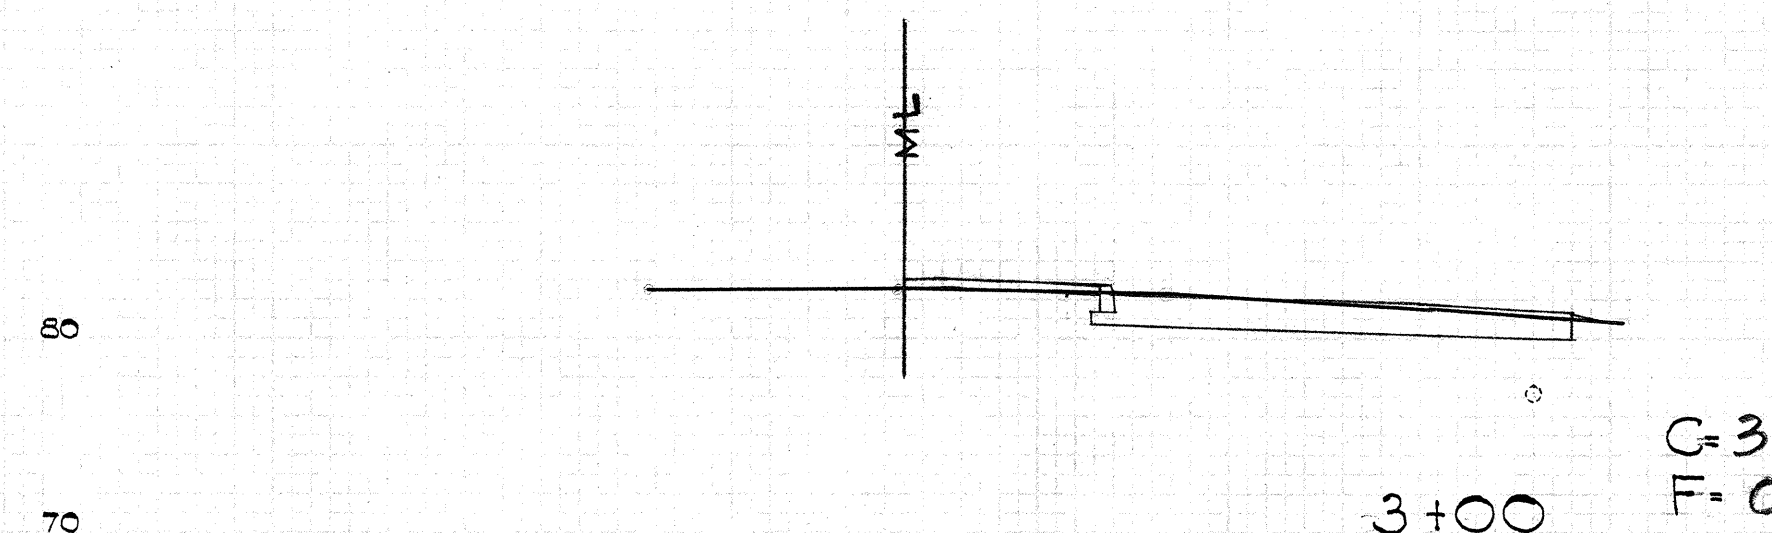


2+50
C=37
F=0

50 40 30 20 10 0 E.P. RIGHT 10 20


Exc = 43
Emb = 4

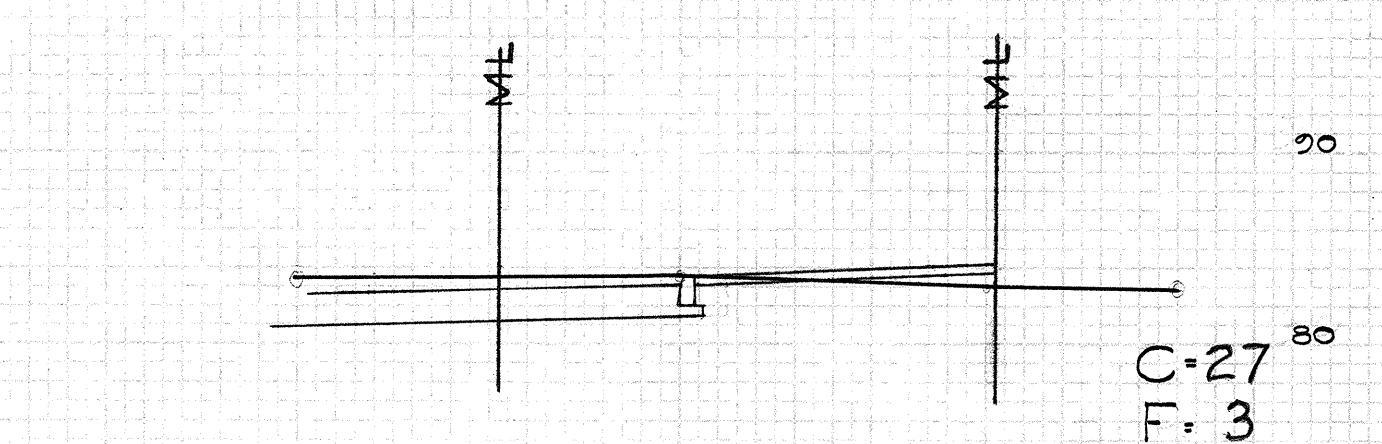


Exc = 106
Emb = 9

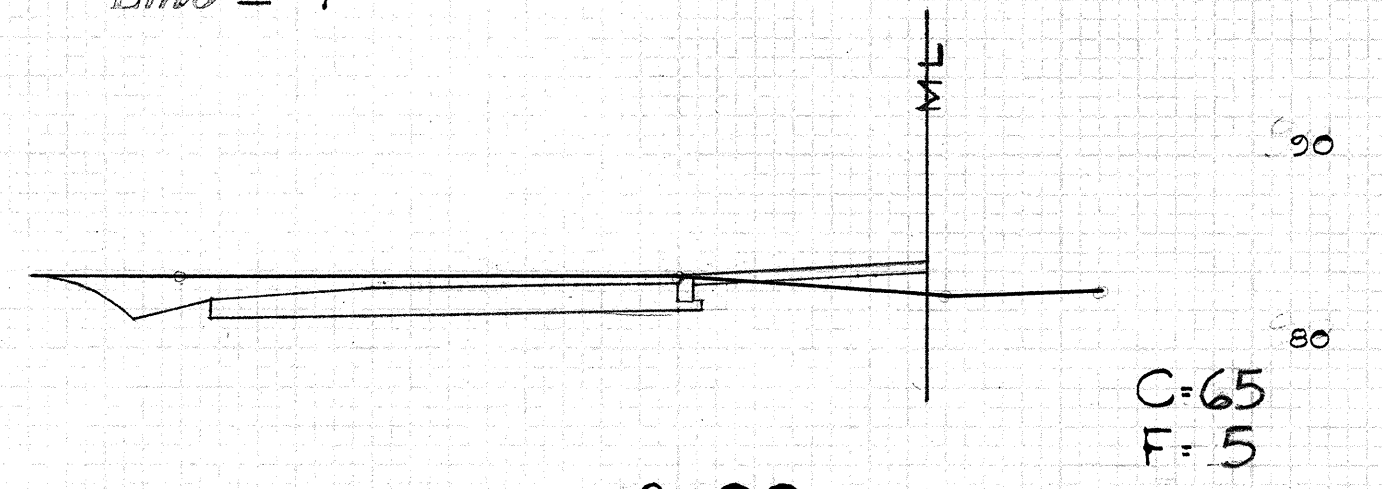



Exc = 93
Emb = 5

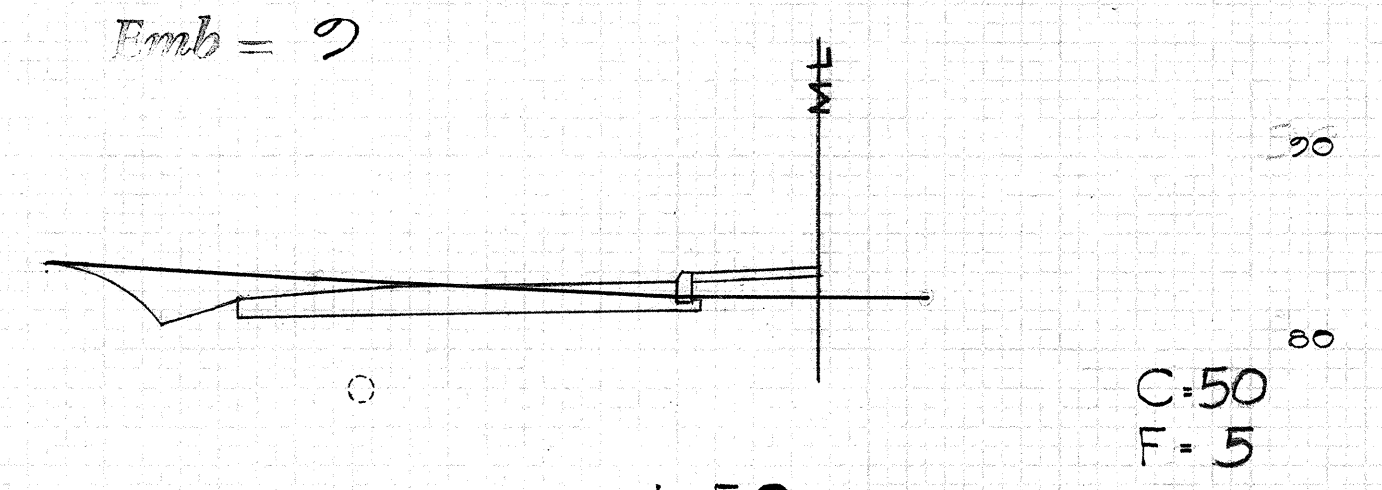

Exc = 86
Emb = 0

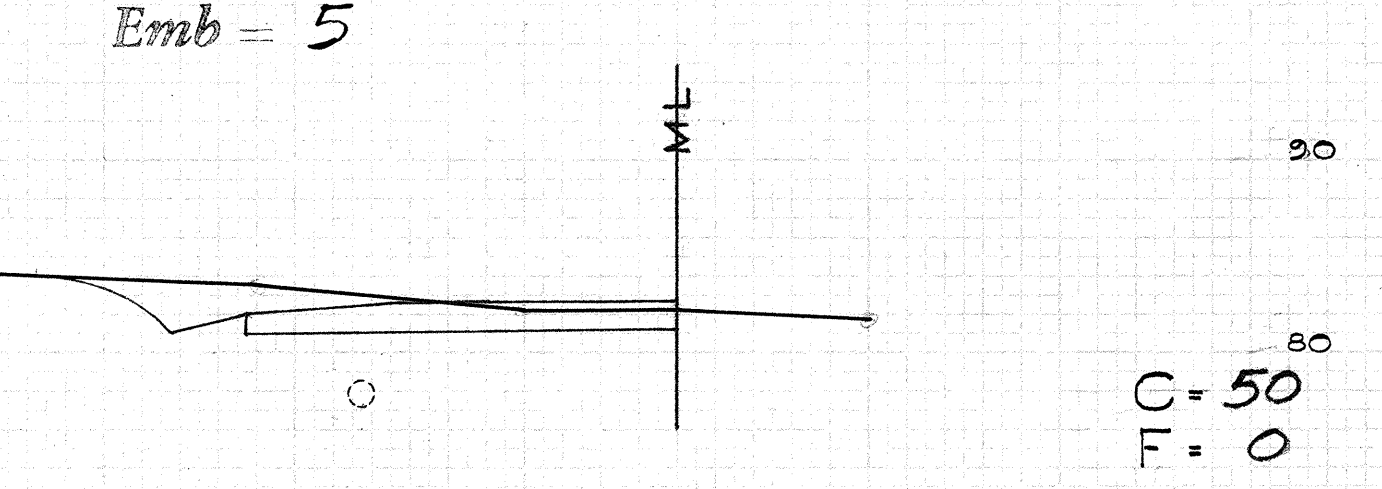

Exc = 40
Emb = 0

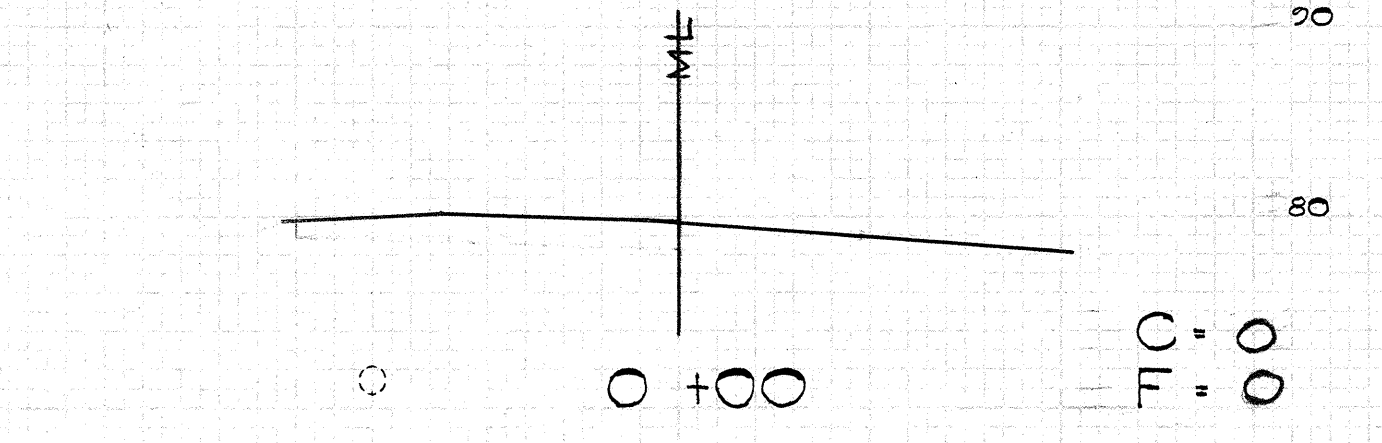
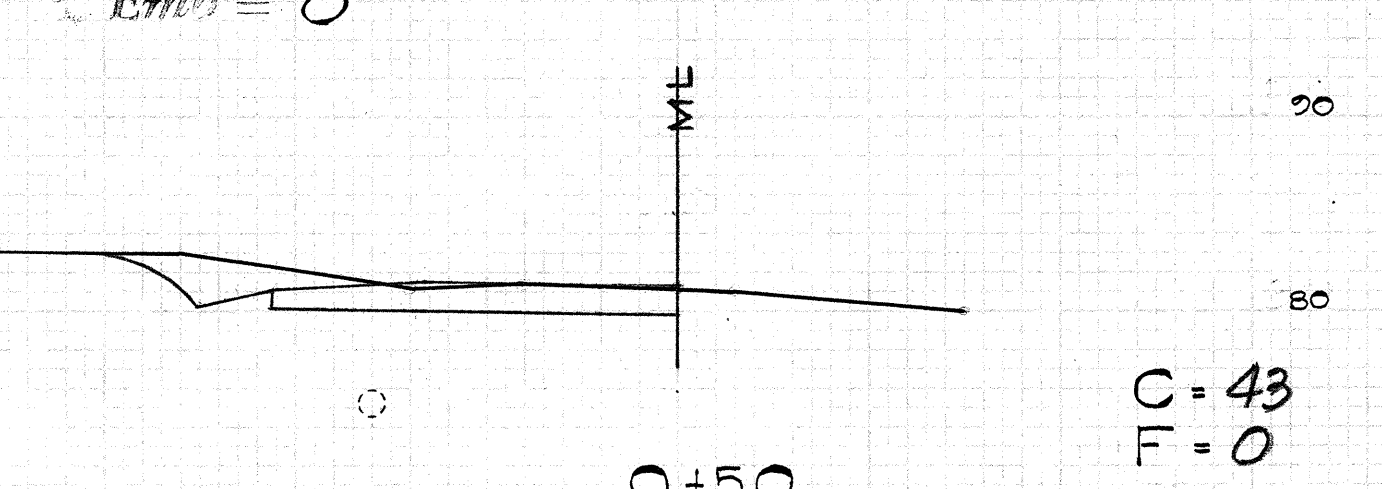


0+00
LINE "A"


40 30 20 10 0 10 20

FED. ROAD DIST. NO.	STATE	FED. AID PROJ. NO.	FISCAL YEAR	SHEET NO.	TOTAL SHEETS
HAWAII	HAW	F-020-1(8)	1963	52	53

KUNIA "A"

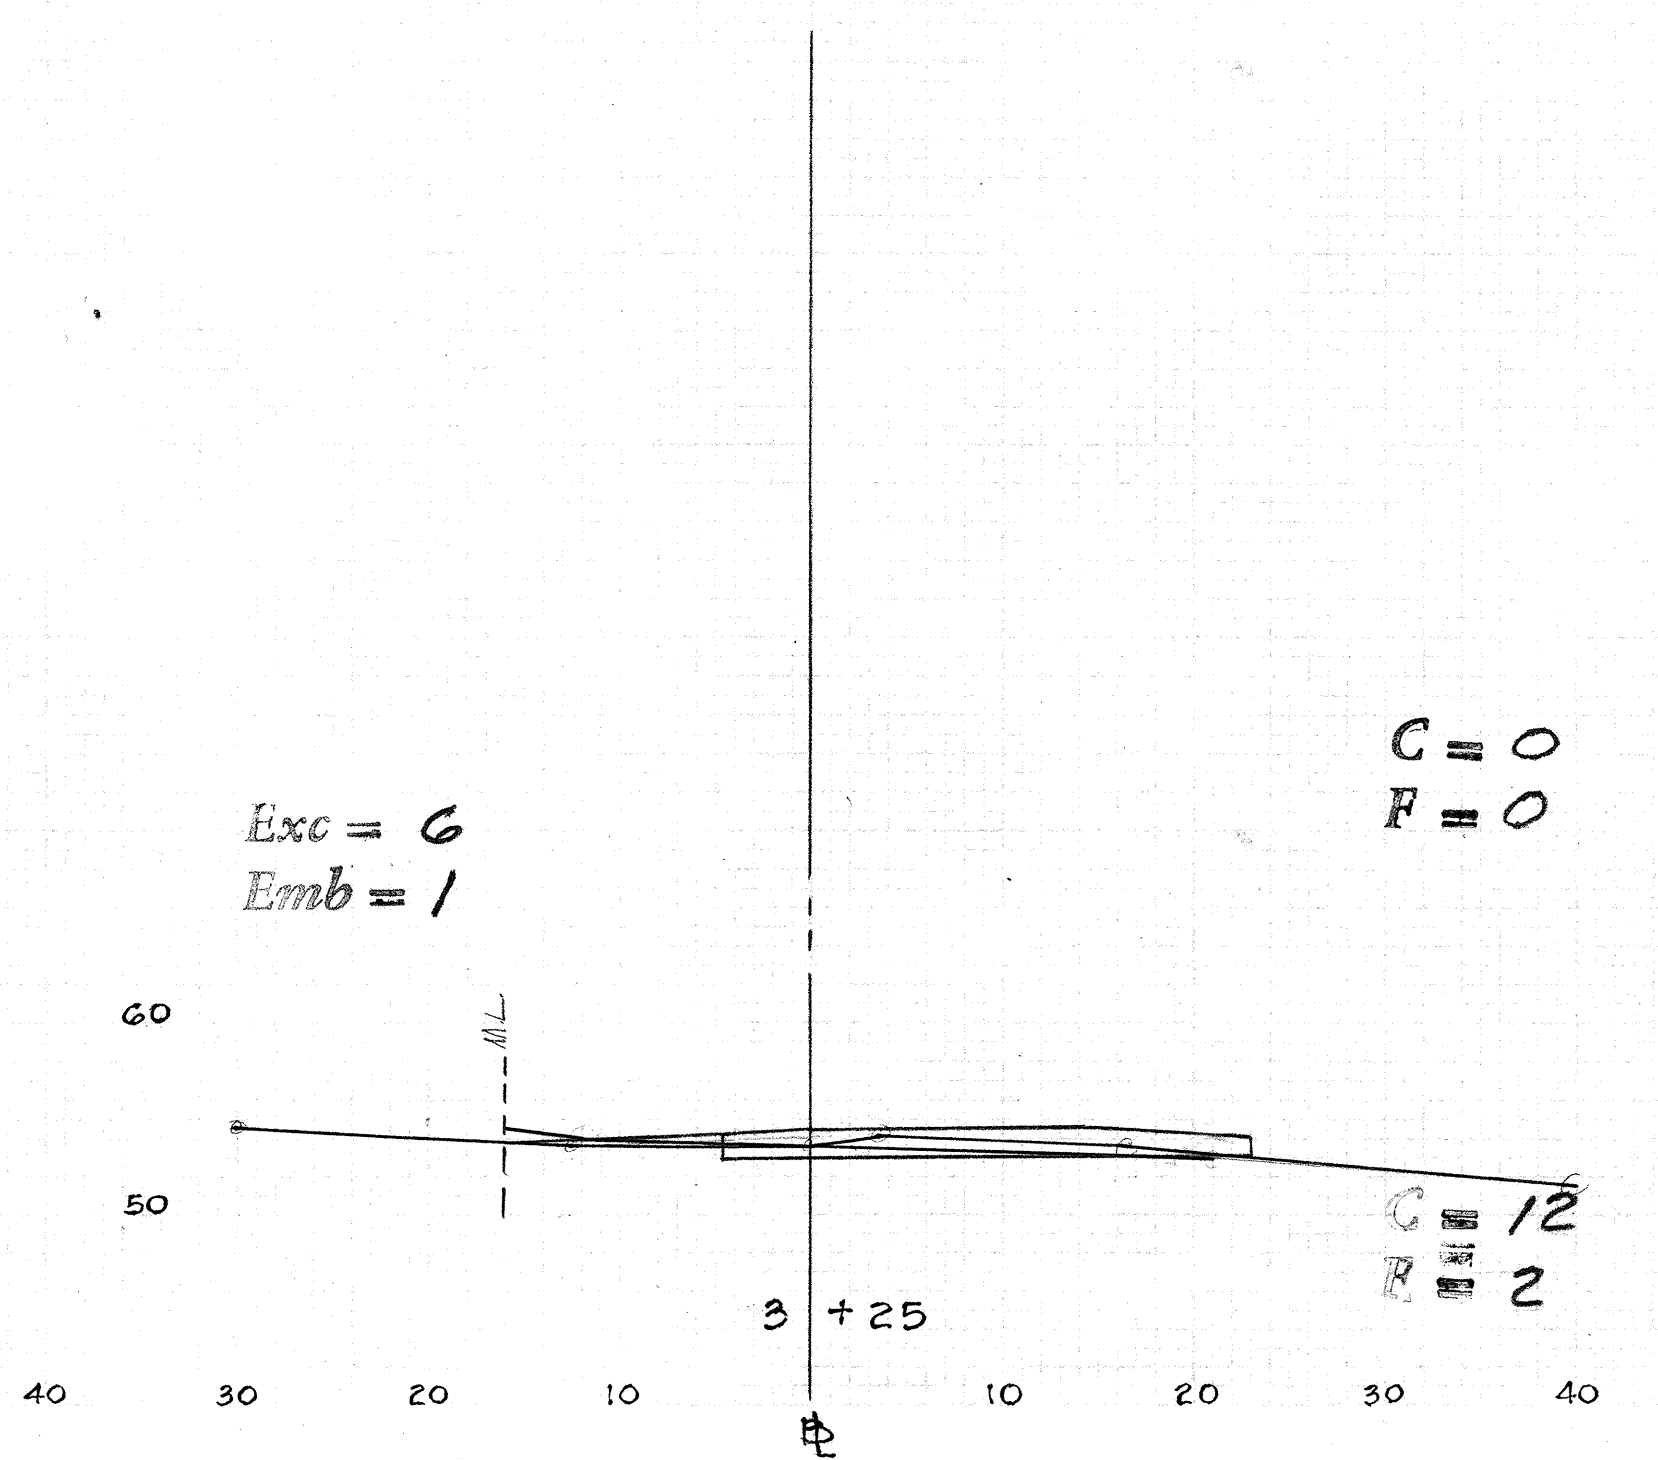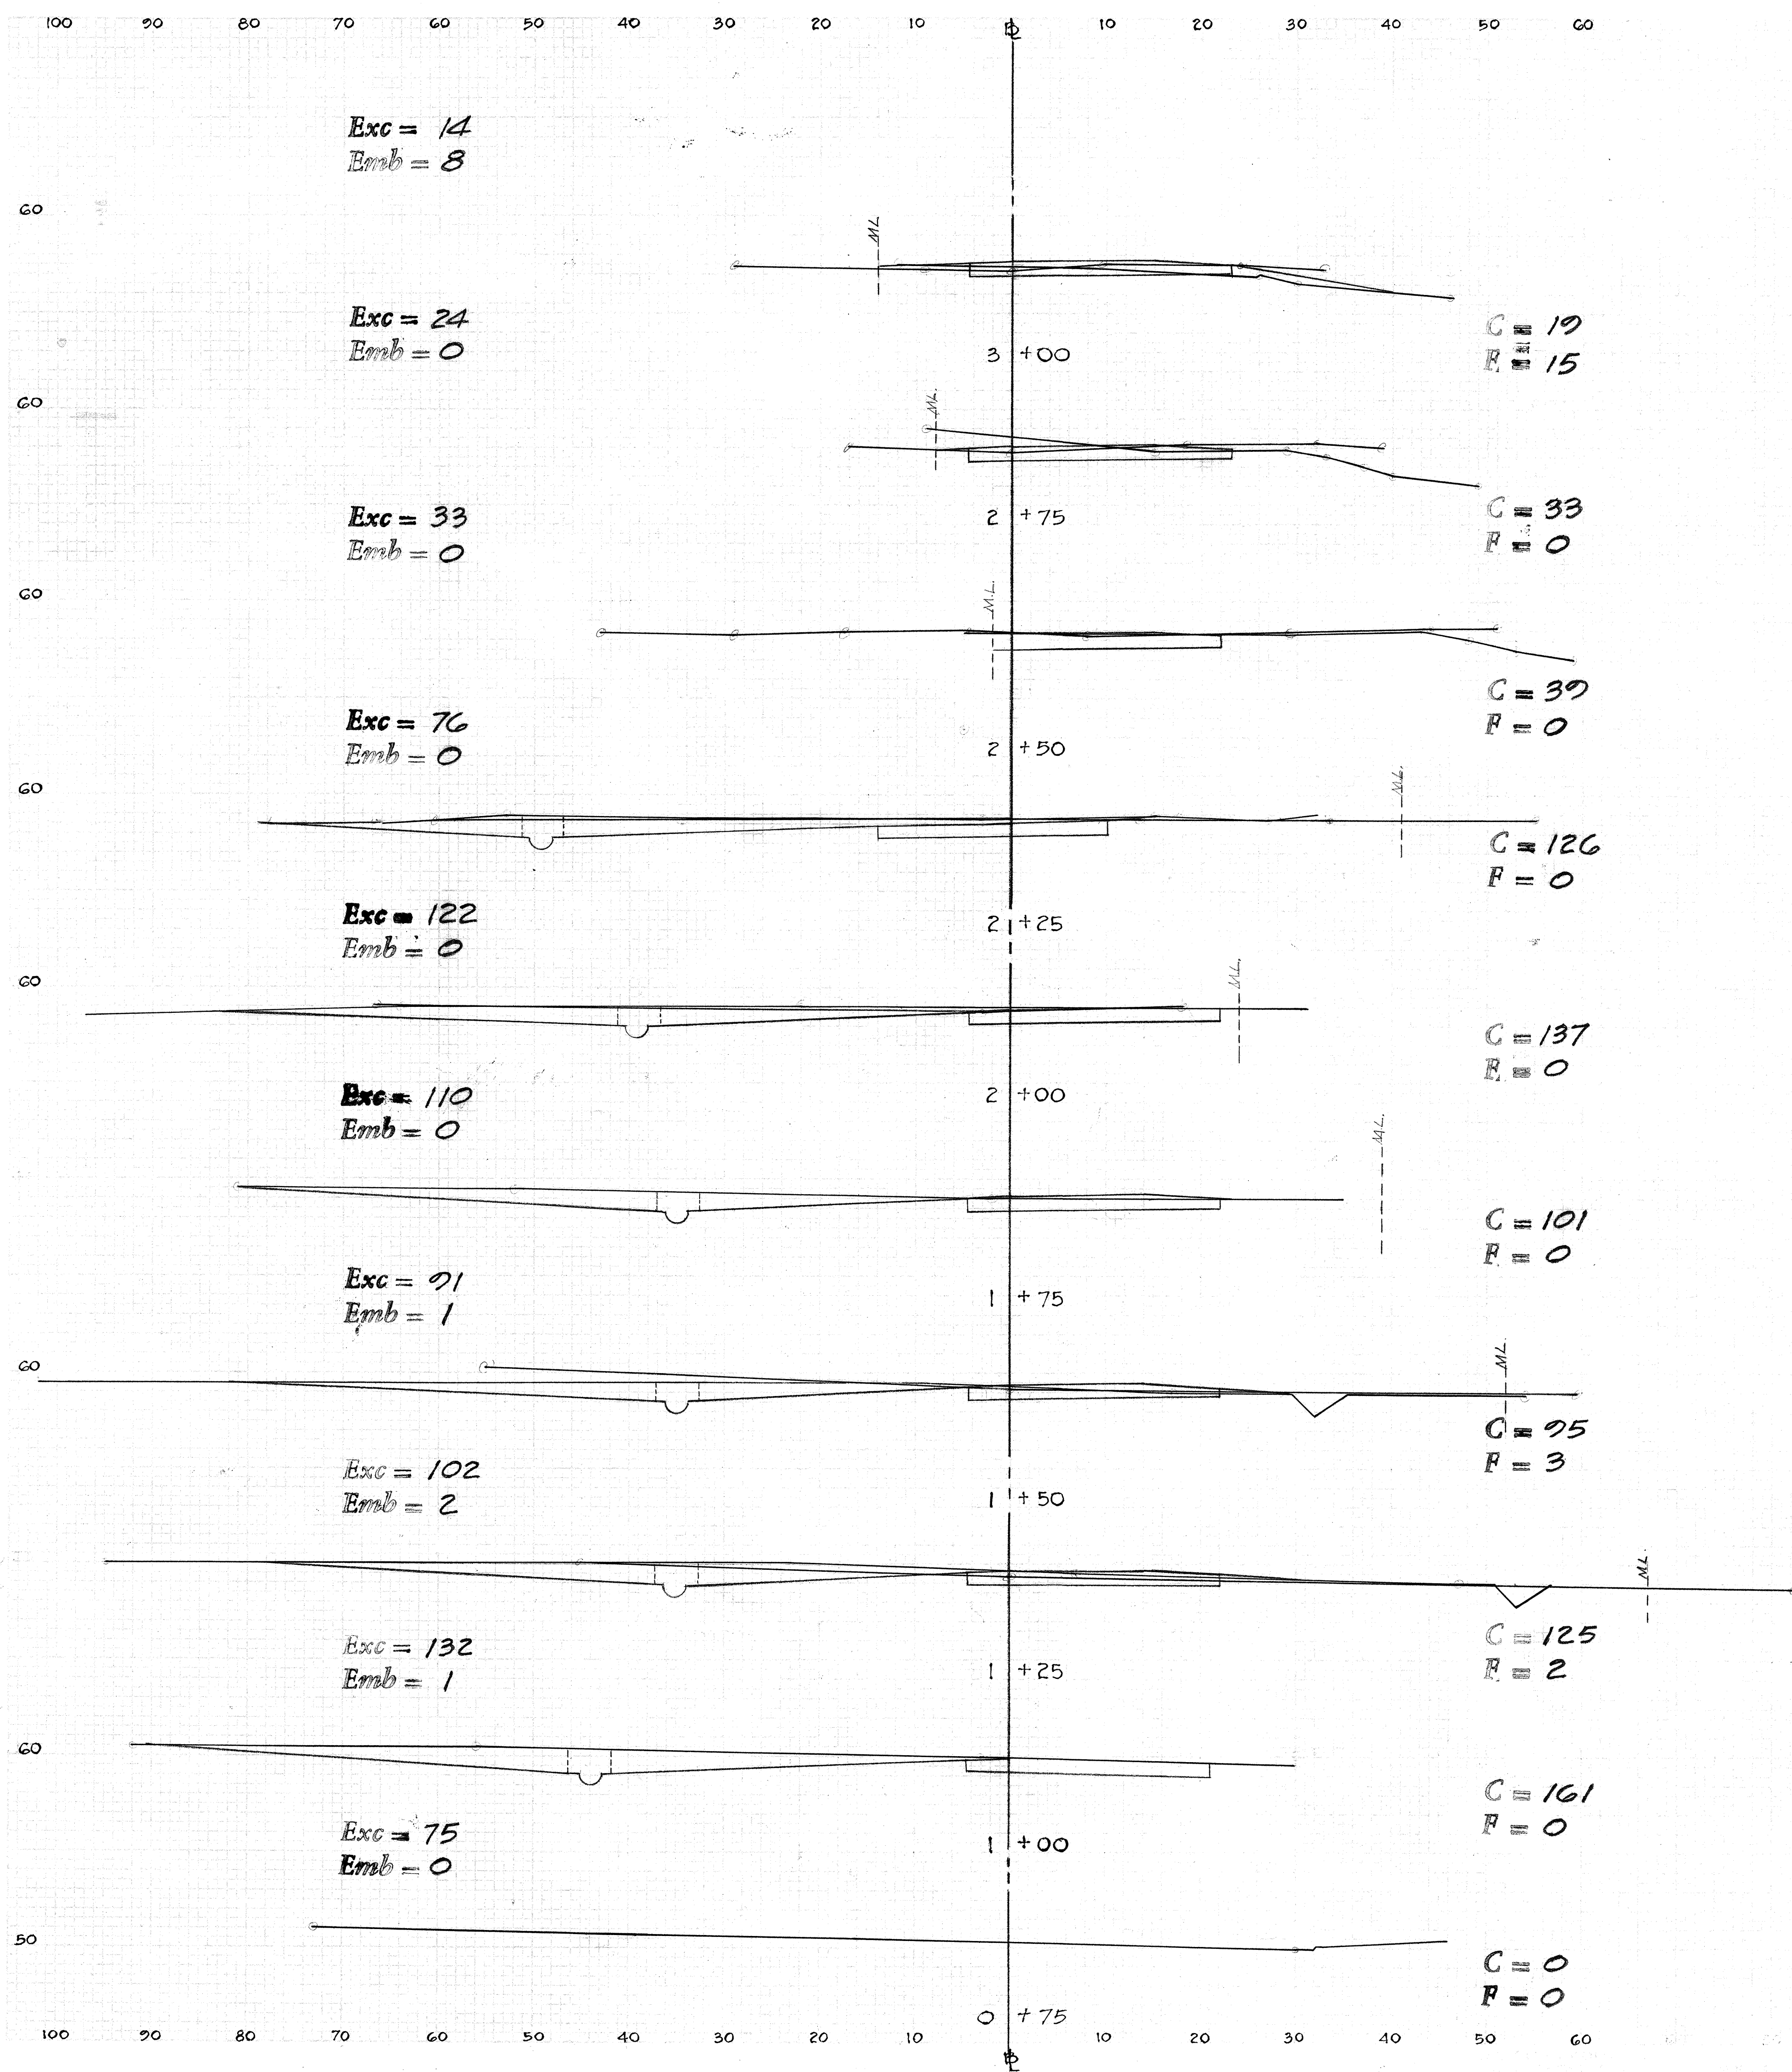

FED. ROAD DIST. NO.	STATE	FED. AID PROJ. NO.	FISCAL YEAR	SHEET NO.	TOTAL SHEETS
HAWAII	HAW	F000-16	1963	53	53

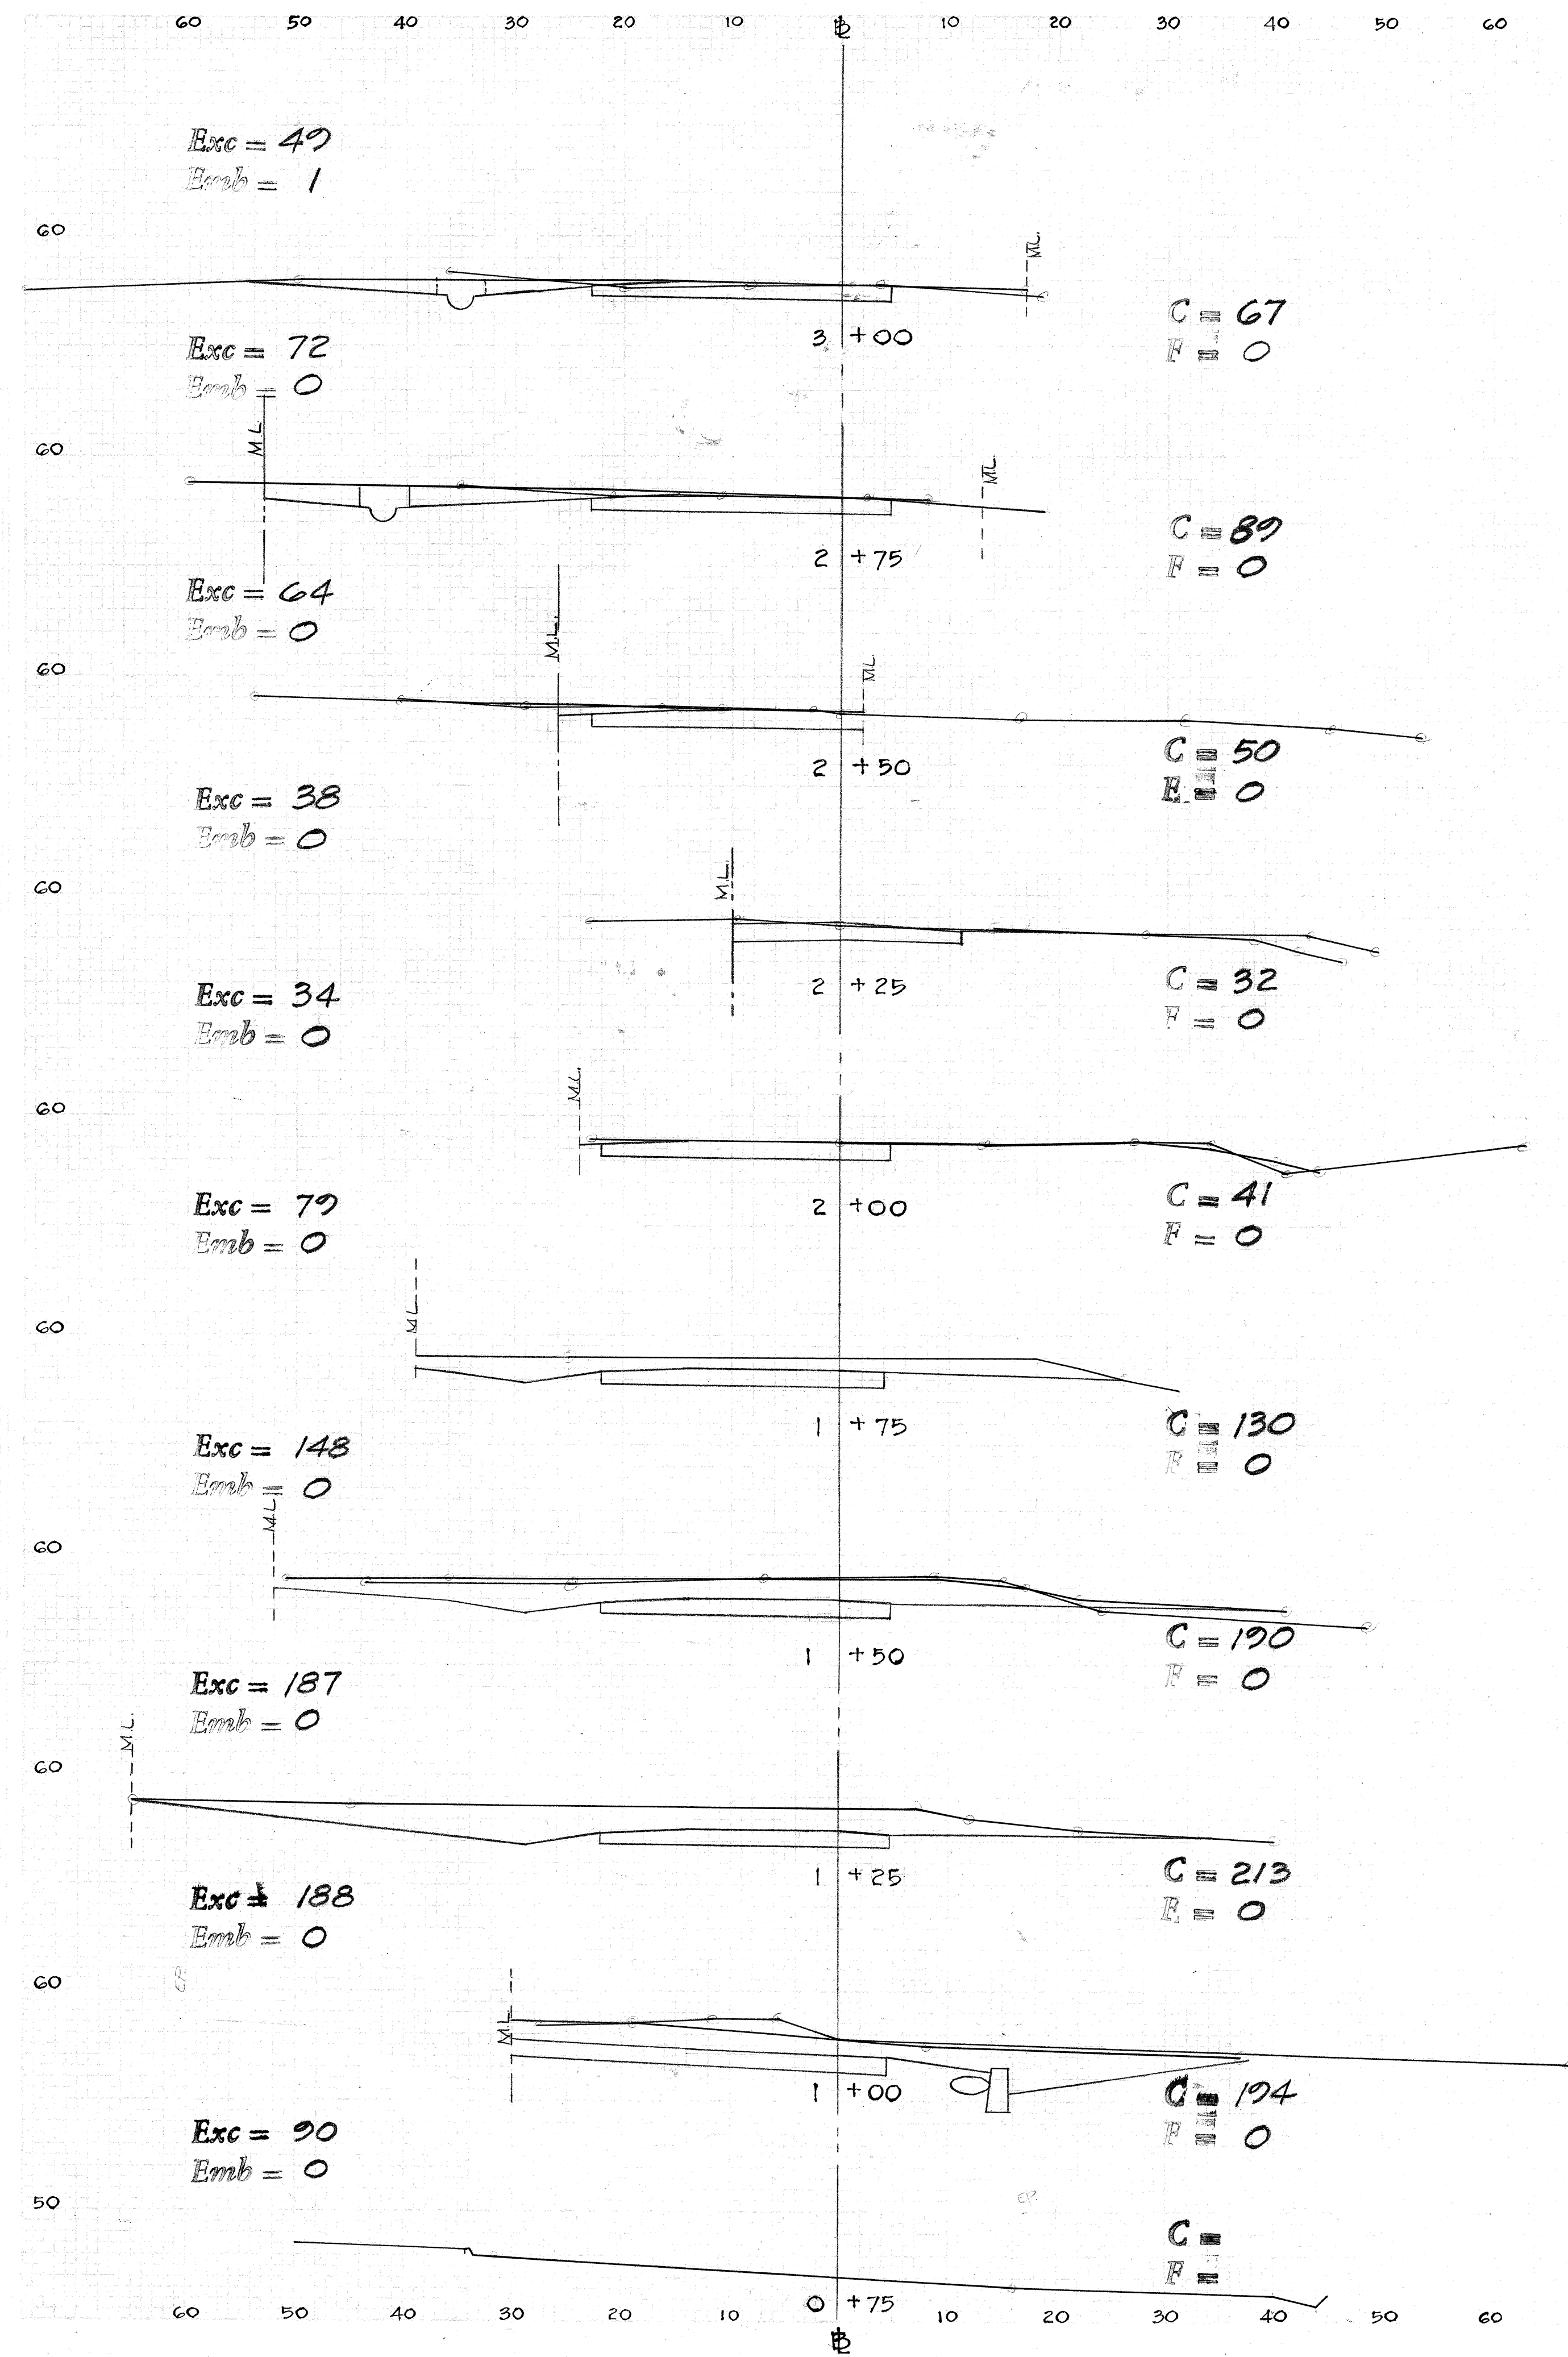

KUNIA "B"

