
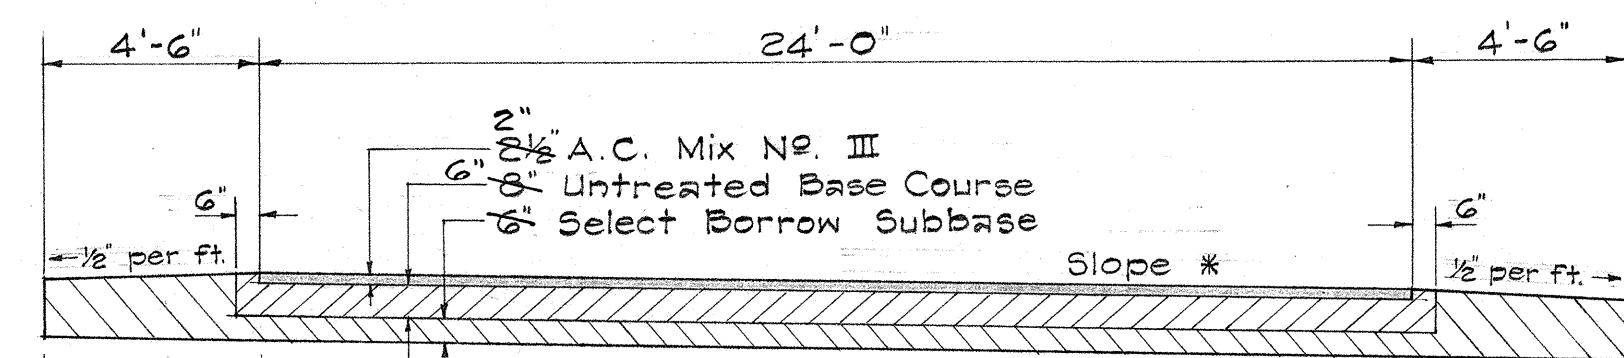


FED. ROAD DIST. NO.	STATE	FED. AID PROJ. NO.	FISCAL YEAR	SHEET NO.	TOTAL SHEETS
HAWAII	HAW.	F-090-1(8)	1963	26	53

REVISED 3-10-64

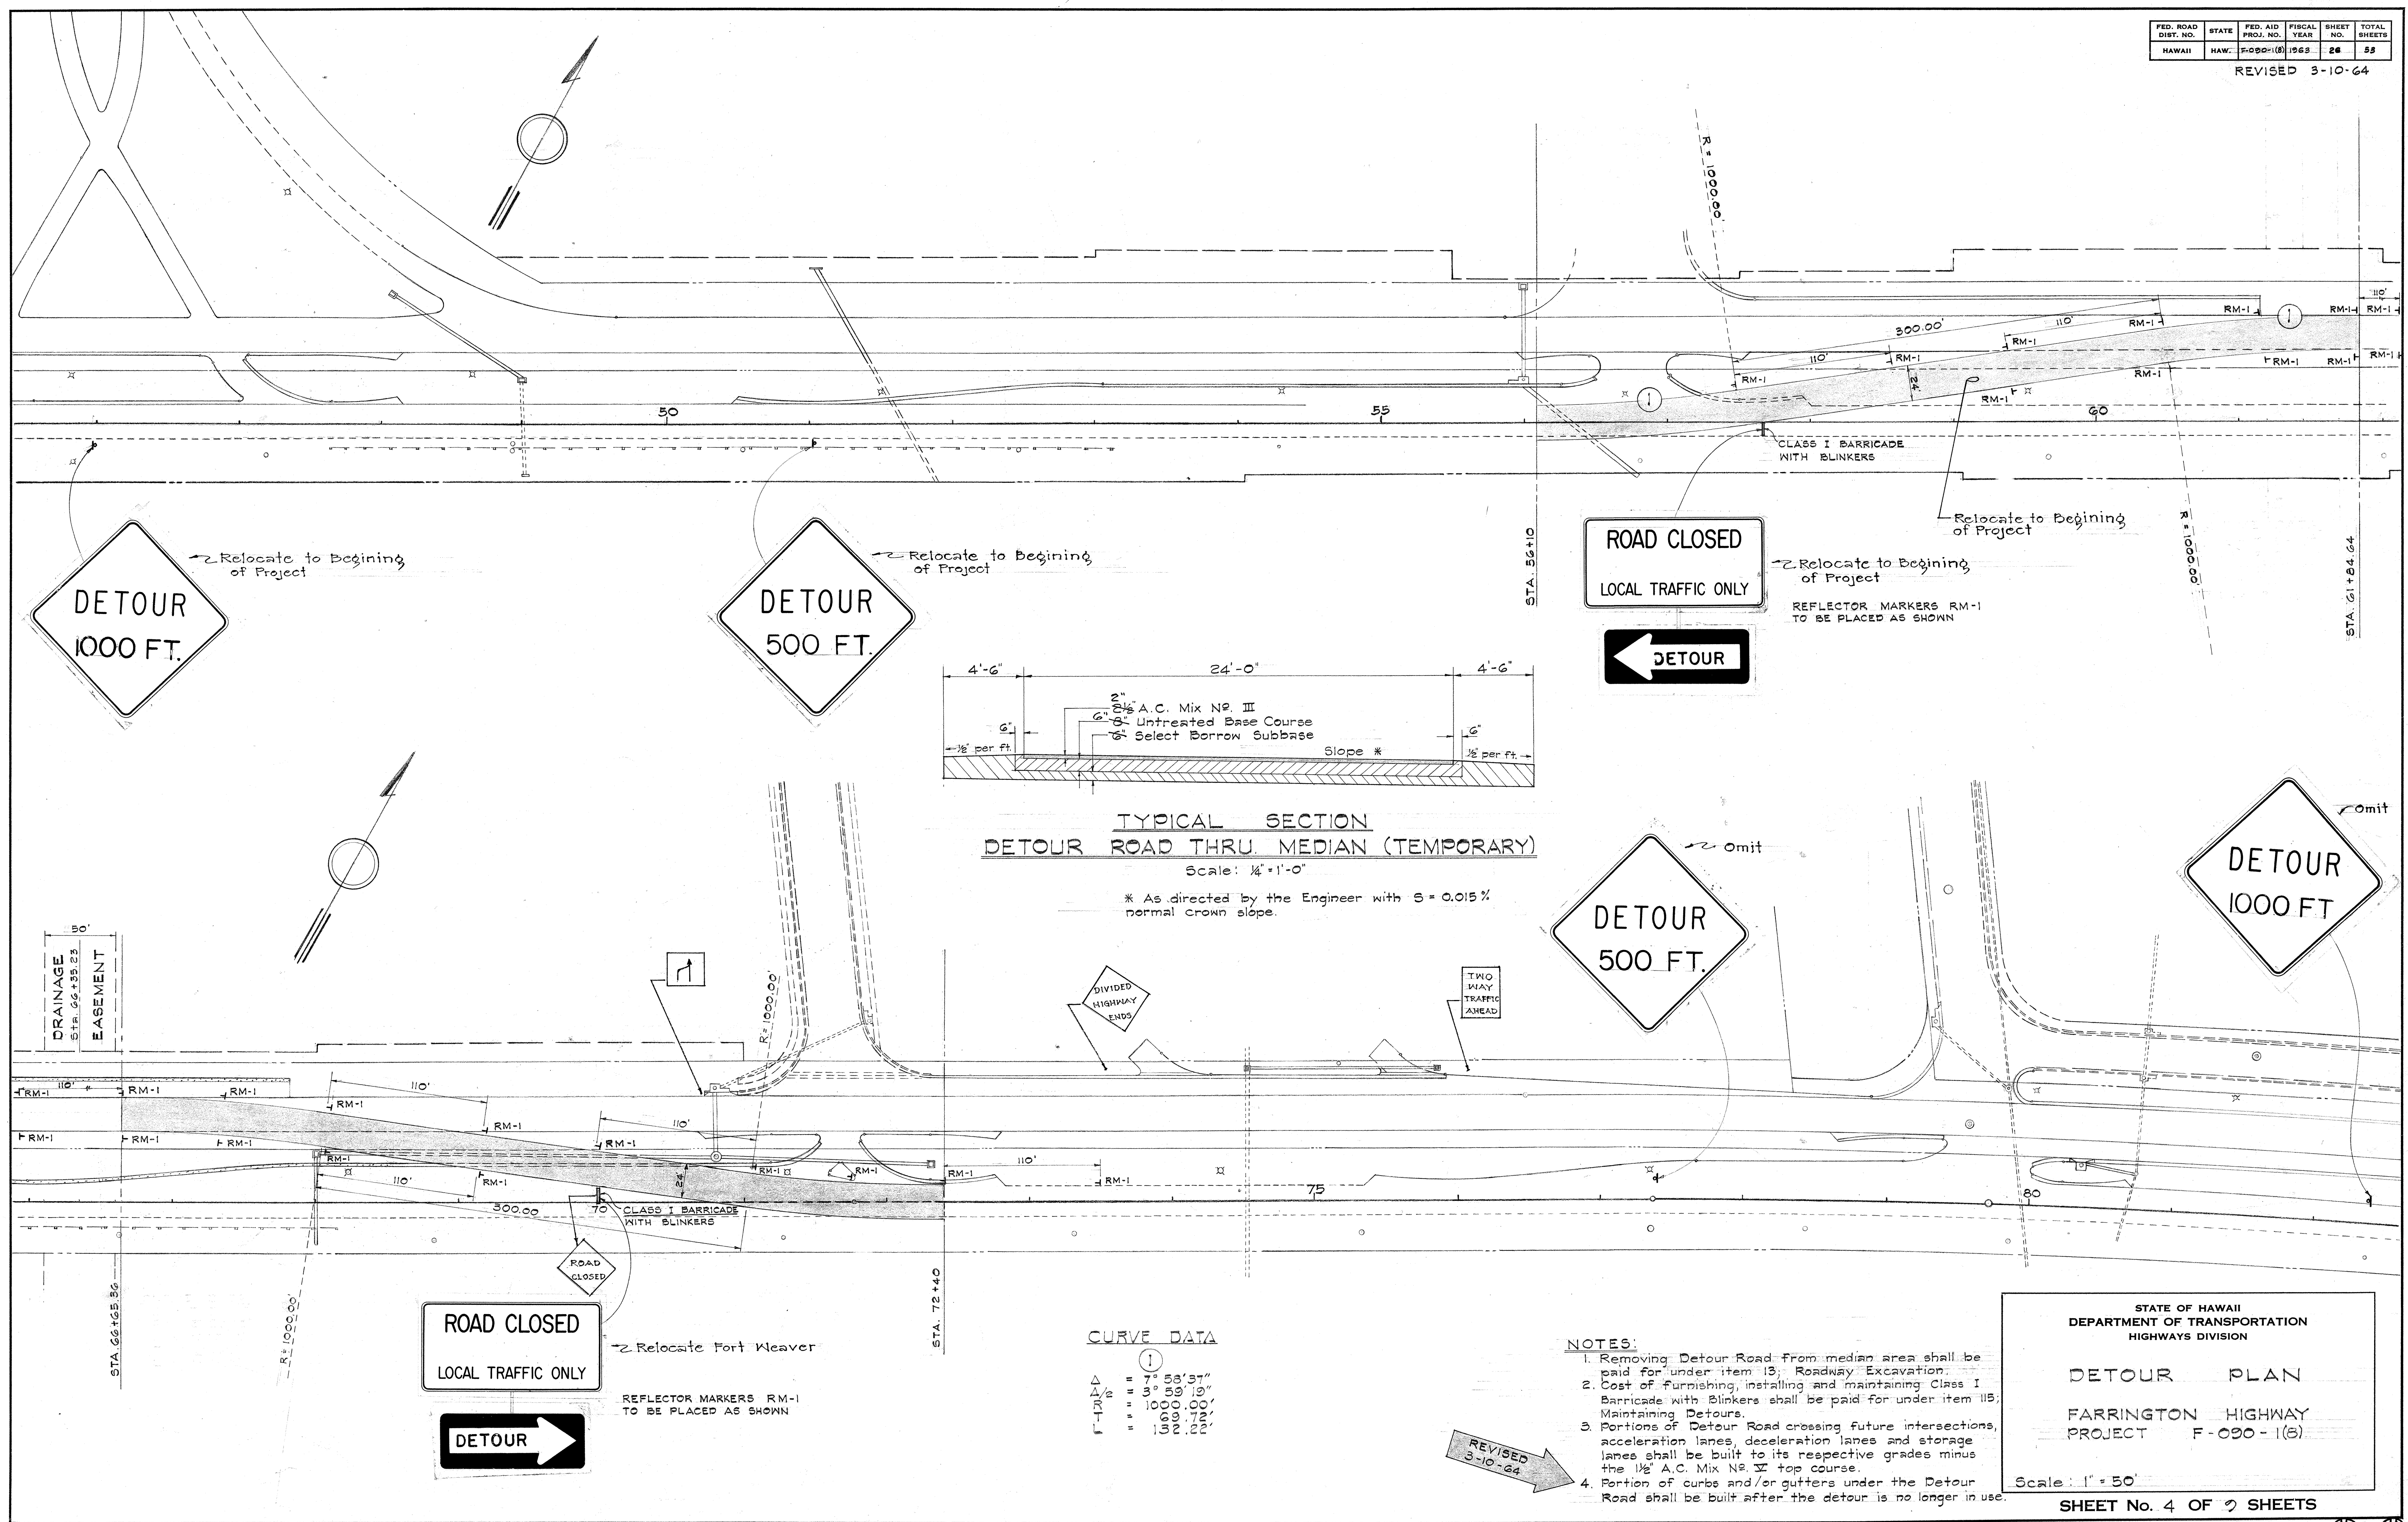

CURVE DATA

1	7° 53' 37"
2	3° 59' 19"
3	100° 00' 00"
4	132° 22' 00"

- NOTES:**
1. Removing Detour Road from median area shall be paid for under item 13: Roadway Excavation.
 2. Cost of furnishing, installing and maintaining Class I Barricade with Blinkers shall be paid for under item 115: Maintaining Detours.
 3. Portions of Detour Road crossing future intersections, acceleration lanes, deceleration lanes and storage lanes shall be built to its respective grades minus the 1/2" A.C. Mix No. III top course.
 4. Portion of curbs and/or gutters under the Detour Road shall be built after the detour is no longer in use.

STATE OF HAWAII
DEPARTMENT OF TRANSPORTATION
HIGHWAYS DIVISION

DETOUR PLAN

FARRINGTON HIGHWAY
PROJECT F-090-1(8)

Scale: 1" = 50'

SHEET No. 4 OF 2 SHEETS

SURVEY PLOTTED BY	DATE
DRAWN BY	
DESIGNED BY	
QUANTITIES BY	
CHECKED BY	