
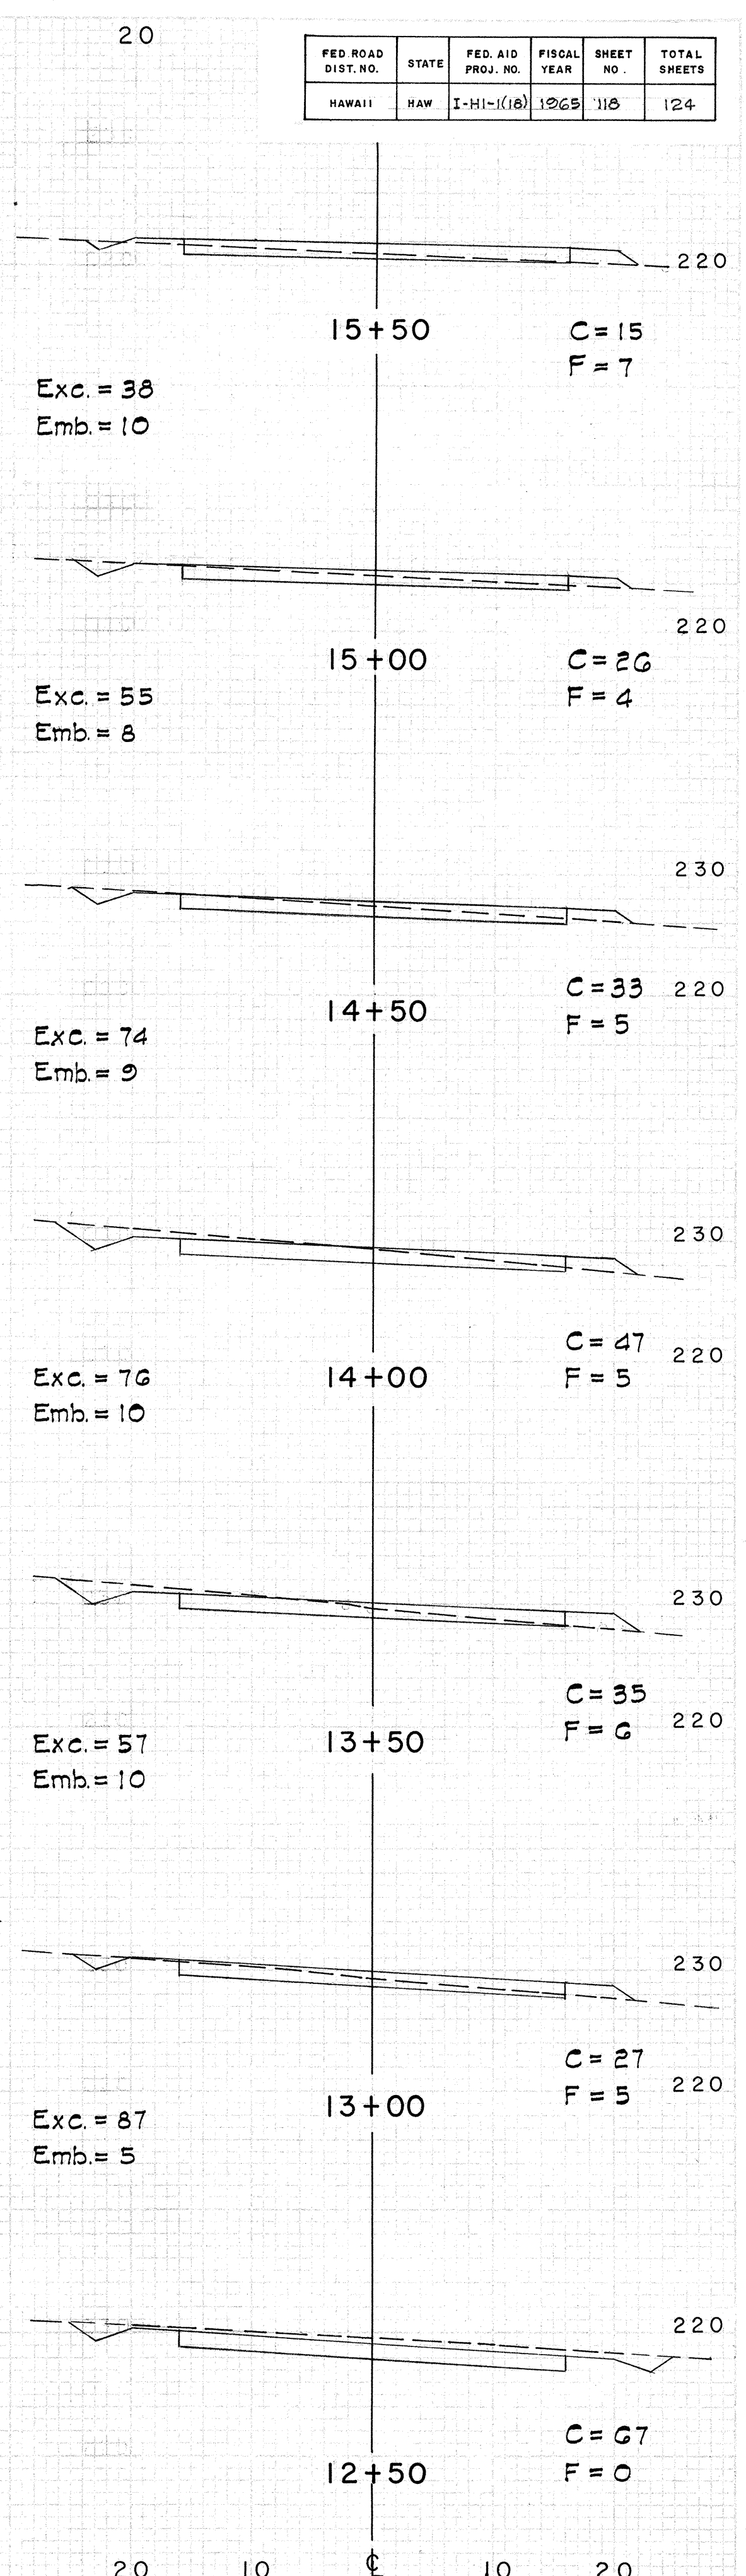
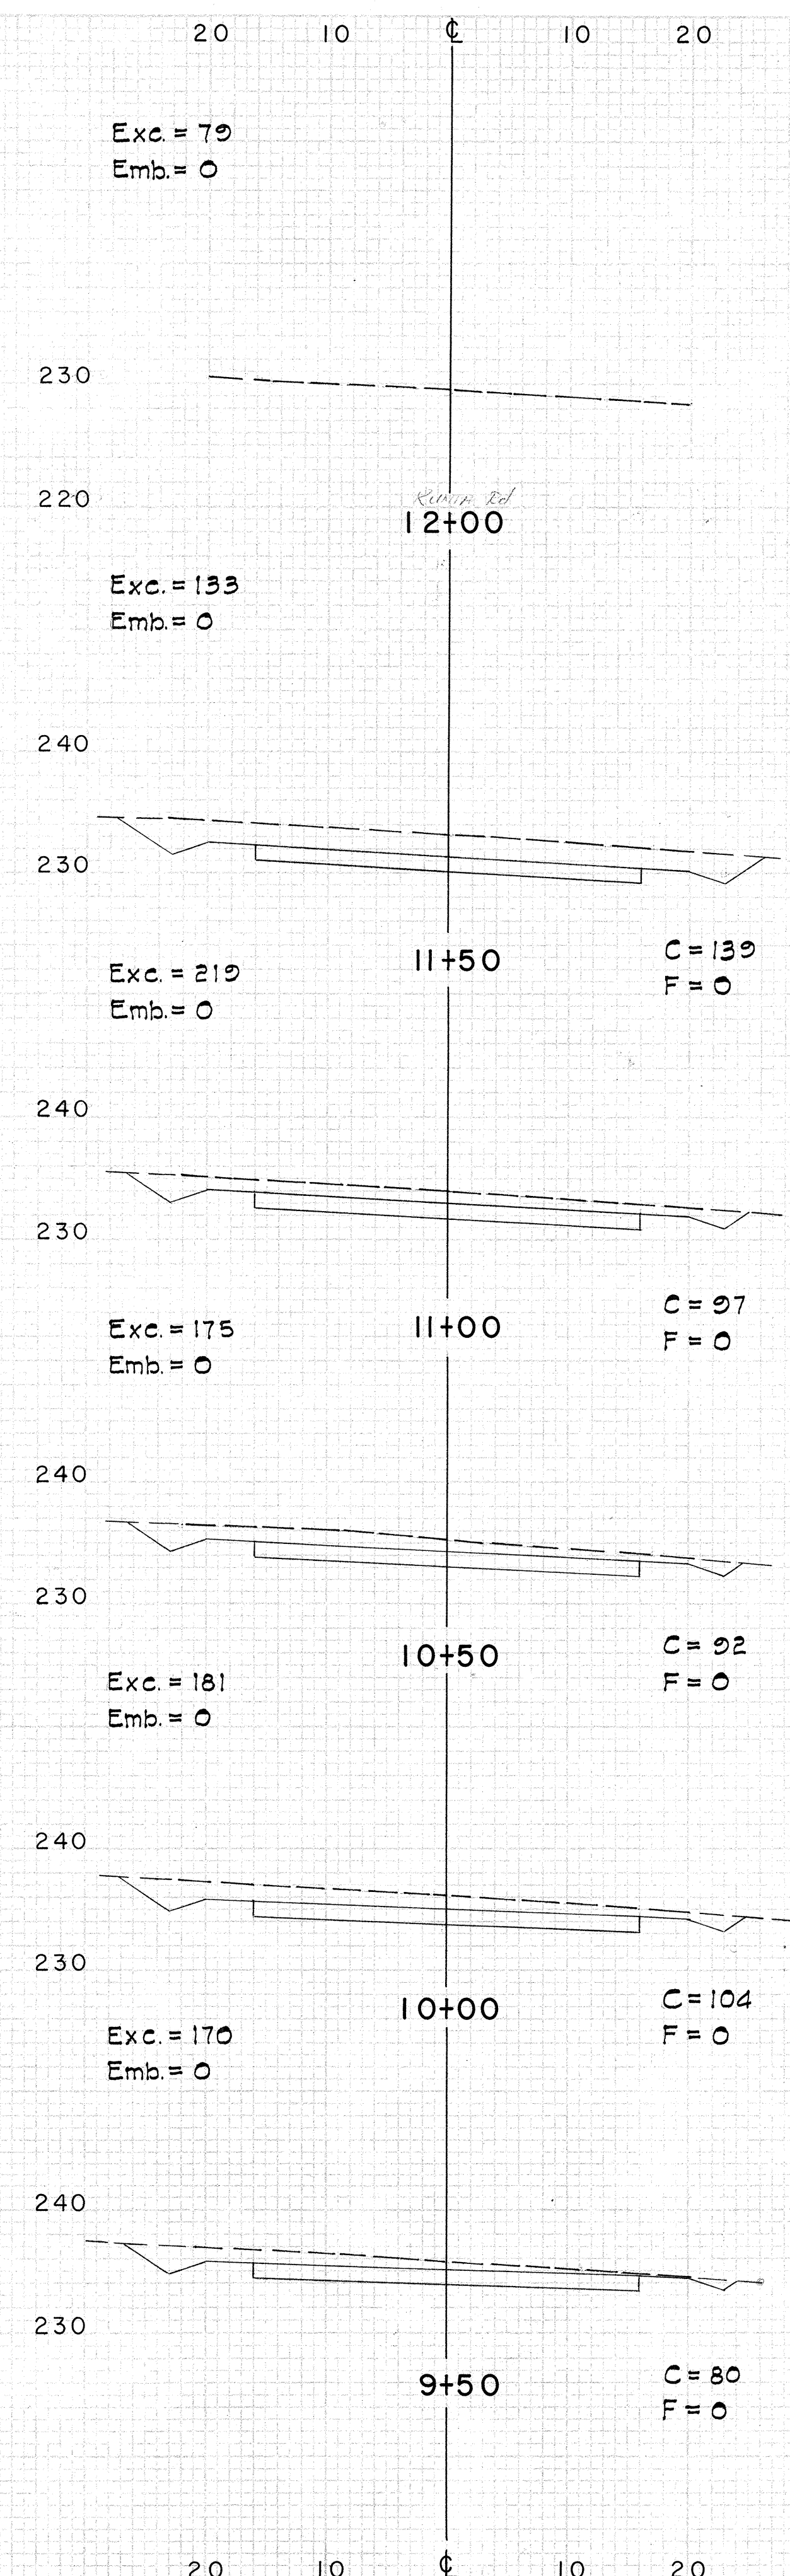
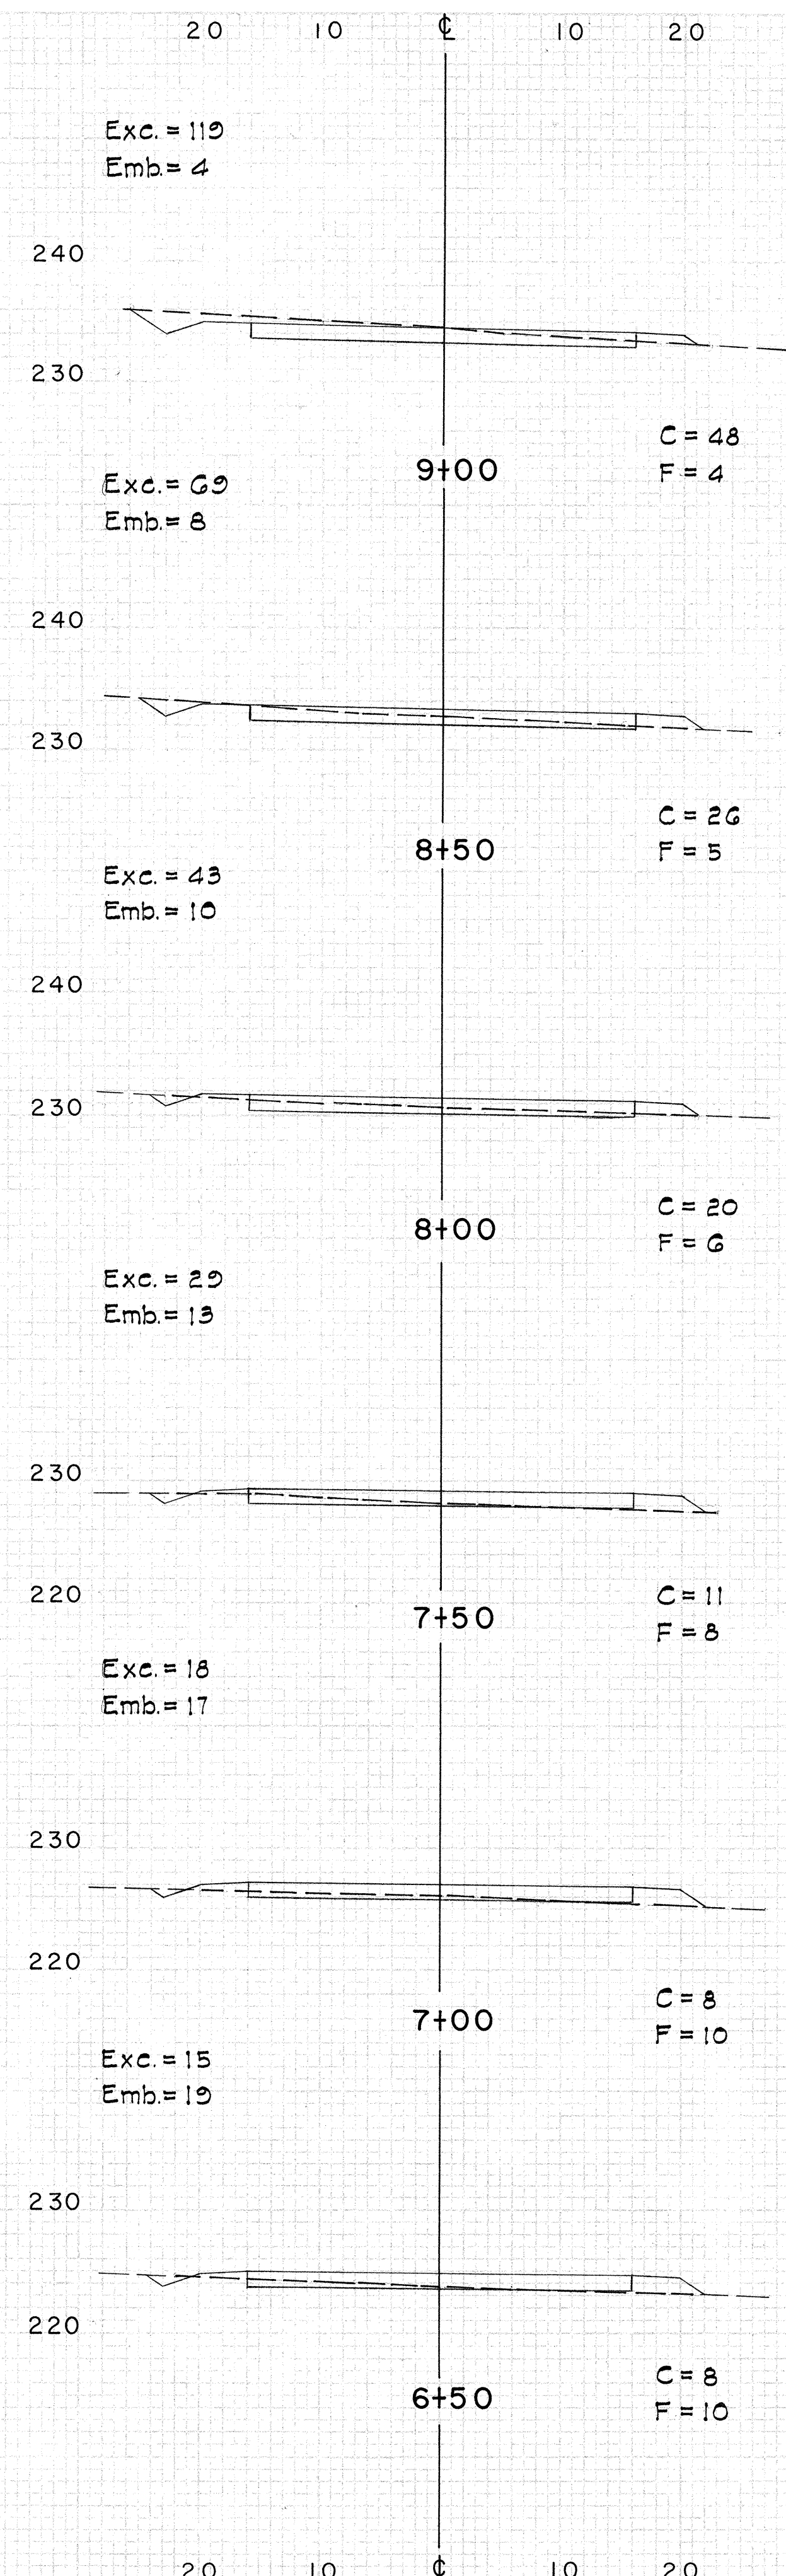
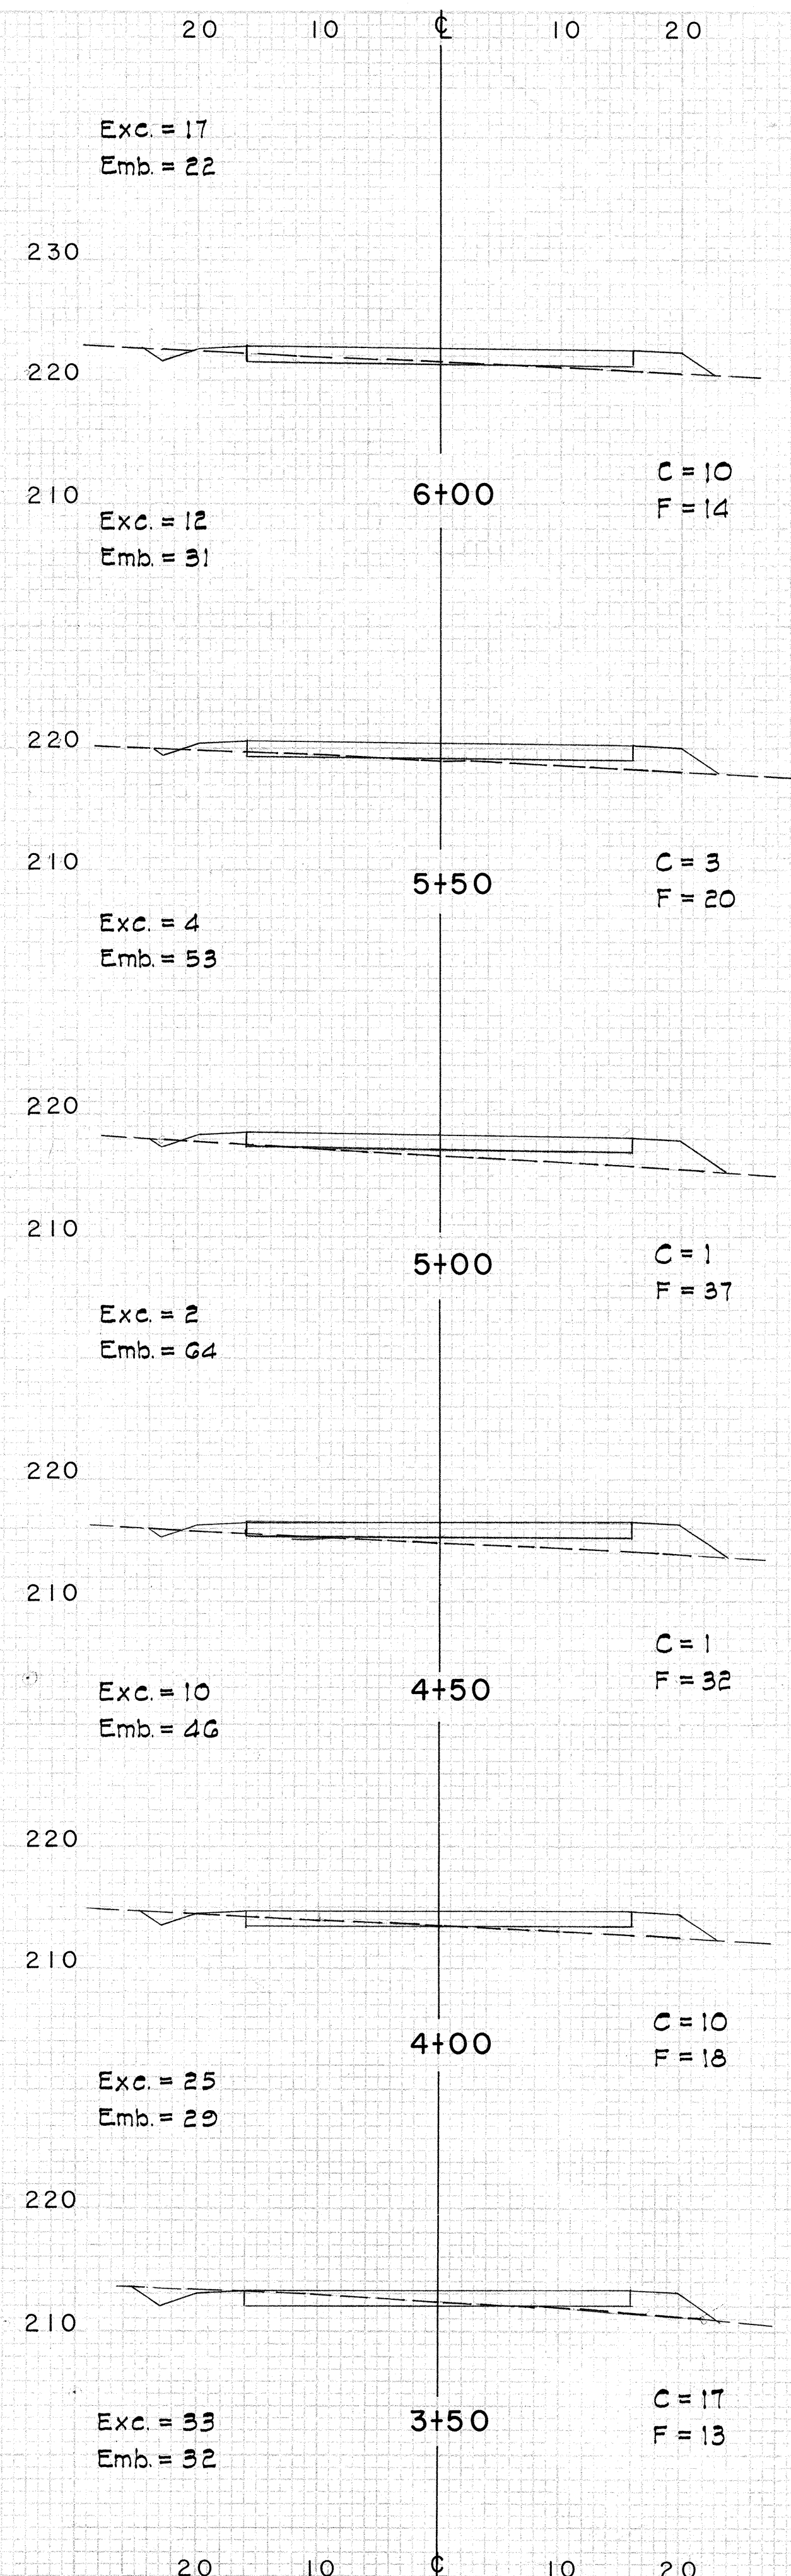


FINAL
SURVEY
NOTES
NO. 100

ORIGINAL
SURVEY
NOTES
NO. 100

FED. ROAD DIST. NO.	STATE	FED. AID PROJ. NO.	FISCAL YEAR	SHEET NO.	TOTAL SHEETS
HAWAII	HAW	I-HI-1(18)	1965	118	124

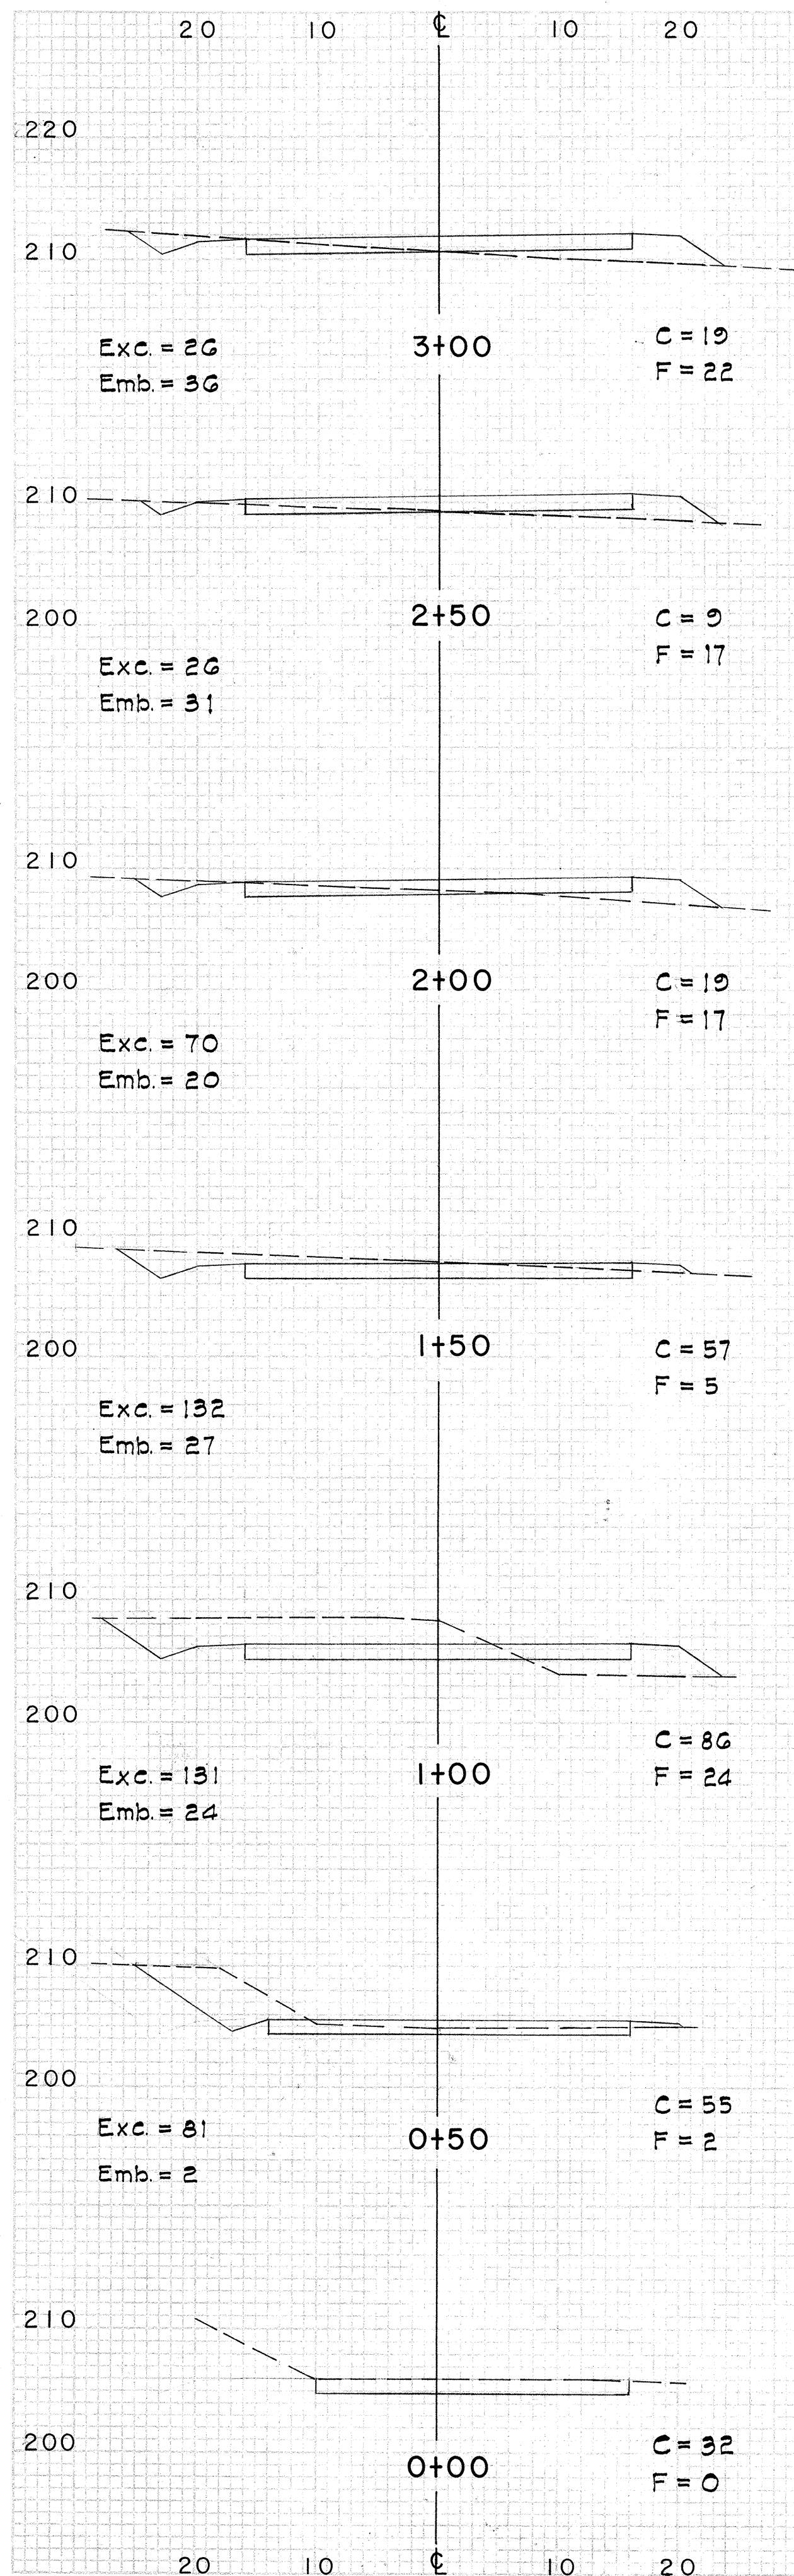


CANE HAUL RD.

FED. ROAD DIST. NO.	STATE	FED. AID PROJ. NO.	FISCAL YEAR	SHEET NO.	TOTAL SHEETS
HAWAII	HAW	I-HI-110	1965	119	124

DATE	BY	REVISION	NO.
		1	
		2	
DATE	BY	REVISION	NO.
		1	
		2	
		3	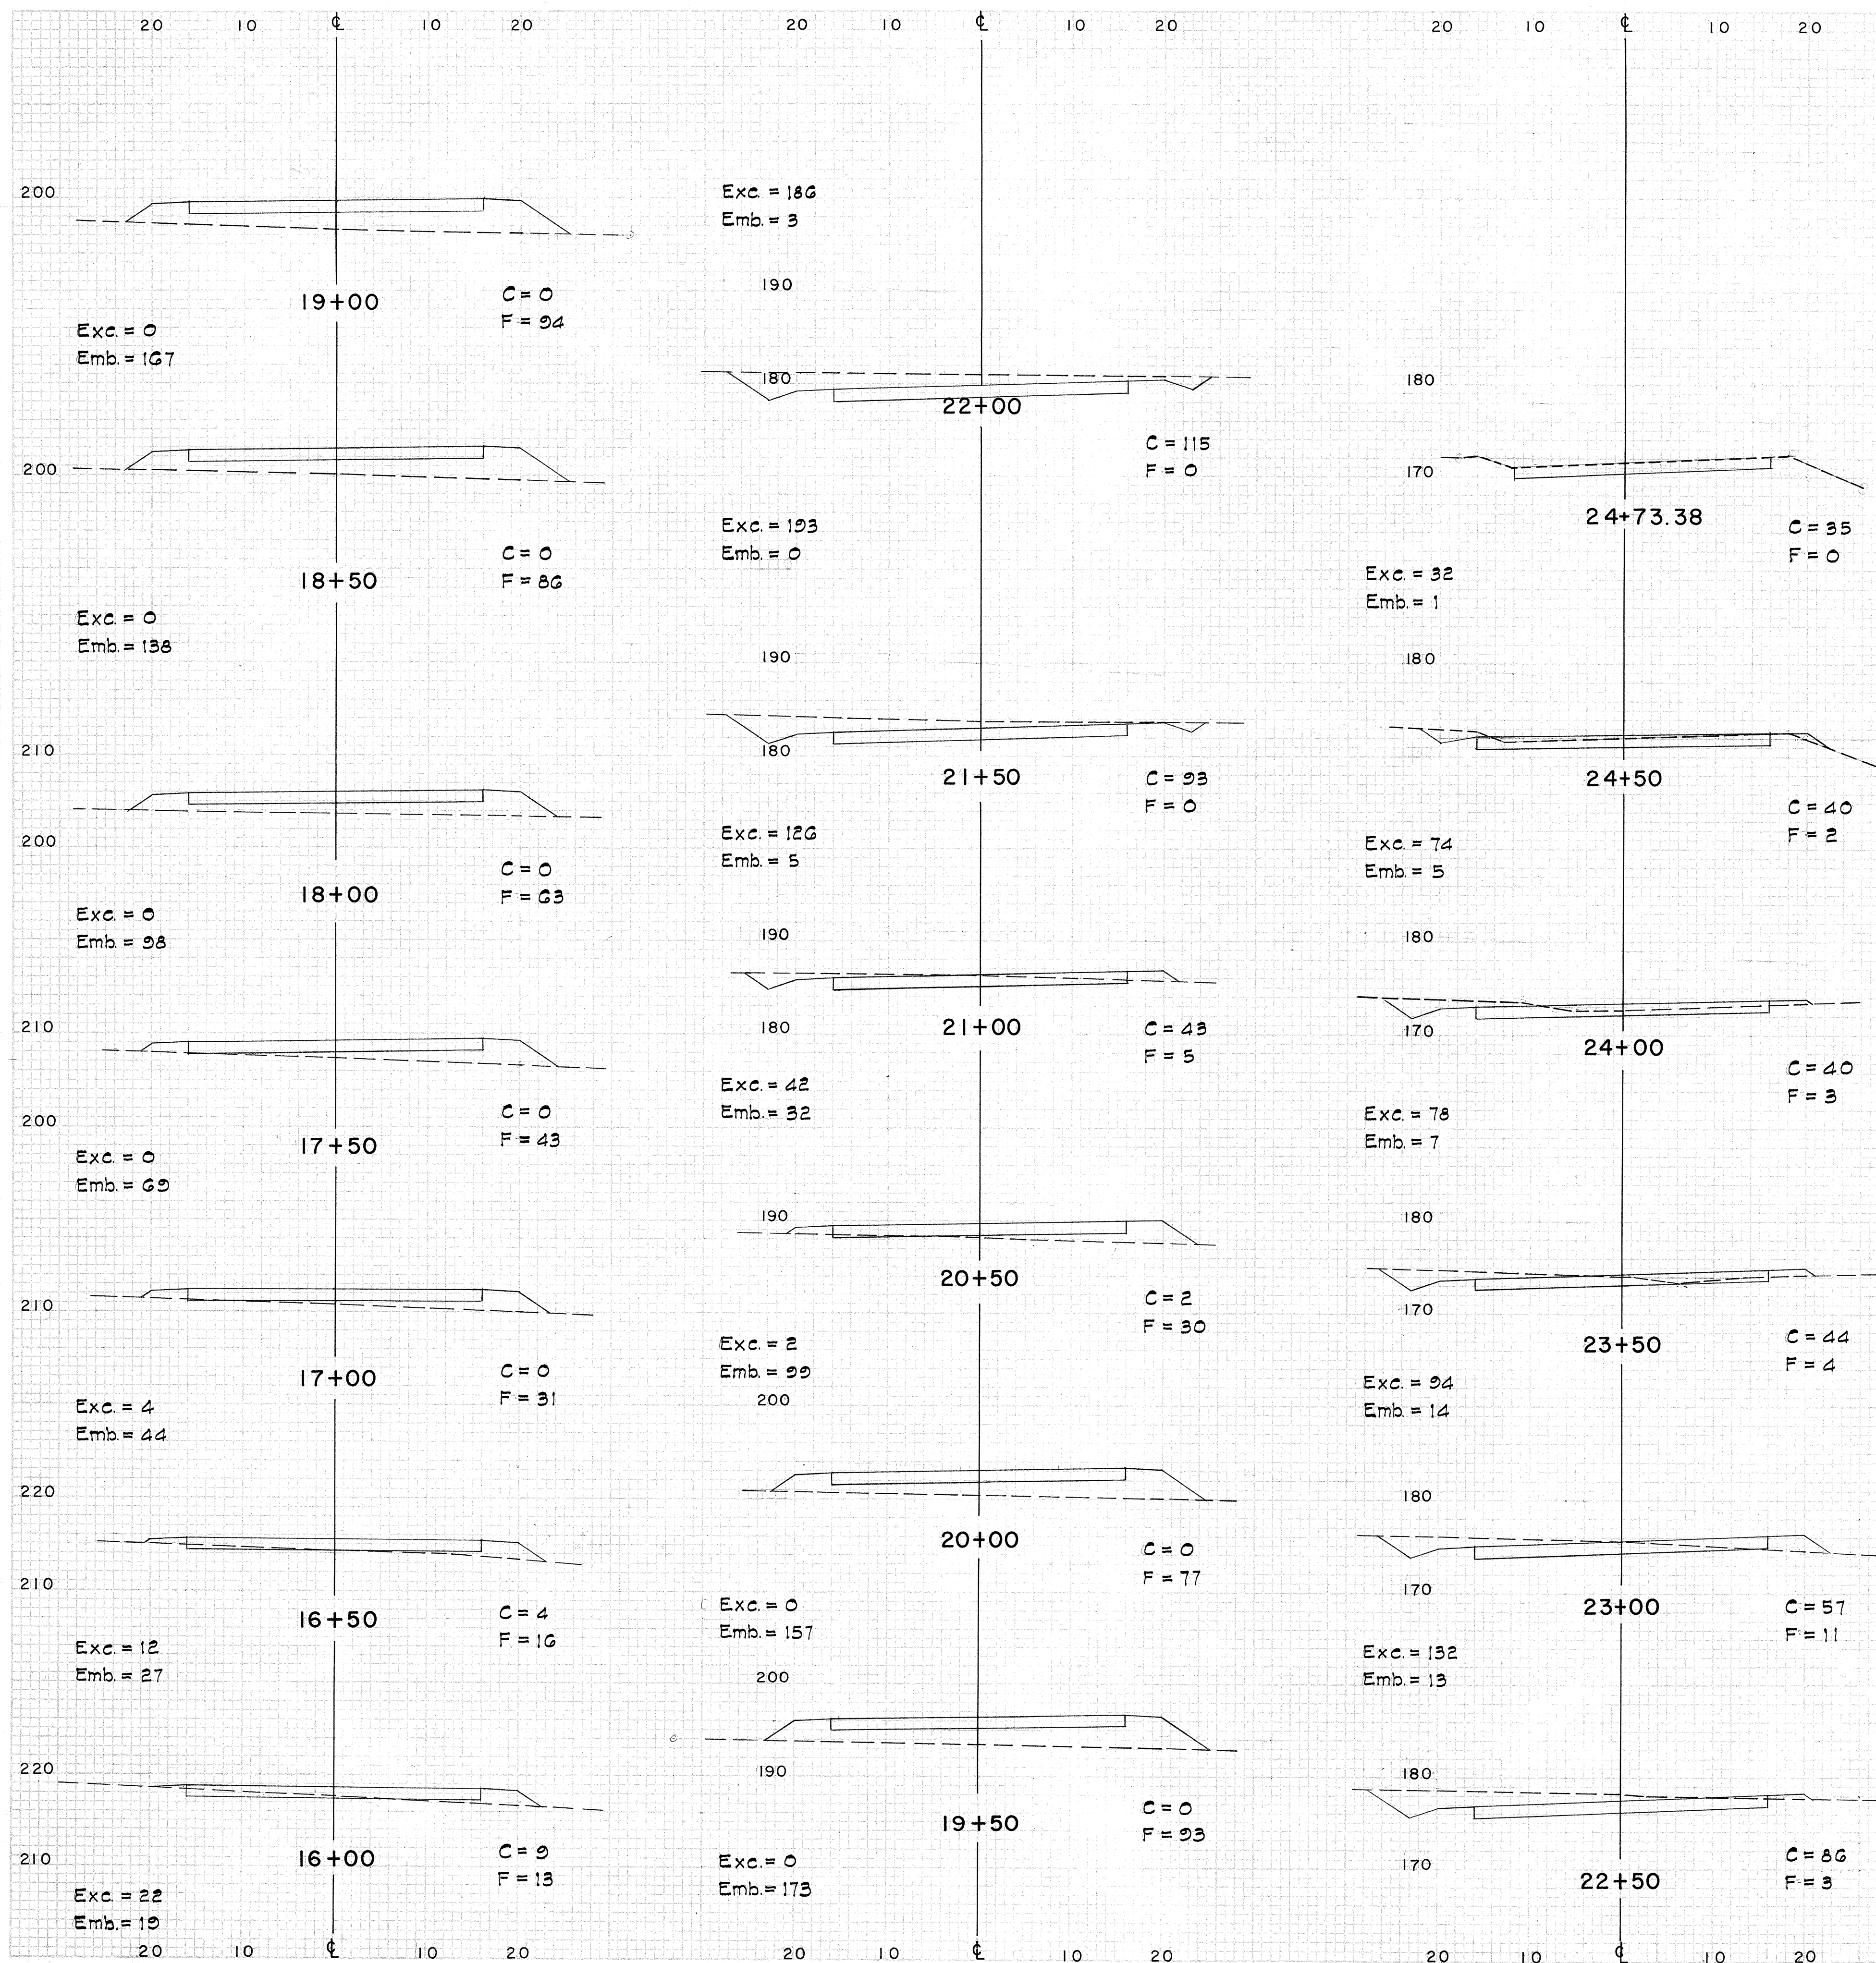
CANE HAUL RD.

119