



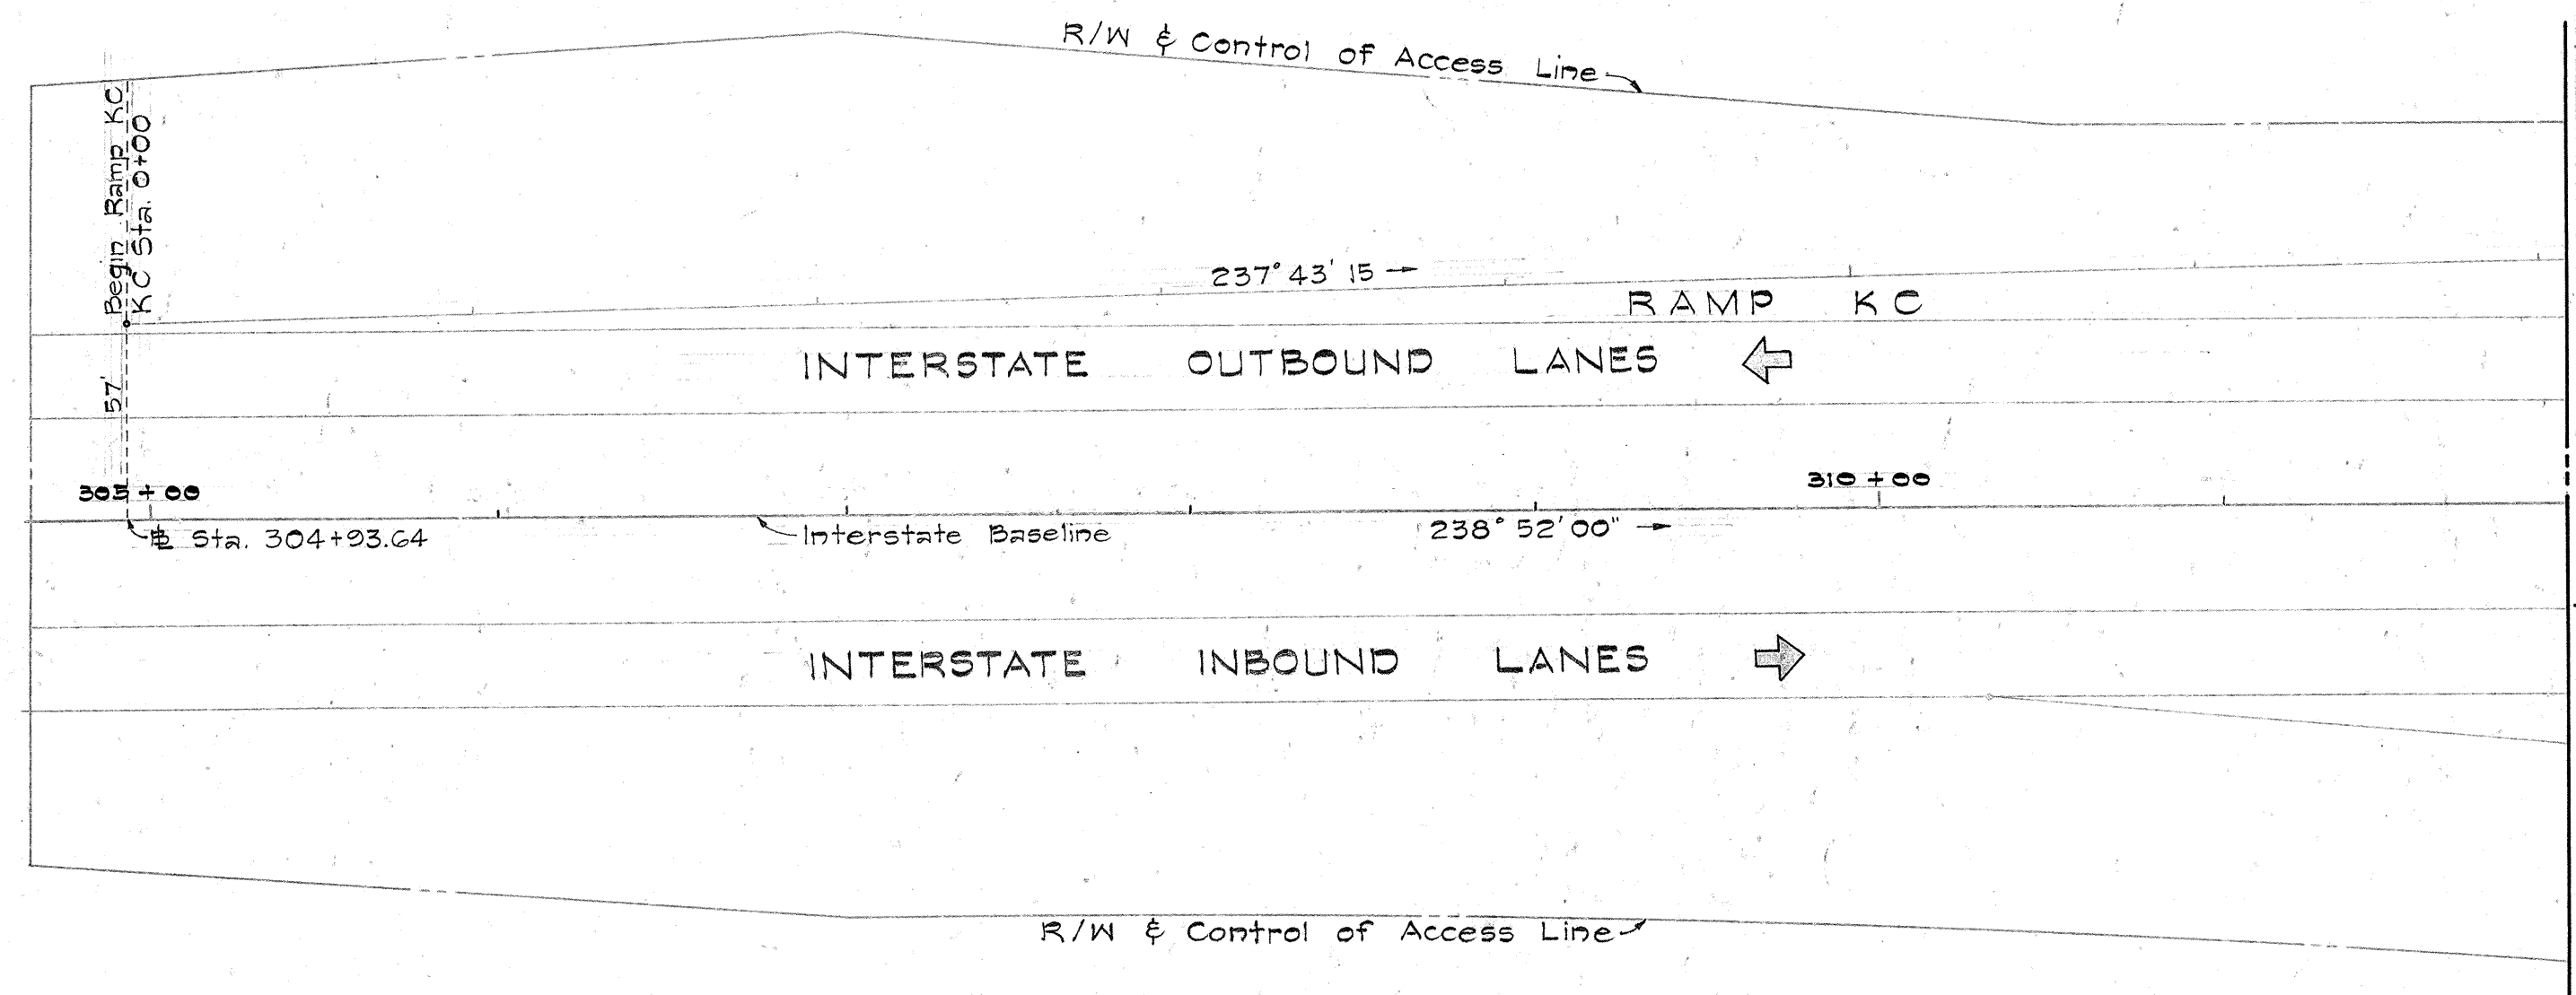

CURVE DATA

B1		B2		C1		C2		C3		C4		C5		Kunia	
Δ	= 233°53'40"	Δ	= 25°00'	Δ	= 3°11'29"	Δ	= 40°39'46"	Δ	= 40°39'46"	Δ	= 127°53'40"	Δ	= 80°11'20"	Δ	= 16°55'00"
A/2	= 116°56'50"	A/2	= 12°30'00"	A/2	= 1°35'44.5"	A/2	= 20°19'53"	A/2	= 20°19'53"	A/2	= 63°56'30"	A/2	= 40°05'40"	A/2	= 8°27'30"
R	= 229.18	R	= 250.00	R	= 2068.00	R	= 384.00	R	= 384.00	R	= 306.00	R	= 150.00	R	= 2292.00
T	= 450.82	T	= 722'	T	= 63.24	T	= 142.29	T	= 150.54	T	= 625.93	T	= 126.29	T	= 340.84
Ch	= 408.59	Ch	= 99.37	Ch	= 166.41	Ch	= 266.84	Ch	= 266.84	Ch	= 549.81	Ch	= 193.21	Ch	= 674.26
Lc	= 935.57	Lc	= 196.23	Lc	= 166.43	Lc	= 272.52	Lc	= 268.34	Lc	= 683.05	Lc	= 209.93	Lc	= 676.72
x		y													

1		2		3	
Δ	= 48°30'00"	Δ	= 52°18'04"	Δ	= 75°35'36"
A/2	= 24°15'00"	A/2	= 26°09'02"	A/2	= 37°47'48"
R	= 250.00	R	= 250.00	R	= 150.00
T	= 112.62	T	= 122.75	T	= 116.34
Ch	= 205.36	Ch	= 220.37	Ch	= 163.86
Lc	= 211.62	Lc	= 226.21	Lc	= 197.90

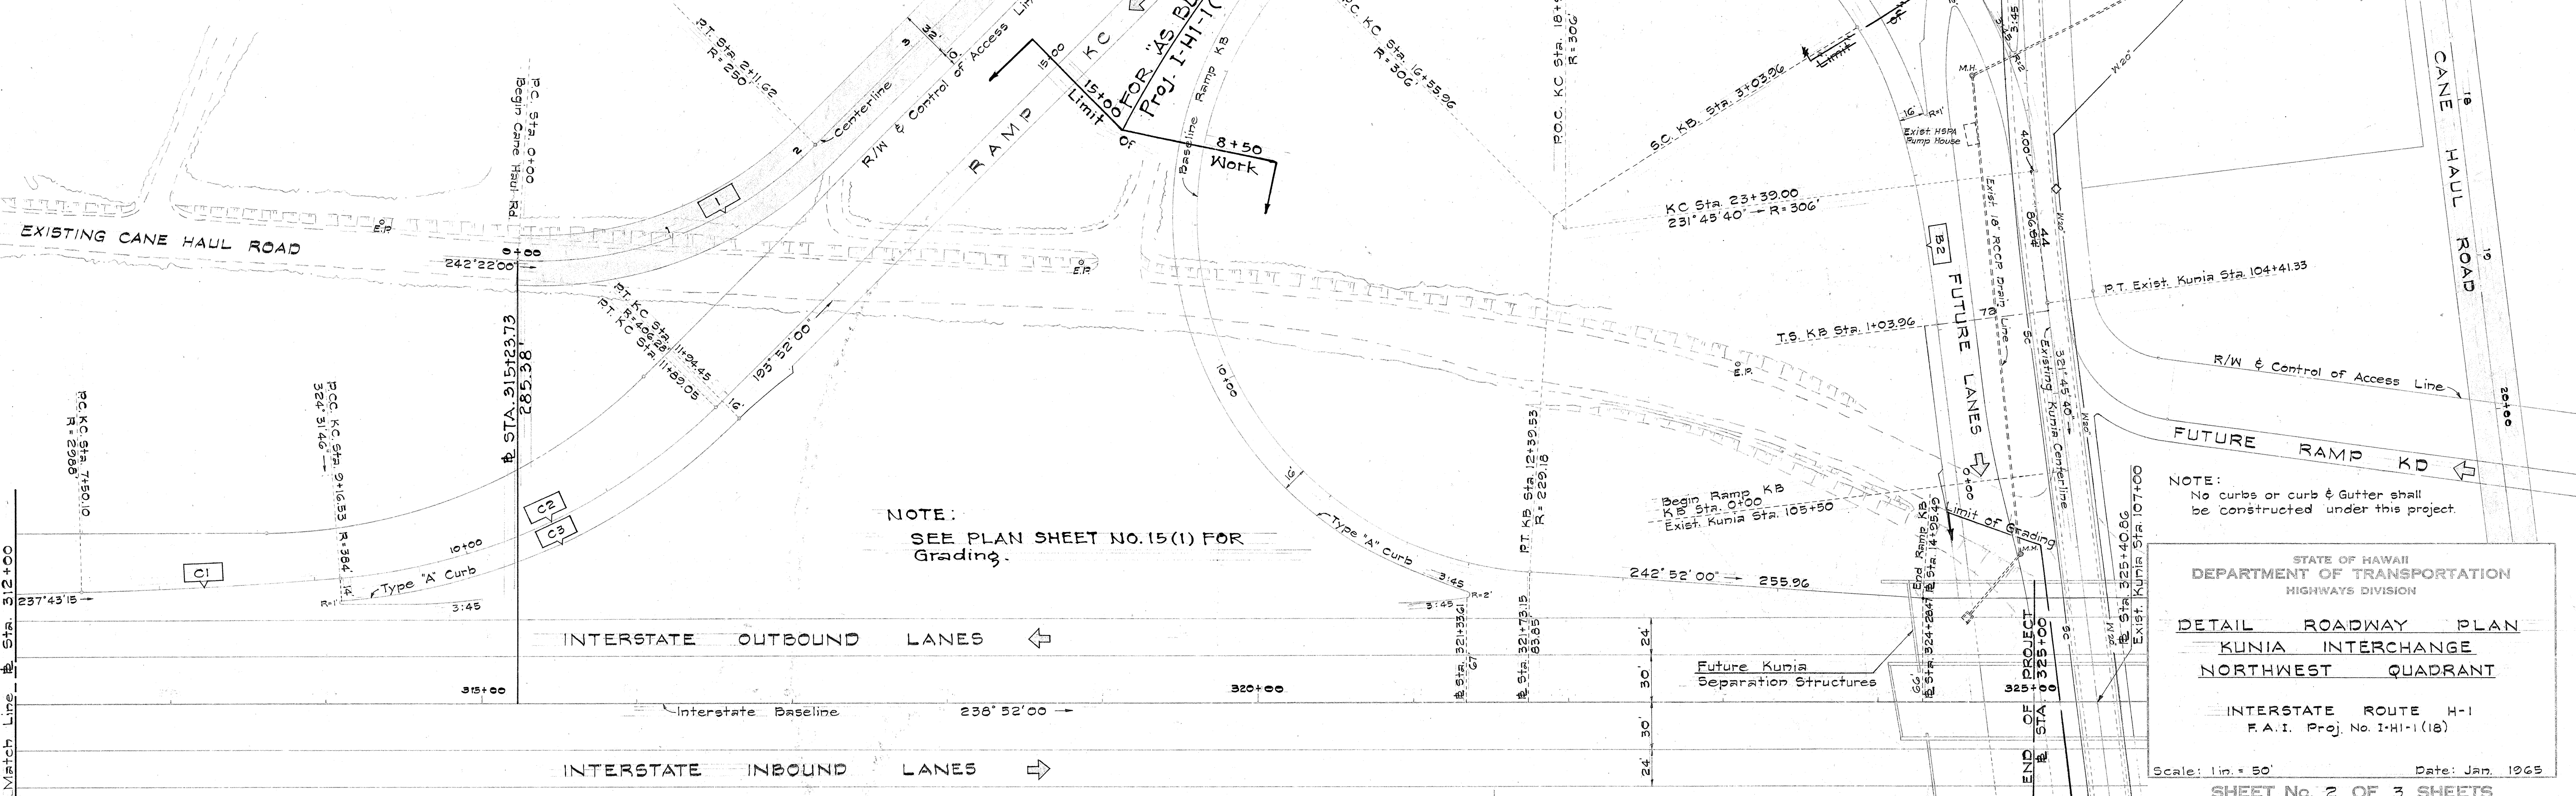

NOTE:
SEE PLAN SHEET NO. 15(1) FOR
Grading.

NOTE:
No curbs or curb & gutter shall
be constructed under this project.

STATE OF HAWAII
DEPARTMENT OF TRANSPORTATION
HIGHWAYS DIVISION
DETAIL ROADWAY PLAN
KUNIA INTERCHANGE
NORTHWEST QUADRANT


INTERSTATE ROUTE H-1
F.A.I. Proj. No. I-HI-1(18)

Scale: 1 in. = 50'

Date: Jan. 1965

SHEET No. 2 OF 3 SHEETS

FED. ROAD DIST. NO.	STATE	FED. AID PROJ. NO.	FISCAL YEAR	SHEET NO.	TOTAL SHEETS
HAWAII	HAW.	I-HI-1(18)	1965	15	124

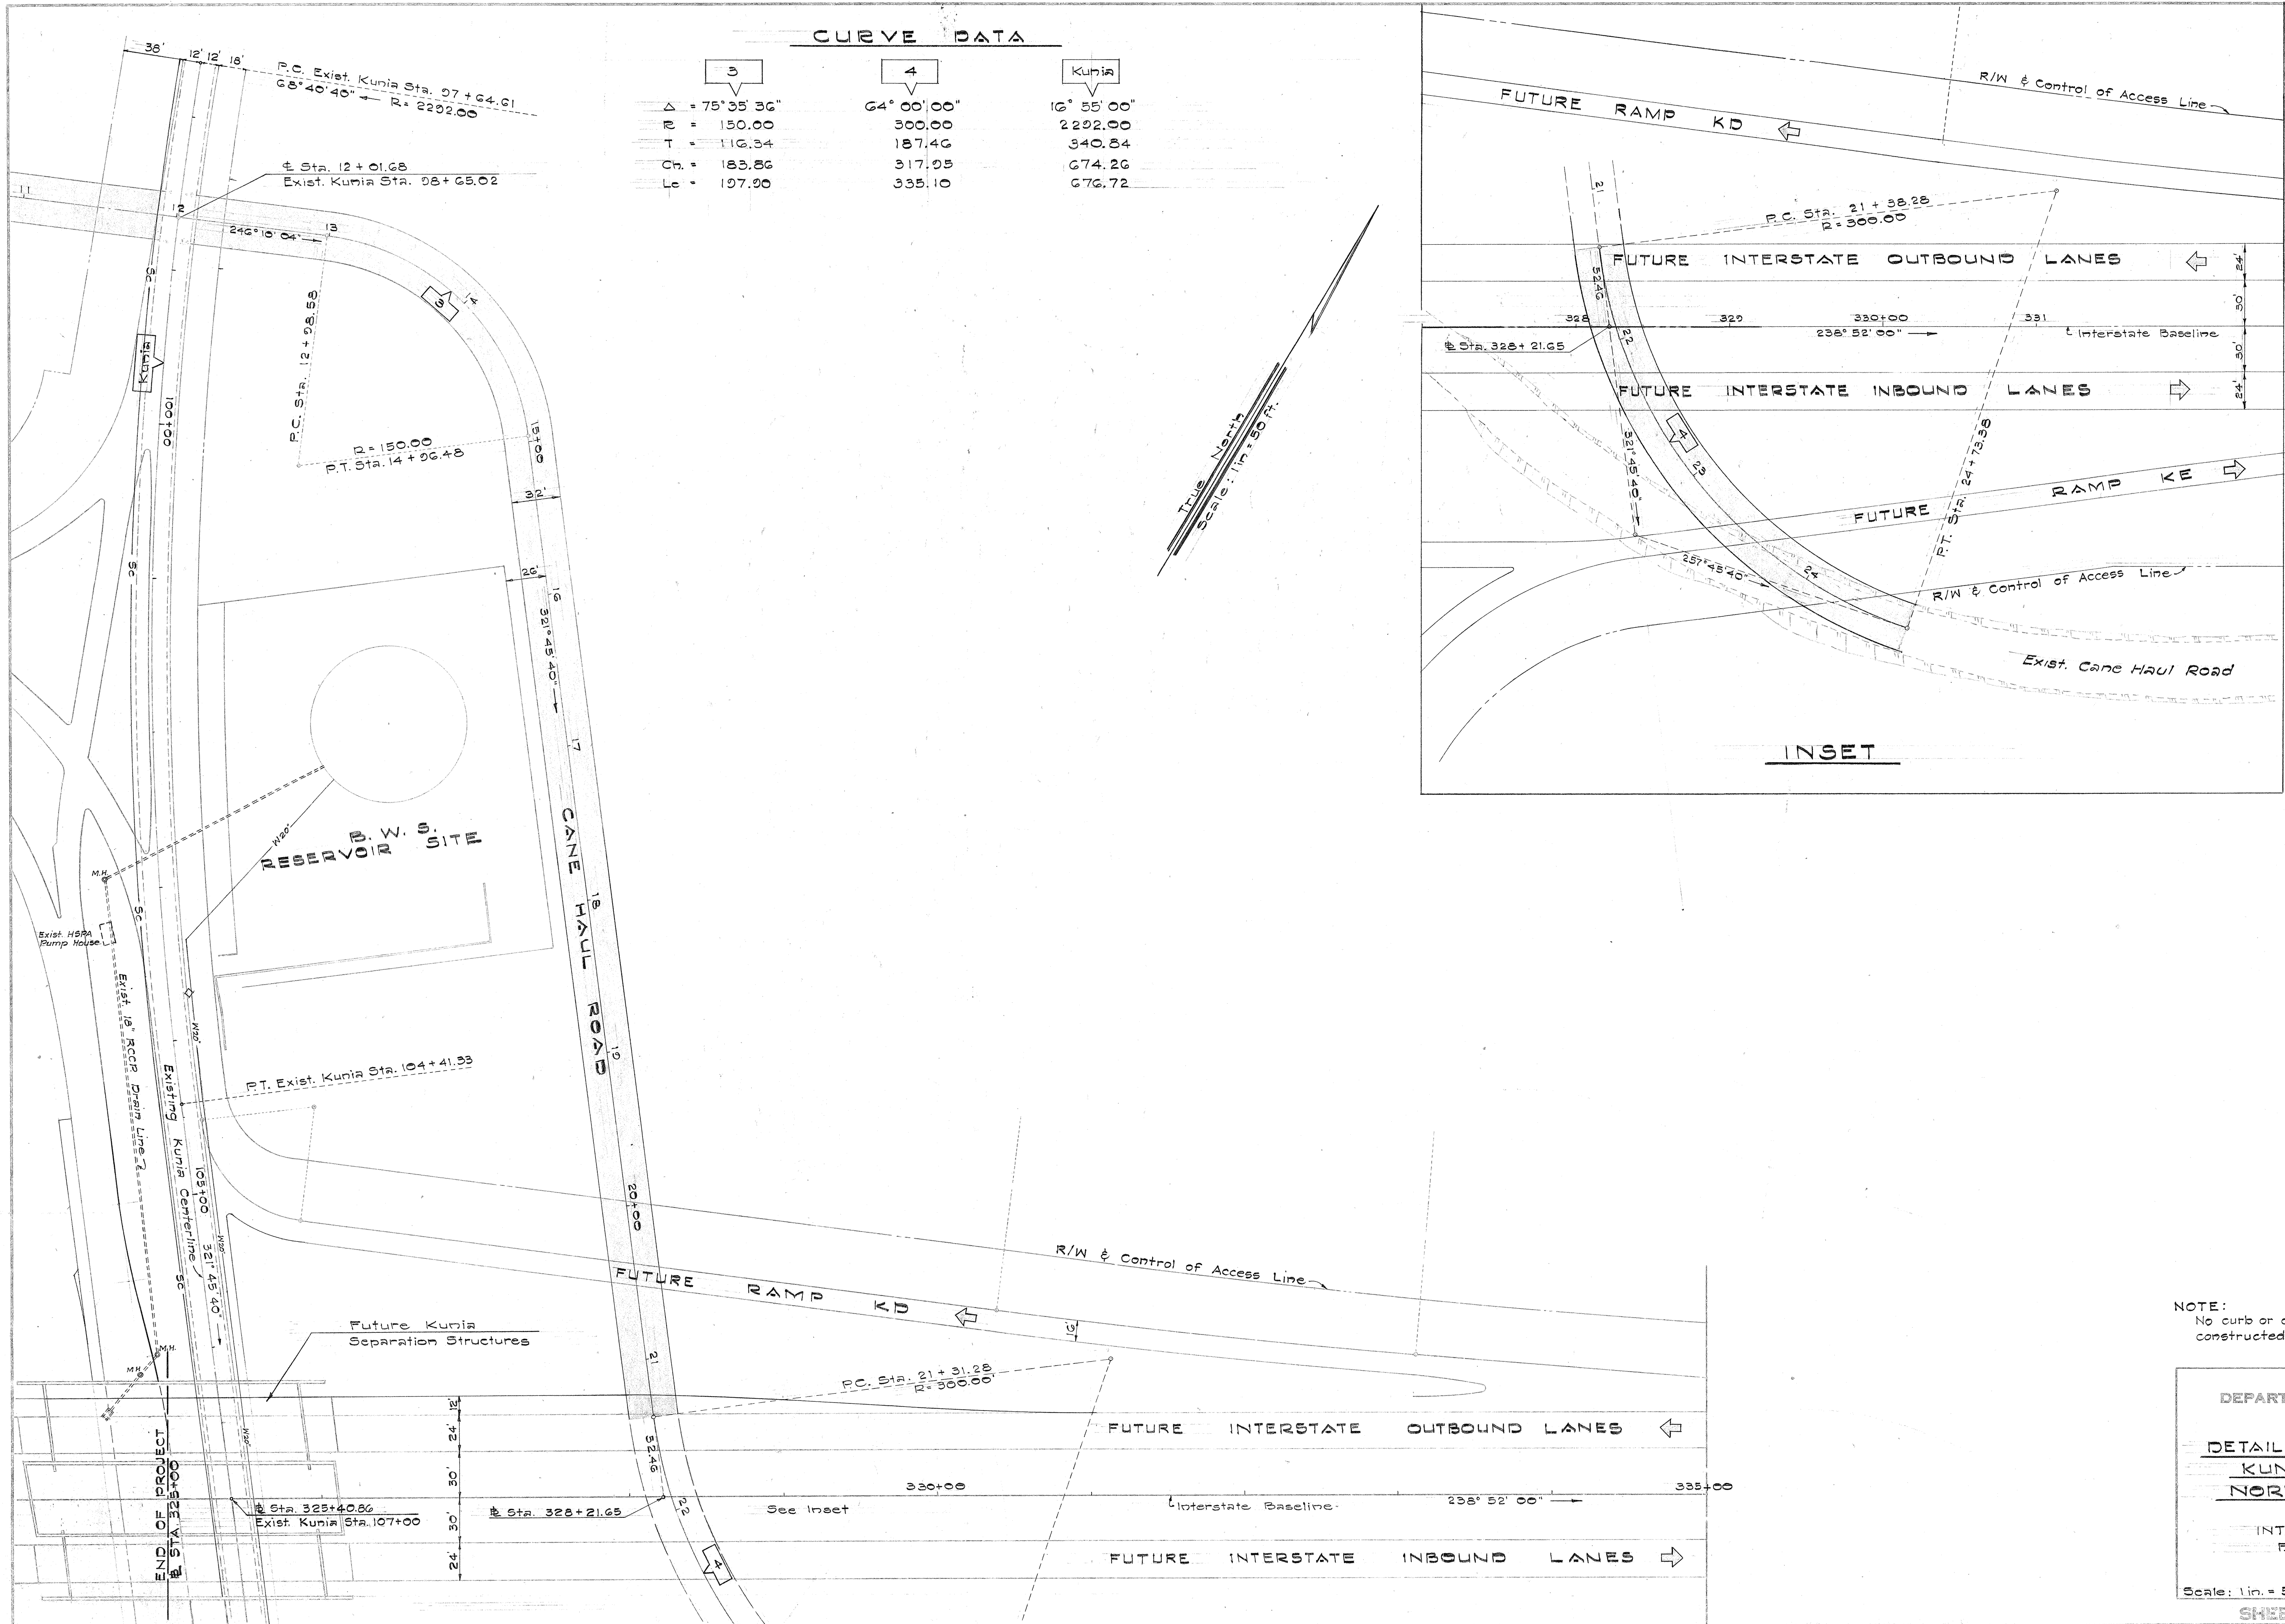

NOTE:
No curb or curb & gutter shall be constructed under this project

STATE OF HAWAII
DEPARTMENT OF TRANSPORTATION
HIGHWAYS DIVISION

DETAIL ROADWAY PLAN
KUNIA INTERCHANGE
NORTHEAST QUADRANT

INTERSTATE ROUTE H-1
F.A.I. Proj. No. I-HI-1(18)

Scale: 1 in. = 50' Date: Jan., 1965

SHEET No. 3 OF 3 SHEETS

FED. ROAD DIST. DIS.	STATE	FED. AID PROJ. NO.	FISCAL YEAR	SHEET NO.	TOTAL SHEETS
HAWAII	HAW.	I-HI-110	1965	15A	124



THIS SHEET IS A SUPPLEMENT TO THE CONTRACT PLANS.

STATE OF HAWAII
DEPARTMENT OF TRANSPORTATION
HIGHWAYS DIVISION

GRADING PLAN

INTERSTATE ROUTE H-1
F.A.I. Proj. No. I-HI-110

Scale: 1"=50'

Date: July 2, 1965

SHEET No. OF SHEETS

~~ADDITIONAL SHEET~~

15(1)

ORIGINAL PLAN	DATE
SURVEY PLOTTED BY	
DRAWN BY	
DESIGNED BY	
QUANTITIES BY	
CHECKED BY	
NO.	