


FED. ROAD DIST. NO.	STATE	FED. AID PROJ. NO.	FISCAL YEAR	SHEET NO.	TOTAL SHEETS
HAWAII	HAW	I-HI-110	1965	120	124

60 40 20 0 20 40 60 80 100 120 140 160

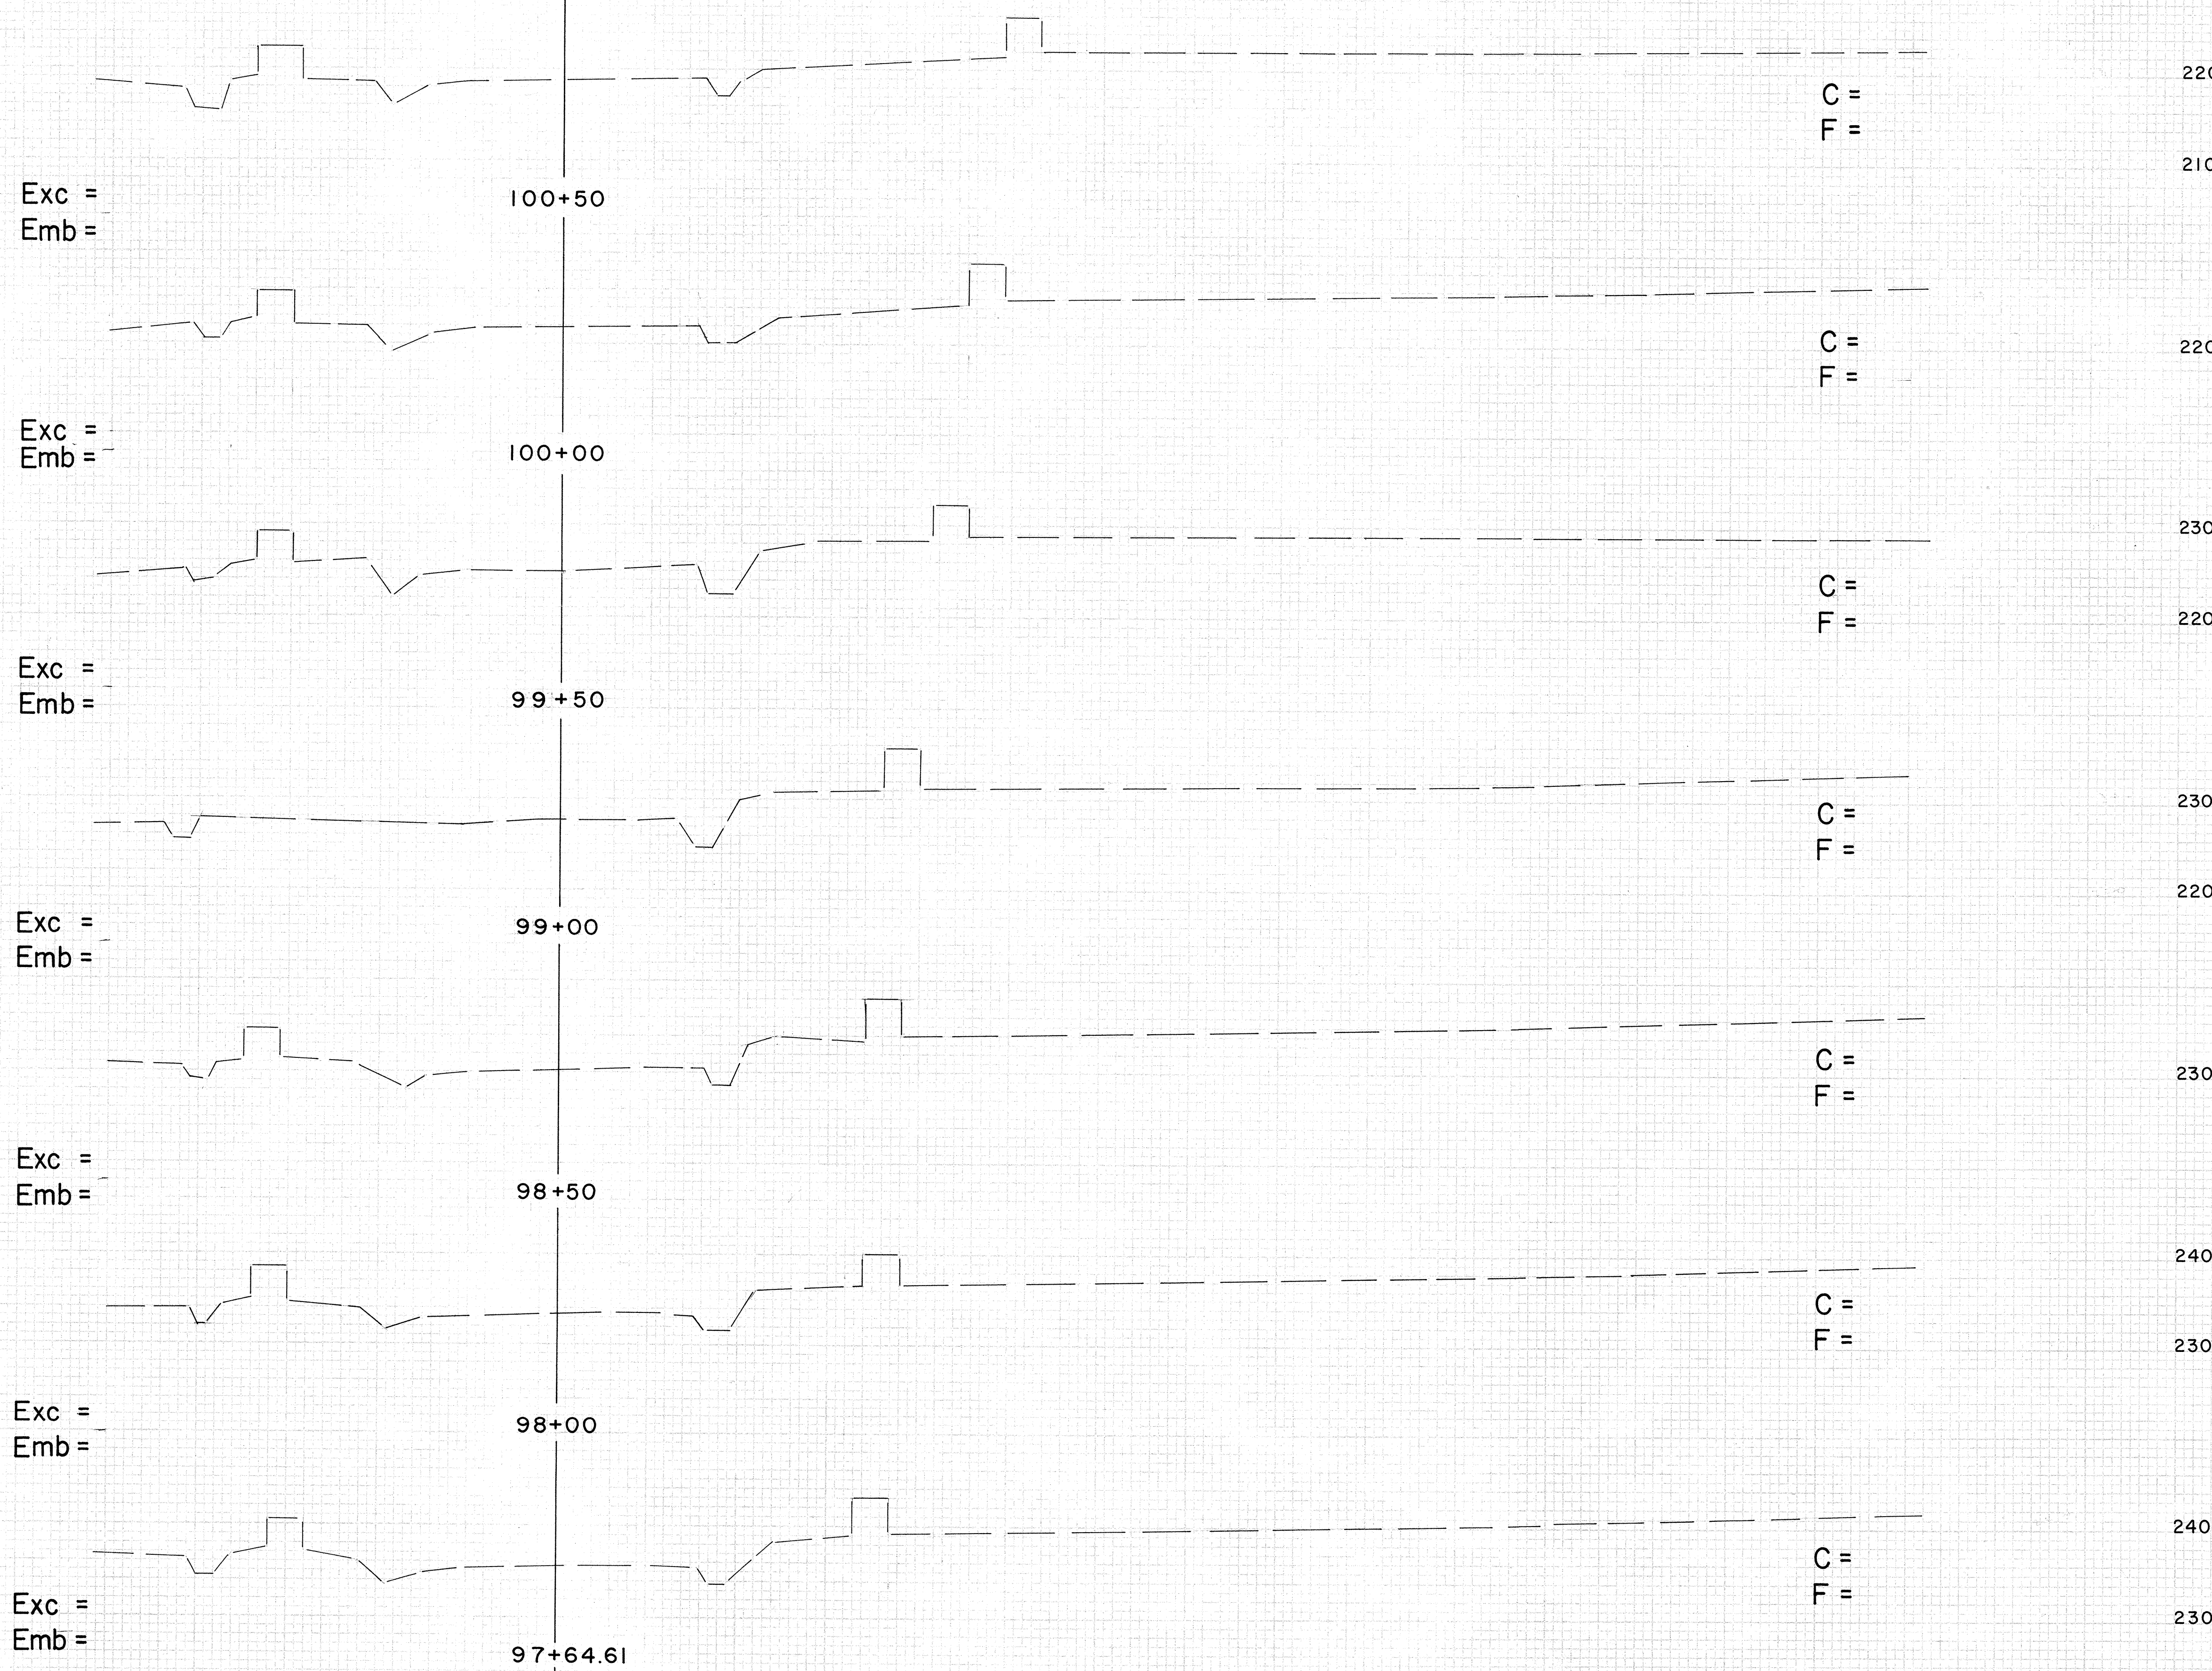


FINAL SURVEY
NO. 107
DATE 10/1/65
BY J. B. BROWN
CHECKED BY J. B. BROWN

ORIGINAL SURVEY
NO. 107
DATE 10/1/65
BY J. B. BROWN
CHECKED BY J. B. BROWN

60 40 20 0 20 40 60 80 100 120 140 160


FED. ROAD DIST. NO.	STATE	FED. AID PROJ. NO.	FISCAL YEAR	SHEET NO.	TOTAL SHEETS
HAWAII	HAW.	I-H-116	1965	121	124

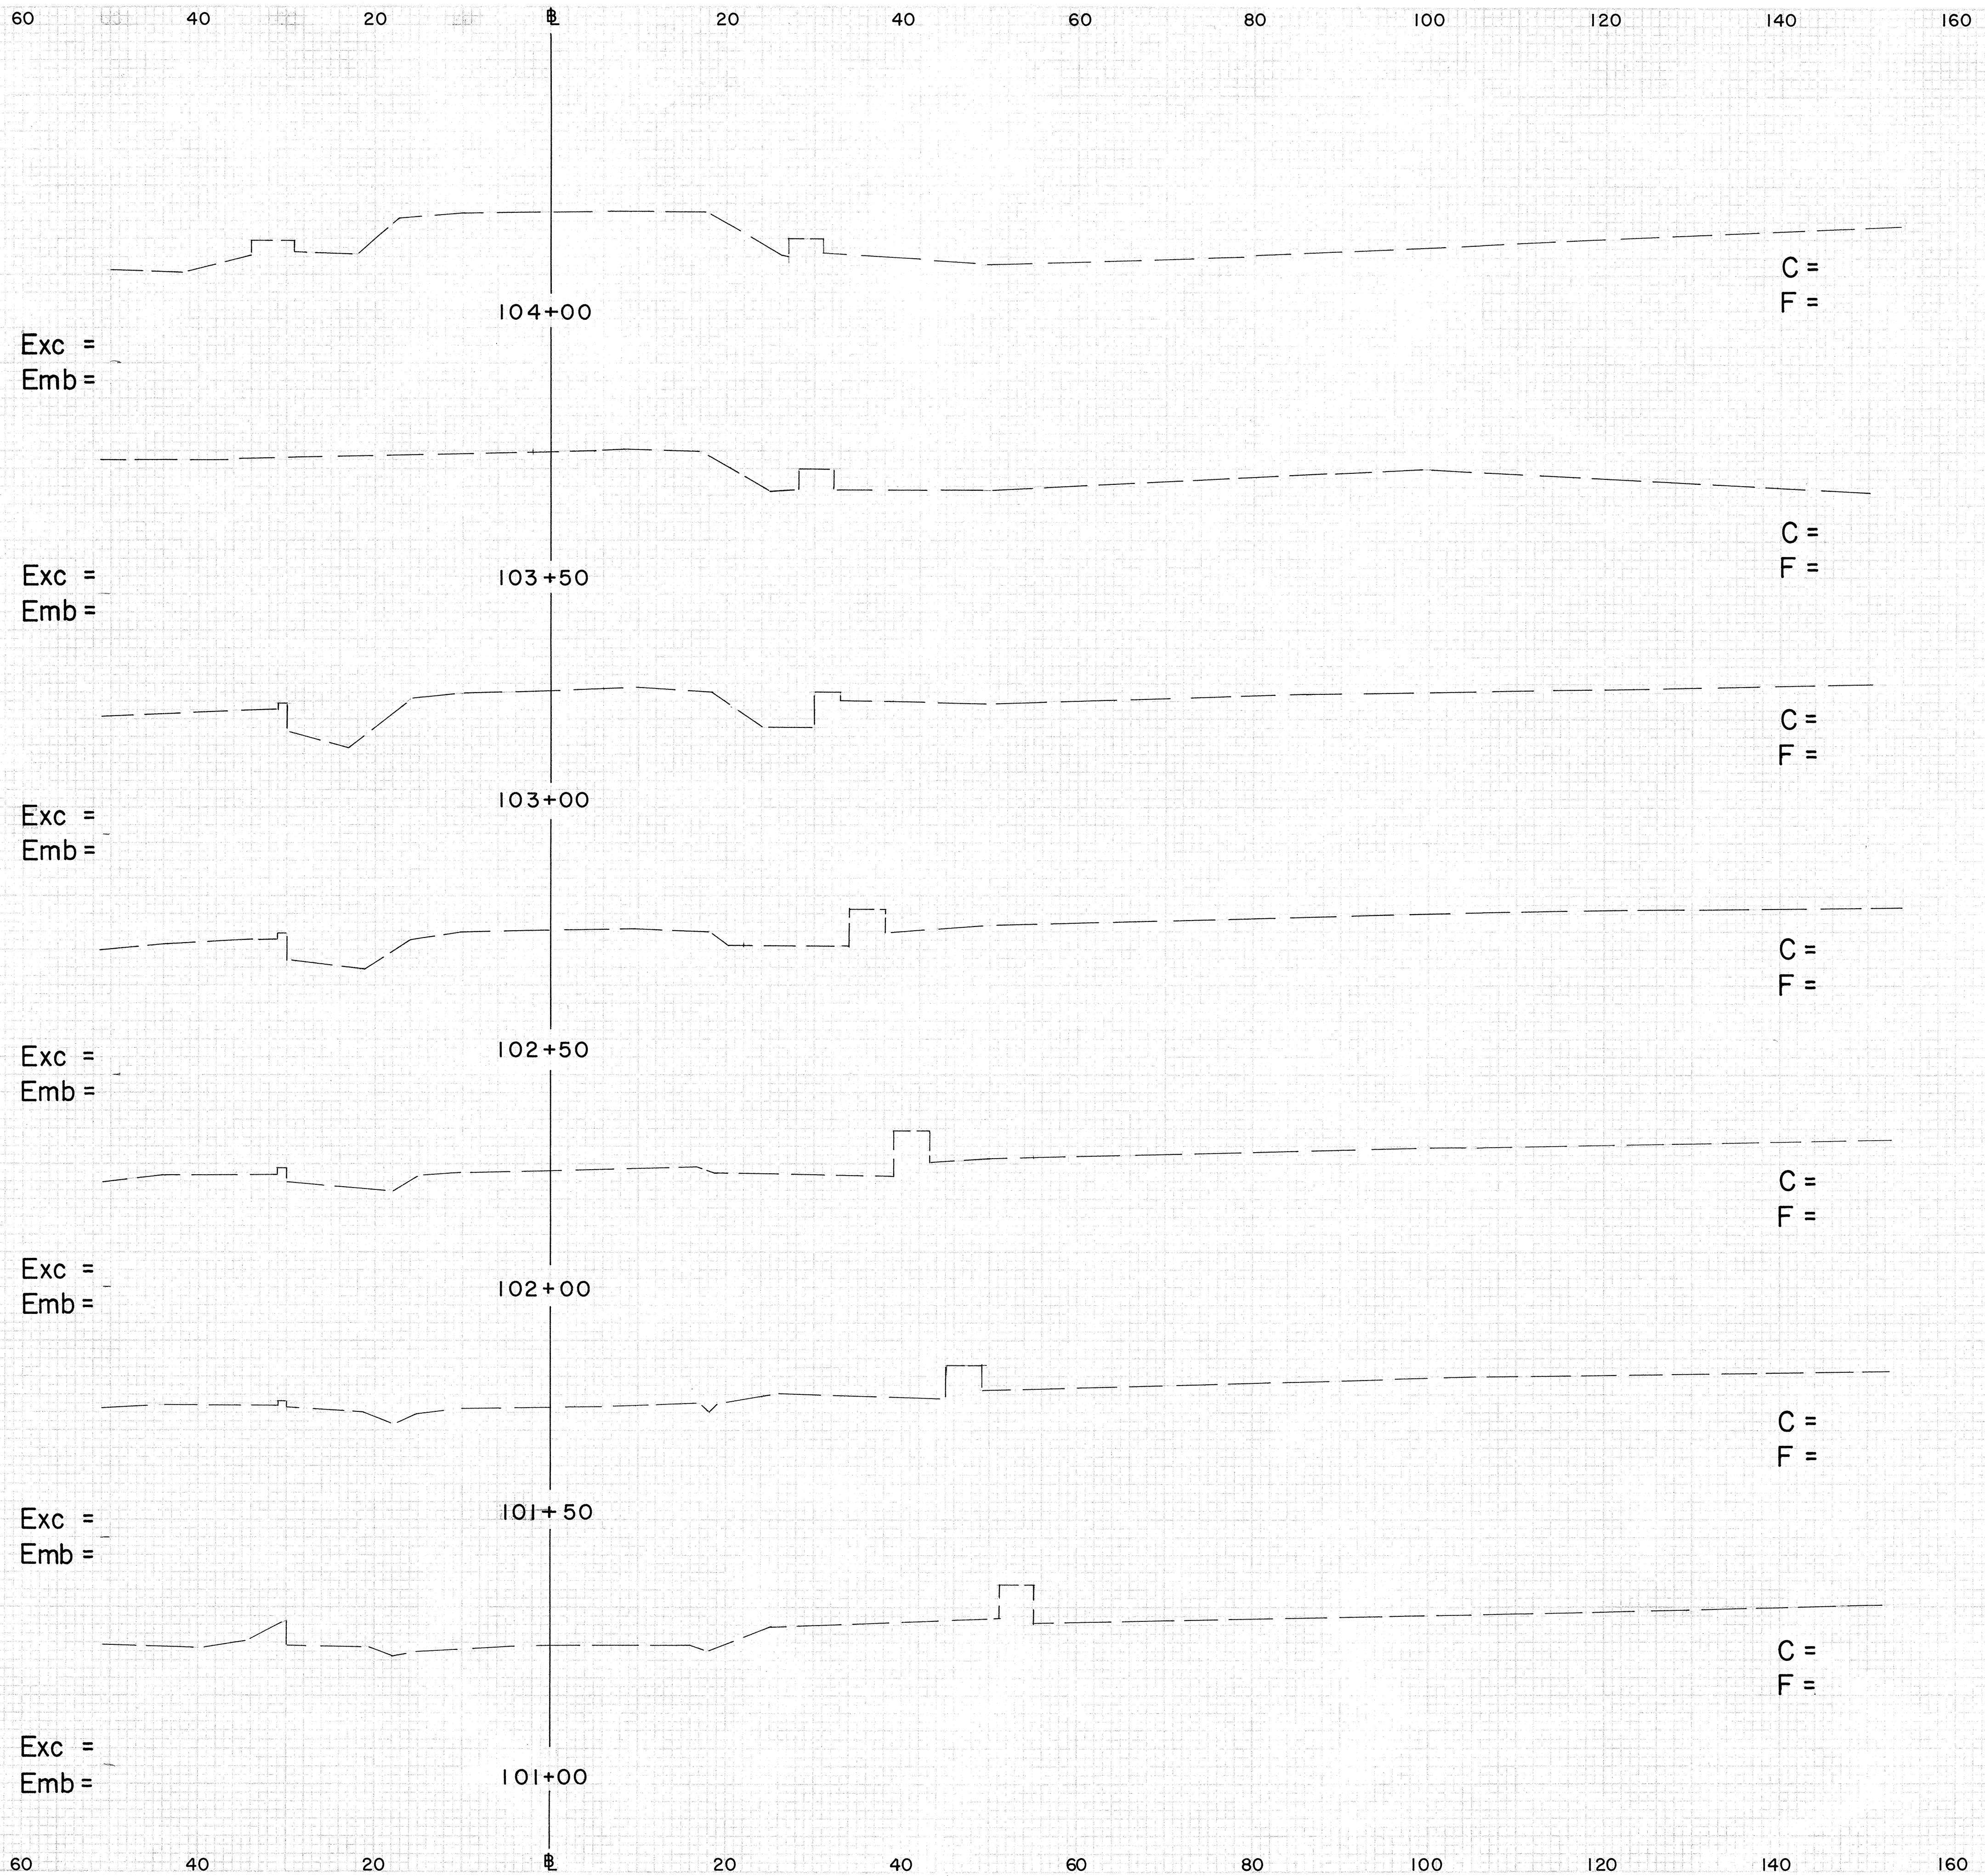

SURVEYED BY
 DATE
 SCALE
 PROJECT NO.
 SHEET NO.


SURVEYED BY
 DATE
 SCALE
 PROJECT NO.
 SHEET NO.

FED. ROAD DIST. NO.	STATE	FED. AID PROJ. NO.	FISCAL YEAR	SHEET NO.	TOTAL SHEETS
HAWAII	HAW.	2-HI-1(18)	1965	122	124

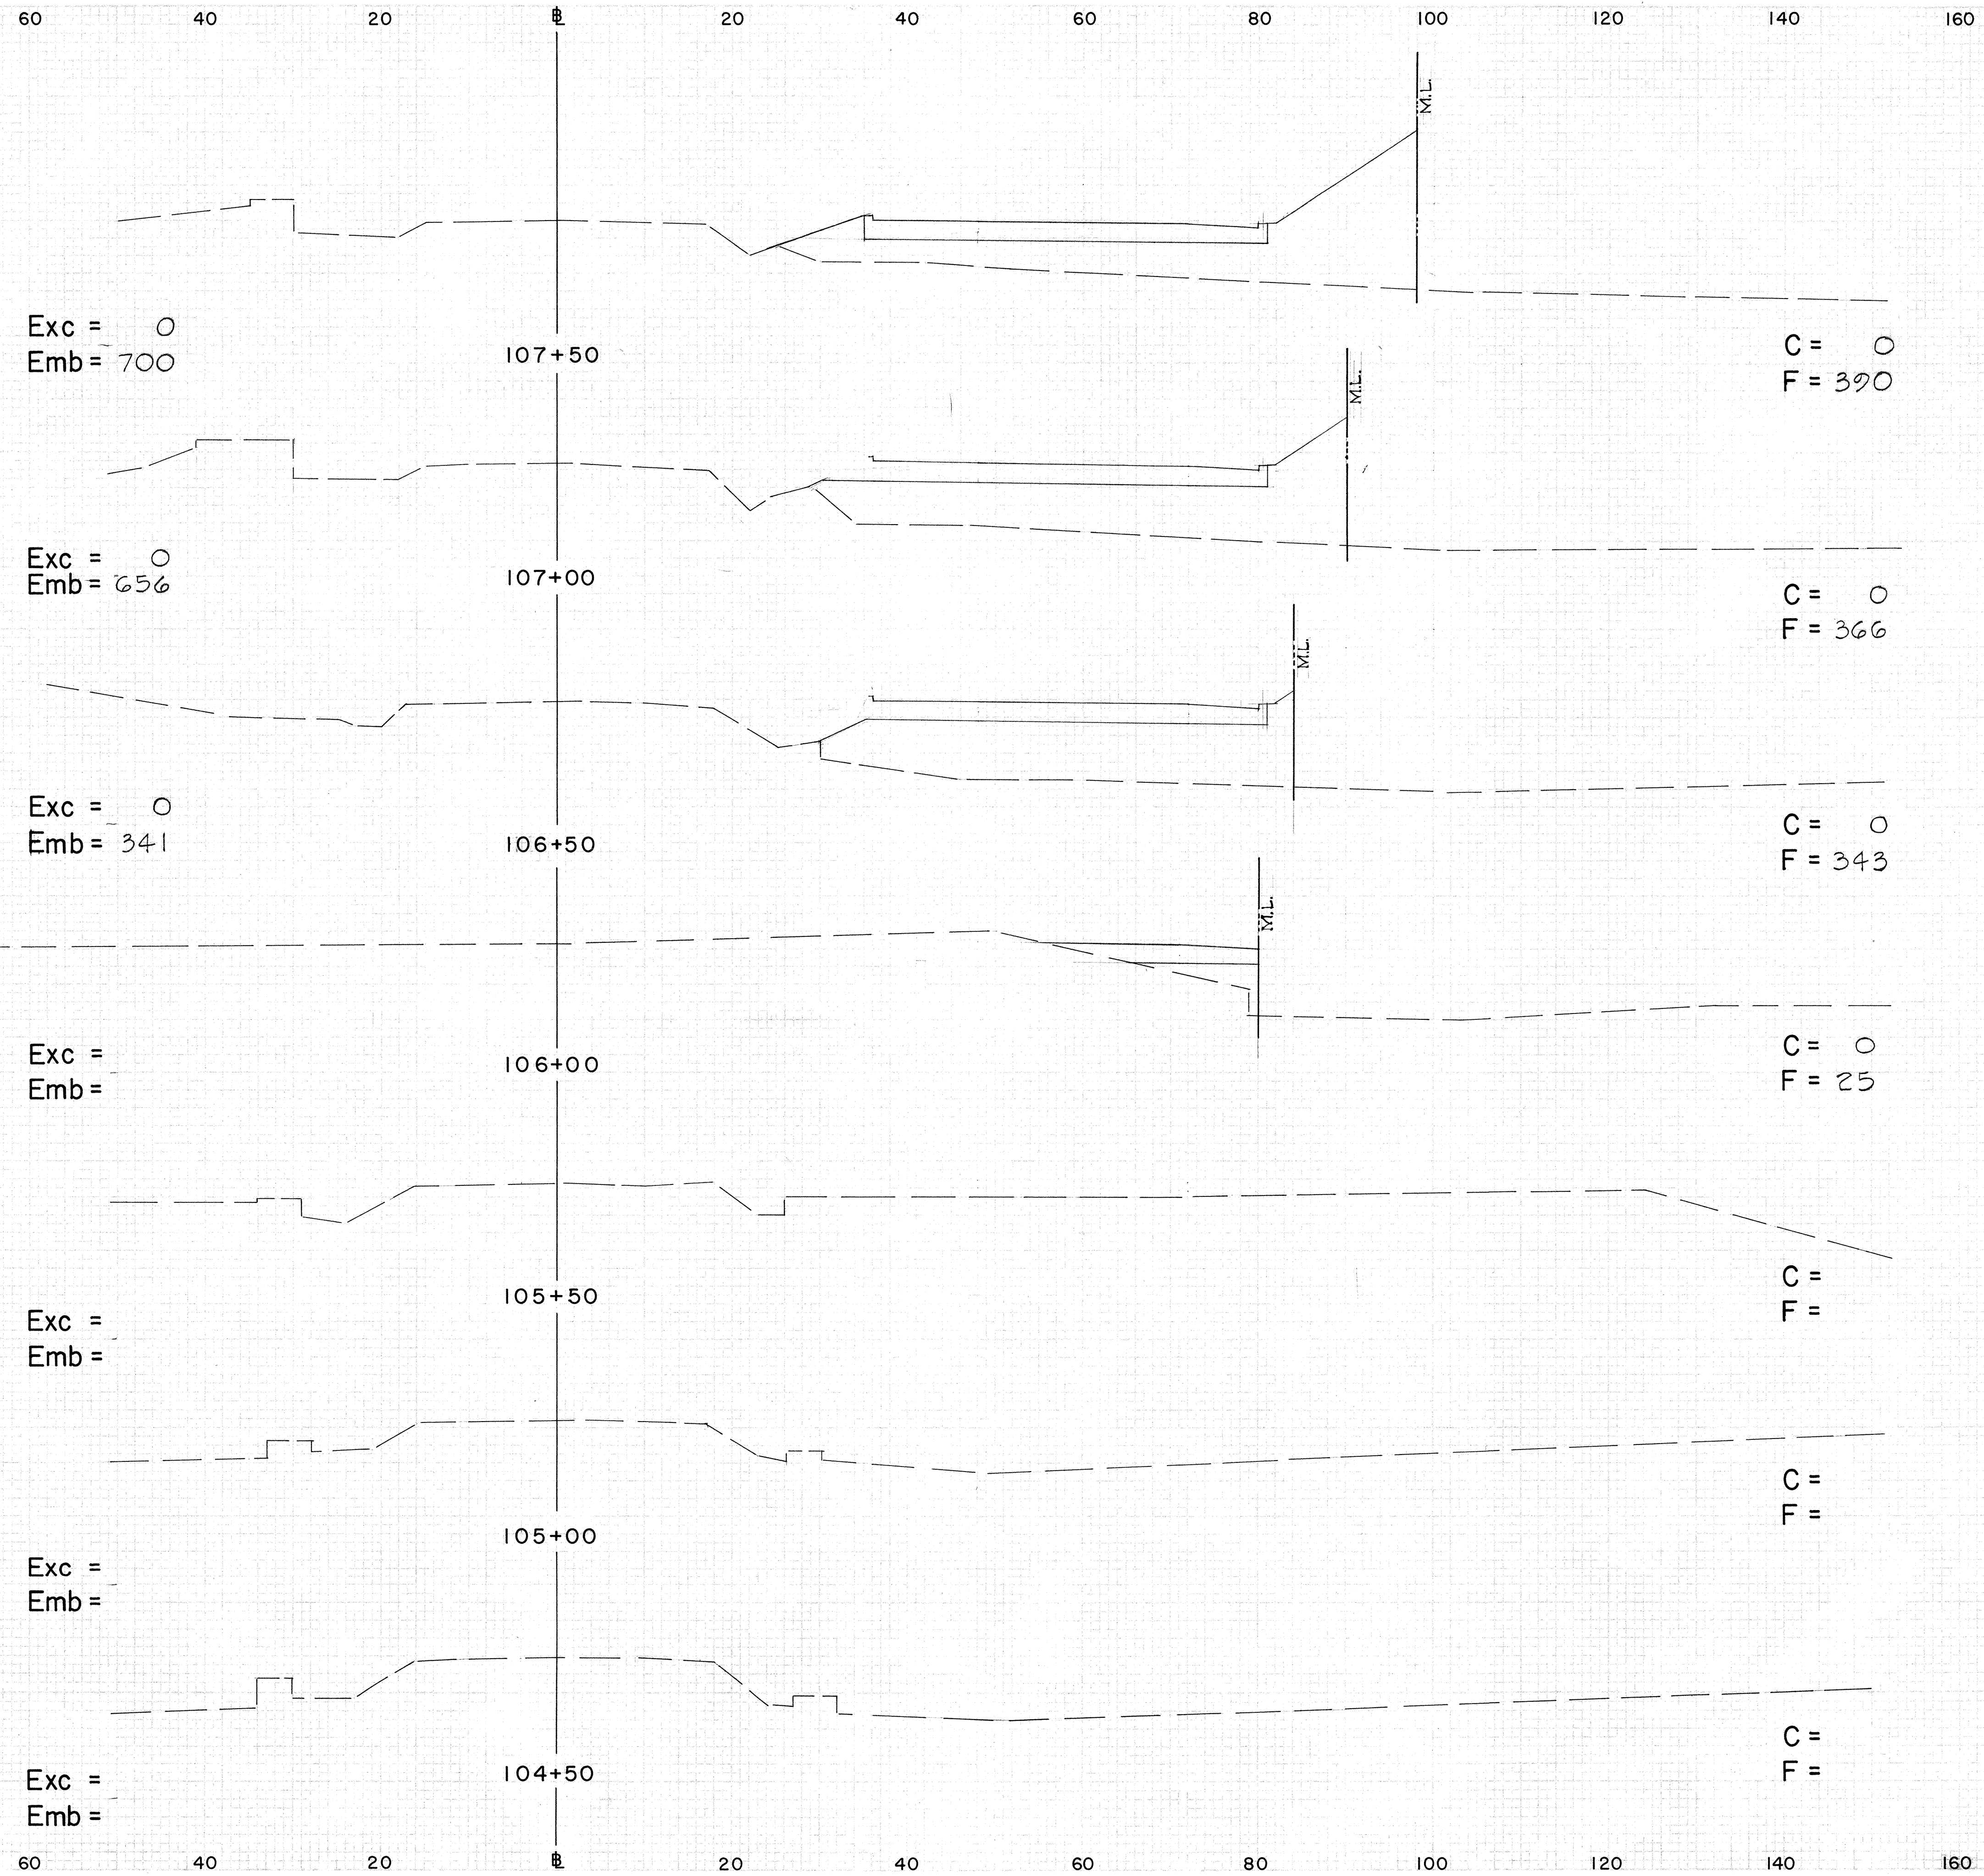


KUNIA ROAD
SHT. NO. 3 OF 5 SHTS.

FED. ROAD DIST. NO.	STATE	FED. AID PROJ. NO.	FISCAL YEAR	SHEET NO.	TOTAL SHEETS
HAWAII	HAW	T-HI-11(8)	1965	123	124

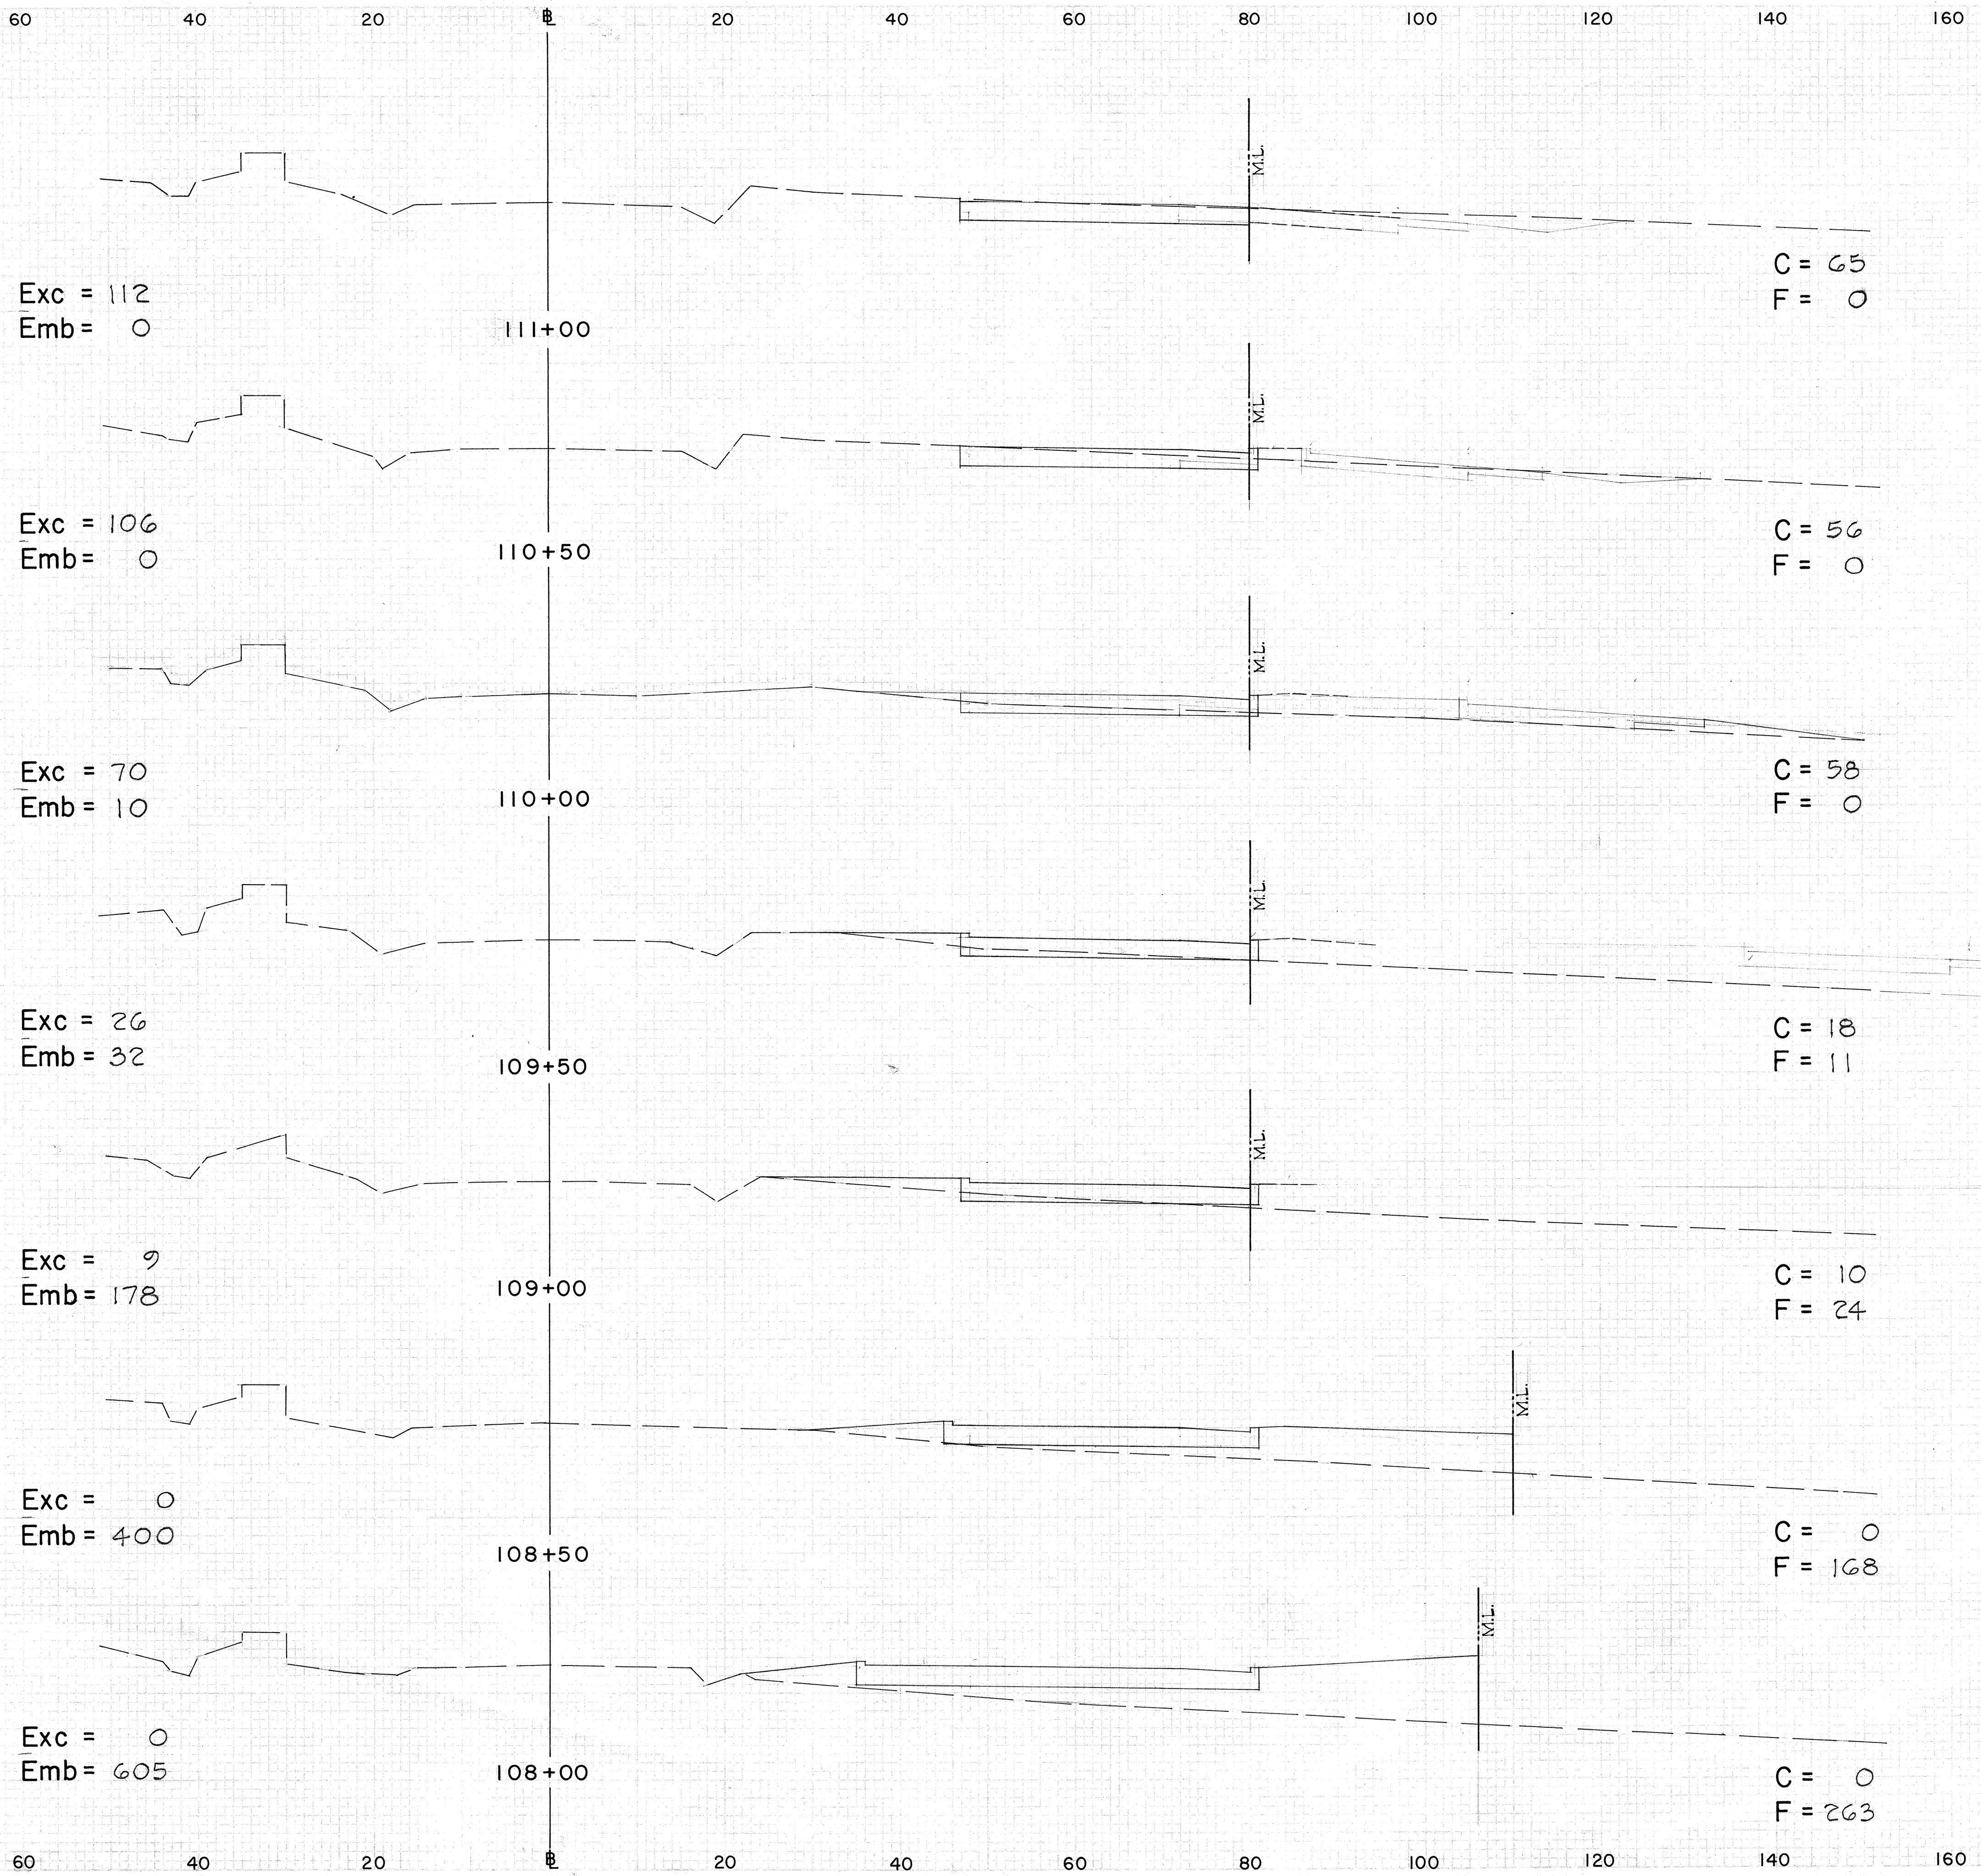

KUNIA ROAD
SHT. NO. 4 OF 5 SHTS.

FED. ROAD DIST. NO.	STATE	FED. AID PROJ. NO.	FISCAL YEAR	SHEET NO.	TOTAL SHEETS
HAWAII	HAW.	I-HI-1(18)	1965	124	124

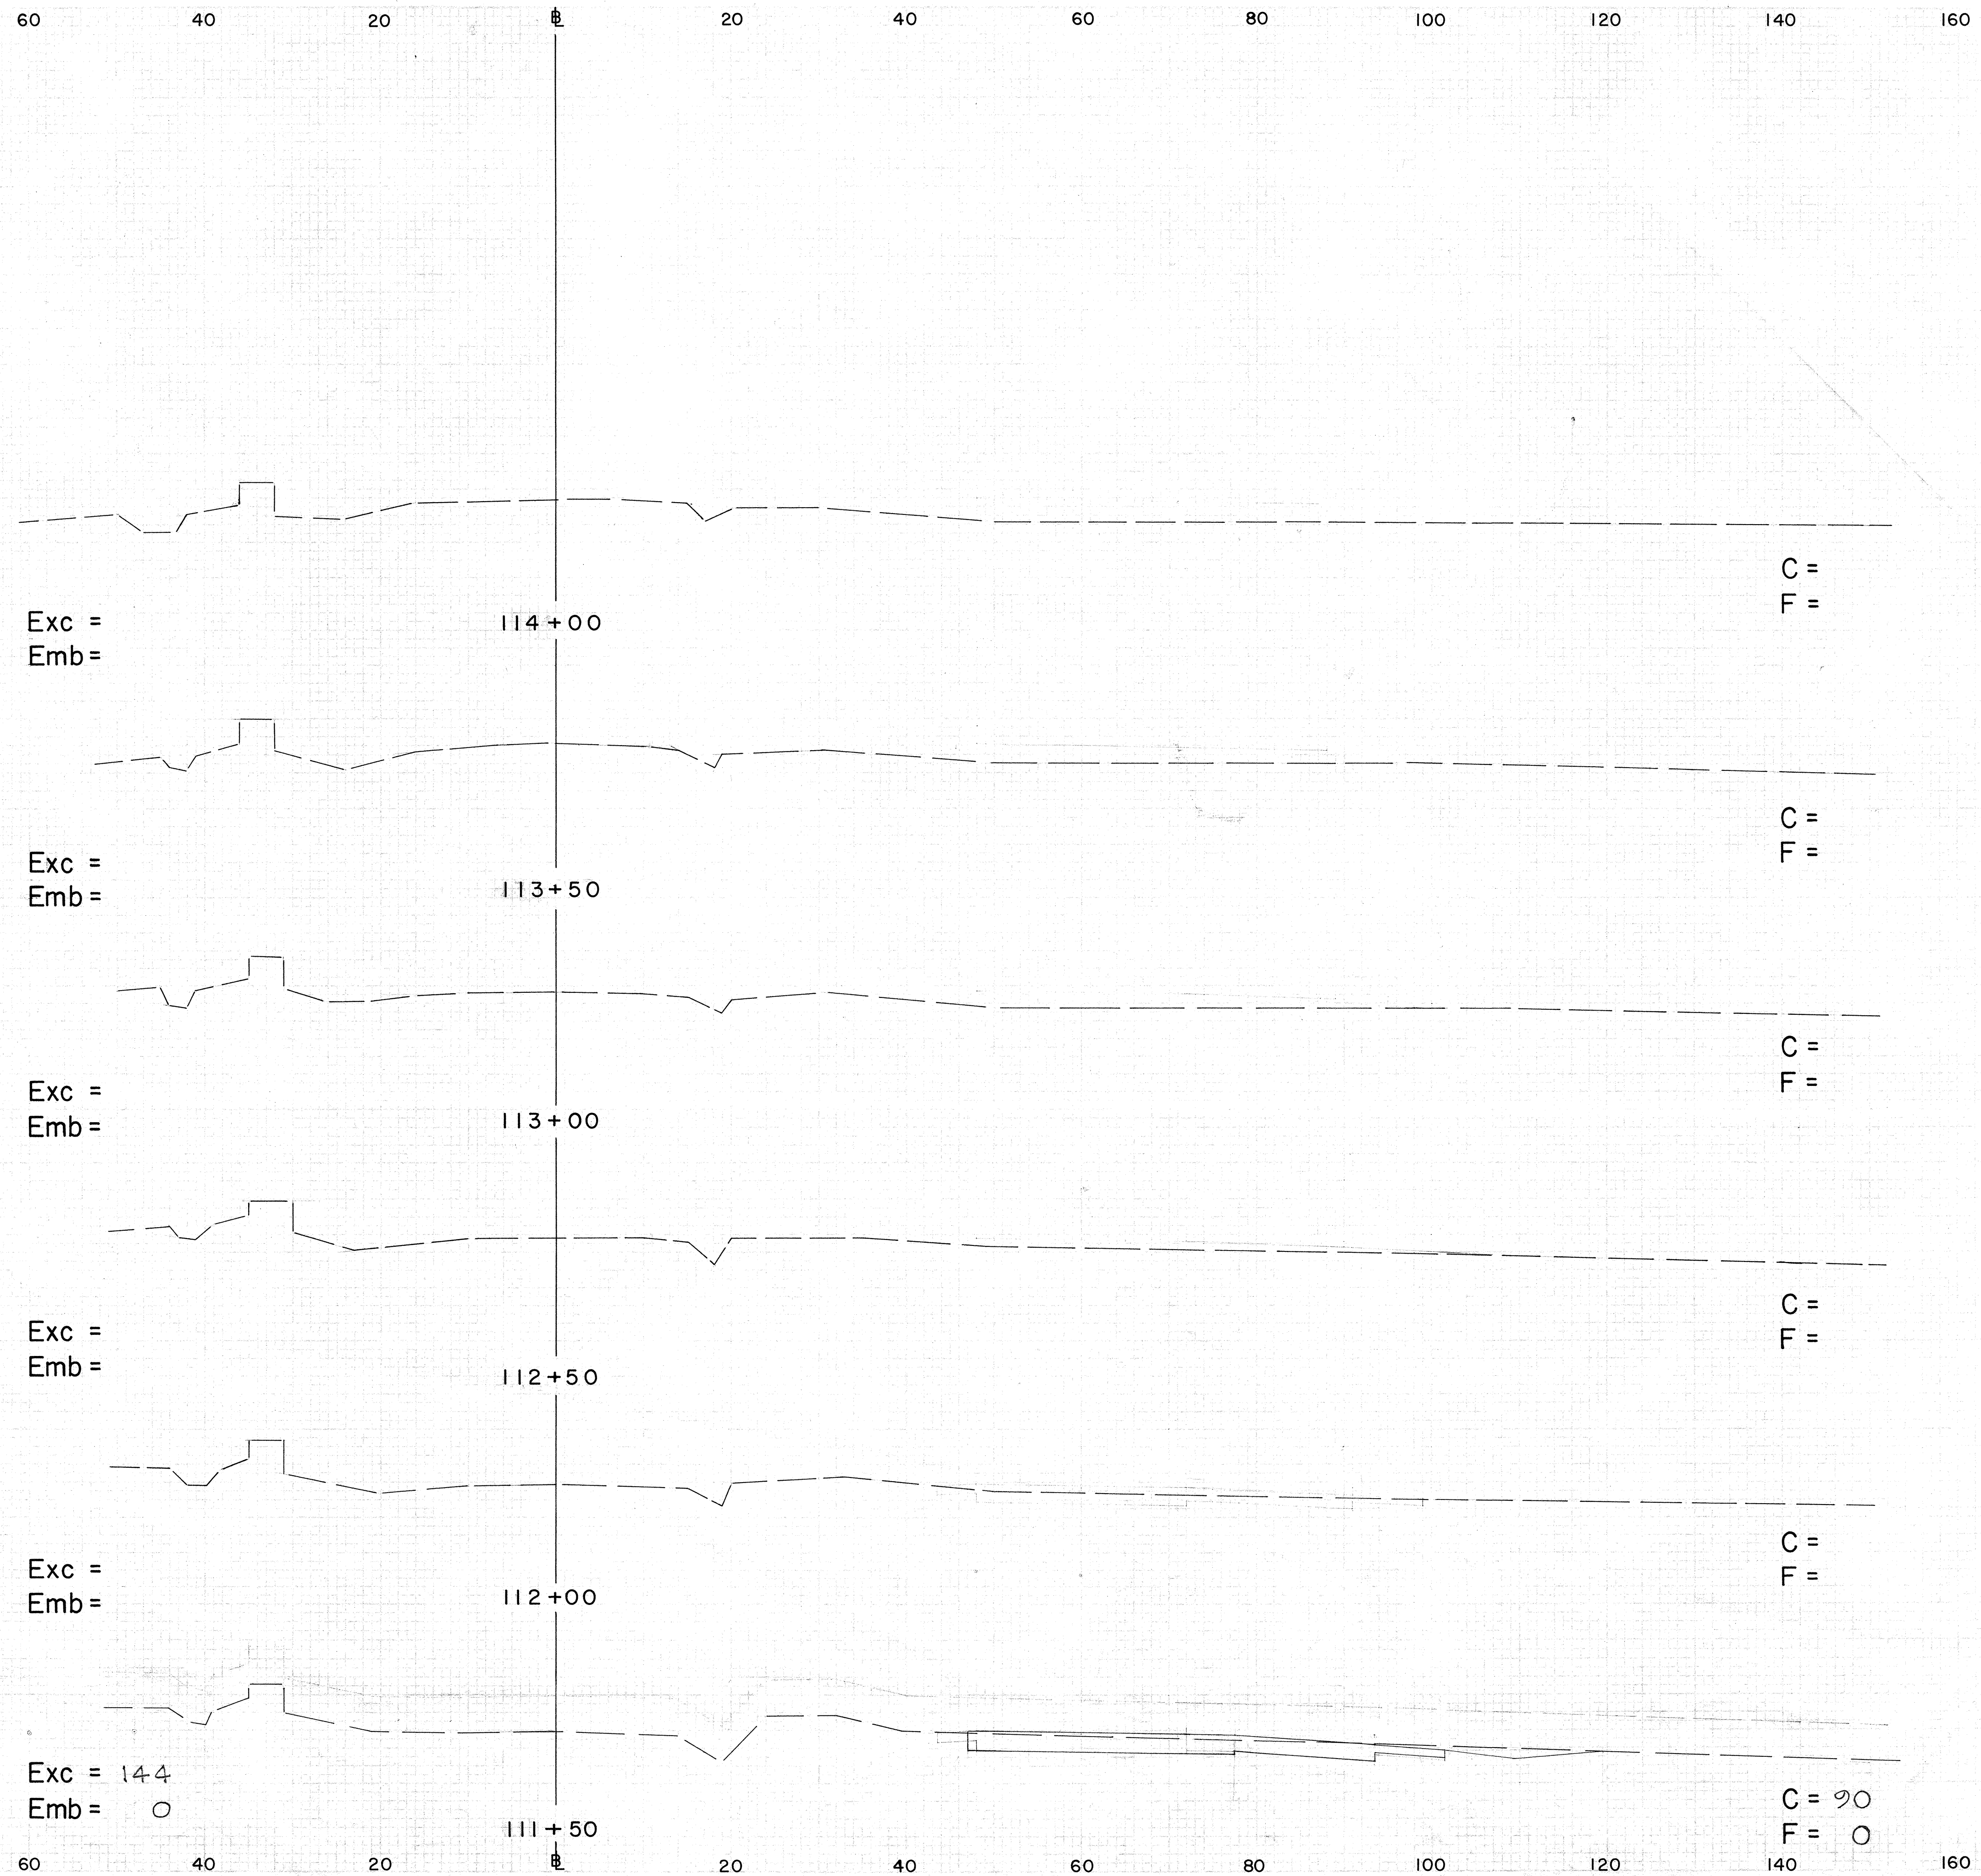

KUNIA ROAD
SHT. NO. 5 OF 5 SHTS.

124