
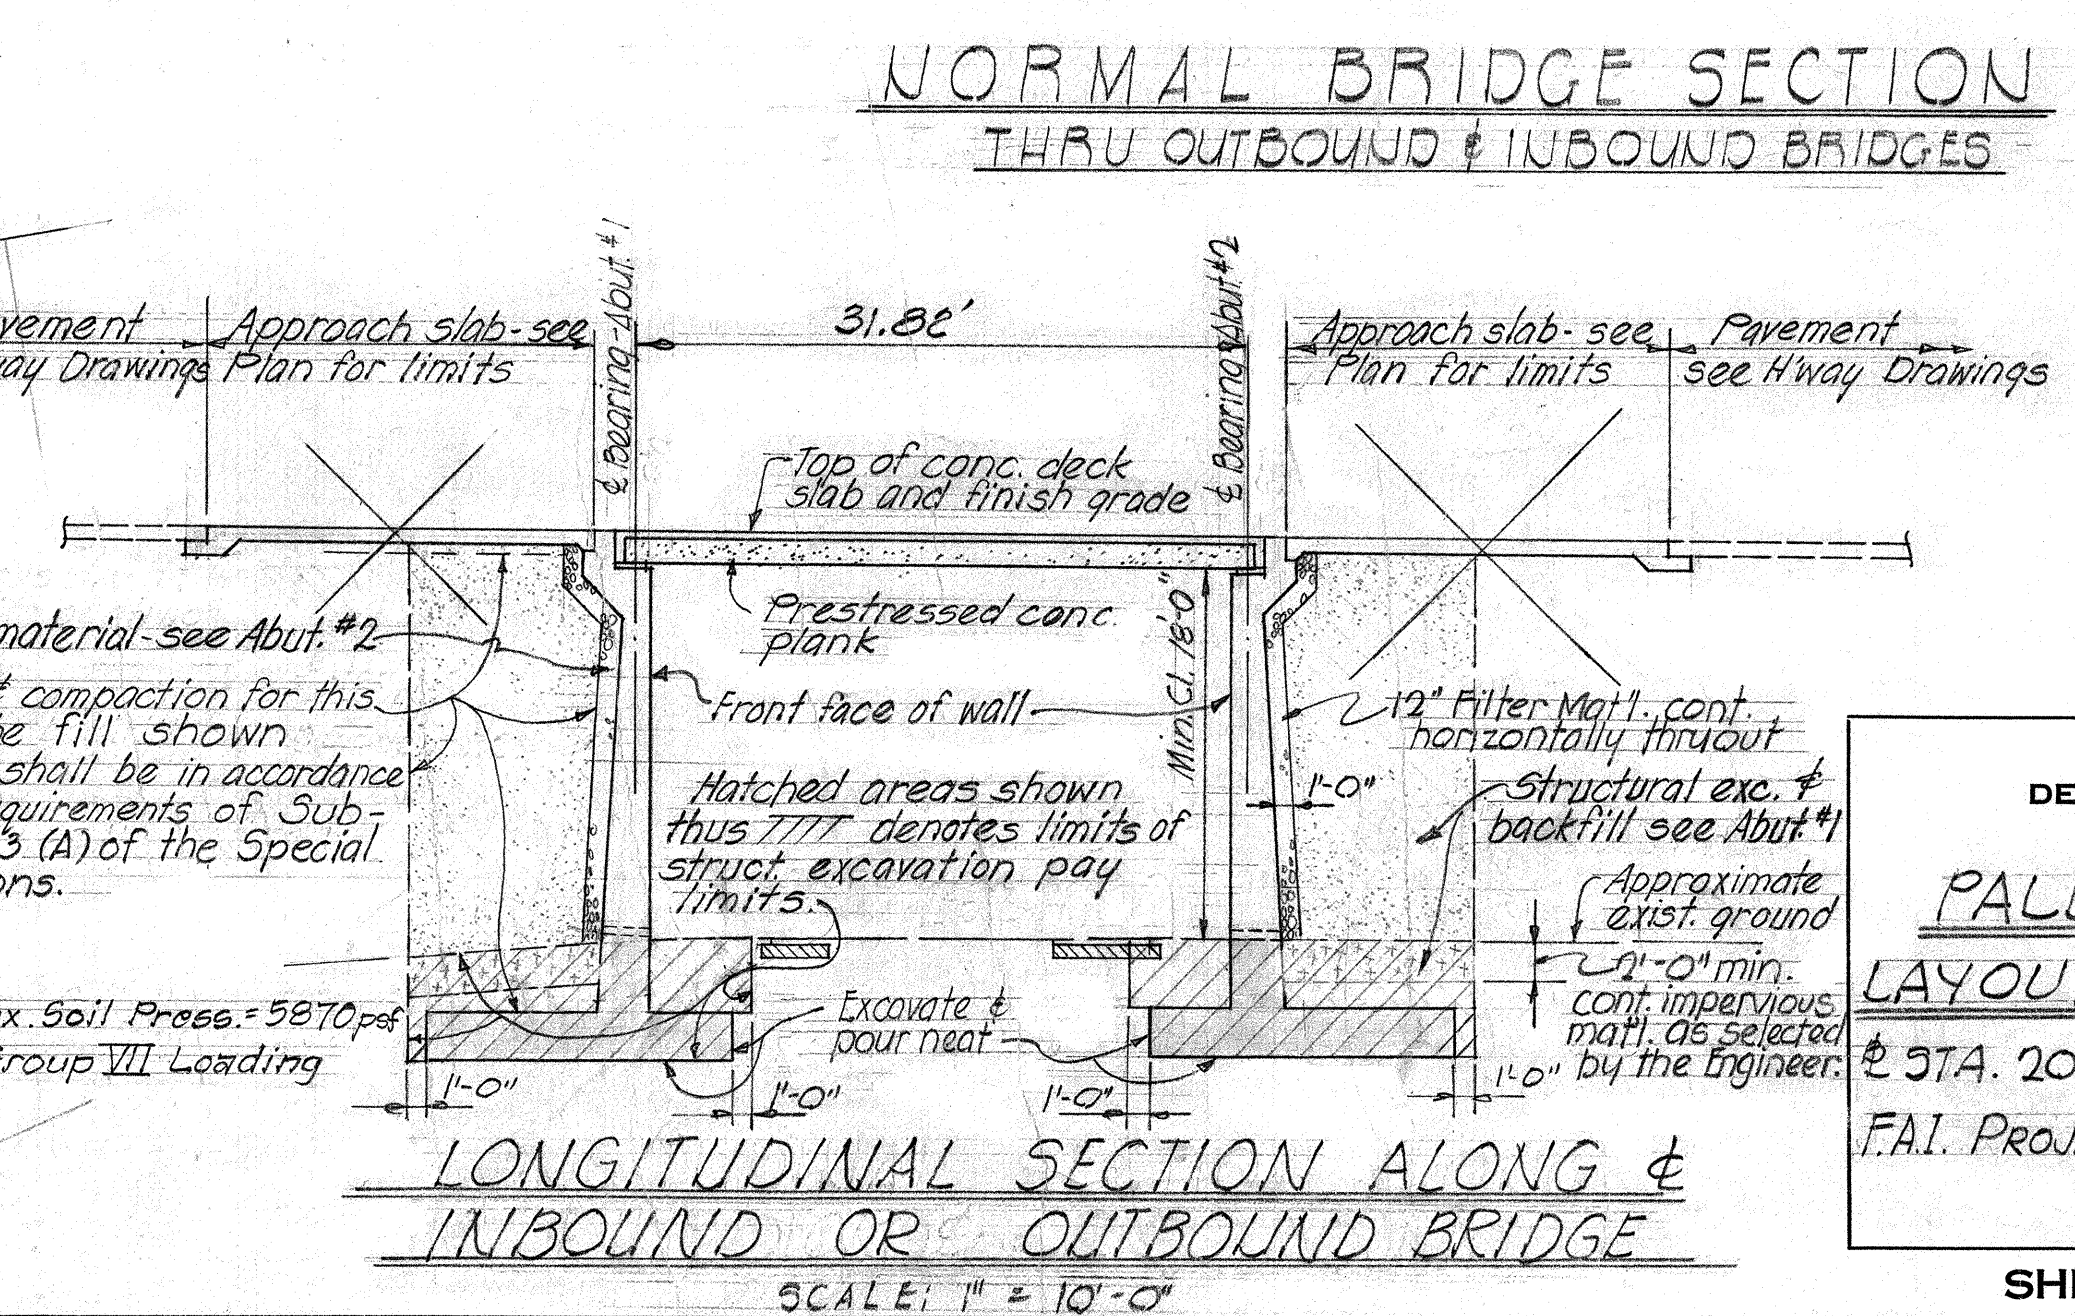
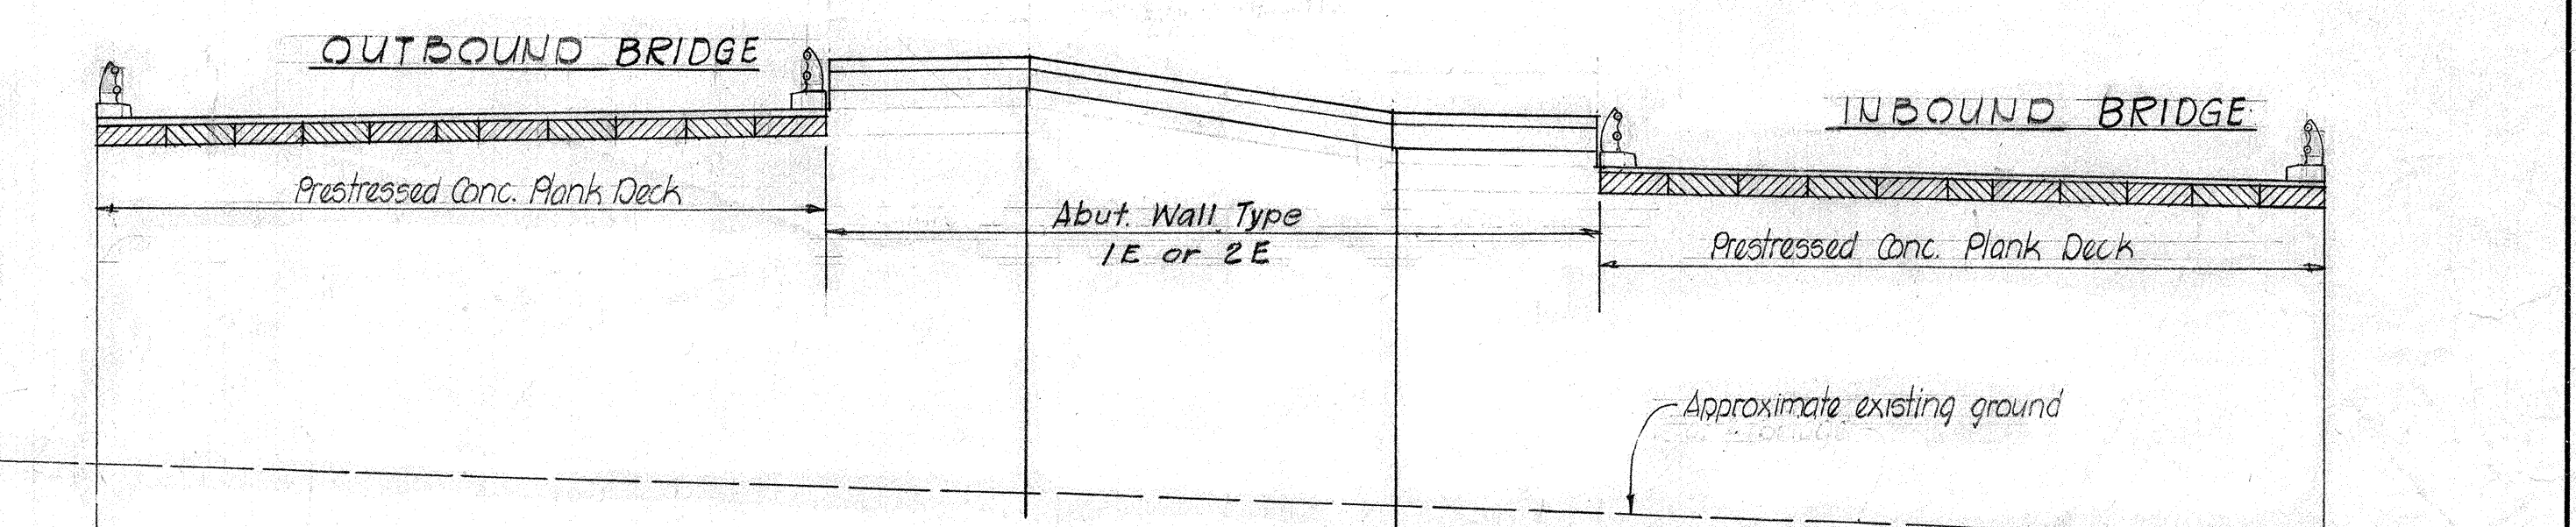
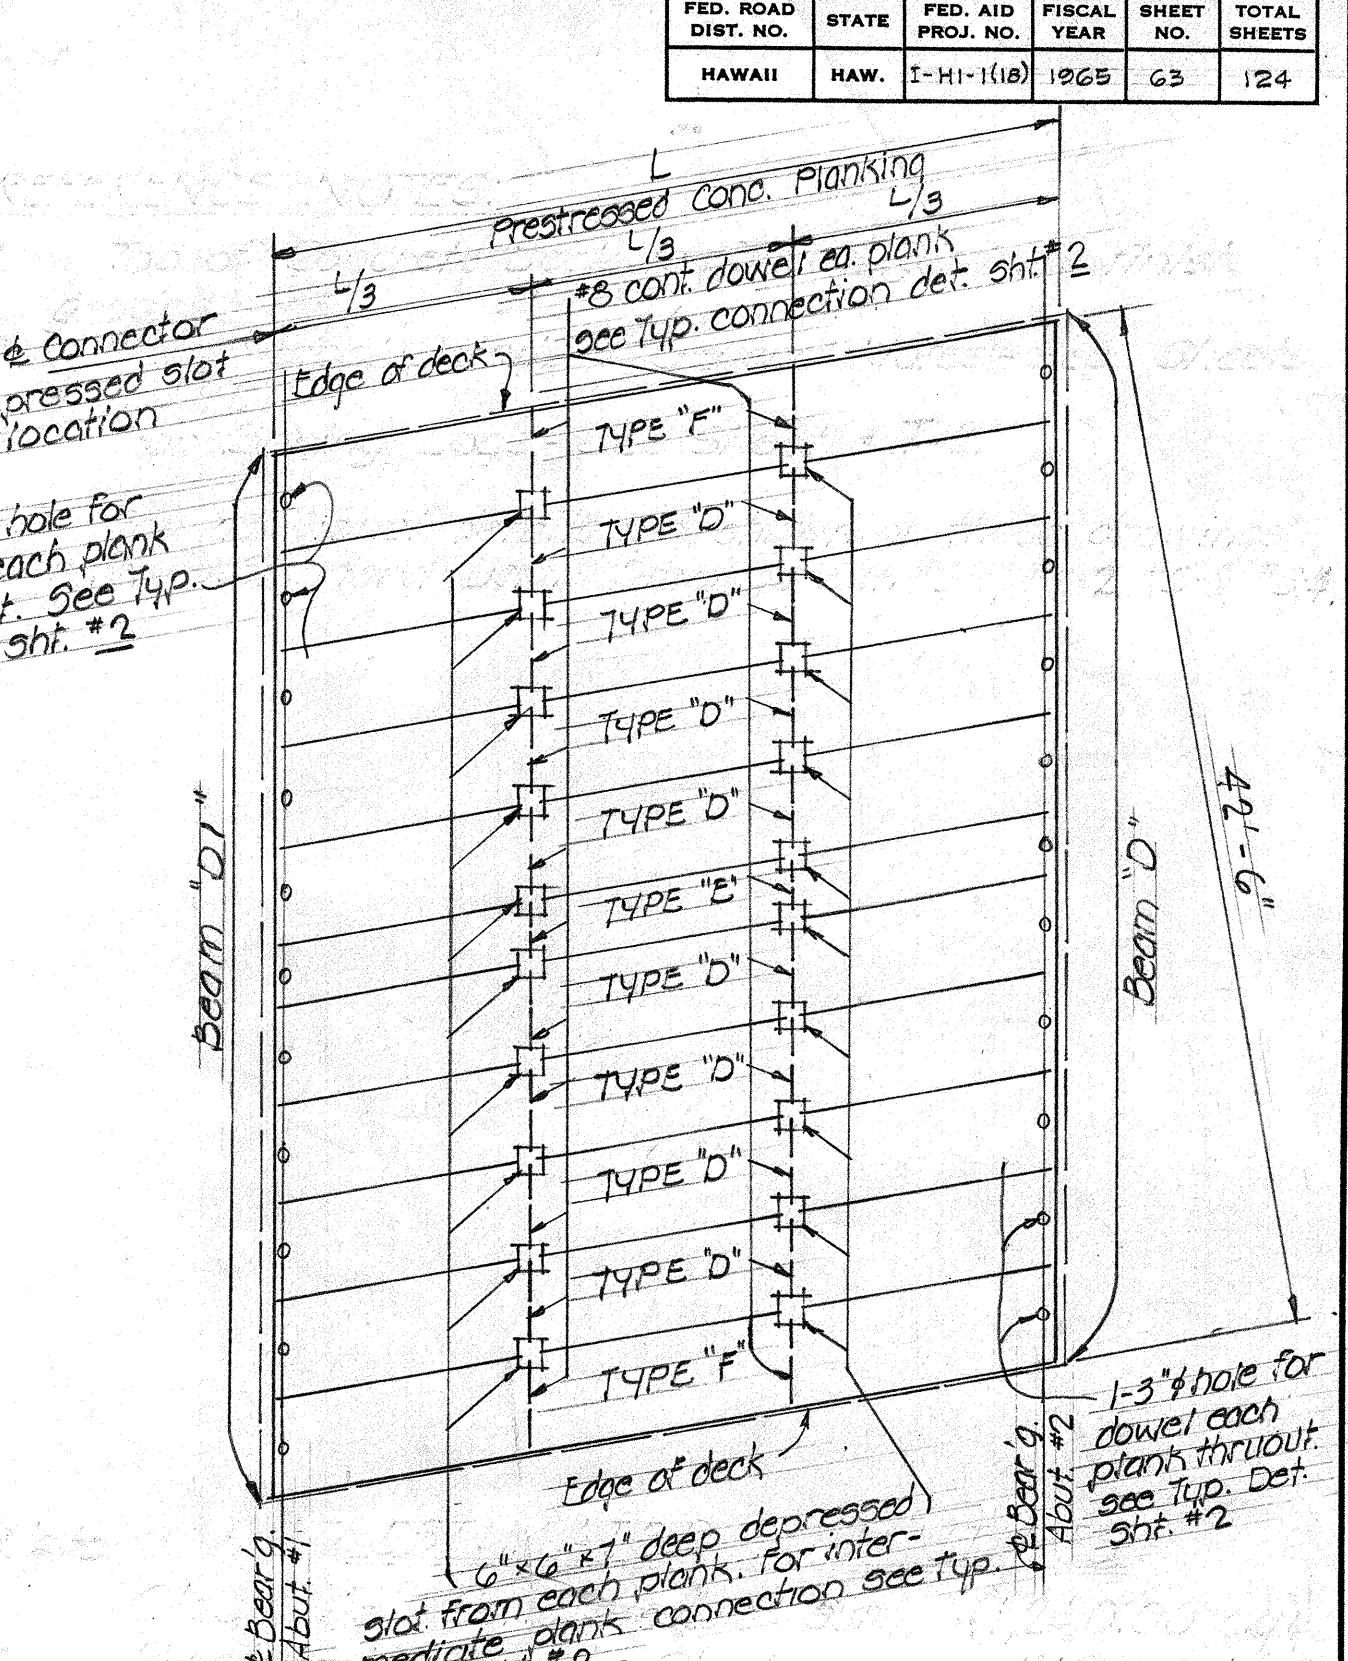
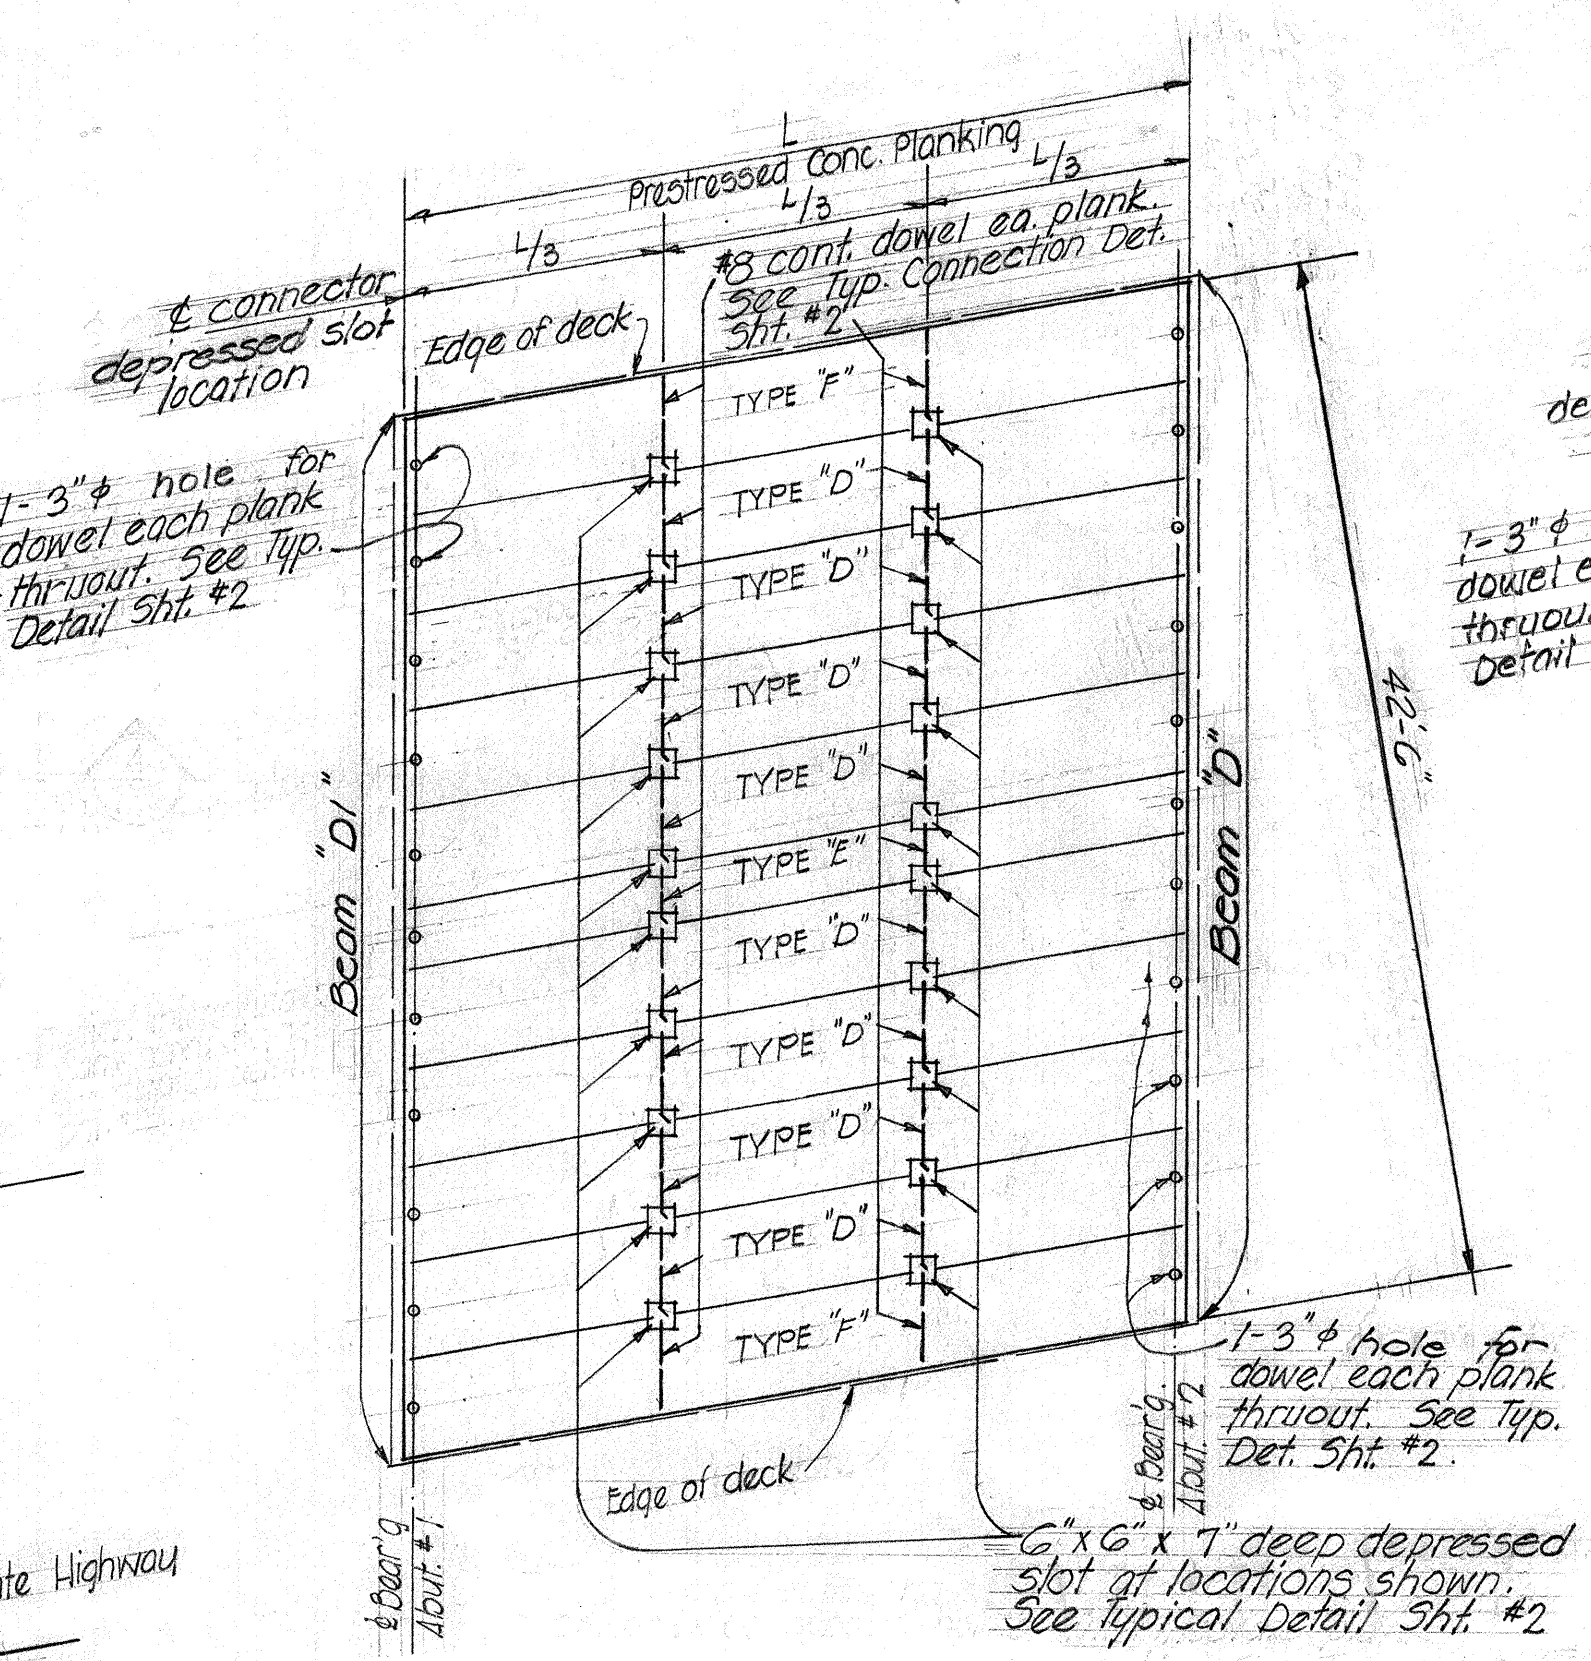


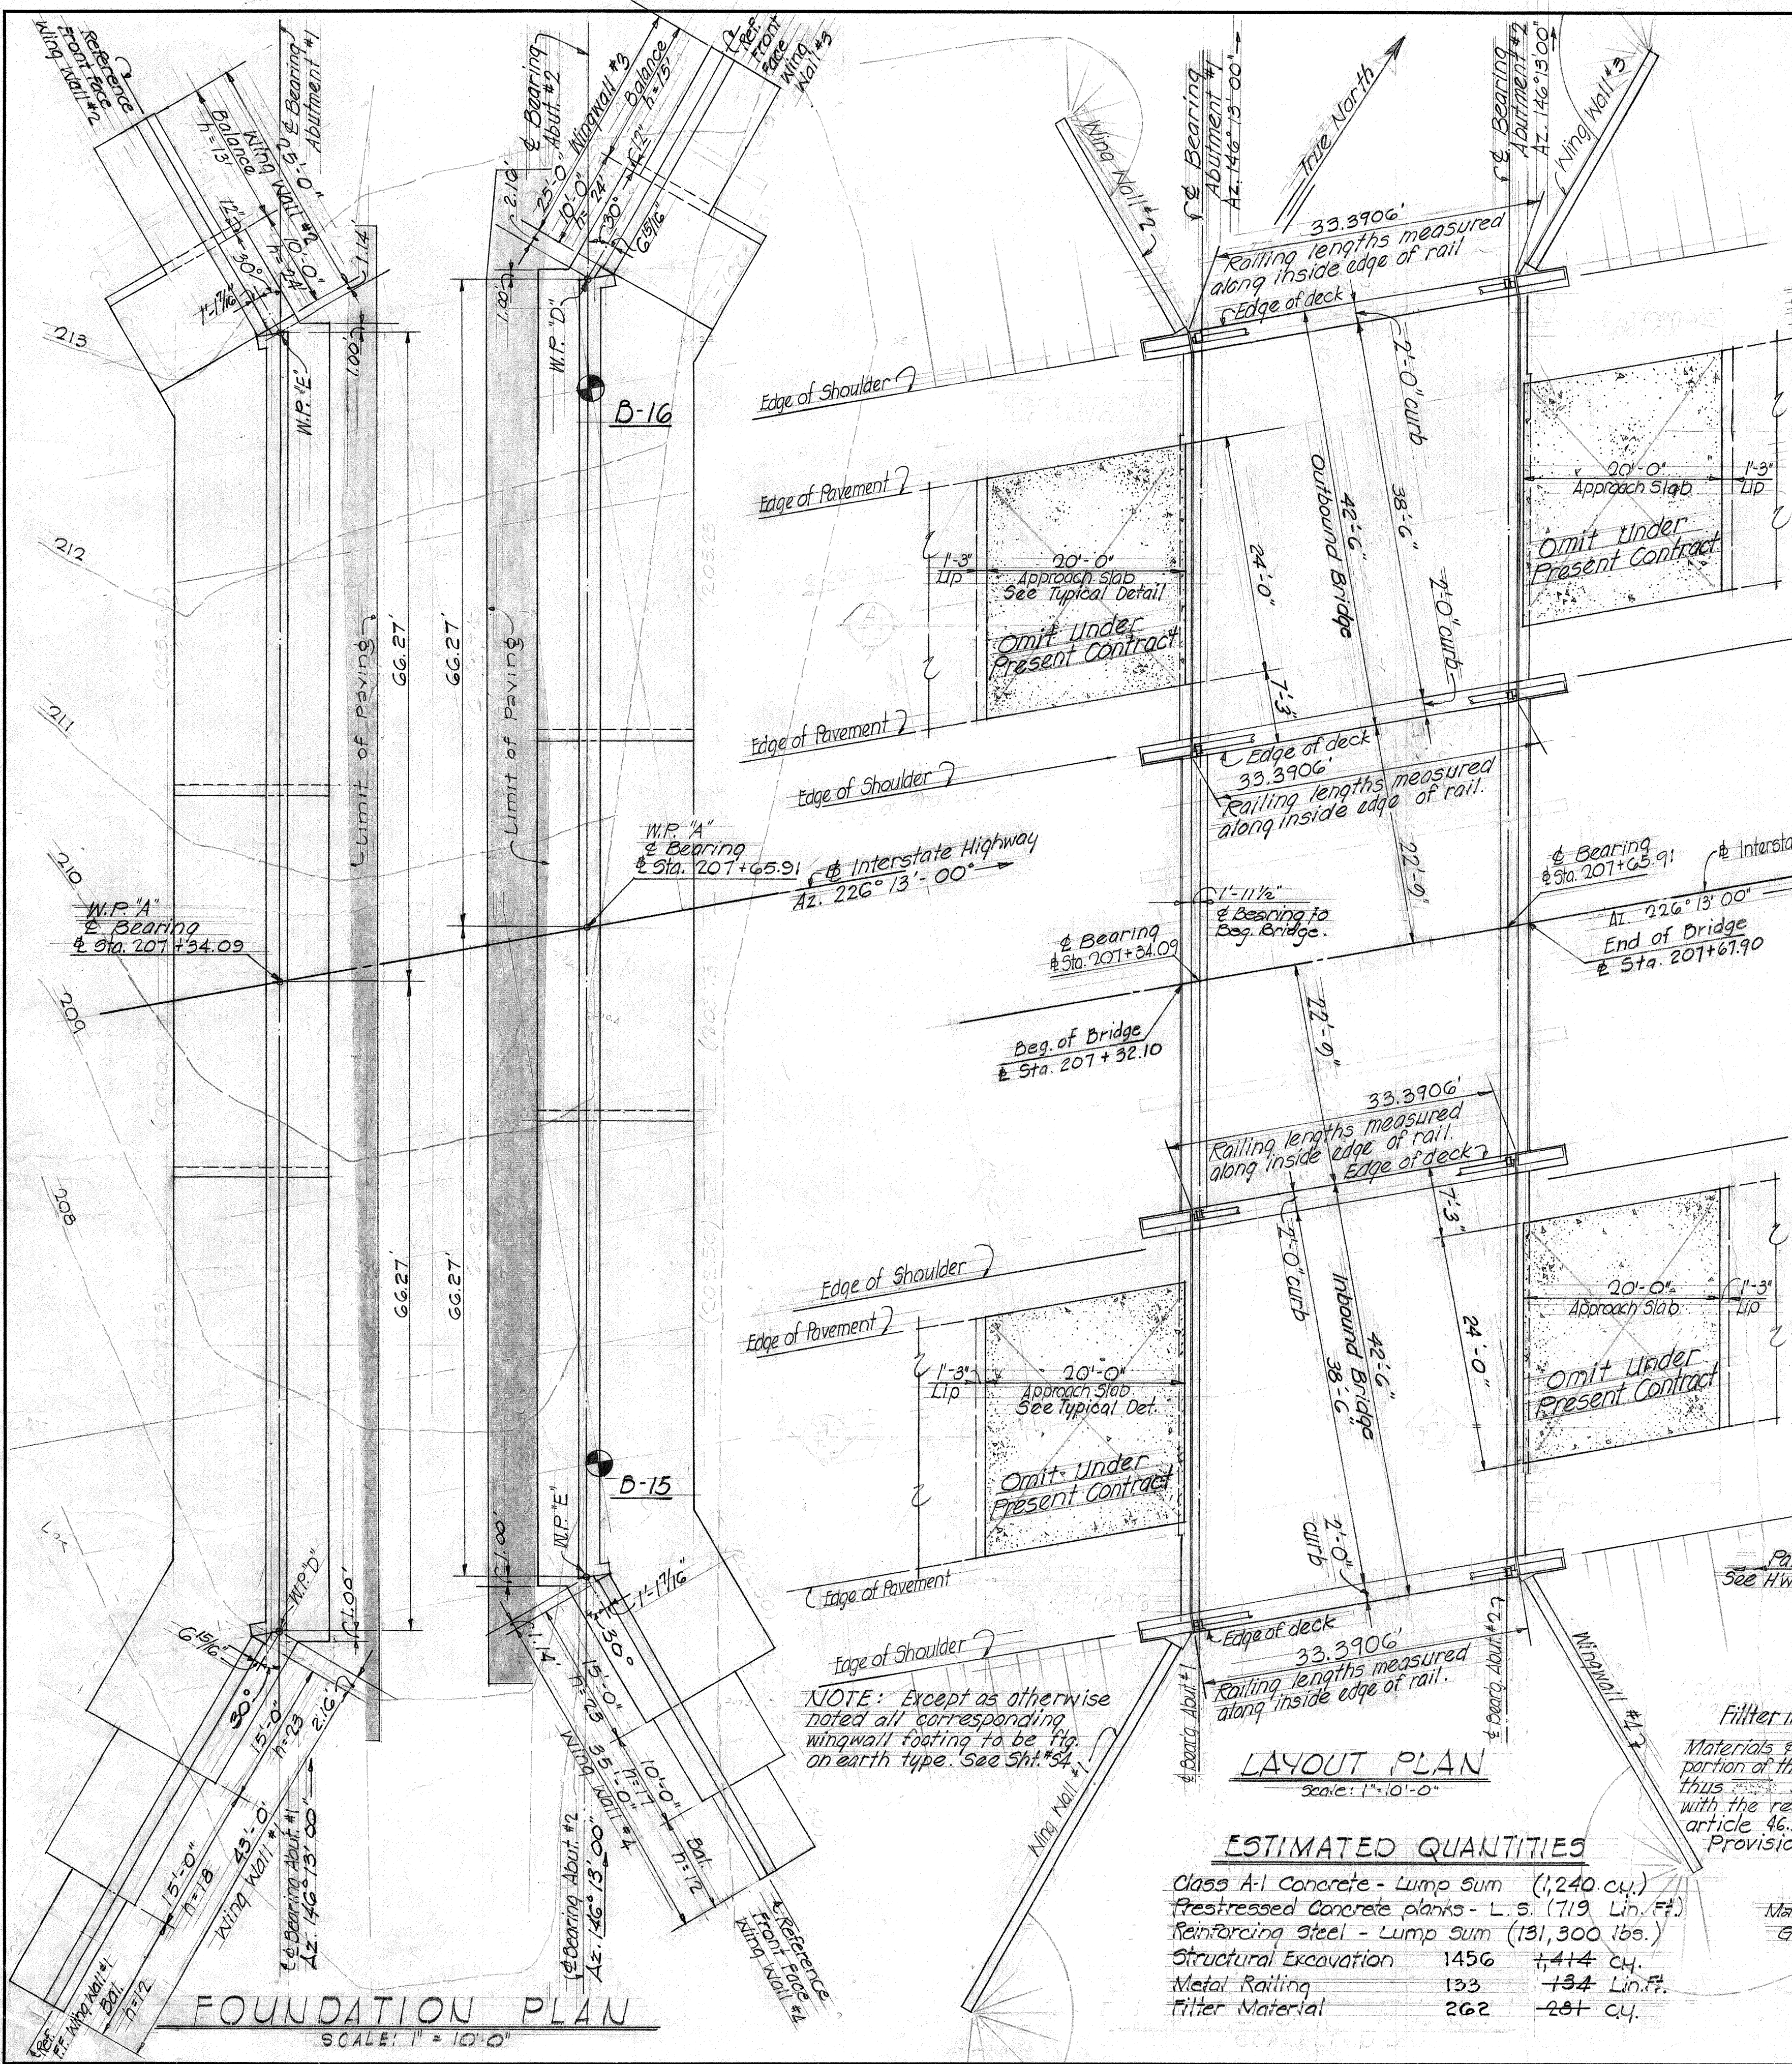

- REFERENCE NOTES**
1. Top of concrete deck to follow Roadway finish grade - see Highway drawings.
 2. For General Notes, see Sht. #1-1.
 3. For Boring Logs - see Sht. #1-1.
 4. For additional details not shown on these drawings, refer to Standard Detail Drawings Sht. #5-1, #5-2, #5-3, #5-4.





STATE OF HAWAII
DEPARTMENT OF TRANSPORTATION
HIGHWAYS DIVISION

PALEHUA SEPARATION
LAYOUT PLANS AND DETAILS
Sta. 207+32.10 to Sta. 207+67.90
F.A.I. Proj. IHI-1101 PALEHUA RD. TO KUNIA RD.
NOV. 1964

SHEET No. 1 OF 5 SHEETS


ORIGINAL PLAN
DATE: 1/16/64
DRAWN BY: M.B. J.E.
CHECKED BY: J.A. H.T.
NOTE BOOK
QUANTITIES BY: J.A. H.T., M.B.
CHECKED BY: J.E., J.A.
No.

FED. ROAD DIST. NO.	STATE	FED. AID PROJ. NO.	FISCAL YEAR	SHEET NO.	TOTAL SHEETS
HAWAII	HAW.	I-HI-1(18)	1965	64	124

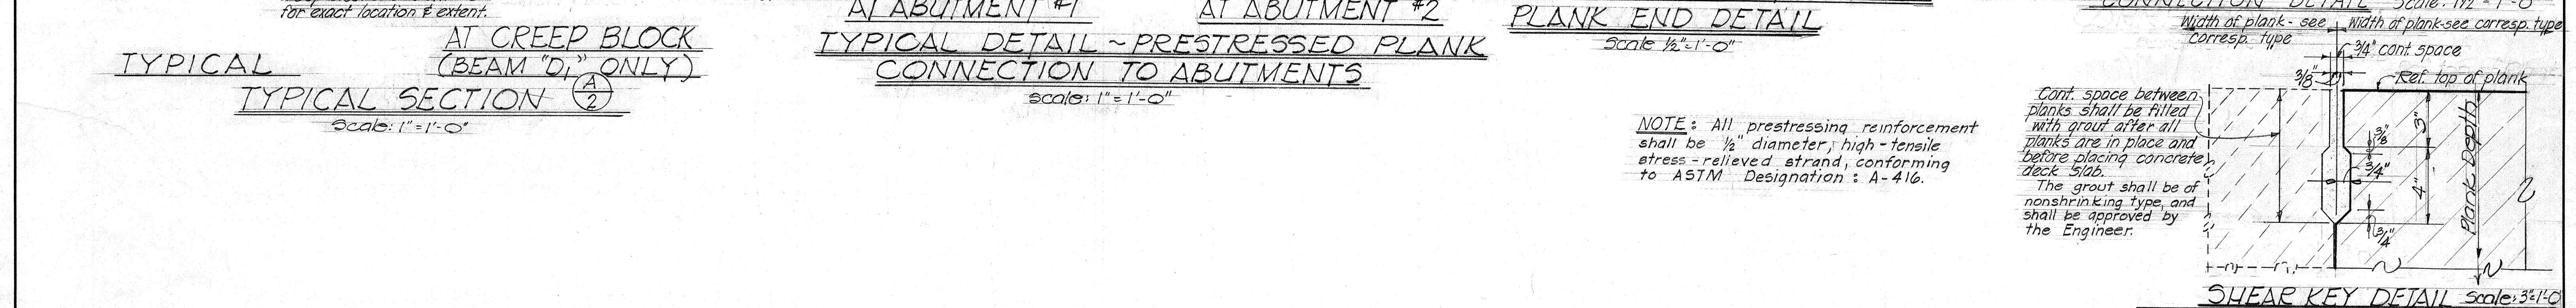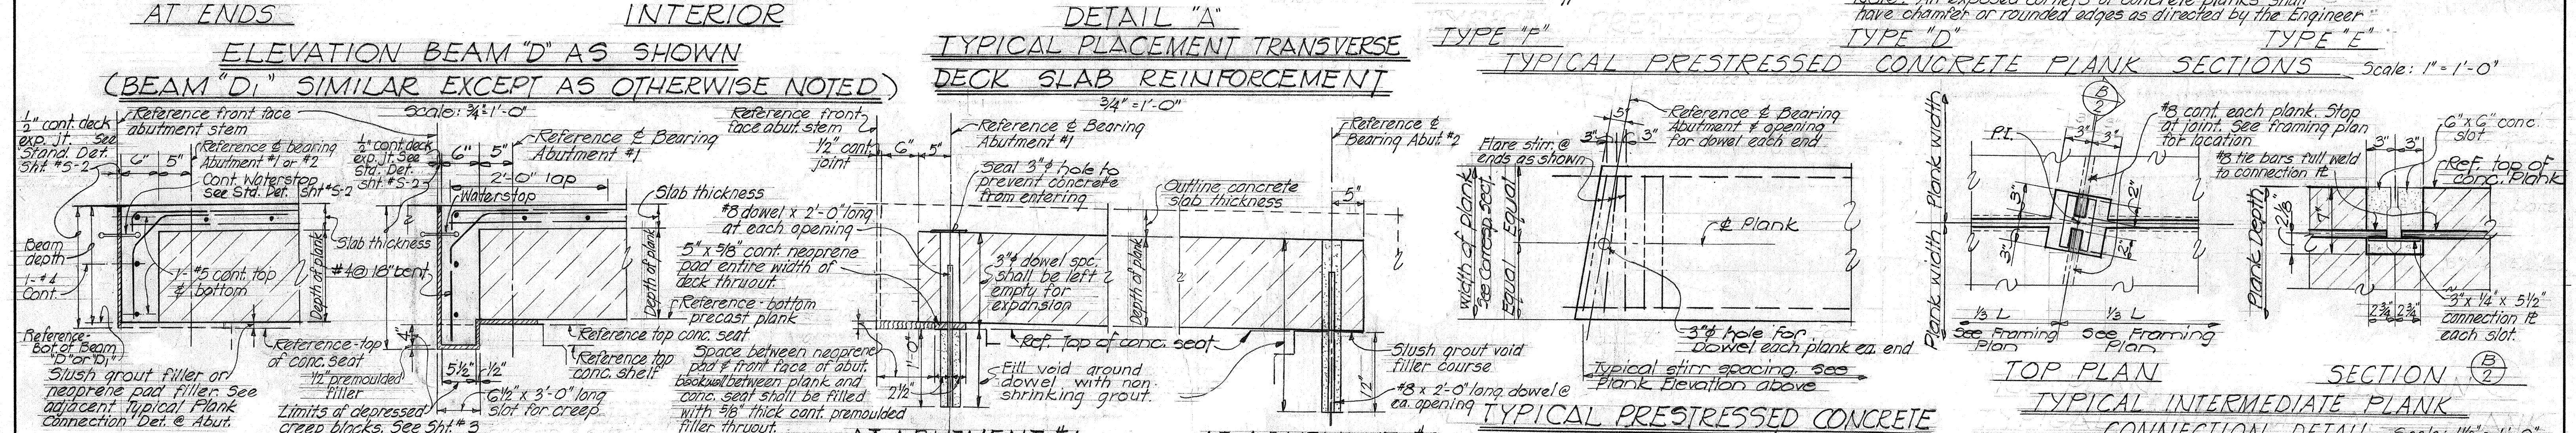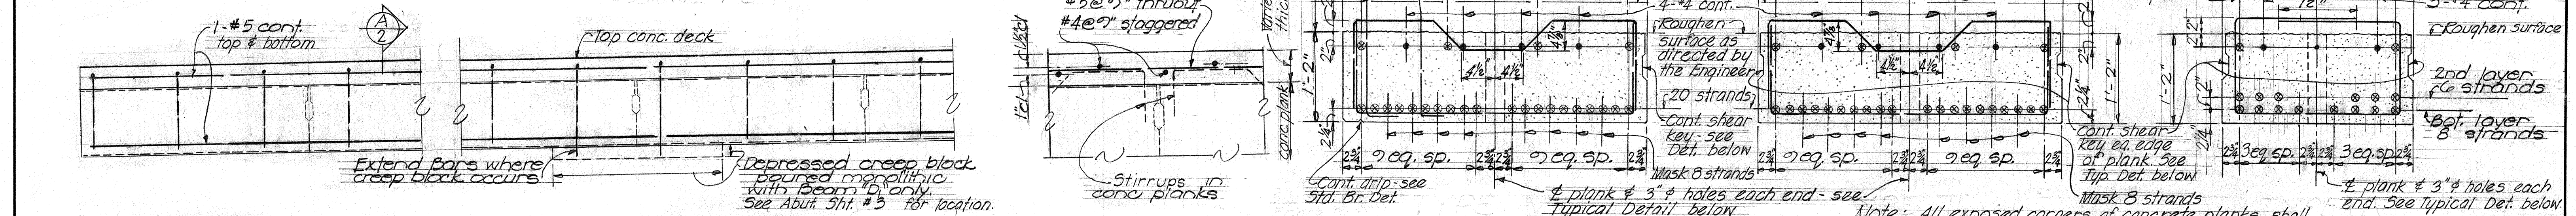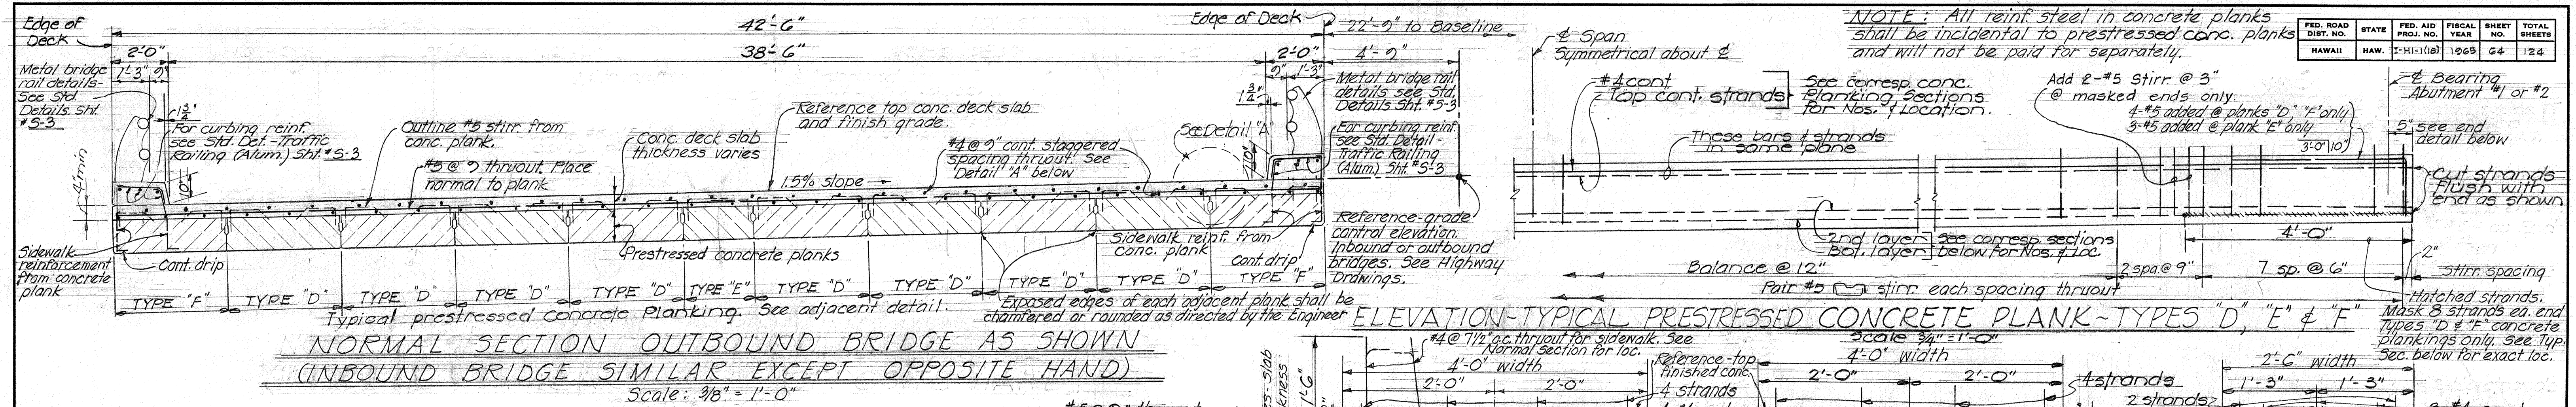

FED. ROAD DIST. NO.	STATE	FED. AID PROJ. NO.	FISCAL YEAR	SHEET NO.	TOTAL SHEETS
HAWAII	HAW.	I-H-1(18)	1965	65	124

IMPORTANT!! The Contractor shall verify the exact location of the 3" holes at each prestressed conc. plank before locating the corresponding hole on the abutment seat to receive the thru dowel.

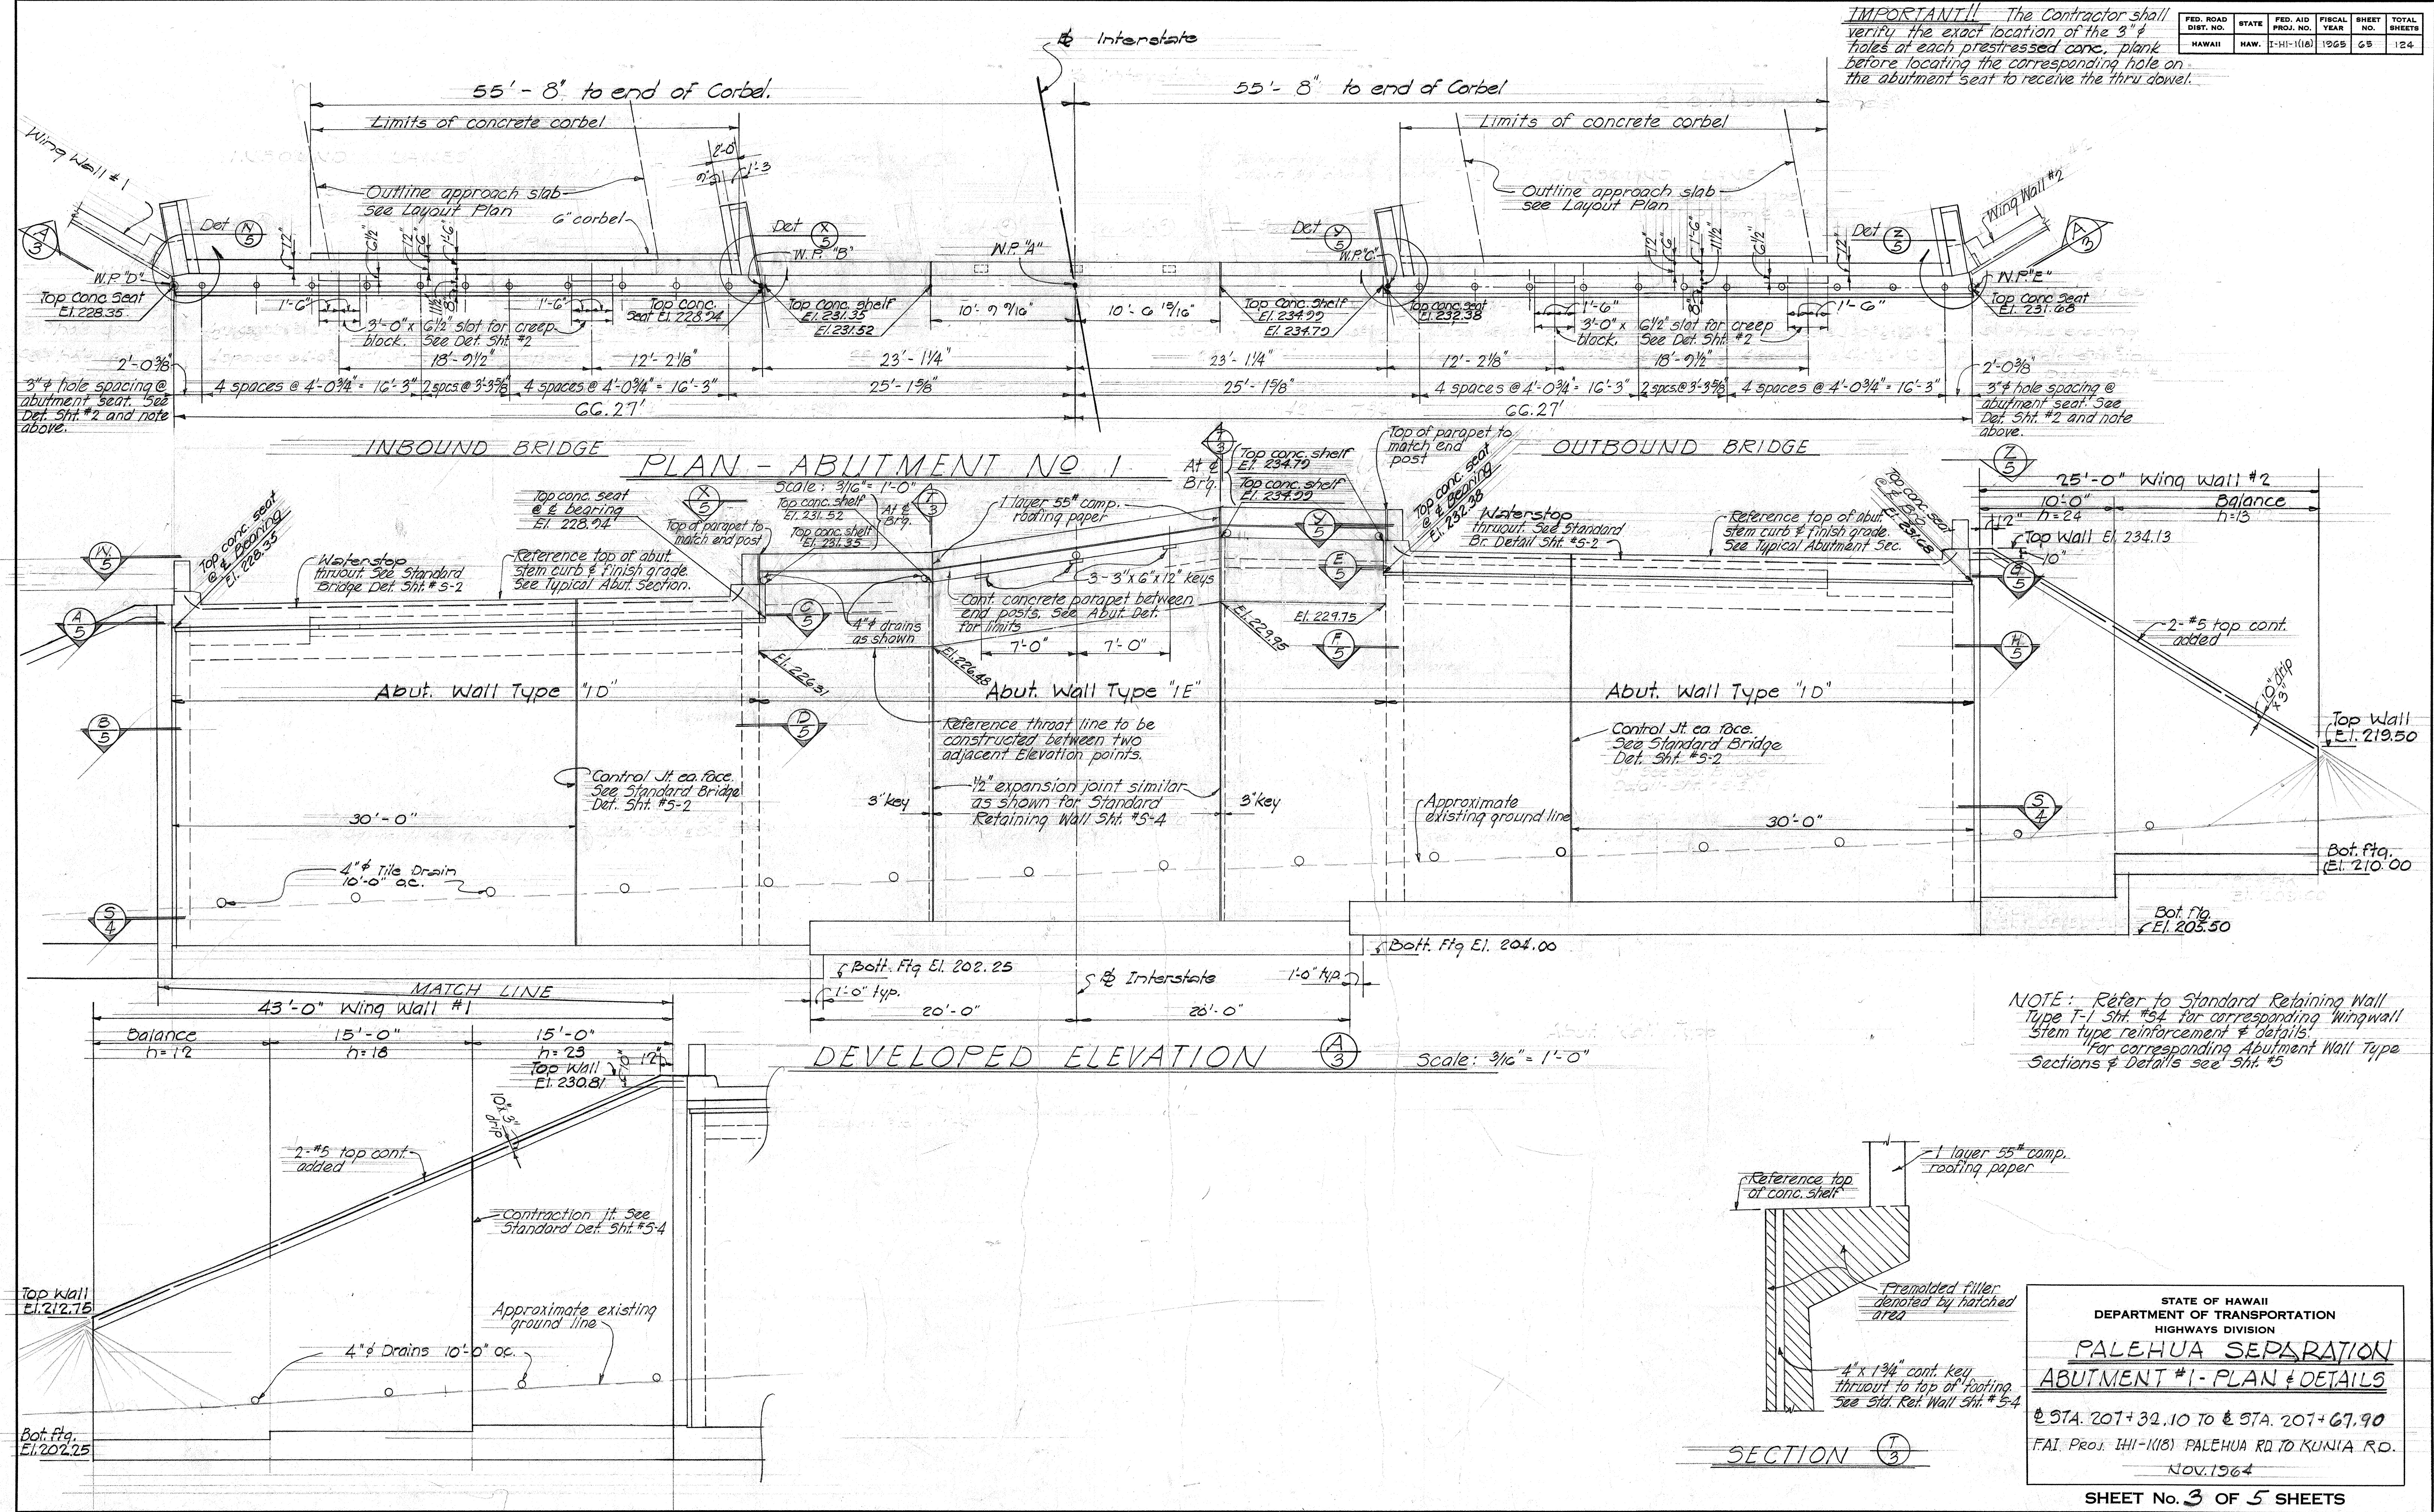

DATE	11/1/64
DESIGNED BY	W.B.
DRAWN BY	W.B.
CHECKED BY	W.B.
NOTED BY	W.B.
ORIGINAL PLAN	
NOTE BOOK	
NO.	

STATE OF HAWAII
DEPARTMENT OF TRANSPORTATION
HIGHWAYS DIVISION

**PALEHUA SEPARATION
ABUTMENT #1 - PLAN & DETAILS**

± STA. 207+32.10 TO ± STA. 207+67.90
FAI, Proj. IHI-1(18) PALEHUA RD TO KUNIA RD.
Nov. 1964

SHEET No. 3 OF 5 SHEETS

