
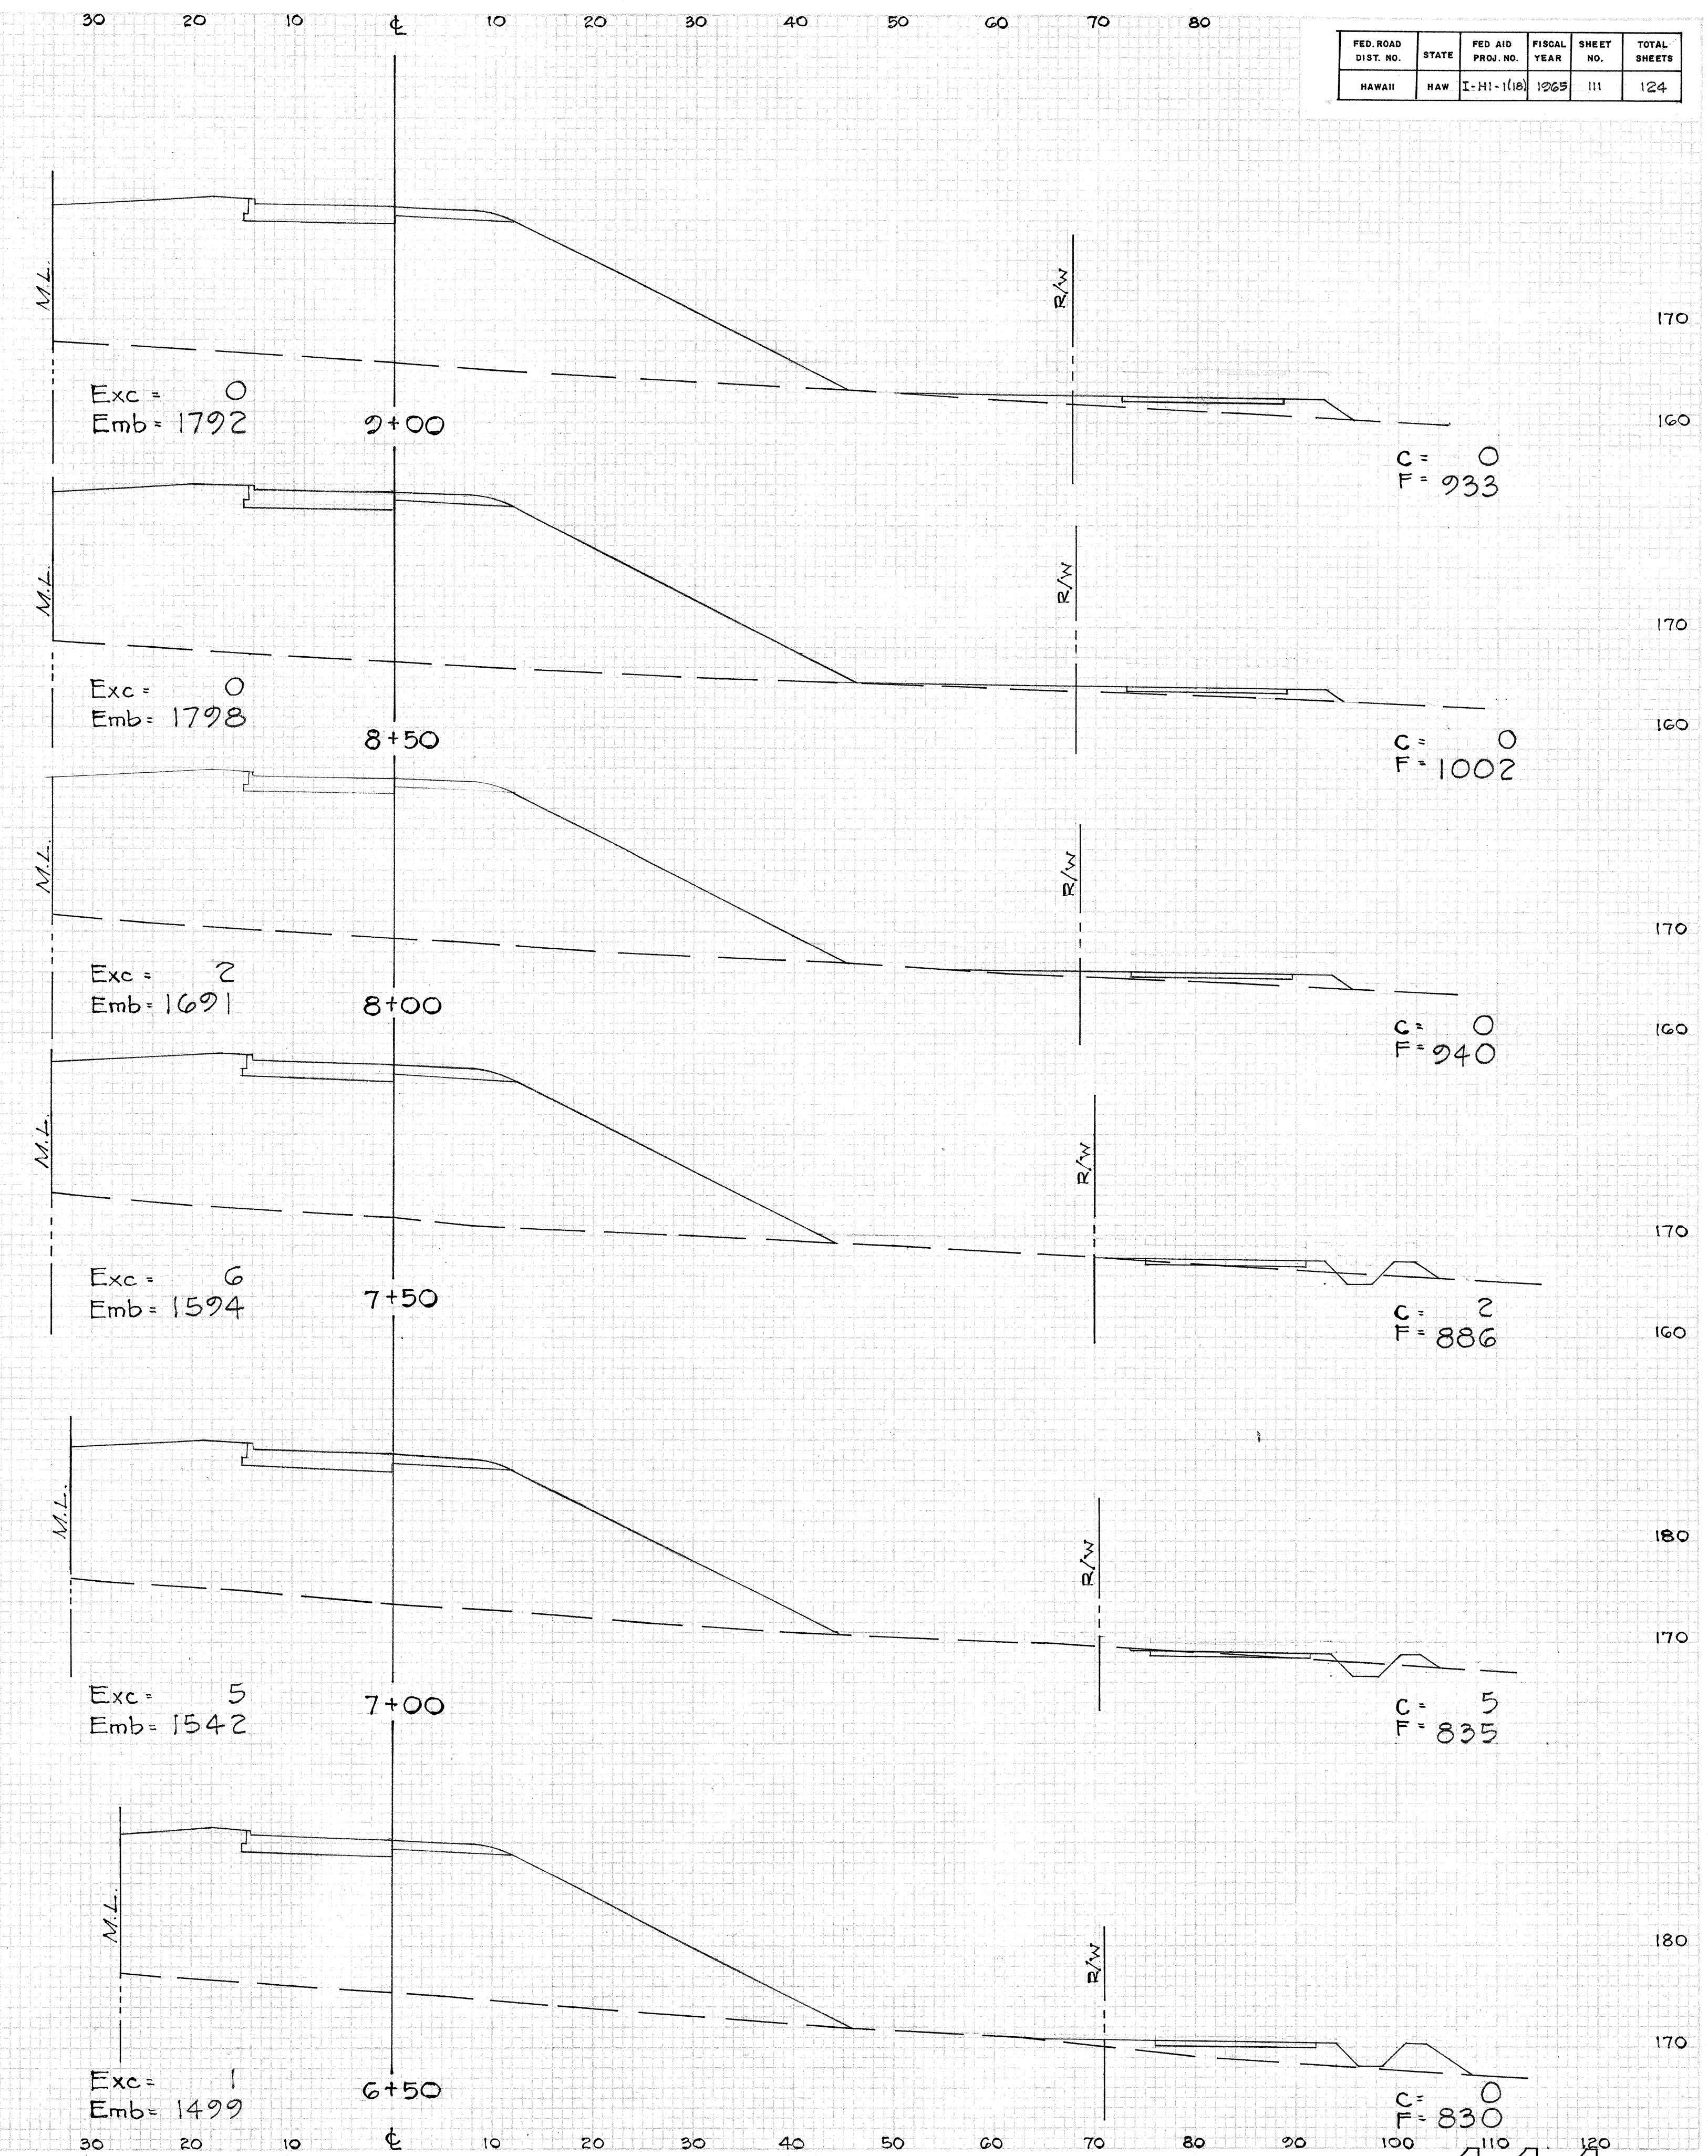


FED. ROAD DIST. NO.	STATE	FED. AID PROJ. NO.	FISCAL YEAR	SHEET NO.	TOTAL SHEETS
HAWAII	HAW	I-HI-118	1965	111	124

DATE
BY
SURVEY
NO. 10013

DATE
BY
SURVEY
NO. 10013

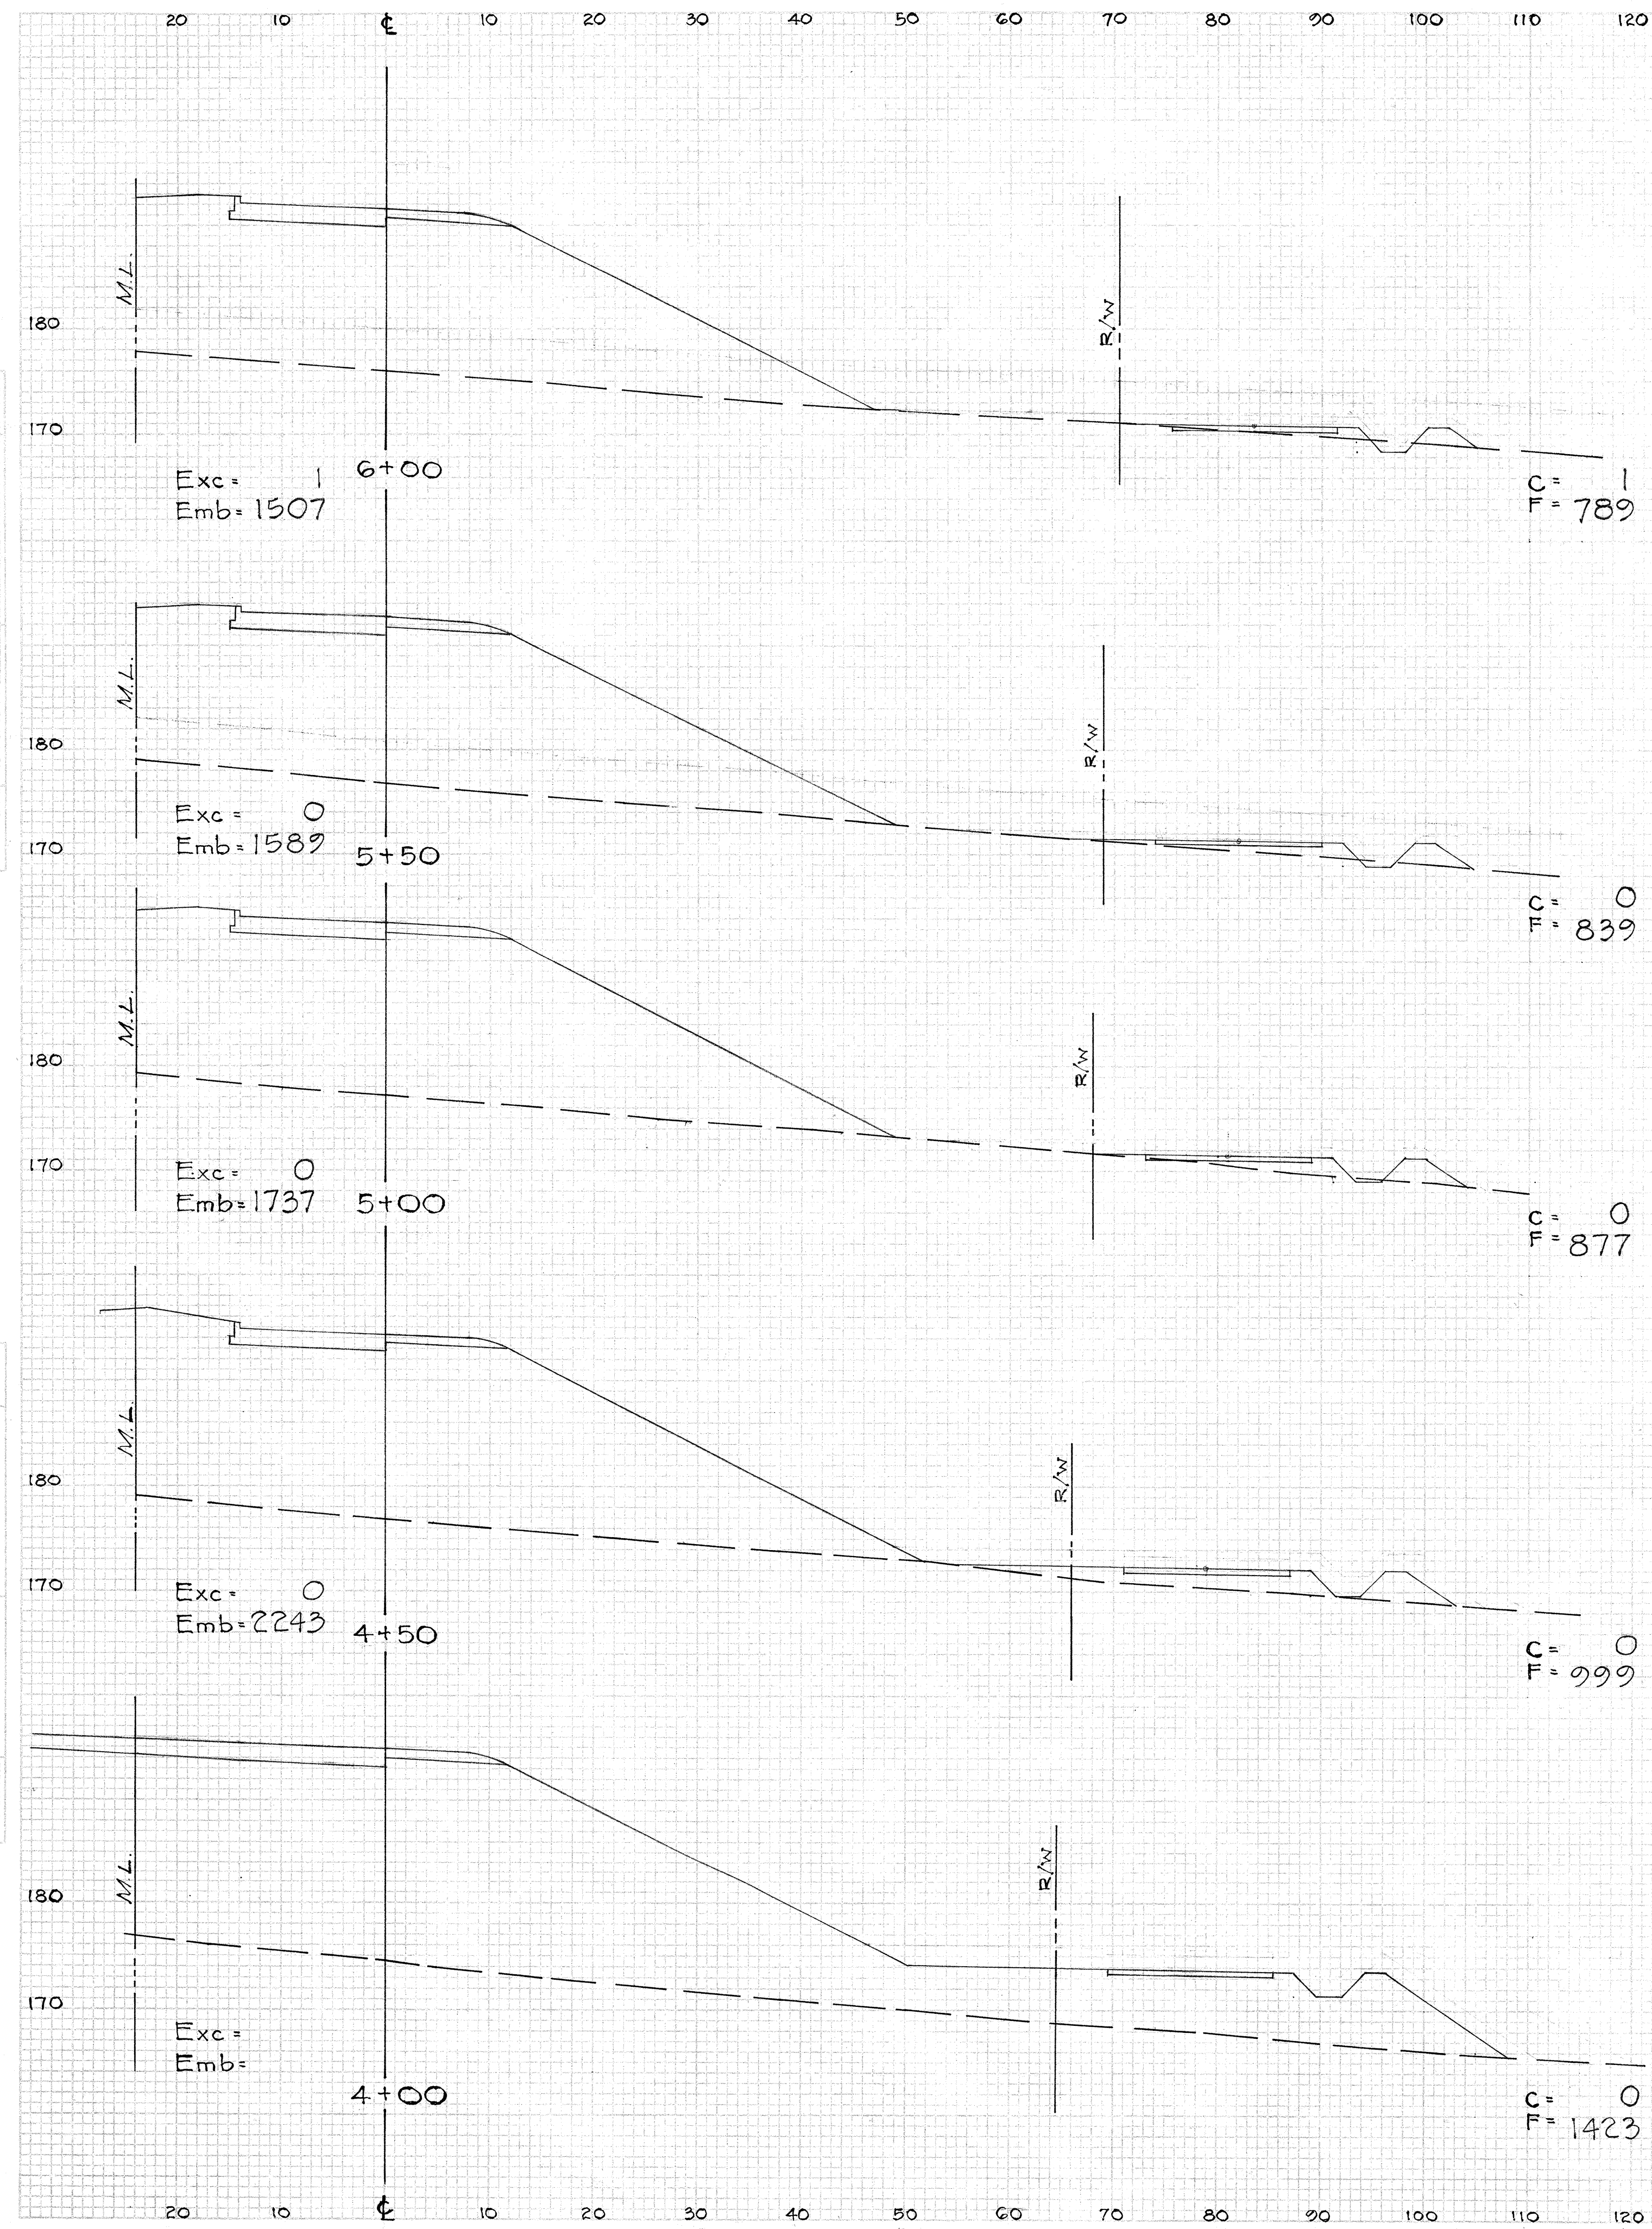


STATE 3 - CROSS SECTION P & S
CLEARPRINT PAPER ONLY - 11x17

RAMP KA

Sht 1 of 3 Shts.

111

FED. ROAD DIST. NO.	STATE	FED AID PROJ. NO.	FISCAL YEAR	SHEET NO.	TOTAL SHEETS
HAWAII	HAW	I-HI-1(18)	1968	112	124

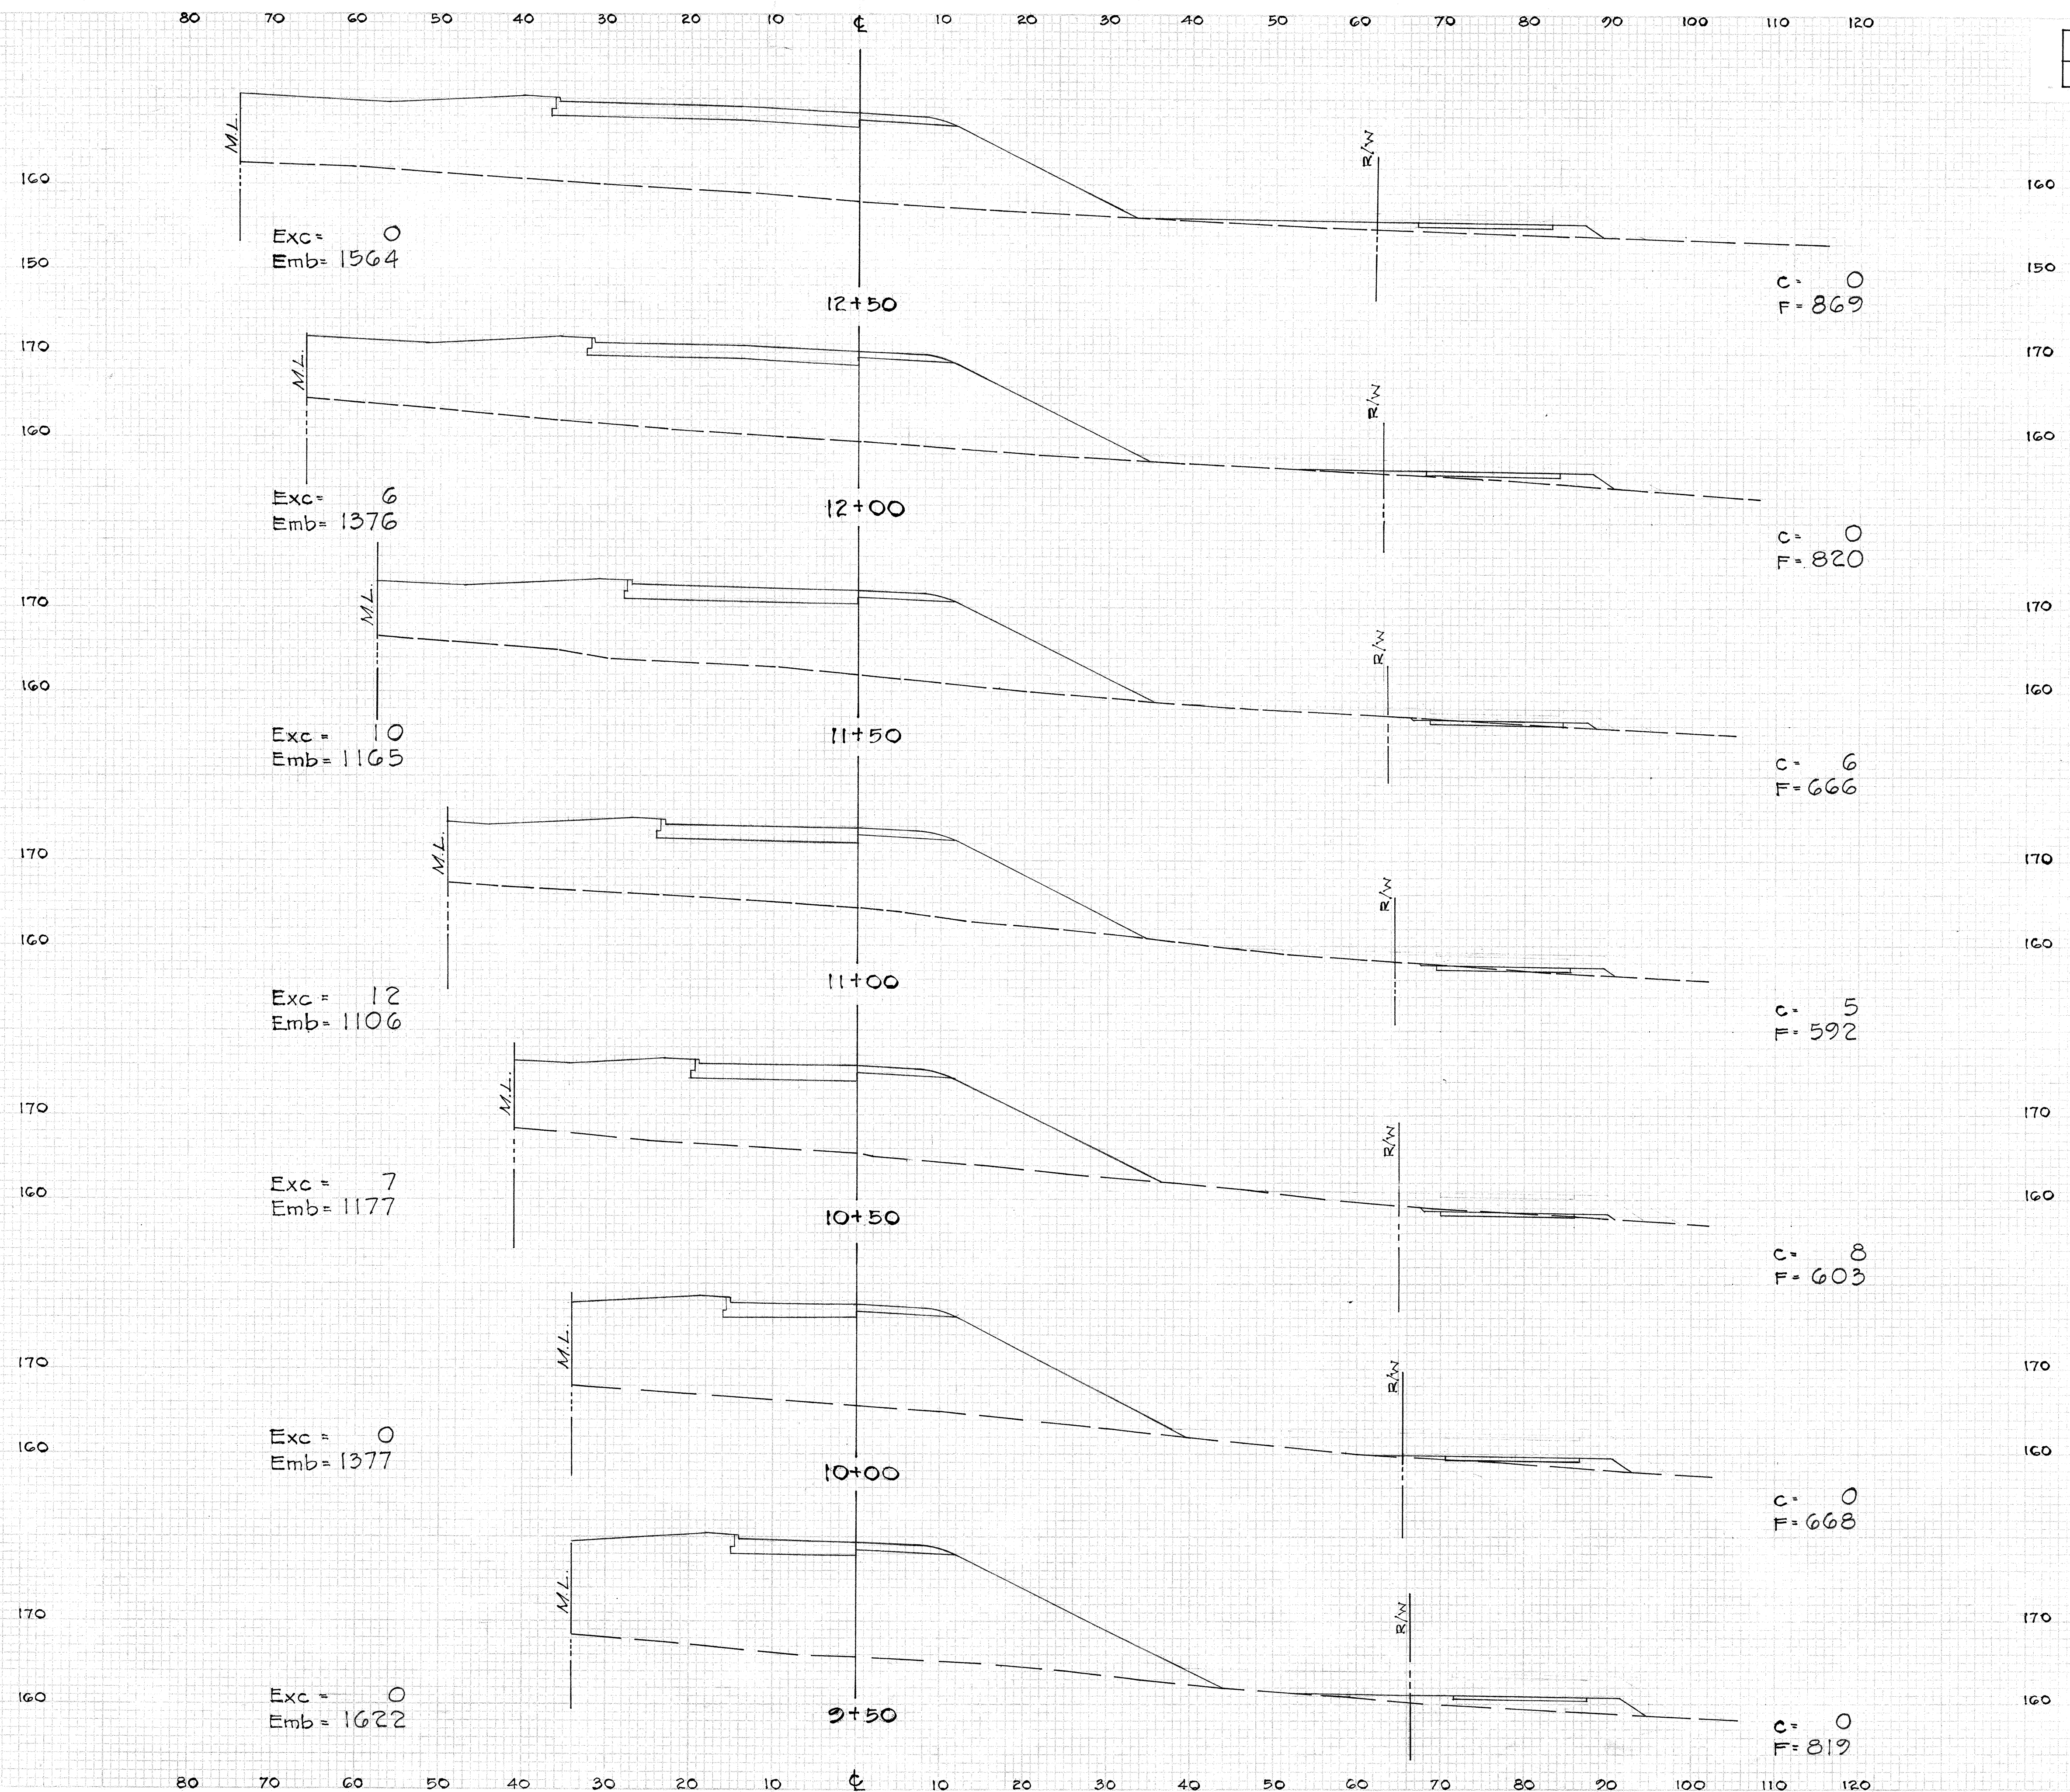

DATE	BY	DATE	BY

DATE	BY	DATE	BY

PLATE 3 - CROSS SECTION: 5-1/2" CLEARPRINT PAPER CO. 5-1/2" GAL. NO. 1008-3

RAMP KA

Sht 2 of 3 Shts.

112

FED. ROAD DIST. NO.	STATE	FED. AID PROJ. NO.	FISCAL YEAR	SHEET NO.	TOTAL SHEETS
HAWAII	HAW	I-H1-1(18)	1965	113	124

FINAL SURVEY	DATE	BY
SURVEYED		
PLOTTED		
NOTE BOOK		
NO.		

ORIGINAL SURVEY	DATE	BY
SURVEYED		
PLOTTED		
NOTE BOOK		
NO.		

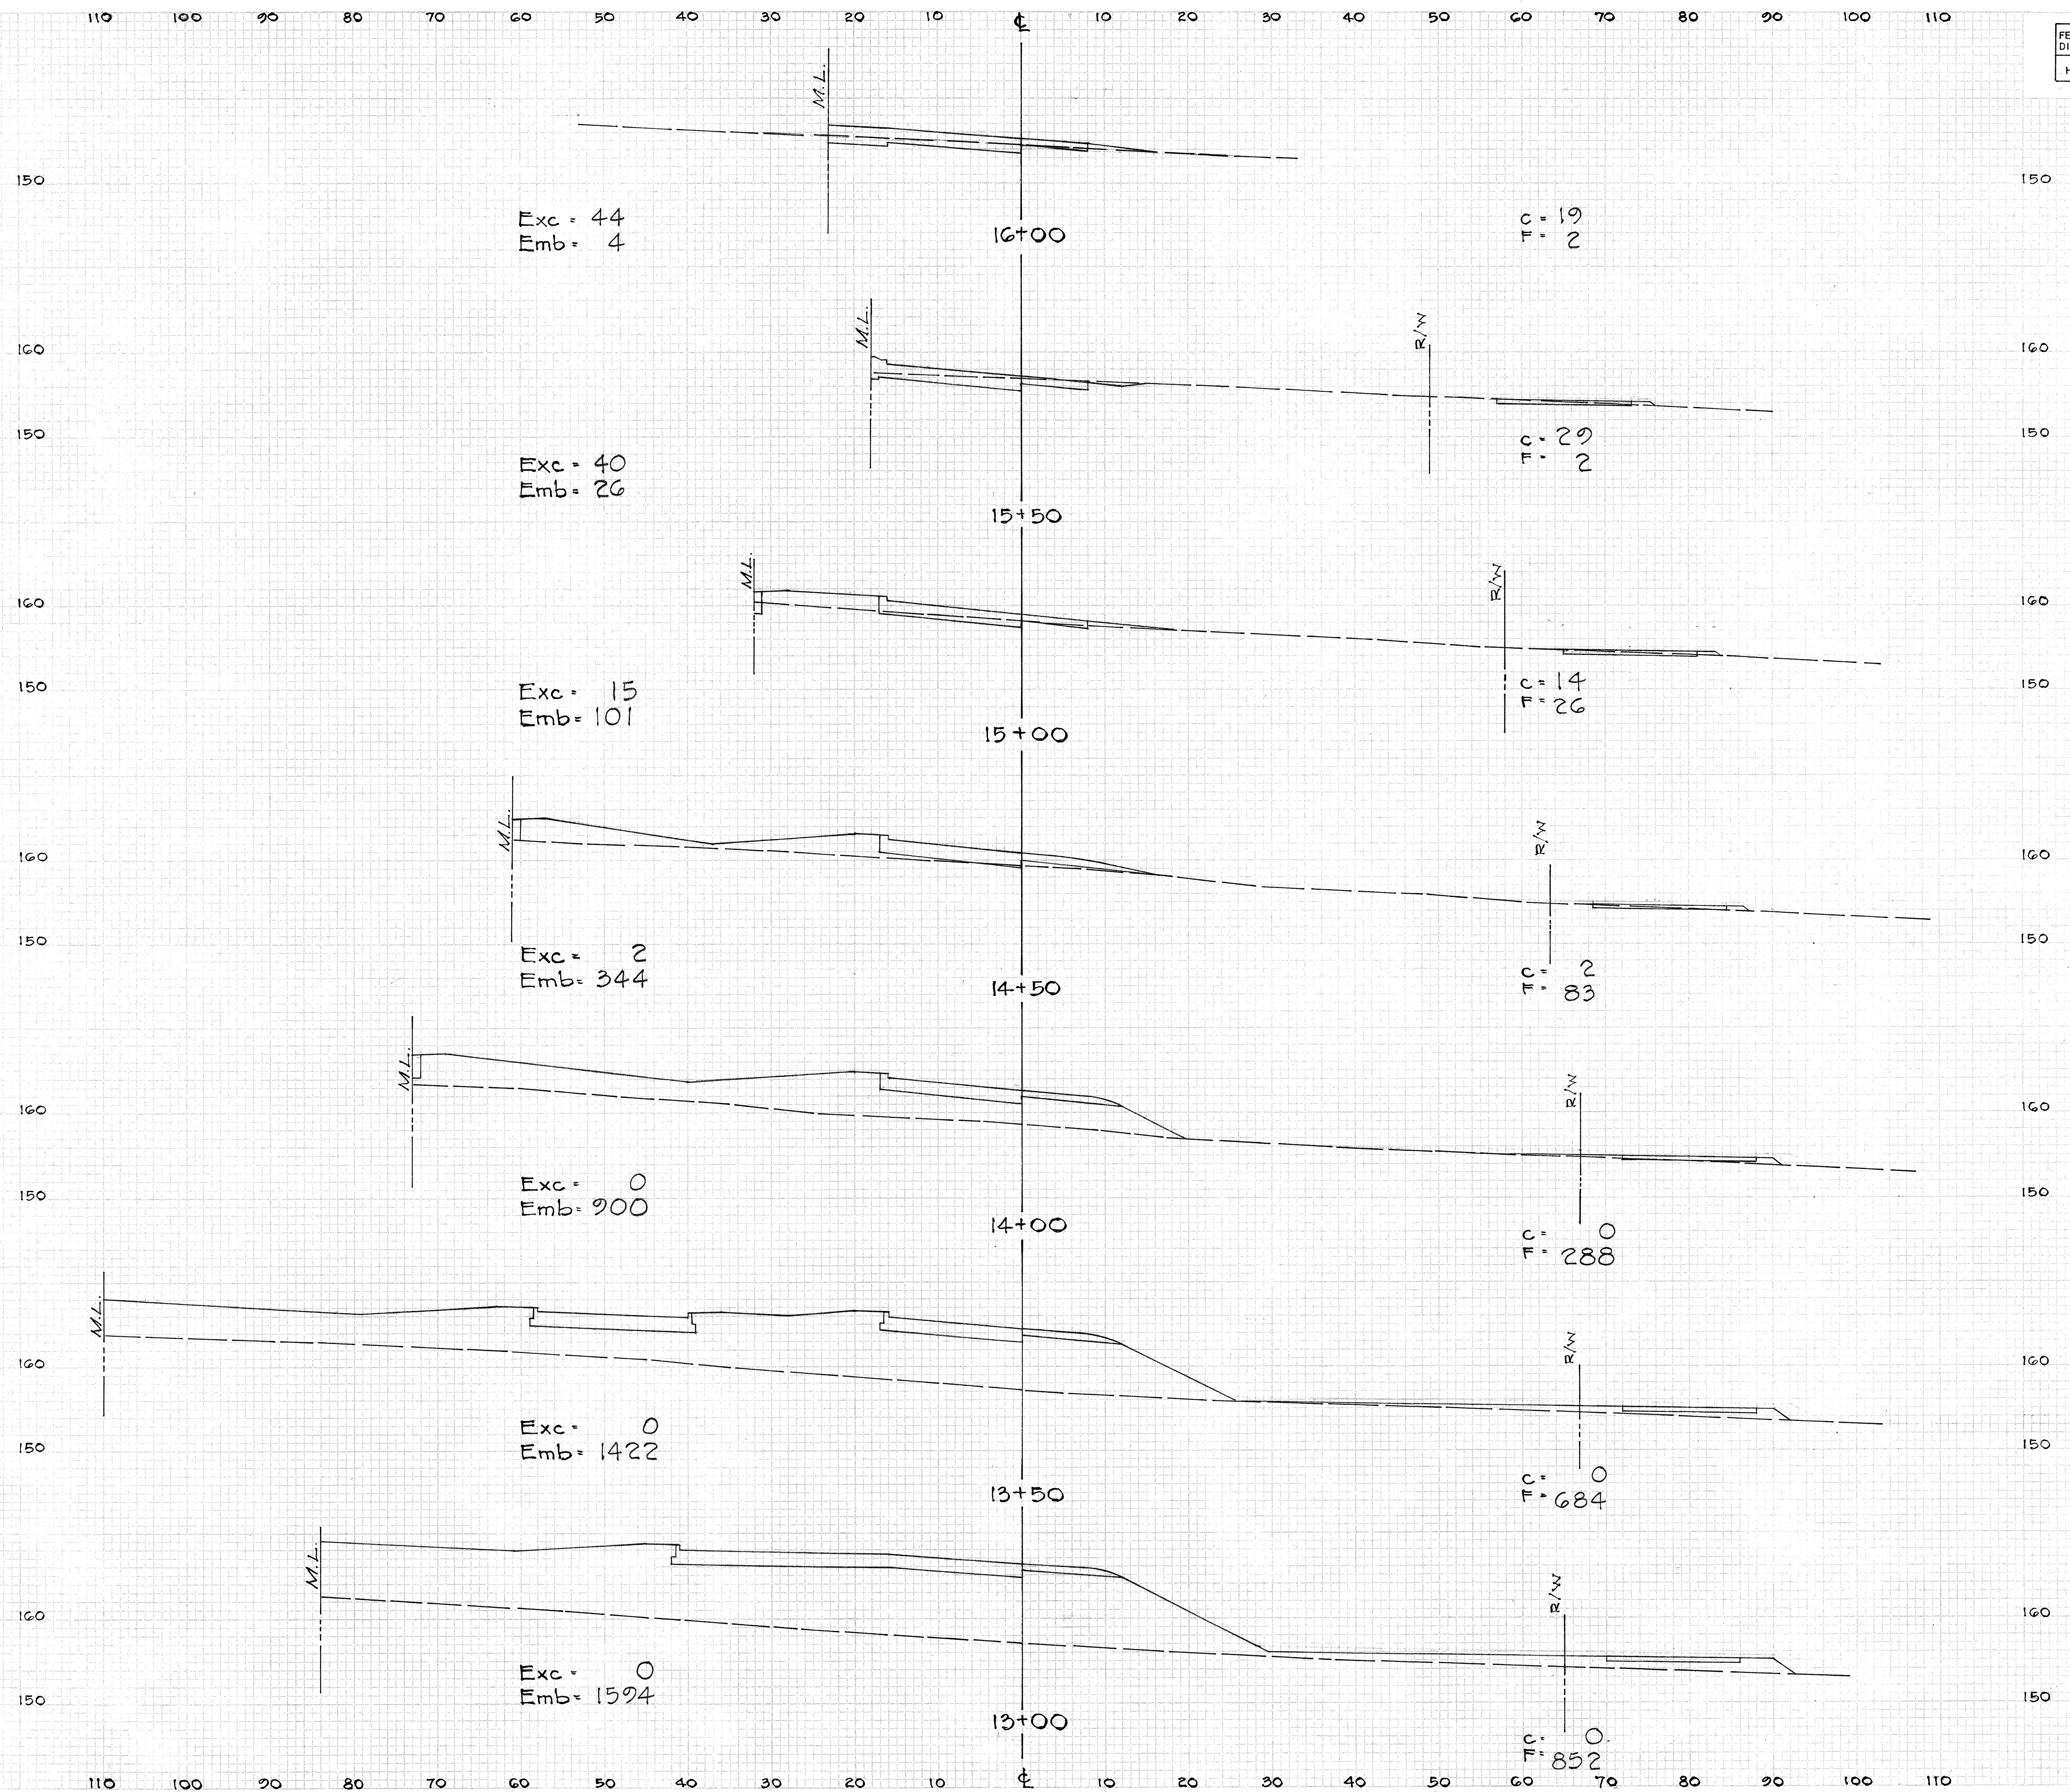


PLATE 3 - CROSS SECTION, F.A.S.
CLEAR-PRINT PAPER CO., S.F. CAL.
NO. 100H-3

RAMP KA

Sht. 3 of 3 Shts.

113