


Date: July 2, 1965

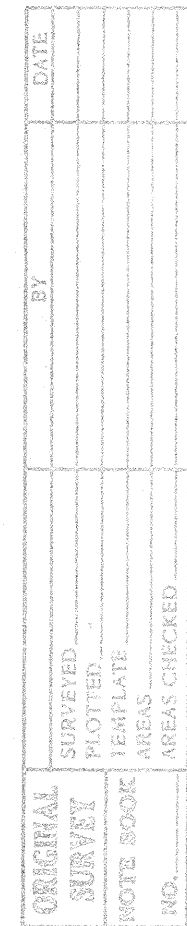


Sht 1 of 2 Shts.

Sht 1 of 2 Shts.

1 1 4 1

FED. ROAD DIST. NO.	STATE	FED. AID PROJ. NO.	FISCAL YEAR	SHEET NO.	TOTAL SHEETS
HAWAII	HAW	1-HI-115	1965	115 A	124

Date: July 2, 1965

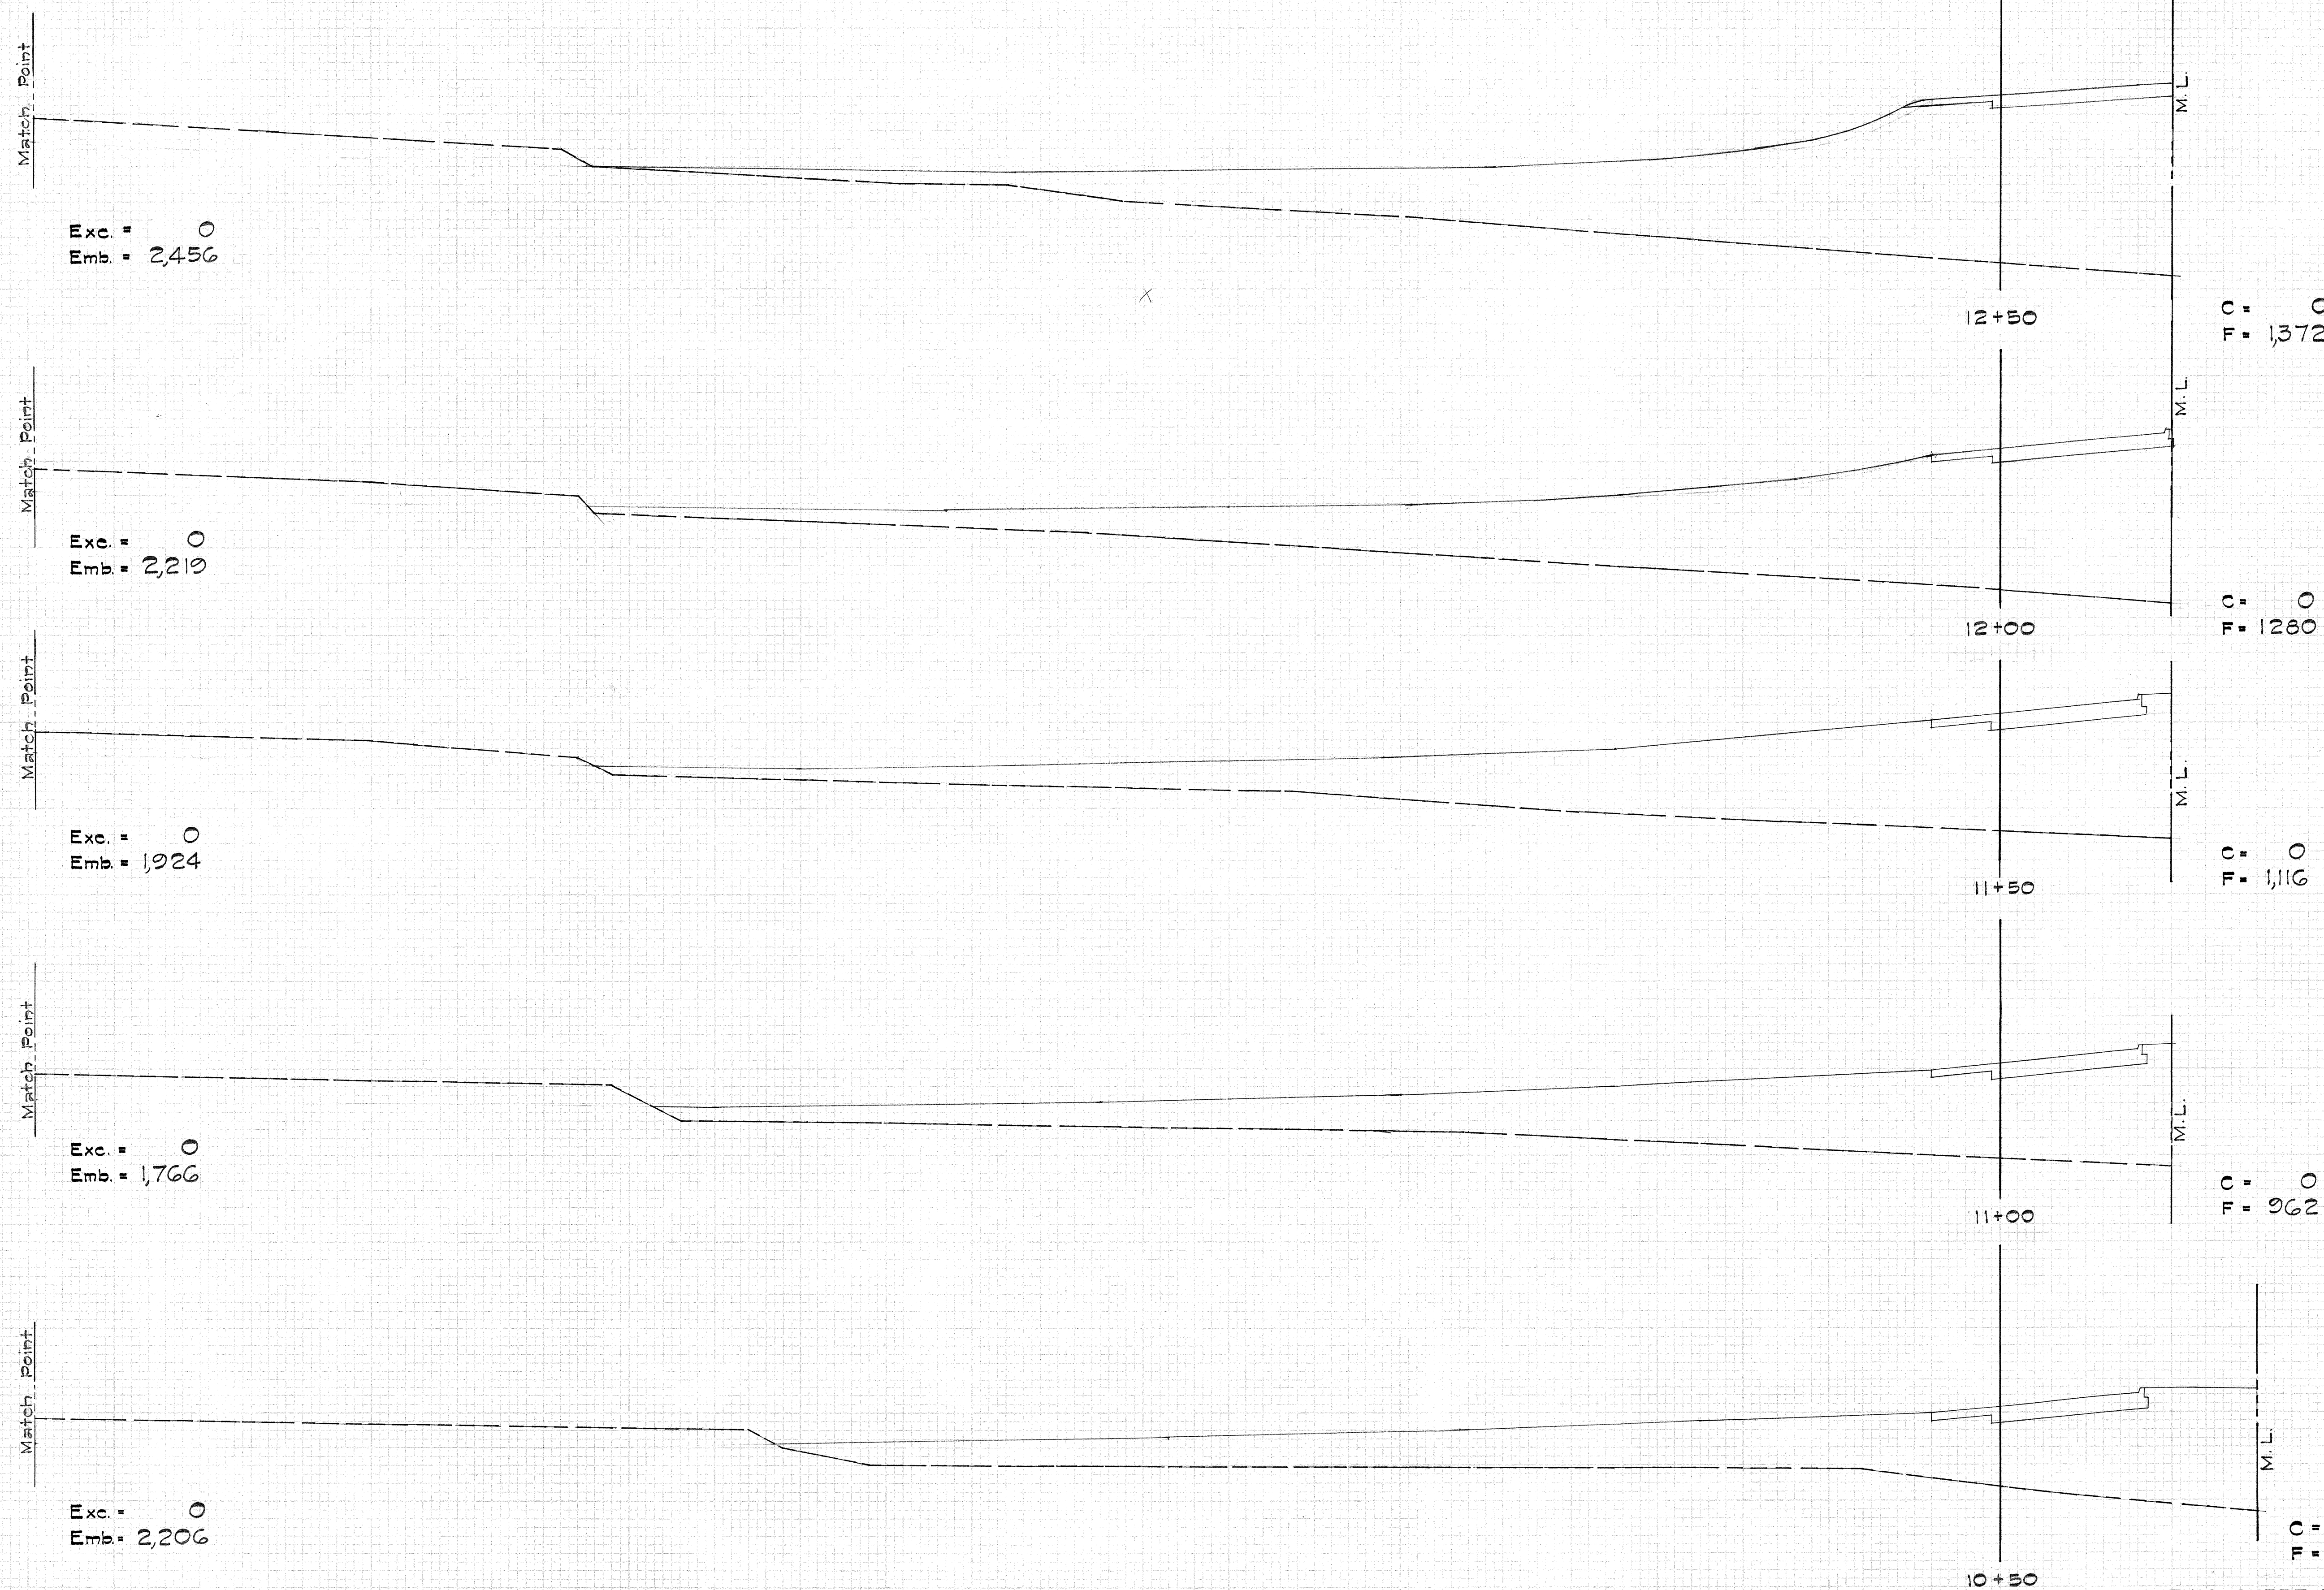

THIS SHEET REPLACES AND
SUPERSEDES SHEET NO. 115

PLATE 3 CROSS SECTION, F-1
CLEARPRINT PAPER ON 8-1/2" X 11" SHEET

~~SUPERSEDES SHEET NO. 115~~

RAMP KB

Sht 2 of 2 Shts.

115 A