


FED. ROAD DIST. NO.	STATE	FED. AID PROJ. NO.	FISCAL YEAR	SHEET NO.	TOTAL SHEETS
HAWAII	HAW	1-HI-116	1965	116A	124

Date: July 2, 1965

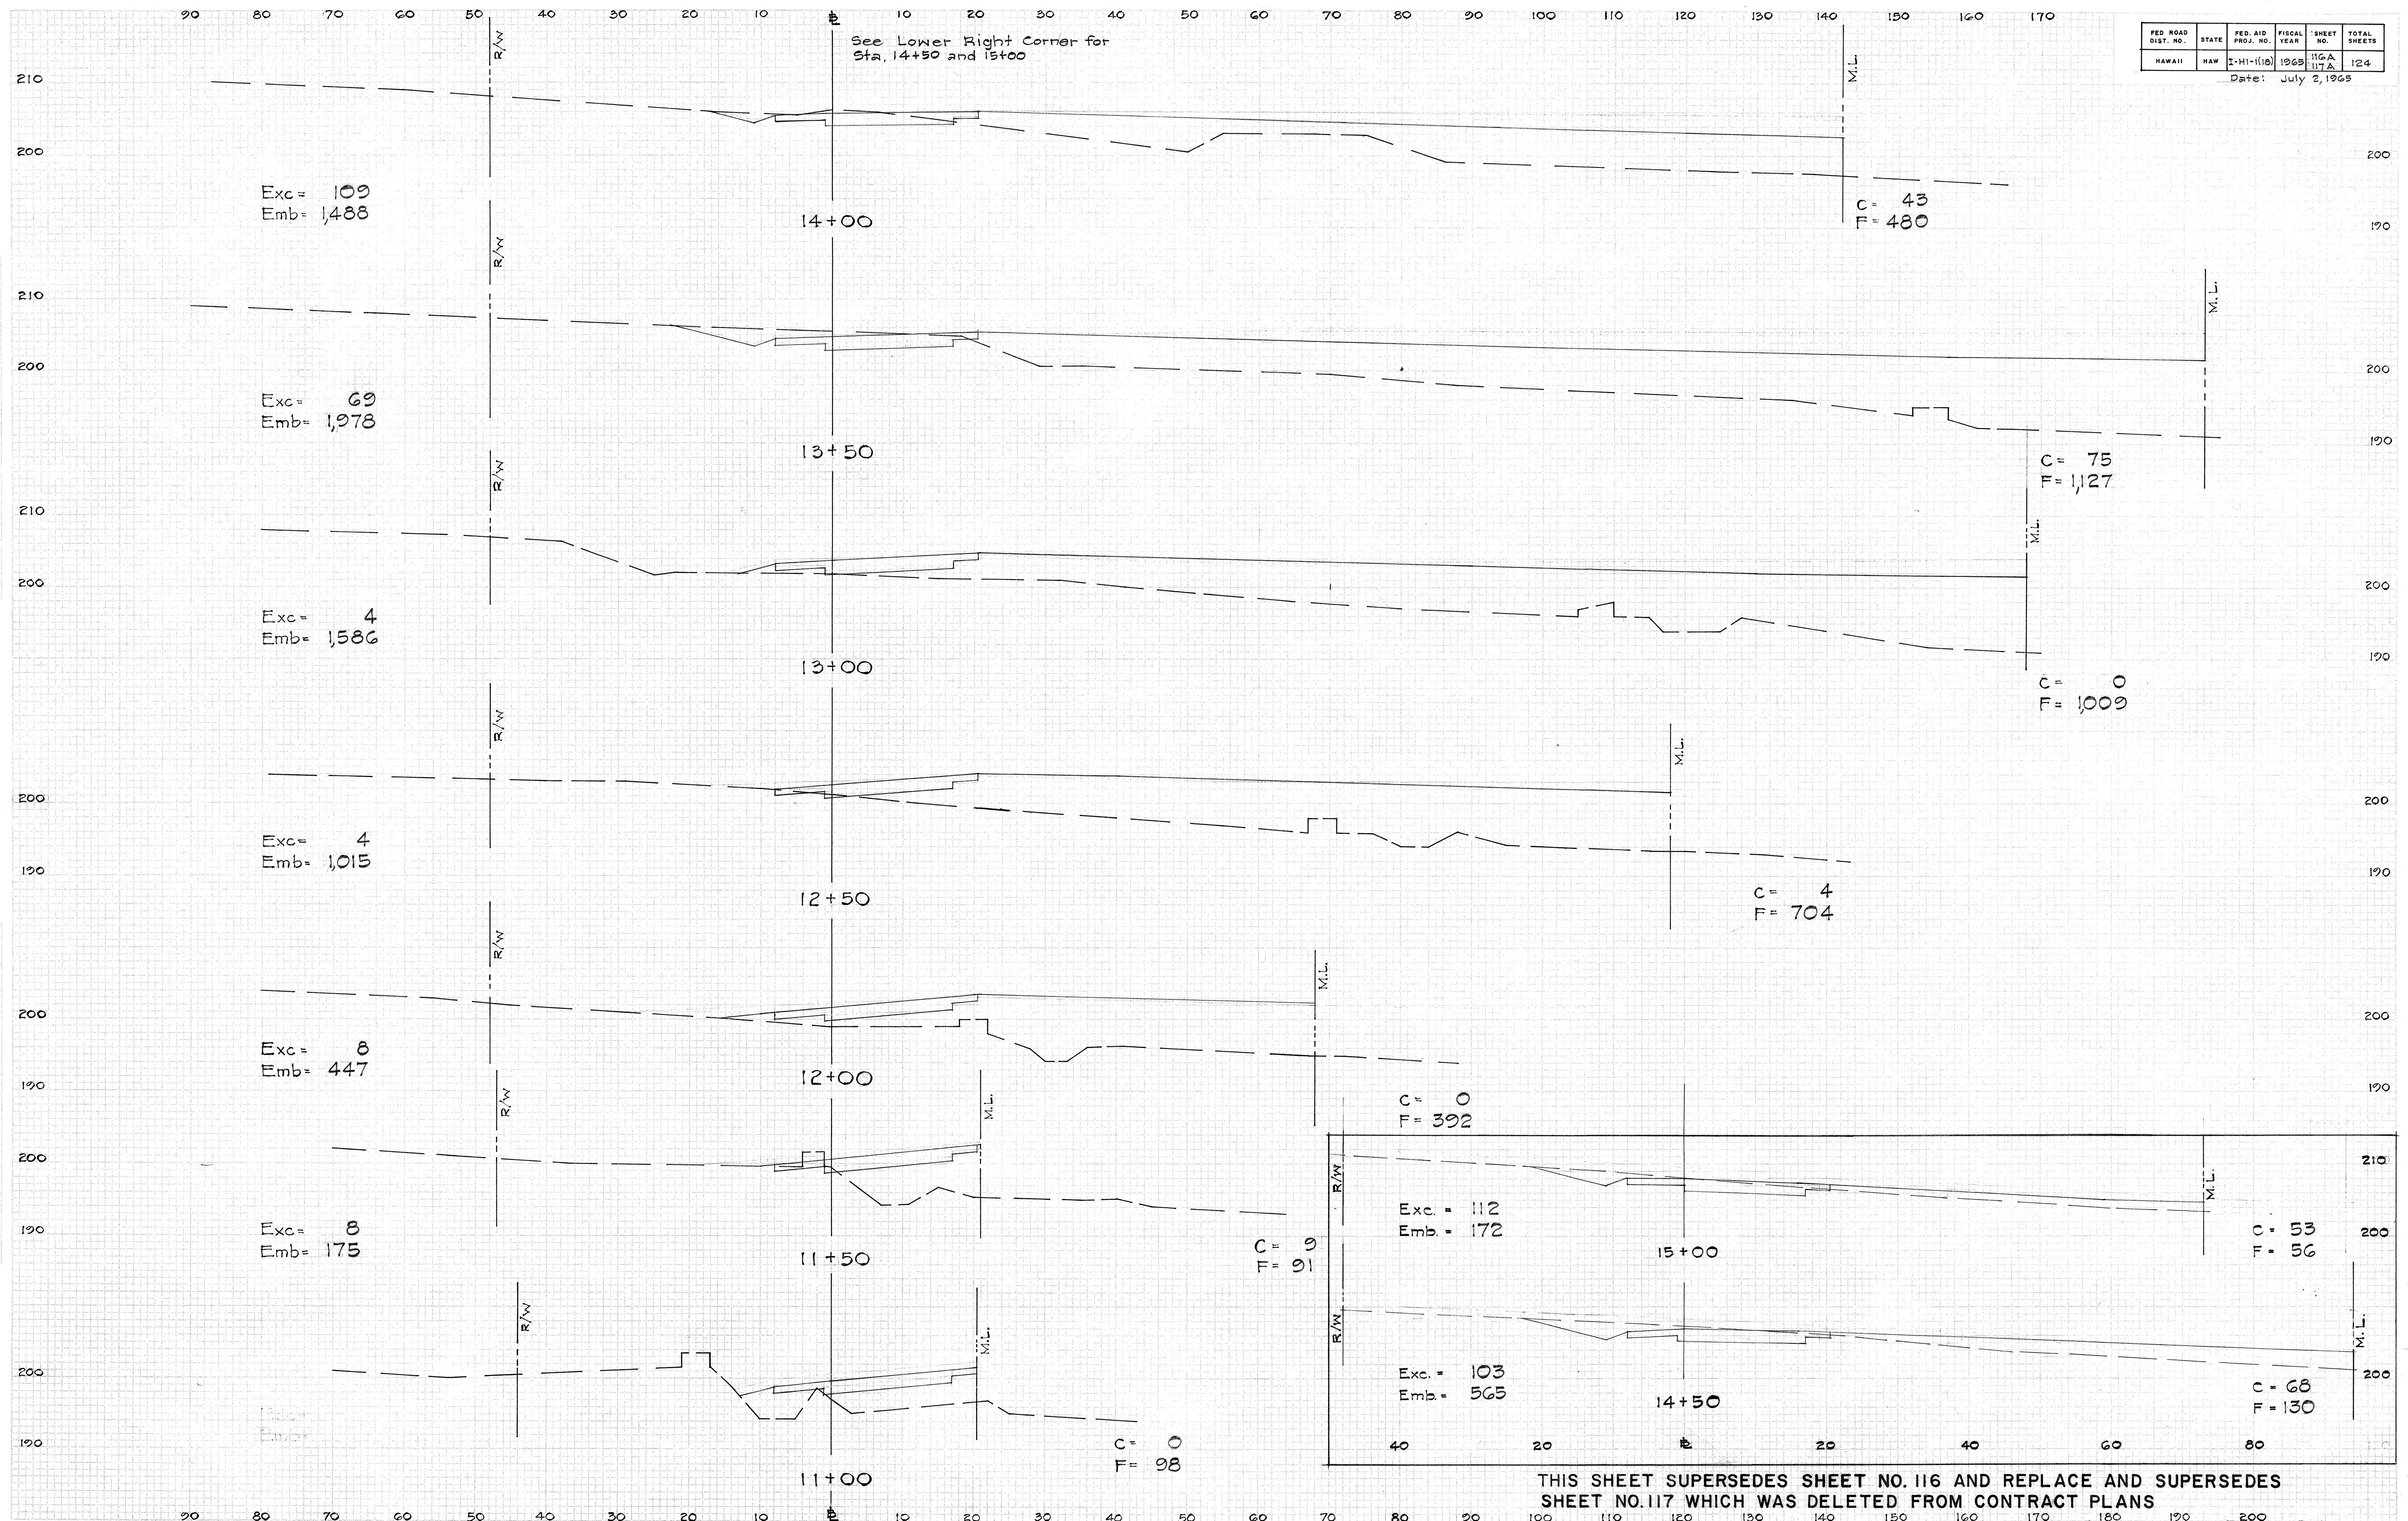

SUPERSEDES SHEETS No. 116 & 117

RAMP KC Sht. 1 of 1 Sht.

116A - 117A