

FINAL SURVEY	SURVEYED _____ PLOTTED _____	BY _____	DATE _____
NOTE BOOK NO. _____	TEMPLATE AREAS _____ AREAS CHECKED _____		

ORIGINAL SURVEY	SURVEYED	BY	DATE
NOTE BOOK	PLOTTED		
	TEMPLATE		
	AREAS		
	AREAS CHECKED		


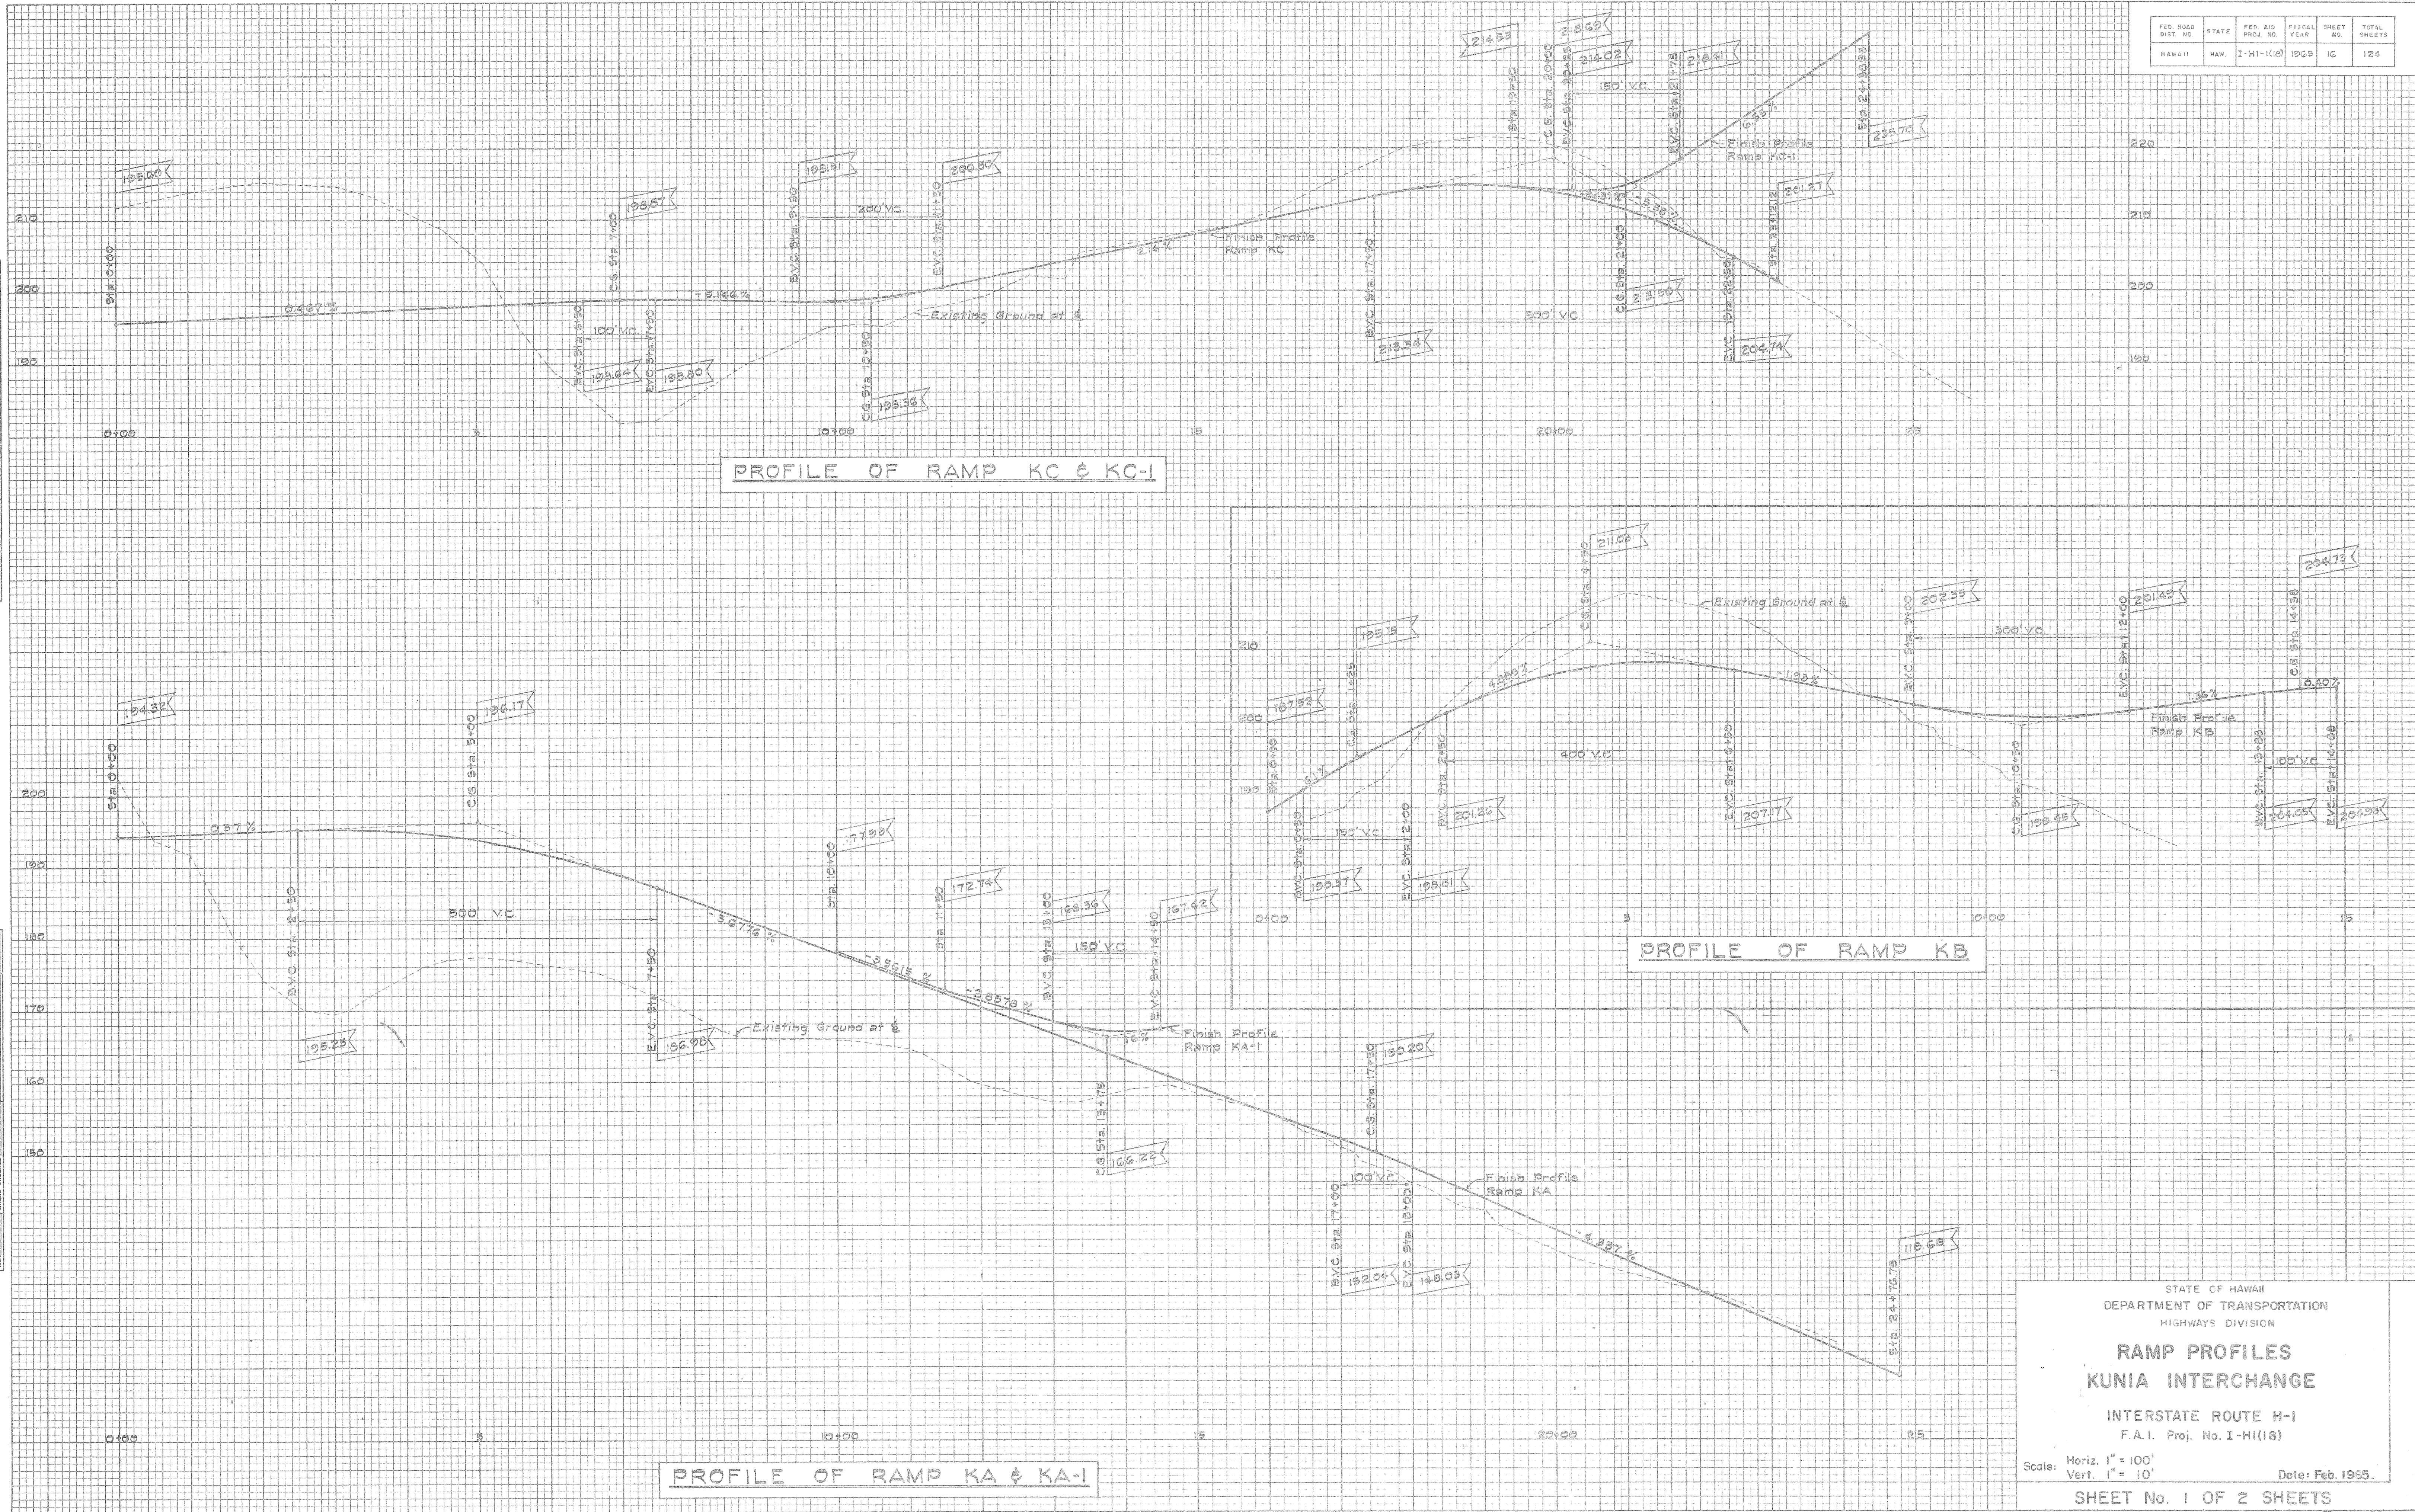


PLATE 2—CROSS SECTION O. P. R. & R. E. STANDARD
J. B. WEL CO., PHILADELPHIA.

FED. ROAD DIST. NO.	STATE	FED. AID PROJ. NO.	FISCAL YEAR	SHEET NO.	TOTAL SHEETS
HAWAII	HAW.	I-HI-1(18)	1965	17	124

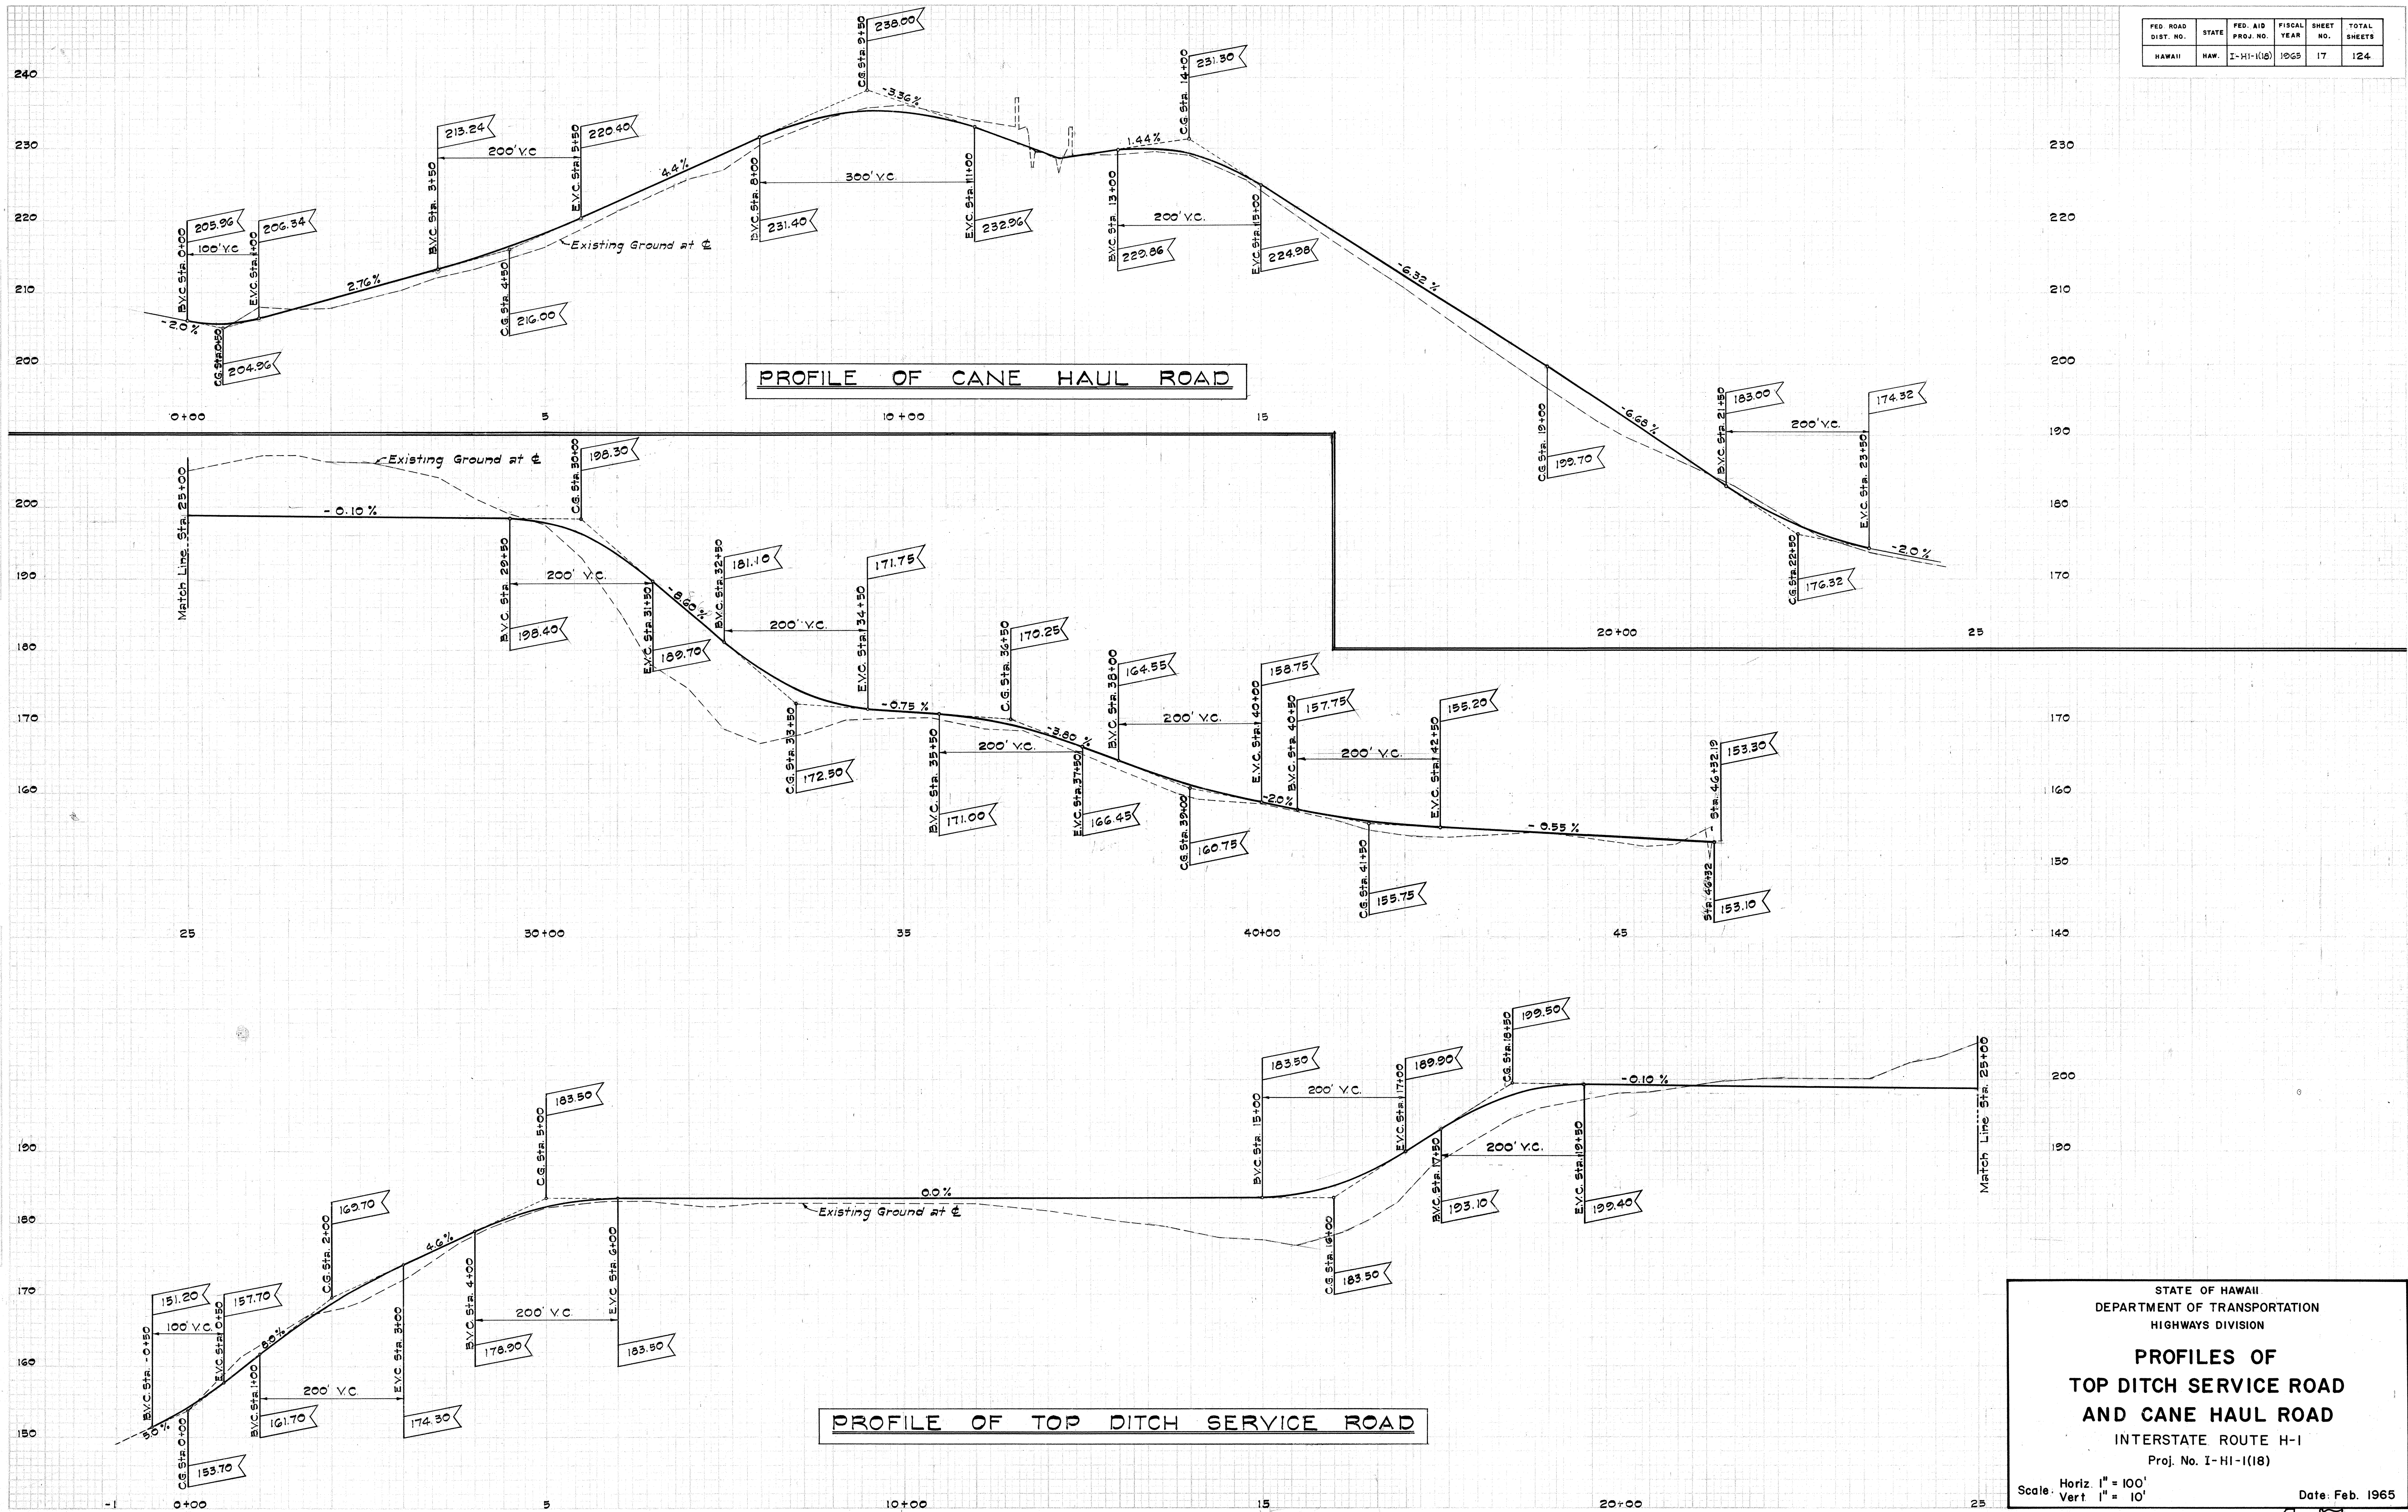

STATE OF HAWAII
DEPARTMENT OF TRANSPORTATION
HIGHWAYS DIVISION

**PROFILES OF
TOP DITCH SERVICE ROAD
AND CANE HAUL ROAD**

INTERSTATE ROUTE H-1
Proj. No. I-HI-1(18)

Scale: Horiz. 1" = 100'
Vert. 1" = 10'

Date: Feb. 1965