


INDEX TO DRAWINGS	
SHT. NO.	DESCRIPTION
1	TITLE SHEET
2 - 6	TYPICAL ROADWAY SECTIONS
7 - 12	PLAN AND PROFILE
13 - 15	DETAIL ROADWAY PLANS
16 - 17	RAMPS, SERVICE & HAUL RD. PROFILES
18	SUPER ELEVATION DIAGRAMS
19 - 24	MISCELLANEOUS ROADWAY DETAILS
25 - 30	UTILITY PLANS AND DETAILS
31 - 52	IRRIGATION PLANS AND DETAILS
(46 - 48)	IRRIGATION AND DRAINAGE PLANS (KUNIA INTERCHANGE)
53 - 62	DRAINAGE PLANS AND DETAILS
63 - 81	STRUCTURES AND DETAILS
(63 - 67)	PALEHUA SEPARATION
(68 - 76)	HONOULIULI STREAM BRIDGE
(77 - 81)	TYPICAL & STANDARD DETAILS
82 - 124	CROSS SECTIONS
(82 - 110)	INTERSTATE
(111 - 113)	RAMP KA
(114 - 115)	RAMP KB
(116 - 117)	RAMP KC
(118 - 119)	CANE HAUL ROAD
(120 - 124)	KUNIA INTERCHANGE
CO. 59(1)	UNDERDRAIN DETAILS
15(1)	GRADING PLAN

STATE OF HAWAII
DEPARTMENT OF TRANSPORTATION
HIGHWAYS DIVISION
HONOLULU, HAWAII
"AS BUILT"
PLANS FOR
CONSTRUCTION OF A PORTION OF
INTERSTATE ROUTE H-1
BARBERS POINT TO KUNIA ROAD
(PALEHUA ROAD TO KUNIA ROAD)
FEDERAL AID INTERSTATE PROJECT No. I-HI-1(18), UNIT 1
GRADING AND STRUCTURES

DISTRICT OF EWA
ISLAND OF OAHU

SCALES:

PLAN & PROFILE HOR. 1" = 100'
VER. 1" = 10'
DETAIL ROADWAY PLAN 1" = 50'
CROSS SECTION HOR. 1" = 10' 1" = 20'
VER. 1" = 10' 1" = 20'

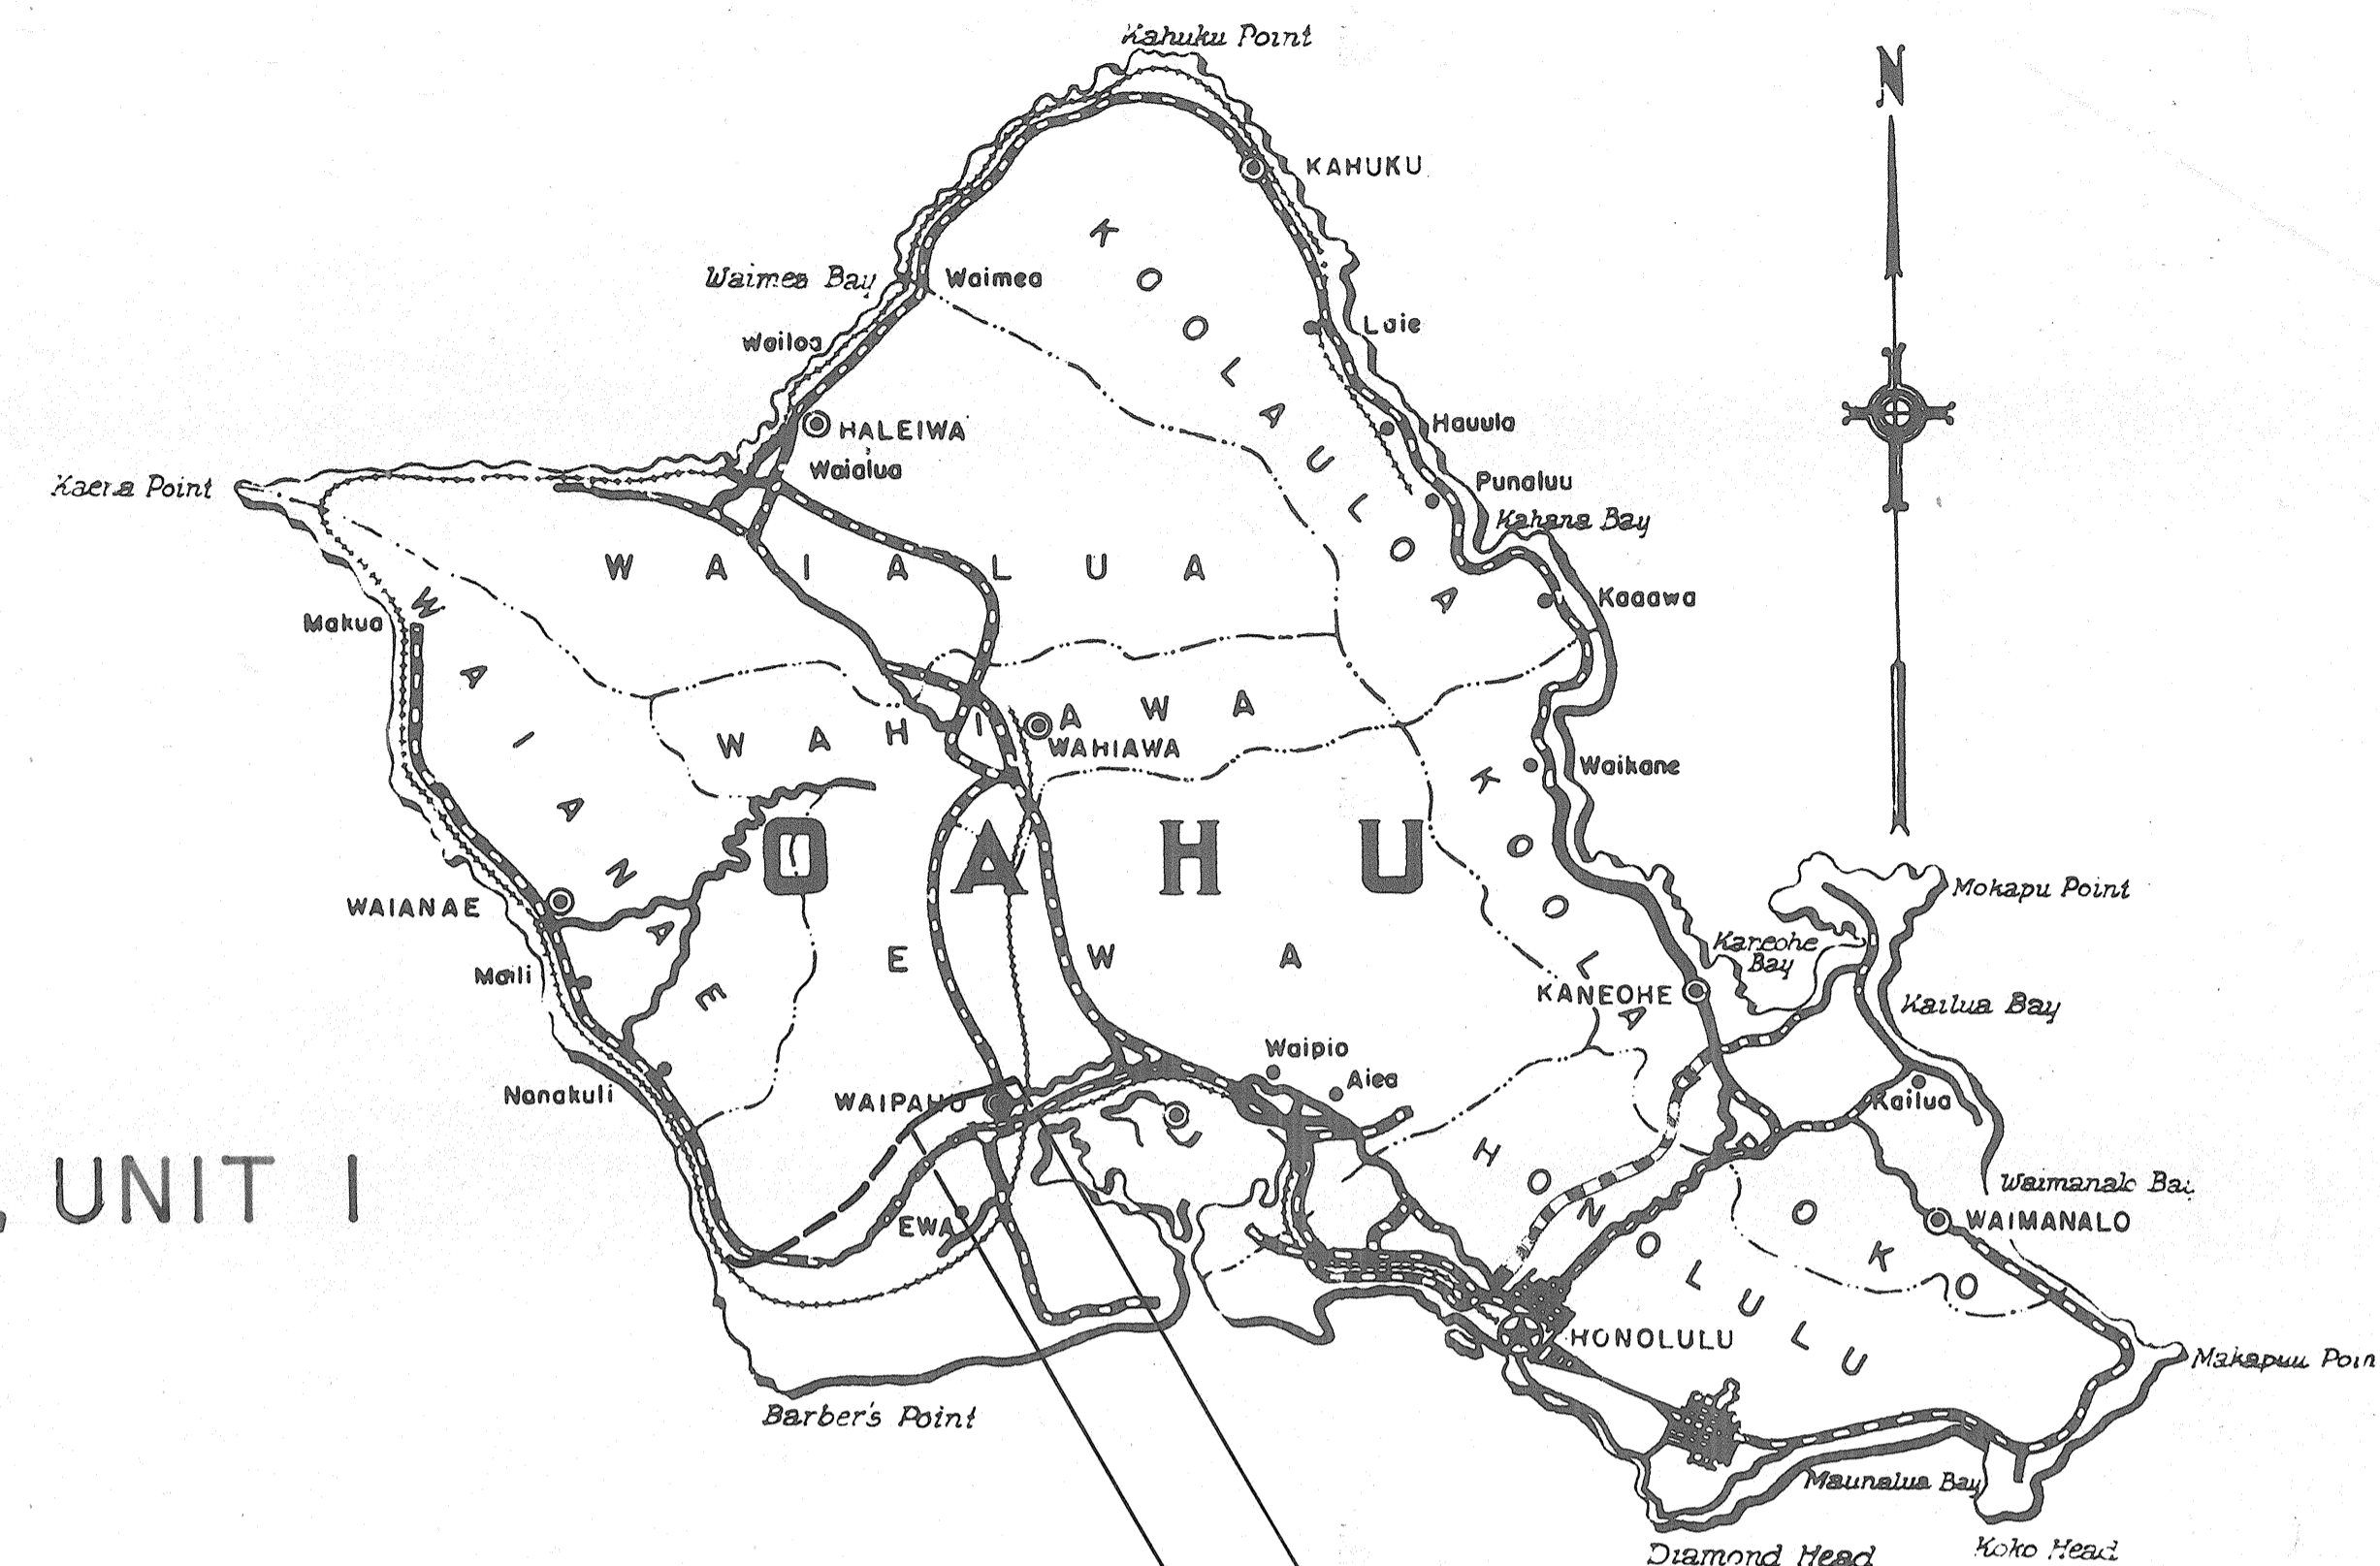

LOCATION OF PROJECT
I-HI-1 (18)

NOTE: Federal Aid Projects Previously Constructed Or Under Construction

ALL CHANGES MADE DURING CONSTRUCTION
HAVE BEEN NOTED IN RED ON THESE TRACINGS
AND CHECKED BY

Robert L. Latta
RESIDENT ENGINEER
FEB 14, 1967
DATE

DESIGN CLASSIFICATION


ADT (1965)..... 0
DESIGN ADT (1985)..... 32,400
DHV..... 11 %
D..... 60/40
T..... 8 %
V..... 70 M.P.H.

APPROVED: Date: 4. MAR. 65.

James H. Latta
DIRECTOR OF TRANSPORTATION

DEPARTMENT OF COMMERCE
BUREAU OF PUBLIC ROADS

APPROVED: *John B. Dalloway* APR 14 1965
DIVISION ENGINEER DATE

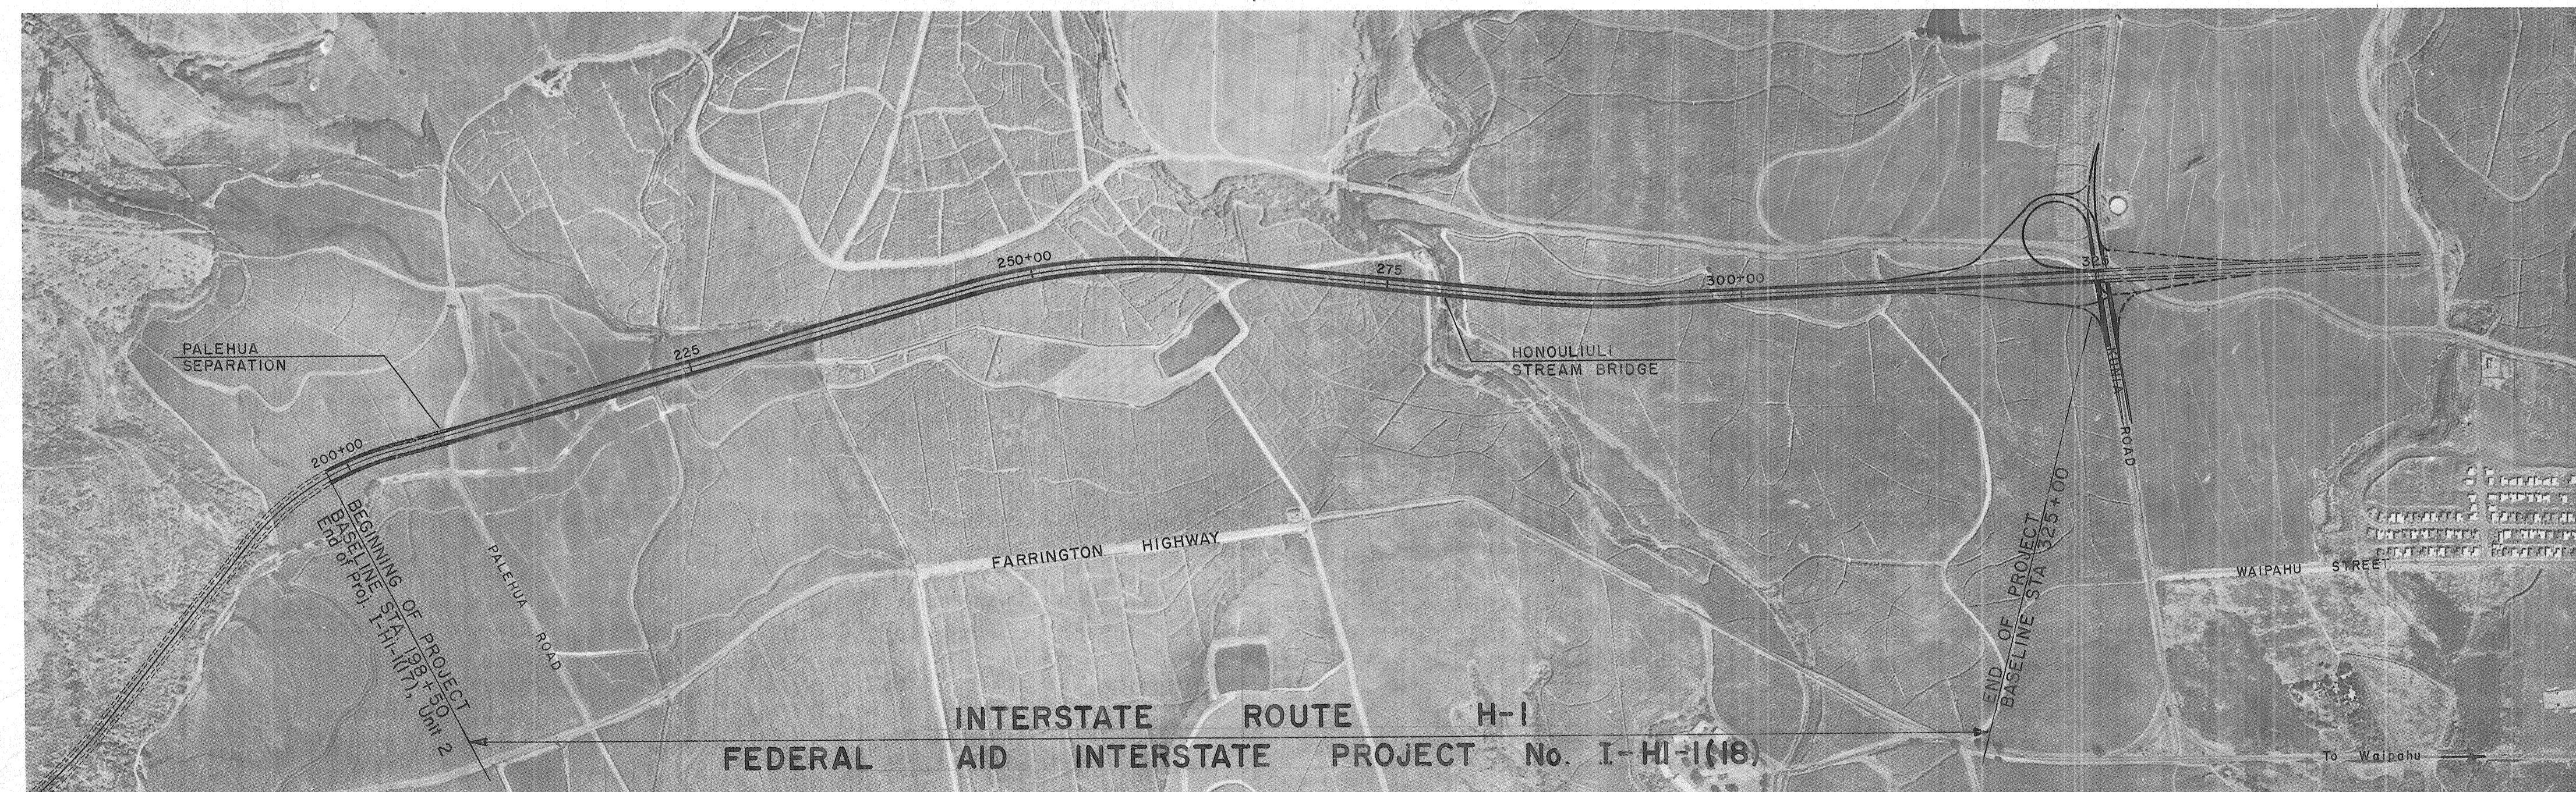

800 0 800 1600 2400
SCALE IN FEET

LAYOUT PLAN

GROSS LENGTH OF PROJECT..... 2.396 MI.
BRIDGES OVER 20.00' SPAN..... 0.038 MI.
NET LENGTH OF ROADWAY..... 2.358 MI.

800 0 800 1600 2400
SCALE IN FEET

DATE: _____
DESIGNED BY: _____
DRAWN BY: _____
CHECKED BY: _____
NOTE BOOK No. _____