

KUNIA STA. 97+65 to 99+60 RIGHT
Construct: Conc. Ditch. For Typical Section see sht. no. 41. For Profile see sht. no. 40.
FINAL
ESTIMATED QUANTITIES
Class "B-1" Conc. 29.8 200 C.Y.
Reinf. Steel 352 440 lbs.
Struct. Exc. 106.6 90 C.Y.
Ditch & Channel Exc. 0 5 C.Y.
CRM. 2.6 25 C.Y.

KUNIA STA. 99+63 RIGHT
Construct: Type "A" C.D.I., For 42" Pipe Culvert Outlet Detail, see sht. no. 41.
Install: 42" Cl. III RCCP or 42" CGMP, 12 Gage
FINAL
ESTIMATED QUANTITIES
Class "B-1" Conc. 3.3 35 C.Y.
Struct. Exc. 106.6 66 C.Y.
42" Pipe Culvert 94 L.F.
U.B. for Pipe Foundation 3 C.Y.

RAMP KC-1 STA. 20+40
Construct: Type "B" C.D.I.
Install: 24" Cl. III RCCP or 24" CGMP, 14 Gage
FINAL
ESTIMATED QUANTITIES
Class "B-1" Conc. 1.7 C.Y.
Struct. Exc. 126.7 450 C.Y.
24" Pipe Culvert 140 L.F.
U.B. for Pipe Foundation 10.8 C.Y.

RAMP KC STA. 21+55
Construct: Type "A" C.D.I.
Install: 24" Cl. III RCCP or 24" CGMP, 14 Gage
FINAL
ESTIMATED QUANTITIES
Class "B-1" Conc. 3.1 29 C.Y.
Struct. Exc. 52.9 80 C.Y.
24" Pipe Culvert 36 80 L.F.

RAMP KB STA. 2+83
Construct: Type "A" C.D.I., Std. Conc. Headwall
Install: 24" Cl. III RCCP or 24" CGMP, 14 Gage
FINAL
ESTIMATED QUANTITIES
Class "B-1" Conc. 3.7 33 C.Y.
Reinf. Steel 42 lbs.
Struct. Exc. 24.5 32 C.Y.
24" Pipe Culvert 39.5 42 L.F.

KUNIA STA. 105+73 RIGHT
Construct: Type "A" C.D.I.
Install: 24" Cl. III RCCP or 24" CGMP, 14 Gage
FINAL
ESTIMATED QUANTITIES
Class "B-1" Conc. 1.9 20 C.Y.
Struct. Exc. 40.8 42 C.Y.
24" Pipe Culvert 33 36 L.F.

KUNIA STA. 97+65 to 100+23 LEFT
Construct: Conc. Ditch. For Typical Section see sht. no. 41. For Profile see sht. no. 40.
FINAL
ESTIMATED QUANTITIES
Class "B-1" Conc. 48.7 452 C.Y.
Reinf. Steel 2877 2600 lbs.
Struct. Exc. 173.3 175 C.Y.
Ditch & Channel Exc. 0 5 C.Y.
CRM 3.7 25 C.Y.

KUNIA STA. 100+23 to 103+36 LEFT
Construct: Conc. Ditch. For Typical Section see sht. no. 41. For Profile see sht. no. 40.
FINAL
ESTIMATED QUANTITIES
Class "B-1" Conc. 80.1 766 C.Y.
Reinf. Steel 3834 5400 lbs.
Struct. Exc. 228.3 250 C.Y.

KUNIA STA. 103+36 LEFT
Construct: Type "A" C.D.I., Std. Conc. Headwall
Install: 54" Cl. III RCCP or 54" CGMP, 10 Gage
1 ea. Grating (For Detail see sht. no. 42)
FINAL
ESTIMATED QUANTITIES
Class "B-1" Conc. 5.7 65 C.Y.
Reinf. Steel 226 205 lbs.
Struct. Exc. 61.5 80 C.Y.
54" Pipe Culvert 38.6 32 L.F.
Grating for Type "A" C.D.I. 1 Ea.

KUNIA STA. 103+71 to 104+67 LEFT
Construct: Conc. Ditch. For Typical Section see sht. no. 41. For Profile see sht. no. 40.
FINAL
ESTIMATED QUANTITIES
Class "B-1" Conc. 28.8 262 C.Y.
Reinf. Steel 1832 4820 lbs.
Struct. Exc. 67.1 65 C.Y.

KUNIA STA. 104+67 LEFT
Construct: Type "A" C.D.I.
Install: 54" Cl. III RCCP or 54" CGMP, 10 Gage
1 ea. Grating (For Detail see sht. no. 42)
FINAL
ESTIMATED QUANTITIES
Class "B-1" Conc. 4.7 54 C.Y.
Reinf. Steel 187 260 lbs.
Struct. Exc. 142.7 220 C.Y.
54" Pipe Culvert 114.5 112 L.F.
Grating for Type "A" C.D.I. 1 Ea.

KUNIA STA. 105+85 LEFT
Construct: Modified Type "C" SDMH.
For Detail see sht. no. 42.
Install: 54" Cl. III RCCP or 54" CGMP, 10 Gage
FINAL
ESTIMATED QUANTITIES
Class "A-1" Conc. 4.8 50 C.Y.
Reinf. Steel 130 132 lbs.
Struct. Exc. 367.1 430 C.Y.
54" Pipe Culvert 241.3 242 L.F.
Type "A" C.I. Frame & Cover 1 Ea.

RAMP KD STA. 1+27 LEFT
Construct: Type "B" C.D.I.
Install: 24" Cl. III RCCP or 24" CGMP, 14 Gage
FINAL
ESTIMATED QUANTITIES
Class "B-1" Conc. 2.3 24 C.Y.
Struct. Exc. 36.3 54 C.Y.
24" Pipe Culvert 47.3 46 L.F.

RAMP KD STA. 1+27 RIGHT
Construct: Type "B" C.D.I.
Install: 24" Cl. III RCCP or 24" CGMP, 14 Gage
FINAL
ESTIMATED QUANTITIES
Class "B-1" Conc. 2.1 C.Y.
Struct. Exc. 43.4 55 C.Y.
24" Pipe Culvert 57.8 60 L.F.


KUNIA STA. 102+92 RIGHT
Adjust 1 each M.H. Frame & Cover
FINAL
ESTIMATED QUANTITIES
Brickwall for Reconstructed M.H. 2.33 L.F.
Adjust M.H. Frame & Cover 1 Ea.

KUNIA STA. 106+00 RIGHT
Adjust 1 each M.H. Frame & Cover
Connection to exist. SDMH (incidental to Rdway. Exo.)
FINAL
ESTIMATED QUANTITIES
Brickwall for Reconstructed M.H. 2.35 L.F.
Adjust M.H. Frame & Cover 1 Ea.

CURVE DATA

Δ = 48° 30' 00"
44 = 24' 15' 00"
R = 250.62'
T = 112.00'
Ch = 205.36'
Lc = 211.62'

DATE	10/1/65
DESIGNED BY	W. H. HARRIS
CHECKED BY	W. H. HARRIS
NOTED BY	W. H. HARRIS
QUANTITIES BY	W. H. HARRIS
PLACED BY	W. H. HARRIS
ORIGINAL	W. H. HARRIS

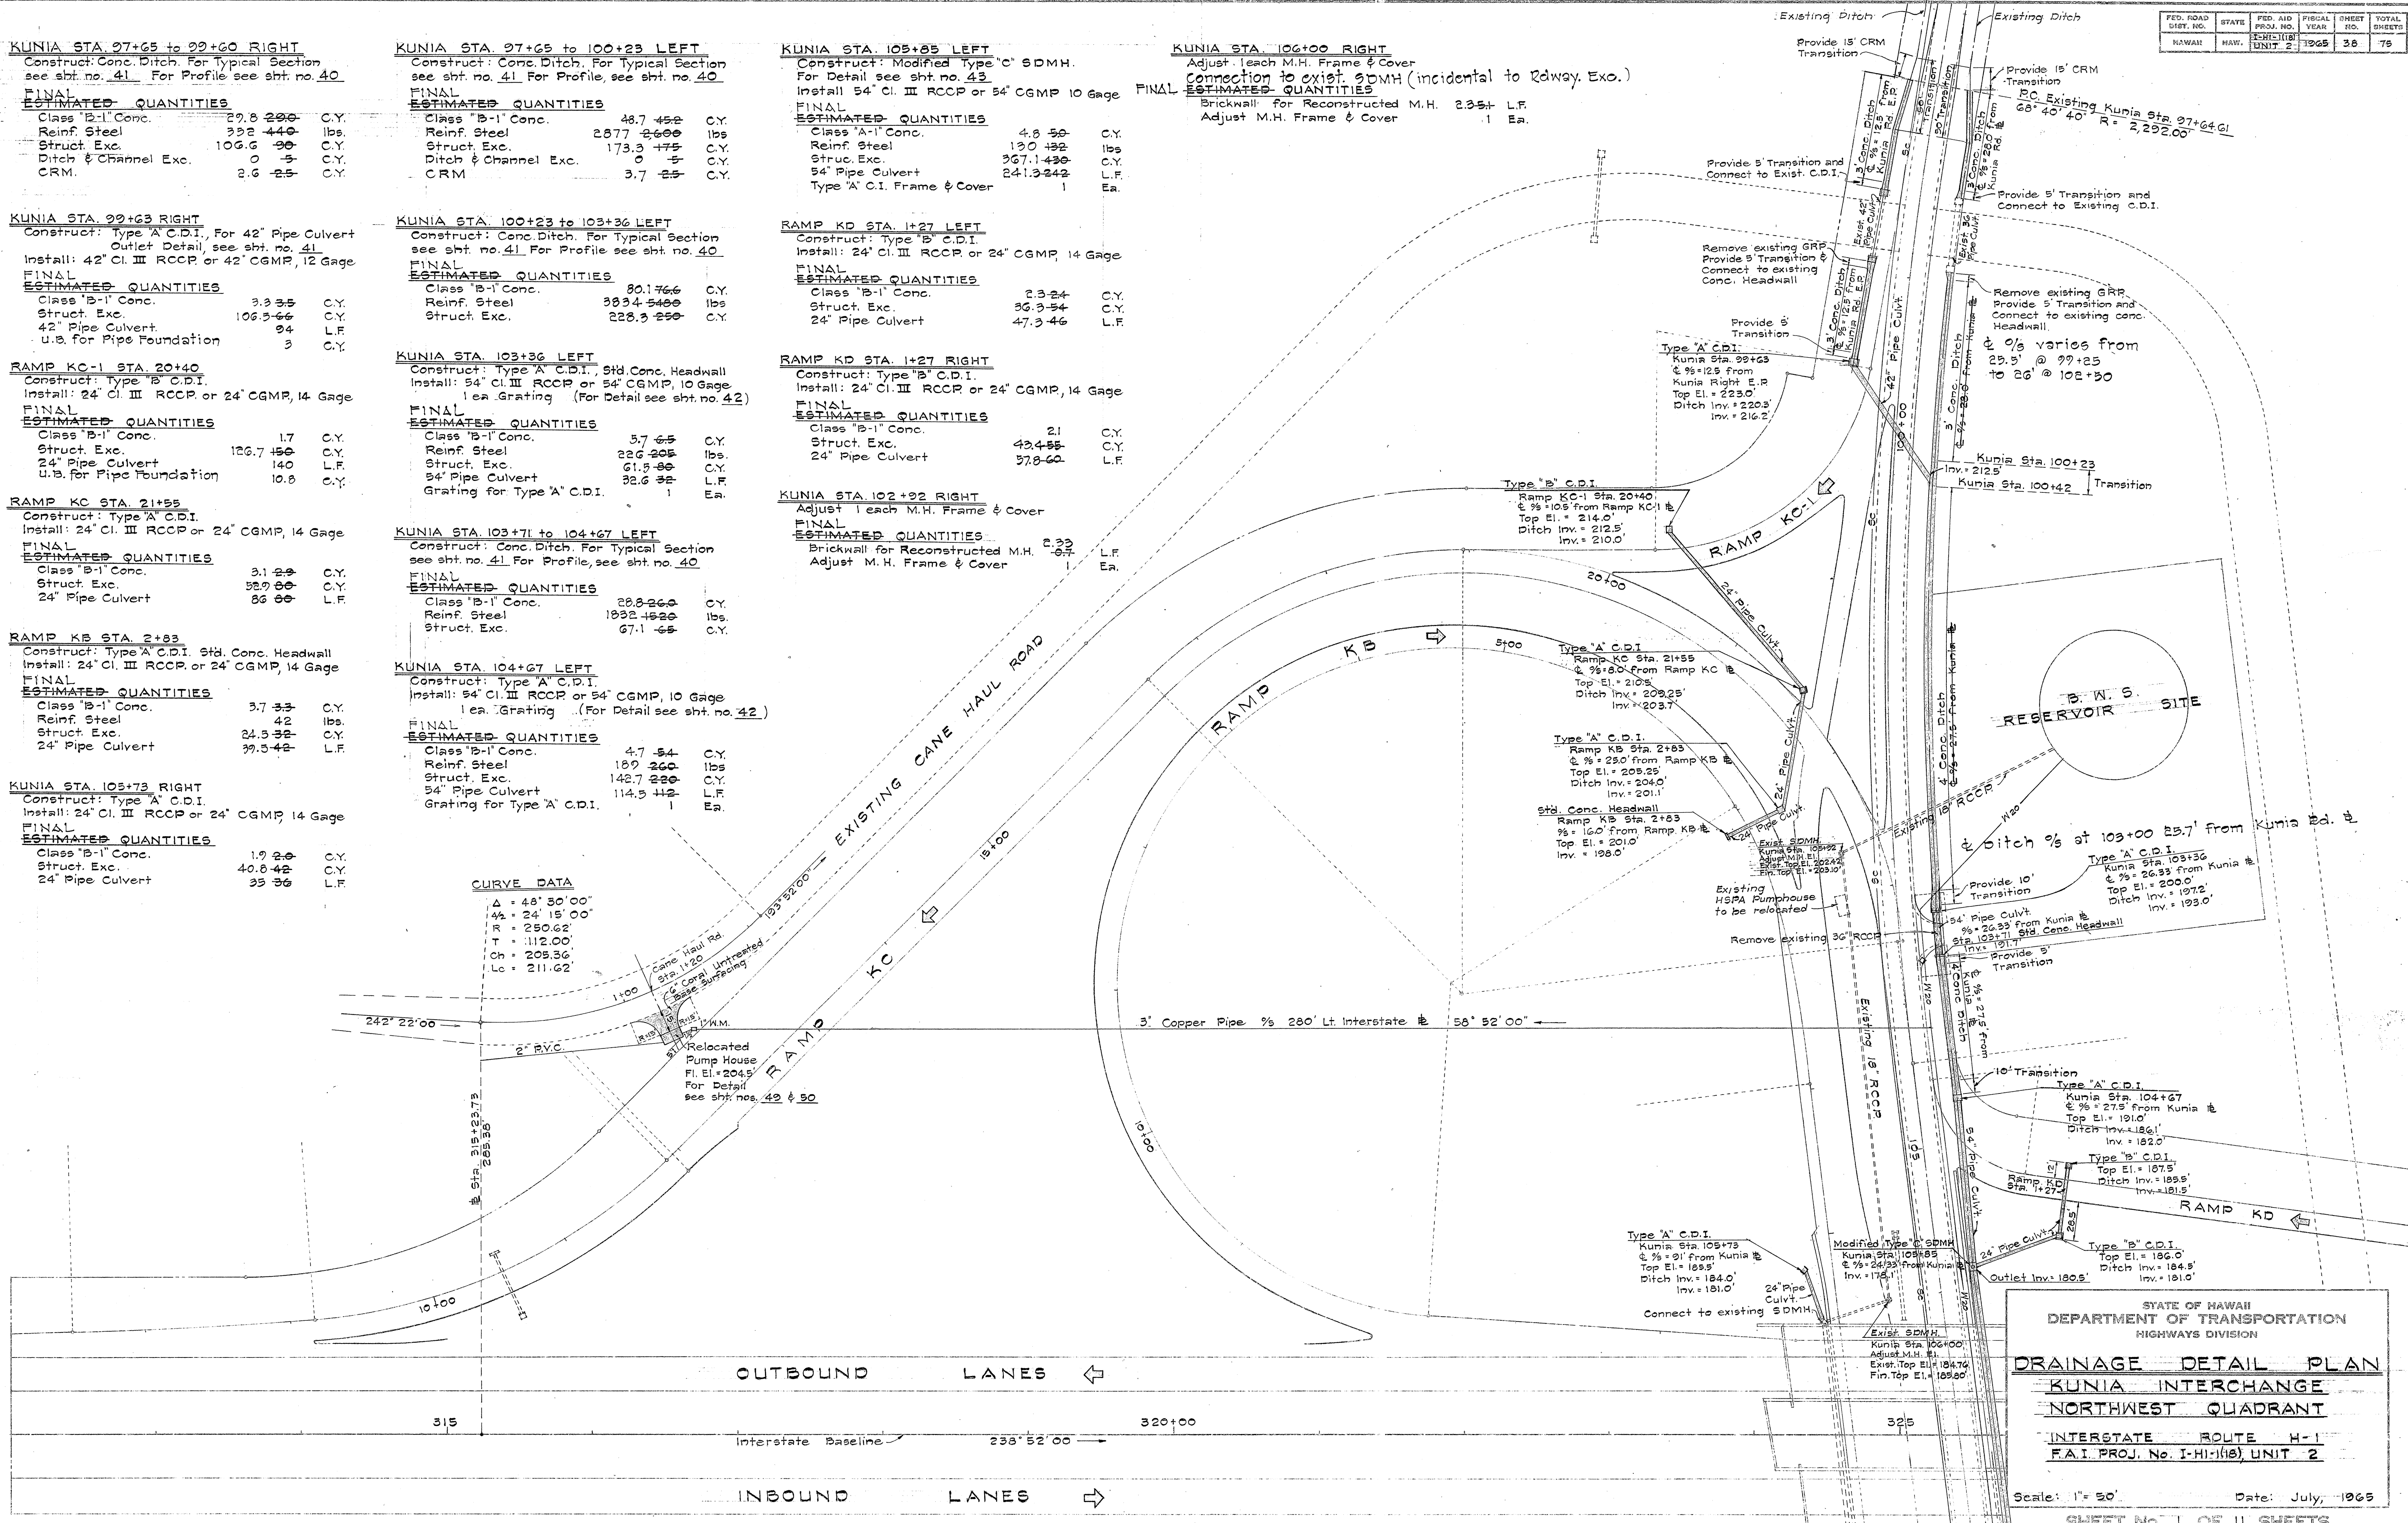

STATE OF HAWAII
DEPARTMENT OF TRANSPORTATION
HIGHWAYS DIVISION


DRAINAGE DETAIL PLAN
KUNIA INTERCHANGE
NORTHWEST QUADRANT

INTERSTATE ROUTE H-1
F.A.I. PROJ. No. I-H-1(18) UNIT 2

Scale: 1" = 50'
Date: July, 1965

SHEET No. 1 OF 11 SHEETS


FED. ROAD DIST. NO.	STATE	FED. AID PROJ. NO.	FISCAL YEAR	SHEET NO.	TOTAL SHEETS
HAWAII	HAW.	1-HI-110	1965	40	75

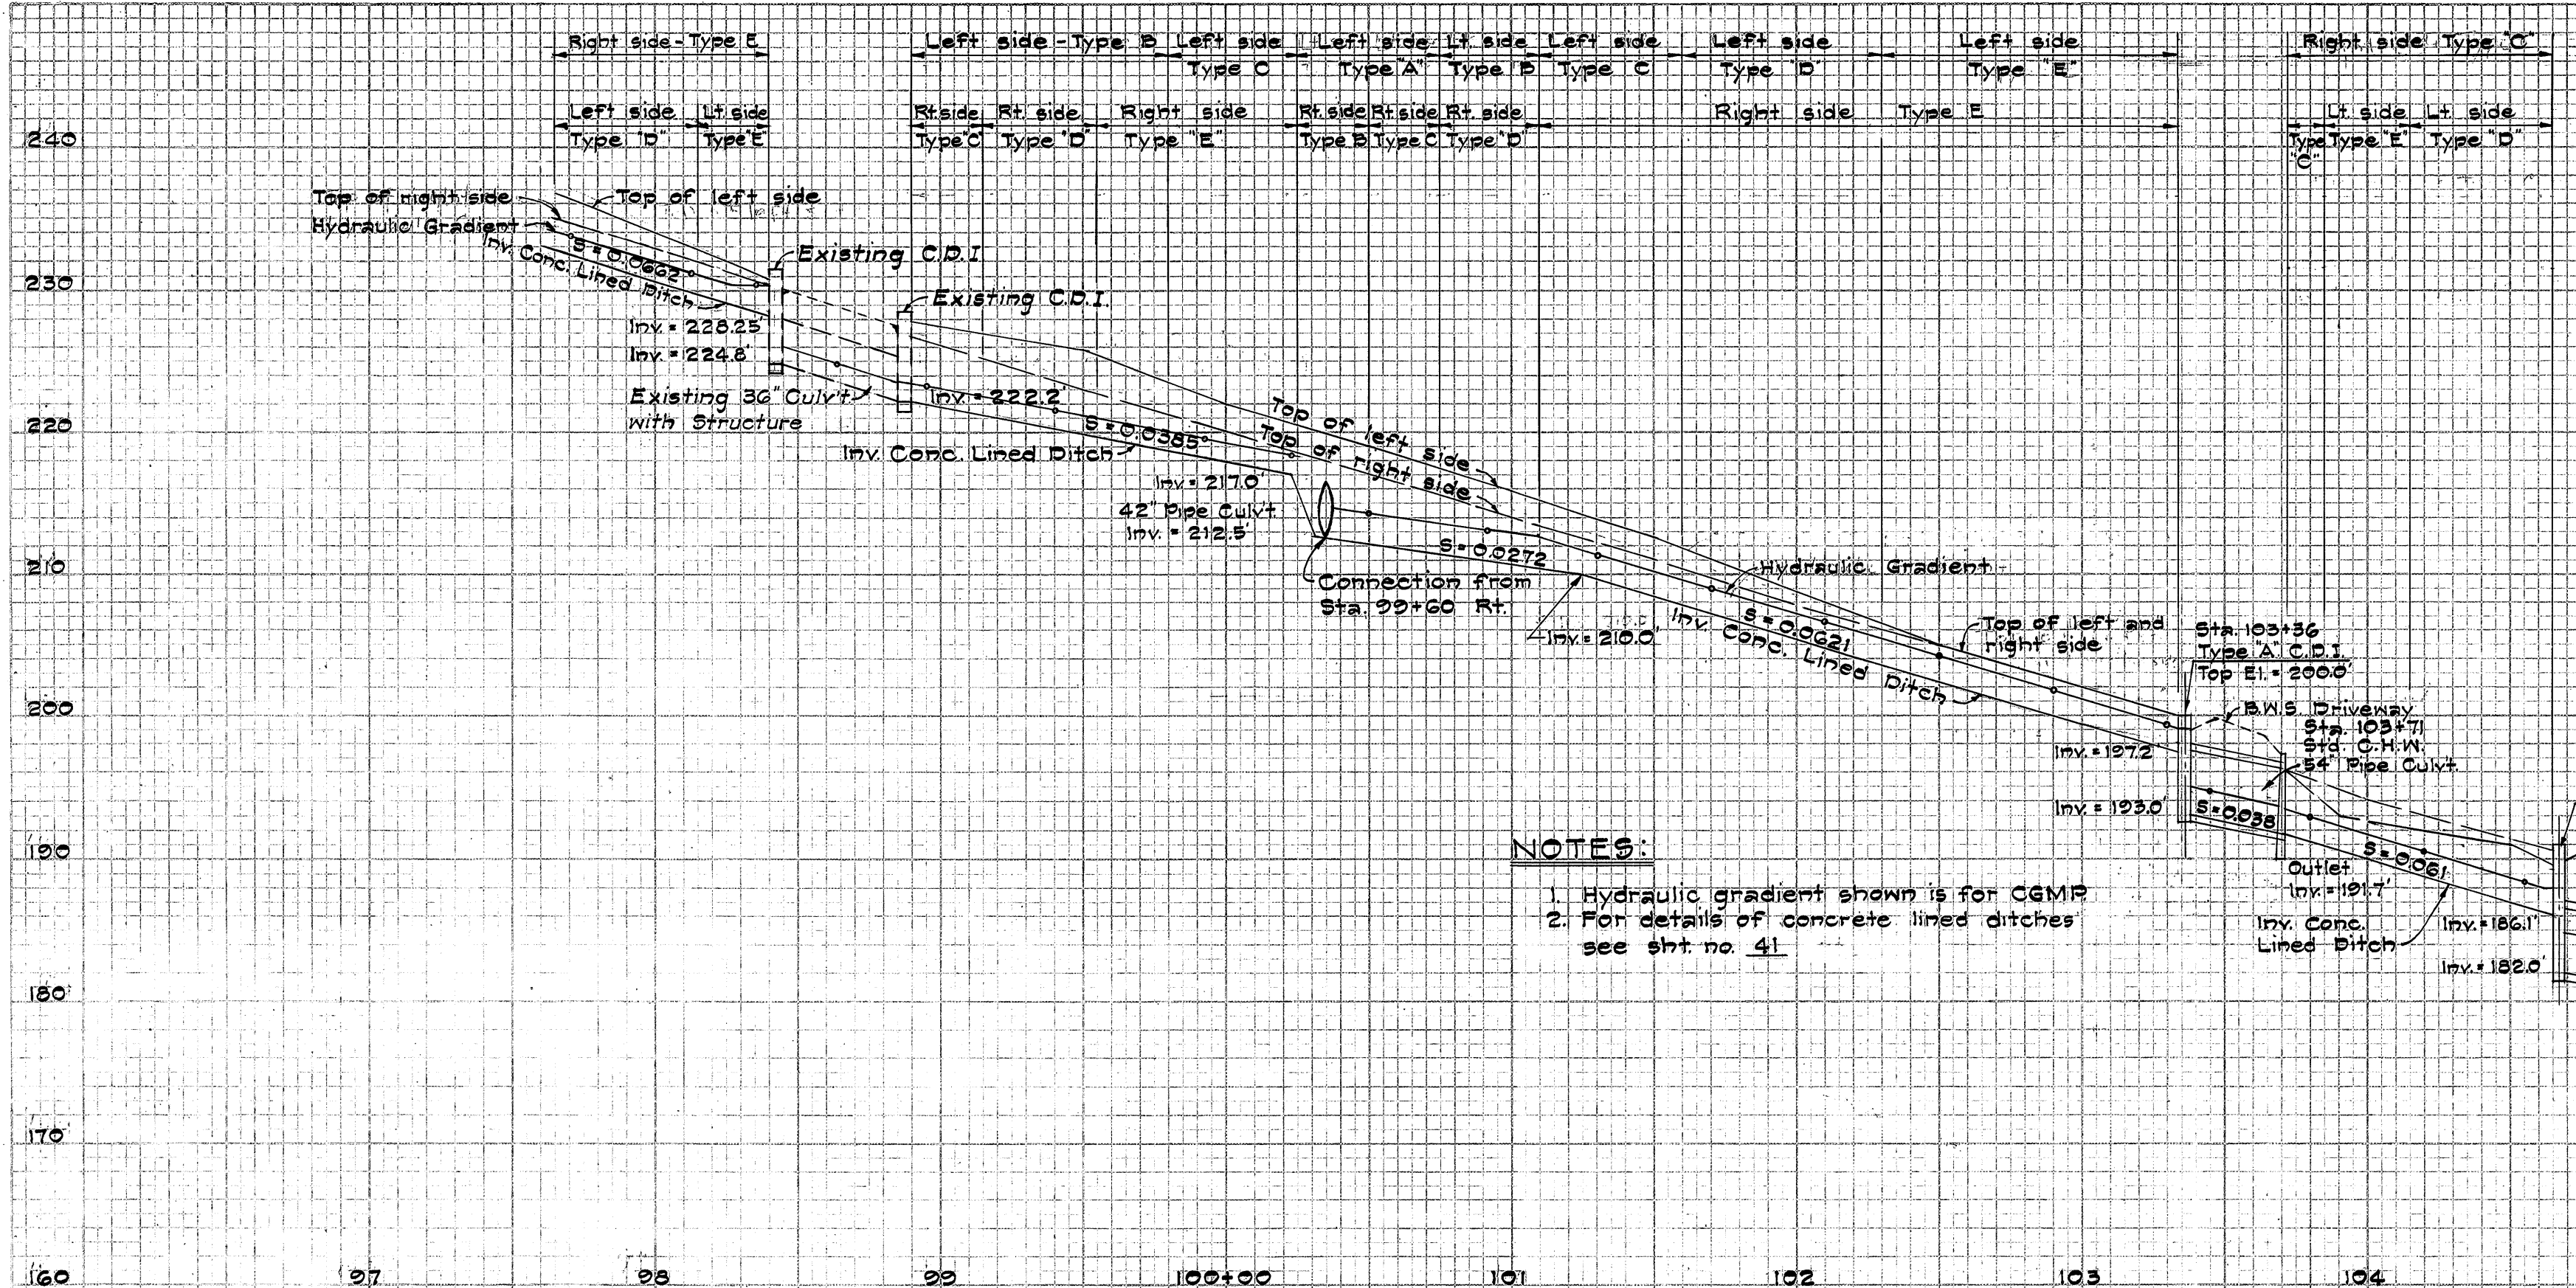

NOTES:
 1. Hydraulic gradient shown is for CGMP
 2. For details of concrete lined ditches see sheet no. 41

PROFILE DRAINAGE SYSTEM
KUNIA STA. 97+64 to 116+00 LEFT



Scale: Horiz. 1" = 50'
 Vert. 1" = 10'

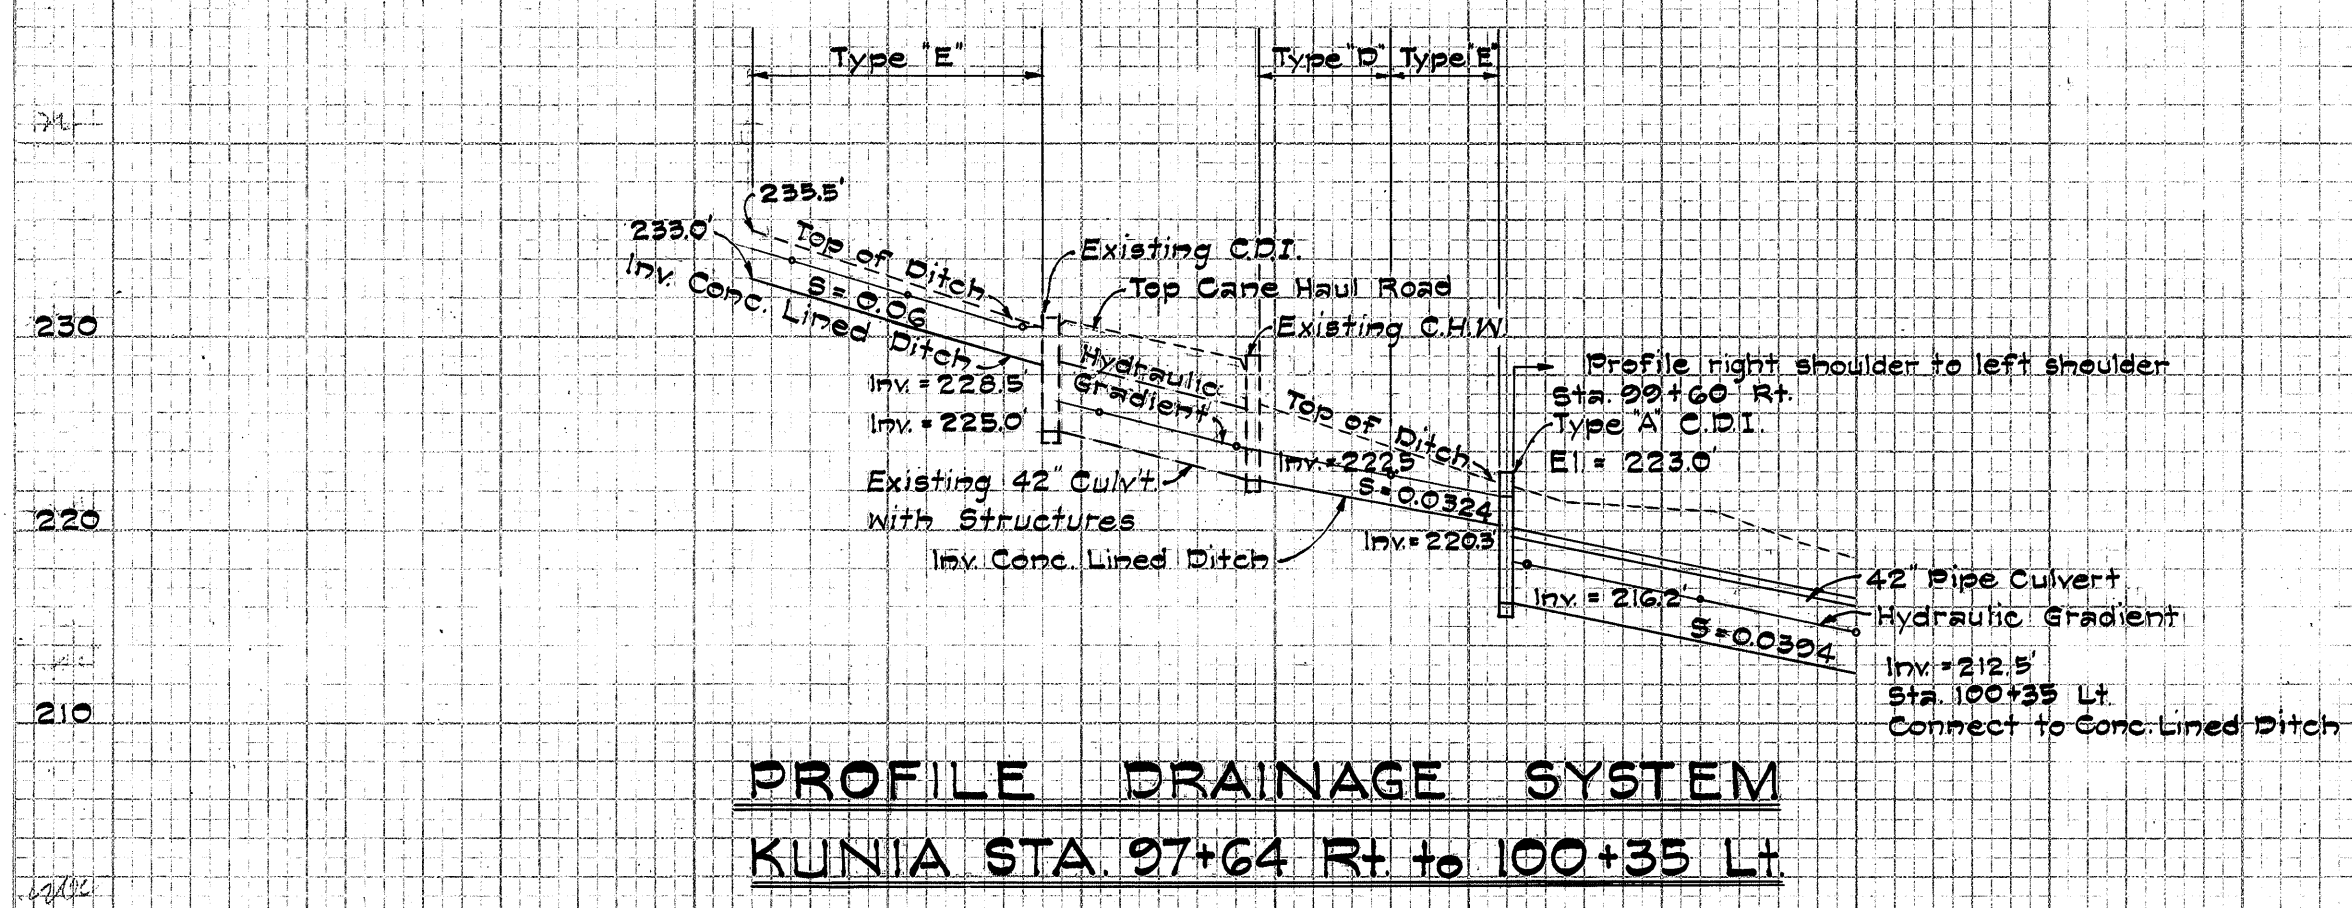

NOTES:
 1. Hydraulic gradient shown is for CGMP
 2. For details of concrete lined ditches see sheet no. 41
 3. Type reference for ditches indicates the reinforcing details for the ditches as shown on sheet no. 41

PROFILE DRAINAGE SYSTEM
KUNIA STA. 97+64 Rt. to 100+35 Lt.

Scale: Horiz. 1" = 50'
 Vert. 1" = 10'

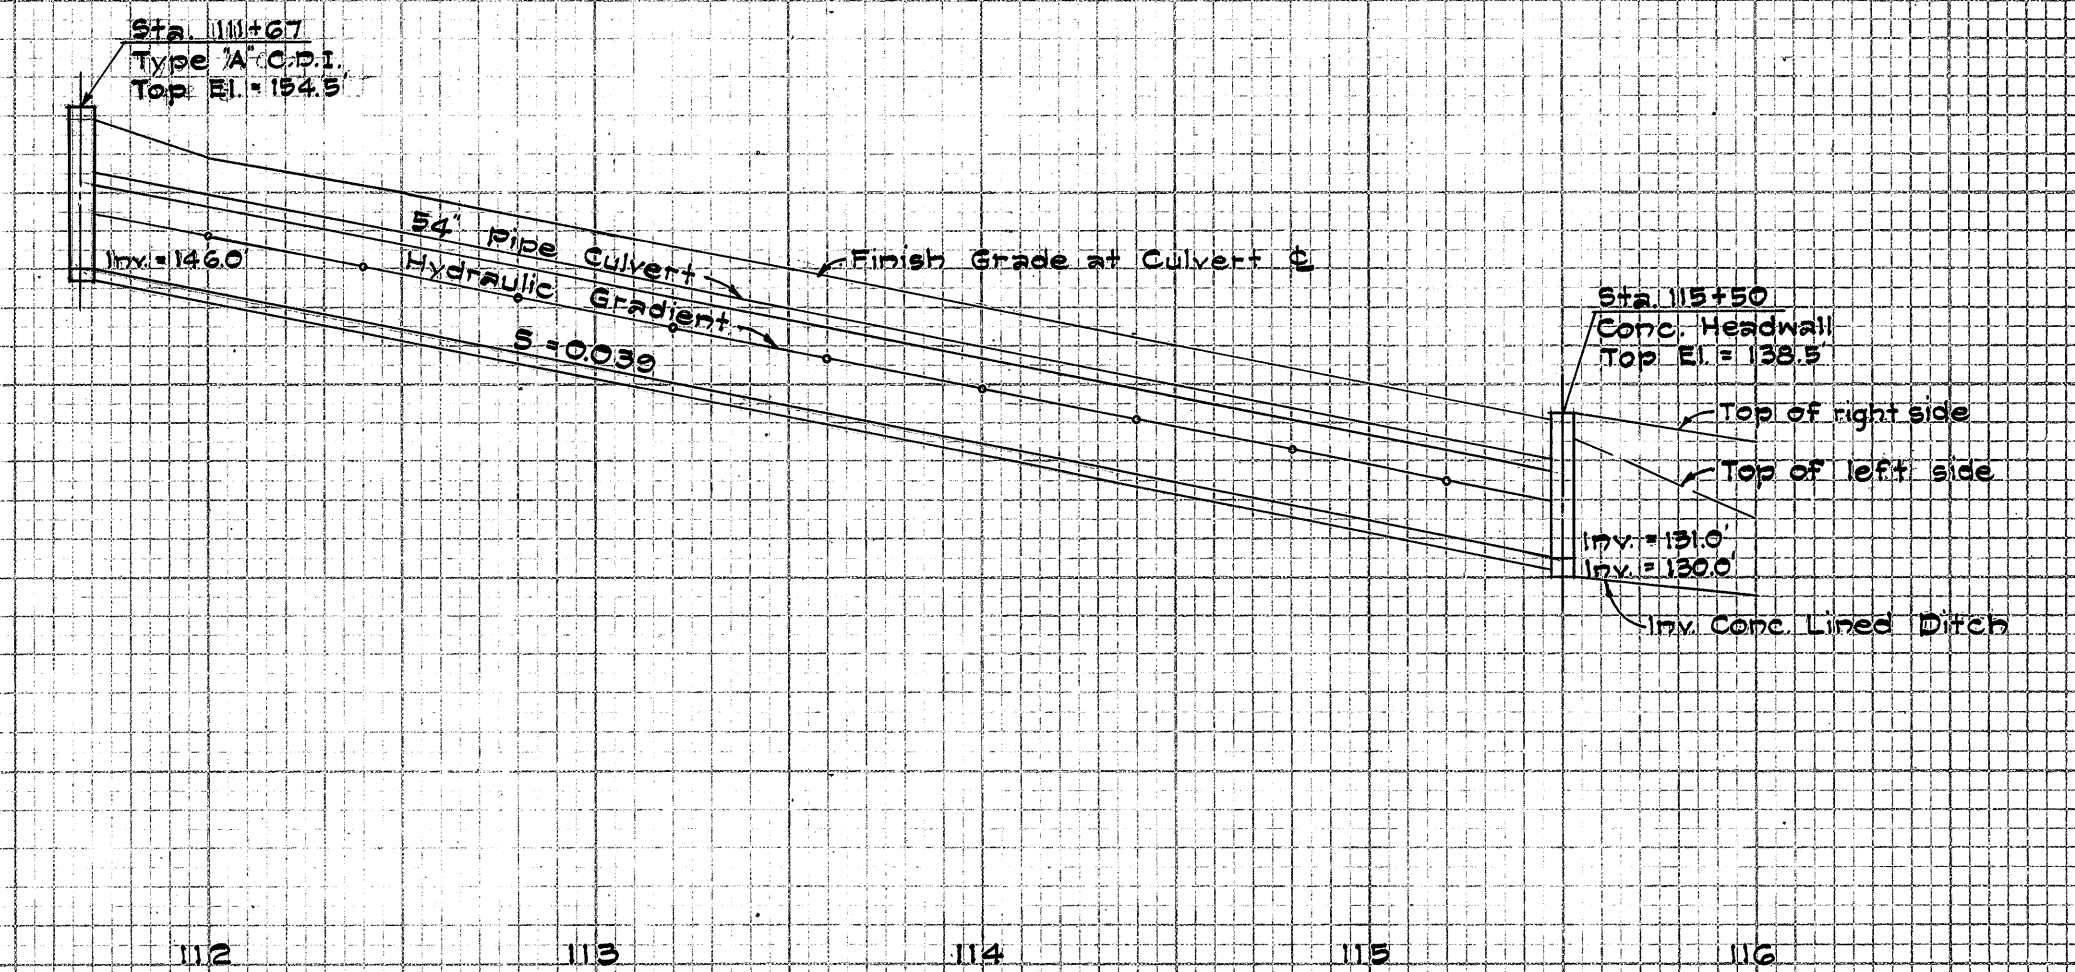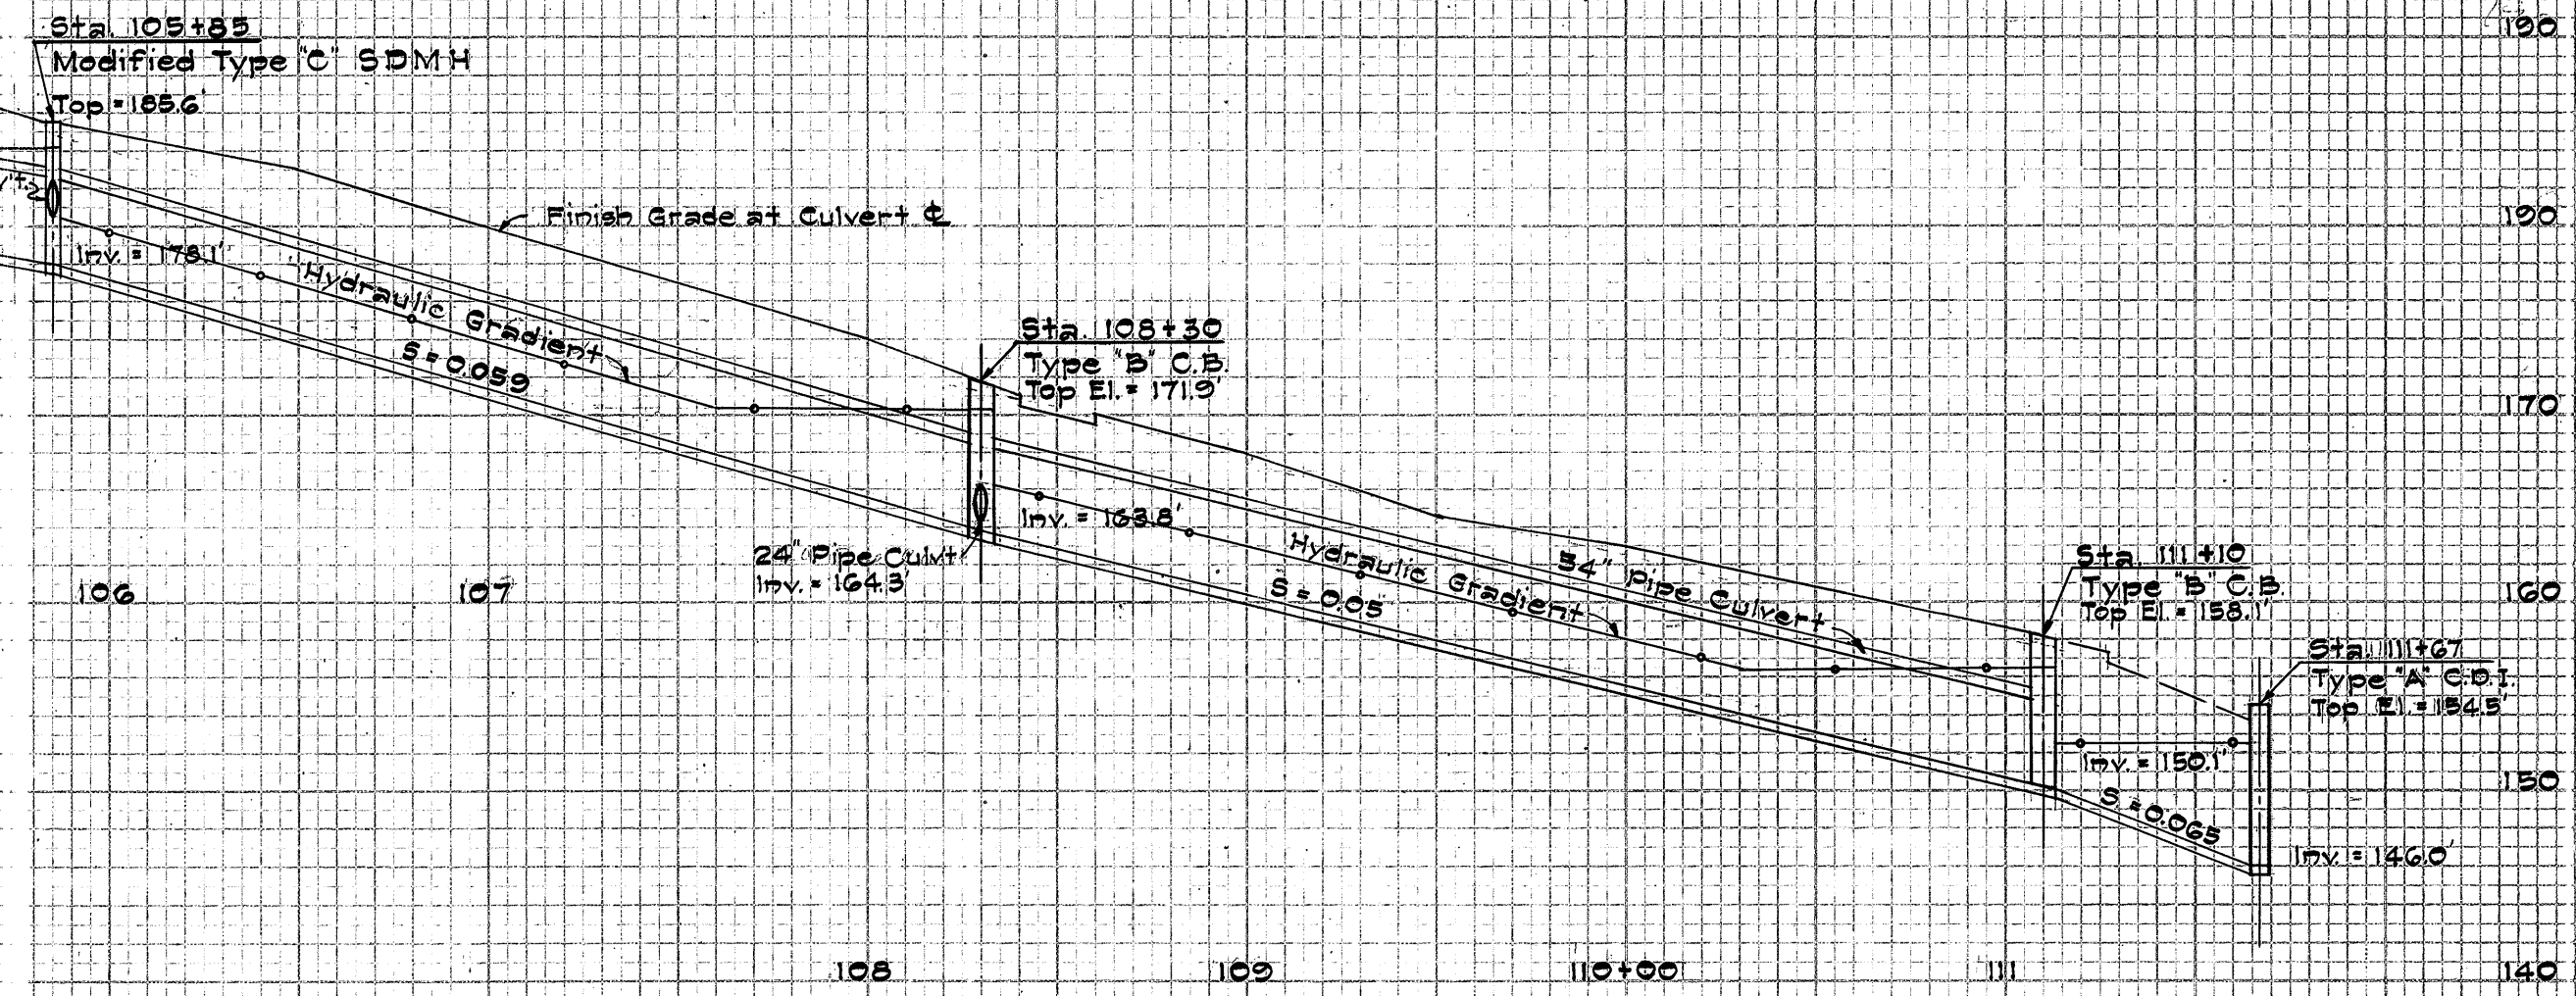



STATE OF HAWAII
 DEPARTMENT OF TRANSPORTATION
 HIGHWAYS DIVISION

PROFILE OF DRAINAGE SYSTEM
KUNIA STA. 97+64 To 116+00 LEFT
KUNIA STA. 97+64 Rt. To 100+23 Lt.


INTERSTATE ROUTE H-1
 F.A.I. PROJ. No. I-HI-110, UNIT 2

Scale: Horiz. 1" = 50'
 Vert. 1" = 10' Date: July 1965

SHEET No. 3 OF 11 SHEETS

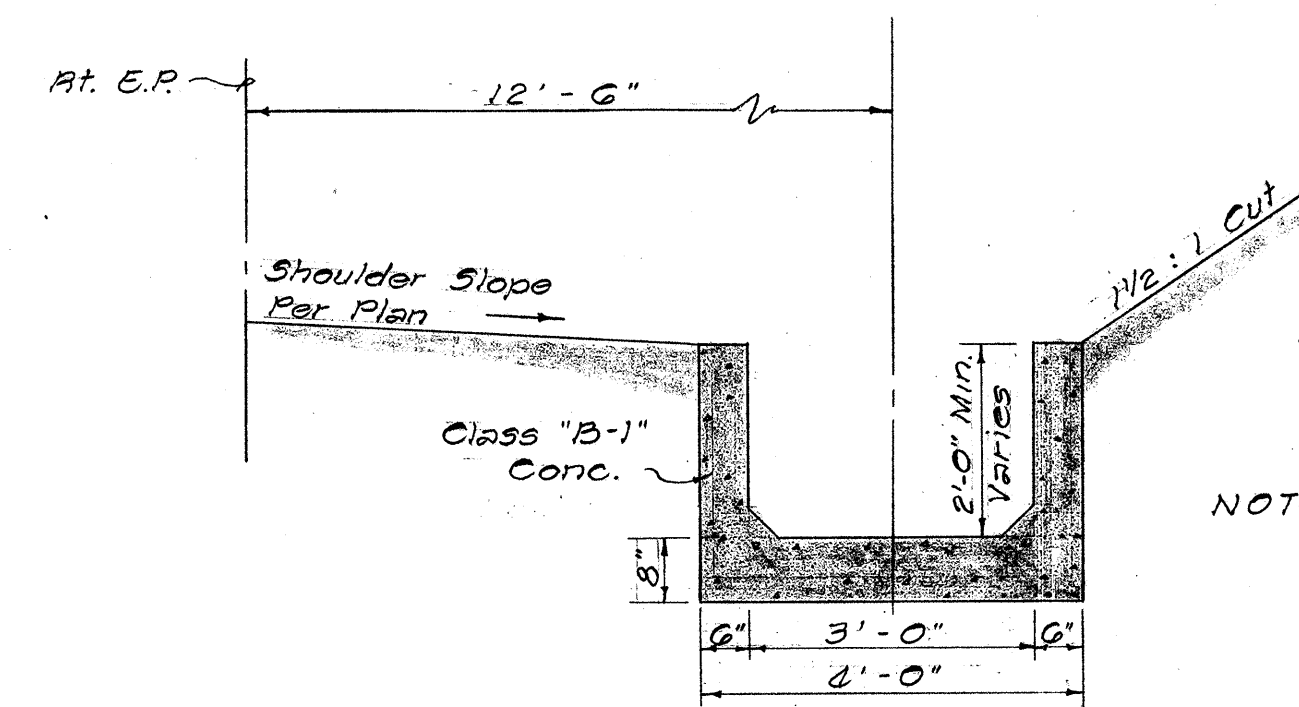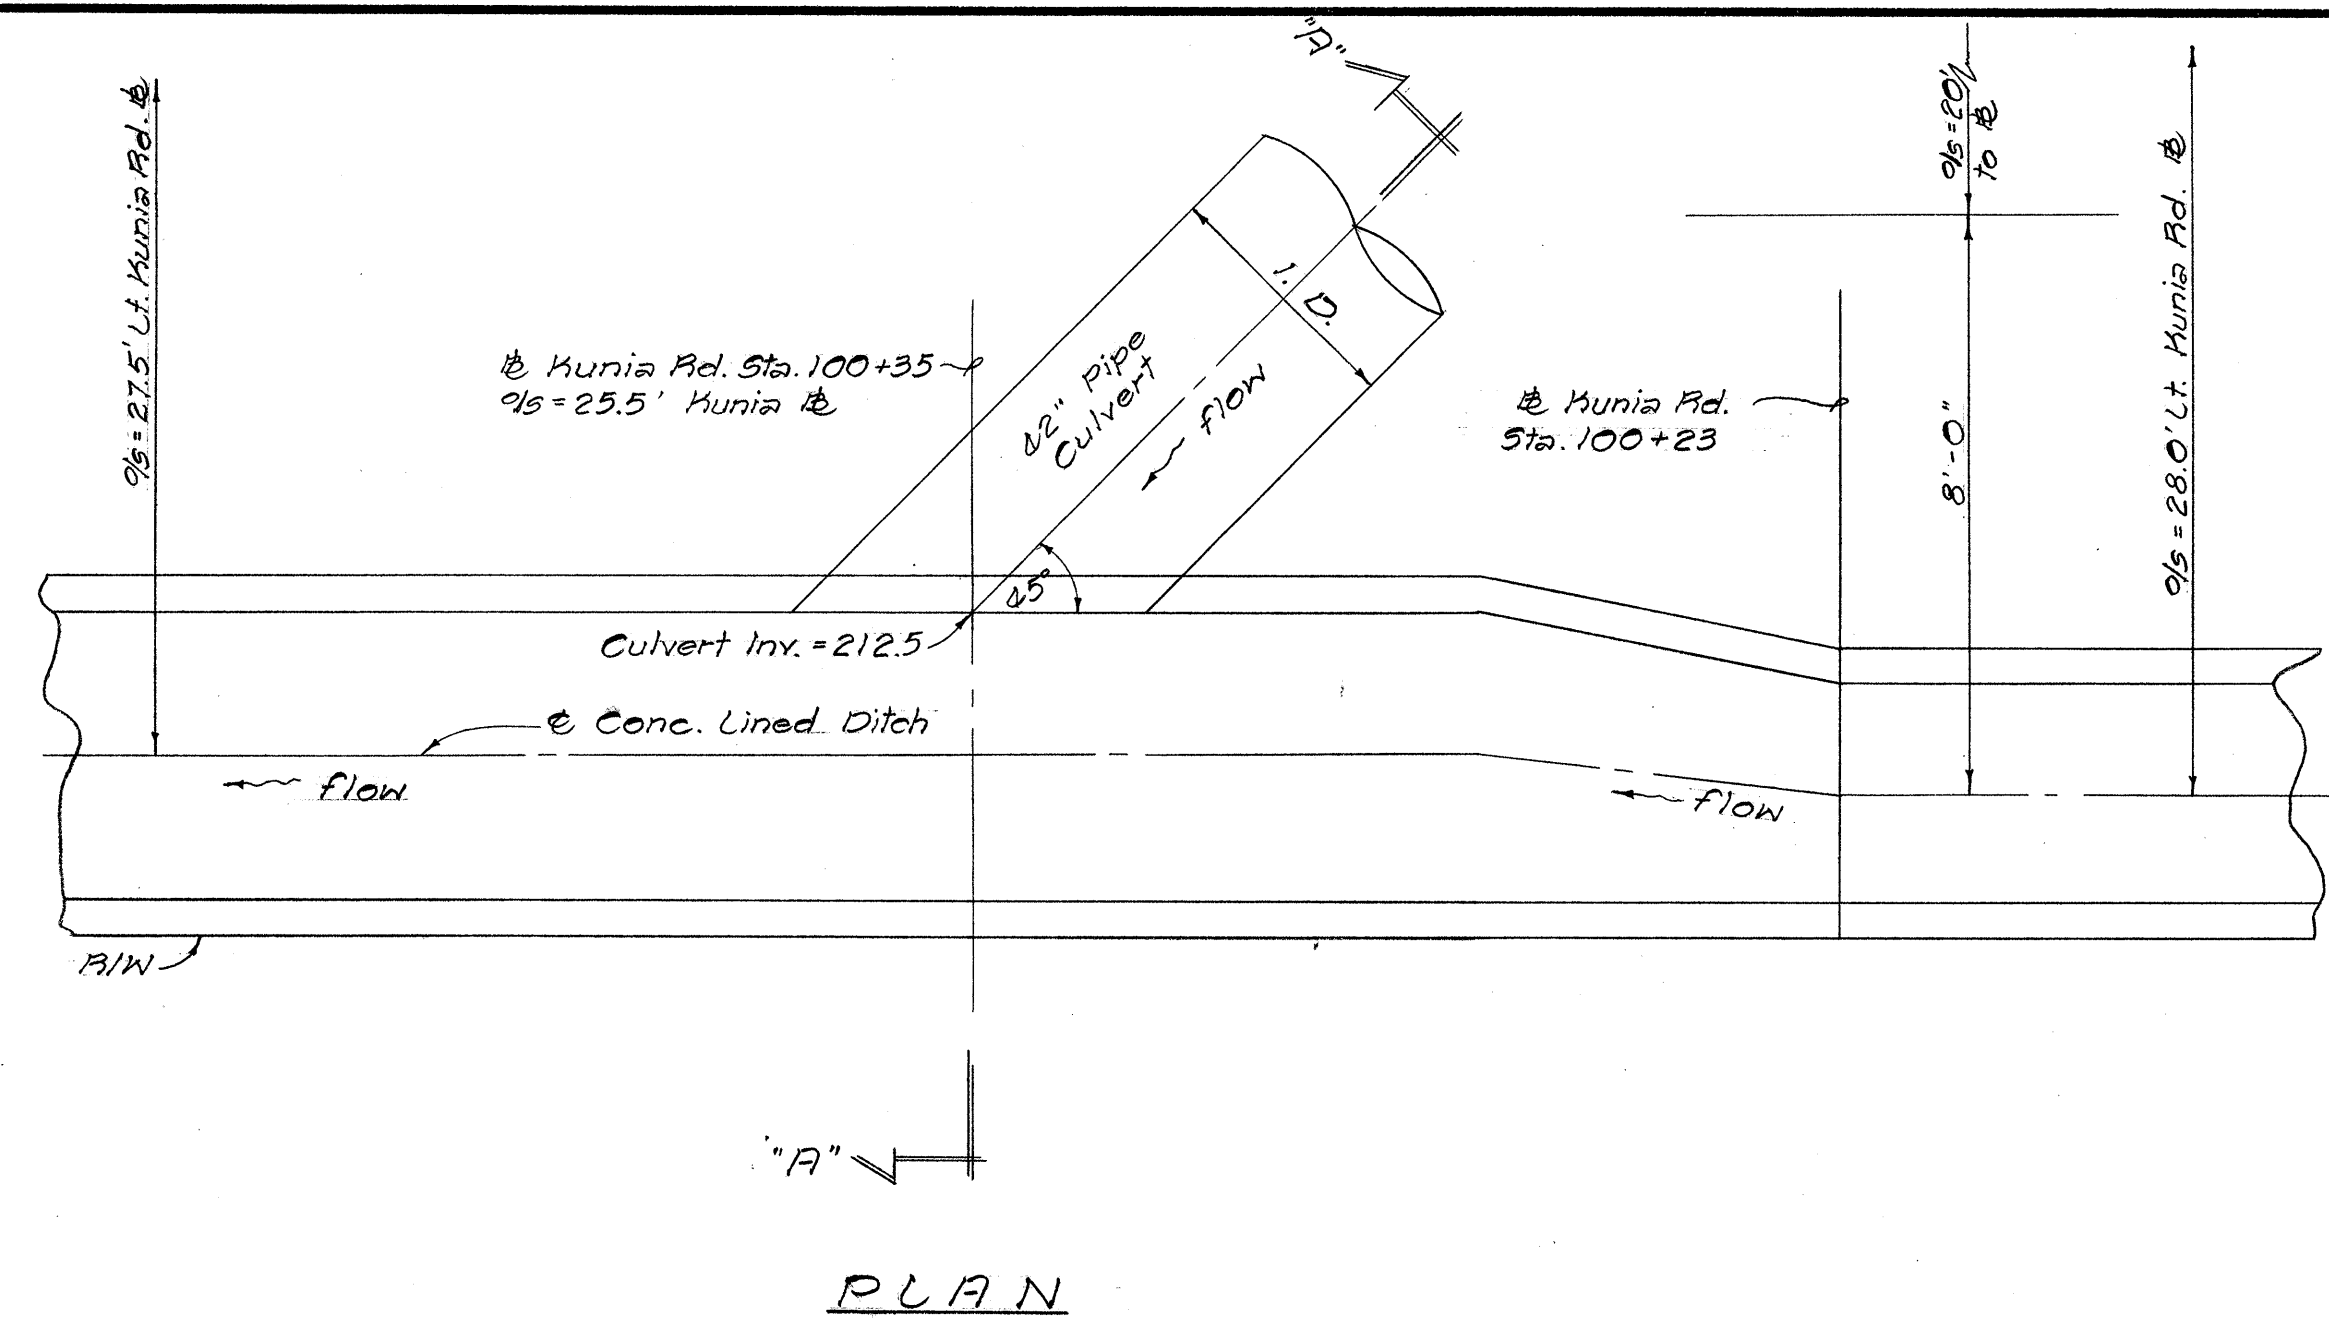



KUNIA STA. 97+65 to 99+60 Lt.
Scale: 1/2" = 1'-0"

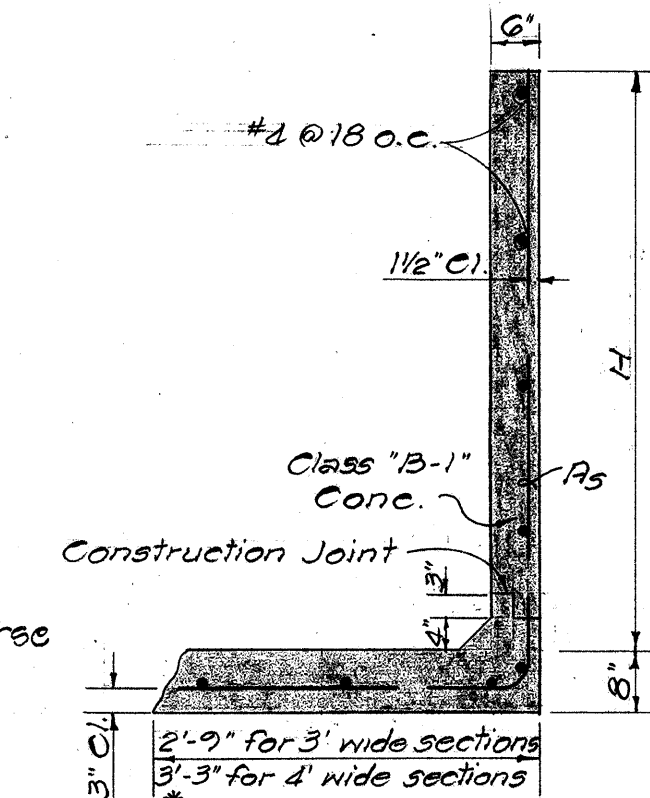


SCHEDULE

TYPE	H	As
A	6' to 8'	#5 @ 6"
B	5' to 6'	#4 @ 6"
C	4' to 5'	#4 @ 9"
D	3' to 4'	#4 @ 15"
E	3' & Under	Unreinforced


* In transition sections, increase length to provide 20" lap with bar from other wall.

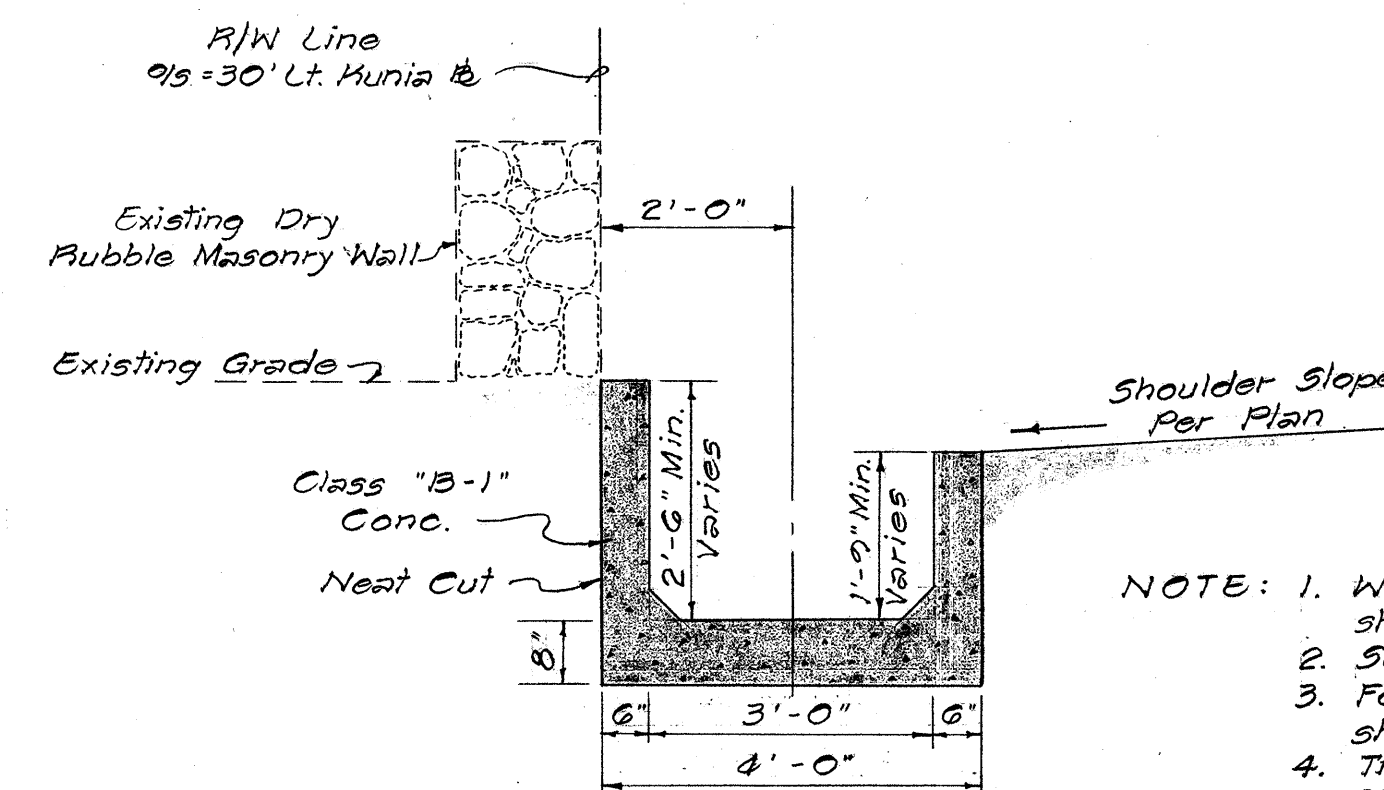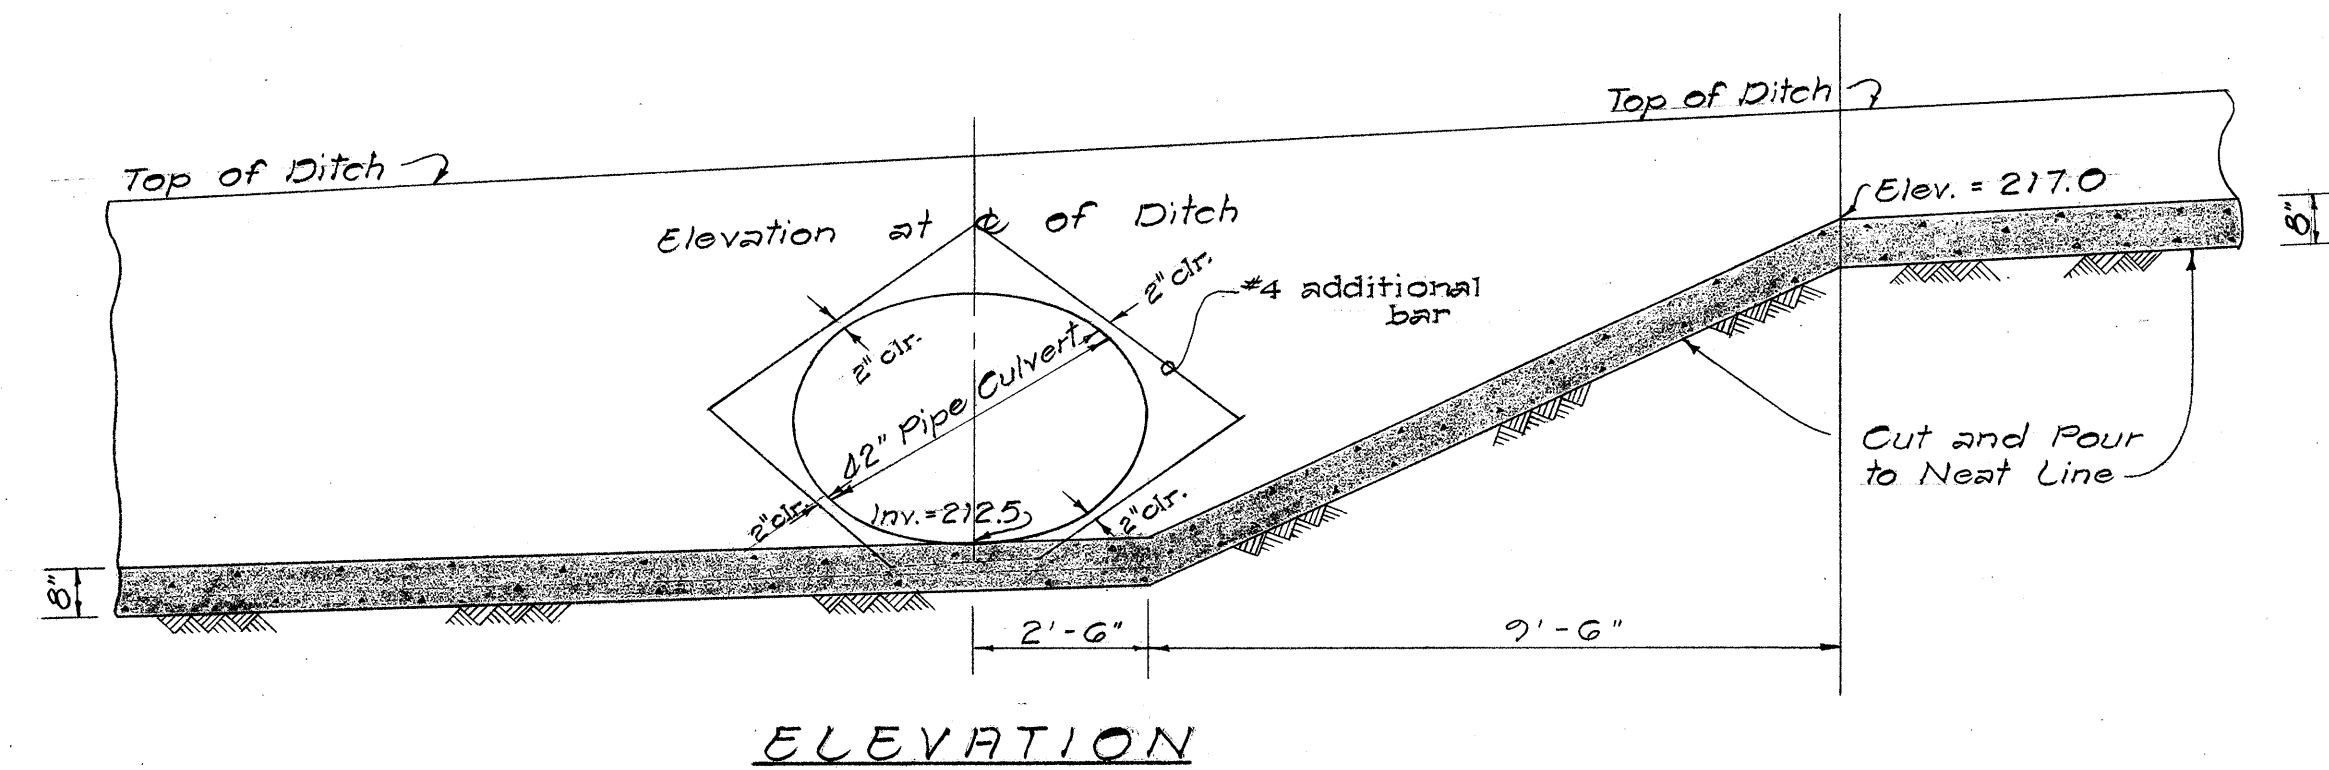


KUNIA STA. 97+65 to 100+23 Lt.
Scale: 1/2" = 1'-0"

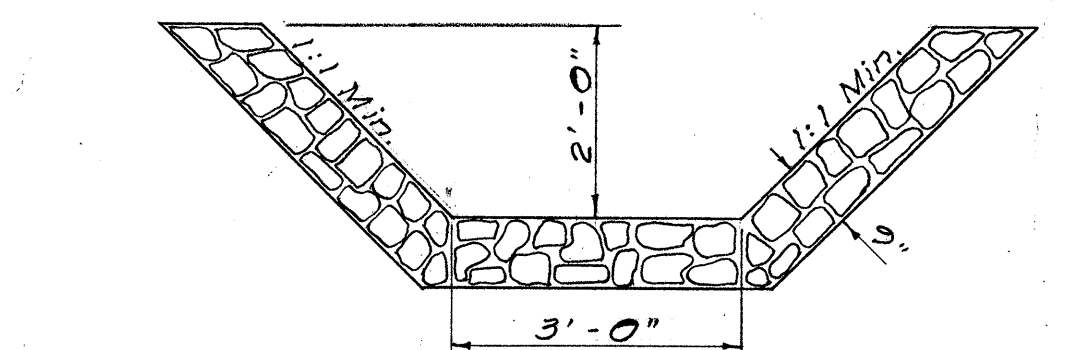


AT KUNIA STA. 97+65
Scale: 1/2" = 1'-0"

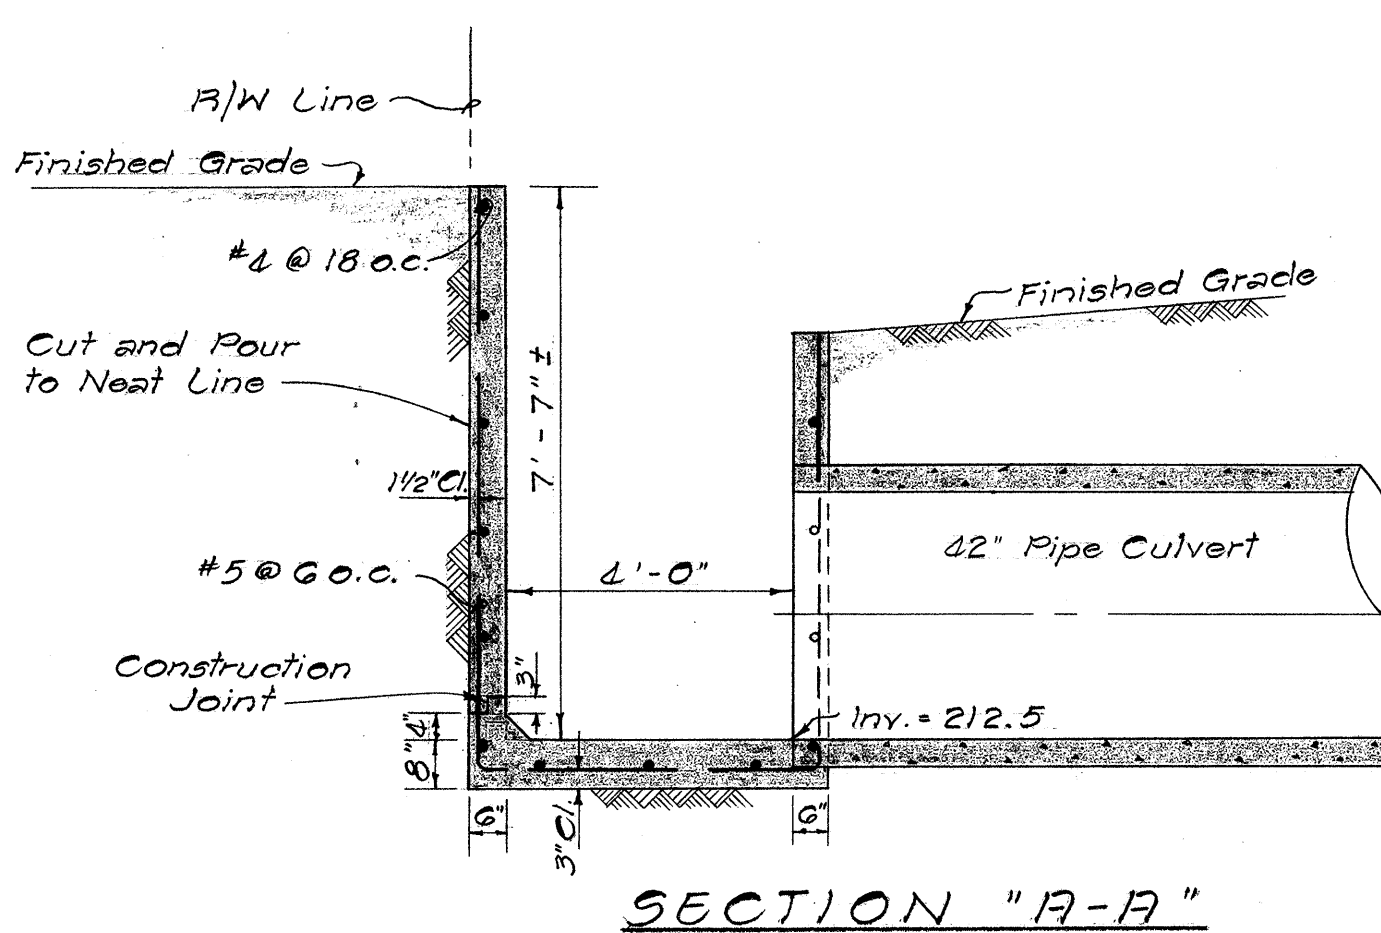

DETAIL OF 42" PIPE CULVERT OUTLET
AT KUNIA STA. 100+35 (LT.)
Scale: 3/8" = 1'-0"












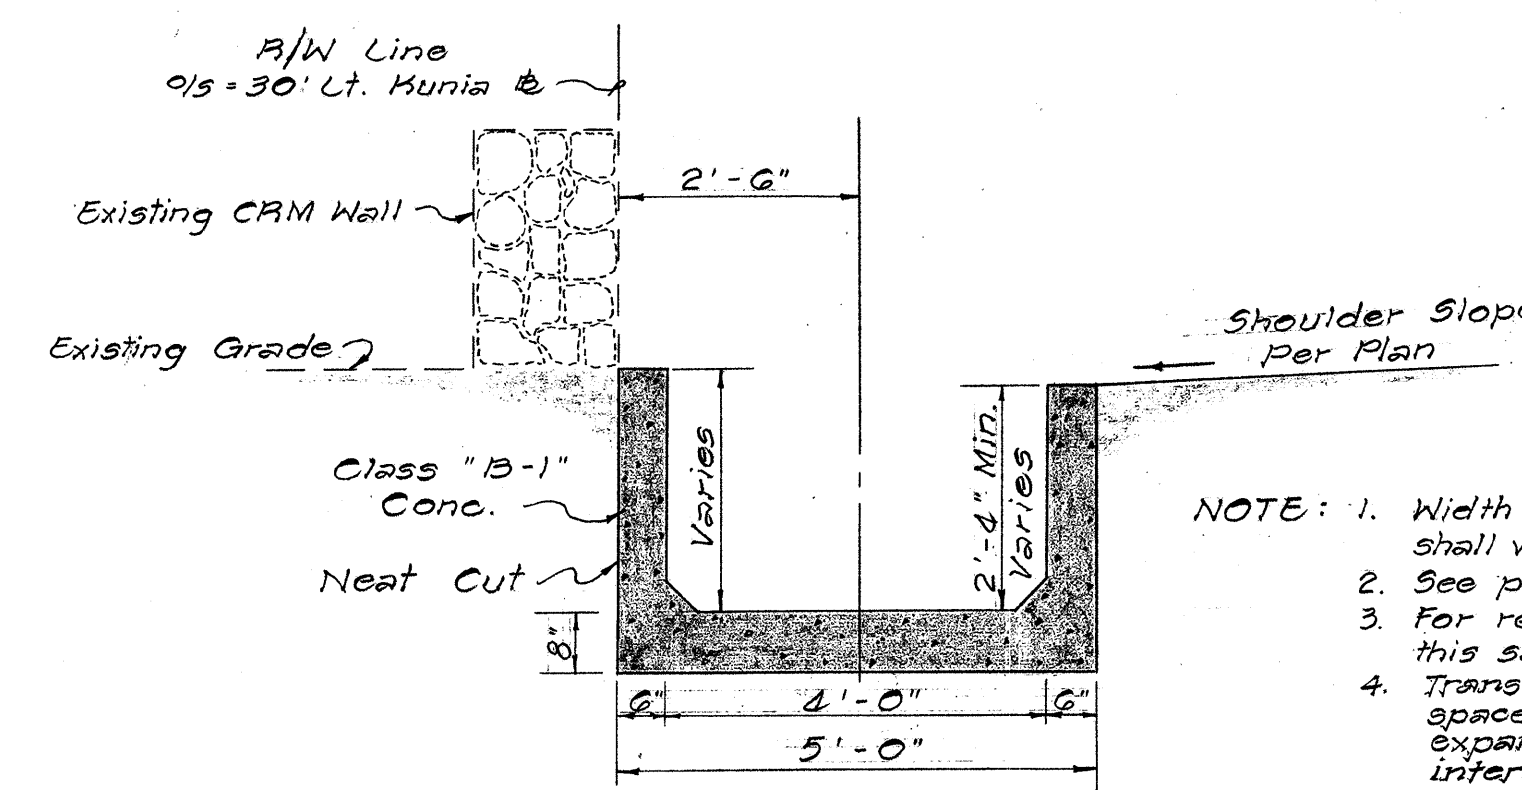


KUNIA STA. 100+42 to 103+17 Lt.
and KUNIA STA. 103+71 to 104+68 Lt.
Scale: 1/2" = 1'-0"

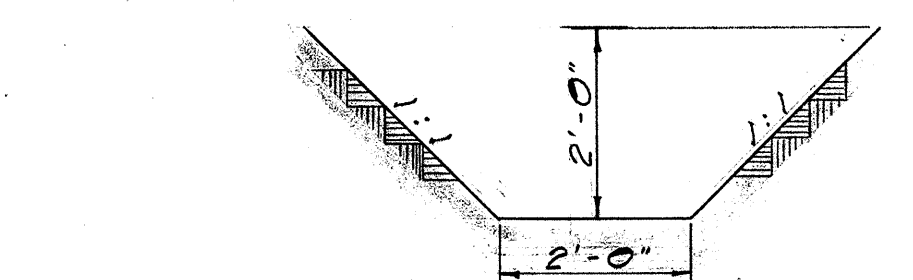

Scale: 1/2" = 1'-0"

FED. ROAD DIST. NO.	STATE	FED. AID PROJ. NO.	FISCAL YEAR	SHEET NO.	TOTAL SHEETS
HAWAII	HAW.	1-HI-118 UNIT 2	1965	42	75

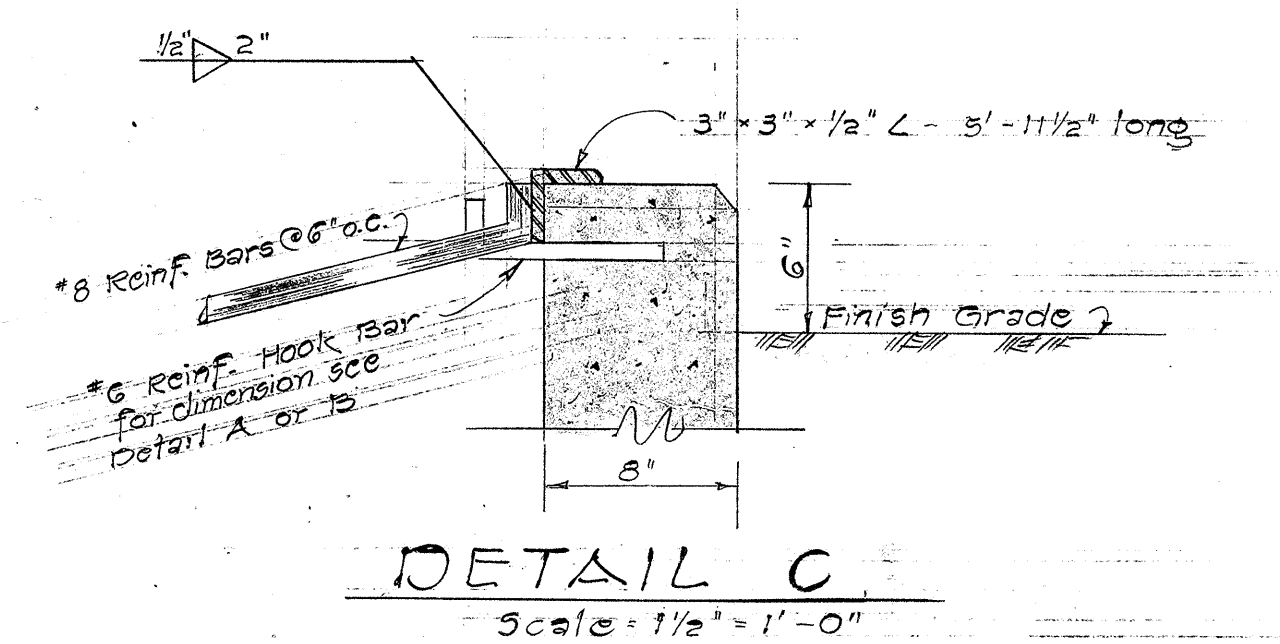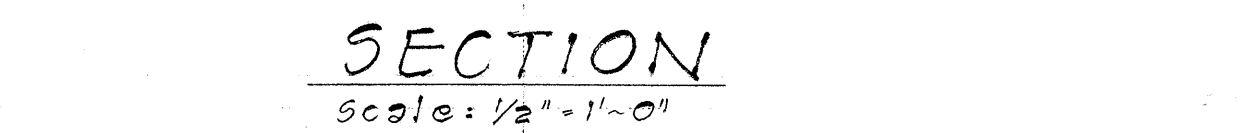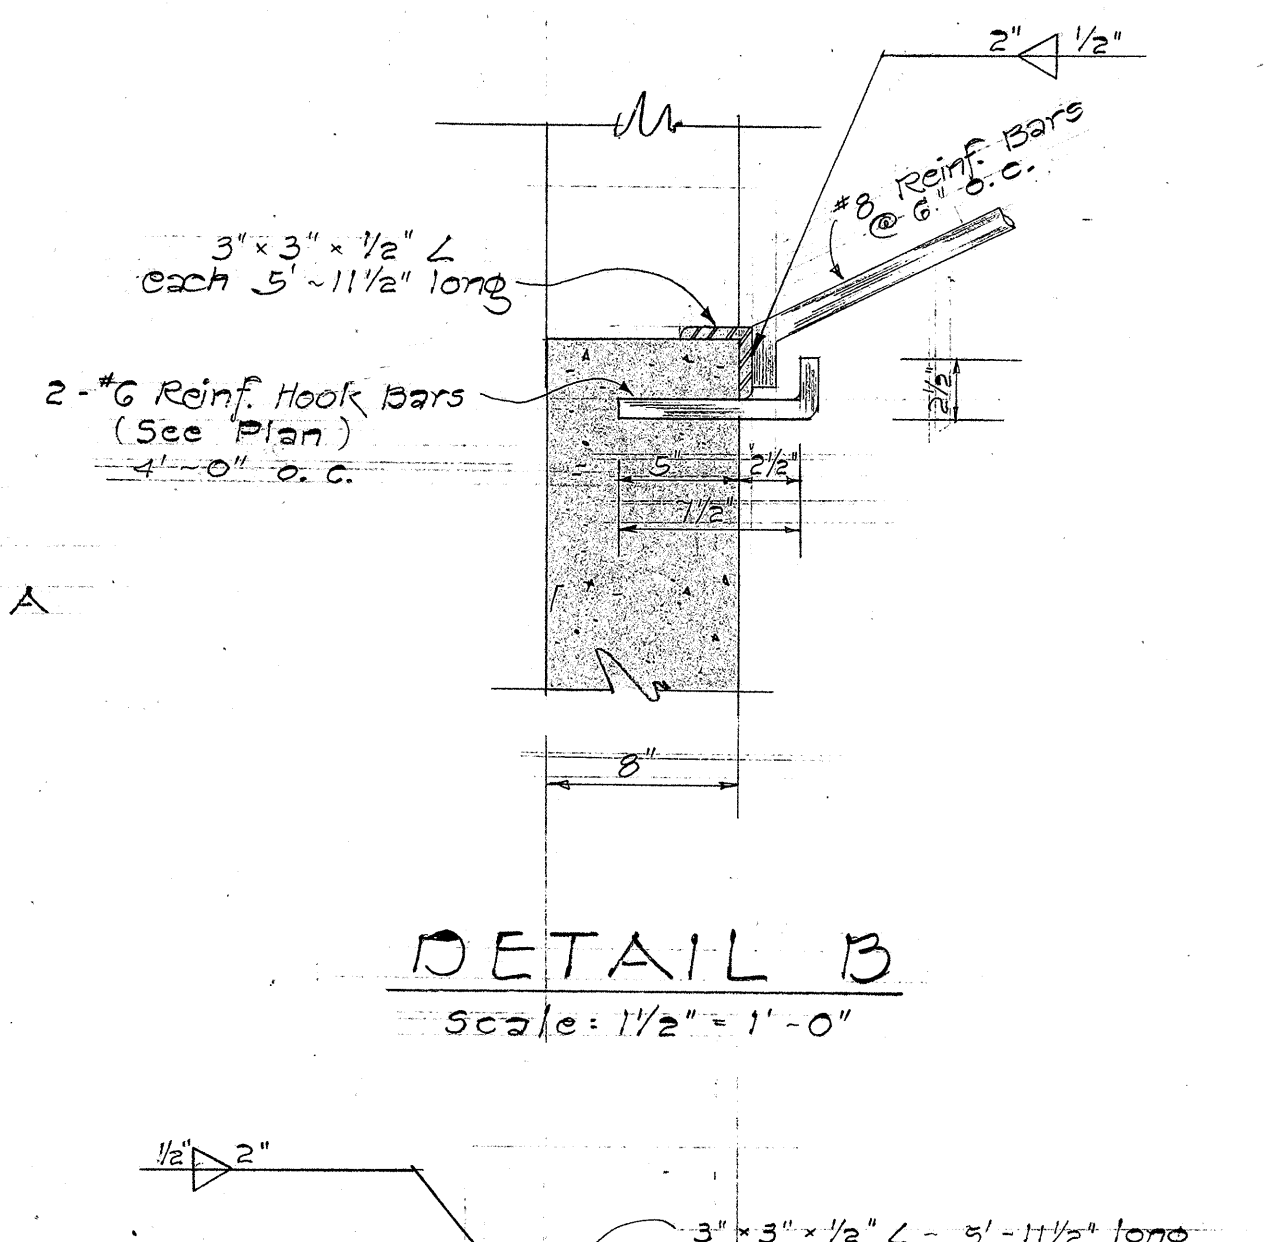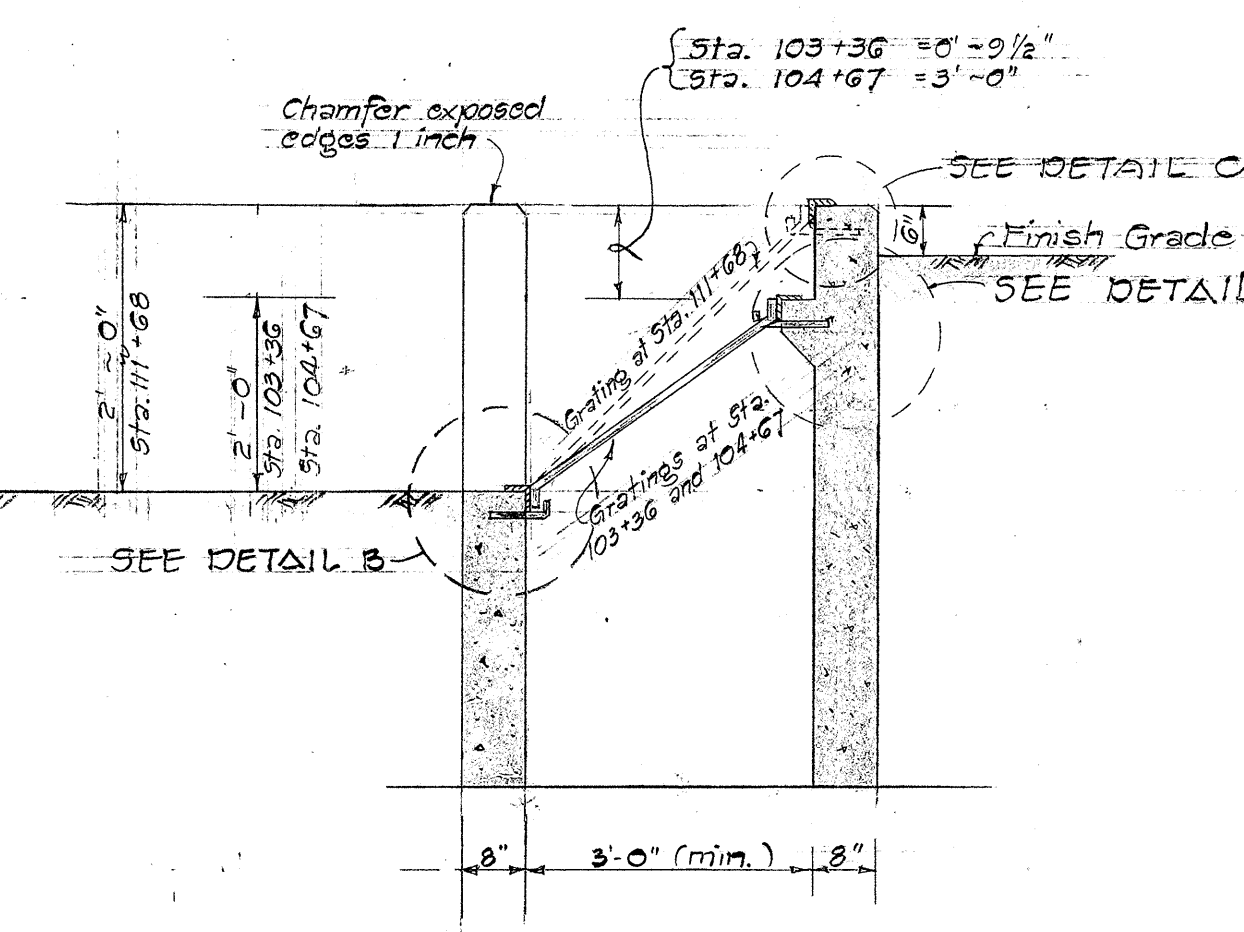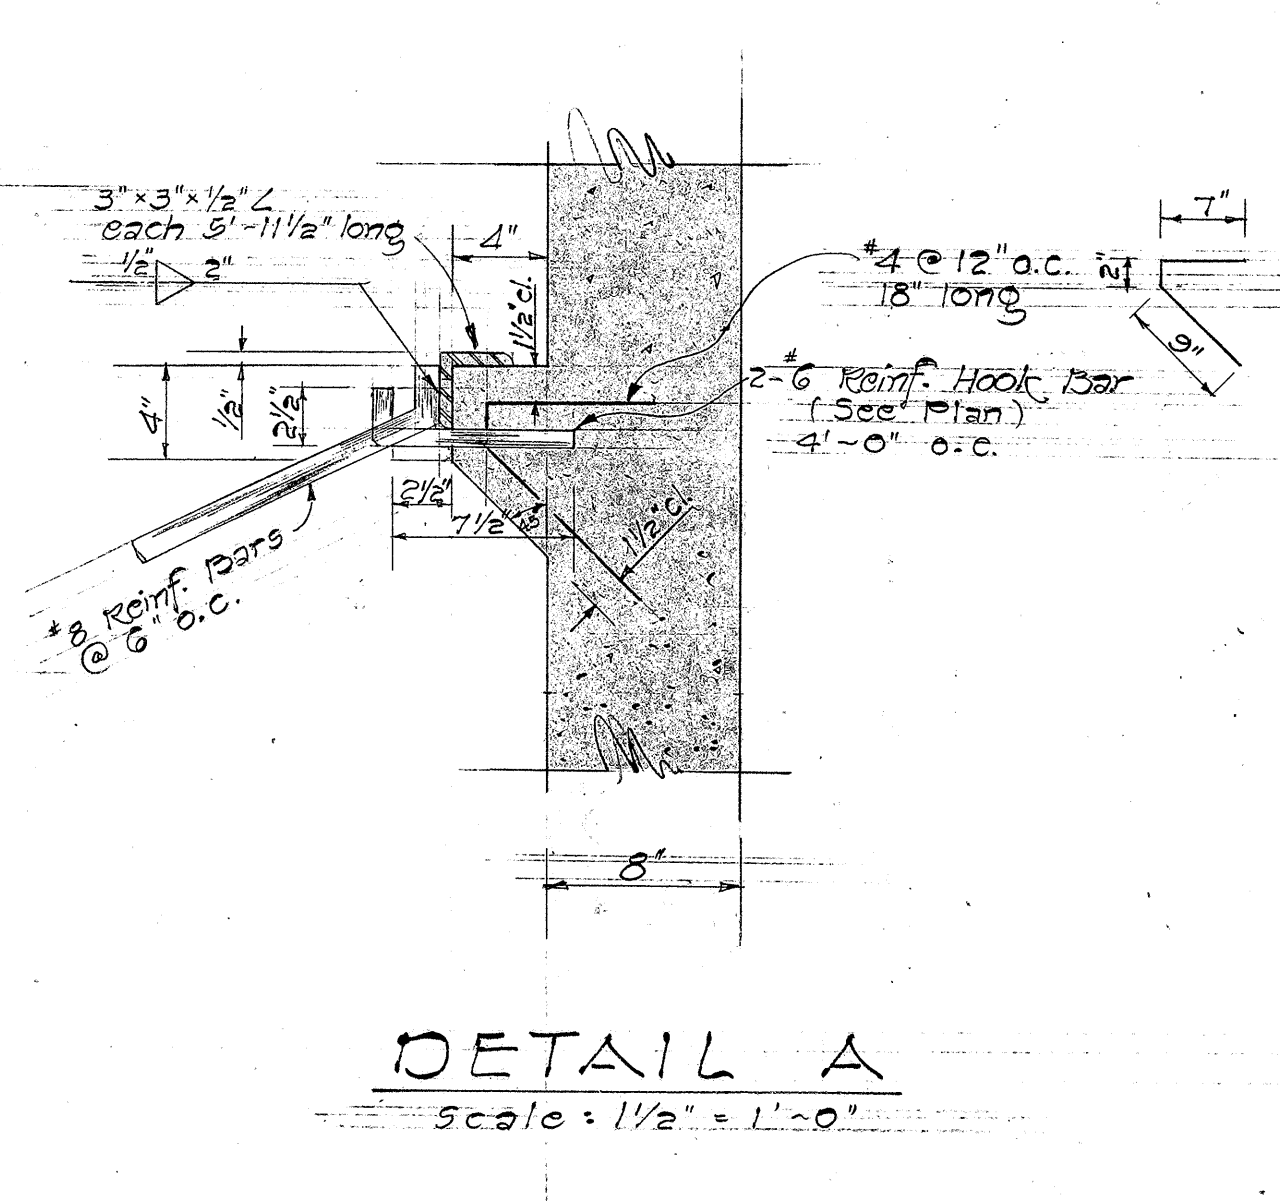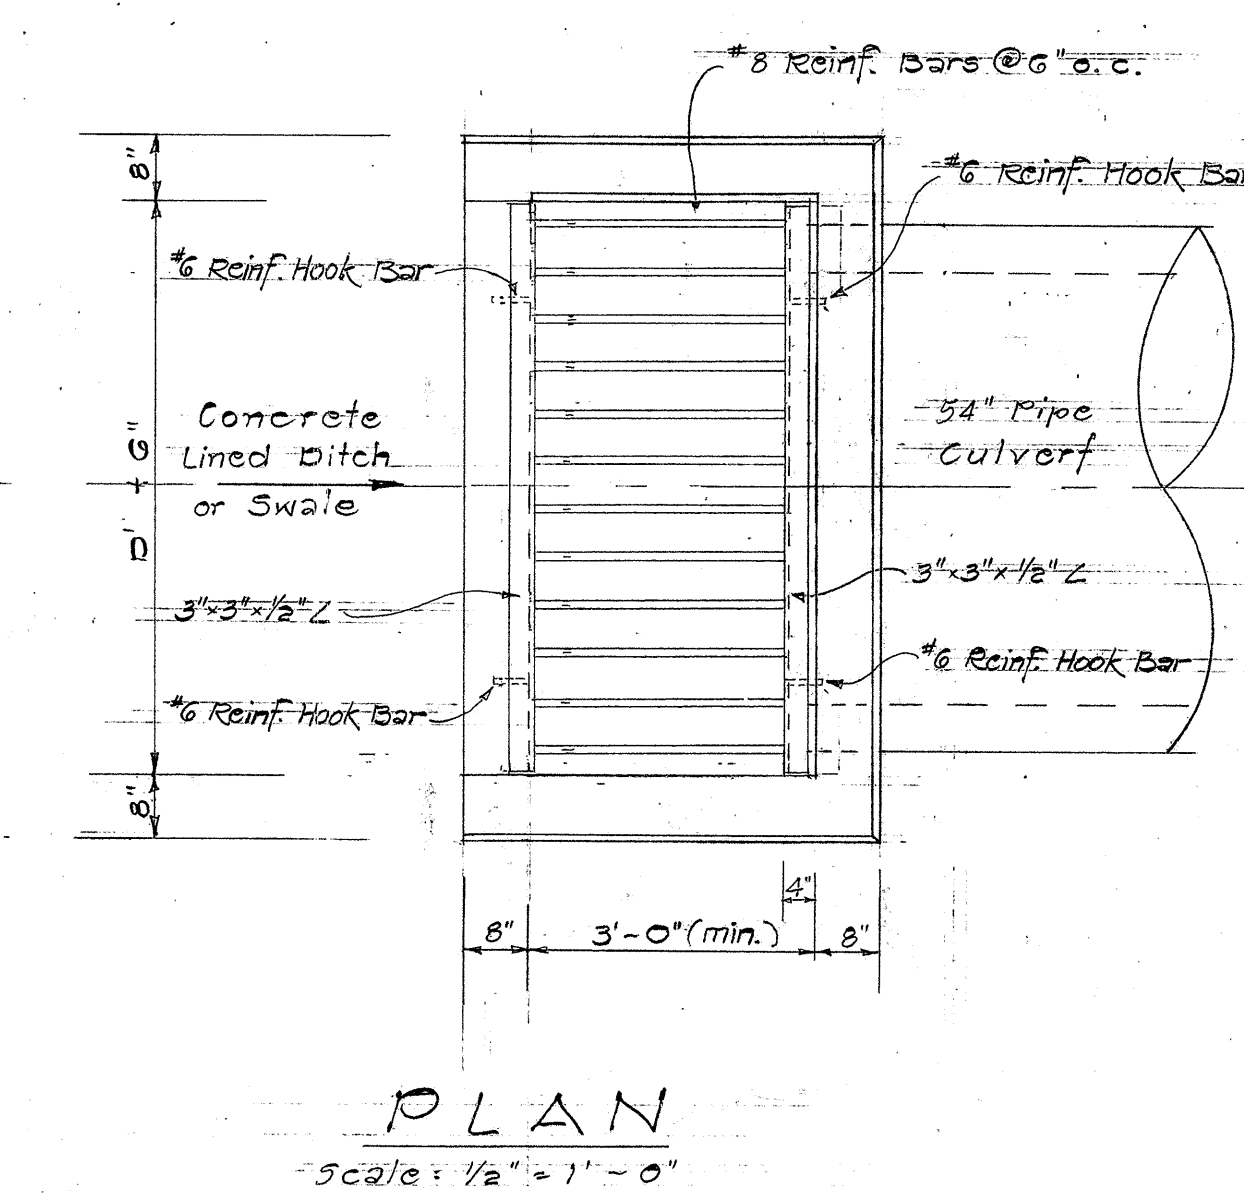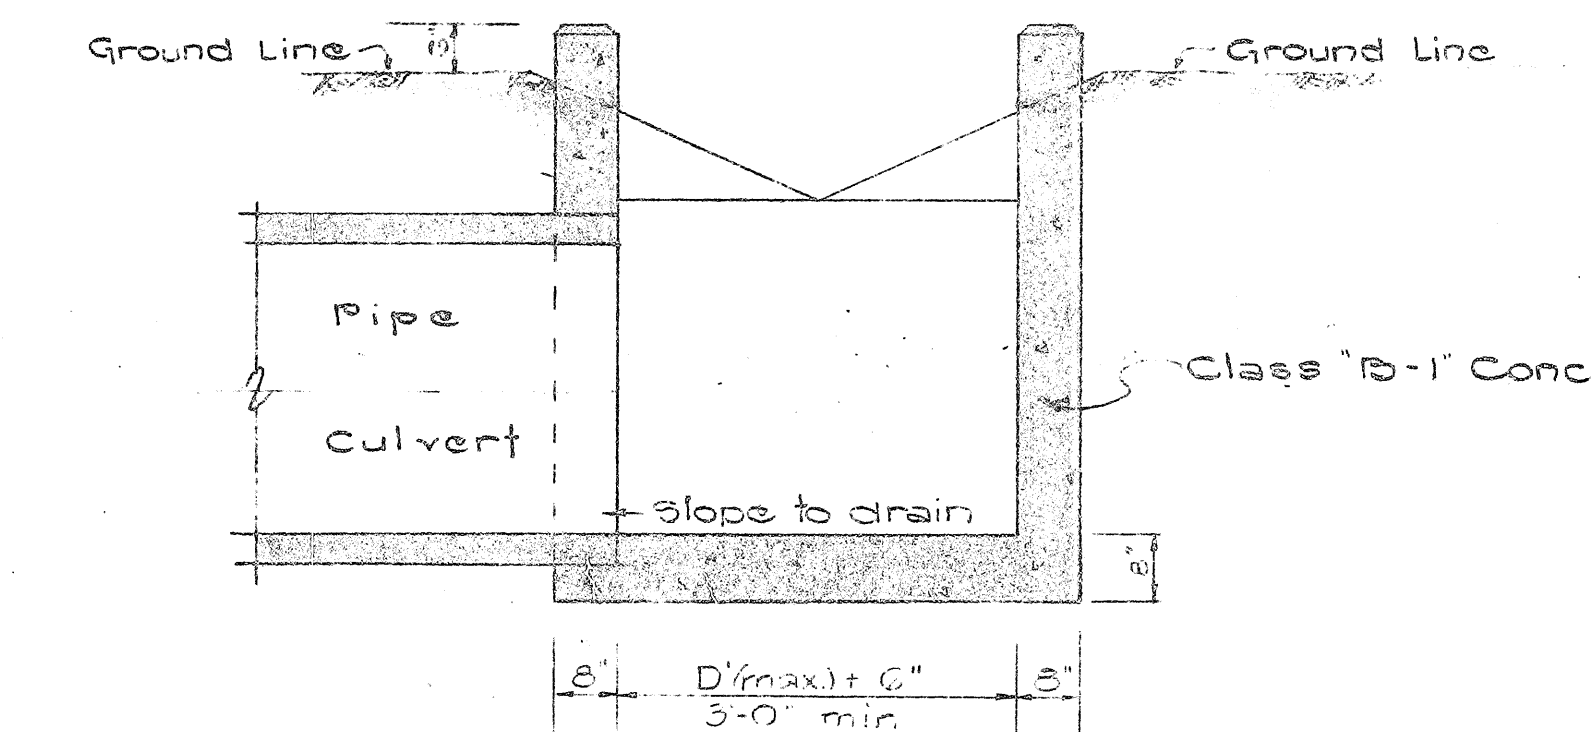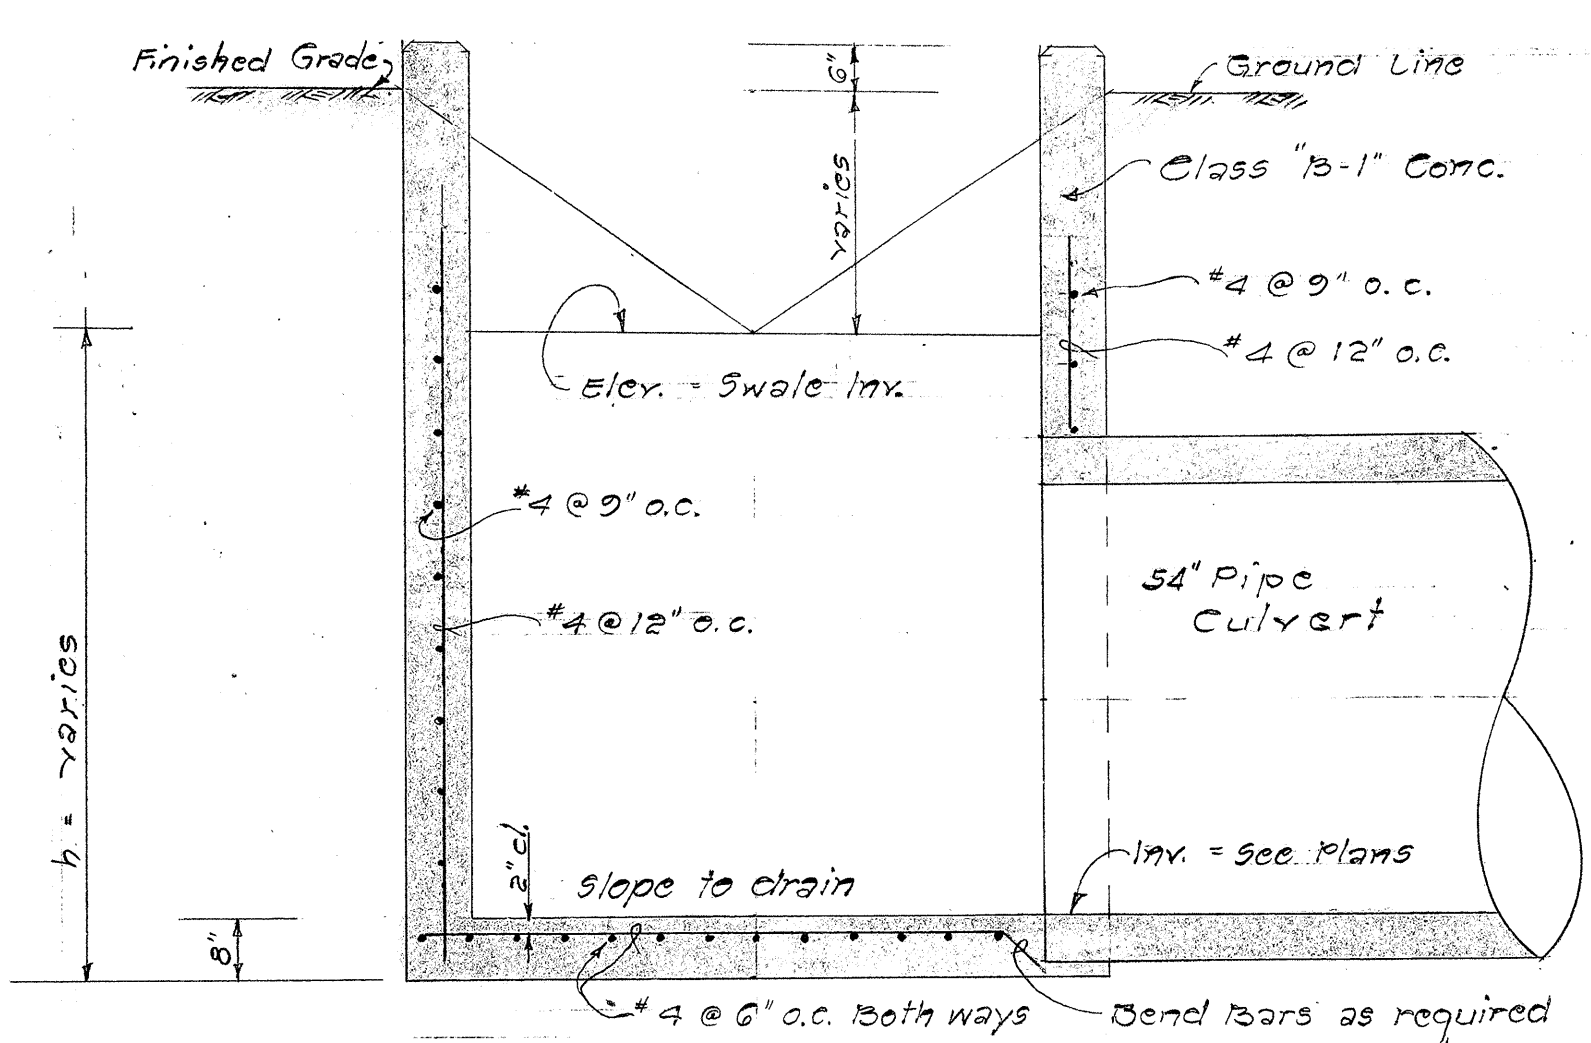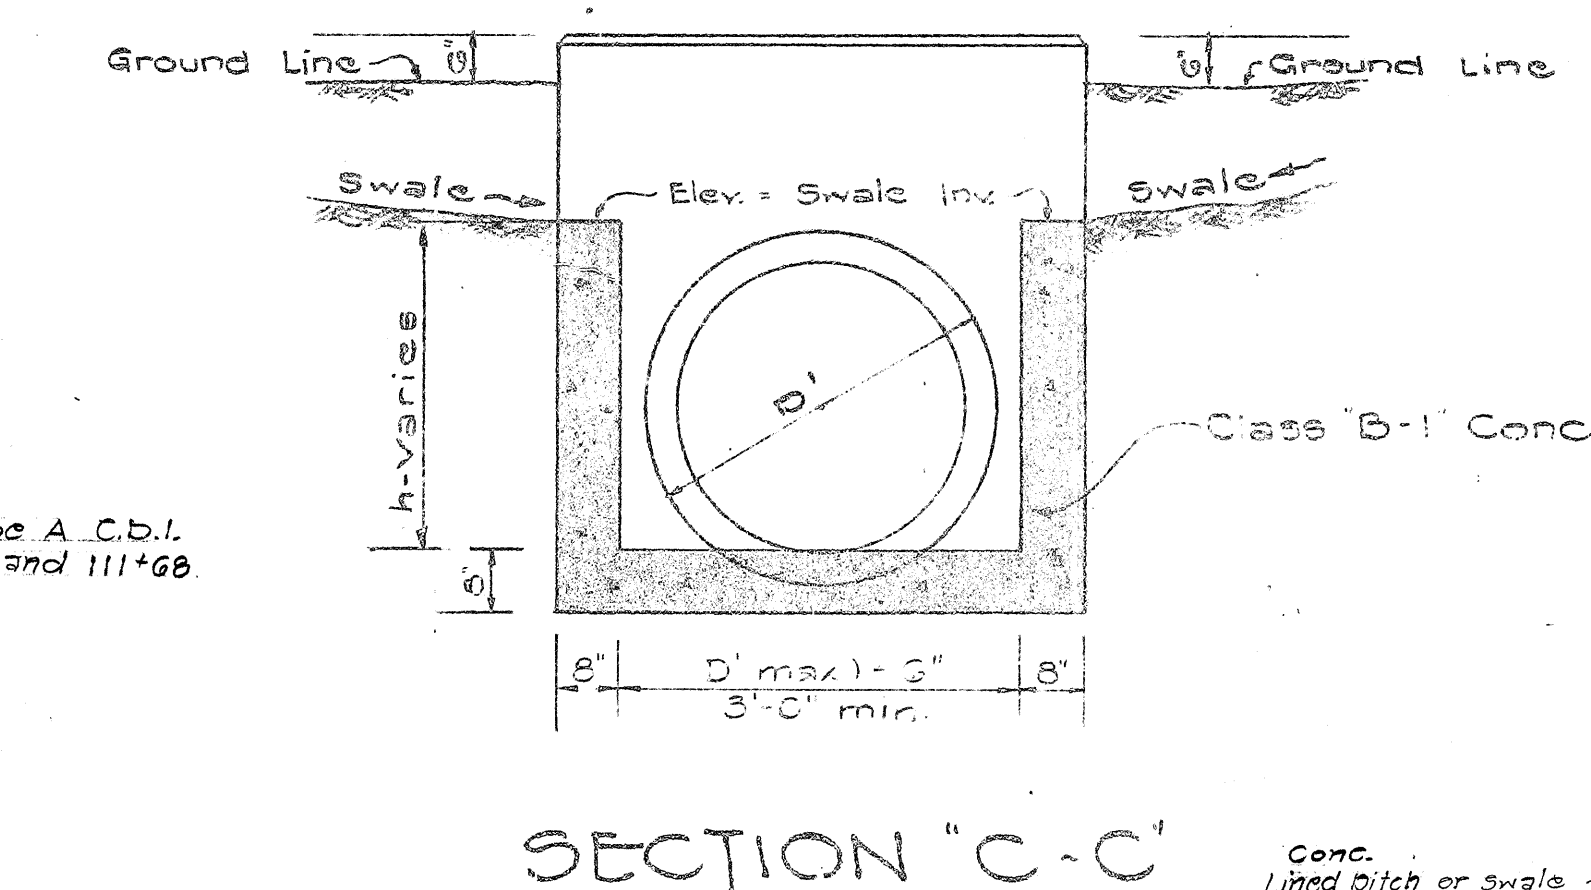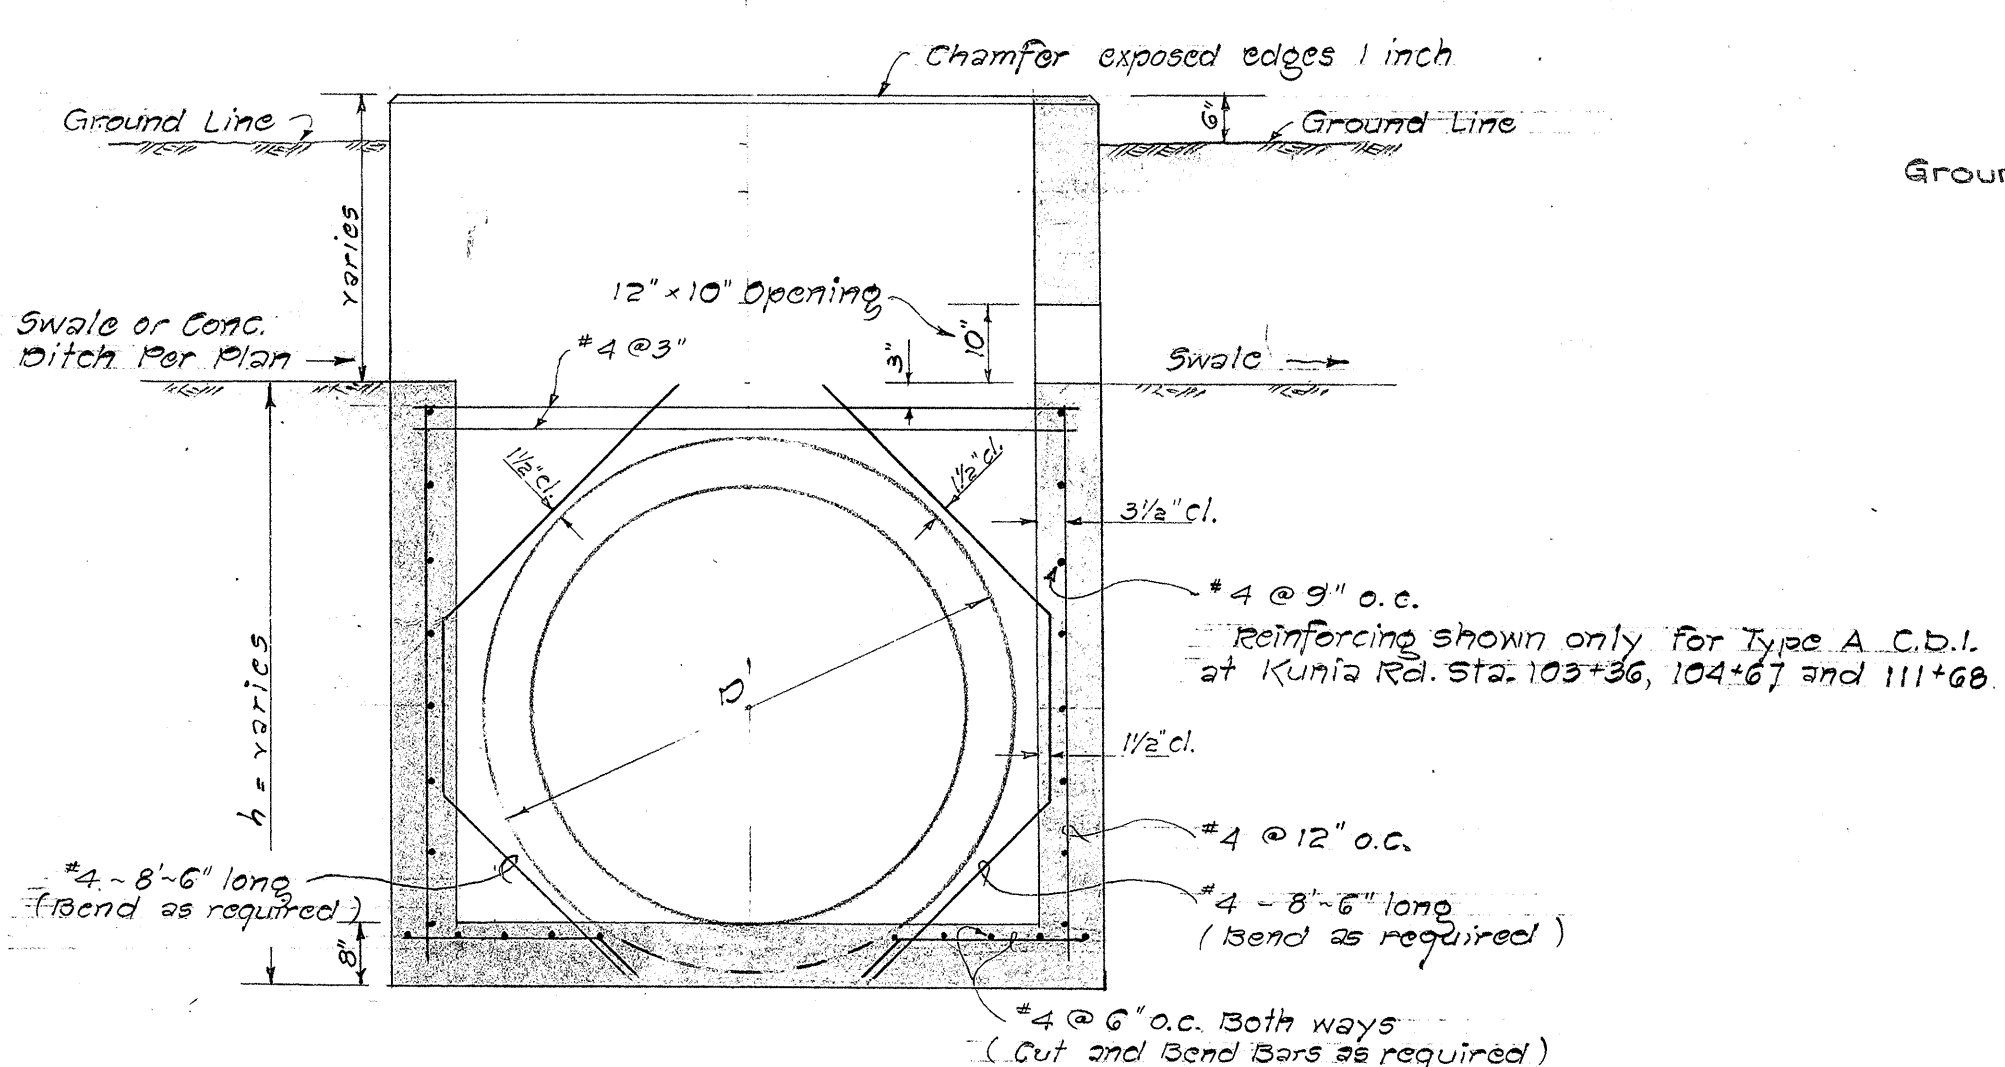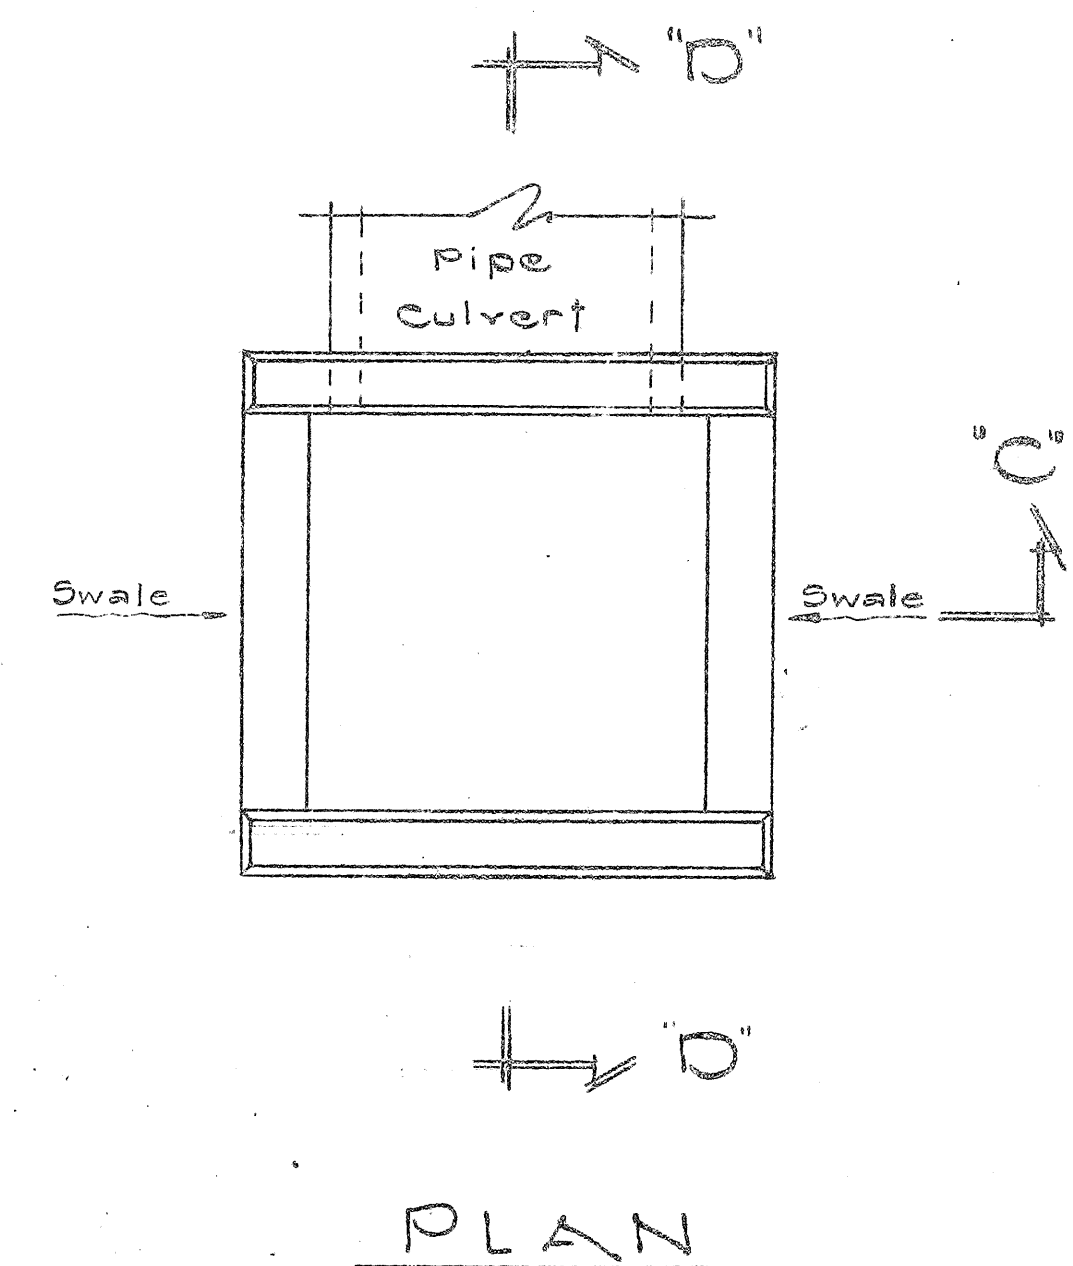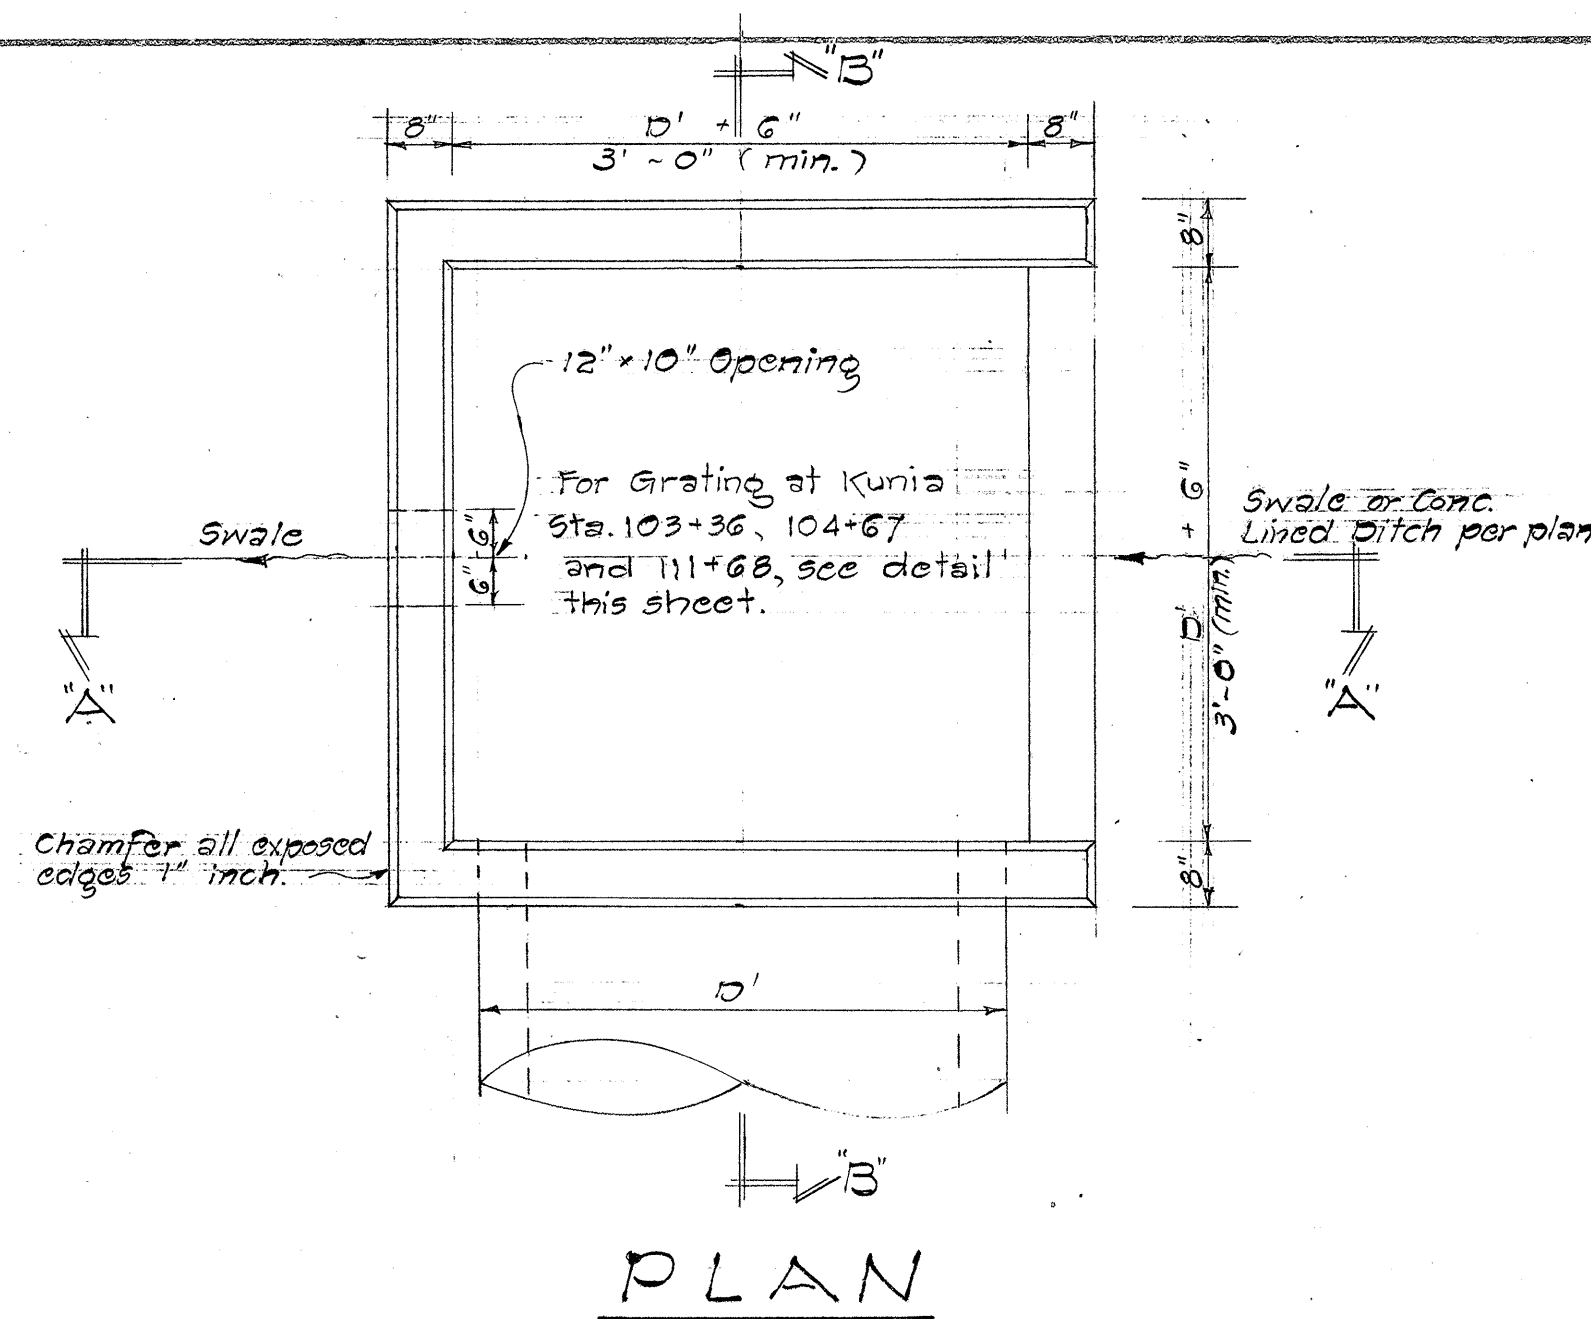

DETAILS OF GRATING FOR TYPE "A" C.D.I.
AT KUNIA RD. STA. 103+36, 104+67 AND 111+68
Scale: As Shown

- NOTE:
- All Conc. Drop Intake unreinforced except for Type "A" Conc. Drop Intakes at Kunia Rd. Sta. 103+36, 104+67 and 111+68.
 - Grating only for Conc. Drop Intakes at Kunia Sta. 103+36, 104+67 and 111+68.
 - 12' x 10' opening in rear wall not required when Conc. Drop Intake is located at termination of swale.
 - Standard Manhole Rings @ 16" o.c. shall be provided for structures having "h" greater than 3'-0" and shall be incidental to Class A-1 or B-1 Concrete.
 - Ditch Inv. and Swale Inv. shall be identical.

STATE OF HAWAII
DEPARTMENT OF TRANSPORTATION
HIGHWAYS DIVISION

DETAILS OF
CONCRETE DROP INTAKE TYPE "A", "B" AND
DETAIL OF GRATING FOR TYPE "A" CDI

INTERSTATE ROUTE H-1
F.A.I. PROJ. No. 1-HI-118, UNIT 2

Scale: As Shown Date: July, 1965


SHEET No. 5 OF 11 SHEETS

DATE	BY
PLAN	DESIGNED BY
NOTE BOOK	QUANTITIES BY
CHECKED BY	


TYPE "A"
CONCRETE DROP INTAKE
SCALE: 1/2" = 1'-0"

TYPE "B"
CONCRETE DROP INTAKE
SCALE: 1/2" = 1'-0"


FED. ROAD DIST. NO.	STATE	FED. AID PROJ. NO.	FISCAL YEAR	SHEET NO.	TOTAL SHEET
HAWAII	HAW.	I-HI-1(18) FINIT 2	1965	43	75

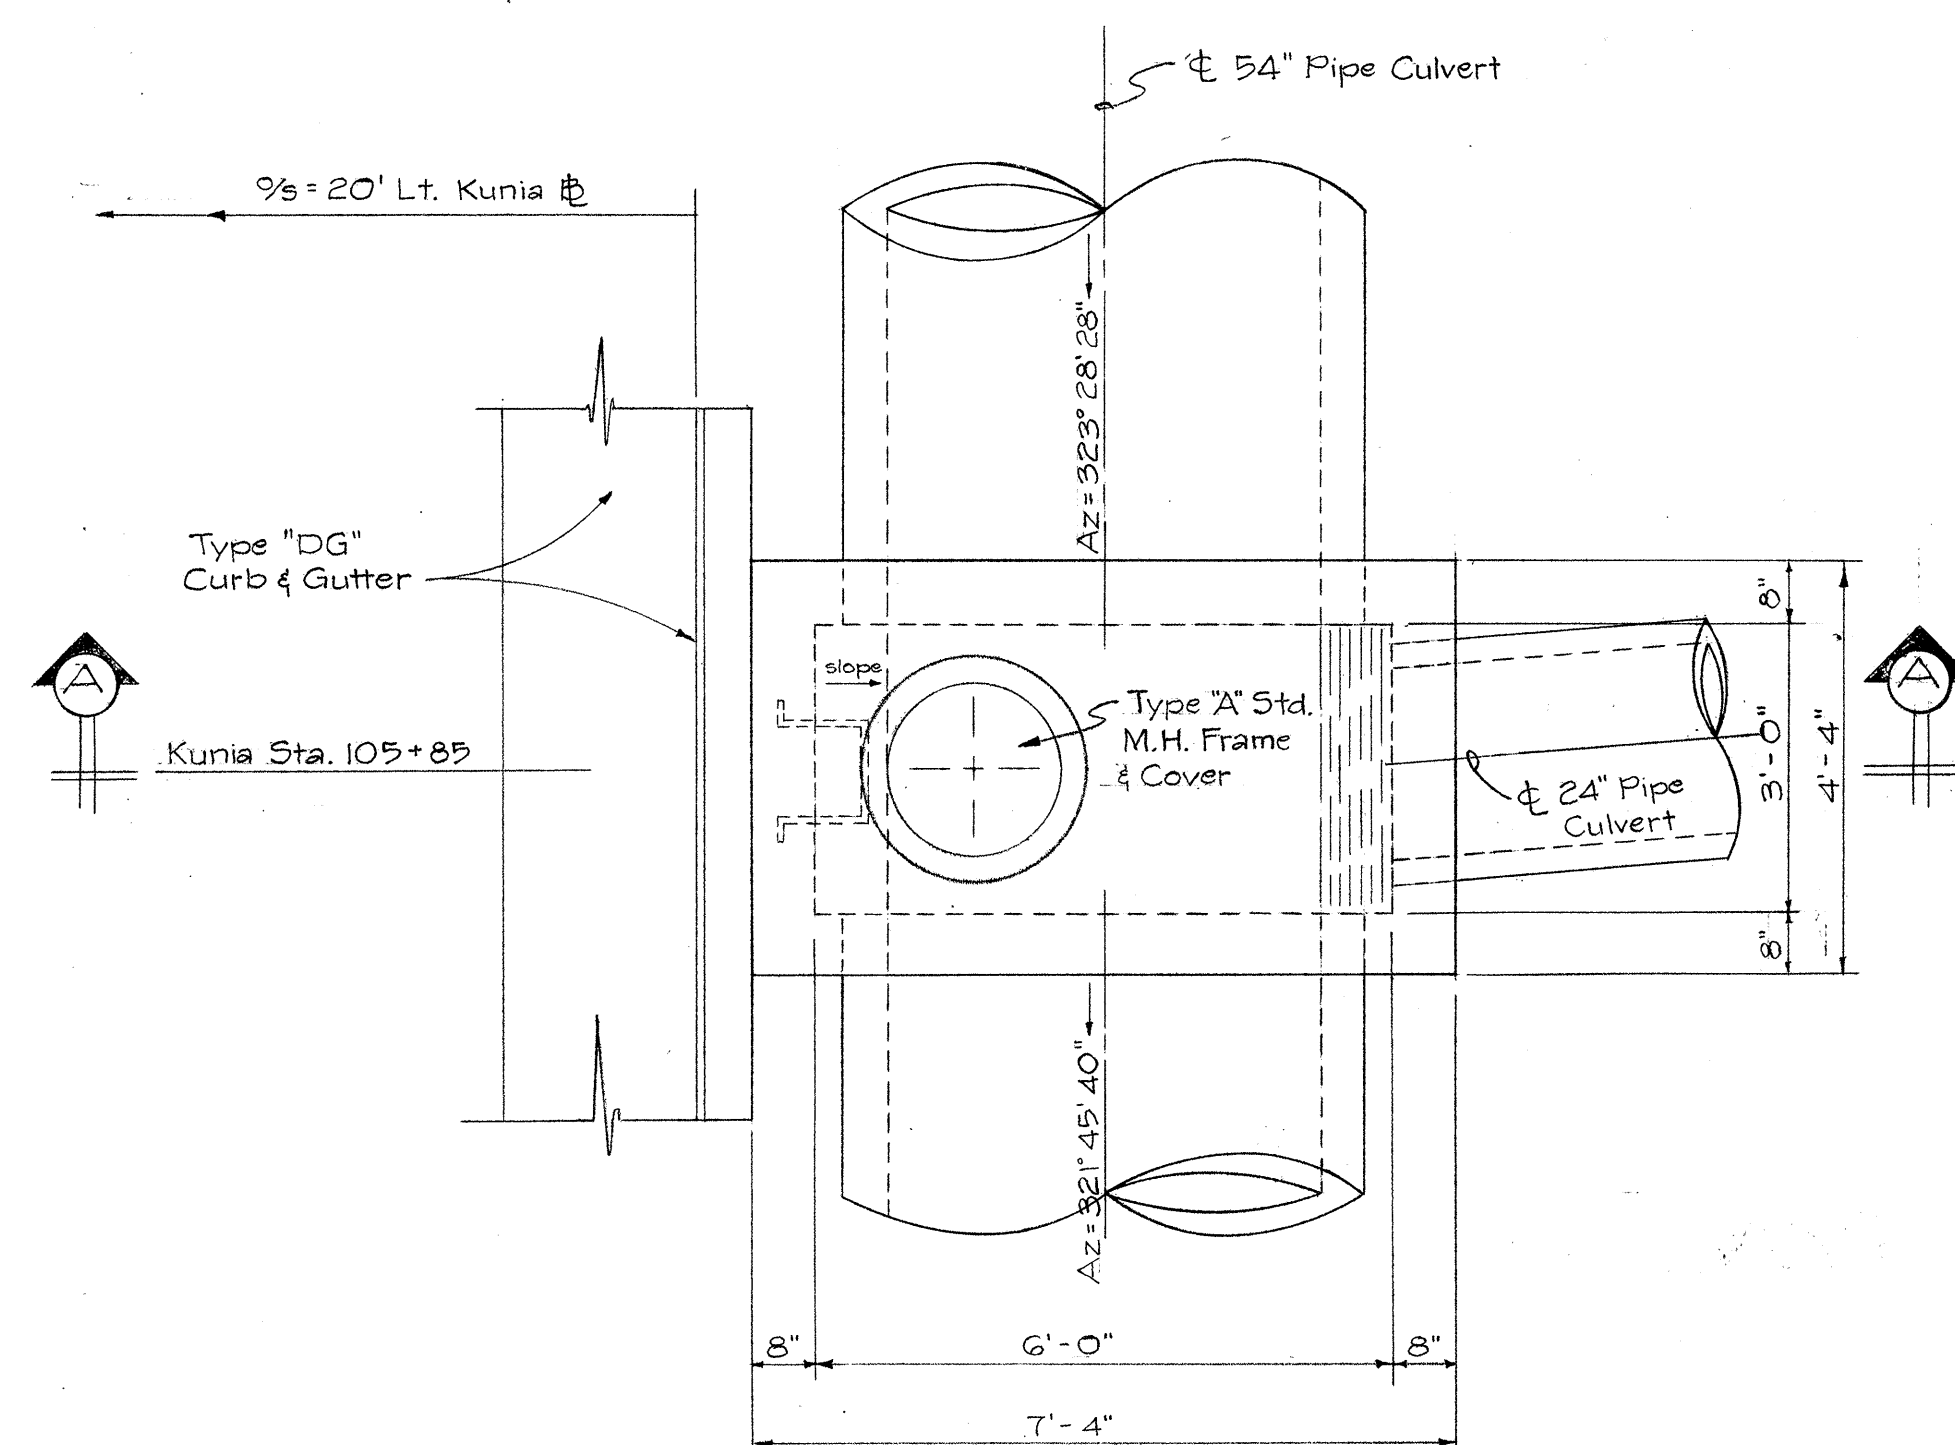


PLAN

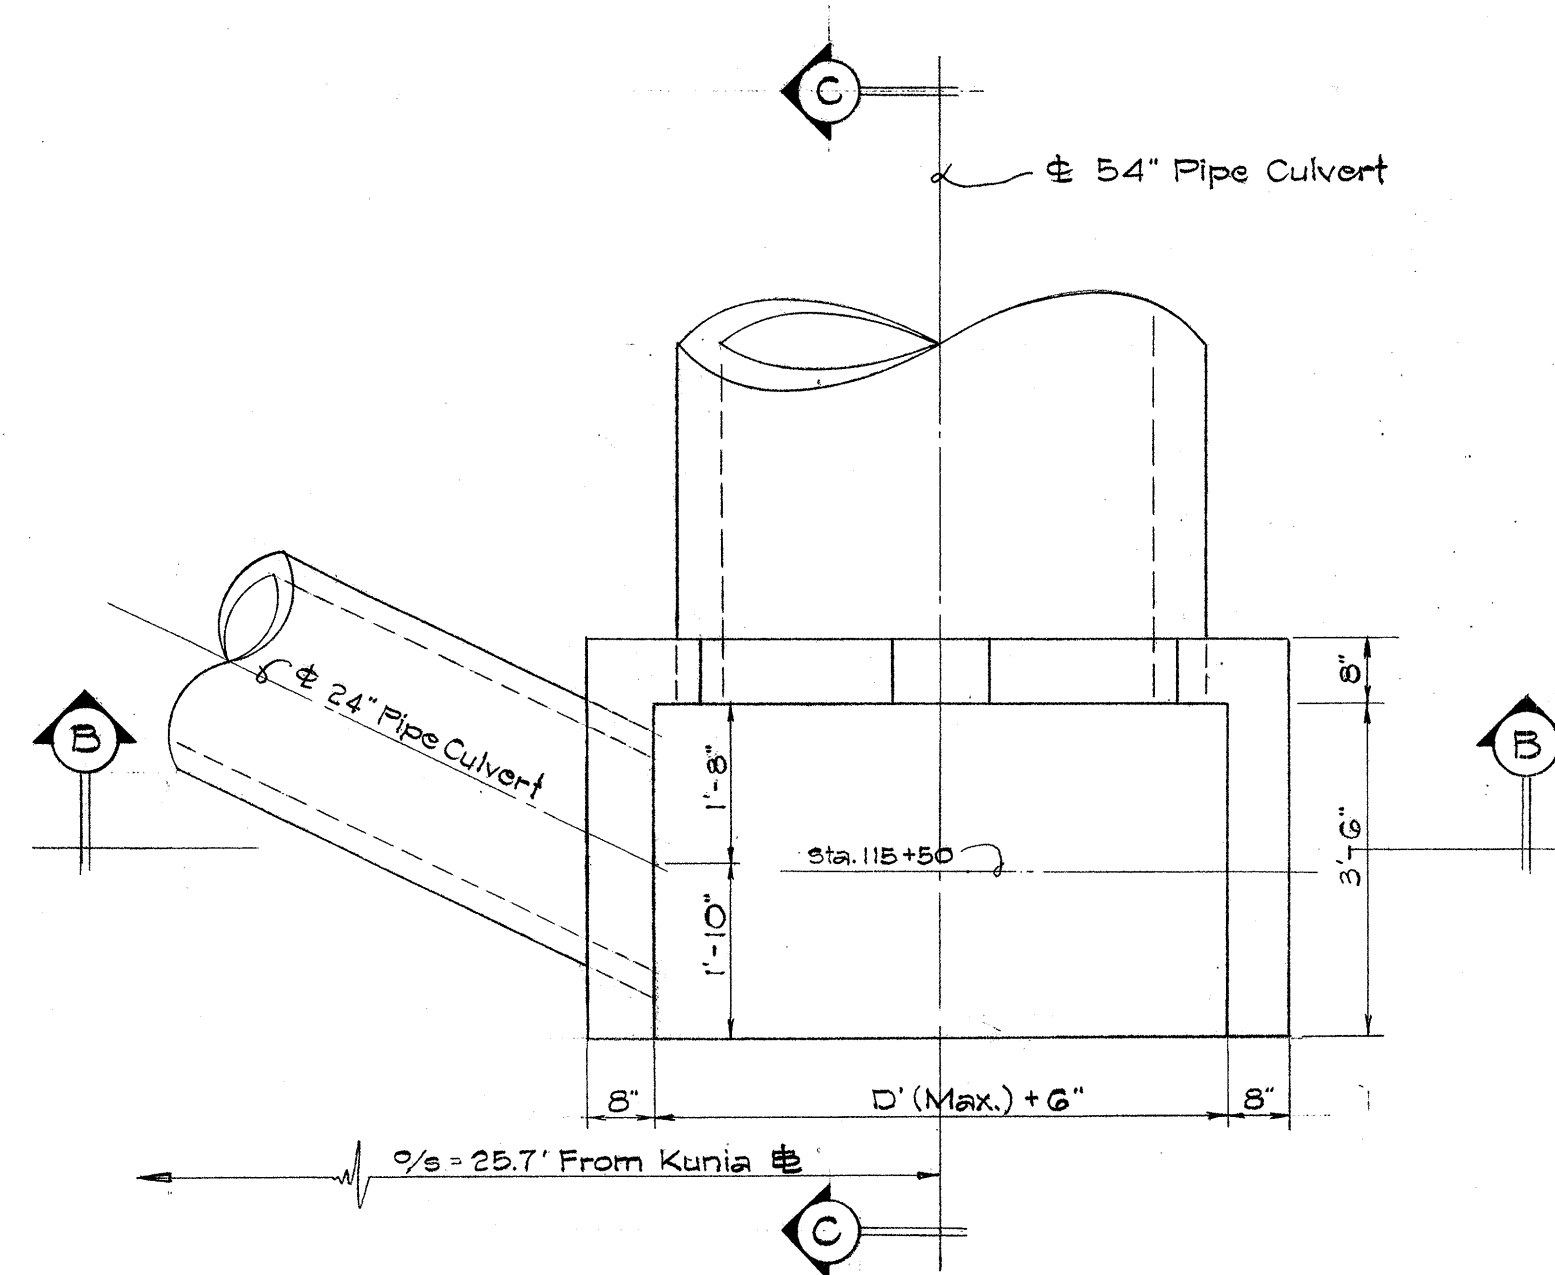


PLAN

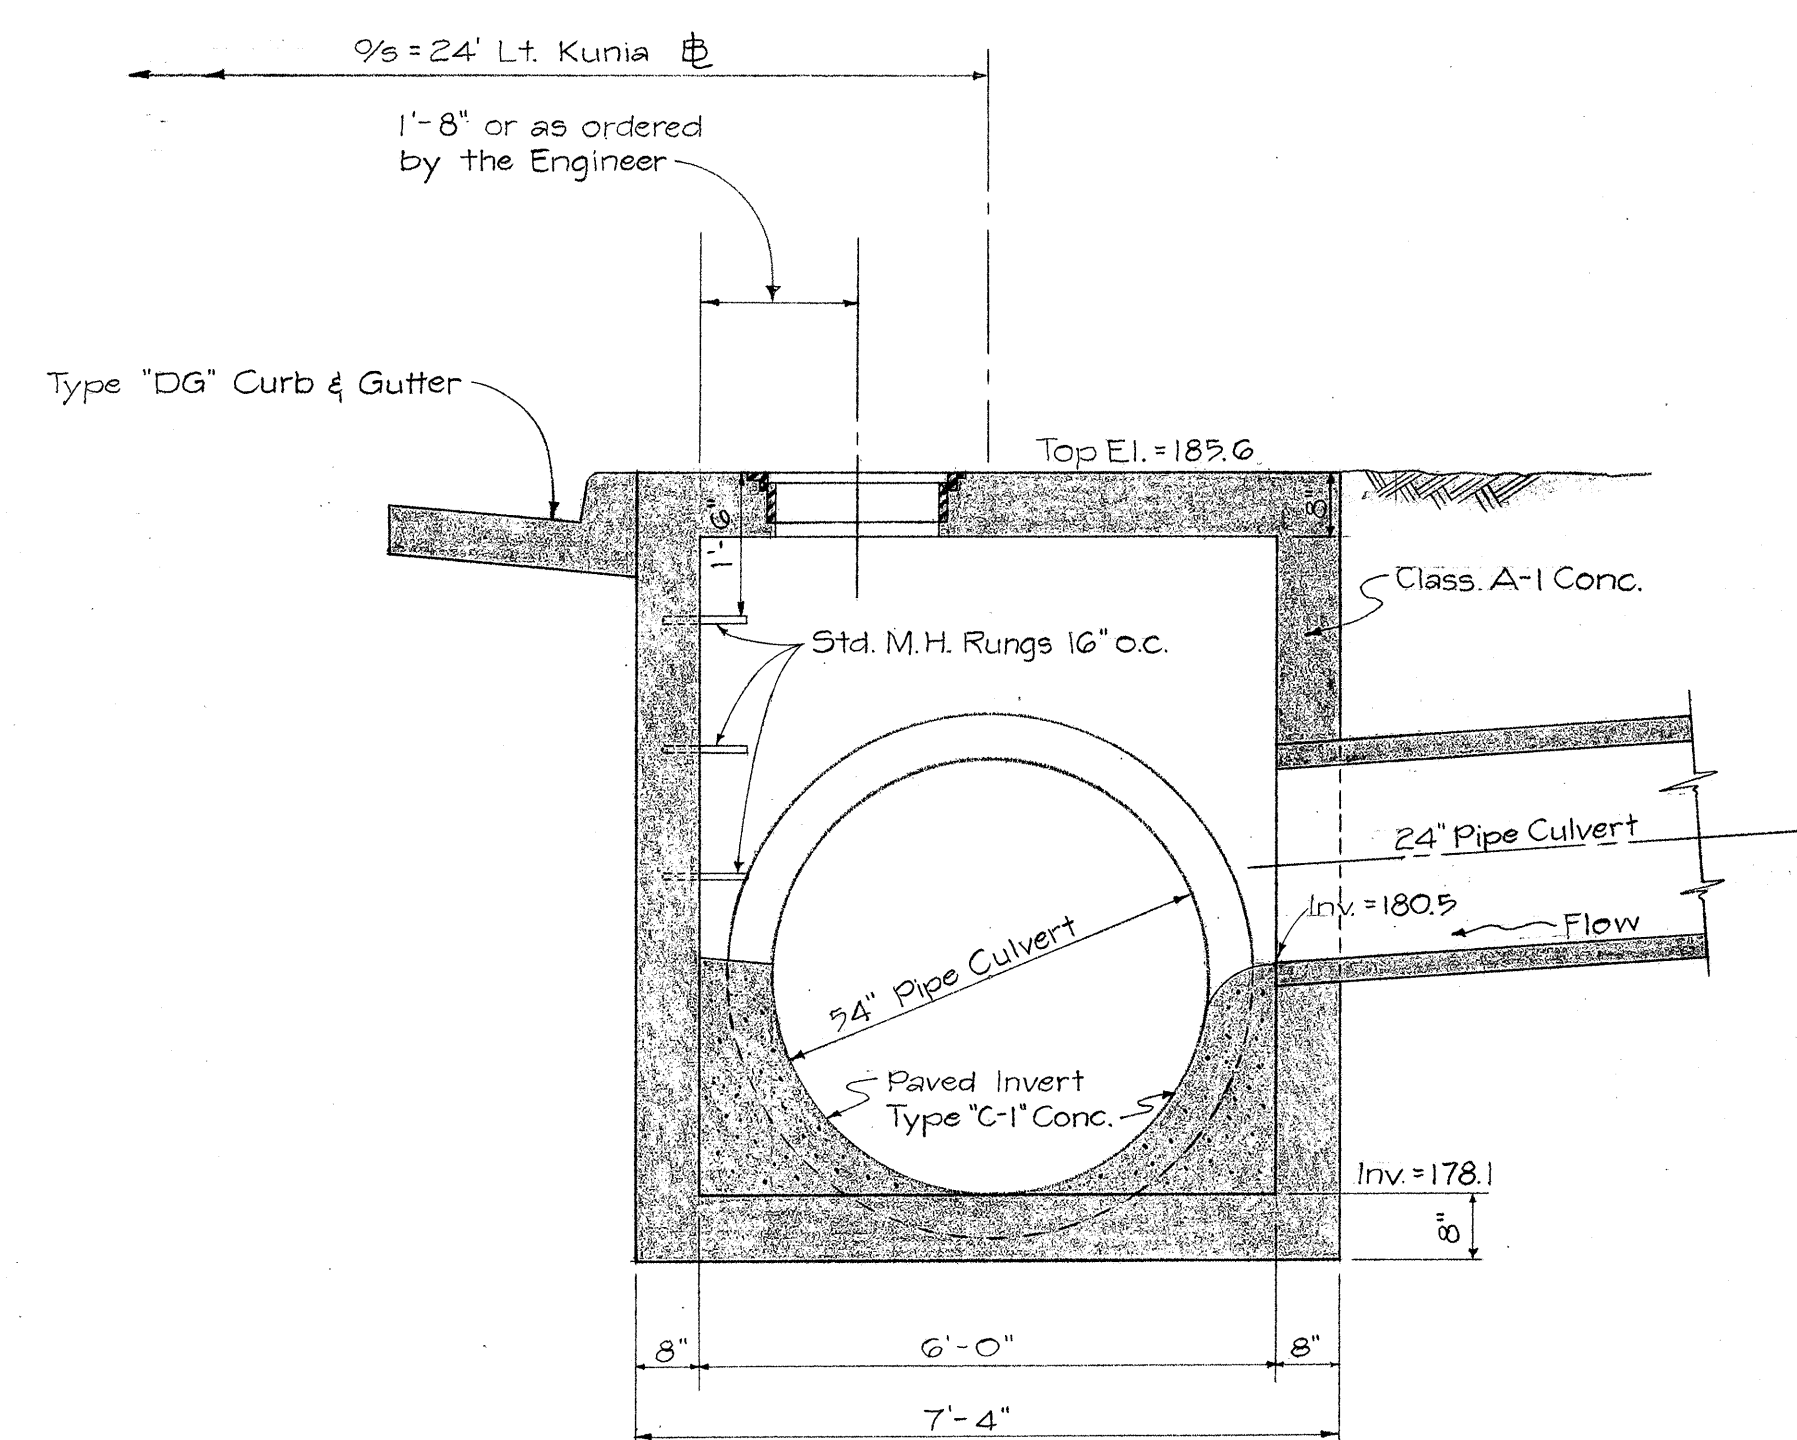

SECTION "A-A"

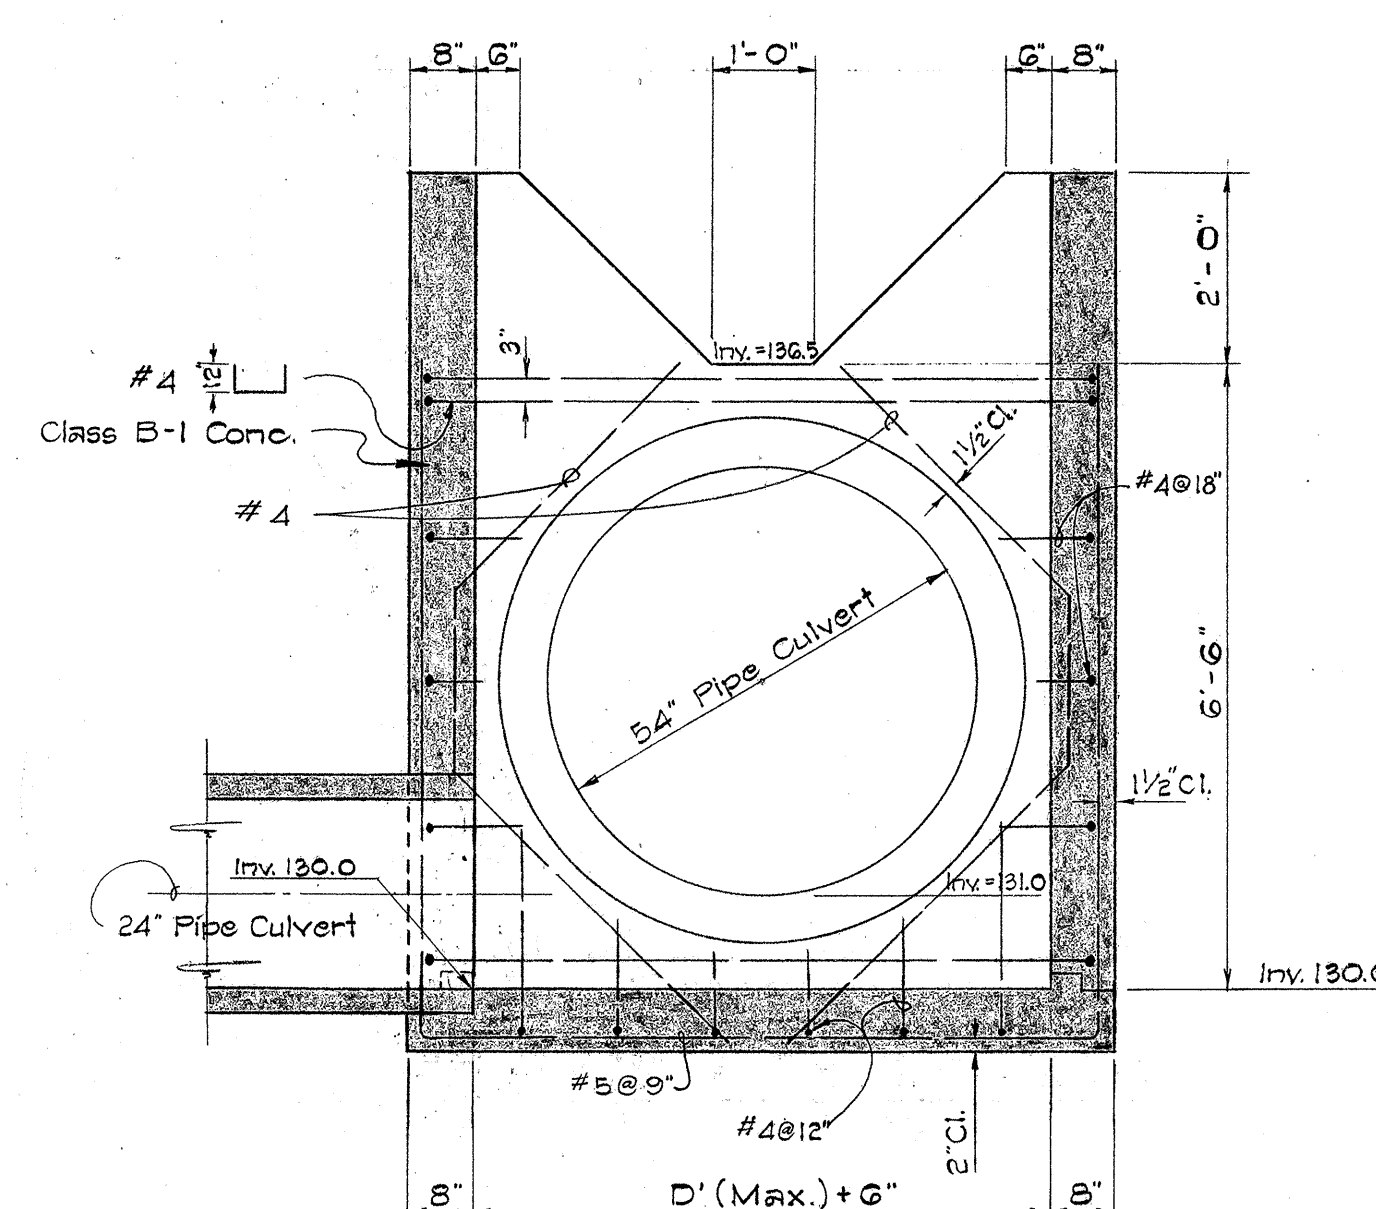

SECTION "B-B"

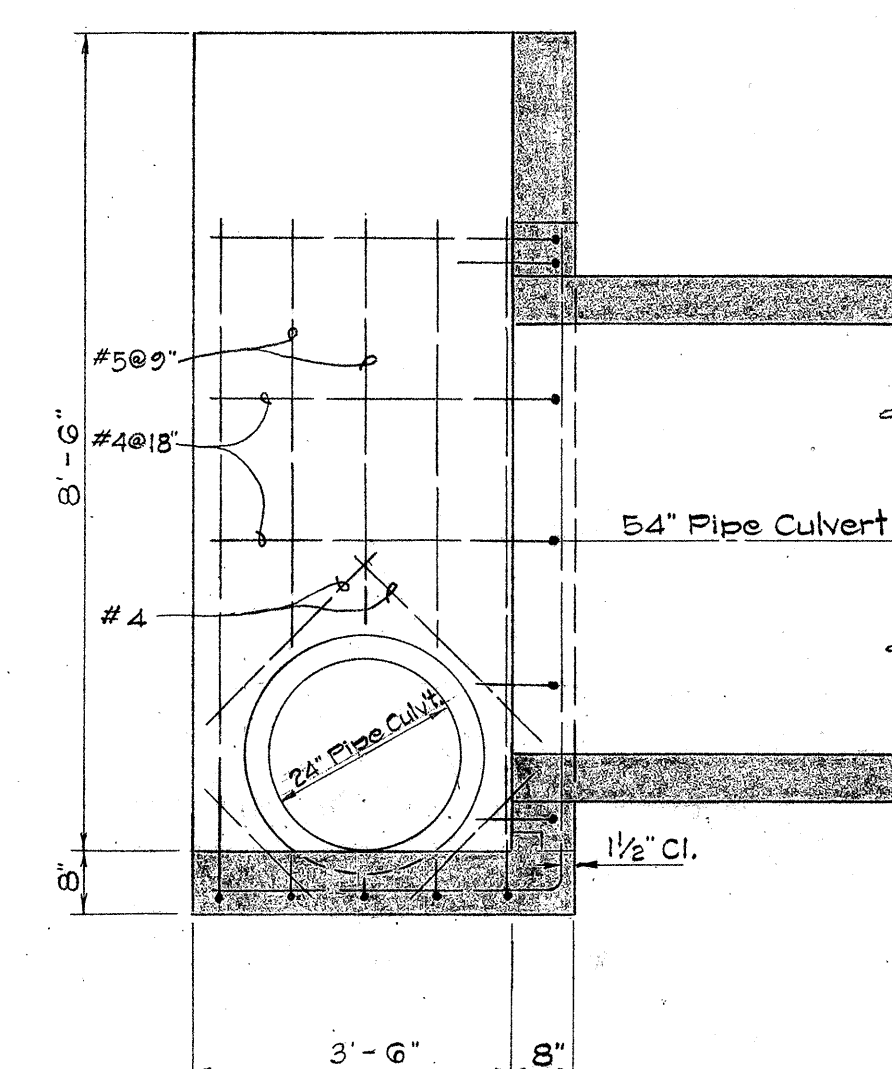

SECTION "C-C"

NOTE:

1. Dimensions and reinforcing steel identical to Type "C" S.D.M.H. unless otherwise noted.
2. Class "C-1" concrete shall be incidental to class "A-1" Concrete.

MODIFIED TYPE "C" SDMH
AT KUNIA STA. 105+85

Scale: $\frac{1}{2}'' = 1' - 0''$

SPECIAL
CONC. HEAD WALL AT KUNIA STA. 115 + 50

Scale: $1/2" = 1' - 0"$



STATE OF HAWAII
DEPARTMENT OF TRANSPORTATION
HIGHWAYS DIVISION

DRAINAGE DETAILS
MODIFIED TYPE "C" SDMH
AND CONCRETE HEADWALL



INTERSTATE ROUTE H-1
F.A.I. PROJ. No. I-HI-1(18) UNIT 2

Scale: As shown Date: July 1965


SHEET No. 6 OF 11 SHEETS

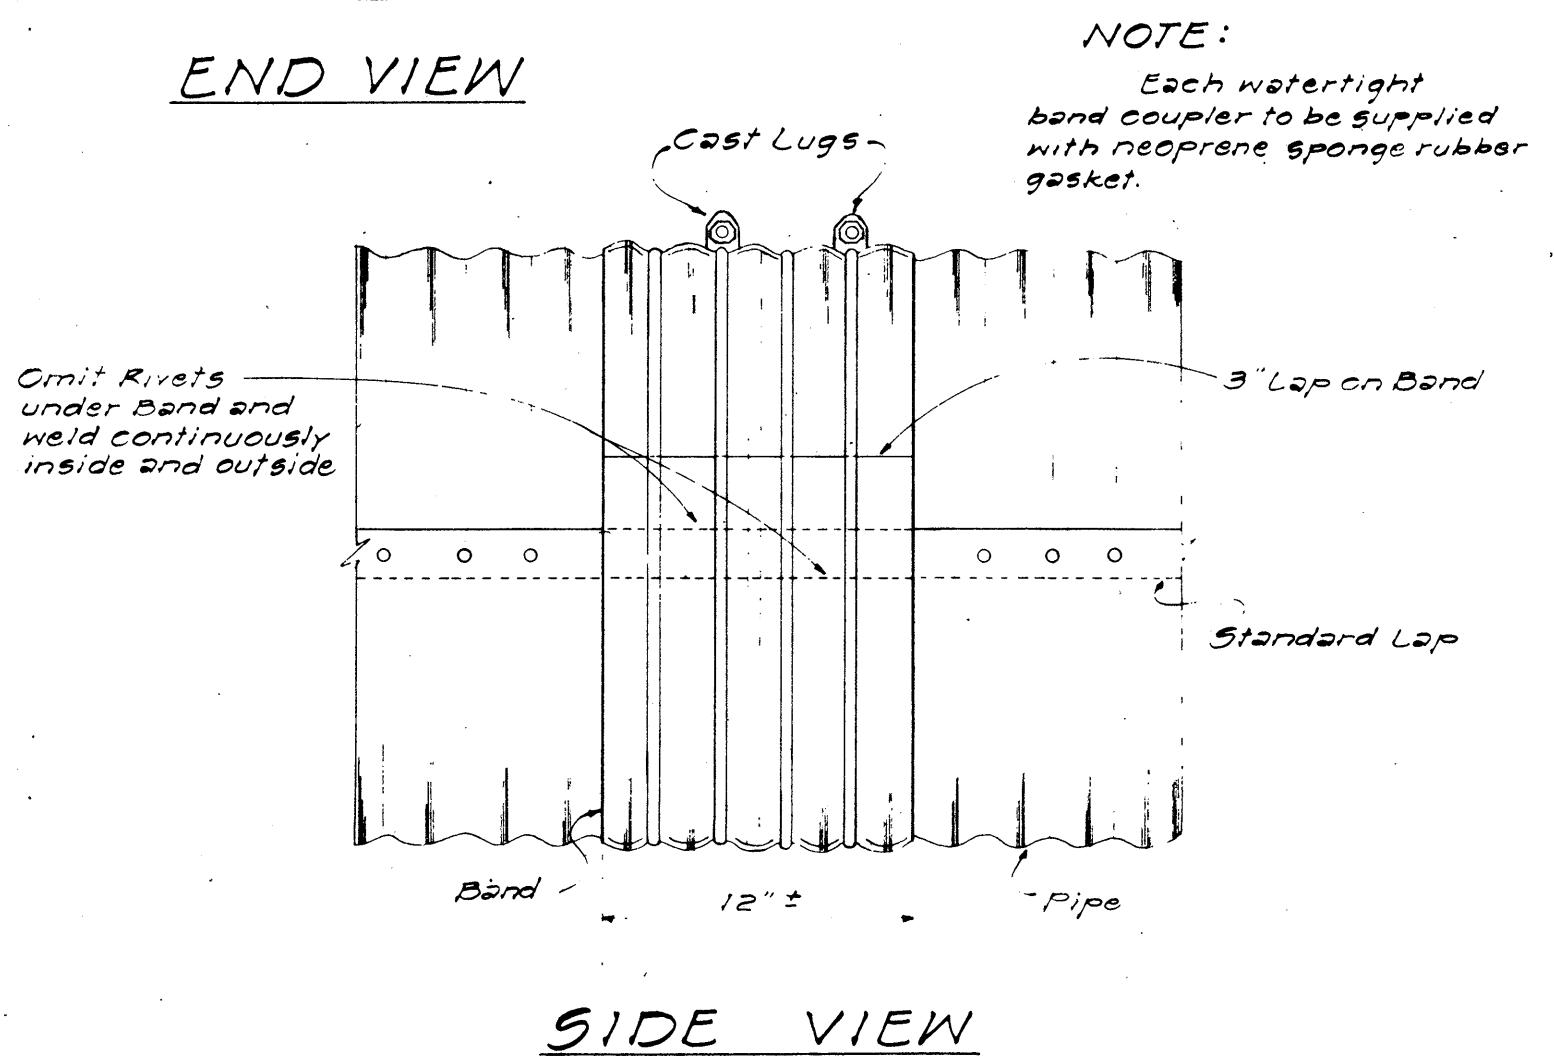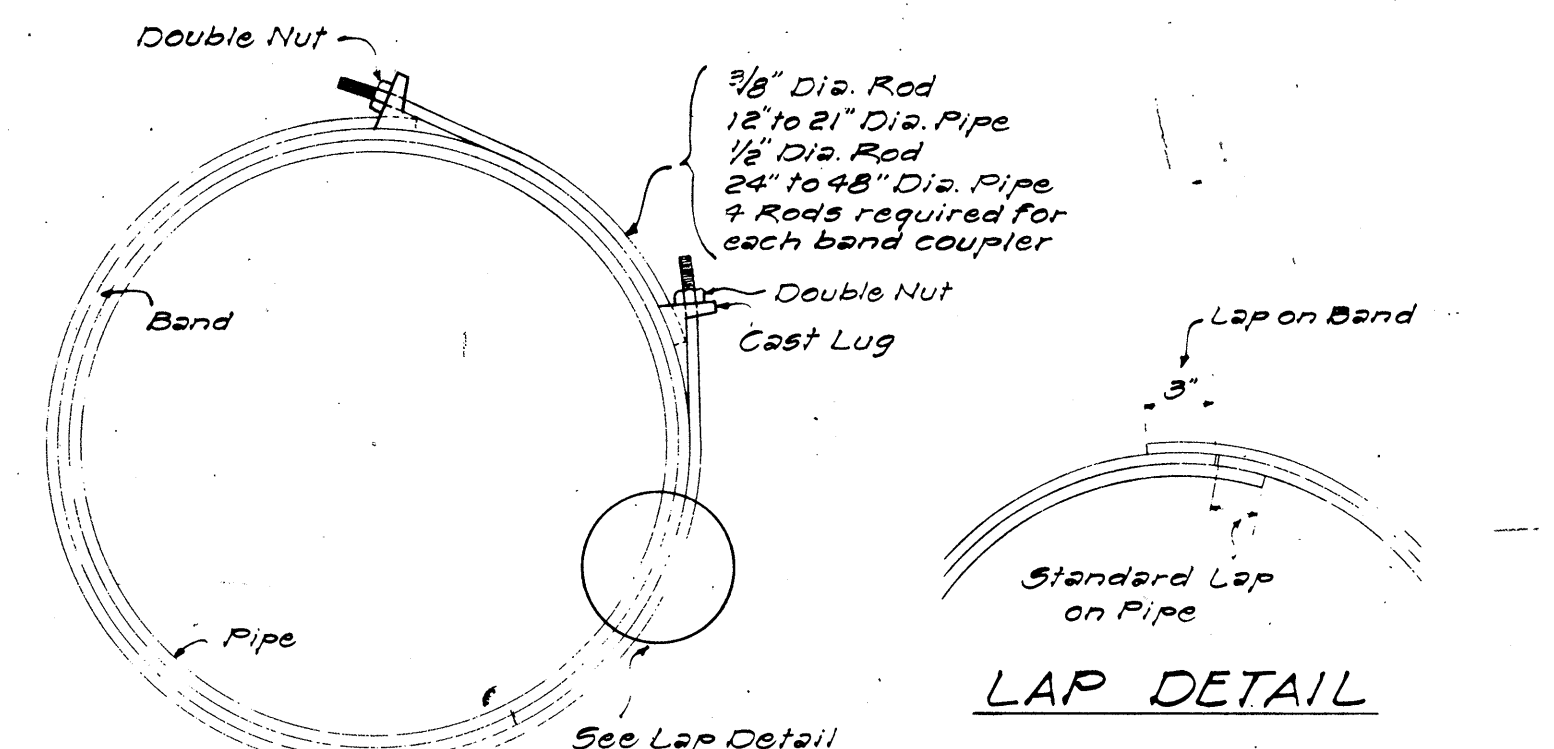



DETAIL OF WATERTIGHT BAND COUPLER
NOT TO SCALE

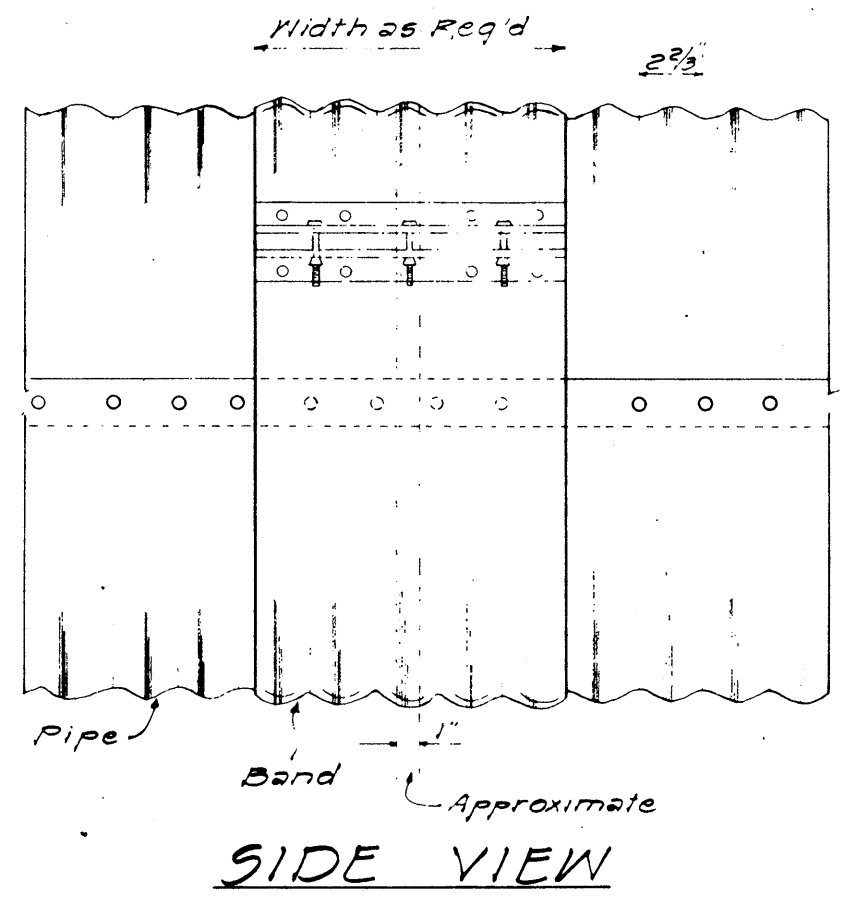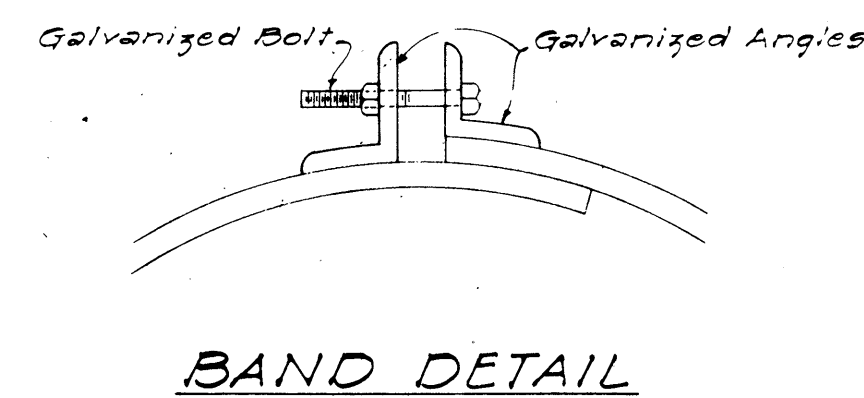



DETAIL OF STANDARD BAND COUPLER
NOT TO SCALE

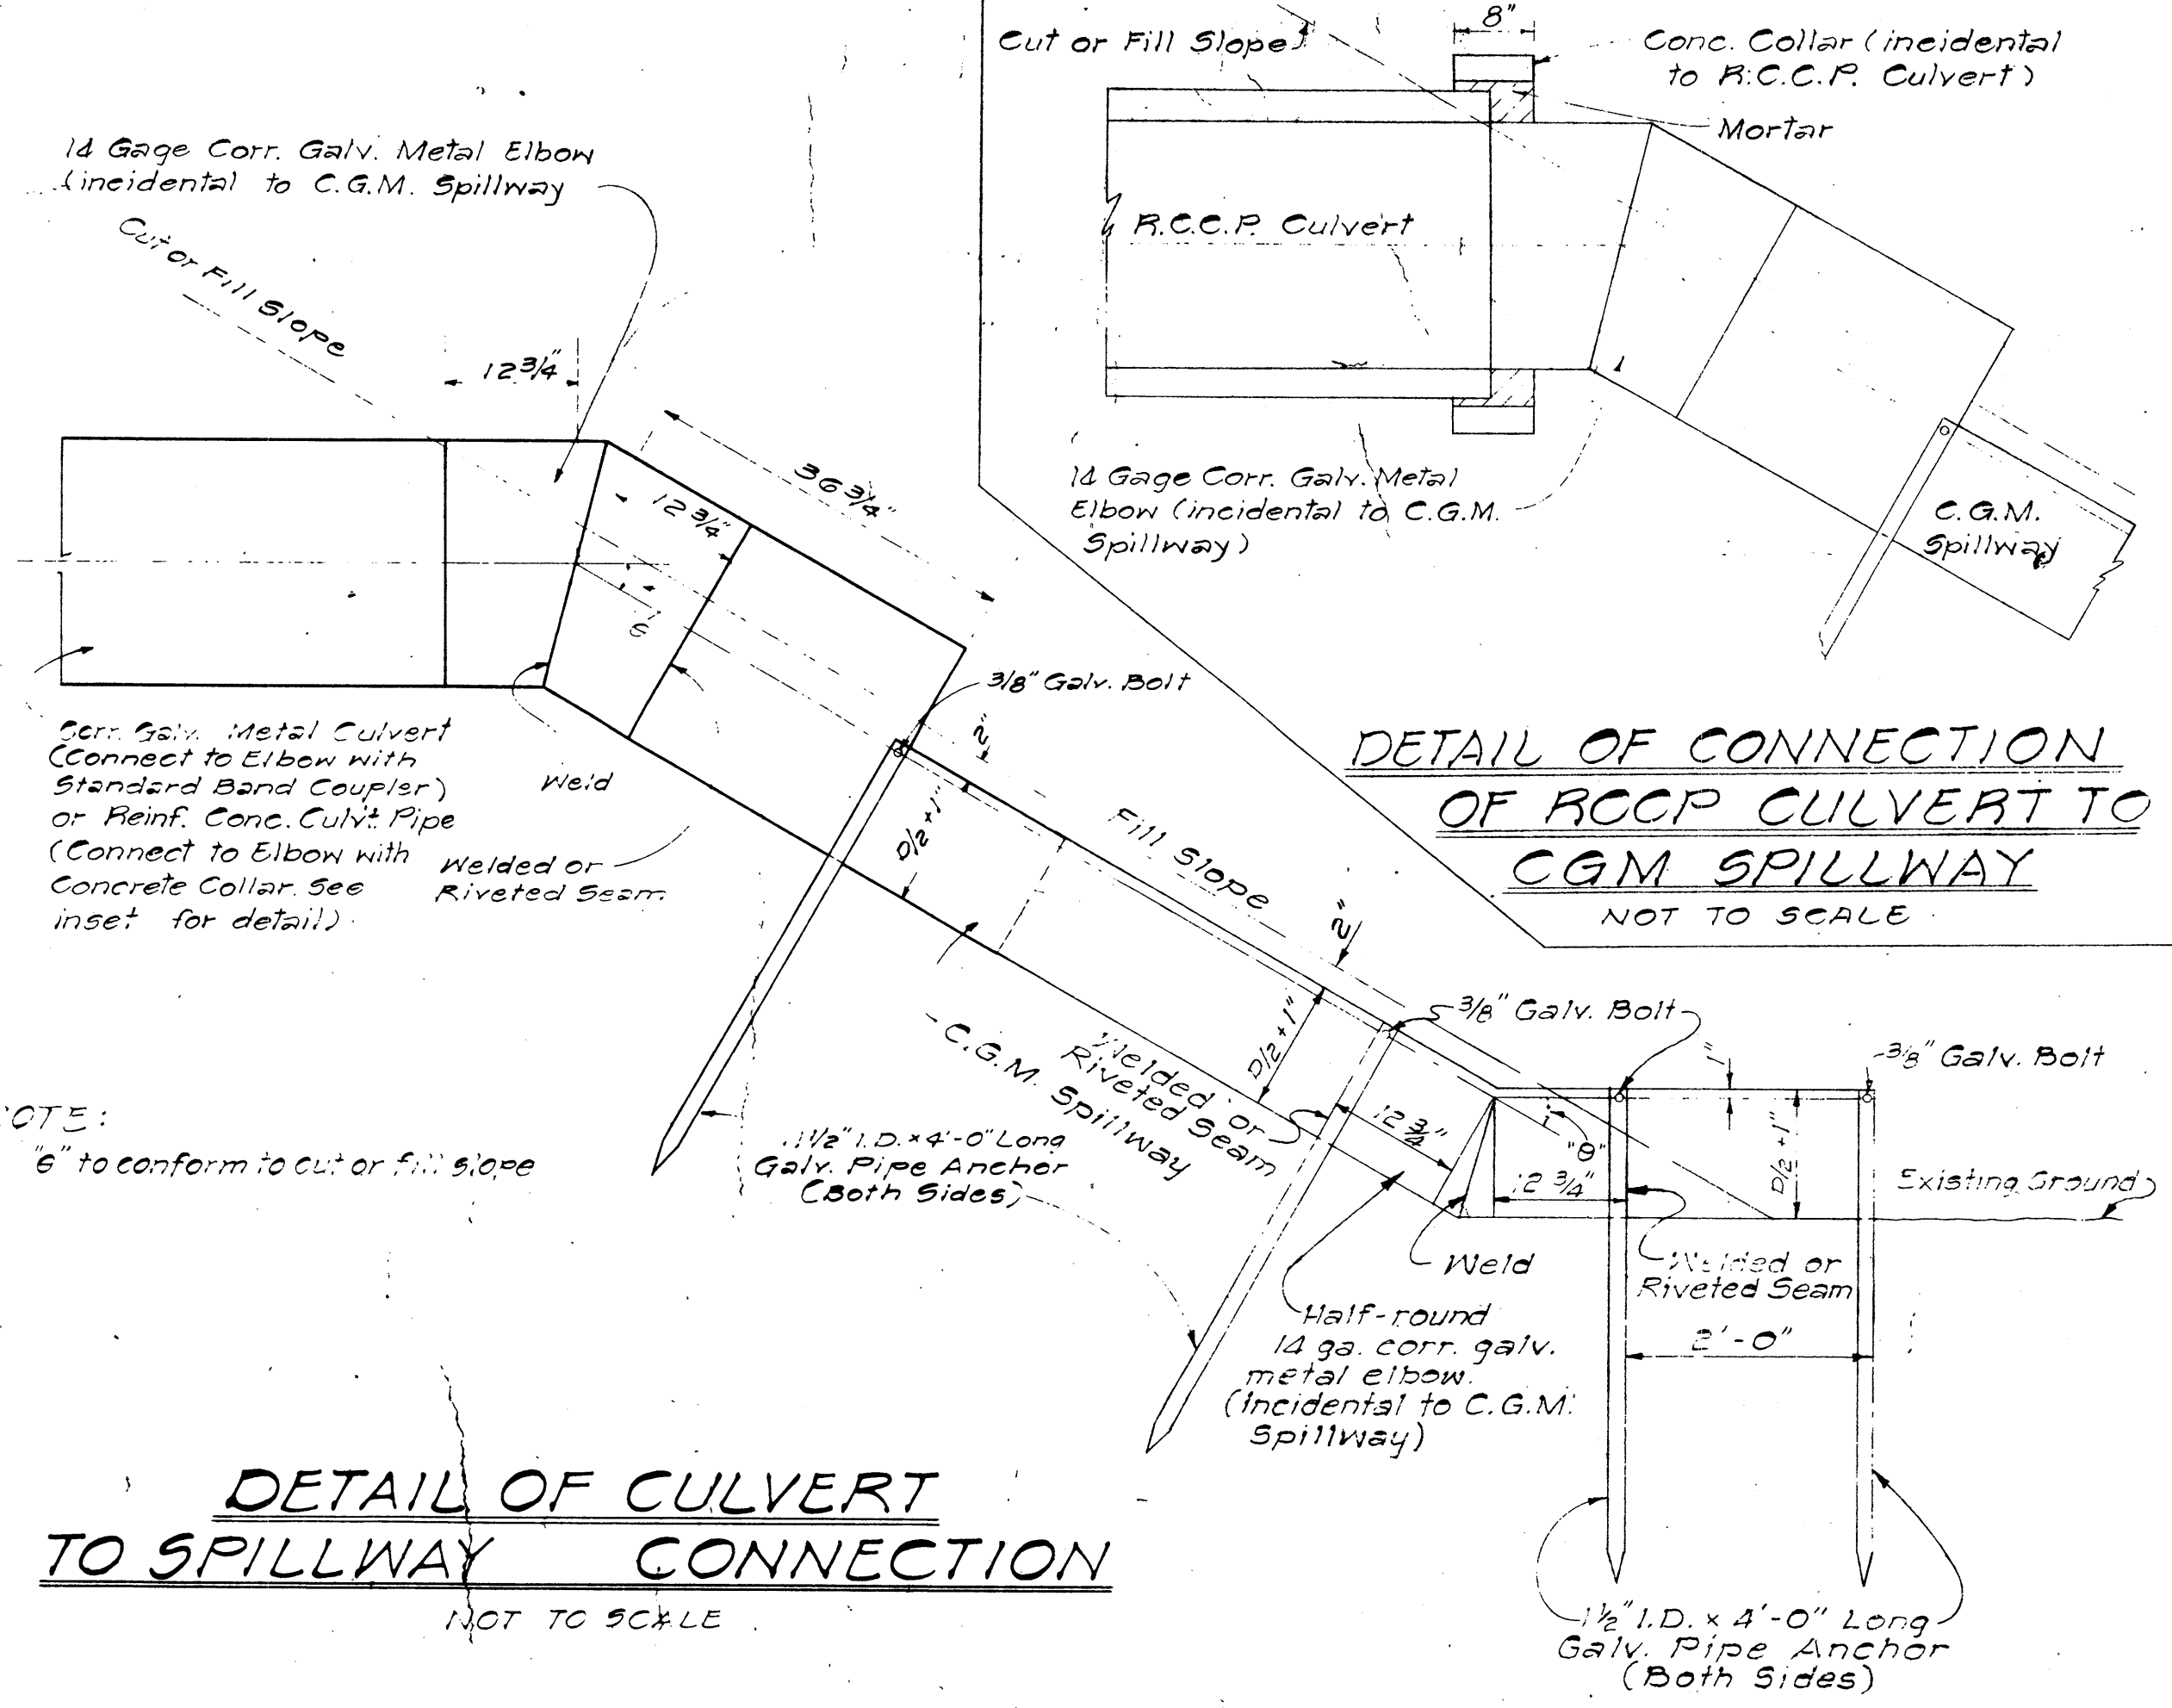

DETAIL OF CULVERT TO SPILLWAY CONNECTION
NOT TO SCALE

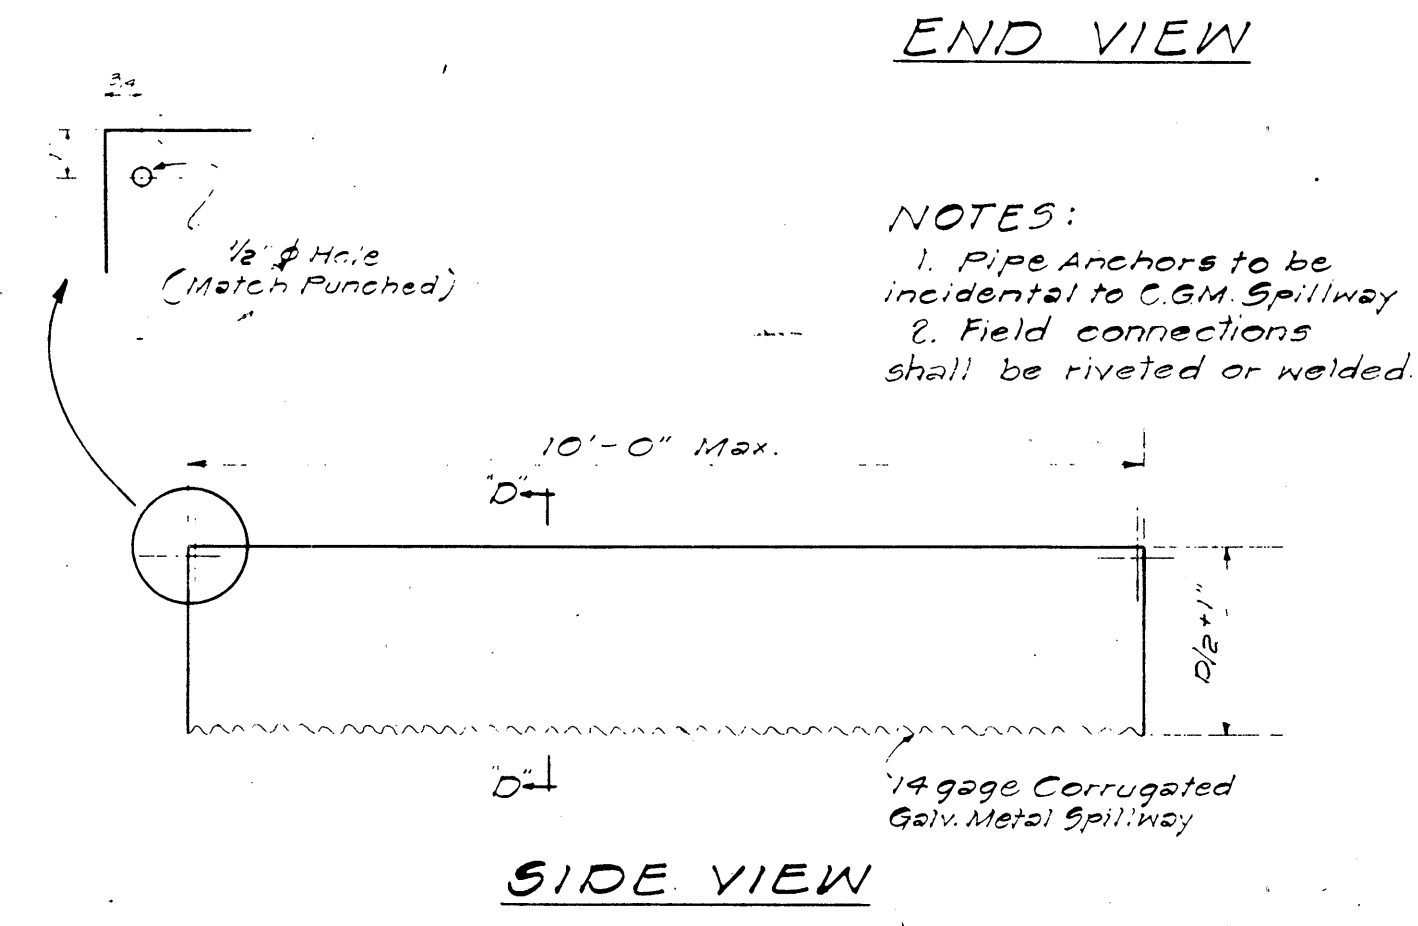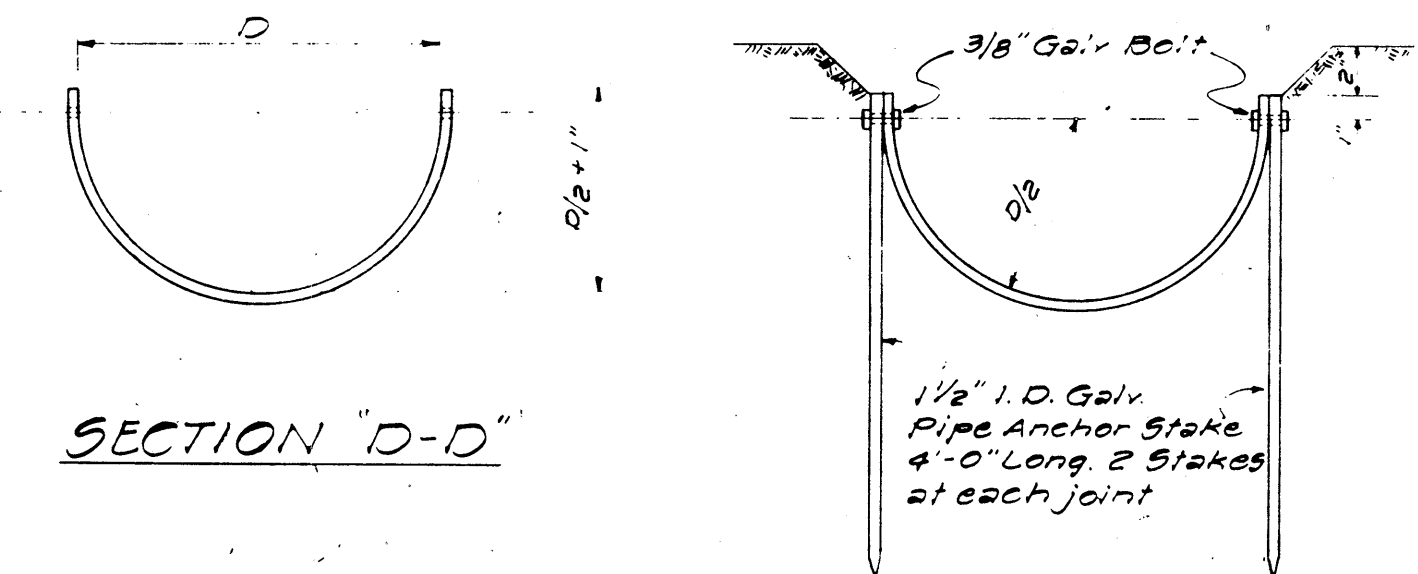



STD. C G.M. SPILLWAY
NOT TO SCALE

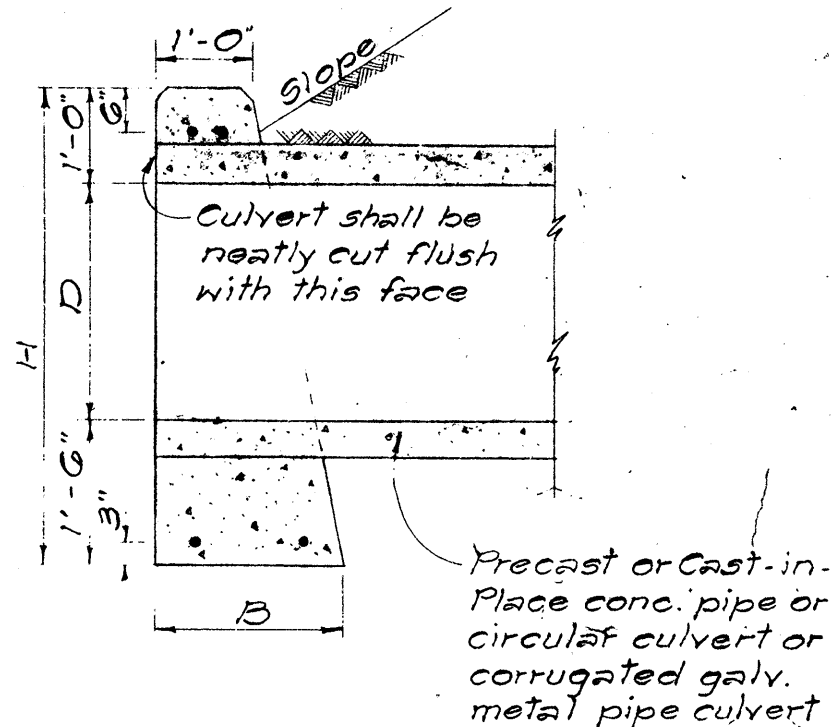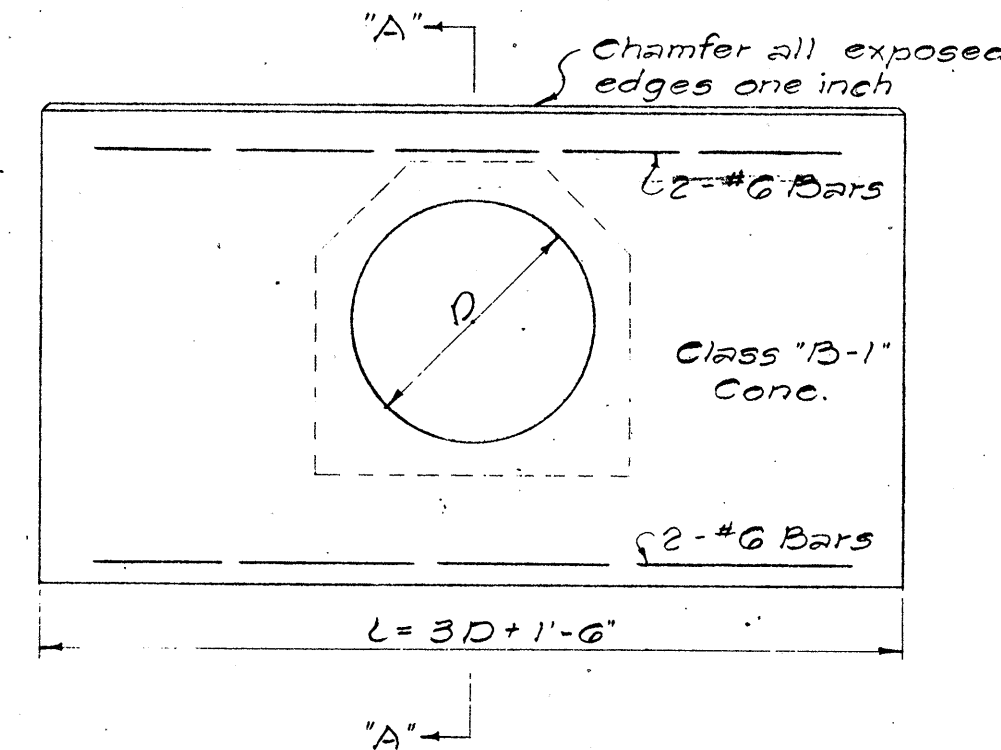


DATA FOR CONC. HEADWALL				Cast-in-Place Conc. Culvert		Conc. Pipe Culvert	Steel For One Headwall		
D	B	L	H	Cu. Yd.	Cu. Yd.	Cu. Yd.	No. of Bars	Size	Length
18"	1'-6"	6'-0"	4'-0"	0.92	1.00	4	4	#6	5'-0"
24"	1'-6"	7'-6"	4'-6"	1.25	1.38	4	4	#6	7'-0"
30"	2'-0"	9'-0"	5'-0"	1.95	2.17	4	4	#6	8'-6"
36"	2'-0"	10'-6"	5'-6"	2.45	2.74	4	4	#6	10'-0"
42"	2'-6"	12'-0"	6'-0"	3.87	3.87	4	4	#6	11'-0"
48"	2'-6"	13'-6"	6'-6"	4.66	4.66	4	4	#6	13'-0"
54"	3'-0"	15'-0"	7'-0"	6.45	6.45	4	4	#6	15'-0"

DETAIL OF STD. CONC. HEADWALL
Scale: 1/2" = 1'-0"

ORIGINAL PLAN	SURVEY PLOTTED BY..... DESIGNED BY <u>G.M.</u> DRAWN BY <u>J.Y.</u> TRACED BY..... QUANTITIES BY..... CHECKED BY.....	DATE..... "..... "..... "..... "..... ".....
NOTE BOOK		
No.		

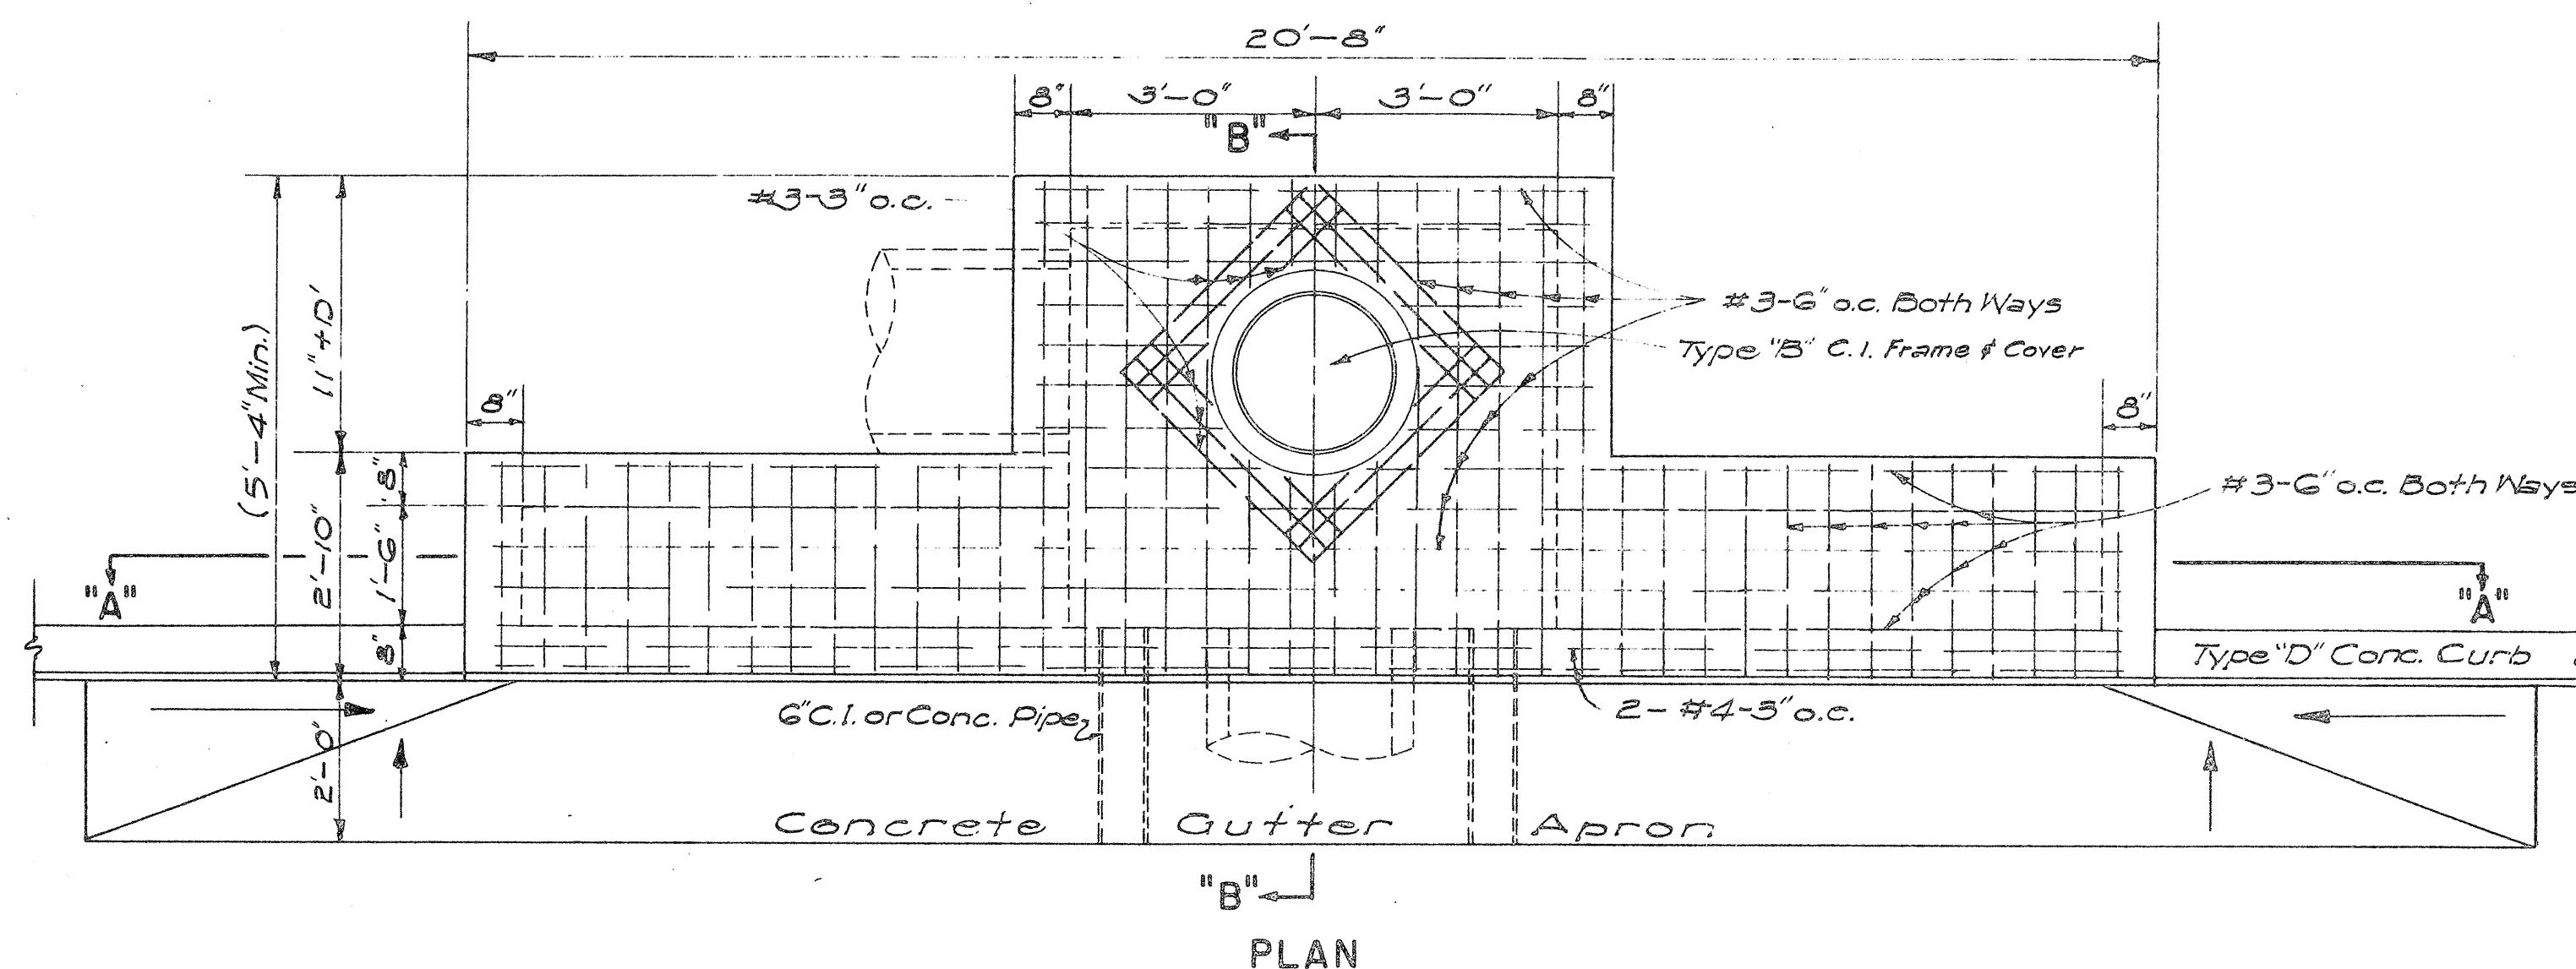
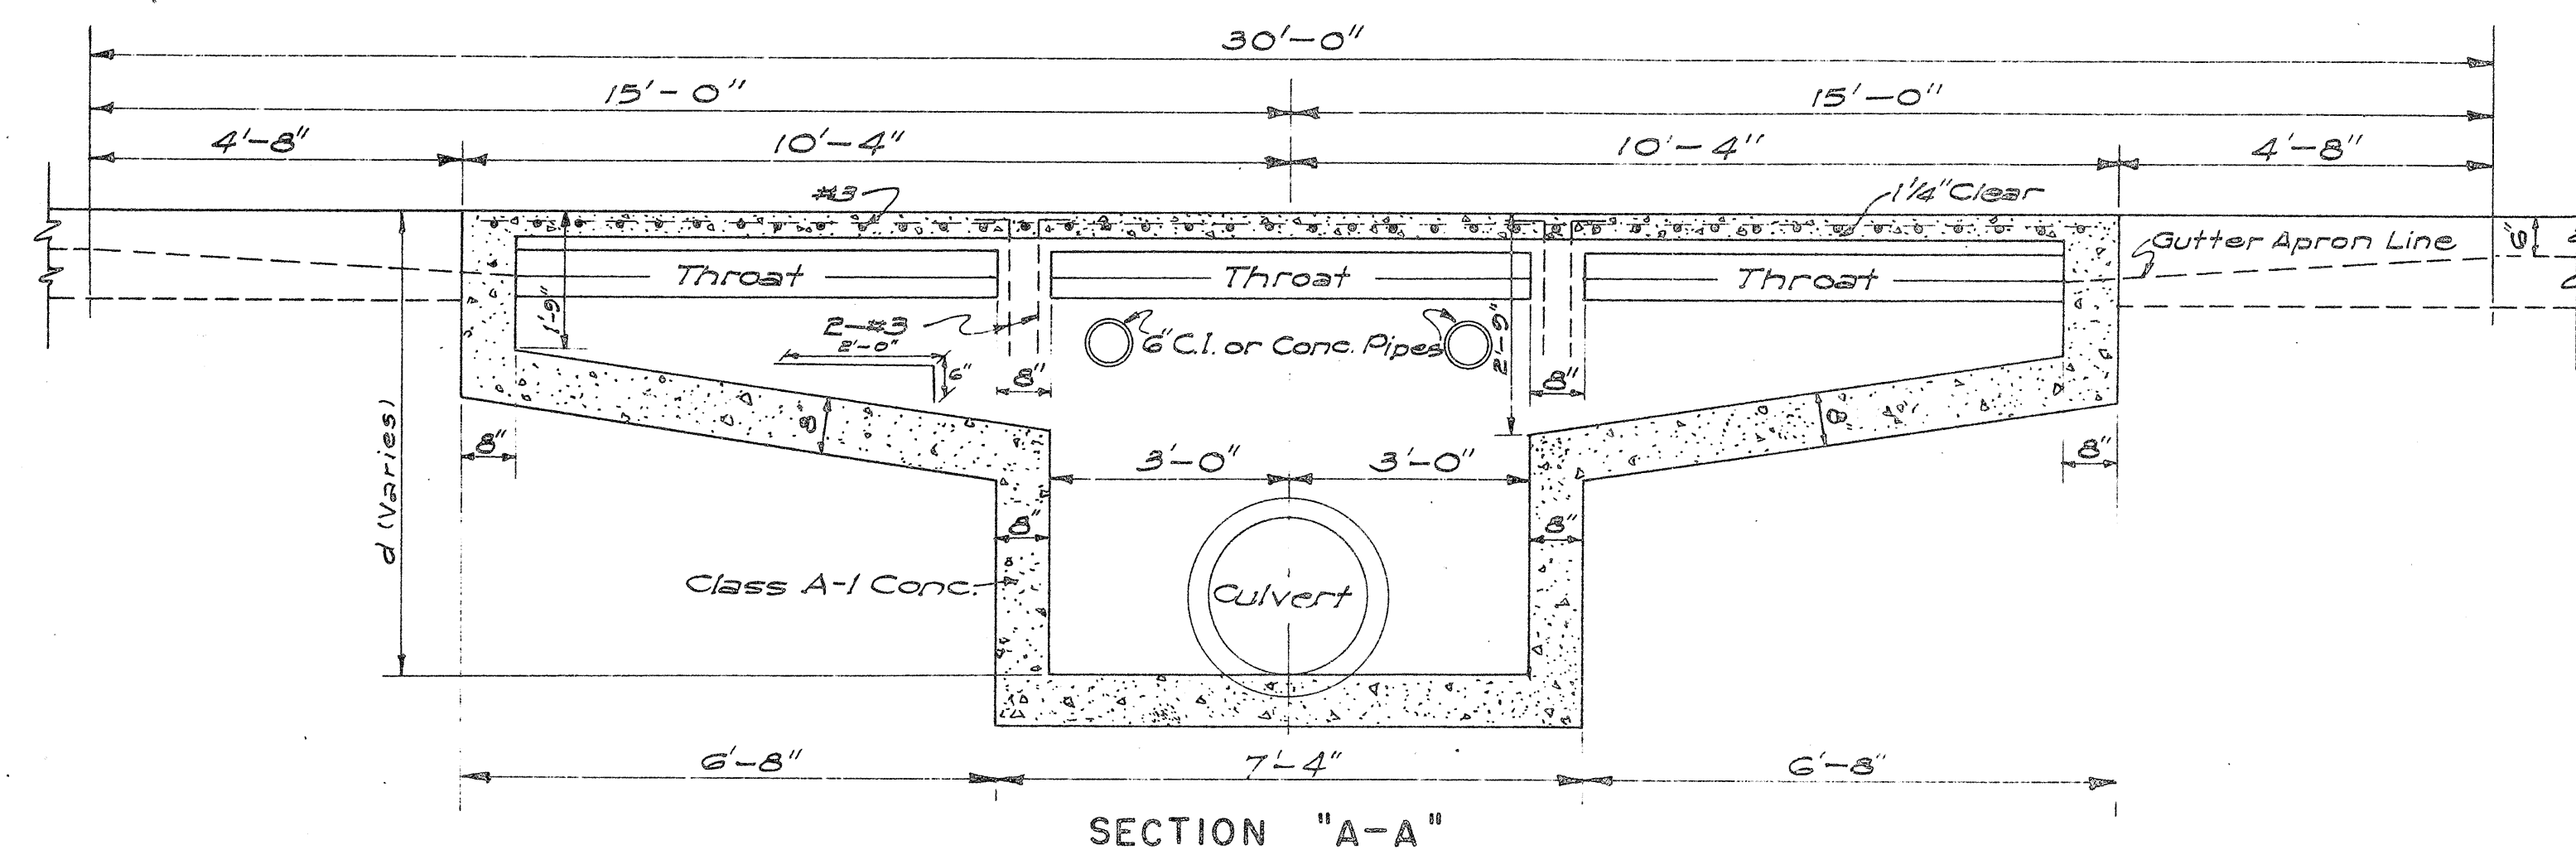


DETAIL OF TYPE "A" CATCH BASIN
SCALE: 1/2" = 1'-0"

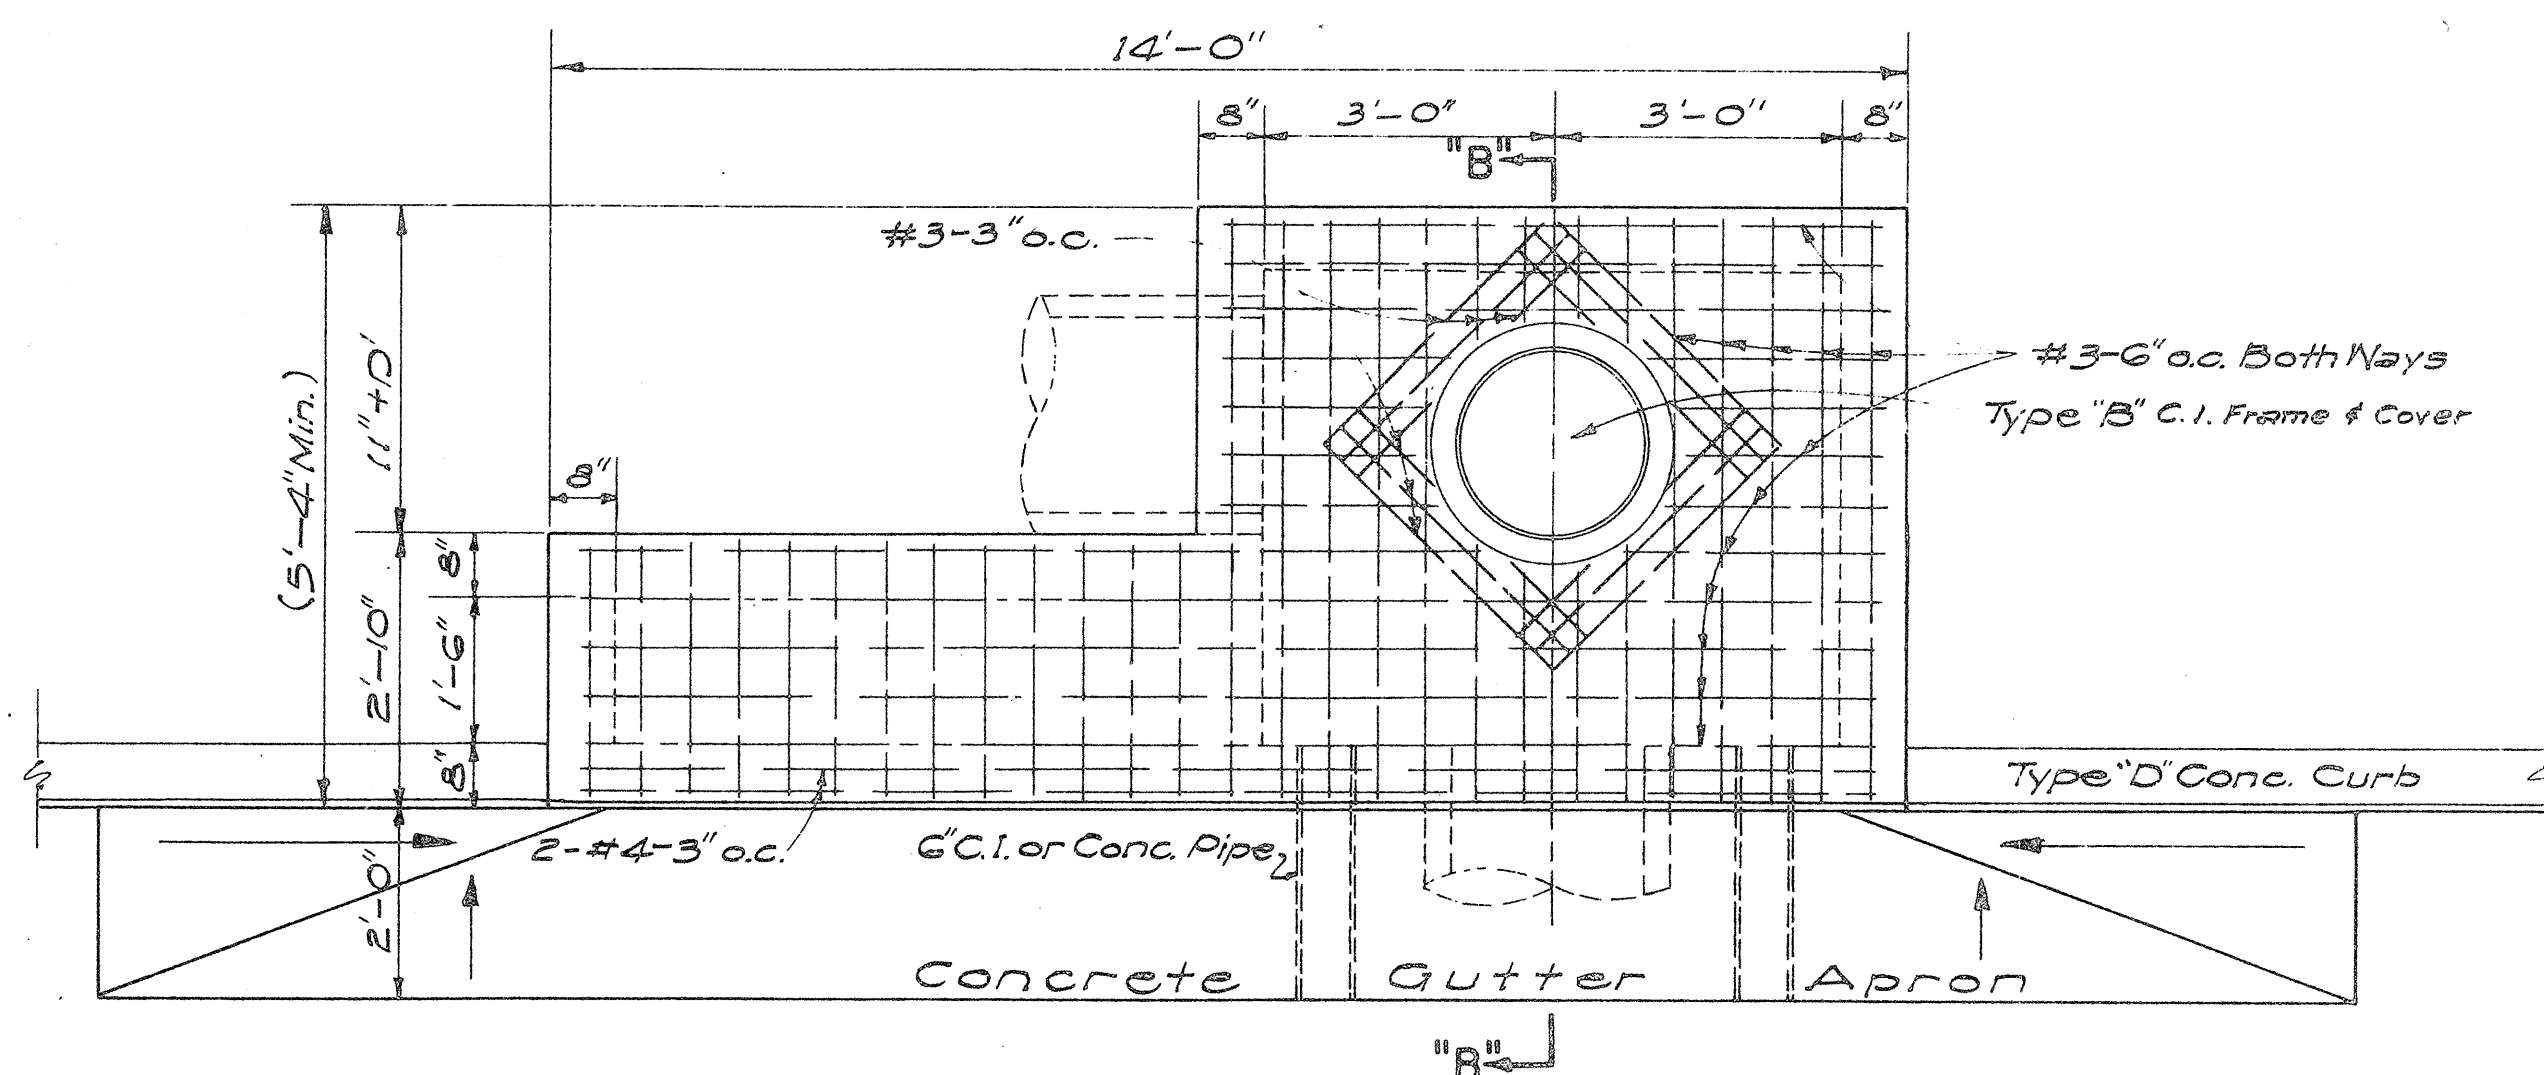


DETAIL OF TYPE "B" CATCH BASIN
SCALE: 1/2" = 1'-0"


NOTE: TYPE "C" C.B. SIMILAR BUT OPPOSITE HAND

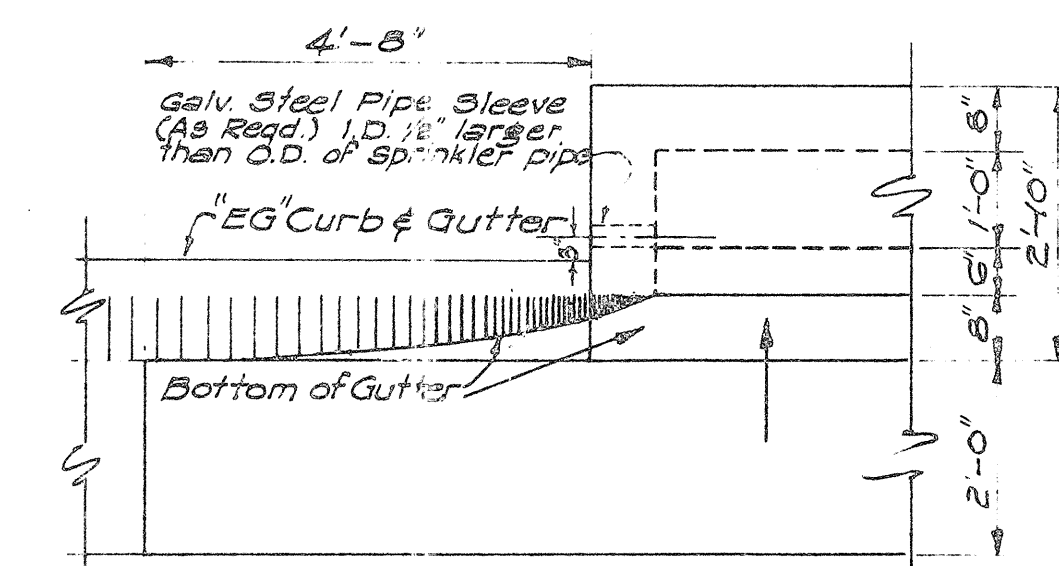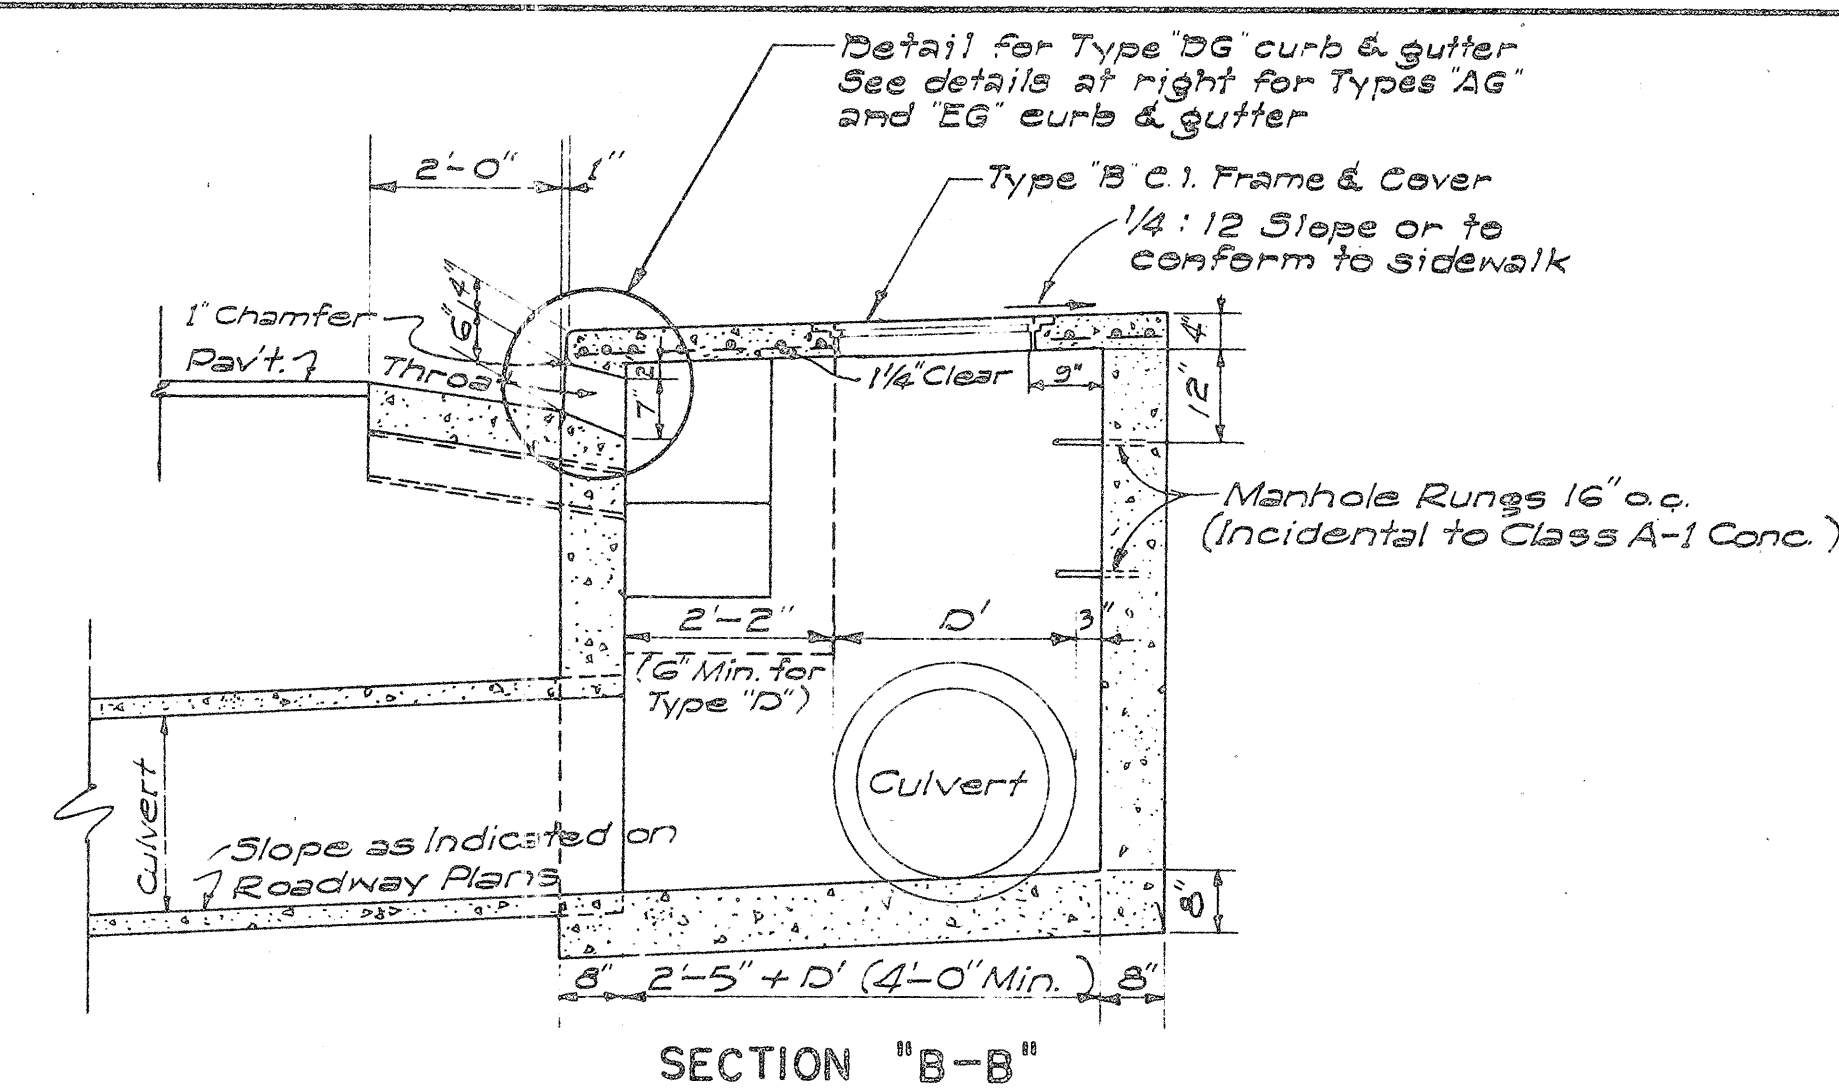

DETAIL OF CATCH BASIN
WITH TYPE "EG" CURB & GUTTER

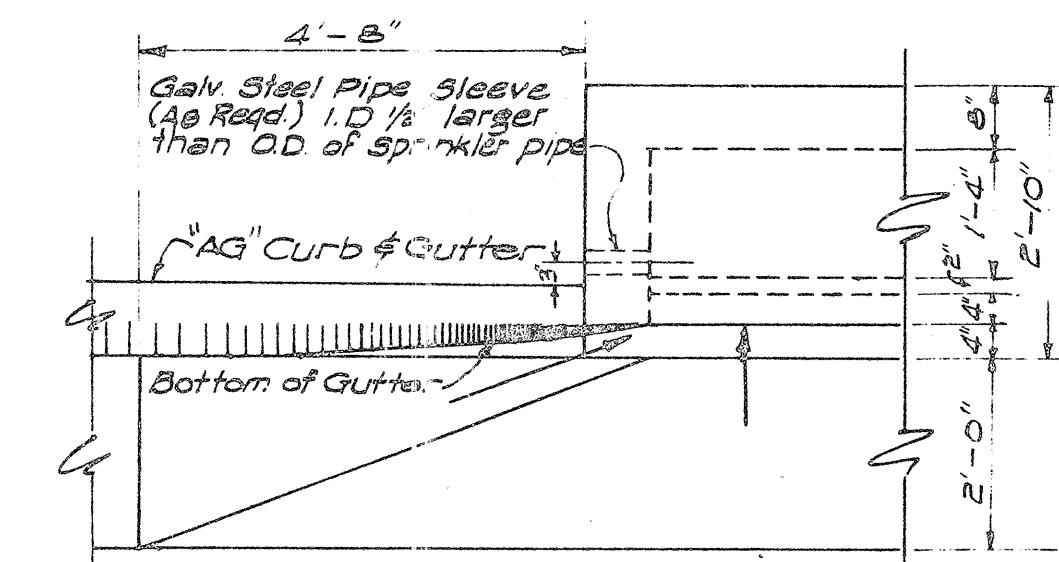


DETAIL OF CATCH BASIN
WITH TYPE "AG" CURB & GUTTER
SCALE: 1/2" = 1'-0"

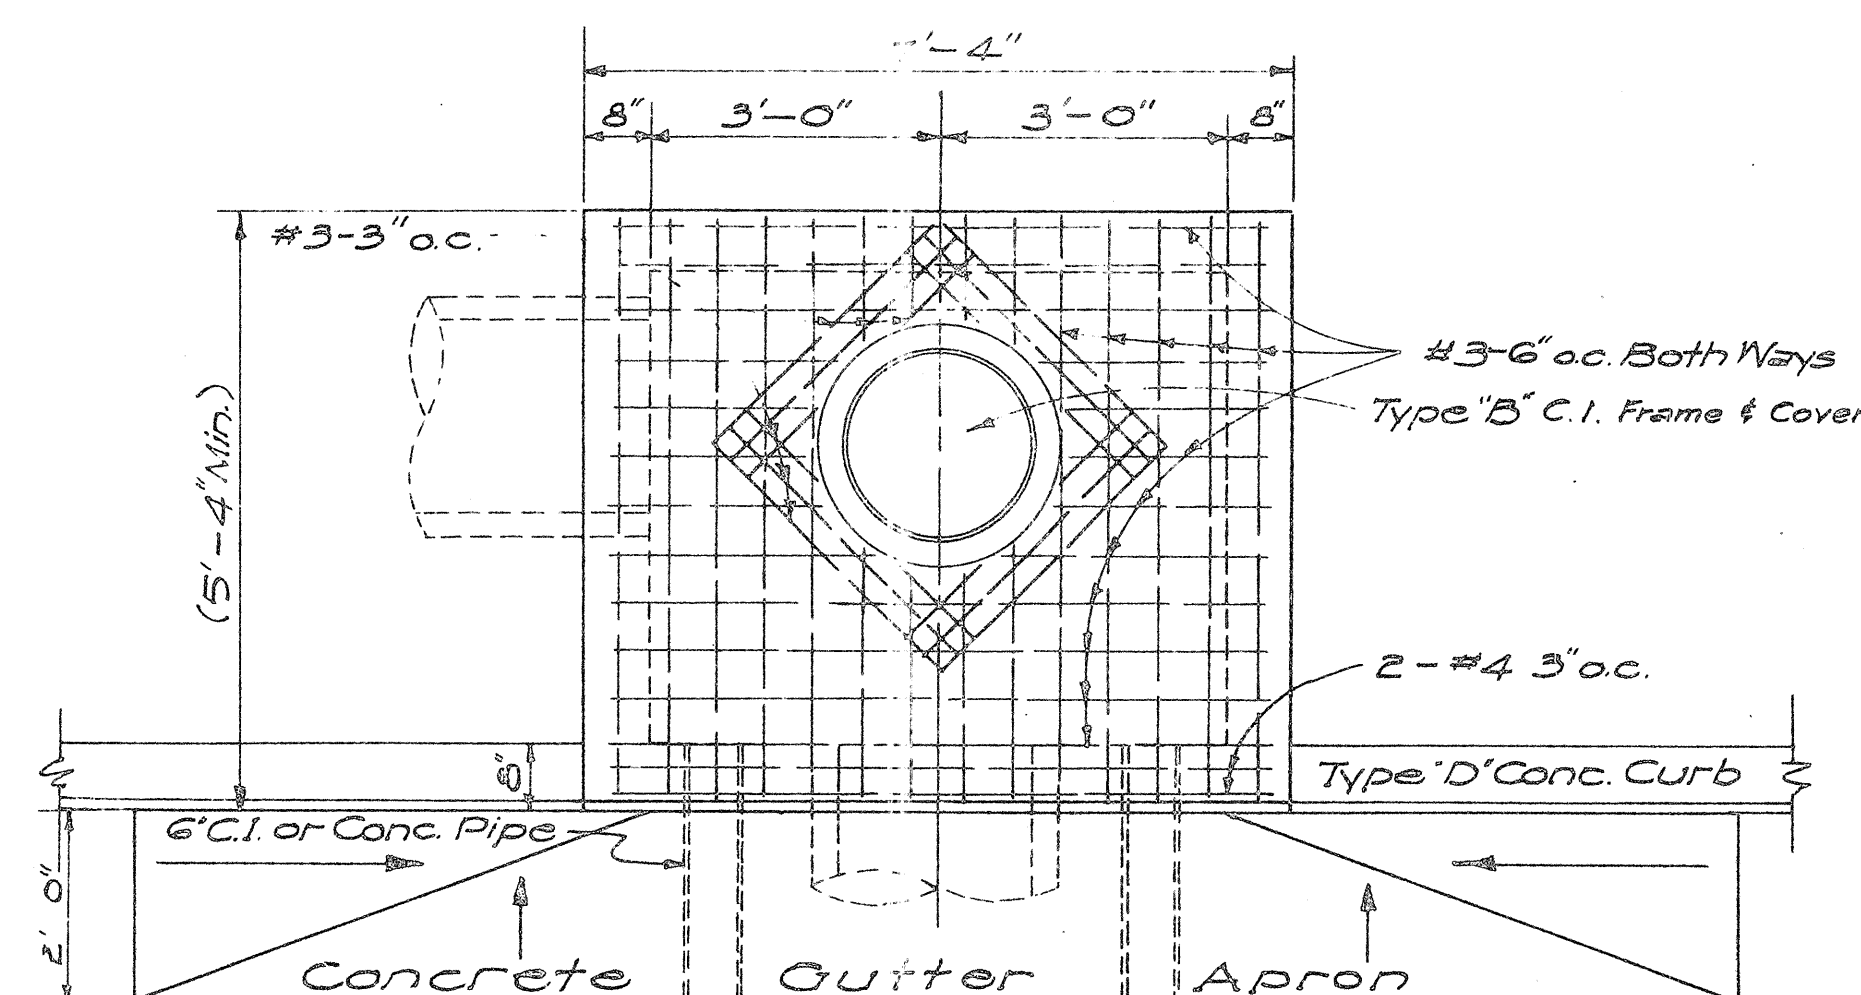


DETAIL OF TYPE "D" CATCH BASIN
SCALE: 1/2" = 1'-0"

FED. ROAD DIST. NO.	STATE	FED. AID PROJ. NO.	FISCAL YEAR	SHEET NO.	TOTAL SHEETS
HAWAII	HAW.	I-HI-1(118) UNIT 2	1965	45	75


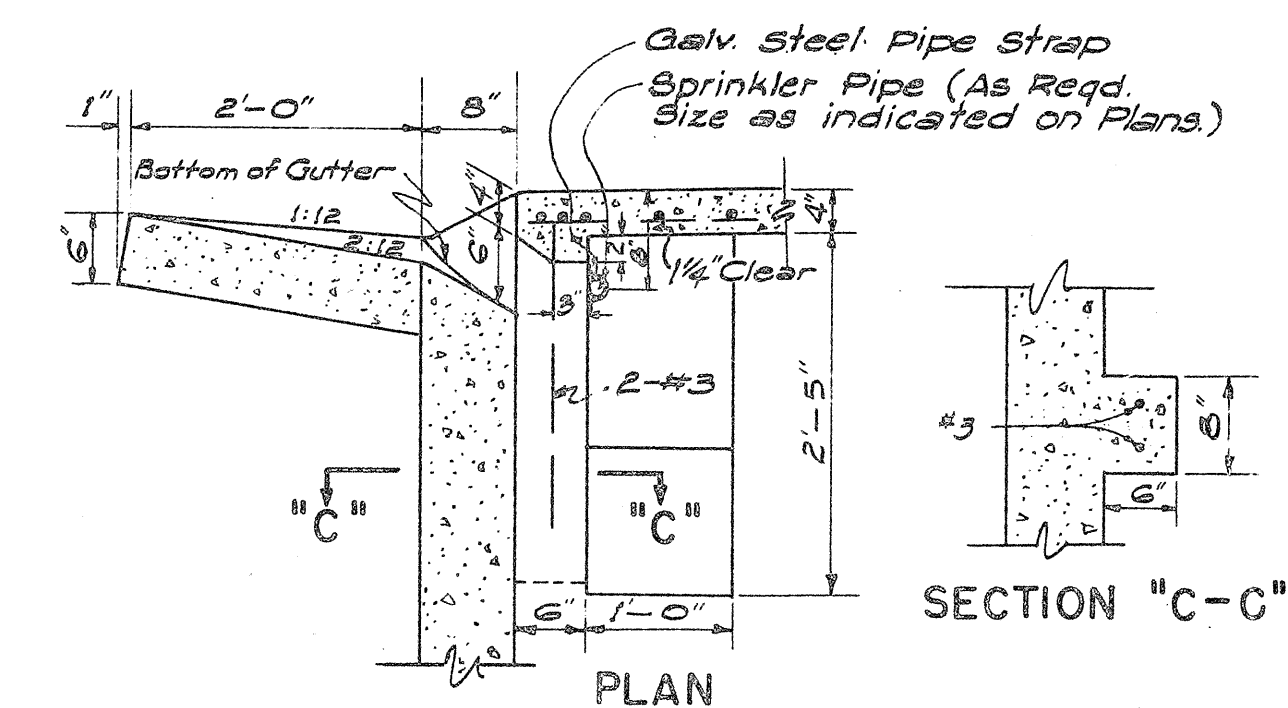


THROAT DETAIL FOR
TYPE "EG" CURB & GUTTER
SCALE: 3/4" = 1' - 0"

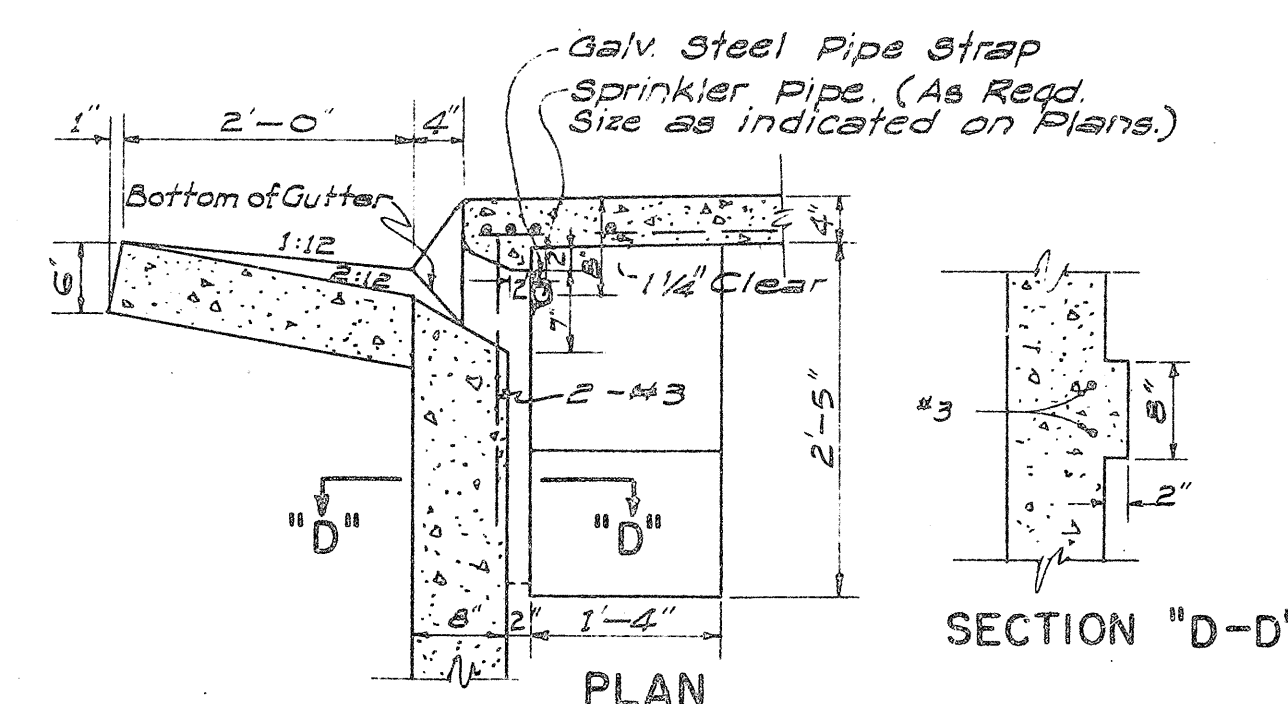

THROAT DETAIL FOR
TYPE "AG" CURB & GUTTER
SCALE: 3/4" = 1'-0"

  ESTIMATED QUANTITIES

Type	Class A-I Conc.	Struct. Exc.	Reinf. Steel	Gutter Length
"A" 	7.5 c.y.	24.7 c.y.	145 lb.	30'-0"
"B" 	6.0 c.y.	21.5 c.y.	108 lb.	23'-4"
"C" 	6.0 c.y.	21.5 c.y.	108 lb.	23'-4"
"D" 	4.9 c.y.	16.5 c.y.	77 lb.	16'-8"

NOTES:

1. Quantities based on $d = 5.75'$ and $P' = 30^\circ$.
2. Quantities do not include concrete for Gutter Apron.
3. The Contractor shall install two 6" Cast Iron or Concrete Pipes as incidental to Class A-1 Concrete for Construction Drainage.
4. Culvert shall leave C.B. from any position and any direction indicated by plans or ordered by the Engineer. Culvert may both enter and leave C.B. so that C.B. will also act as Manhole.
5. The Contractor shall install Galvanized Steel Pipe sleeves and Straps as incidental to Sprinkler System.

APPROVED: _____ DATE Aug. 26, 1957

 STATE HIGHWAY ENGINEER


STATE OF HAWAII
DEPARTMENT OF TRANSPORTATION
HIGHWAYS DIVISION
STANDARD DETAILS
CATCH BASINS

SCALES AS NOTED


SHEET NO 8 OF 11 SHEETS

45


FED. AID DIST. NO.	STATE	FED. AID PROJ. NO.	FISCAL YEAR	SHEET NO.	TOTAL SHEETS
HAWAII	HAWAII	I-HI-1(10)	1965	47	75
UNIT 2					

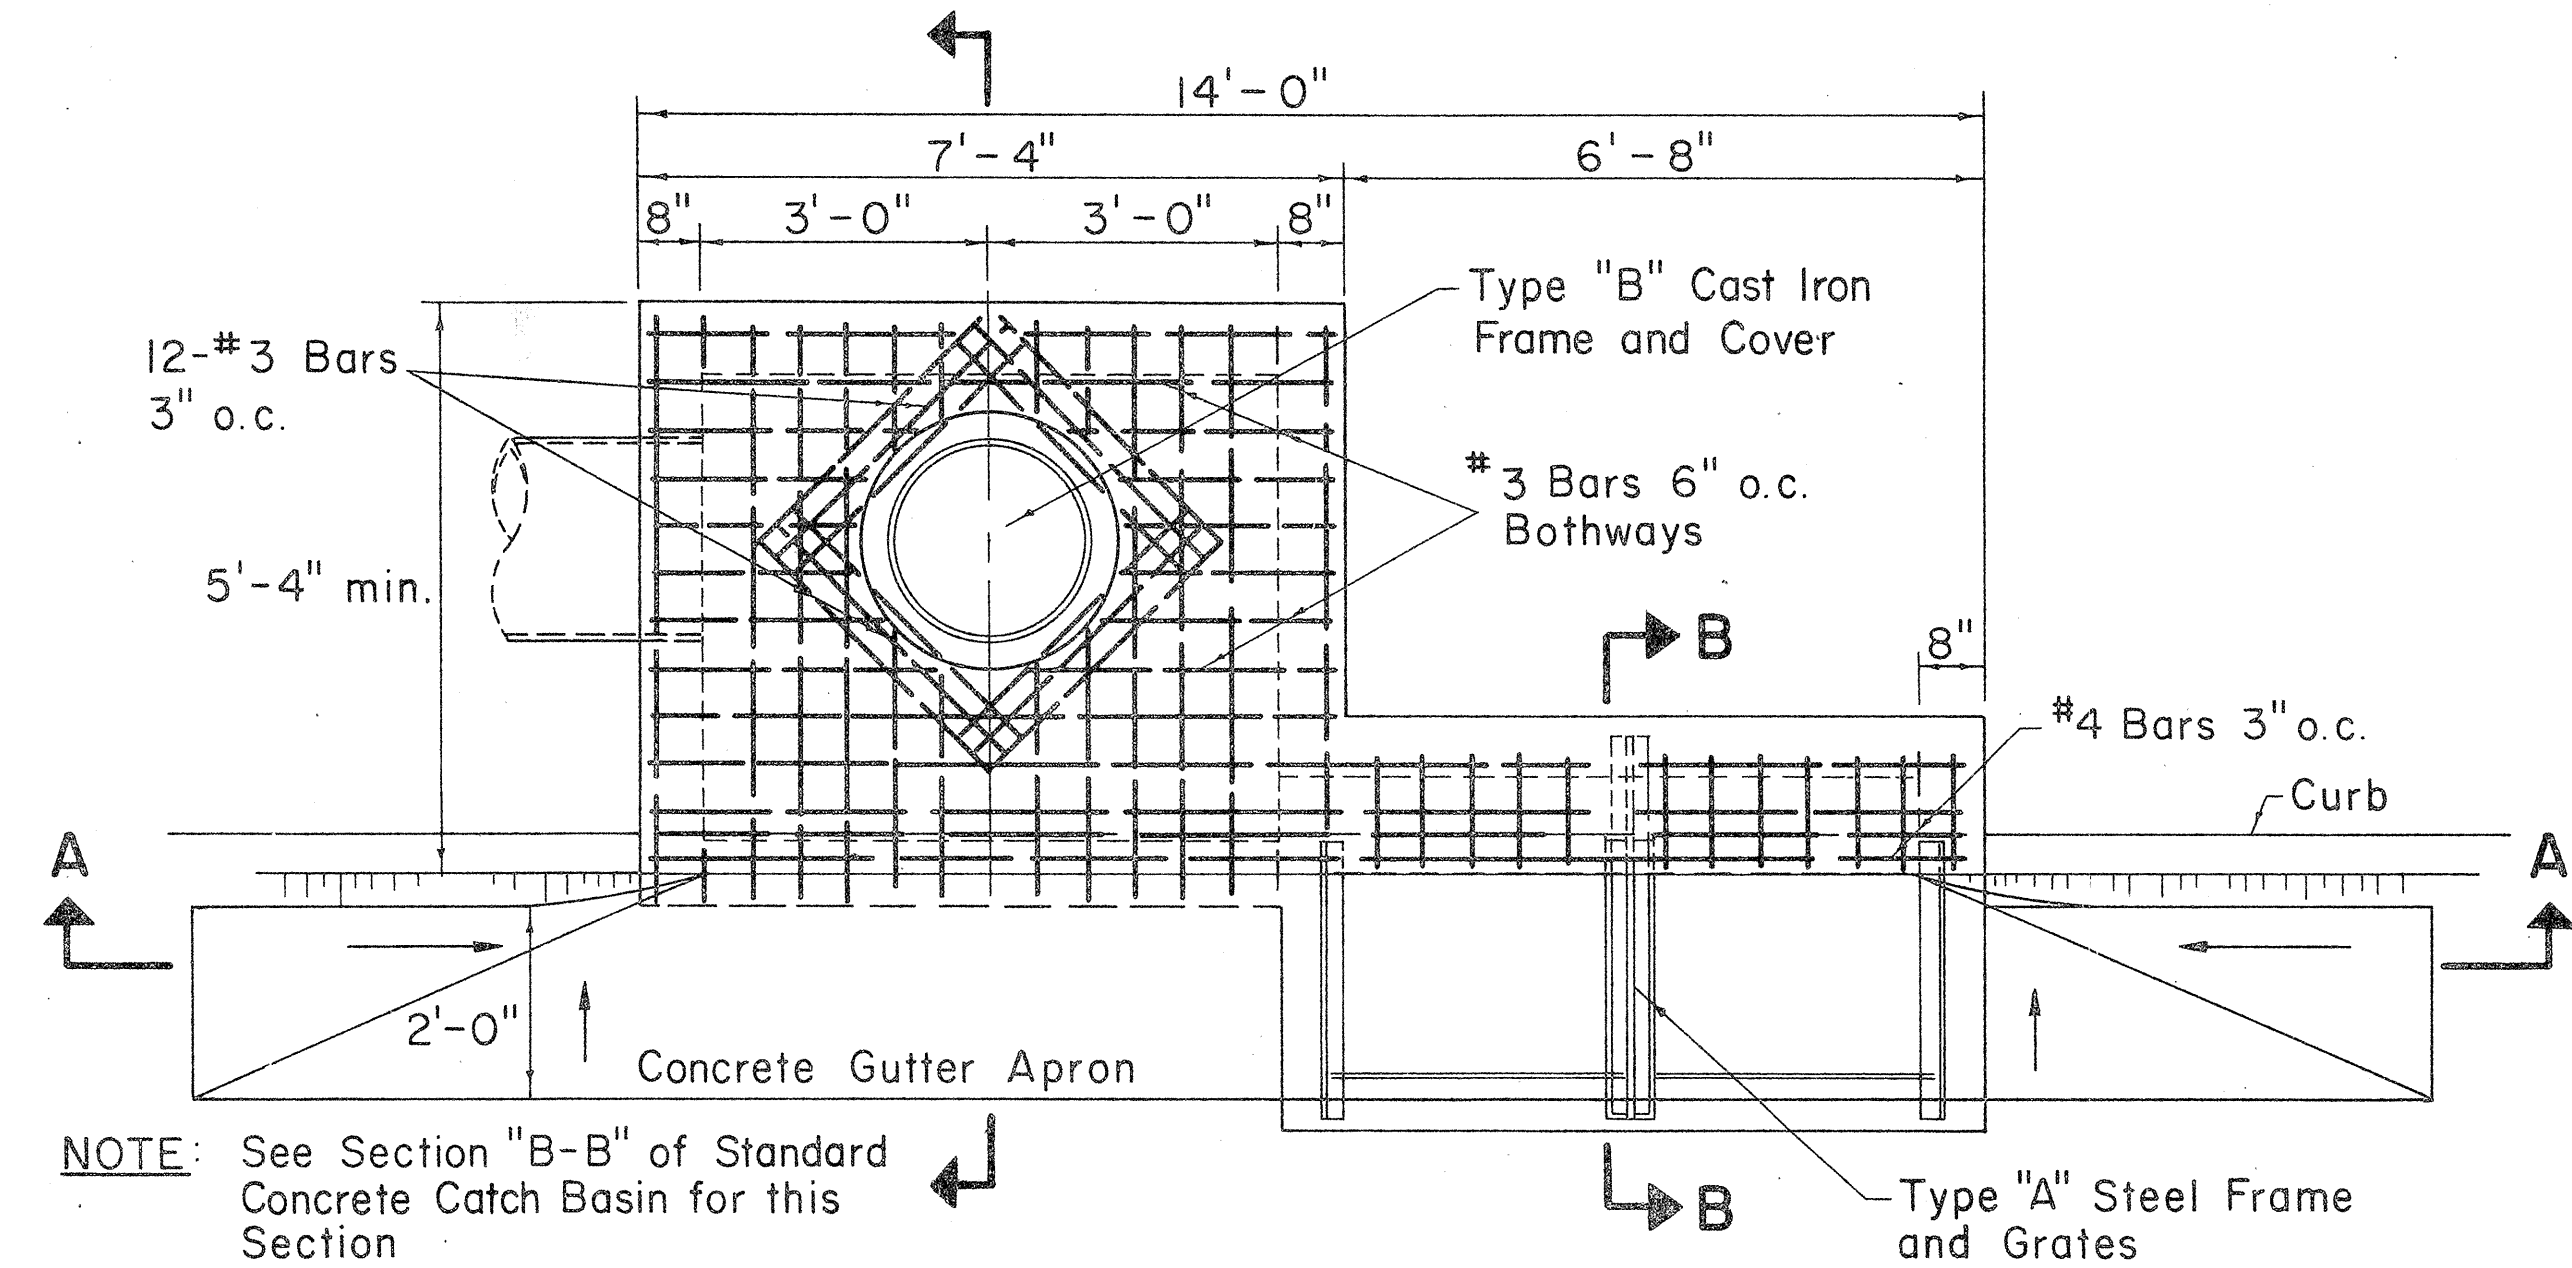

PLAN

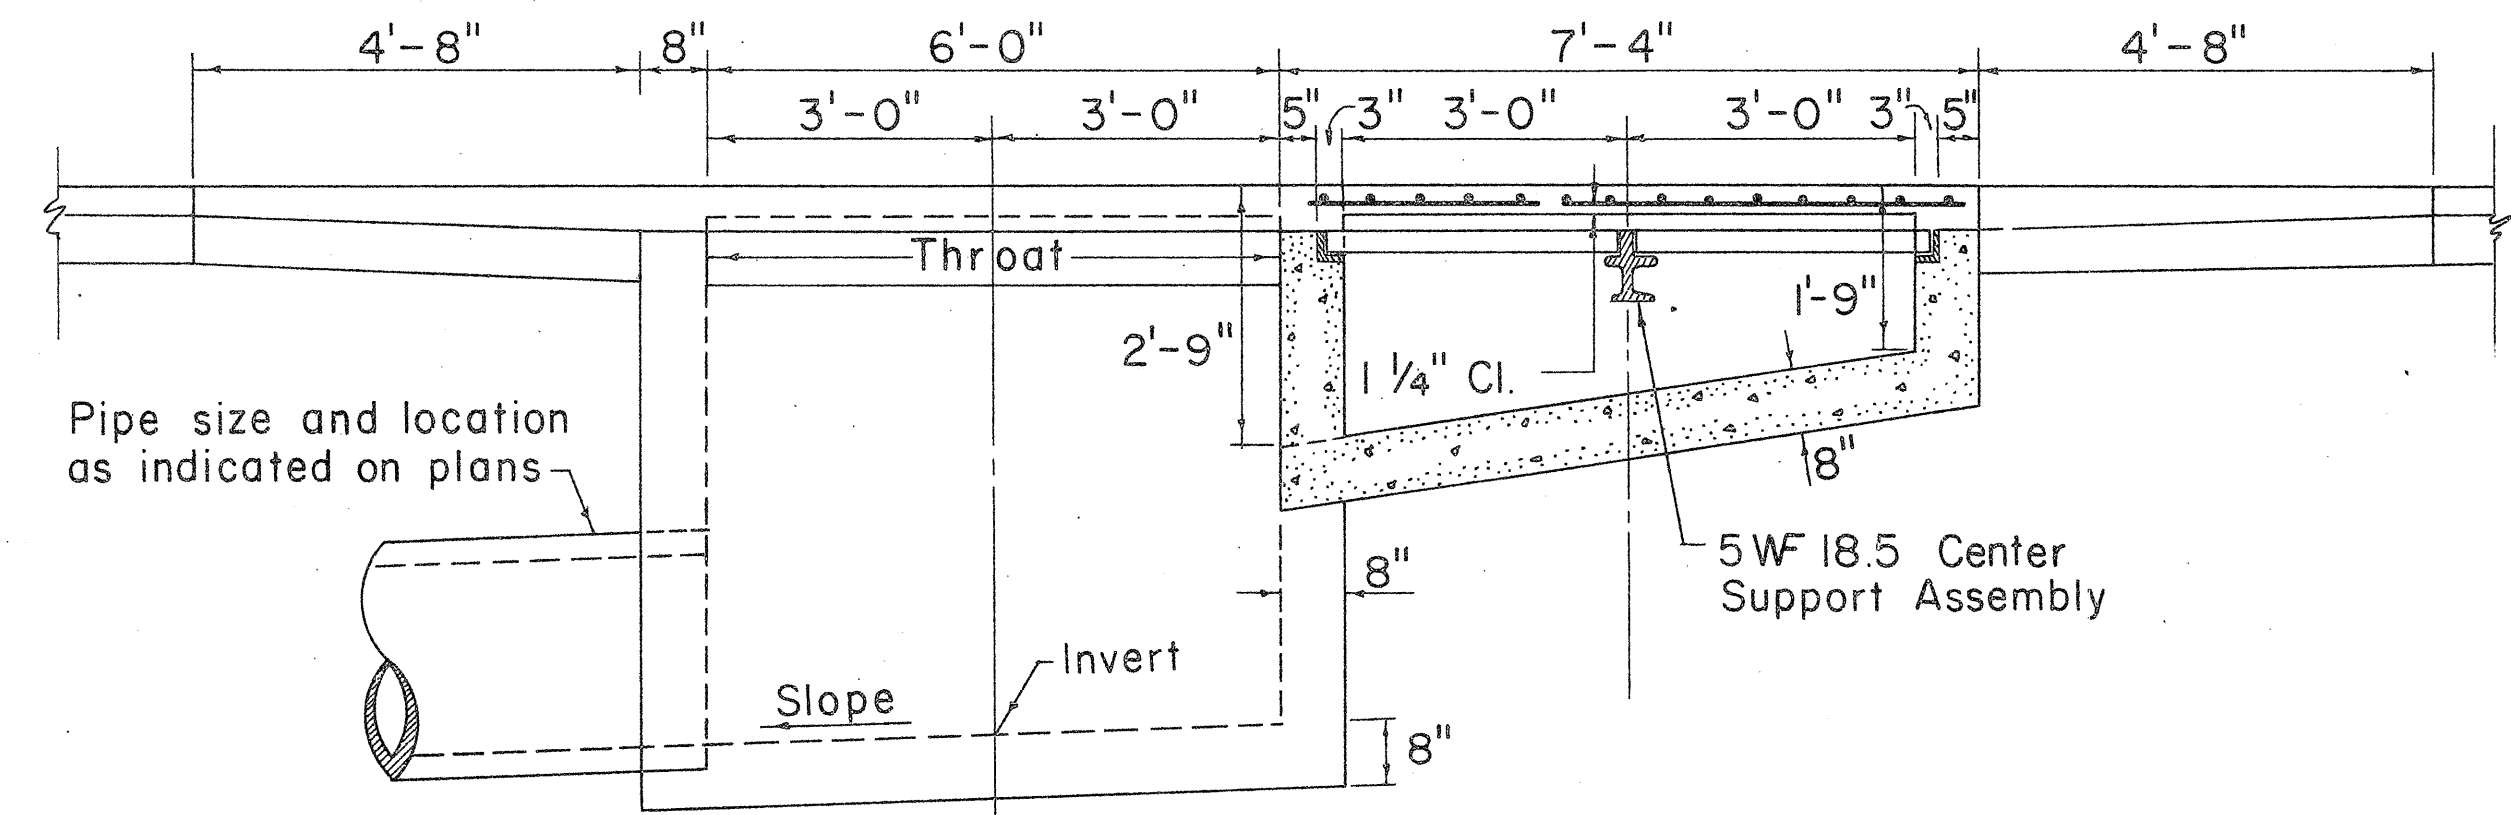


SECTION A-A

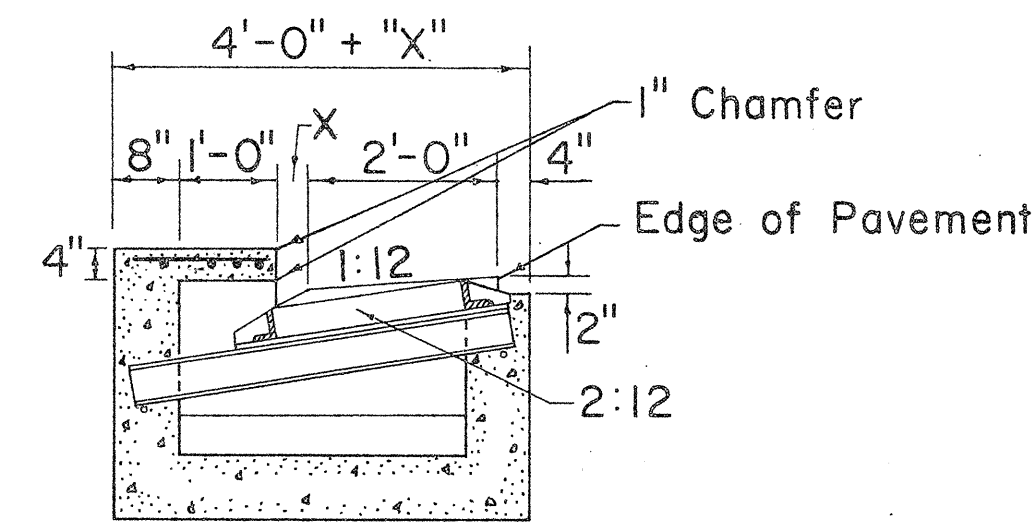


SECTION B-B

DETAIL OF TYPE "CG" CATCH BASIN


Scale: 1/2" = 1'-0"

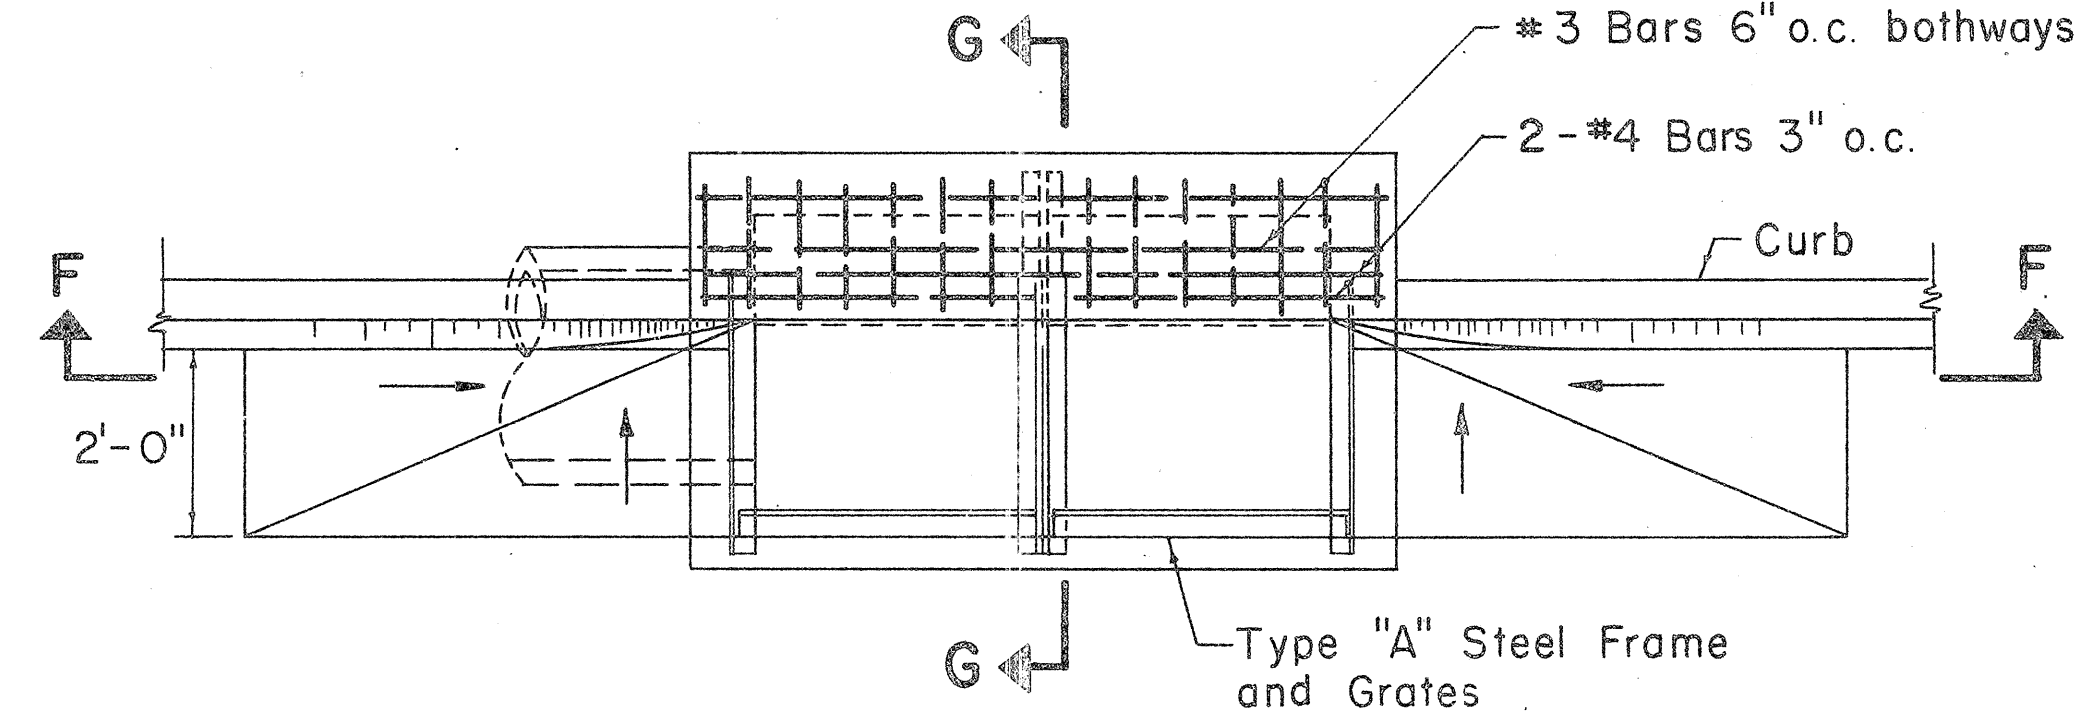

PLAN

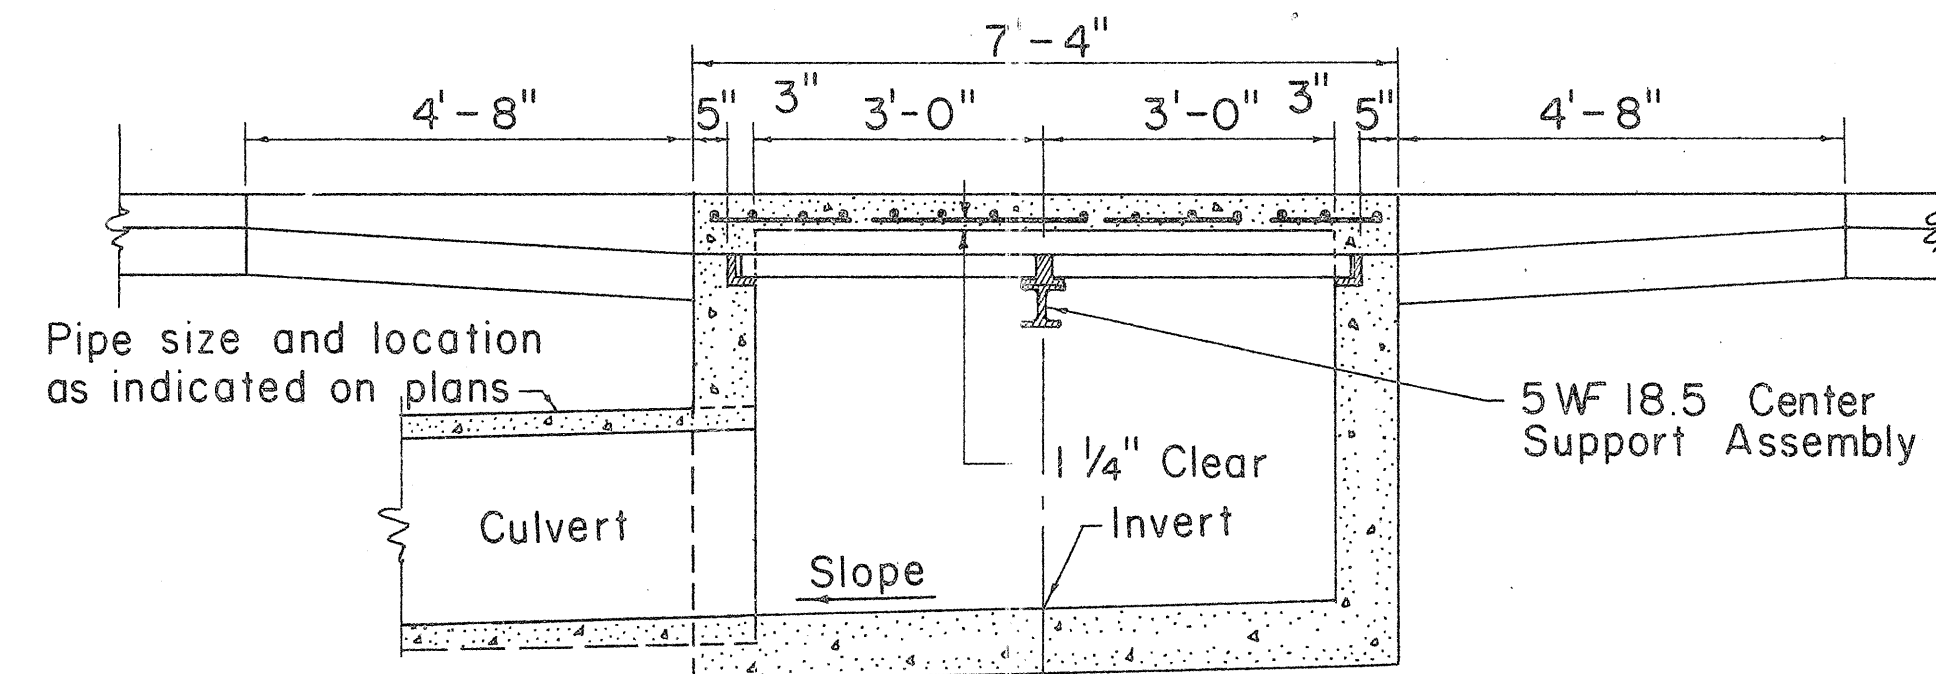


SECTION F-F

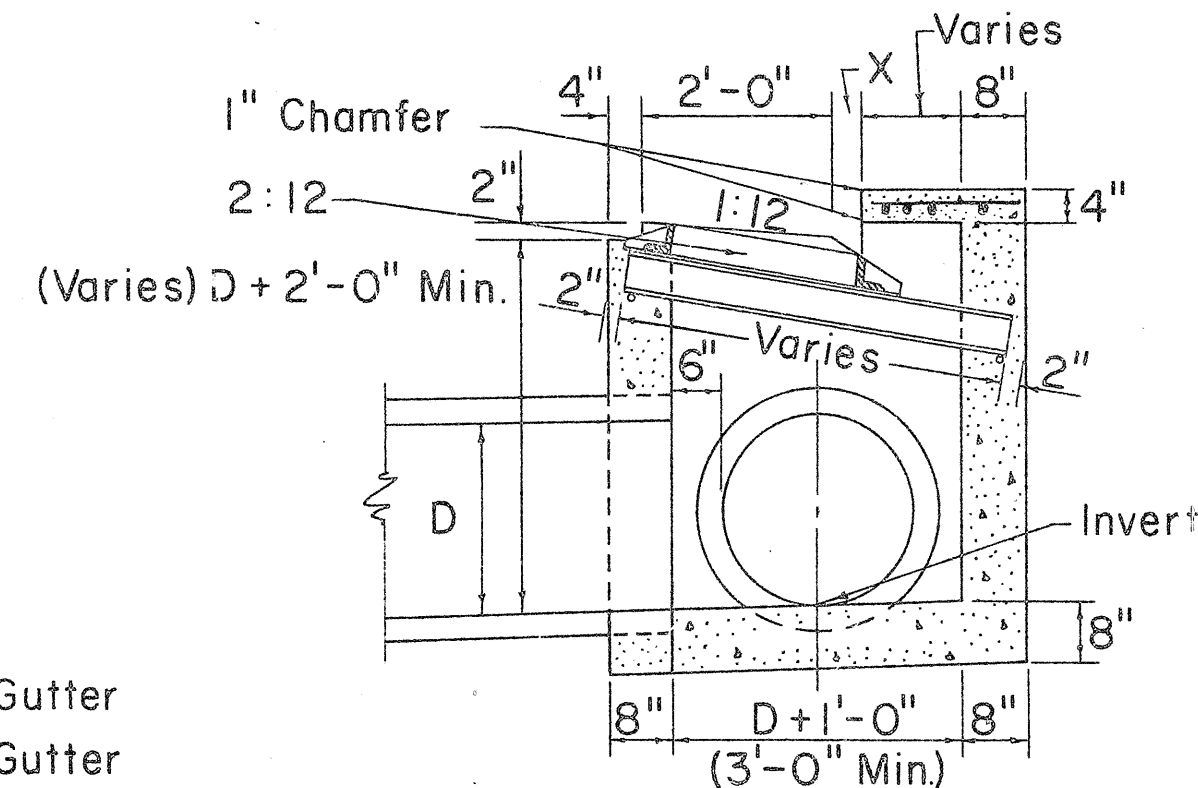


SECTION G-G

DETAIL OF TYPE "DG" CATCH BASIN

Scale: 1/2" = 1'-0"

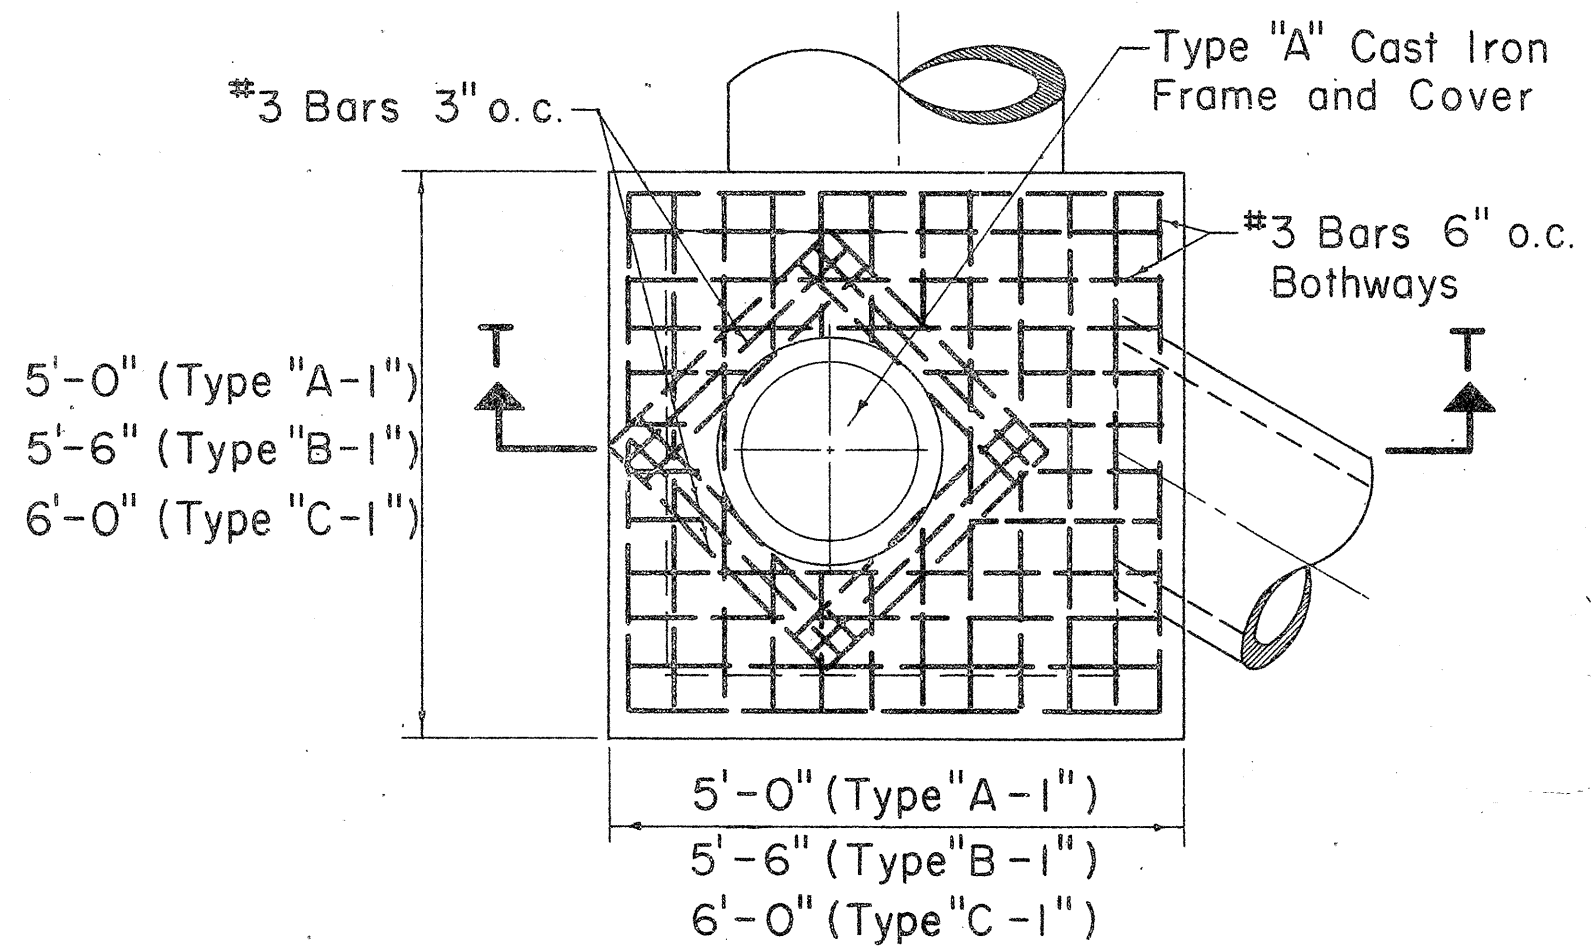

PLAN

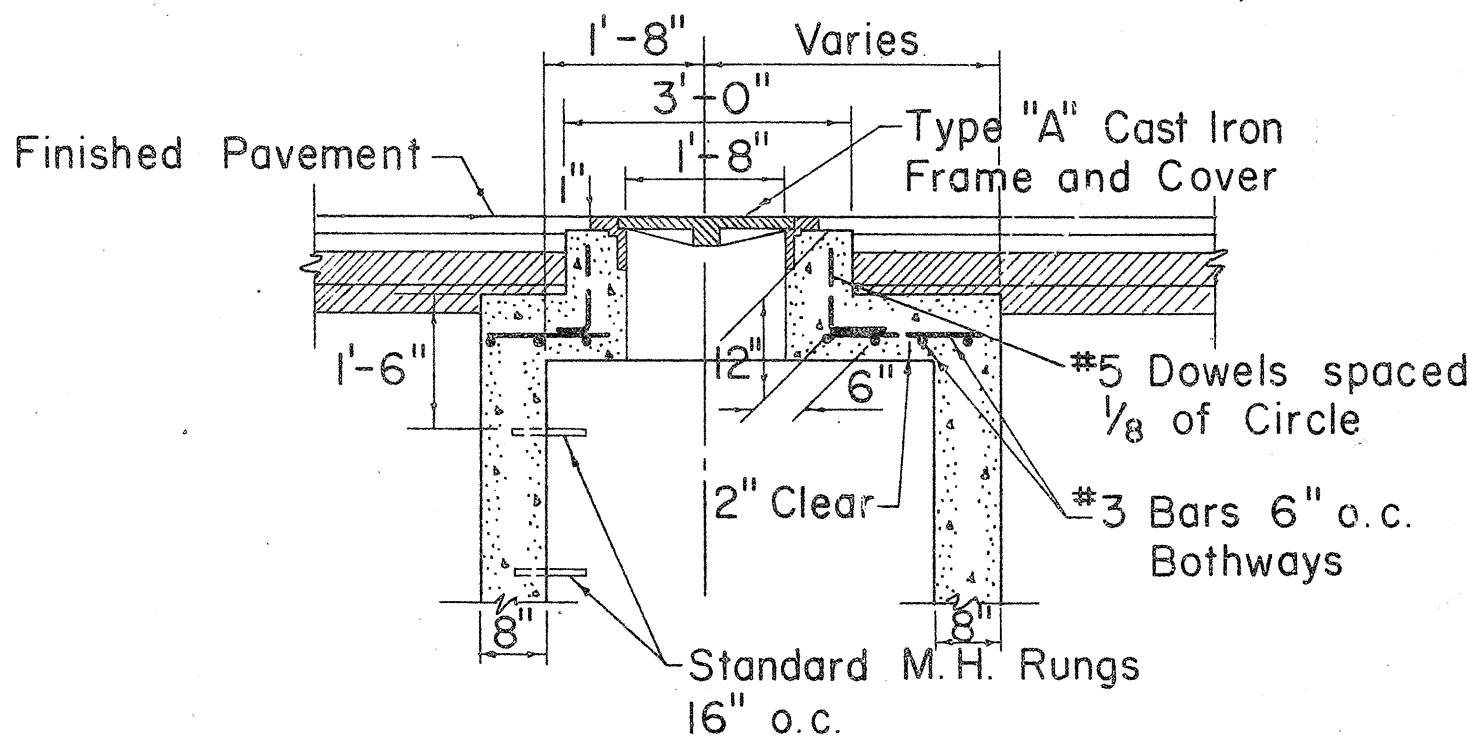

SECTION T-T

TYPE "A-1", "B-1", & "C-1"
STORM DRAIN MANHOLE
TOP DETAIL UNDER PAVEMENT
(BOTTOM DETAIL SIMILAR TO TYPE "A", "B", & "C")
Scale: 1/2" = 1'-0"

STATE OF HAWAII
DEPARTMENT OF TRANSPORTATION
HIGHWAYS DIVISION

STANDARD DETAILS
CATCH BASINS AND
STORM DRAIN MANHOLES

Scales: As Noted Date July, 1965

SHEET NO. 10 OF 11 SHEETS

