


FED. ROAD DIST. NO.	STATE	FED. AID PROJ. NO.	FISCAL YEAR	SHEET NO.	TOTAL SHEETS
HAWAII	HAW.	1-1-108	1965	51	75

REV. #1, 7/5/66 - Bridge Widening

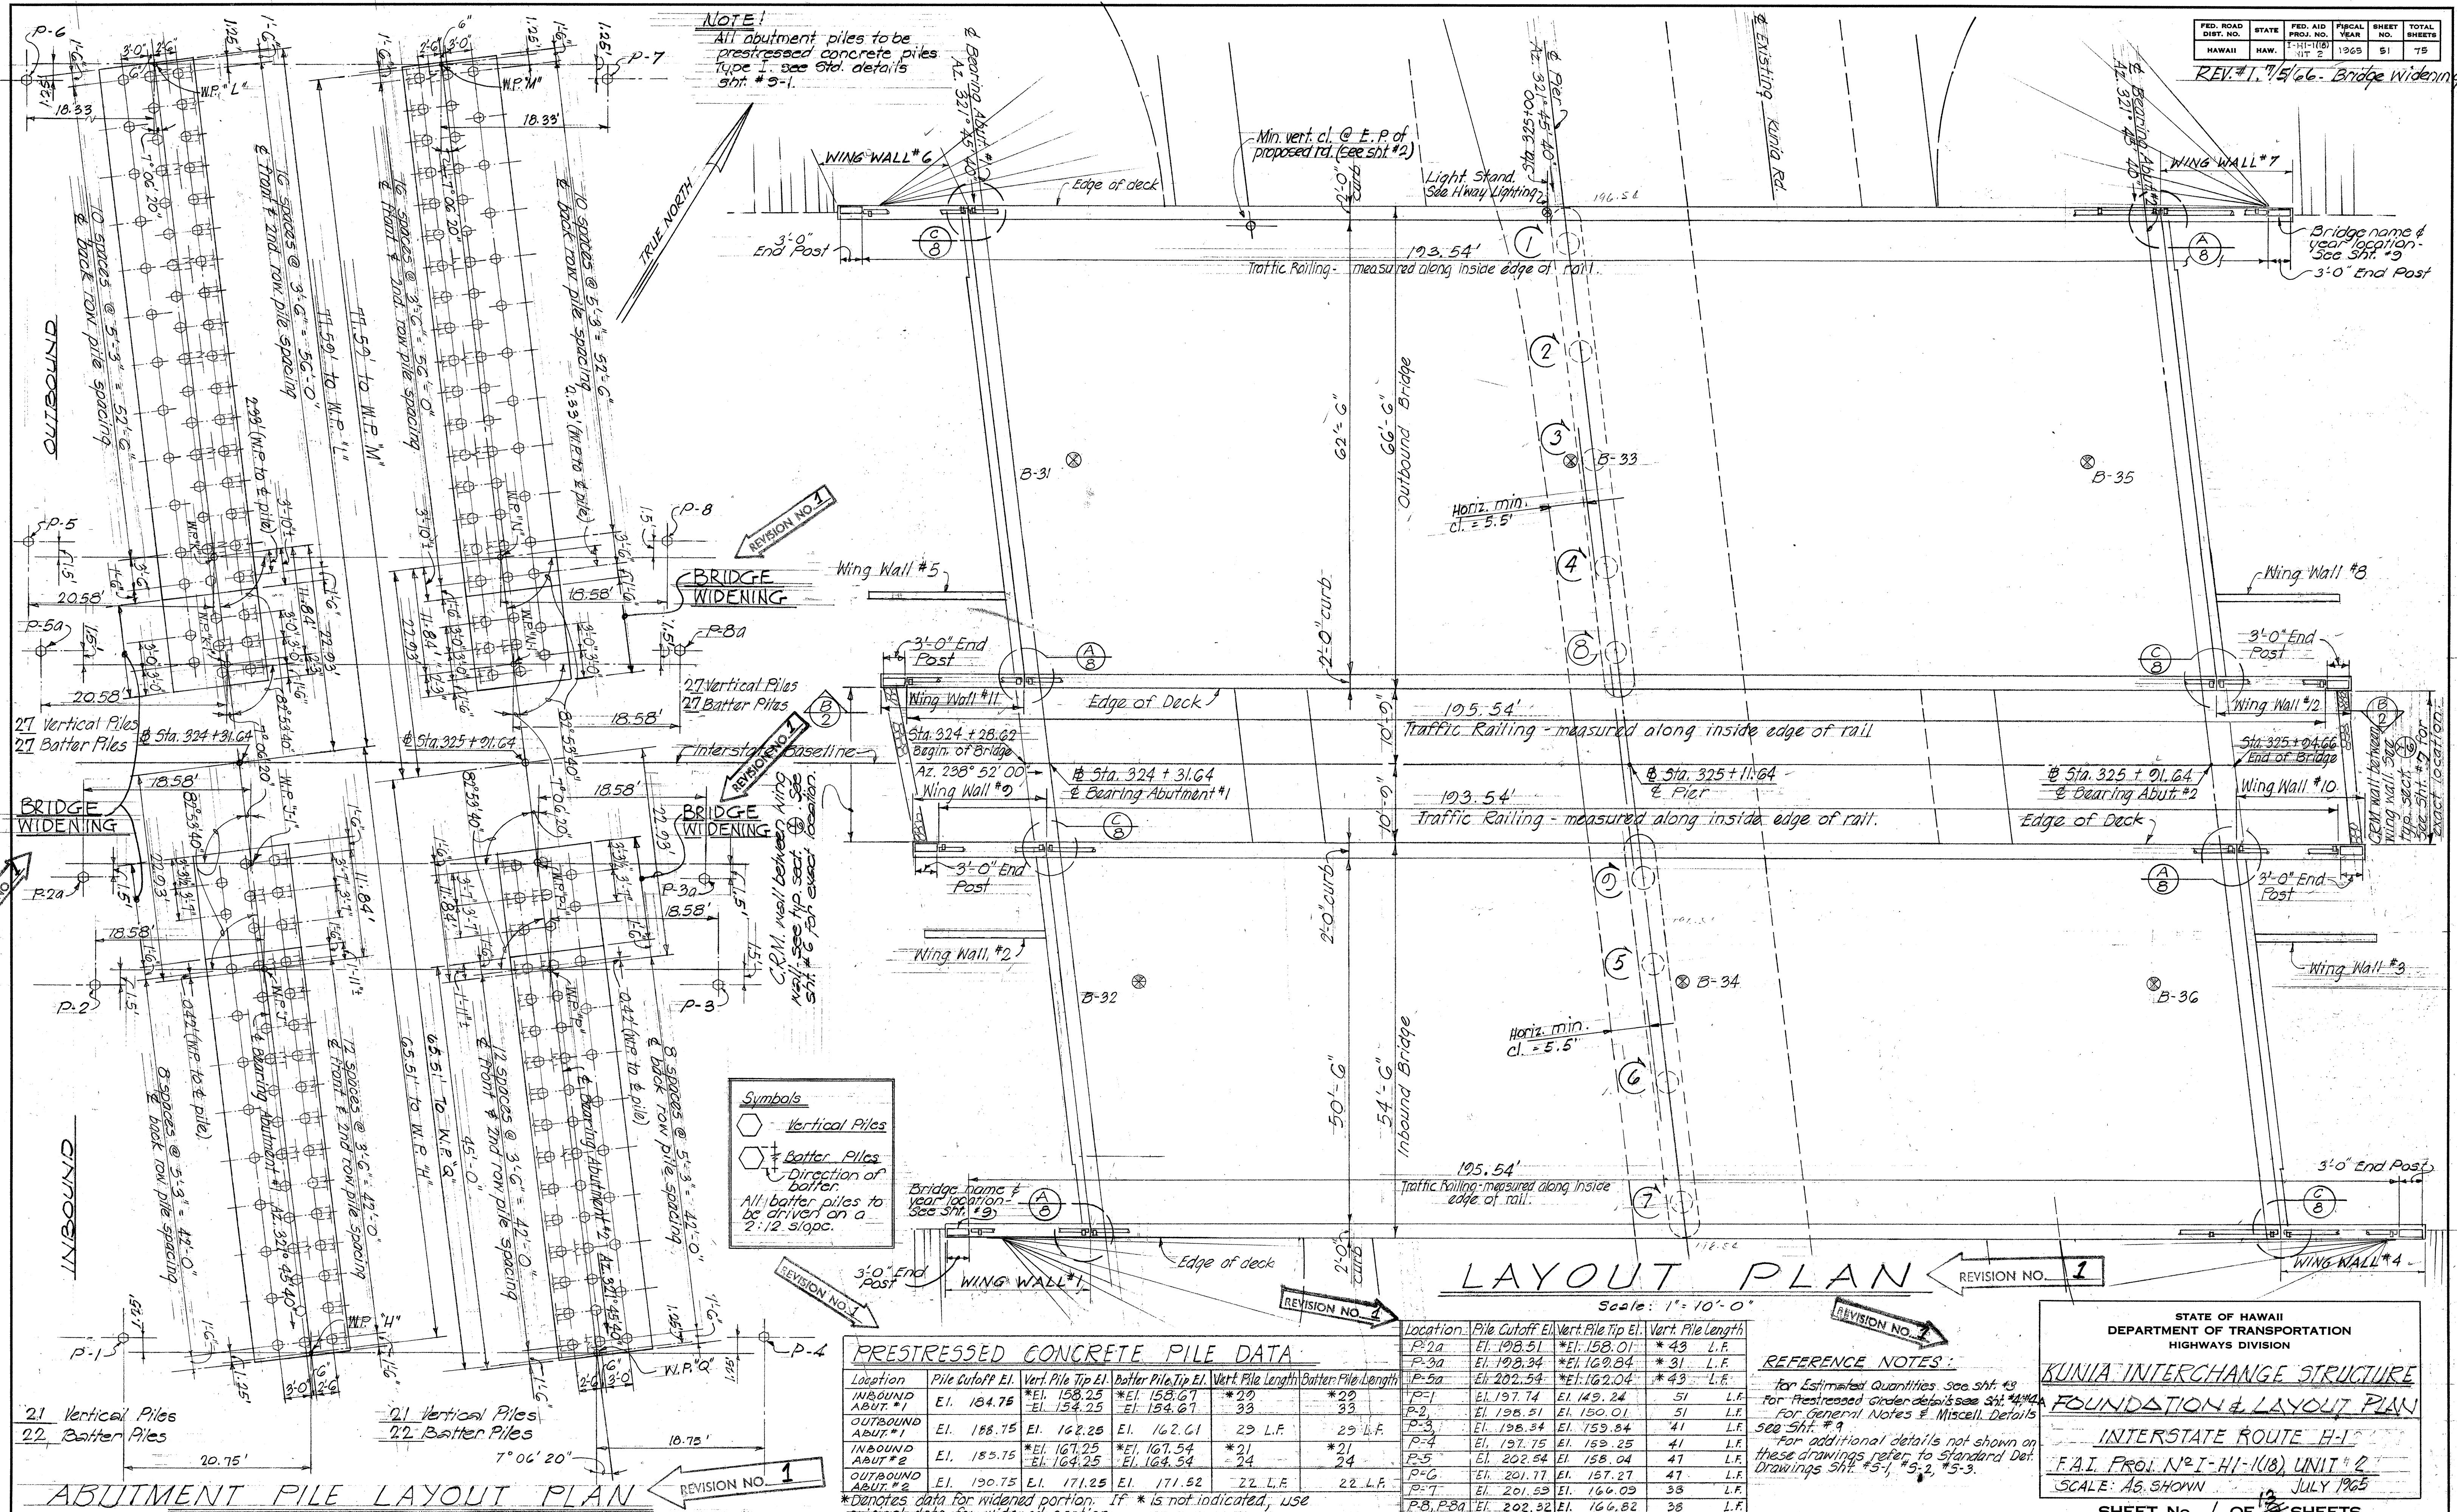

NOTE:
All abutment piles to be prestressed concrete piles type 1. See Std. details Sht. #5-1.

Symbols

- Vertical Piles
- Batter Piles
- Direction of batter

All batter piles to be driven on a 2:12 slope.

PRESTRESSED CONCRETE PILE DATA

Location	Pile Cutoff El.	Vert. Pile Tip El.	Batter Pile Tip El.	Vert. Pile Length	Batter Pile Length
INBOUND ABUT. #1	El. 184.75	*El. 158.25	*El. 158.67	*20	*29
OUTBOUND ABUT. #1	El. 188.75	El. 162.25	El. 162.61	29 L.F.	29 L.F.
INBOUND ABUT. #2	El. 185.75	*El. 167.25	*El. 167.54	*21	*24
OUTBOUND ABUT. #2	El. 190.75	El. 171.25	El. 171.62	22 L.F.	22 L.F.

* Denotes data for widened portion. If * is not indicated, use original data for widened portion.

Location	Pile Cutoff El.	Vert. Pile Tip El.	Vert. Pile Length
P-2a	El. 198.51	*El. 158.01	*43 L.F.
P-3a	El. 198.34	*El. 160.84	*31 L.F.
P-5a	El. 202.54	*El. 162.04	*43 L.F.
P-1	El. 197.74	El. 149.24	51 L.F.
P-2	El. 198.51	El. 150.01	51 L.F.
P-3	El. 198.34	El. 159.84	41 L.F.
P-4	El. 197.75	El. 159.25	41 L.F.
P-5	El. 202.54	El. 158.04	47 L.F.
P-6	El. 201.77	El. 157.27	47 L.F.
P-7	El. 201.29	El. 166.09	38 L.F.
P-8, P-8a	El. 202.32	El. 166.82	38 L.F.

REFERENCE NOTES:
For Estimated Quantities, see Sht. #3
For Prestressed Girder details see Sht. #4, #5
For General Notes & Miscell. Details see Sht. #9
For additional details not shown on these drawings refer to Standard Det. Drawings Sht. #5-1, #5-2, #5-3.

LAYOUT PLAN

Scale: 1" = 10'-0"

STATE OF HAWAII
DEPARTMENT OF TRANSPORTATION
HIGHWAYS DIVISION

KUNIA INTERCHANGE STRUCTURE

FOUNDATION & LAYOUT PLAN

INTERSTATE ROUTE H-1

F.A.I. PROJ. N° I-H-1(18) UNIT # 2


SCALE: AS SHOWN

JULY 1965


SHEET NO. 1 OF 3 SHEETS

DATE	DESIGNED BY	CHECKED BY
PLAN	NOTED BY	
ORIGINAL	NOTE BOOK	
QUANTITIES BY		


FED. ROAD DIST. NO.	STATE	FED. AID PROJ. NO.	FISCAL YEAR	SHEET NO.	TOTAL SHEETS
HAWAII	HAW.	2-111-1(18)	1965	52	75

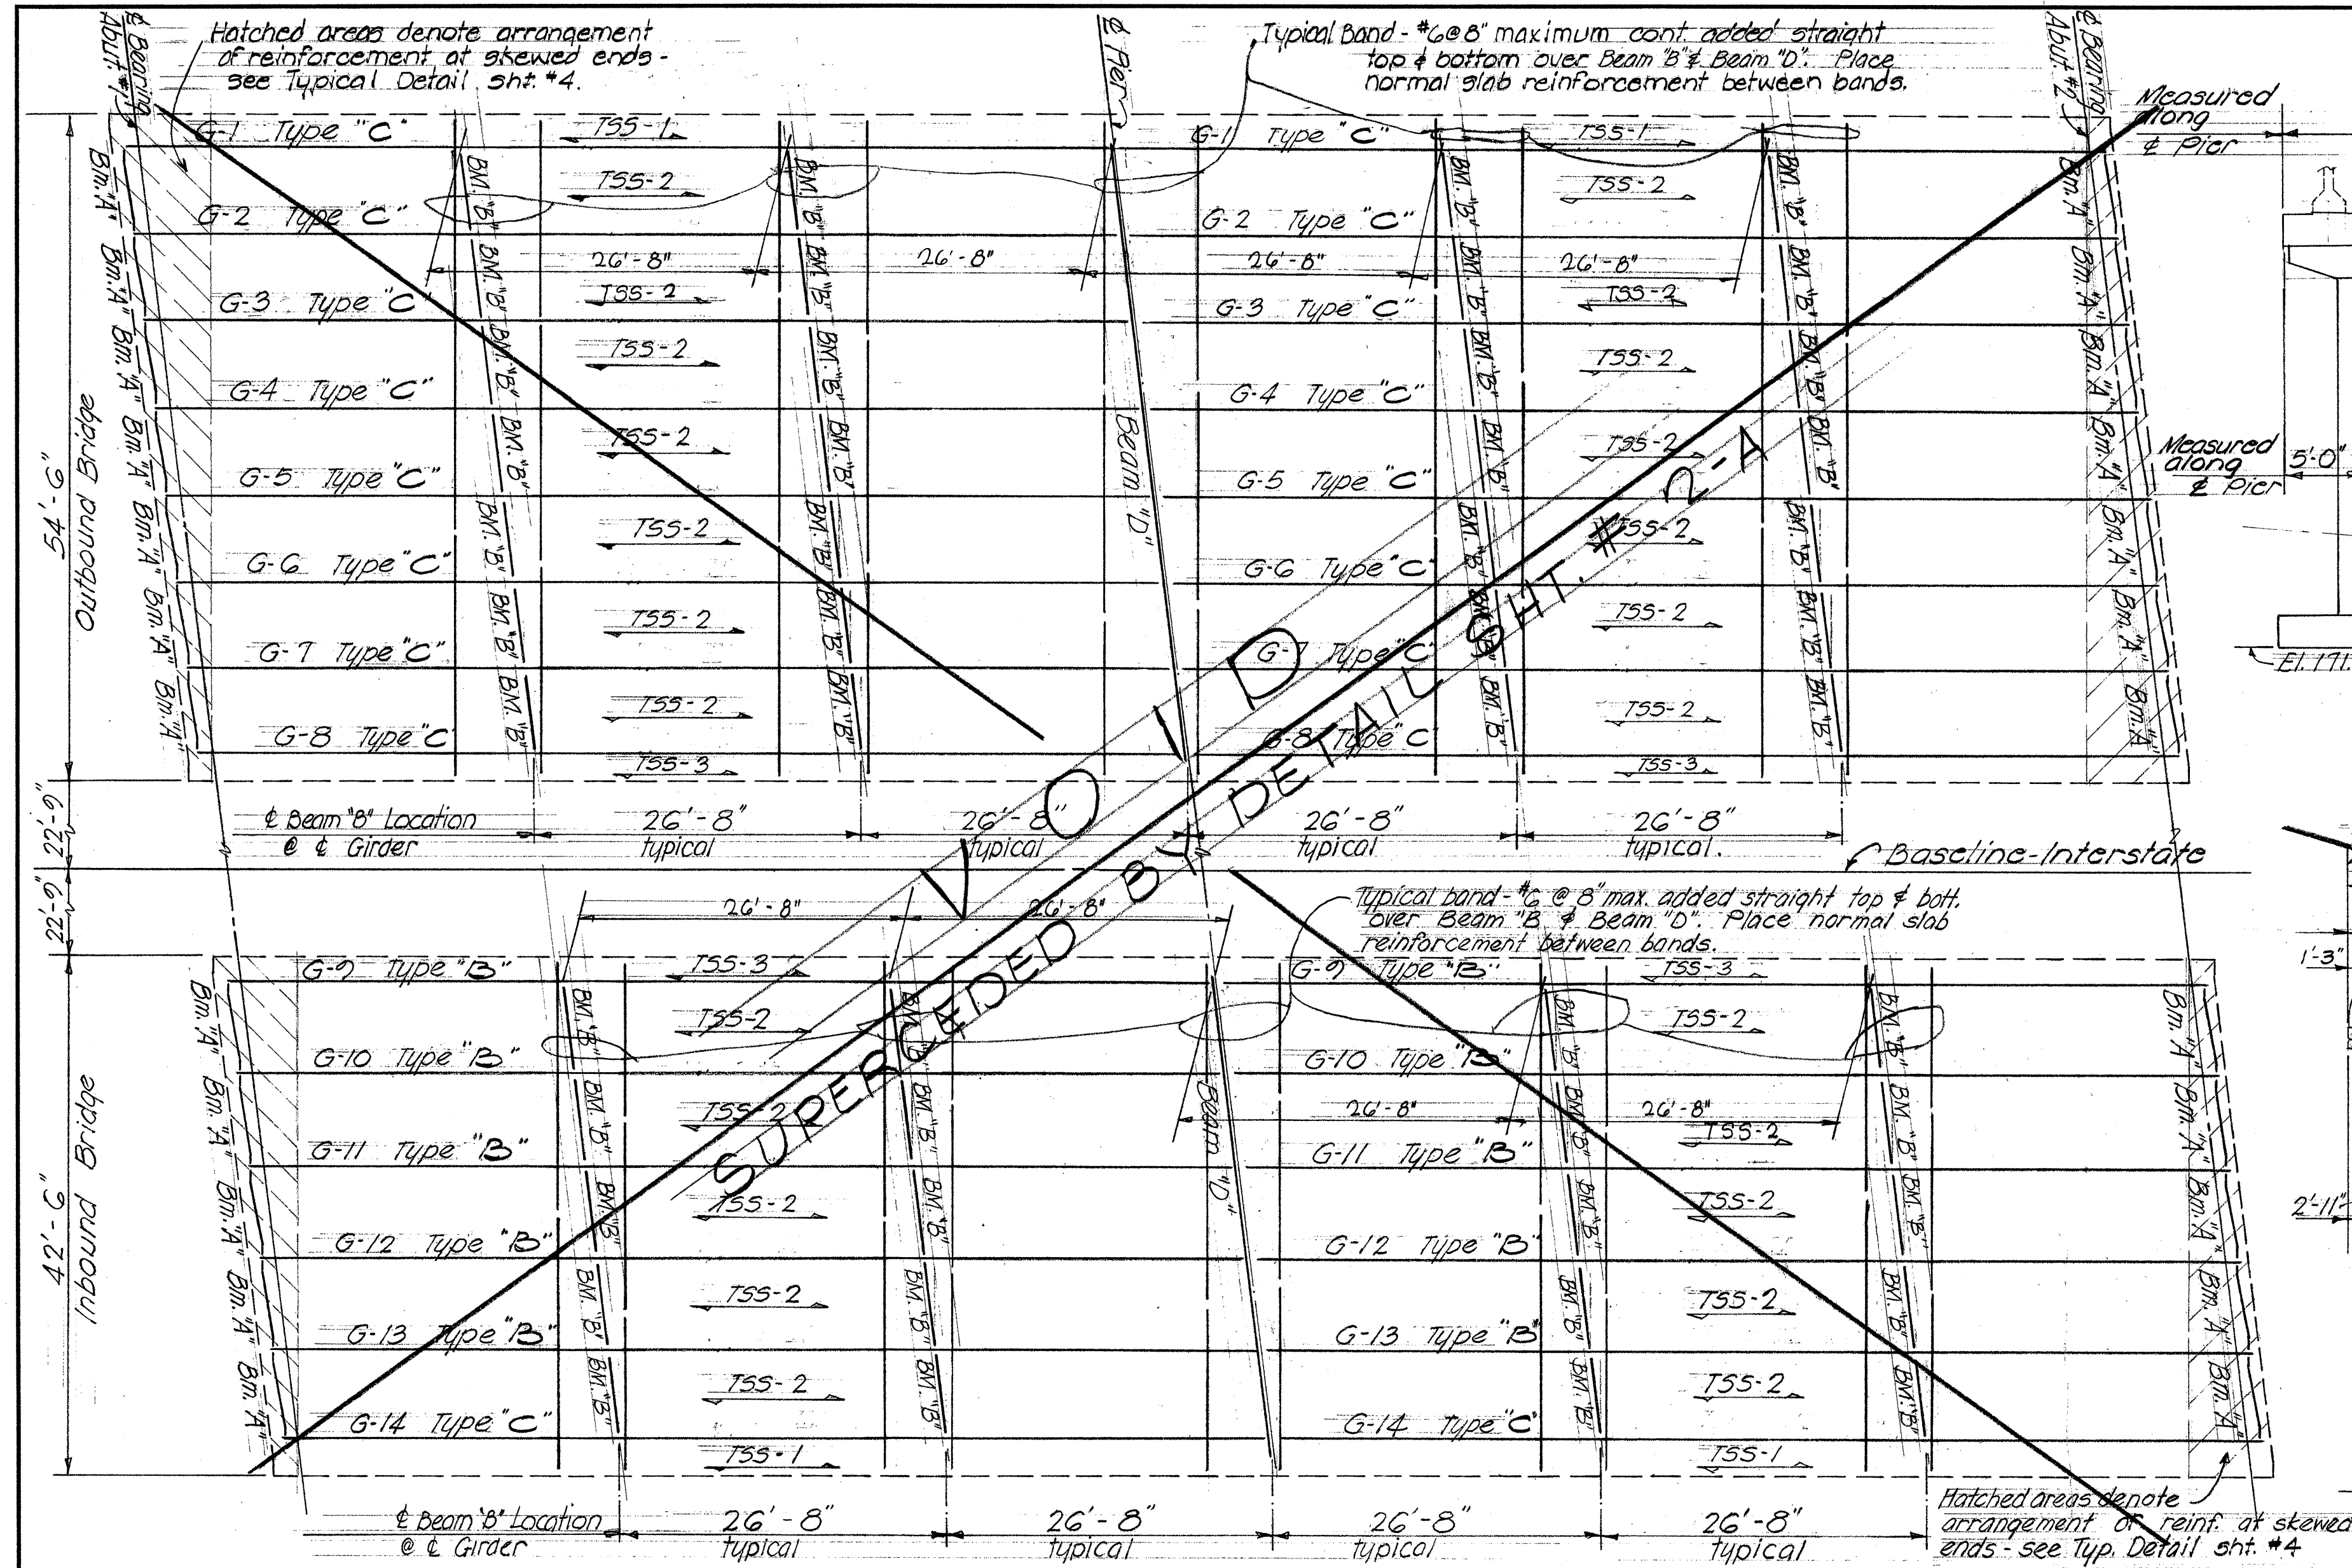

DECK FRAMING PLAN - INBOUND AND OUTBOUND BRIDGES
Scale: 1" = 10'-0"

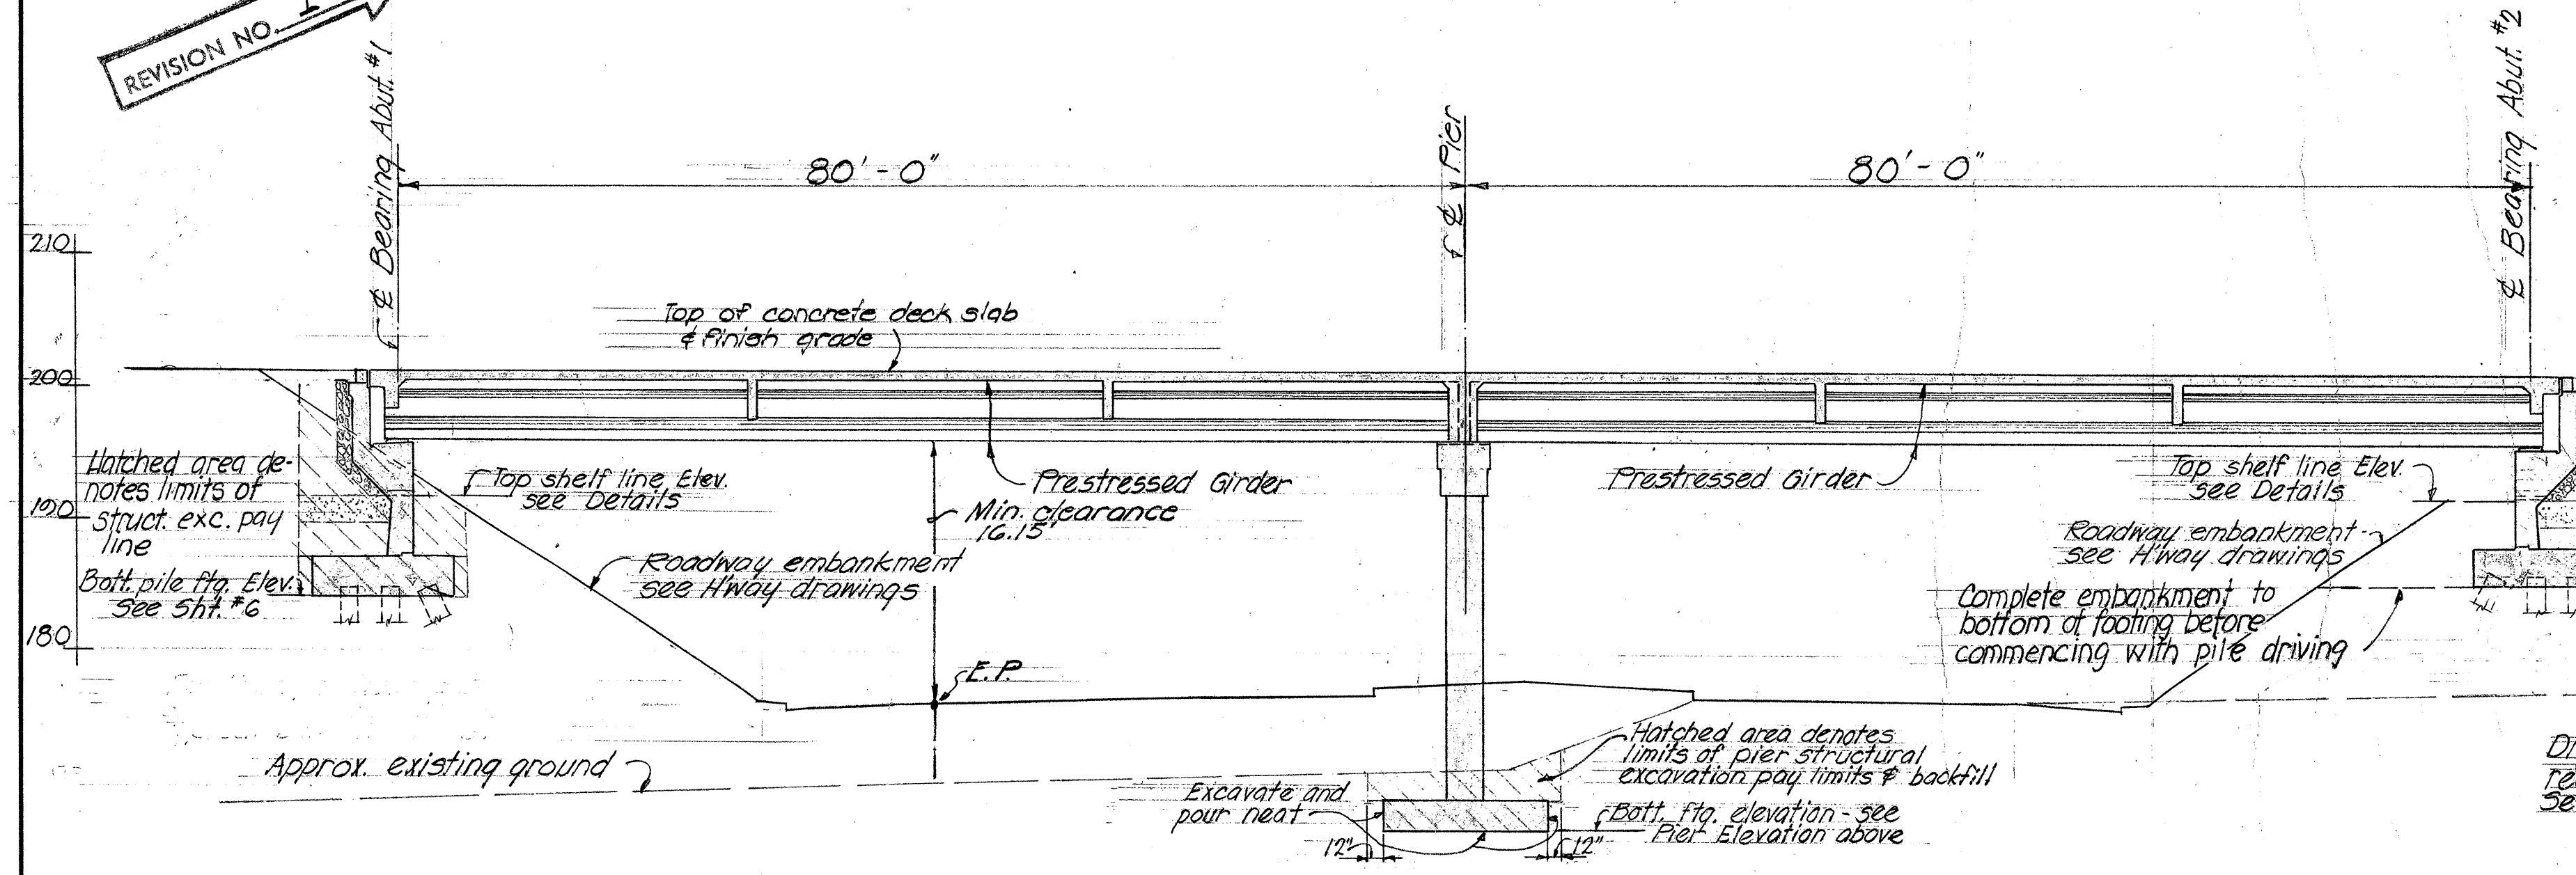


TYPICAL LONGITUDINAL SECTION - INBOUND OR OUTBOUND BRIDGES
Scale: 1" = 10'-0"

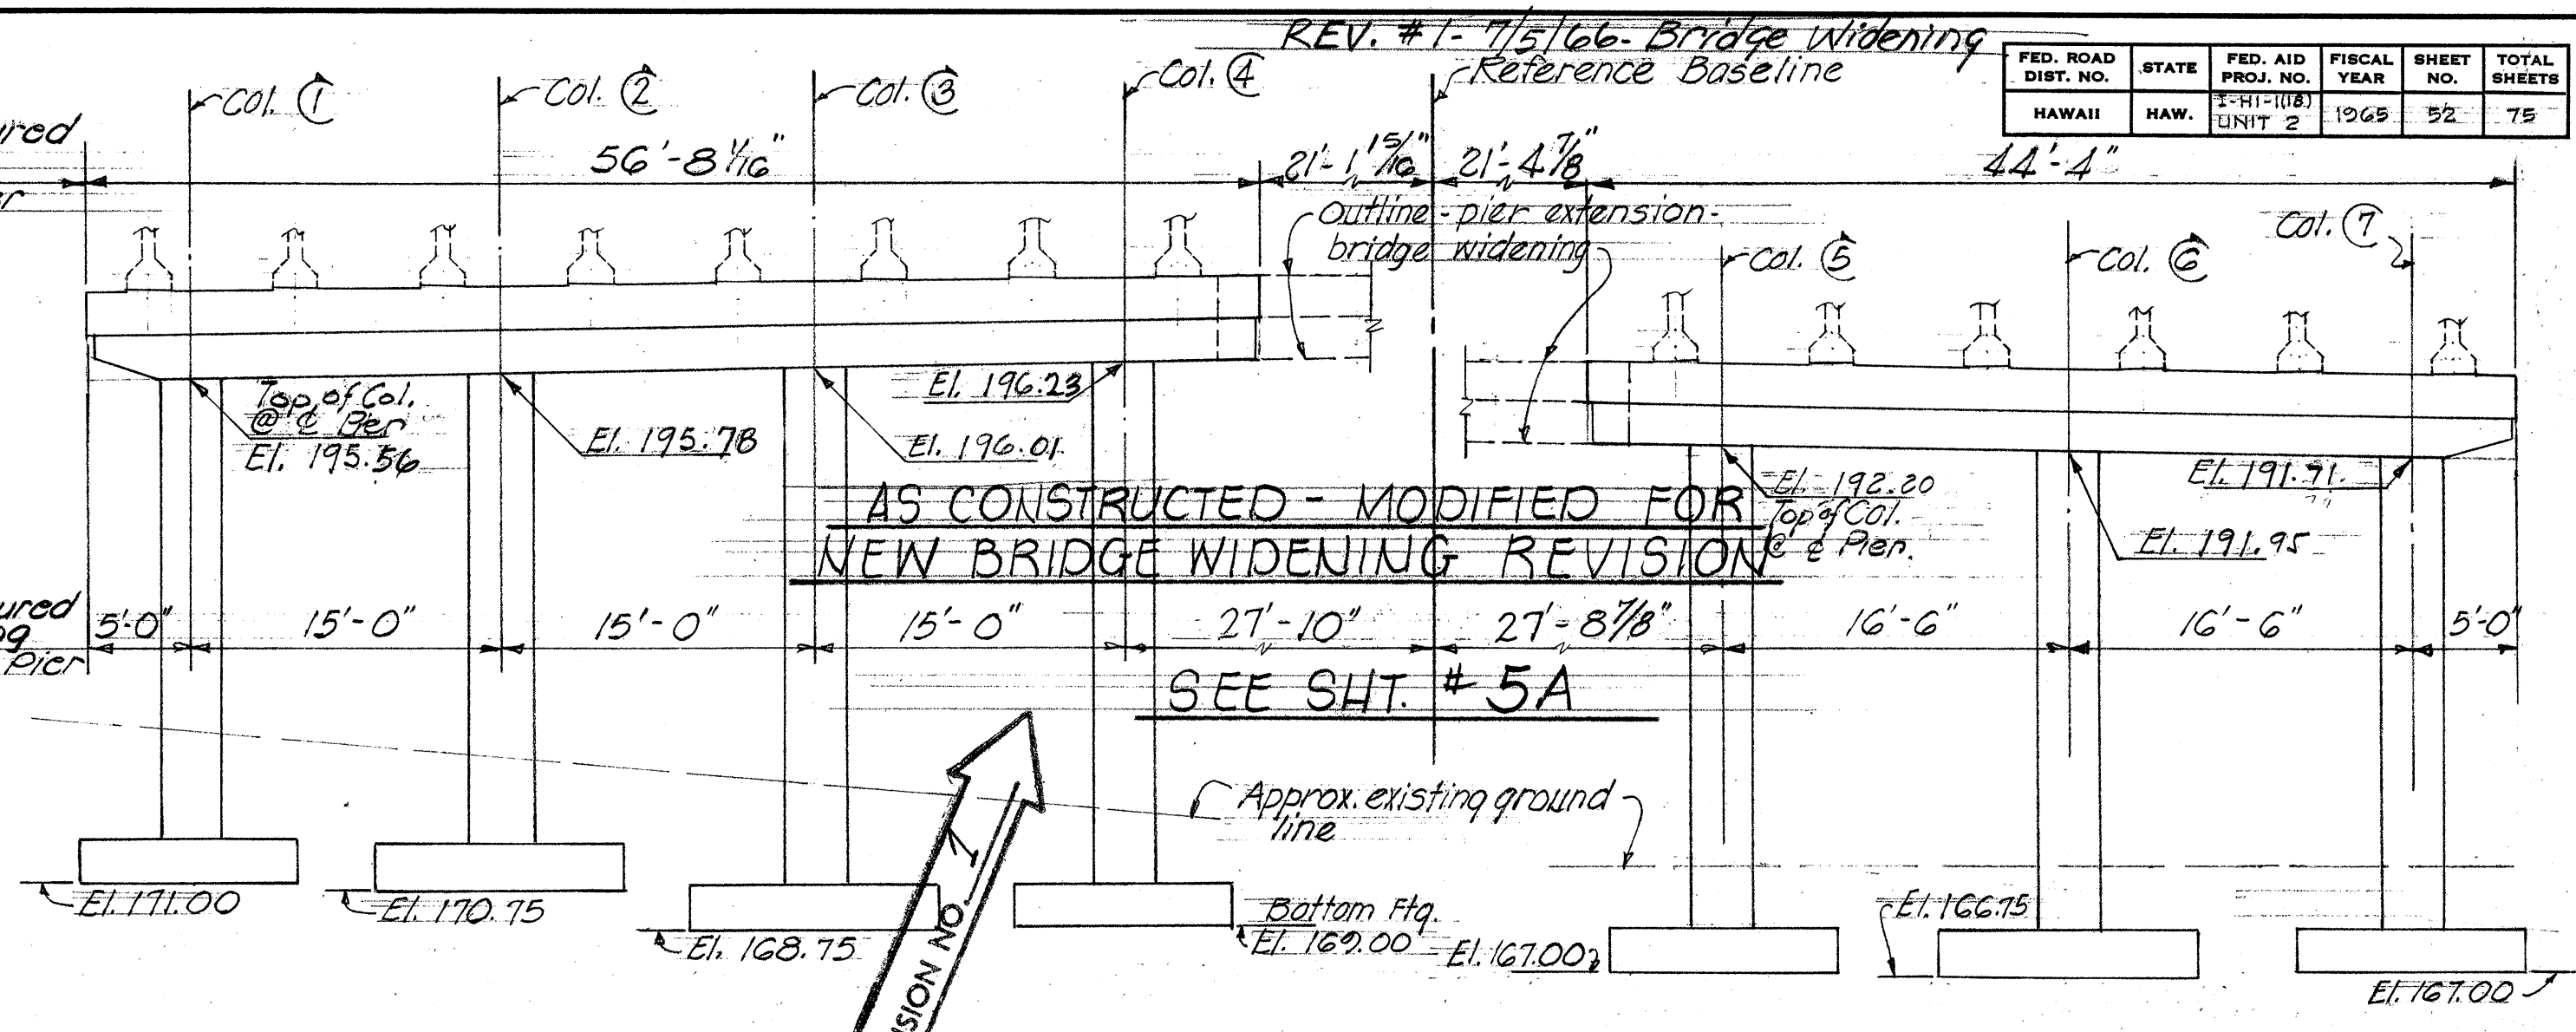

AS CONSTRUCTED - MODIFIED FOR
NEW BRIDGE WIDENING REVISION

SEE SHT. #5A

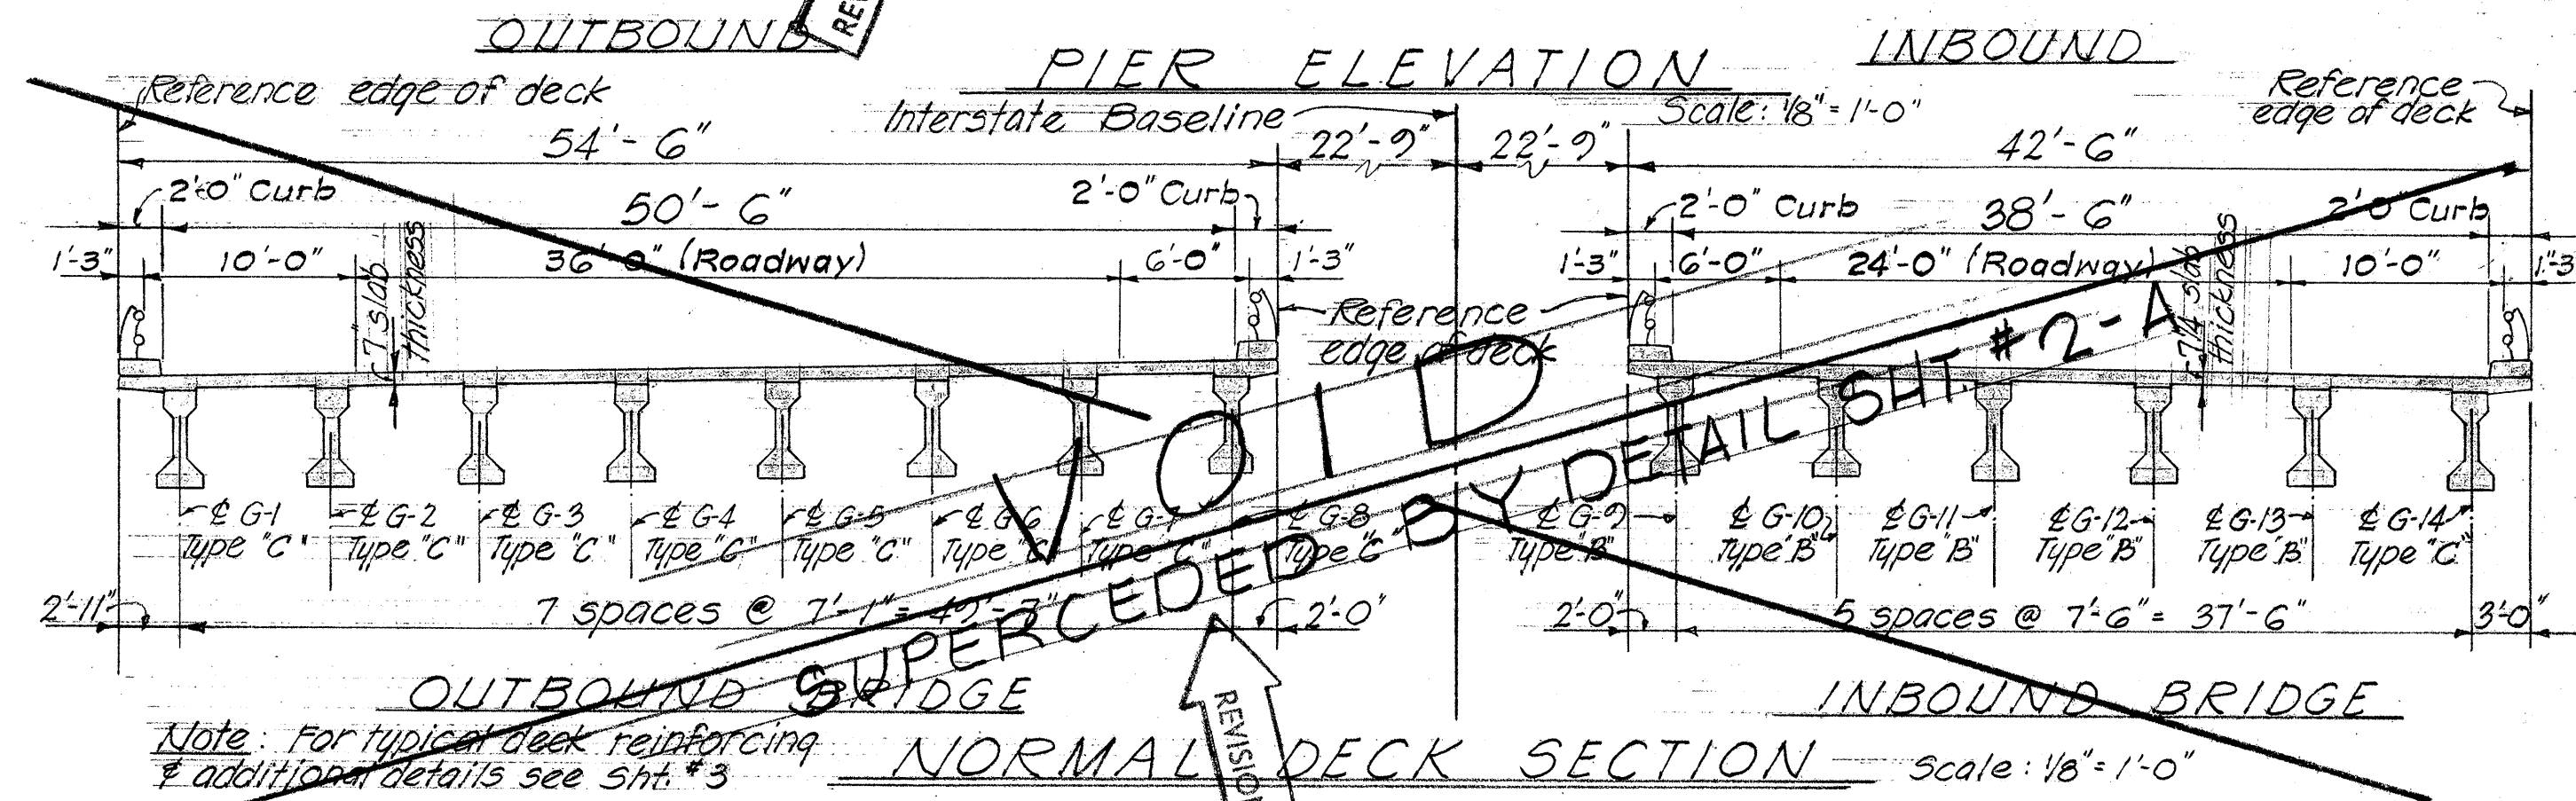

OUTBOUND BRIDGE

INBOUND BRIDGE

NORMAL DECK SECTION Scale: 1/8" = 1'-0"


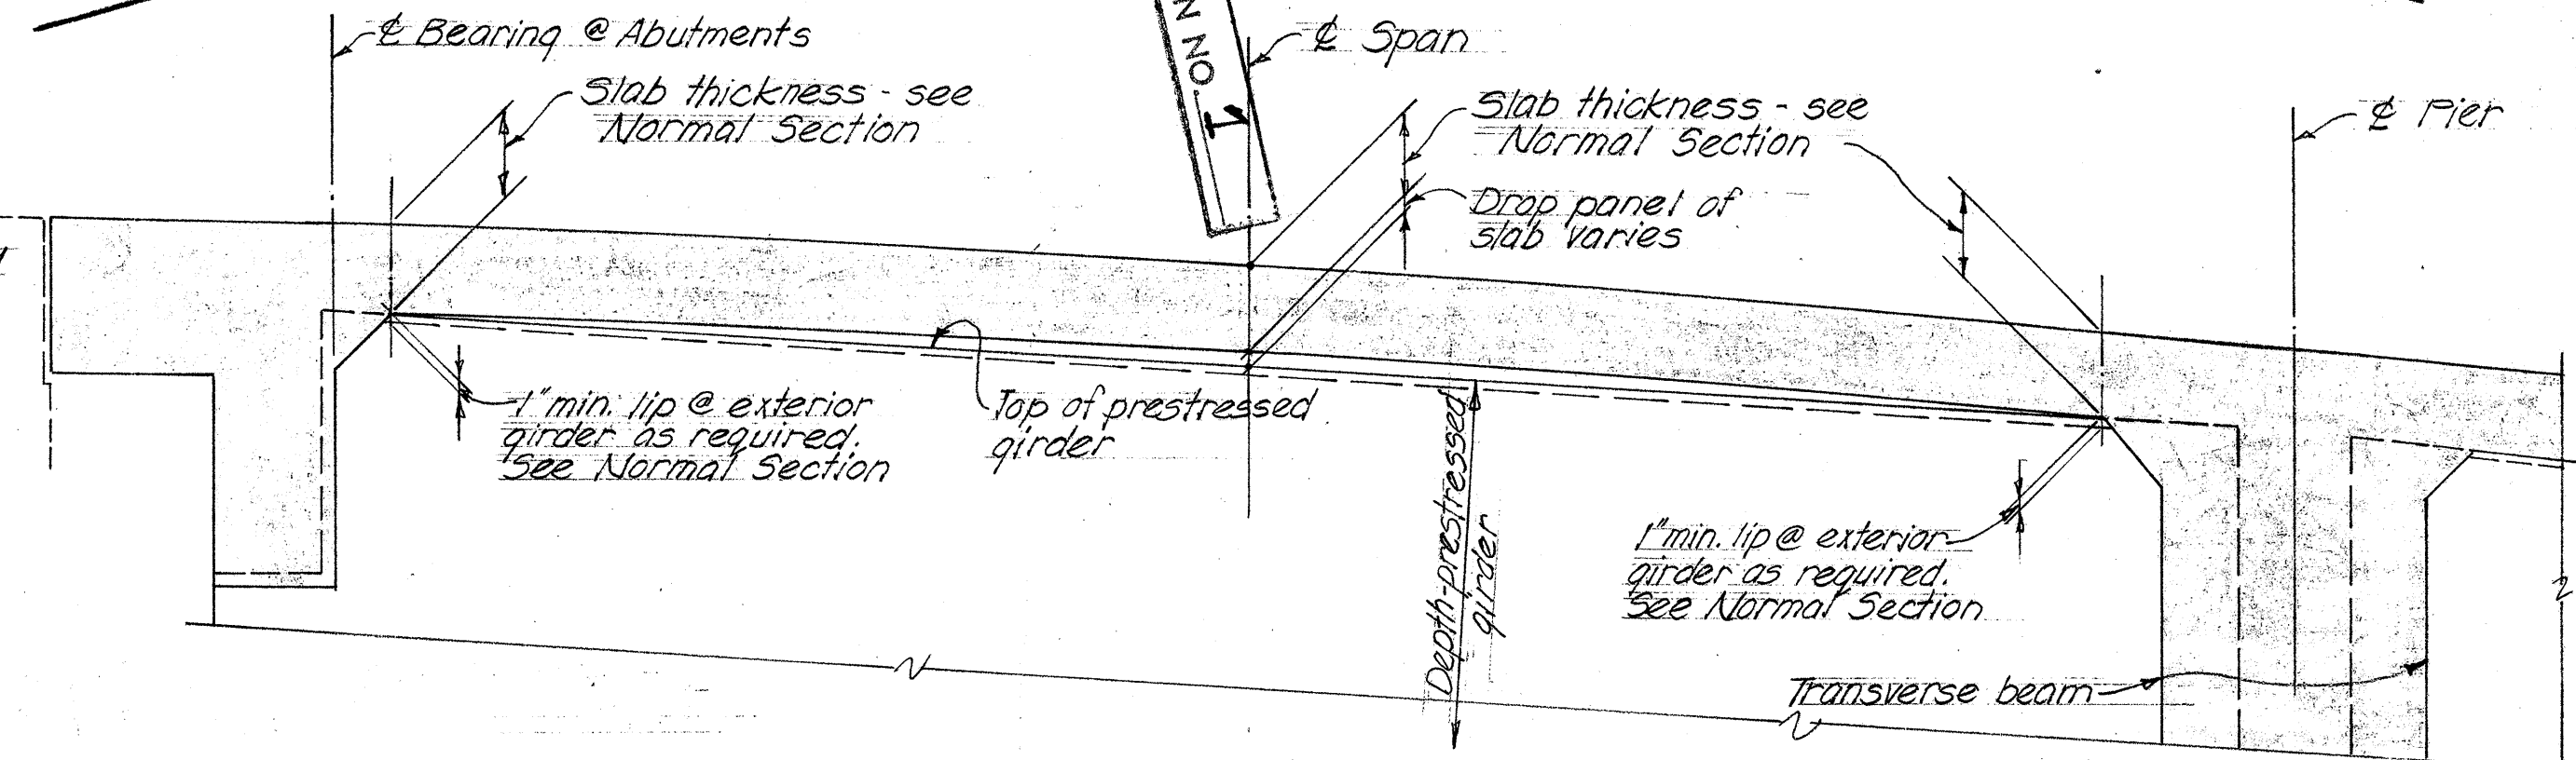


DIAGRAM SHOWING DROP PANEL OF SLAB AT EACH GIRDER
No Scale

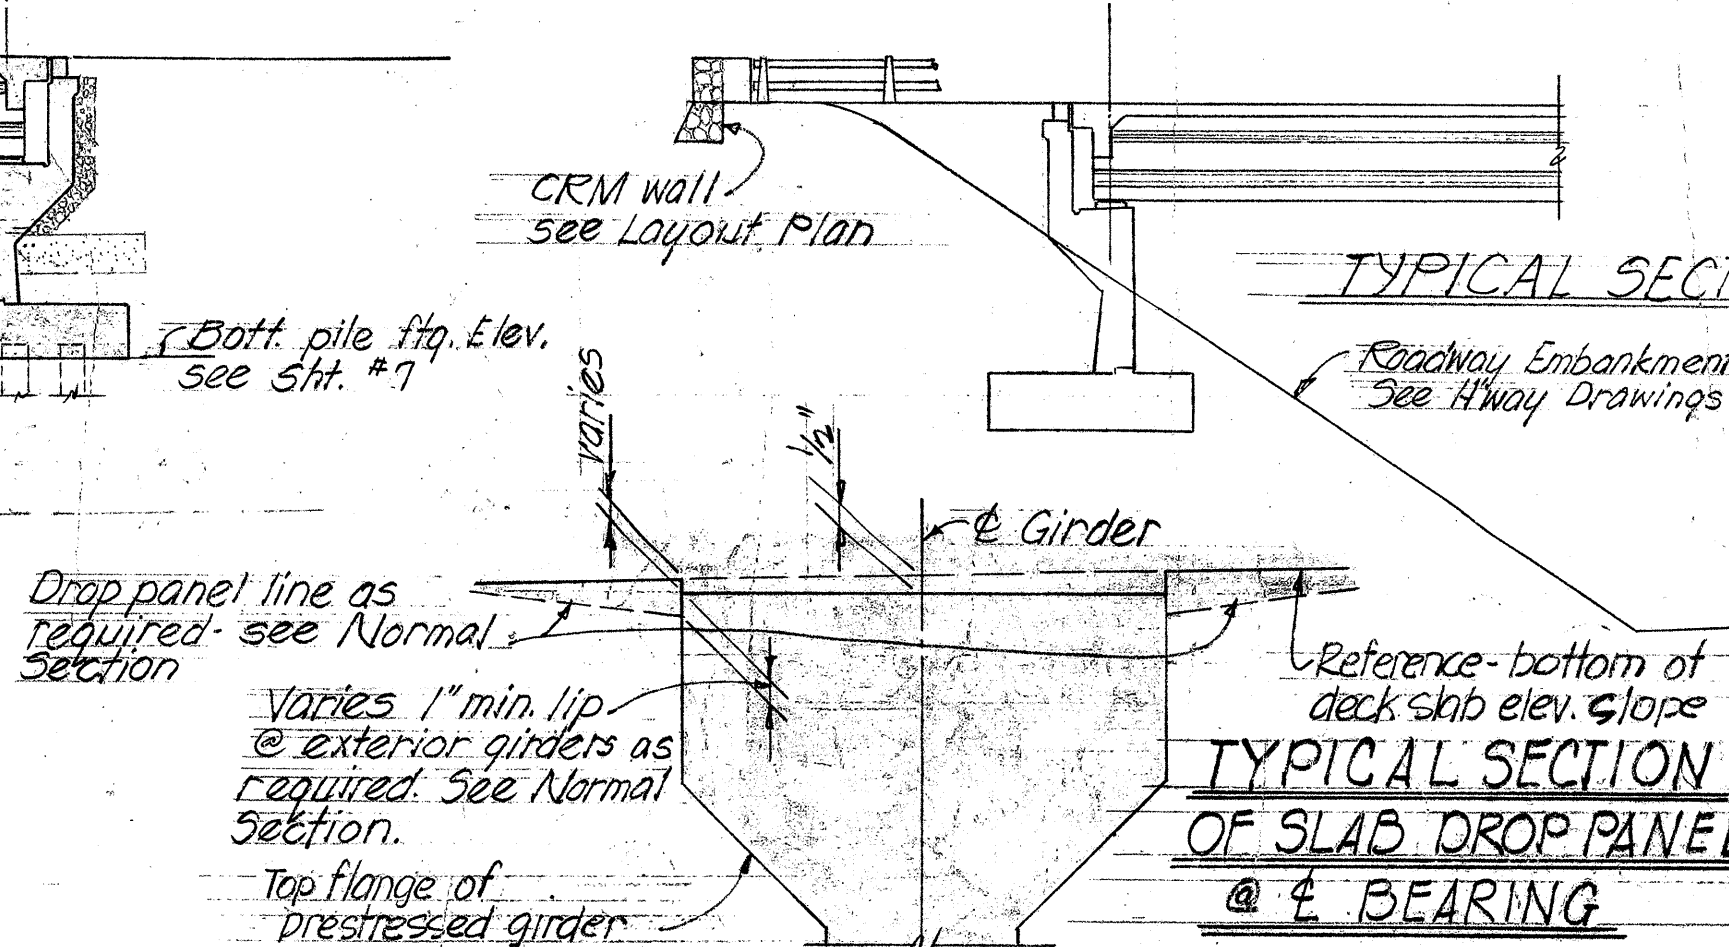

TYPICAL SECTION (B)

TYPICAL SECTION
OF SLAB DROP PANEL
@ BEARING

STATE OF HAWAII
DEPARTMENT OF TRANSPORTATION
HIGHWAYS DIVISION

KUNIA INTERCHANGE STRUCTURE
FRAMING PLAN, SECTIONS & DETAILS

INTERSTATE ROUTE H-1
F.A.I. PROJ. NO. 2-HI-1(18) UNIT 2
SCALE: AS SHOWN JULY 1965

SHEET NO. 2 OF 5 SHEETS


C 0 5 2

FED. ROAD DIST. NO.	STATE	FED. AID PROJ. NO.	FISCAL YEAR	SHEET NO.	TOTAL SHEETS
HAWAII	HAW.	1-H-1(18) UNIT 2	1965	52A	75

REV. #1 7/5/66 BRIDGE WIDENING

ORIGINAL PLAN BRIDGE WIDENING


± Girder G-8 or G-9

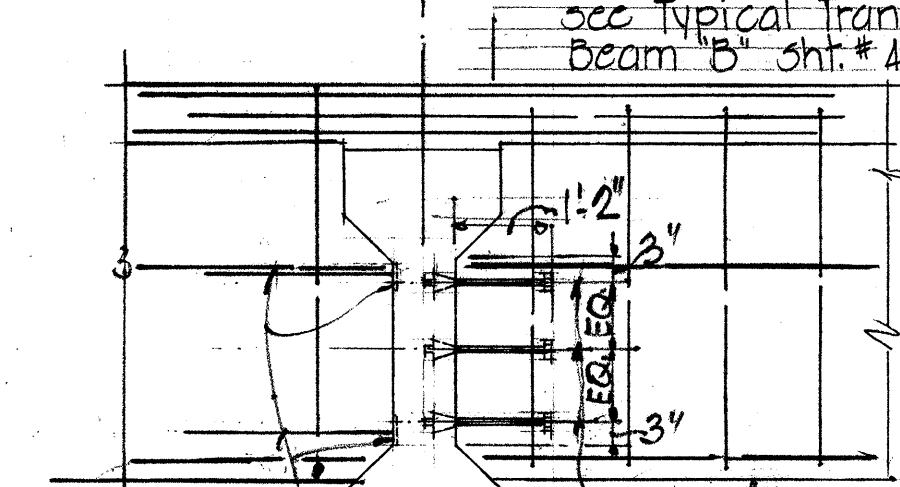


NOTE: For reinforcing see Typical Transverse Beam "B" sht. #4
 3-1/8" Anchor bolts & expansion shields, center on Beam "B" - see framing plan for location.
 Typ. weld & anchors at non-cont. ends. see

SPECIAL BEAM "B" CONNECTION AT GIRDERS G-8 & G-9

Scale: 1/2" = 1'-0"

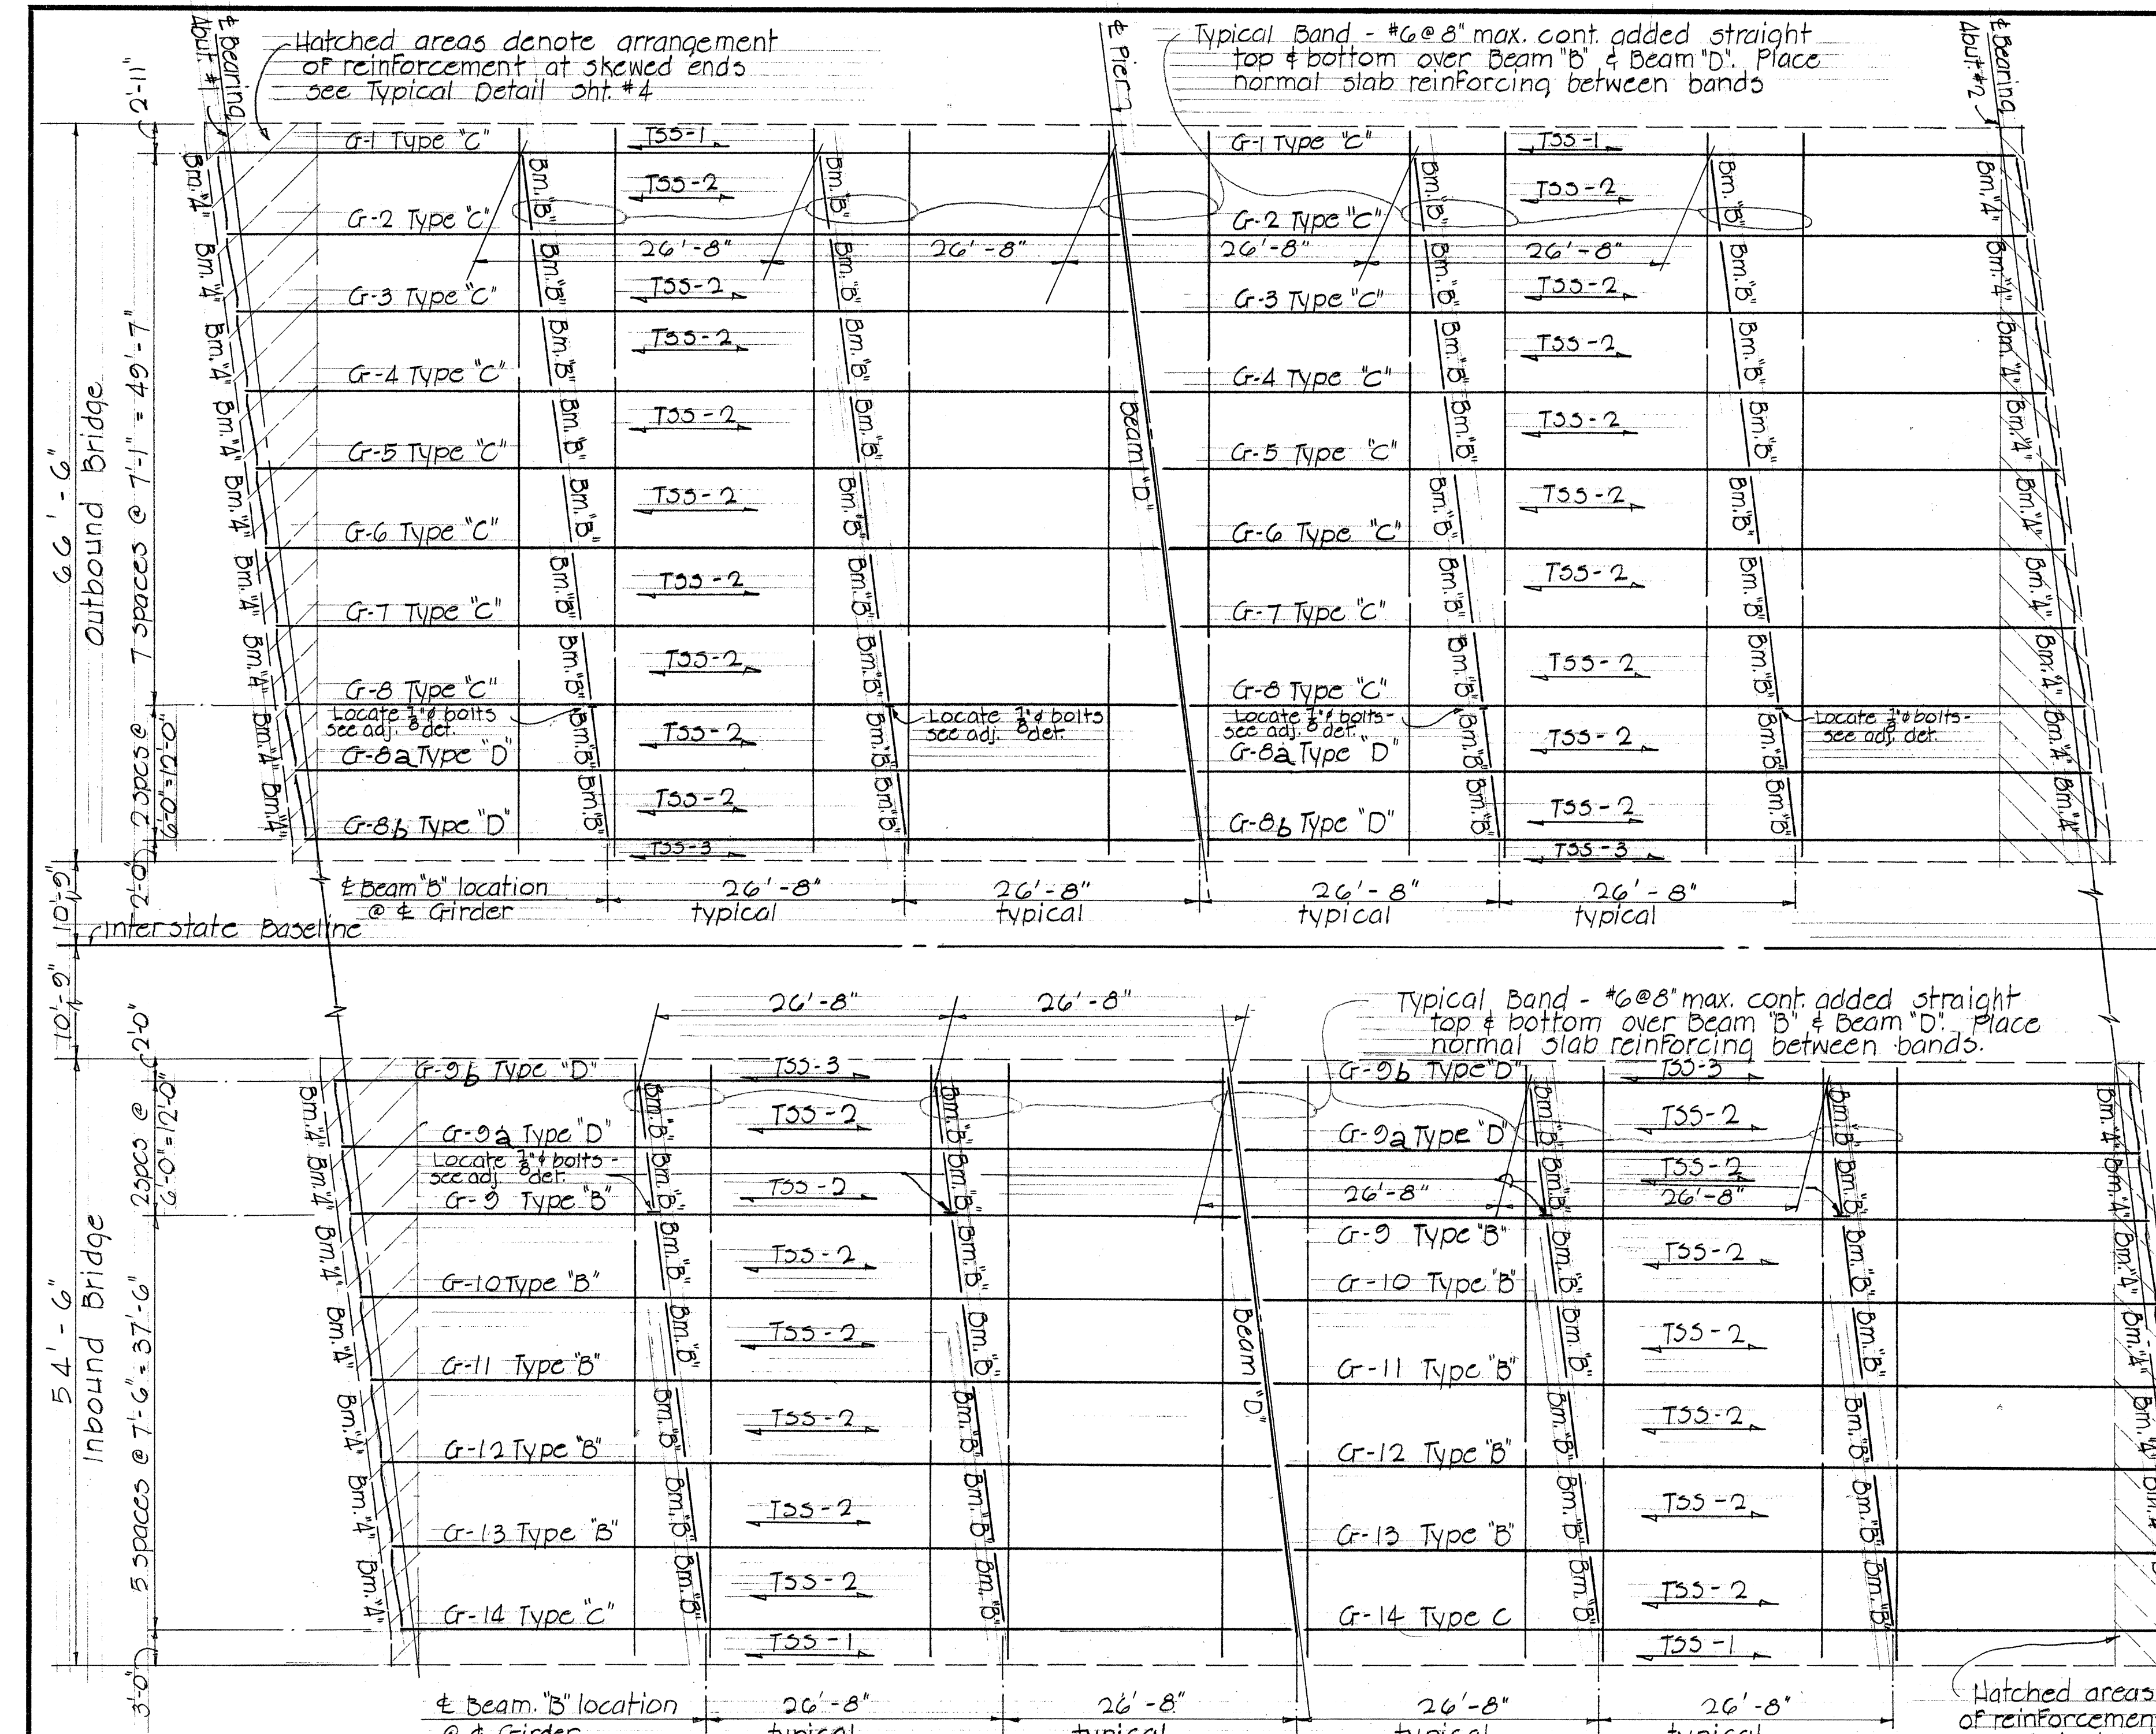

DECK FRAMING PLAN - INBOUND AND OUTBOUND BRIDGES

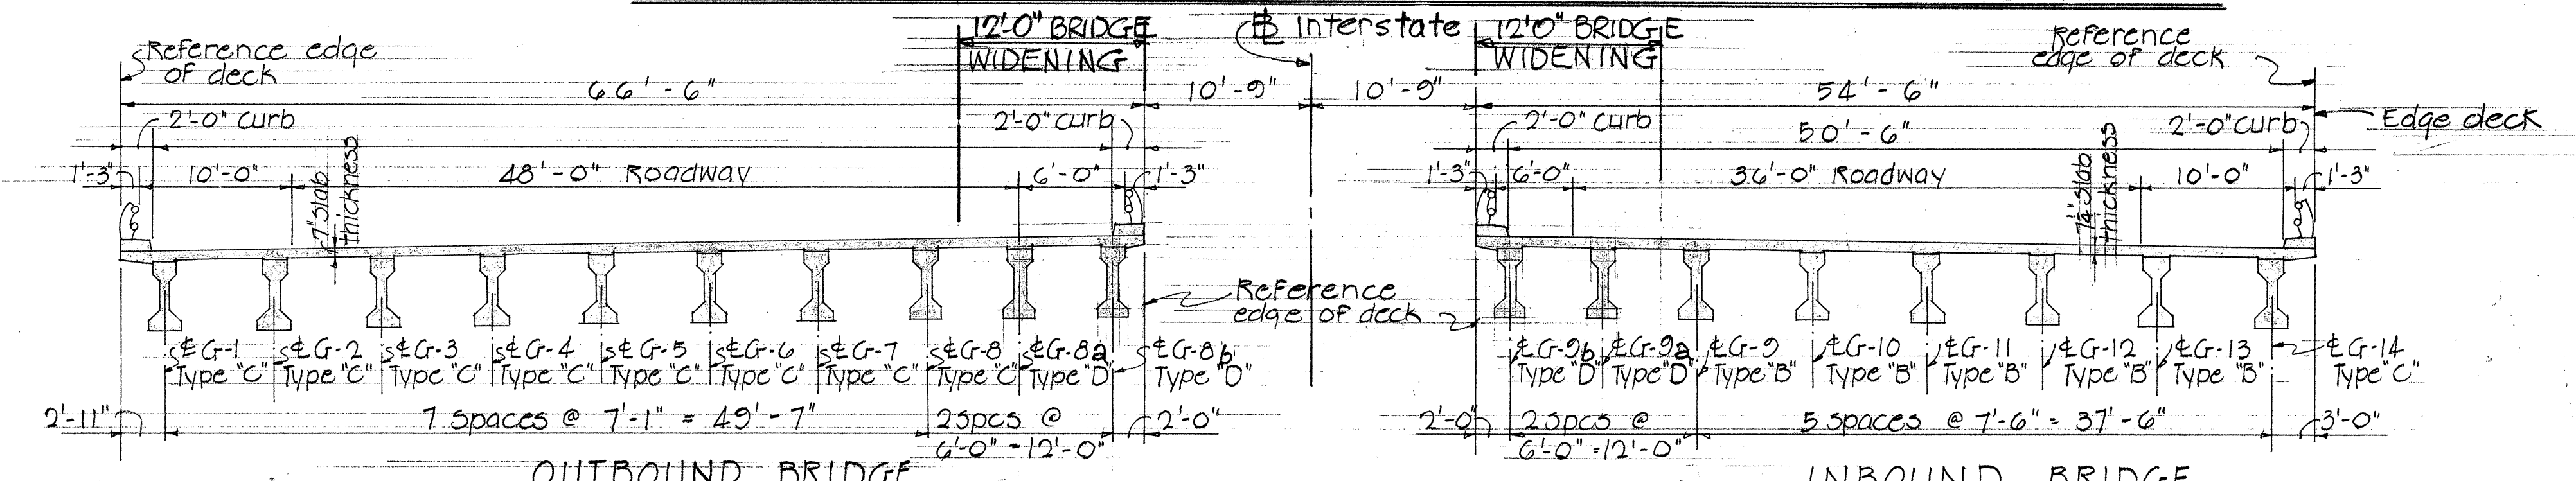


NOTE: For typical deck reinforcing & additional details see sht. #3

NORMAL DECK SECTION Scale: 1/8" = 1'-0"


REVISION No 1 JULY 5, 1966

STATE OF HAWAII
 DEPARTMENT OF TRANSPORTATION
 HIGHWAYS DIVISION
 KUNIA INTERCHANGE STRUCTURE
 FRAMING PLAN, SECTIONS & DETAILS
 INTERSTATE ROUTE H-1
 F.A.I. PROJ. No I-H-1(18) UNIT 2
 SCALE: AS SHOWN July 1966
 SHEET No. 2A OF 13 SHEETS


52A

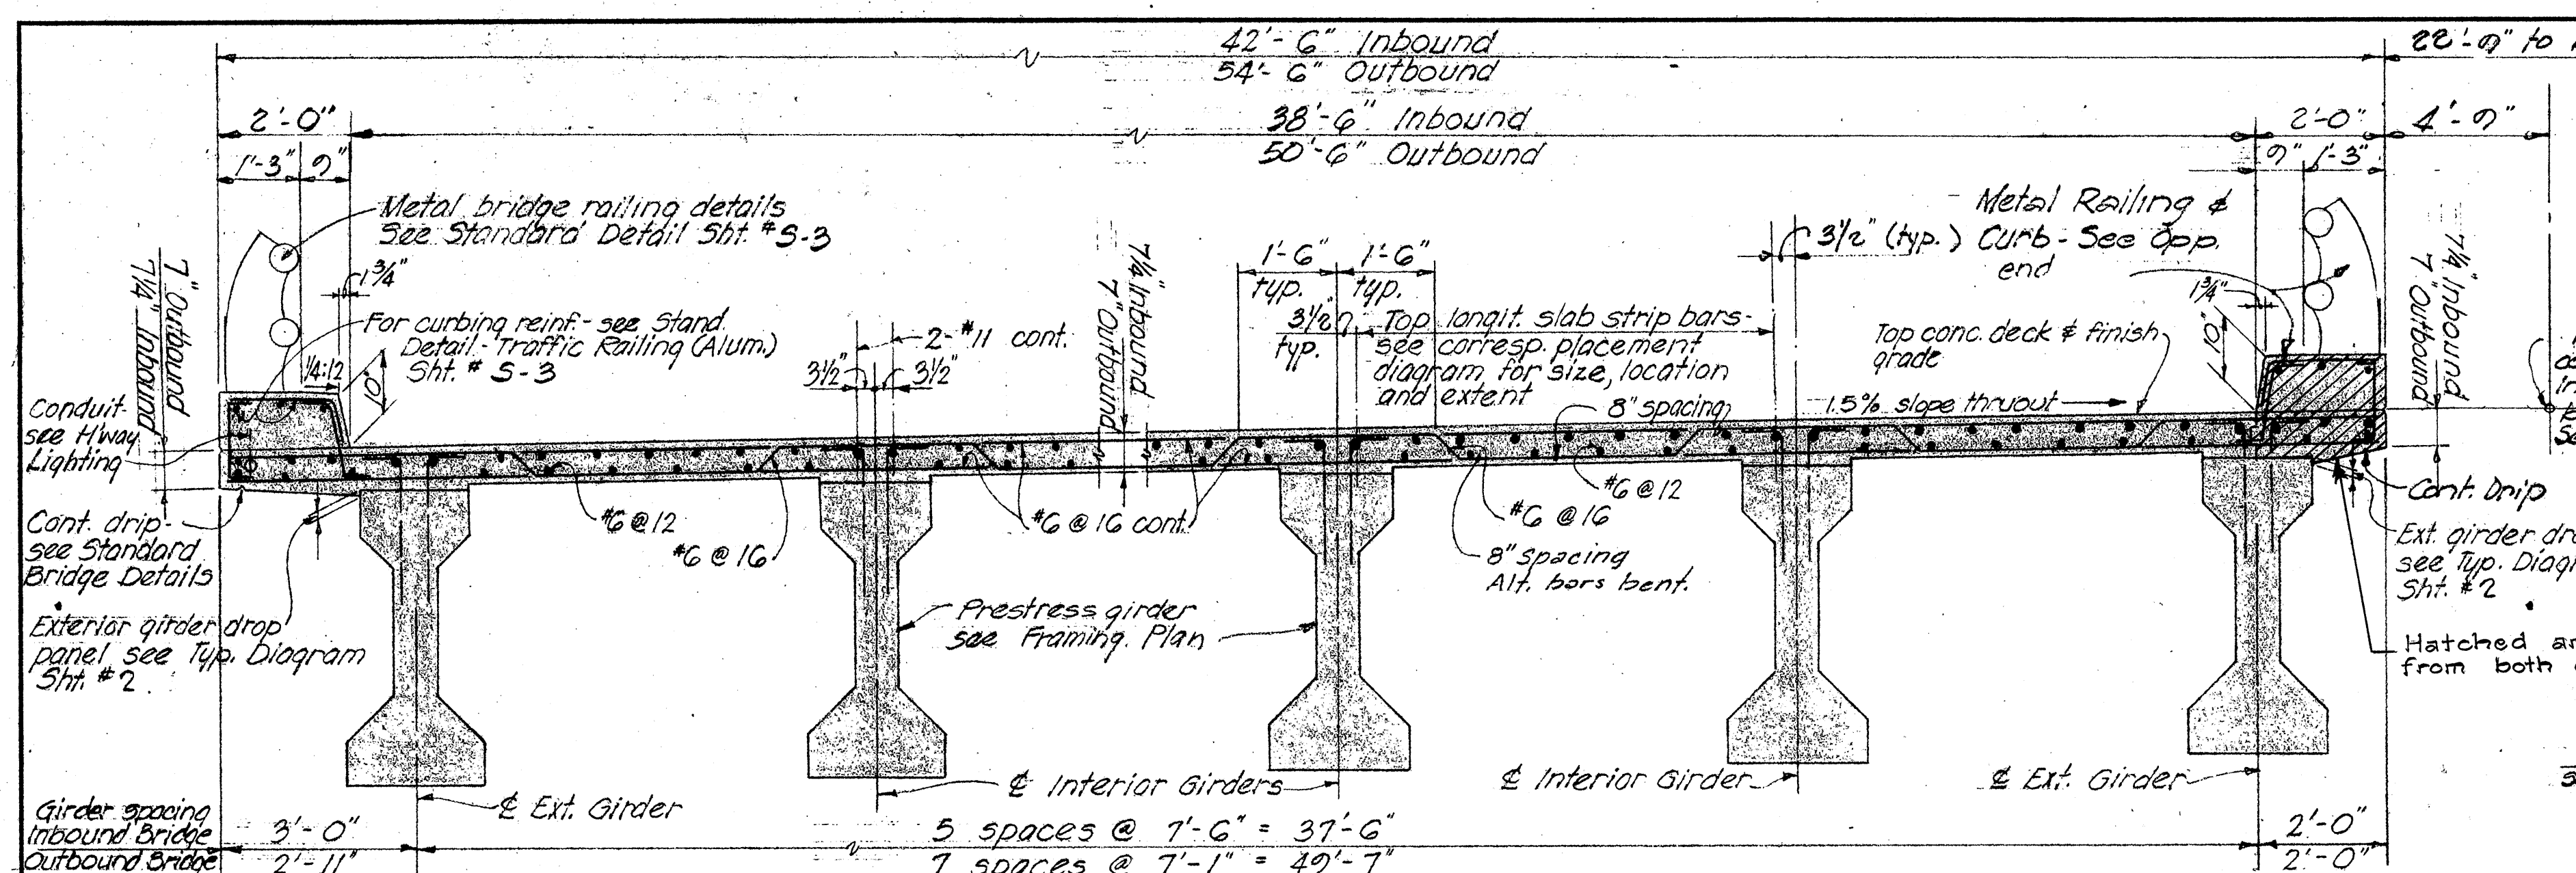


NORMAL DECK SECTION - INBOUND or OUTBOUND BRIDGES
Scale: 1/8" = 1'-0"

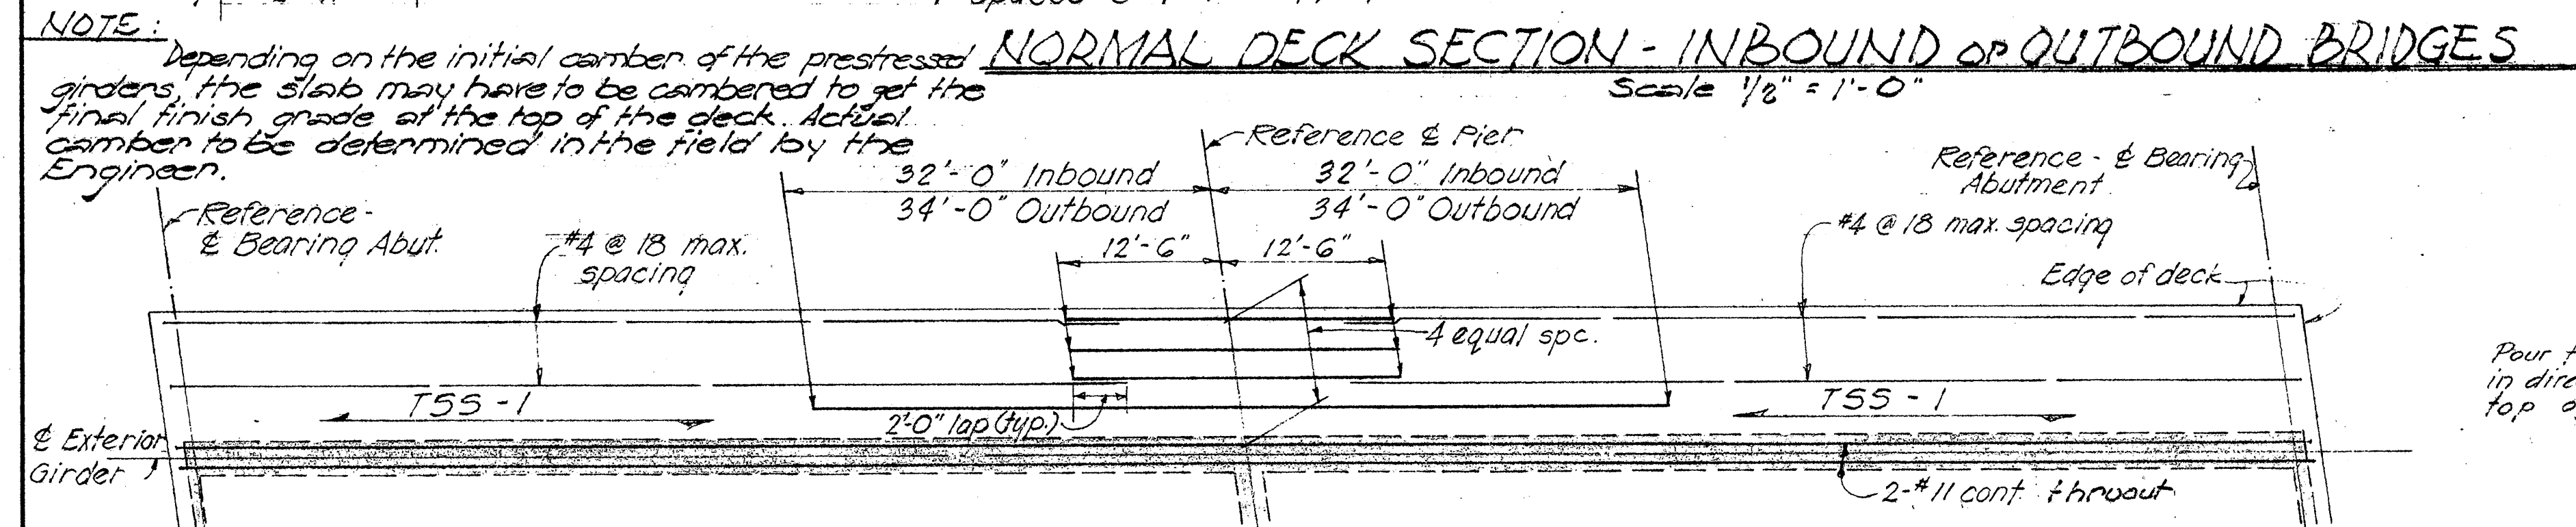


TYPICAL ARRANGEMENT OF REINFORCEMENT - TOP SLAB STRIP TSS-1

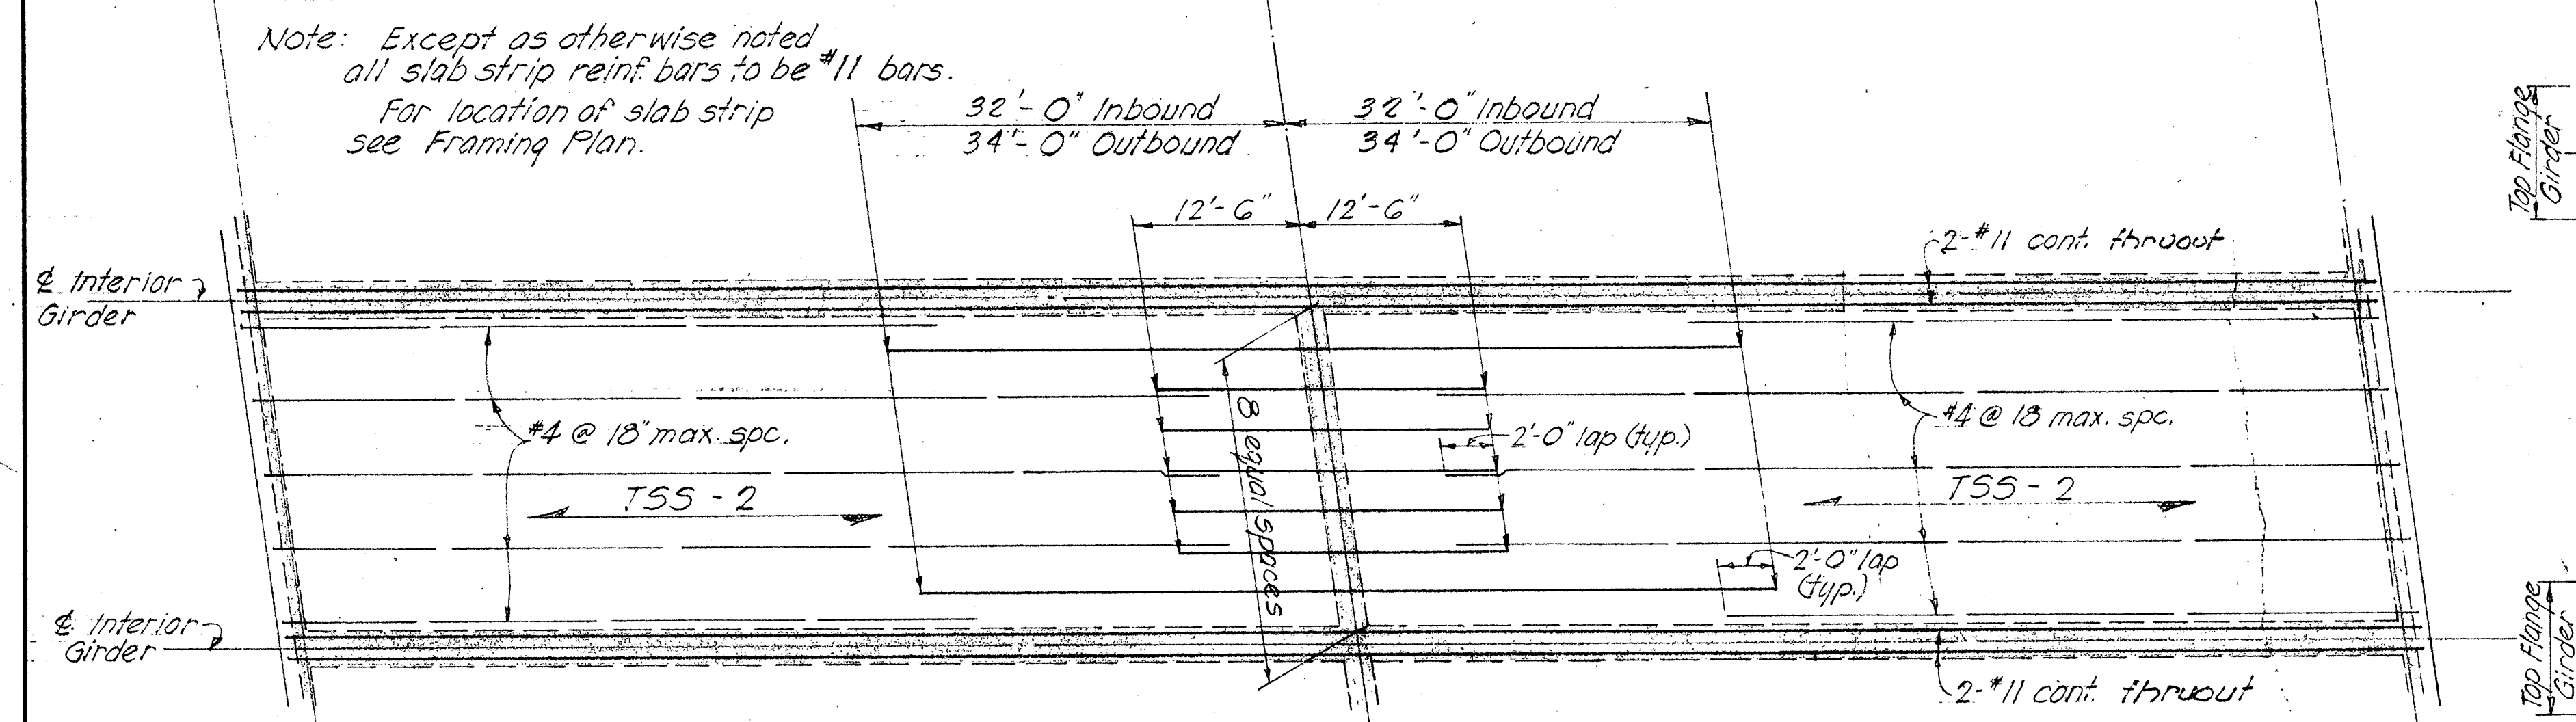


TYPICAL ARRANGEMENT OF REINFORCEMENT - TOP SLAB STRIP TSS-2
Scale: Horiz. 1" = 10'-0" Vert. 3/8" = 1'-0"

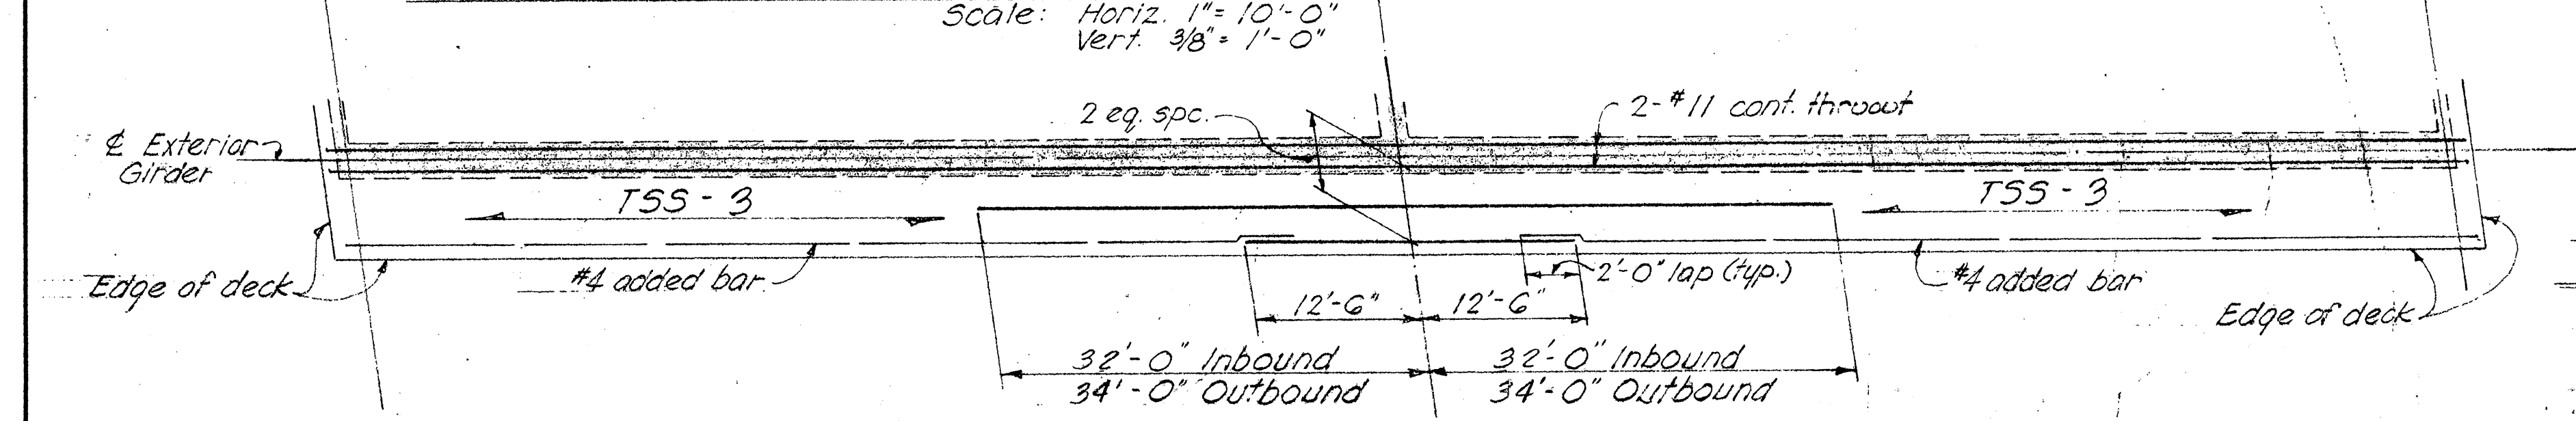


TYPICAL ARRANGEMENT OF REINFORCEMENT - TOP SLAB STRIP TSS-3

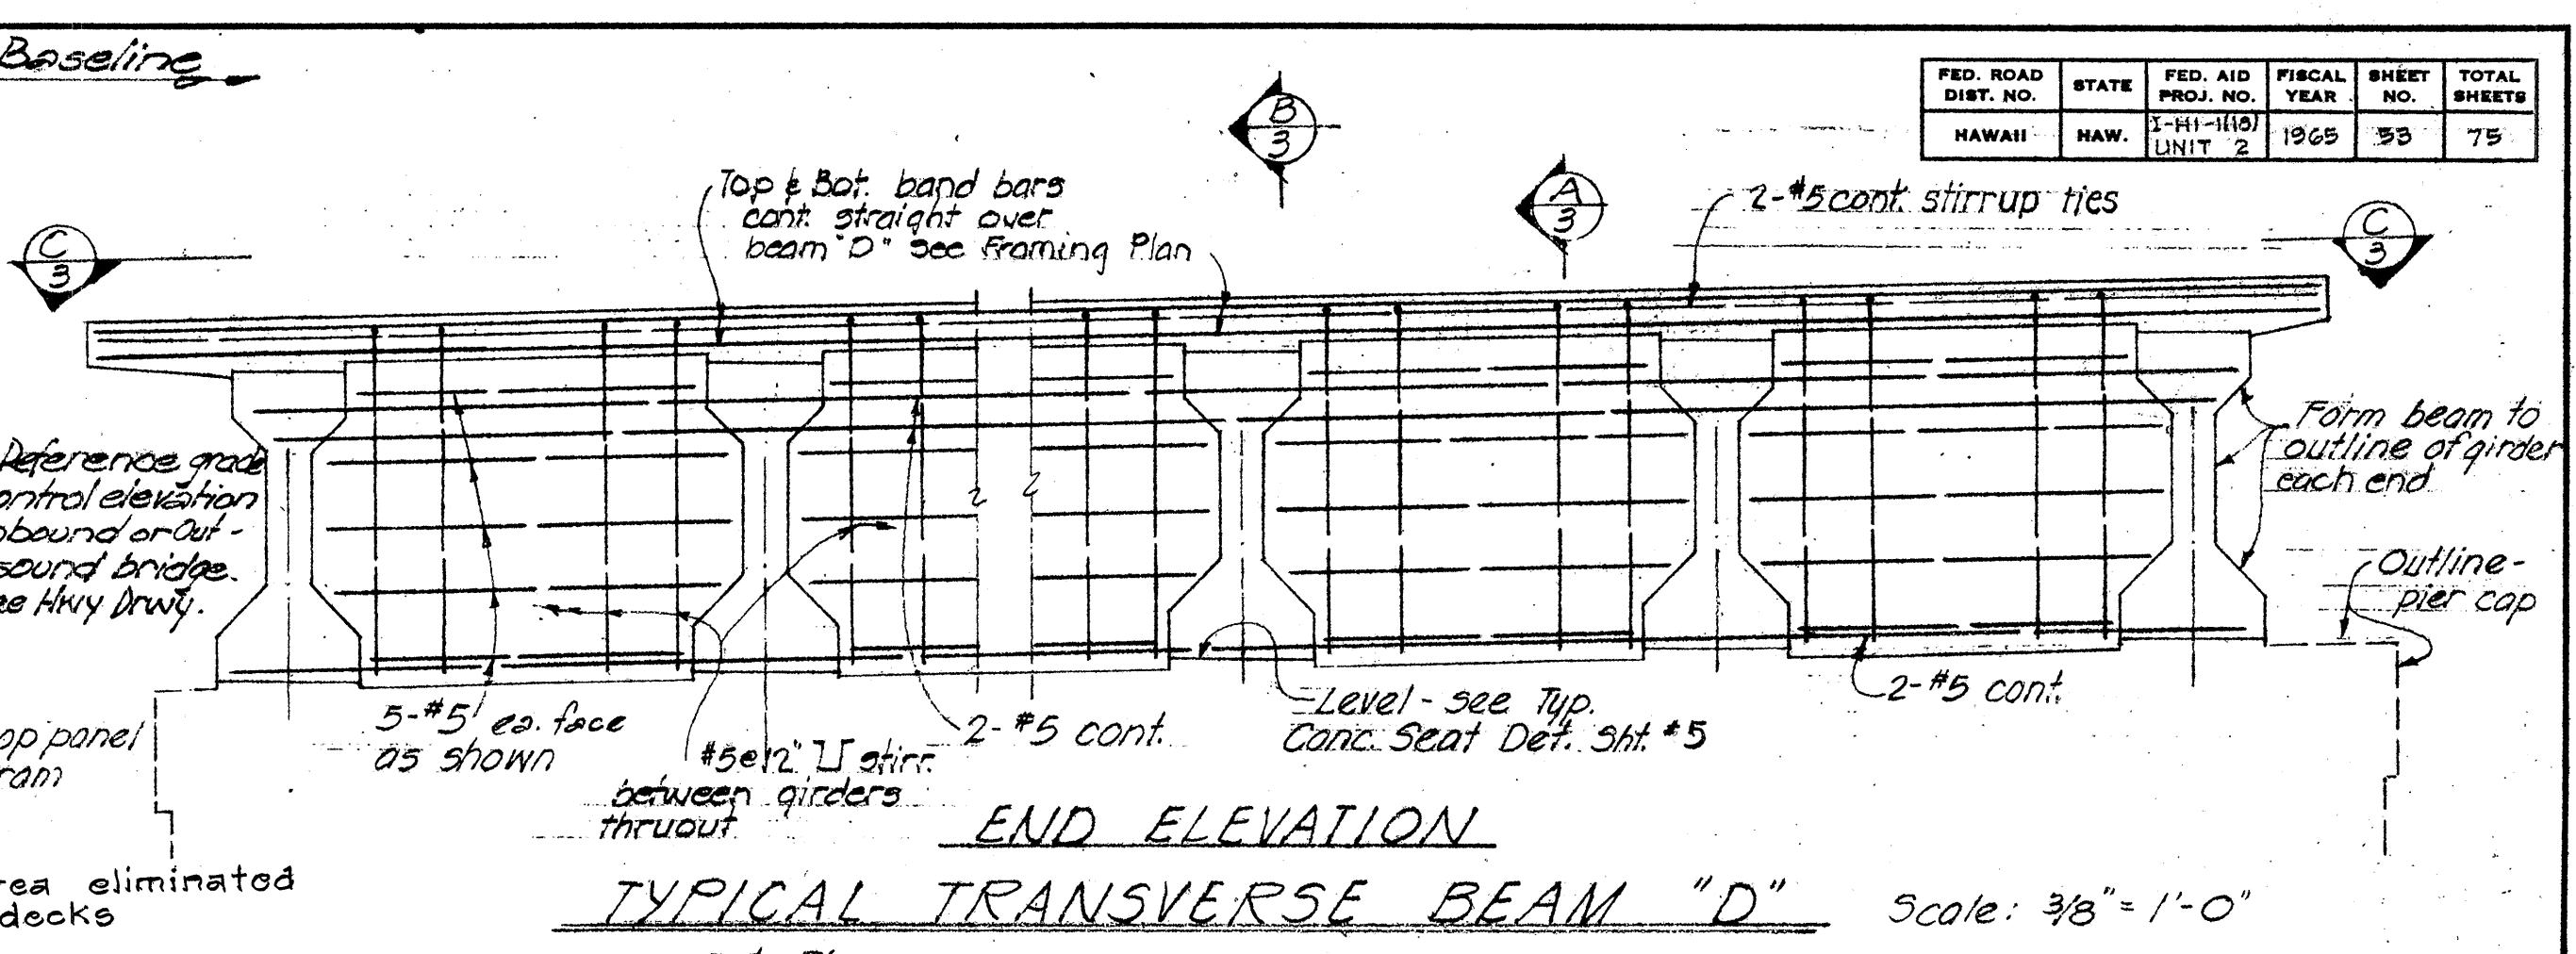

END ELEVATION TYPICAL TRANSVERSE BEAM "D" Scale: 3/8" = 1'-0"

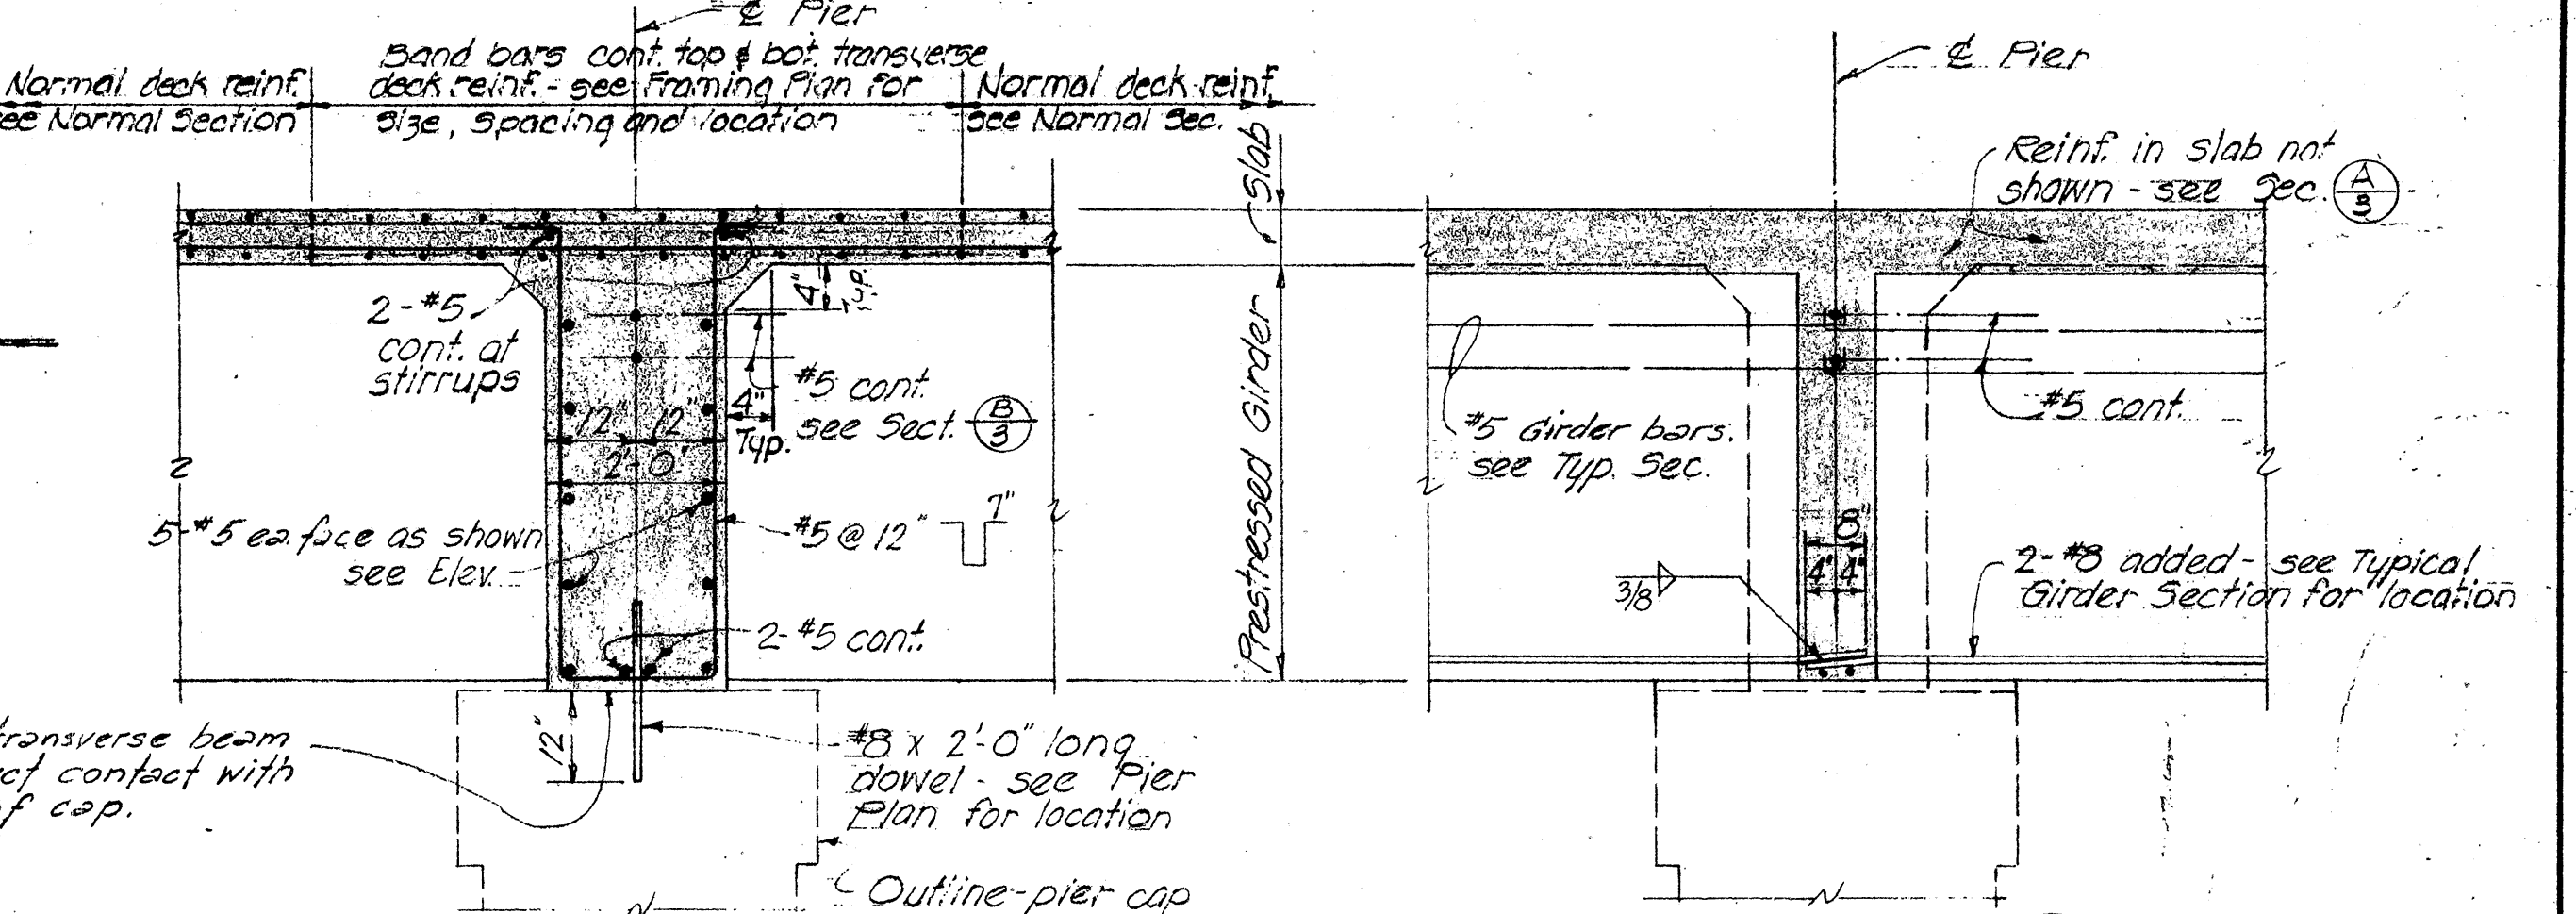

SECTION (A) (BETWEEN GIRDERS) SECTION (B) (AT GIRDER) TYPICAL SECTION - BEAM "D" Scale: 1/2" = 1'-0"


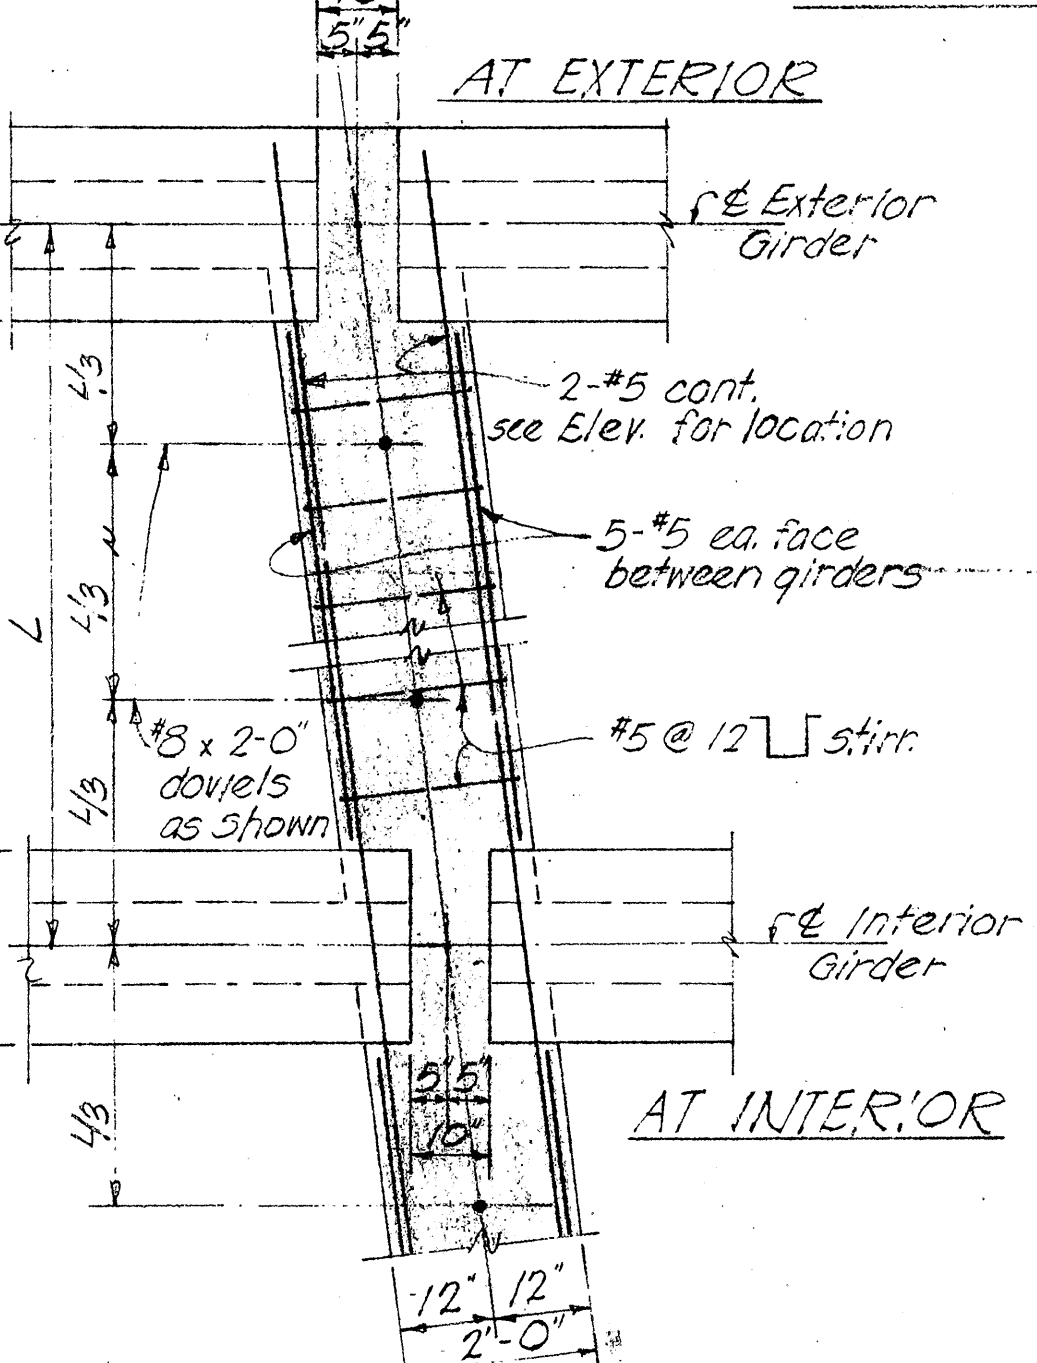


TRANSVERSE BEAM "D" PLAN TYPICAL ARRANGEMENT & LOCATION OF TRANSVERSE BEAM REINF. AT GIRDERS Scale: 1/2" = 1'-0"


ESTIMATED QUANTITIES		
Class A-1 Conc.: Lump Sum	(1,135 cu.yd.)	
Reinf. Steel: Lump Sum	(224,000 lbs.)	
Prestressed Girder: Lump Sum	(2,251 L.F.)	
Structural Exc.:	930 cu.yd.	
Filter Material:	70 cu.yd.	
C. R. M.:	20 cu.yd.	
Metal Bridge Railing (Traffic Railing):	780 L.F.	
Concrete Piles	4,700 L.F.	

DATE: _____
SURVEY PLOTTED BY: _____
DRAWN BY: _____
CHECKED BY: _____
NOTE BOOK: _____
No. _____


FED. ROAD DIST. NO.	STATE	FED. AID PROJ. NO.	FISCAL YEAR	SHEET NO.	TOTAL SHEET
HAWAII	HAW.	I-HI-1(8) 11111	1965	55	75

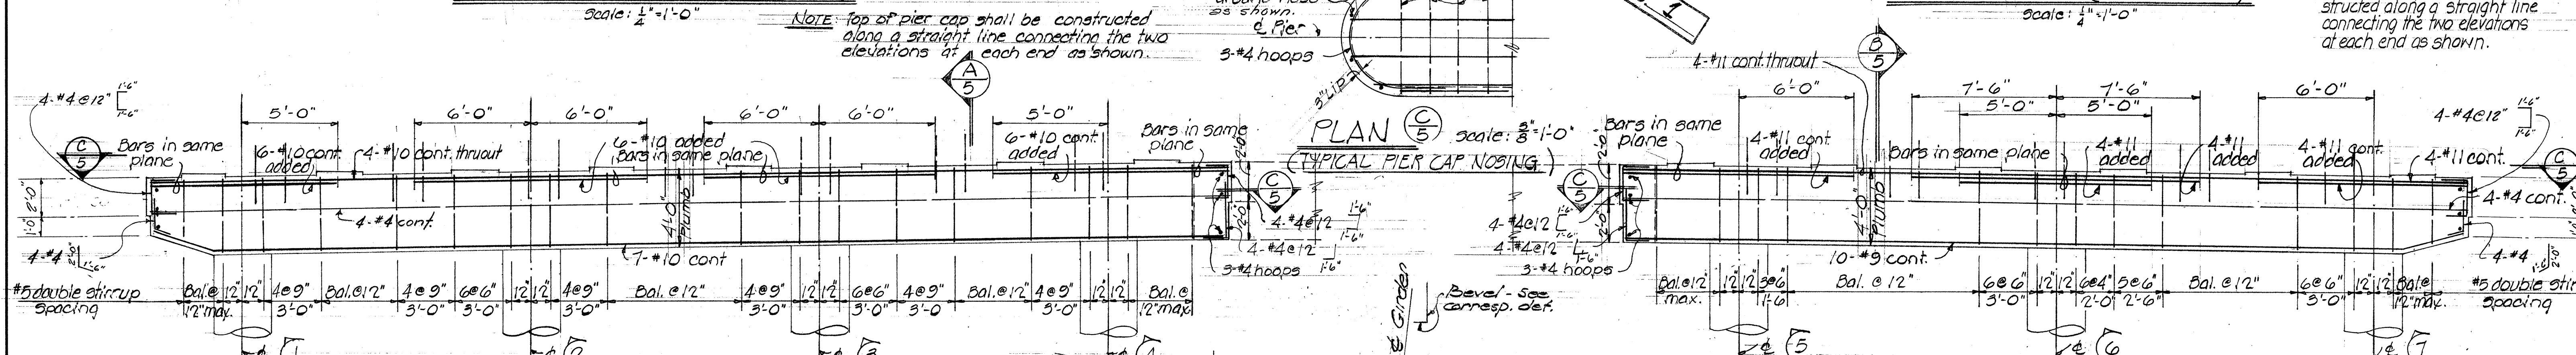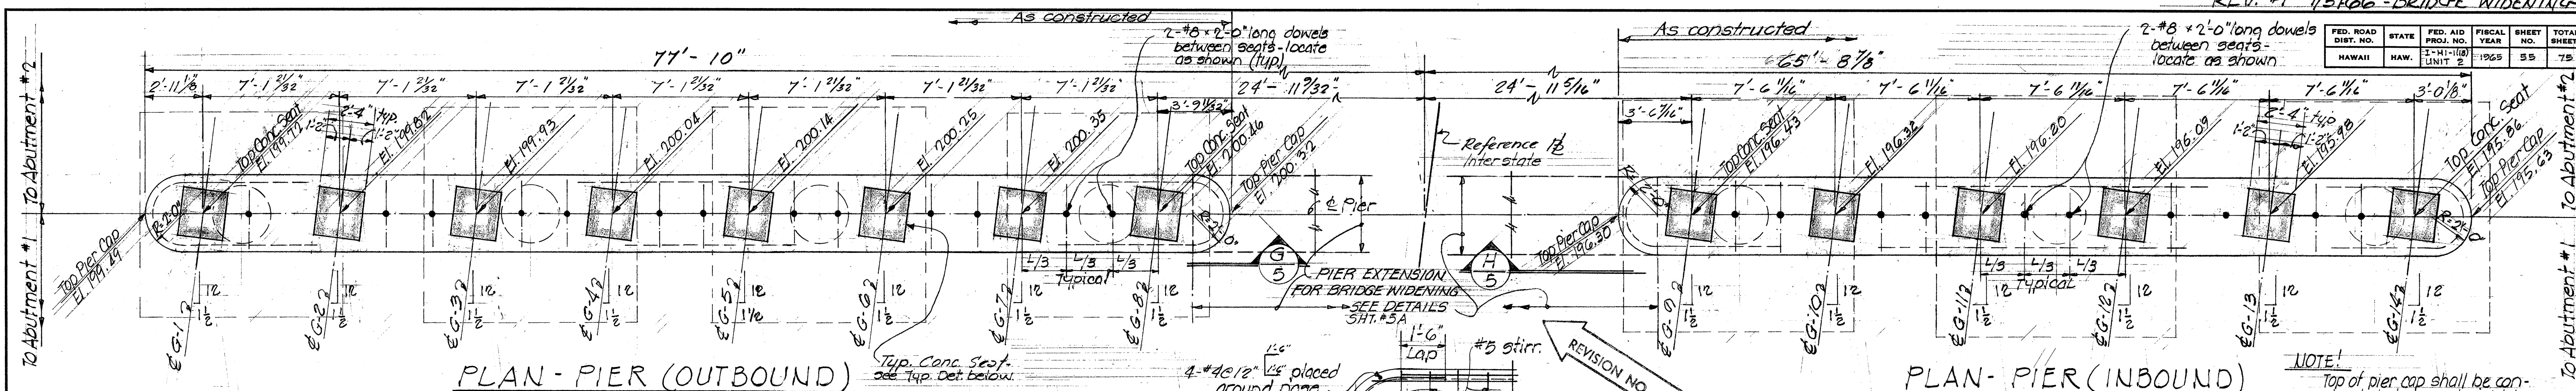

PIER COLUMN SCHEDULE							
COLUMN No	(1)	(2)	(3)	(4)	(5)	(6)	(7)
LOCATION	(4)	(3)	(7)				
BOT. PIER CAP	8"-11	8"-11	12"-11	16"-11	16"-11	16"-11	16"-11
	36" DIA.	36" DIA.	36" DIA.	36" DIA.	36" DIA.	36" DIA.	36" DIA.
TOP FIG.							
DOWELS	8"-11	8"-11	12"-11	16"-11	16"-11	16"-11	16"-11
FIG. TYPE	F-1	F-3	F-2	F-4	F-5	F-5	



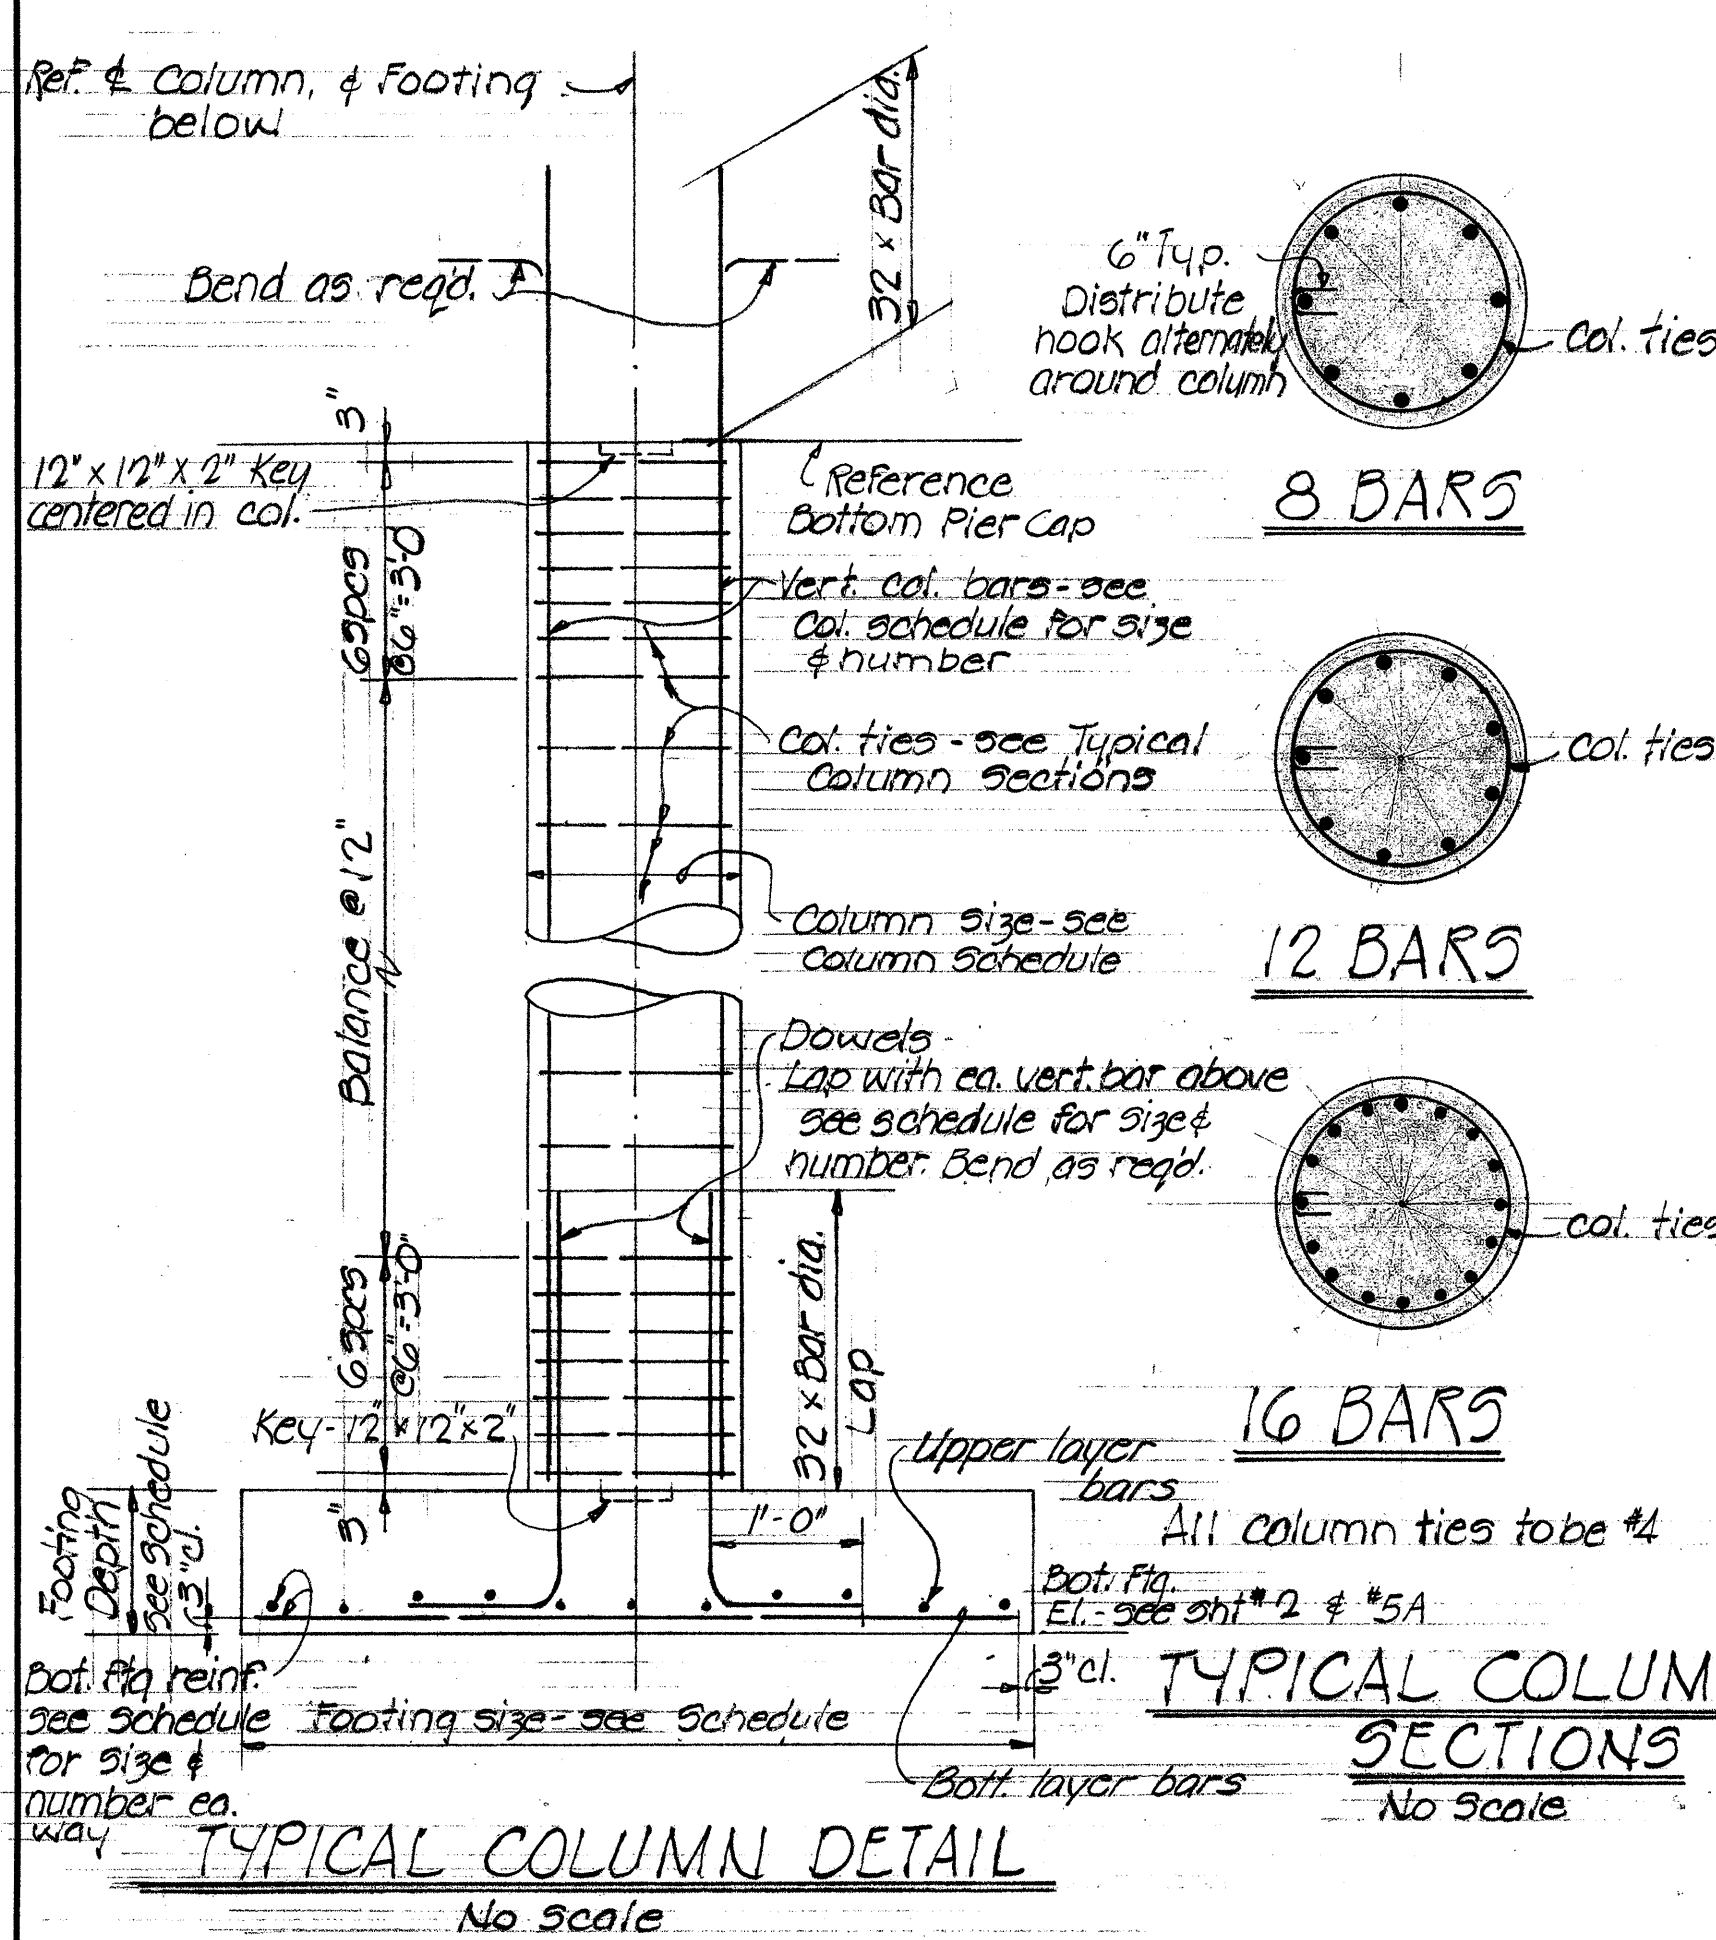


<u>PIER FOOTING SCHEDULE</u>			
TYPE	SIZE	DEPTH	BOTTOM REINFORCEMENT
F-1	10'-6" x 10'-6"	2'-0"	14-#9 EACH WAY
F-2	12'-0" x 12'-0"	2'-3"	19-#9 EACH WAY
F-3	11'-0" x 11'-0"	2'-0"	14-#10 EACH WAY
F-4	12'-6" x 12'-6"	2'-3"	19-#10 EACH WAY
F-5	11'-0" x 13'-0"	2'-3"	18-#10 LONG BARS (Both Layer) 15-#10 SHORT BARS (Upper Layer)

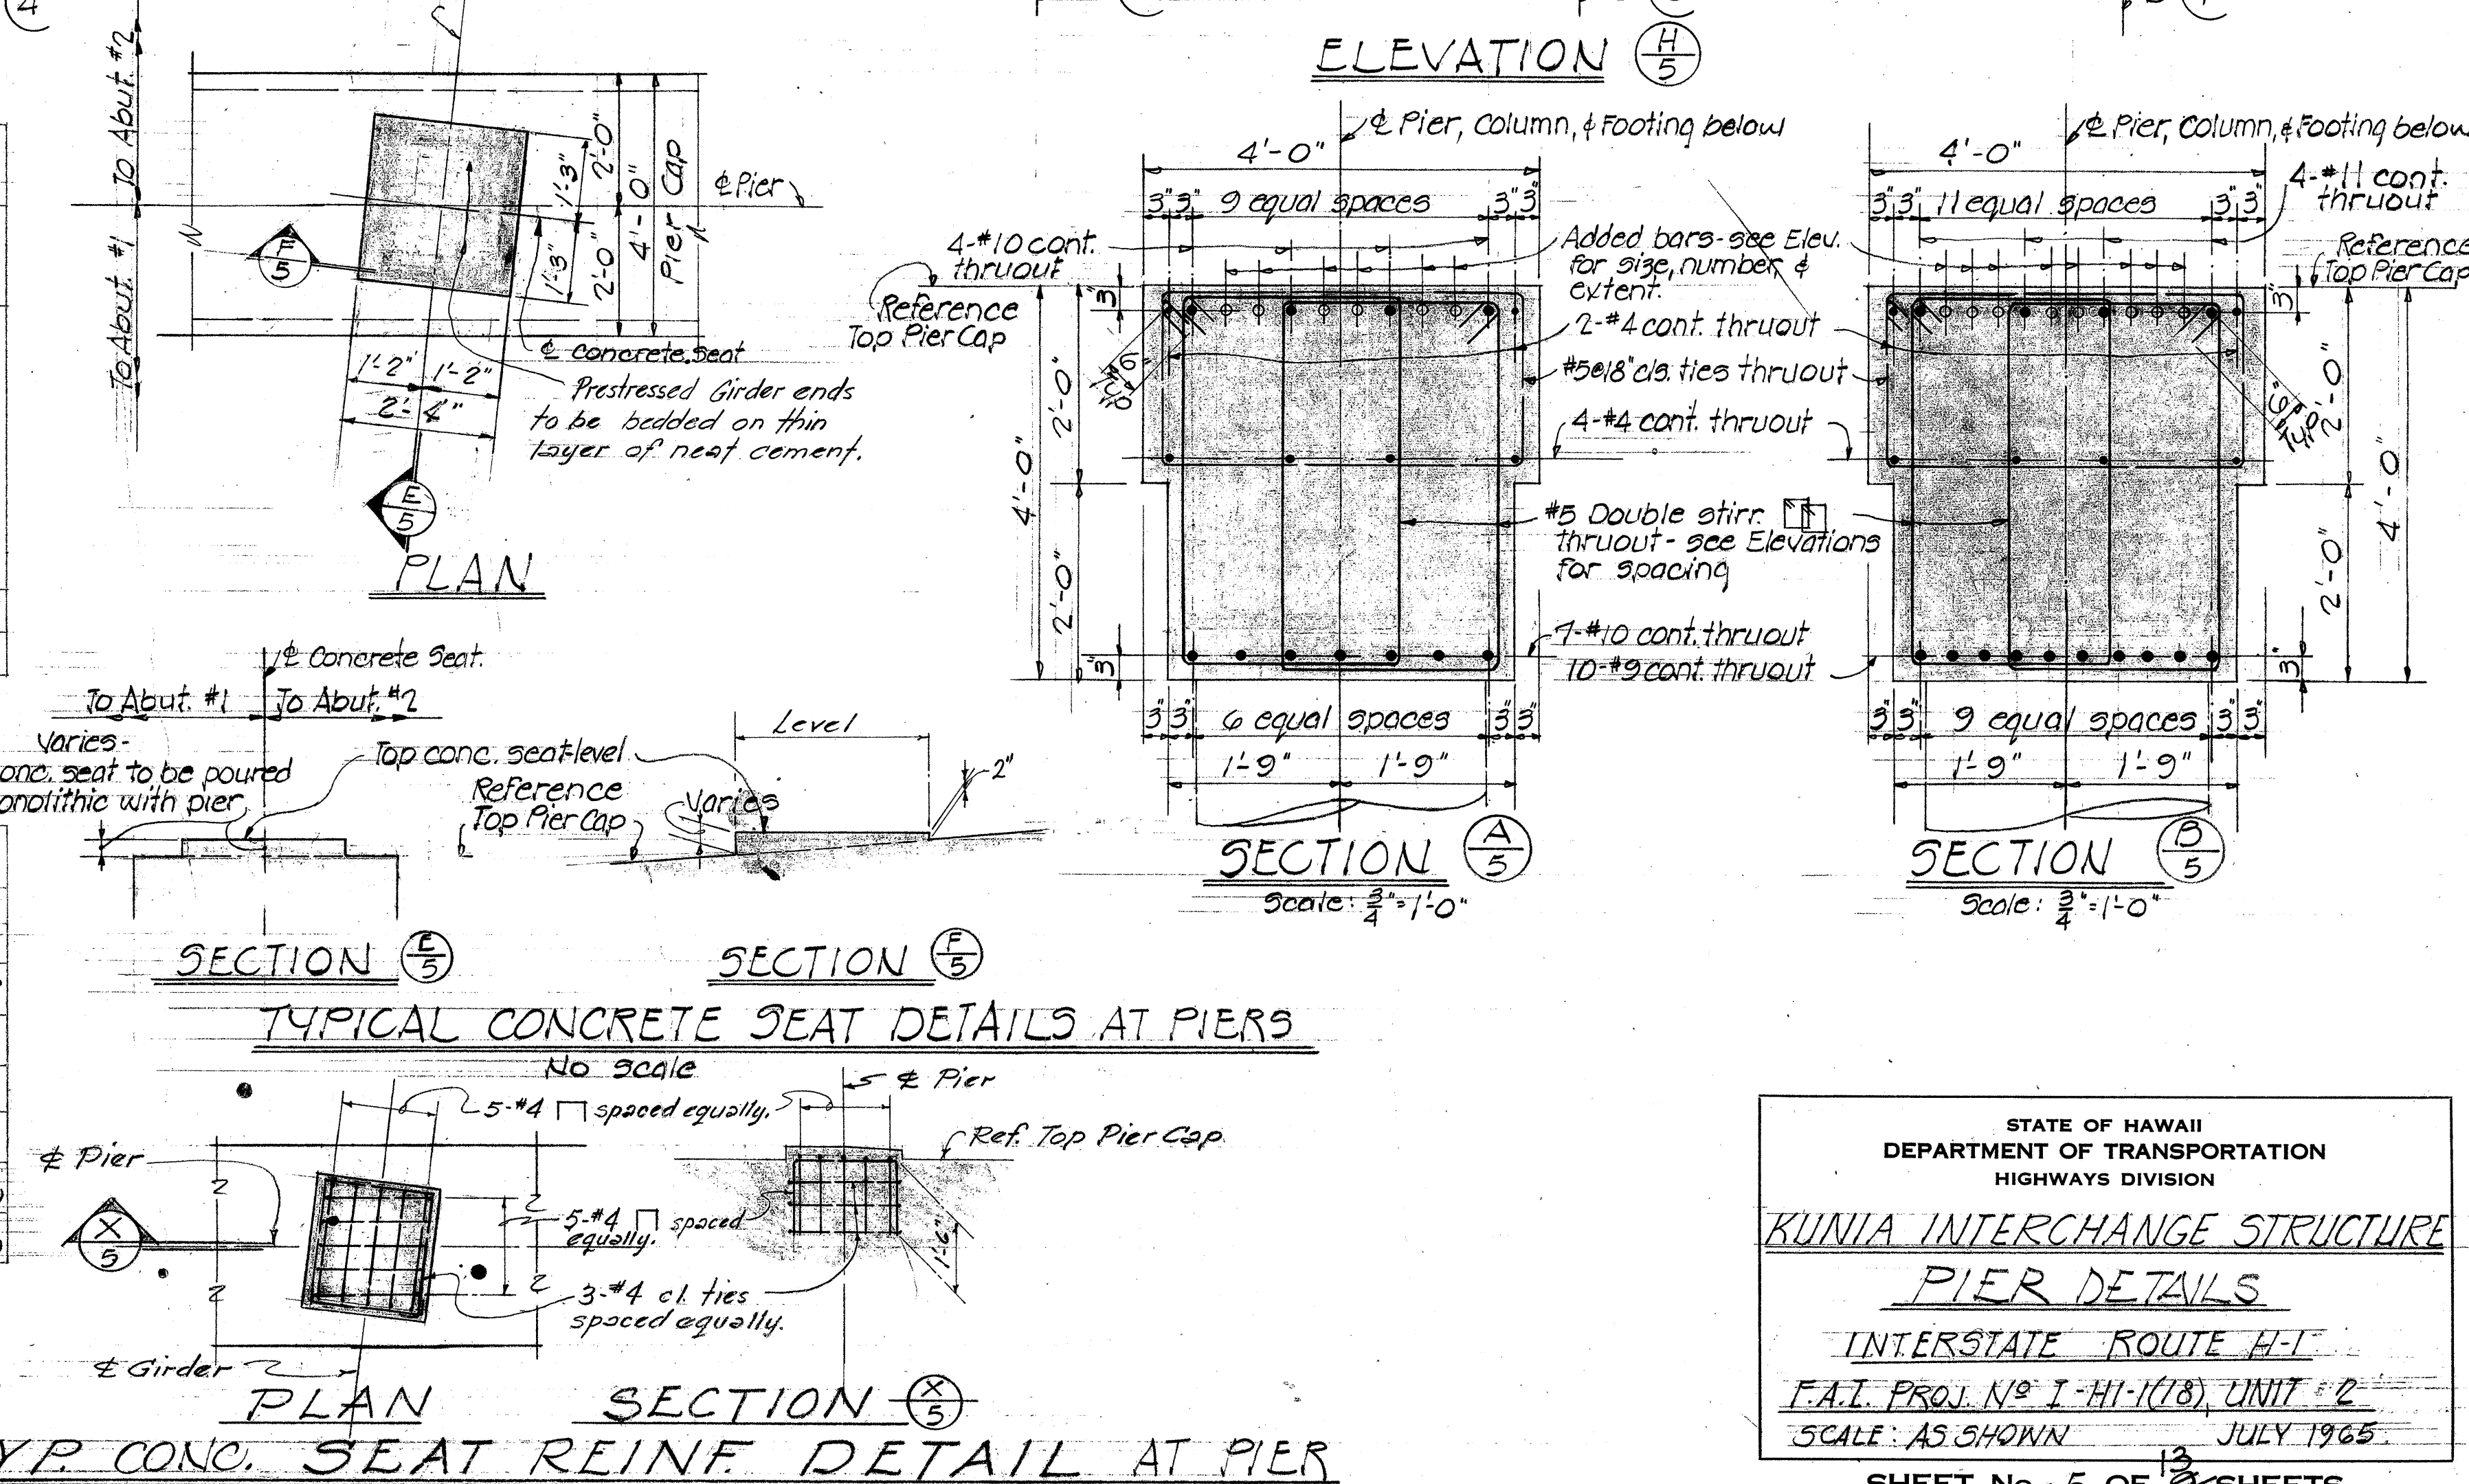

REV. #1 - 7/5/66 - Bridge Widening

FED. ROAD DIST. NO.	STATE	FED. AID PROJ. NO.	FISCAL YEAR	SHEET NO.	TOTAL SHEETS
HAWAII	HAW.	1-H1-1(18)	1965	57	75

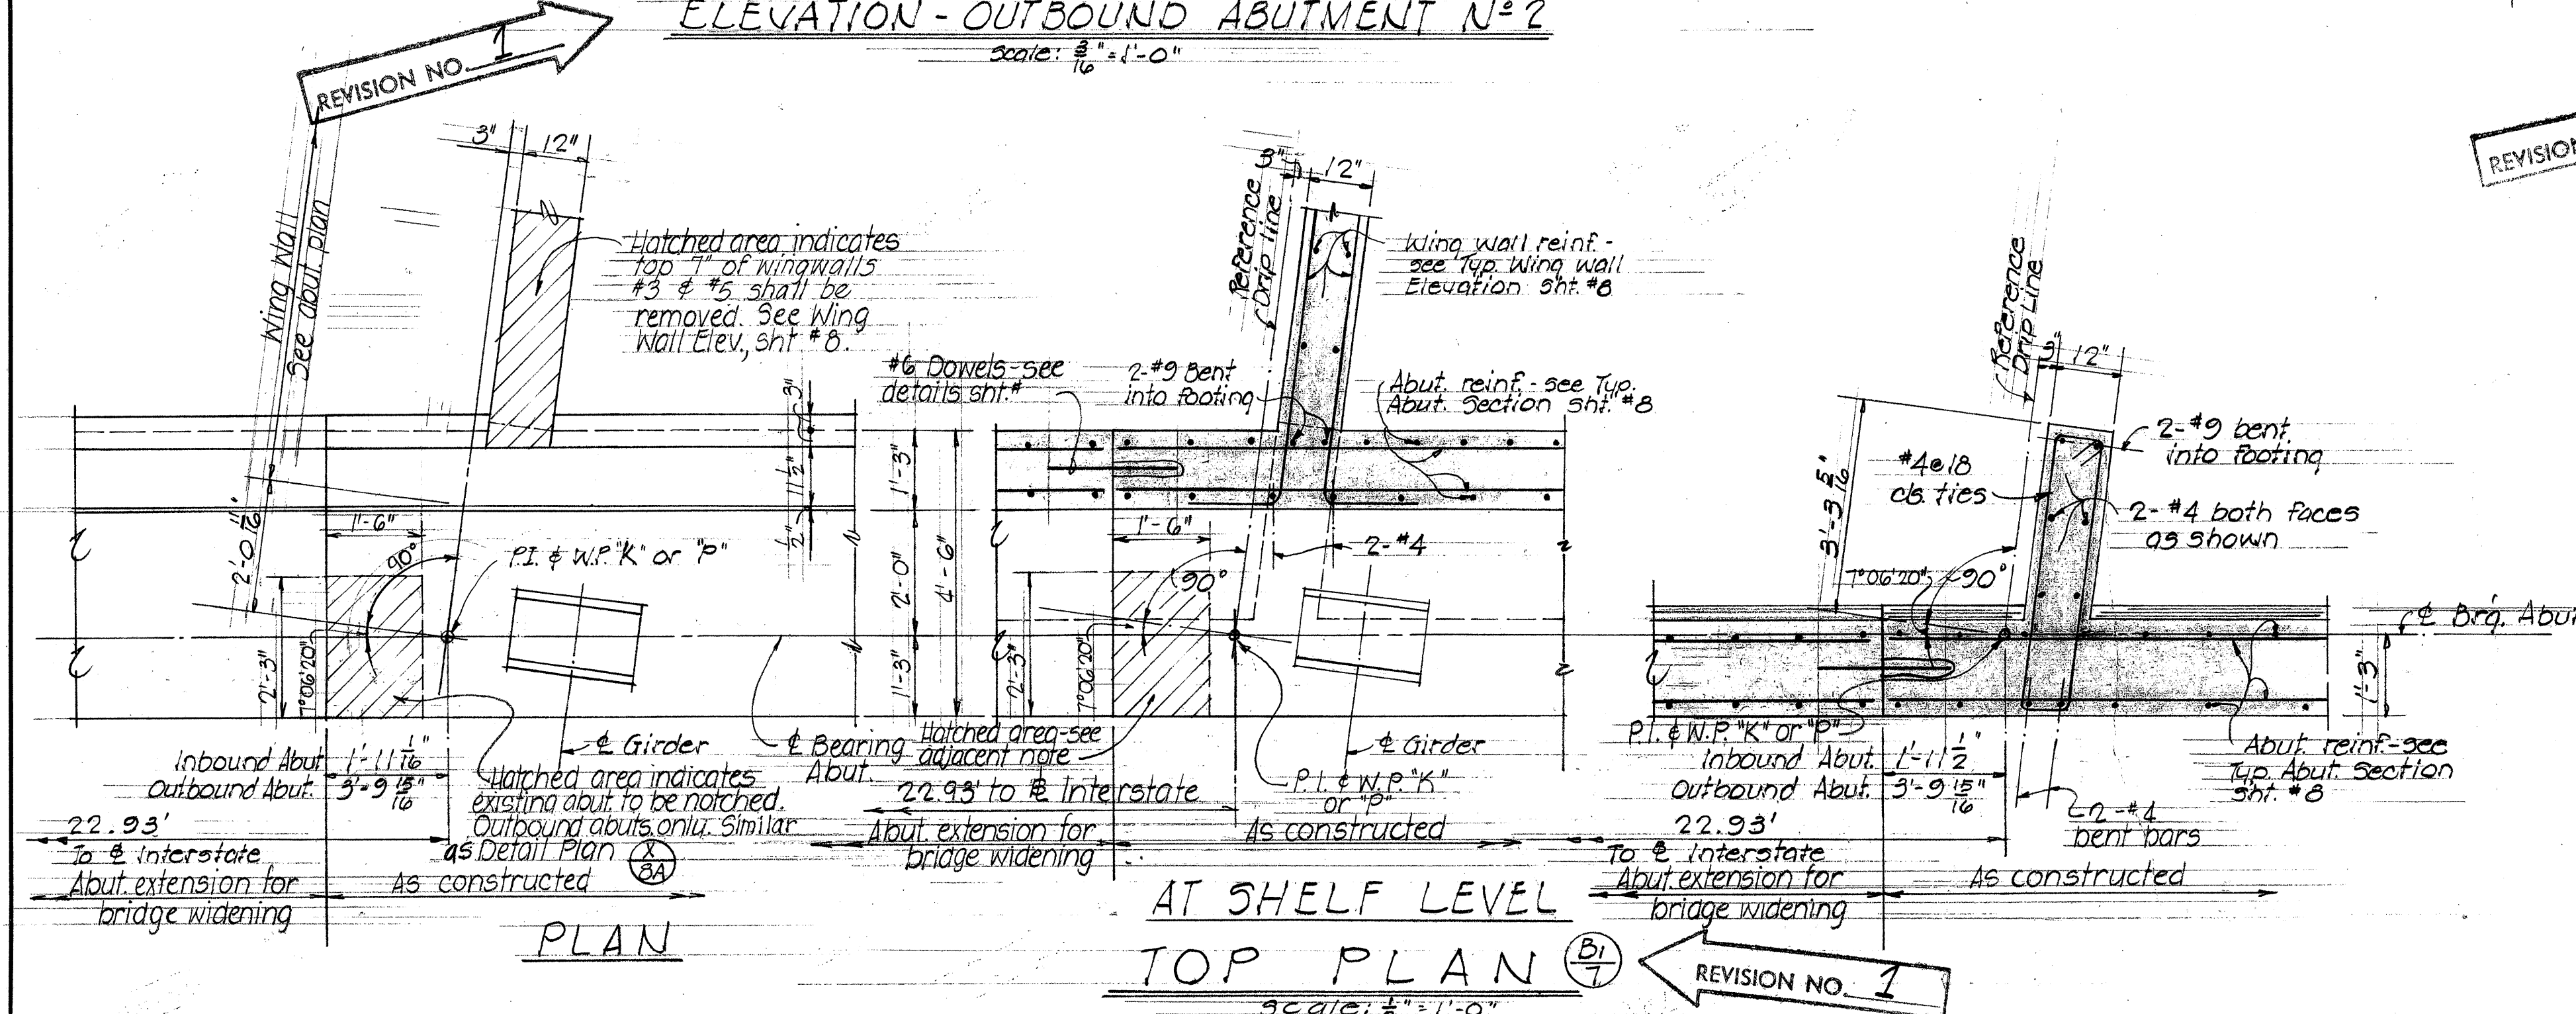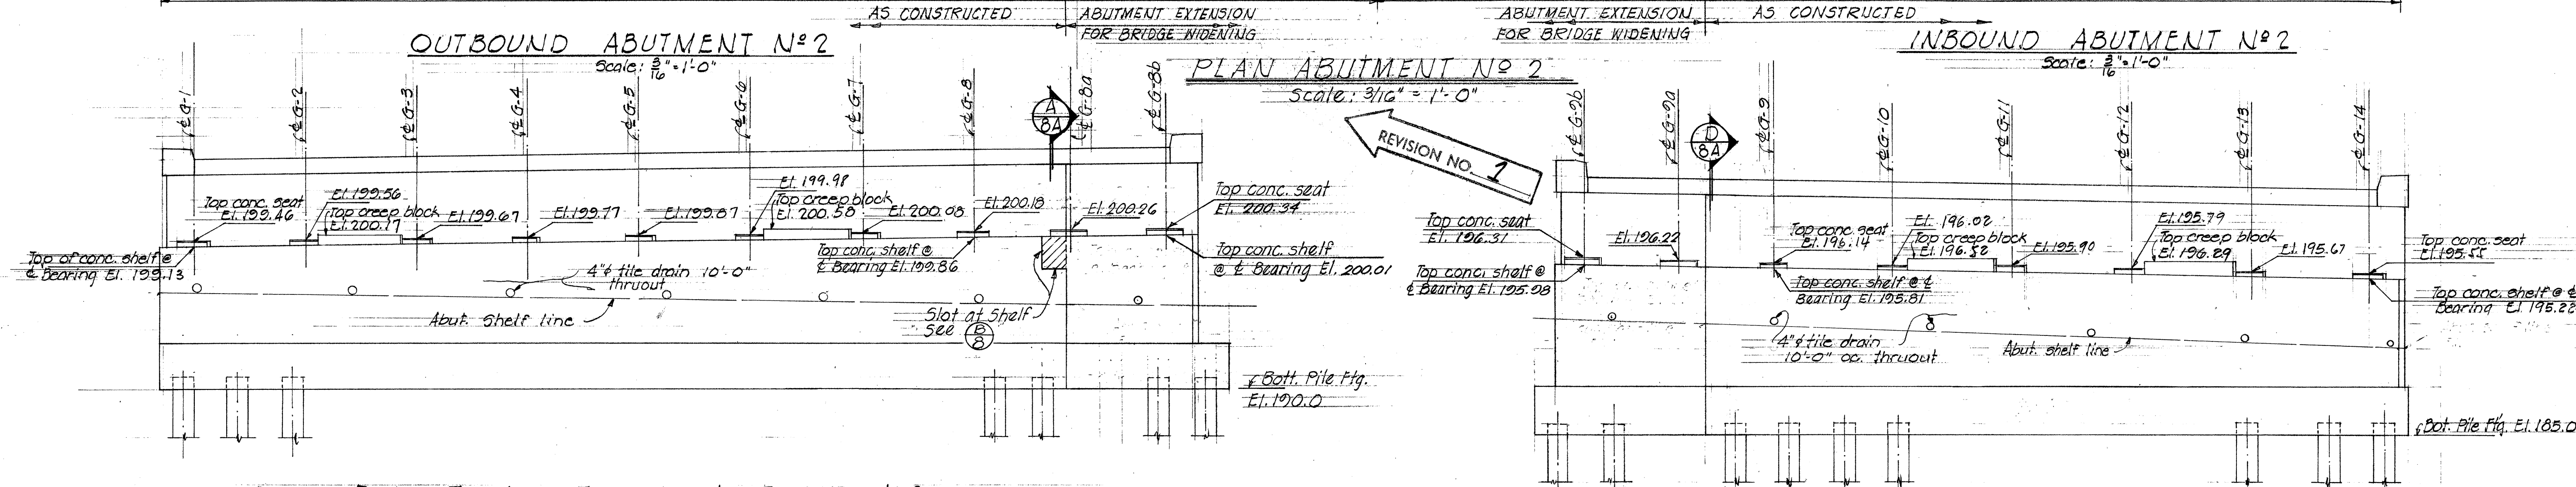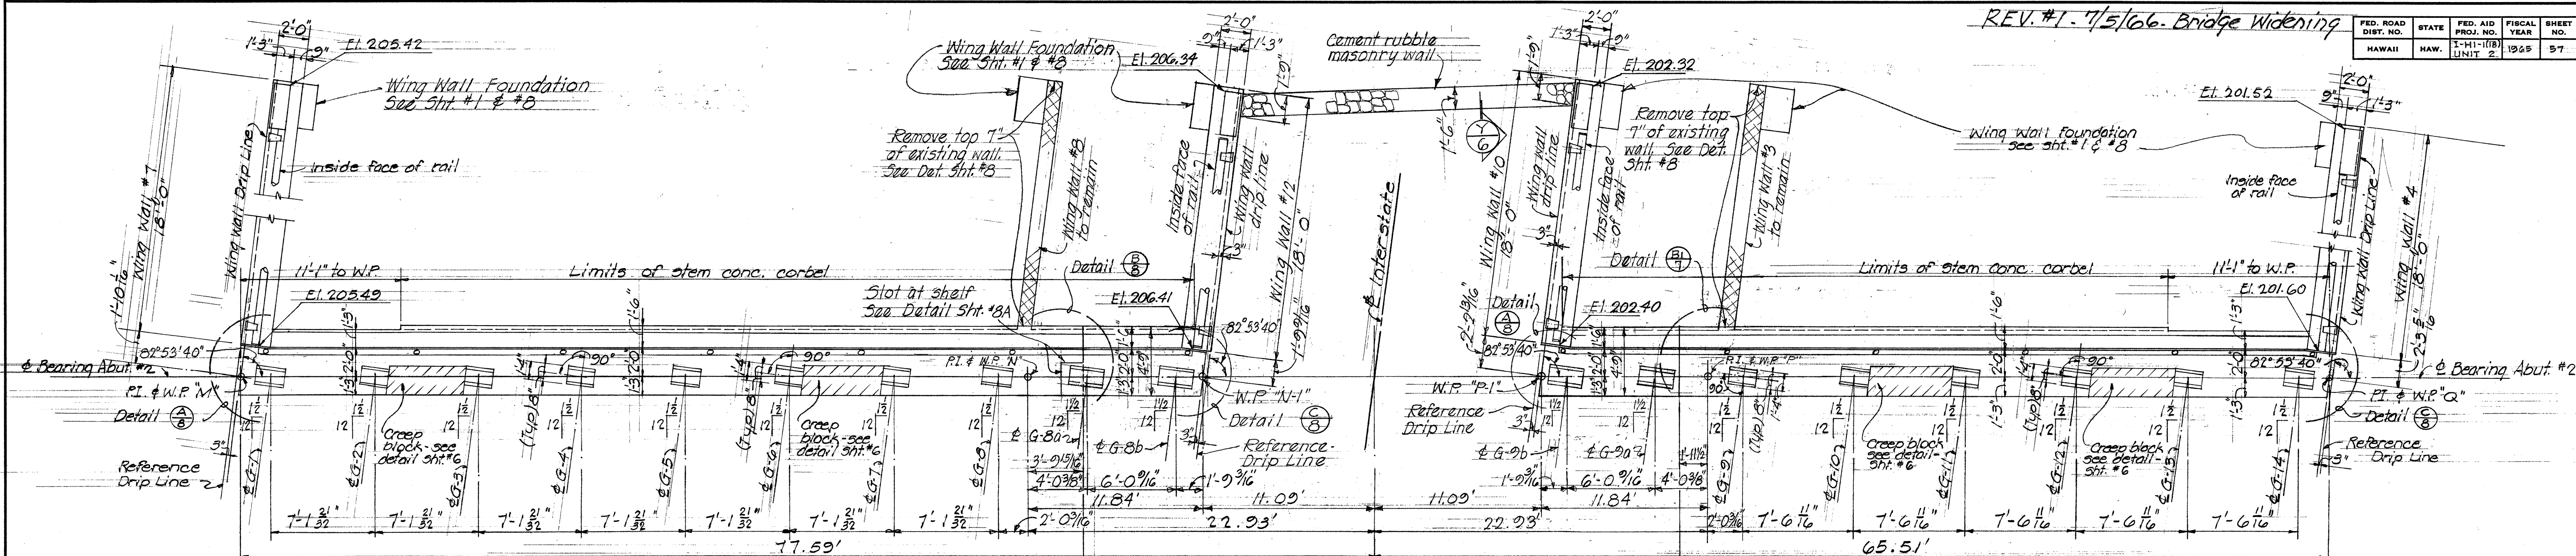

STATE OF HAWAII
DEPARTMENT OF TRANSPORTATION
HIGHWAYS DIVISION

KUNIA INTERCHANGE STRUCTURE

ABUTMENT N°2 DETAILS

INTERSTATE ROUTE H-1

F.A.I. PROJ. N° I-H1-1(18), UNIT #2

SCALE: AS SHOWN

JULY 1965

SHEET NO. 7 OF 13 SHEETS



REV. #1 - 7/5/66 - DELETED DIAGRAM.

FED. ROAD DIST. NO.	STATE	FED. AID PROJ. NO.	FISCAL YEAR	SHEET NO.	TOTAL SHEETS
HAWAII	HAW.	I-HI-1118	1965	59	75

GENERAL NOTES

Specifications: AASHTO

Standard specifications for Highway Bridges (8th Edition) with subsequent additions and modifications.

Design Stresses: R.C. Beams & Slabs:

See AASHTO specification except as otherwise noted and see Special Provisions.

$$f'_c = 3,000 \text{ psi}$$

$$f_c = 1,200 \text{ psi}$$

$$n = 10$$

$$f_s = 20,000 \text{ psi - tension}$$

Materials:

1. All concrete shall be Class A-1 except as otherwise noted on plans. Concrete for prestressed concrete girders see Special Provisions & as noted below.
2. Neoprene pads are incidental to prestressed concrete girders and will not be paid for separately.
3. See Special Provisions for admixture in concrete.
4. All piles to be prestressed concrete piles Type I - see Standard Details sheet #9-1.

Construction Methods:

1. See Standard Specifications and Special Provisions.
2. Except for footings on piles & as otherwise noted, all other footings shall be excavated & poured to neat lines. In case of over excavation, space between footing & ground shall be filled with concrete at the Contractor's expense. The fill concrete shall have a minimum quality of Class D-1. Limits of excavation for pile footing, see corresponding details.
3. The Contractor shall verify the location of all existing utility lines and notify the respective owners before commencing work of excavation or pile driving.
4. All fill behind abutments & wingwalls shall be complete in place before placing superstructure prestressed concrete girders.
5. For concrete finish see Special Provisions. Concrete seats & creep blocks to be poured monolithically with pier or abutment sections. Seats shall receive a hard trowel finish, level & true to Elevations.
6. Neoprene pad: The neoprene pads shall be secured against displacement by adhesives. The adhesive shall be approved by the Engineer.

General Notes:

1. Symbols

- (No.) - Denotes column numbers
 (A) - Alphabet section no. description
 (10) - Sheet no. detail is drawn on
 → - Direction in which main reinforcing bars extend

- P.I. - Point of intersection
 W.P. - Working point
 TSS - Top slab strip
 ⊗ - Boring

2. For additional details & general notes not covered by these drawings, refer to Standard Drawings 3-1, 3-2, & 3-3.

Design Stresses:

Prestressed Beams

$$f'_c = 5,500 \text{ psi}$$

$$f_c = 4,000 \text{ psi}$$



$$1/2" \text{ dia. } 7 \text{ wire strands}$$

$$\text{Tensioning load} = 25,200 \text{ lb. per strand}$$

$$\text{Design Load} = 20,160 \text{ lb. per strand}$$


Forms must be removed and the beam inspected before the strands are cut.

STATE OF HAWAII DEPARTMENT OF TRANSPORTATION HIGHWAYS DIVISION
KUNIA INTERCHANGE STRUCTURE MISCELLANEOUS DETAILS & GENERAL NOTES INTERSTATE ROUTE H-1 F.A.I. PROJ. N° I-HI-1118, UNIT 2 SCALE: AS SHOWN JULY 1965
SHEET No. 9 OF 8 SHEETS

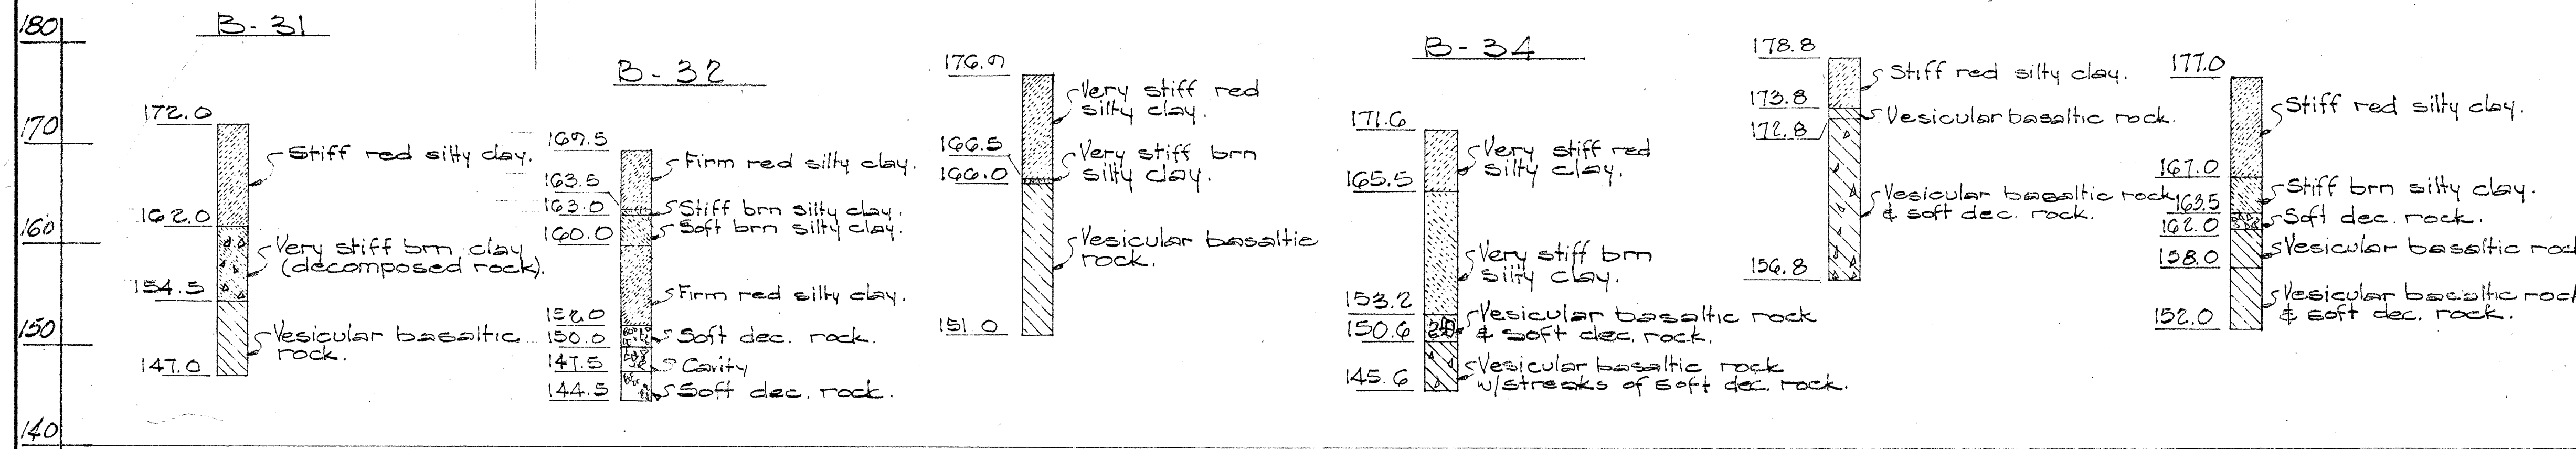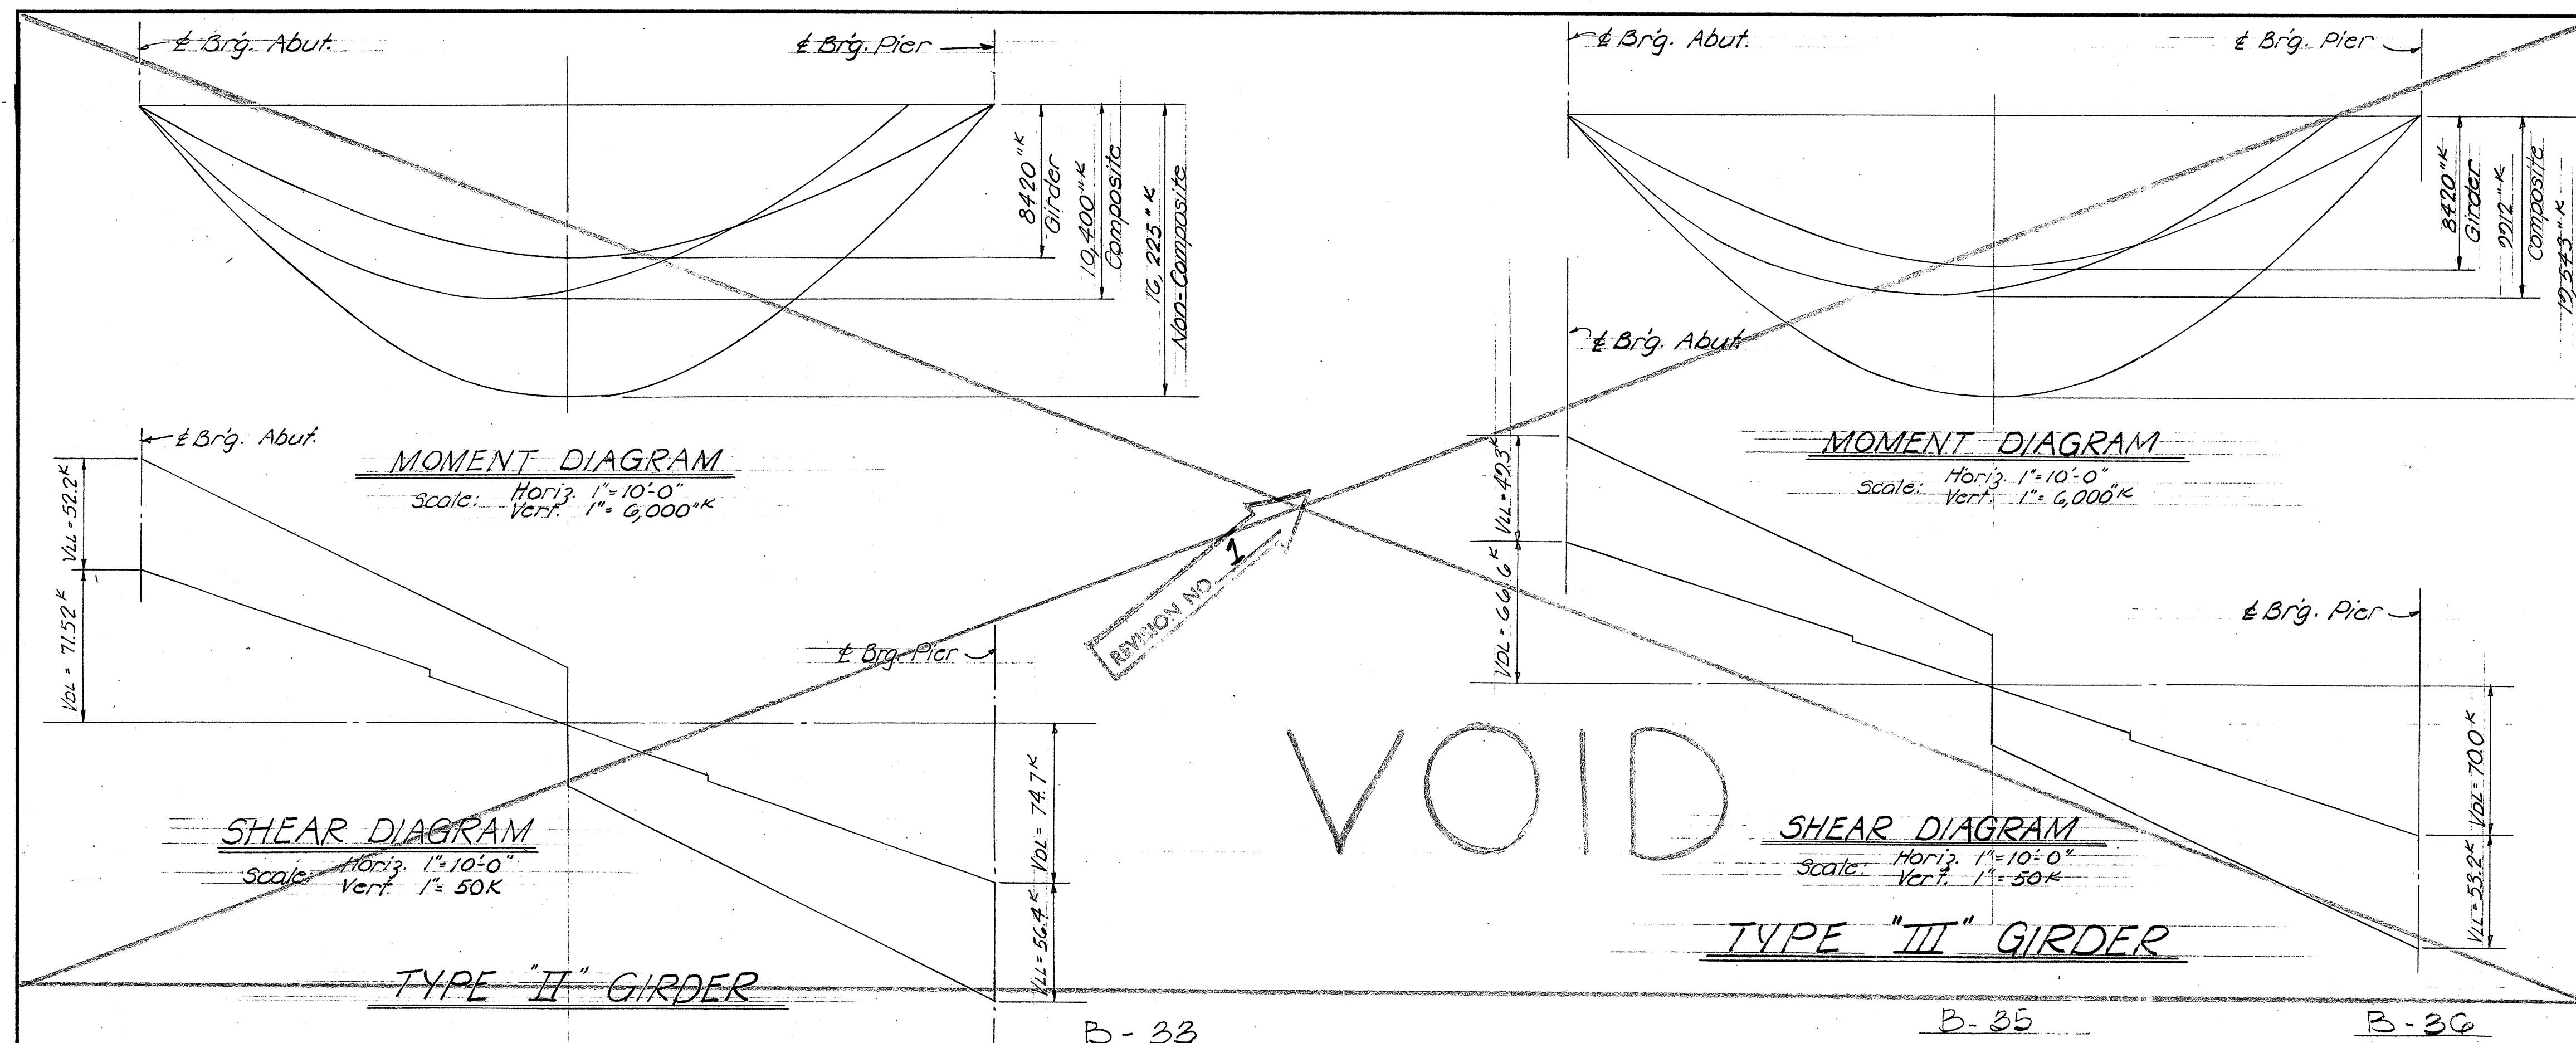

BORING LOG FOR KUNIA INTERCHANGE

SCALE 1"=10'-0"

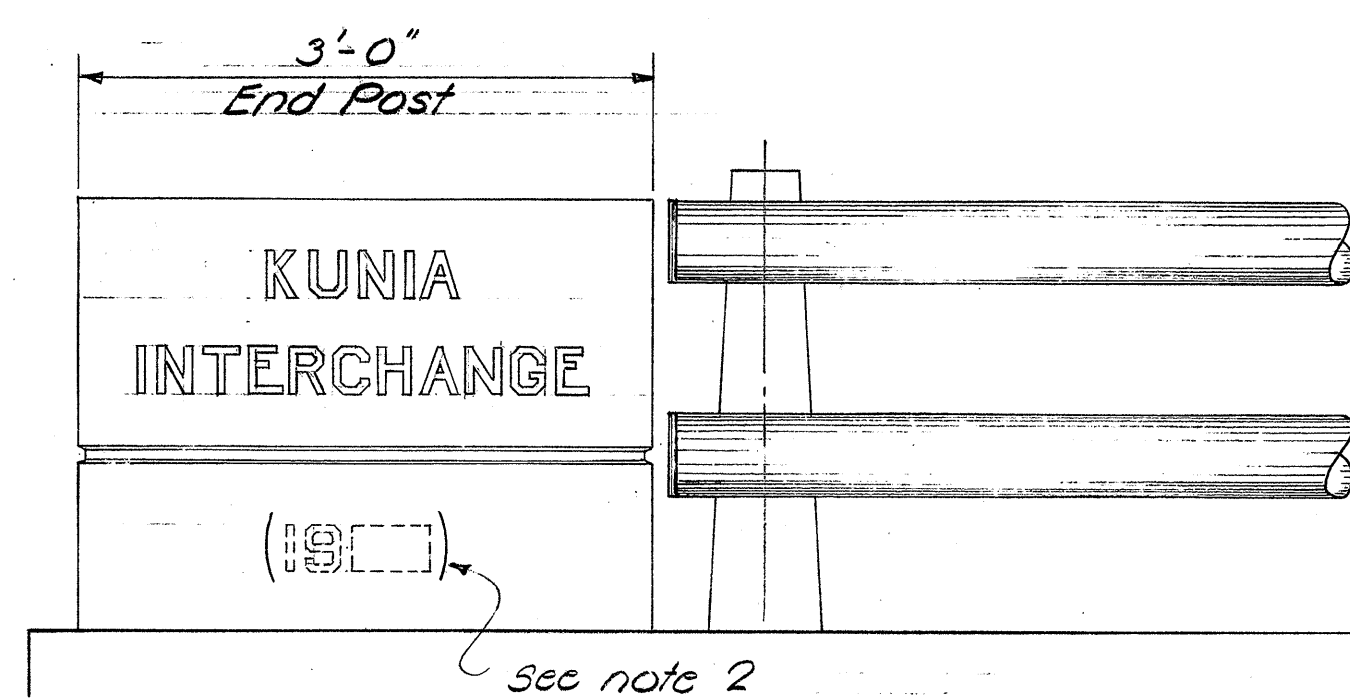


NOTE:

1. Place name of structure as shown - for location, see Layout Plan.
2. Year shown will be year structure is completed.
3. Letter size & detail - see Standard Letter drawings.


TYPICAL BRIDGE NAME & YEAR LOCATION AT END POST

Scale: 1"=1'-0"


C 0 5 9

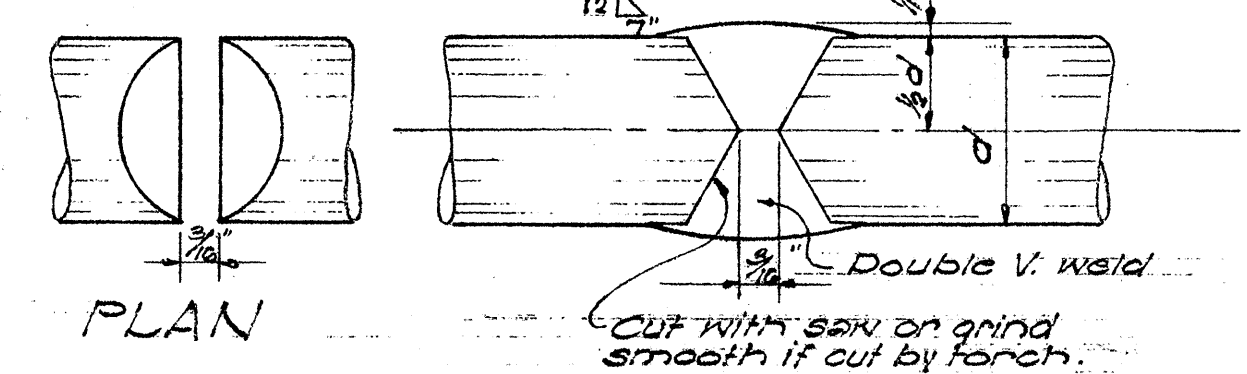


REINFORCING BAR SPLICE
Scale: Full Scale

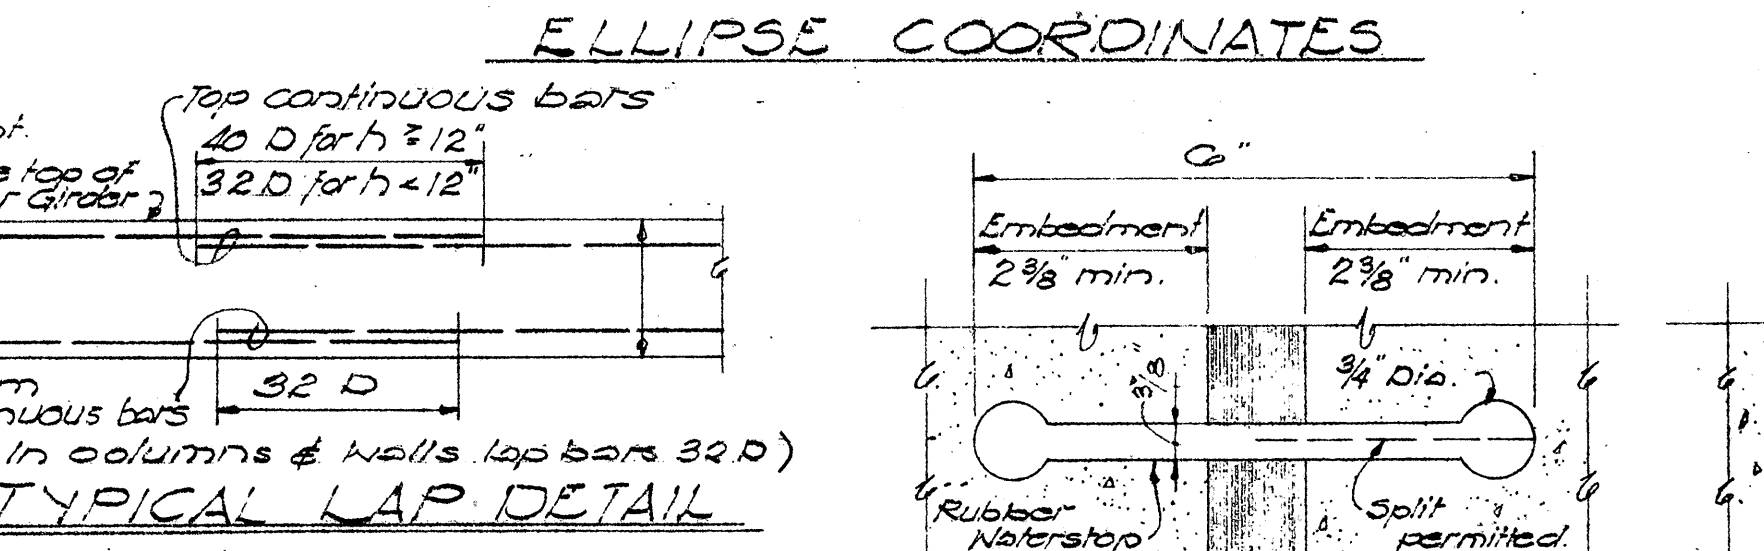


ELLIPSE COORDINATES

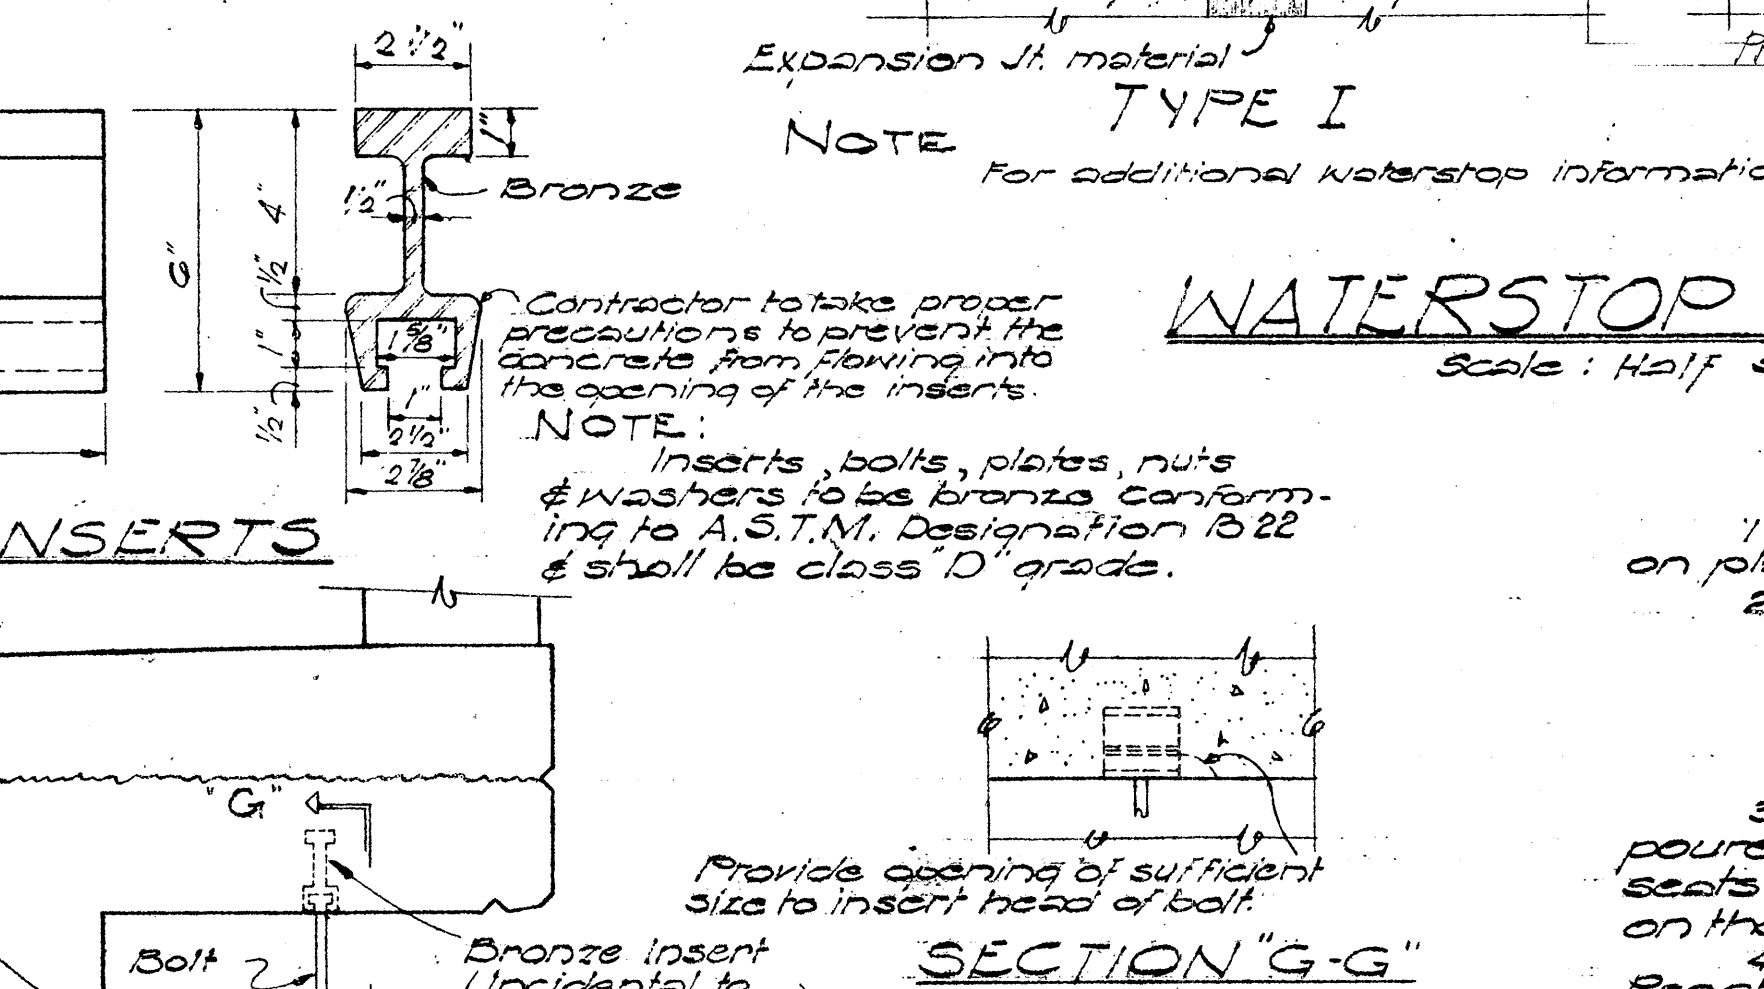


WATERSTOP DETAILS

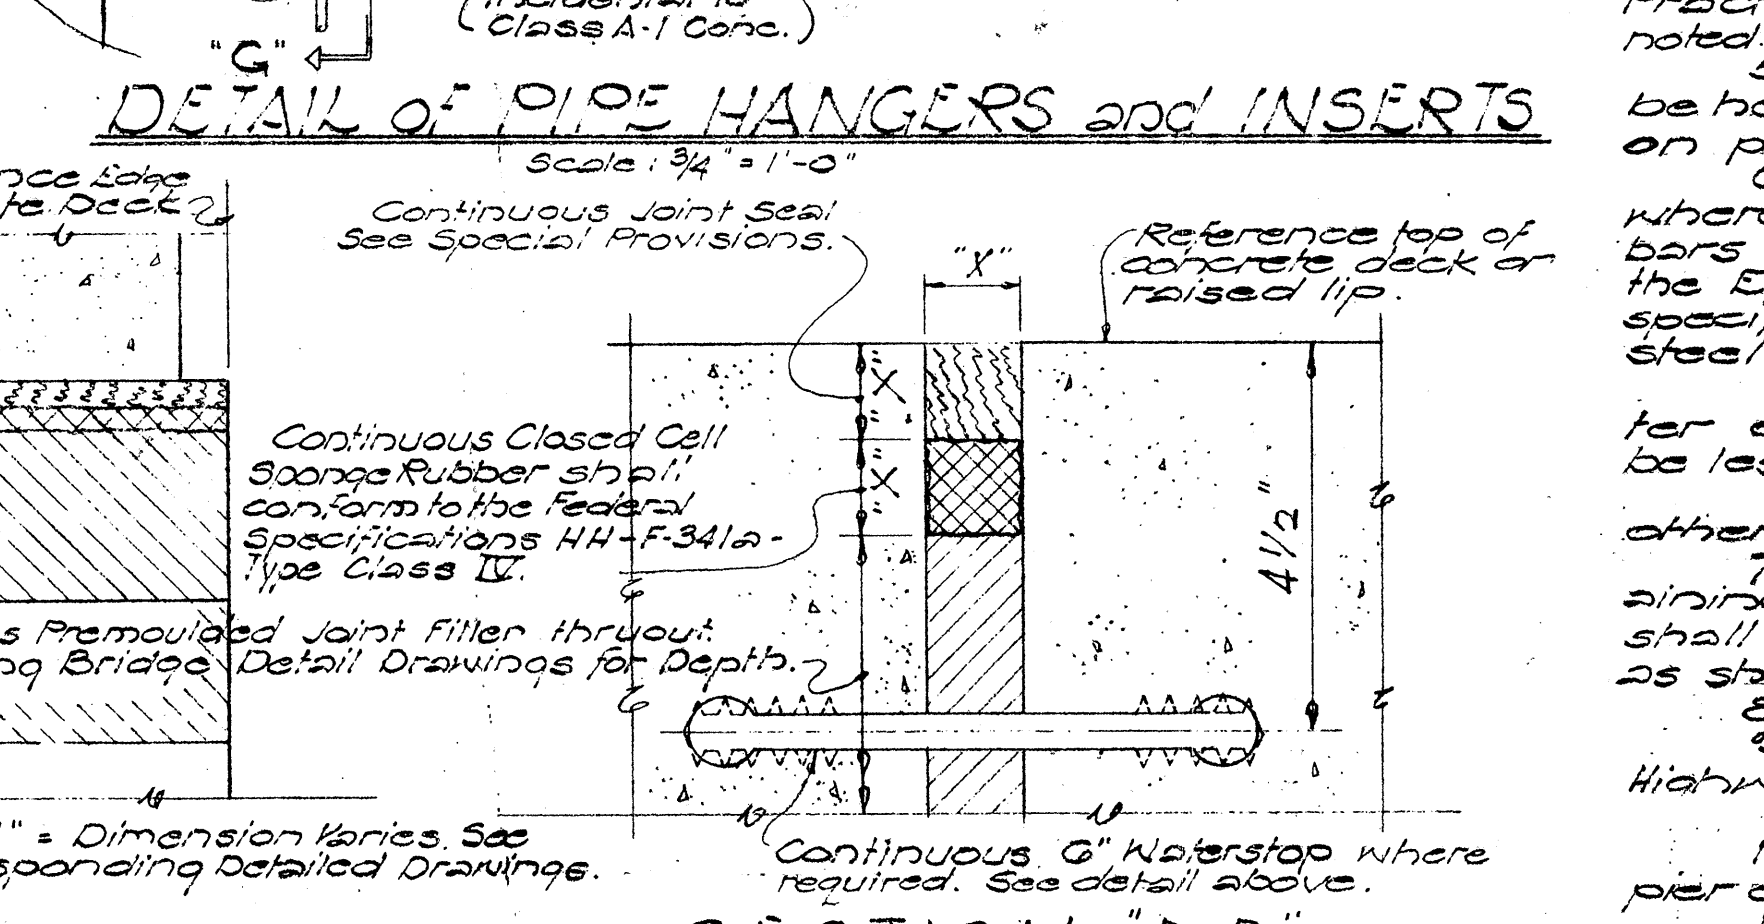

DETAIL OF PIPE HANGERS and INSERTS

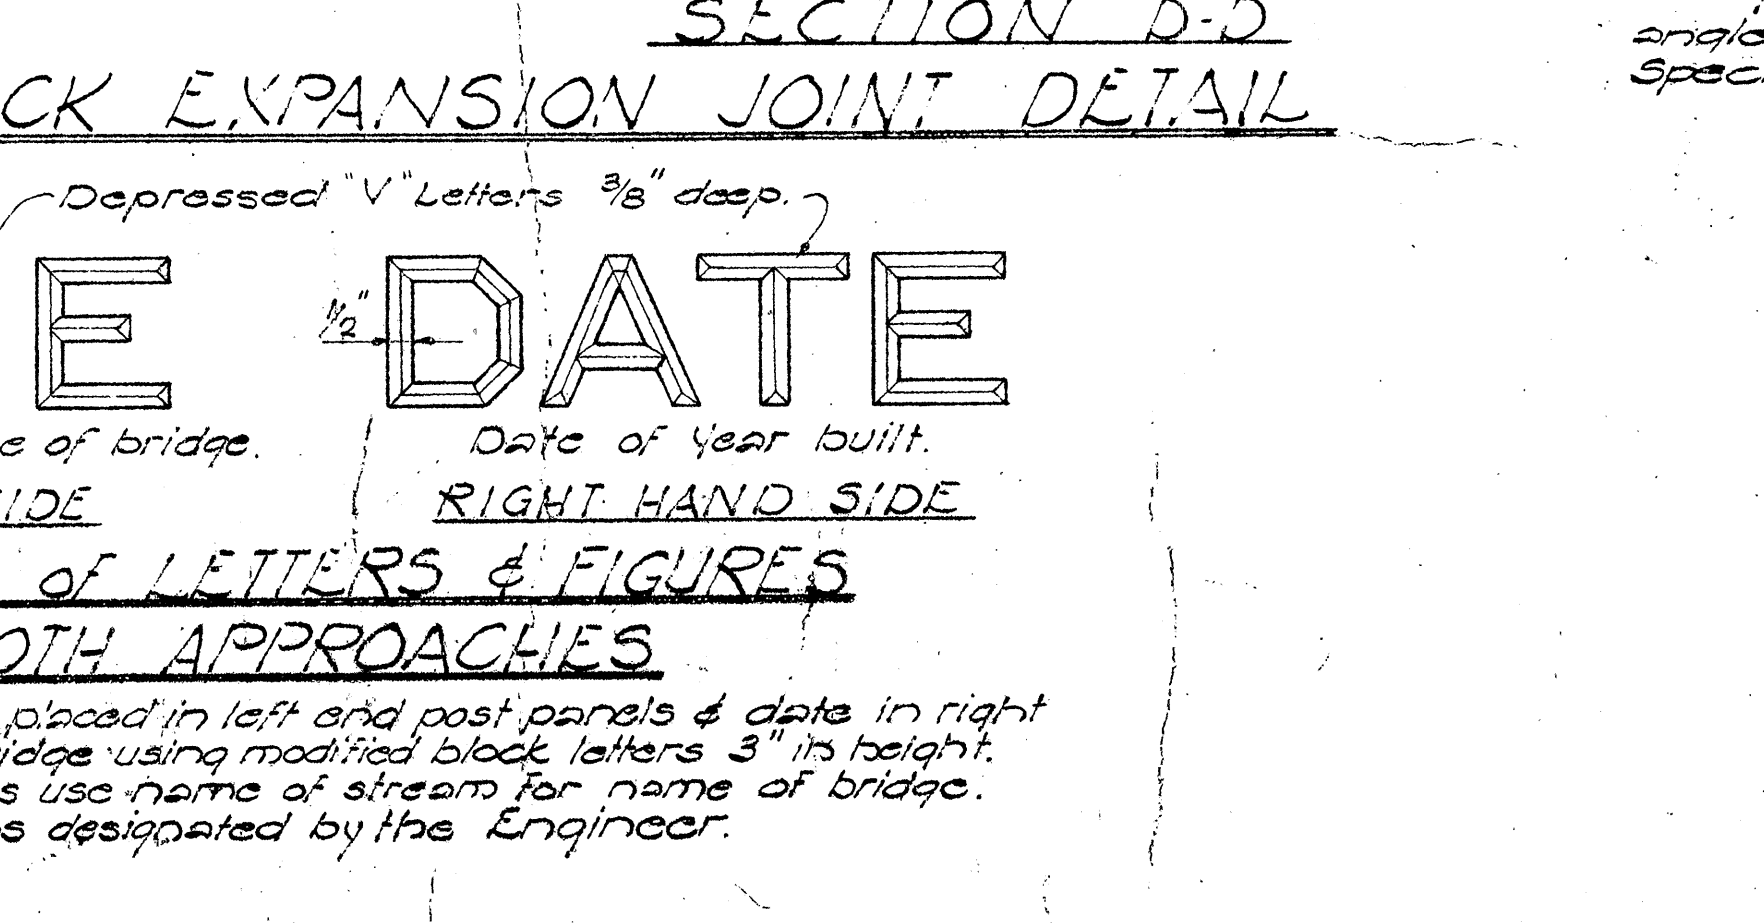

TYPICAL BRIDGE DECK EXPANSION JOINT DETAIL

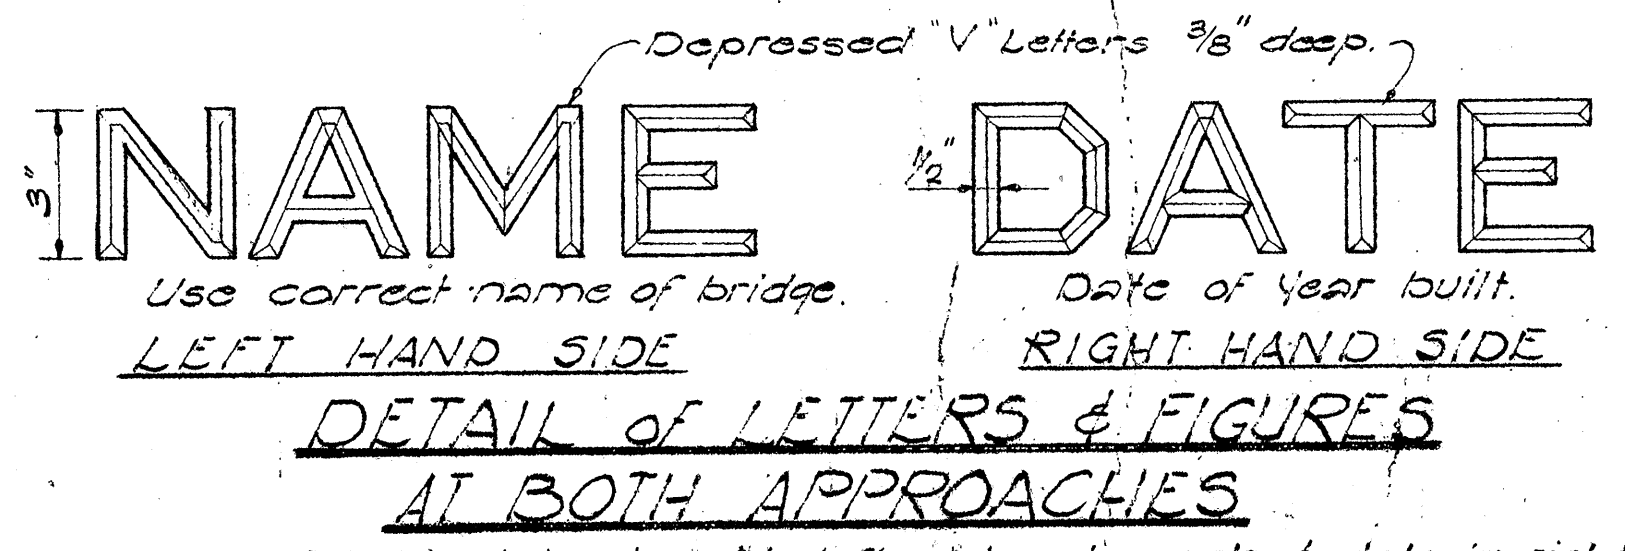

DETAIL OF LETTERS & FIGURES
AT BOTH APPROACHES

NOTE: Name of bridge to be placed in left end post panels & date in right post panels on entering bridge using modified block letters 3" in height. In case of stream crossings use name of stream for name of bridge. For all others use name as designated by the Engineer.






- NOTE:** Carbon content of reinforcing bars for welding shall not be over 0.40%. Low hydrogen electrodes E7015 or E7016 shall be used with preheat and interpass temperature not less than 200°F.

REINFORCING BAR SPLICE
Scale: Full Scale

TYPICAL CONTROL JOINT OR ALTERNATE CONTRACTION JT DETAIL

GENERAL NOTES

 - 1 - Class of concrete to be used in different parts of the structure are as noted on plans.
 - 2 - Clearance for reinforcing shall be as follows unless otherwise noted:
 - a - 1 1/2" for stirrups of beams & pier caps.
 - b - 2" for ties of column.
 - c - 2" for formed walls.
 - d - 3" for footings.
 - 3 - Concrete seals receiving steel plates, lead plates or neoprene pads shall be poured monolithically with supporting structures & top surfaces of the concrete seals shall be finished with a steel trowel to a smooth level at the elevation shown on the plans.
 - 4 - Reinforcing shall be detailed in accordance with A.C.I. Manual of Standard Practice for Detailing Reinforced Concrete Highway Structures unless otherwise noted.
 - 5 - Reinforcing bars shall be securely tied at all intersections & lap splices & shall be held in place during pouring to maintain their proper locations as shown on plans.
 - 6 - Splicing of reinforcing shall be done as shown in above sketch except where shown otherwise. Splices are to be staggered. Splices in main bridge bars are permitted only in bars exceeding 60'-0" in length at points indicated by the Engineer. Splices to be electrically welded shall be according to detail & specifications. No allowance will be made in the quantities for extra weight of steel required for splices not shown on the plans.
 - Minimum spacing between parallel bars shall be 1 1/2 times the diameter of bars, but in no case shall the clear distance between the bars be less than 1 1/2 times the maximum size of the coarse aggregate.
 - All dimensions relating to reinforcing are to centers of bars unless otherwise noted.
 - 7 - Forms for all exposed surfaces of separation structures including retaining walls (except round columns) shall be plywood forms for round columns shall be made of material that results in smooth finishes and true dimensions as shown on the plans. Forms for prestressed concrete members shall be either metal or plywood.
 - 8 - Concrete finish - See Special Provisions.
 - 9 - All welding shall conform to the latest Specifications for Welded Highway & Railway Bridges of the American Welding Society.
 - 10 - Vertical column bars shall be arranged in such a manner as to miss pier cap bars above as directed by the Engineer.
 - 11 - Except as otherwise noted on drawings all exterior corners & re-entrant angles in concrete work shall be chamfered 3/4" x 3/4". See Standard Specifications.

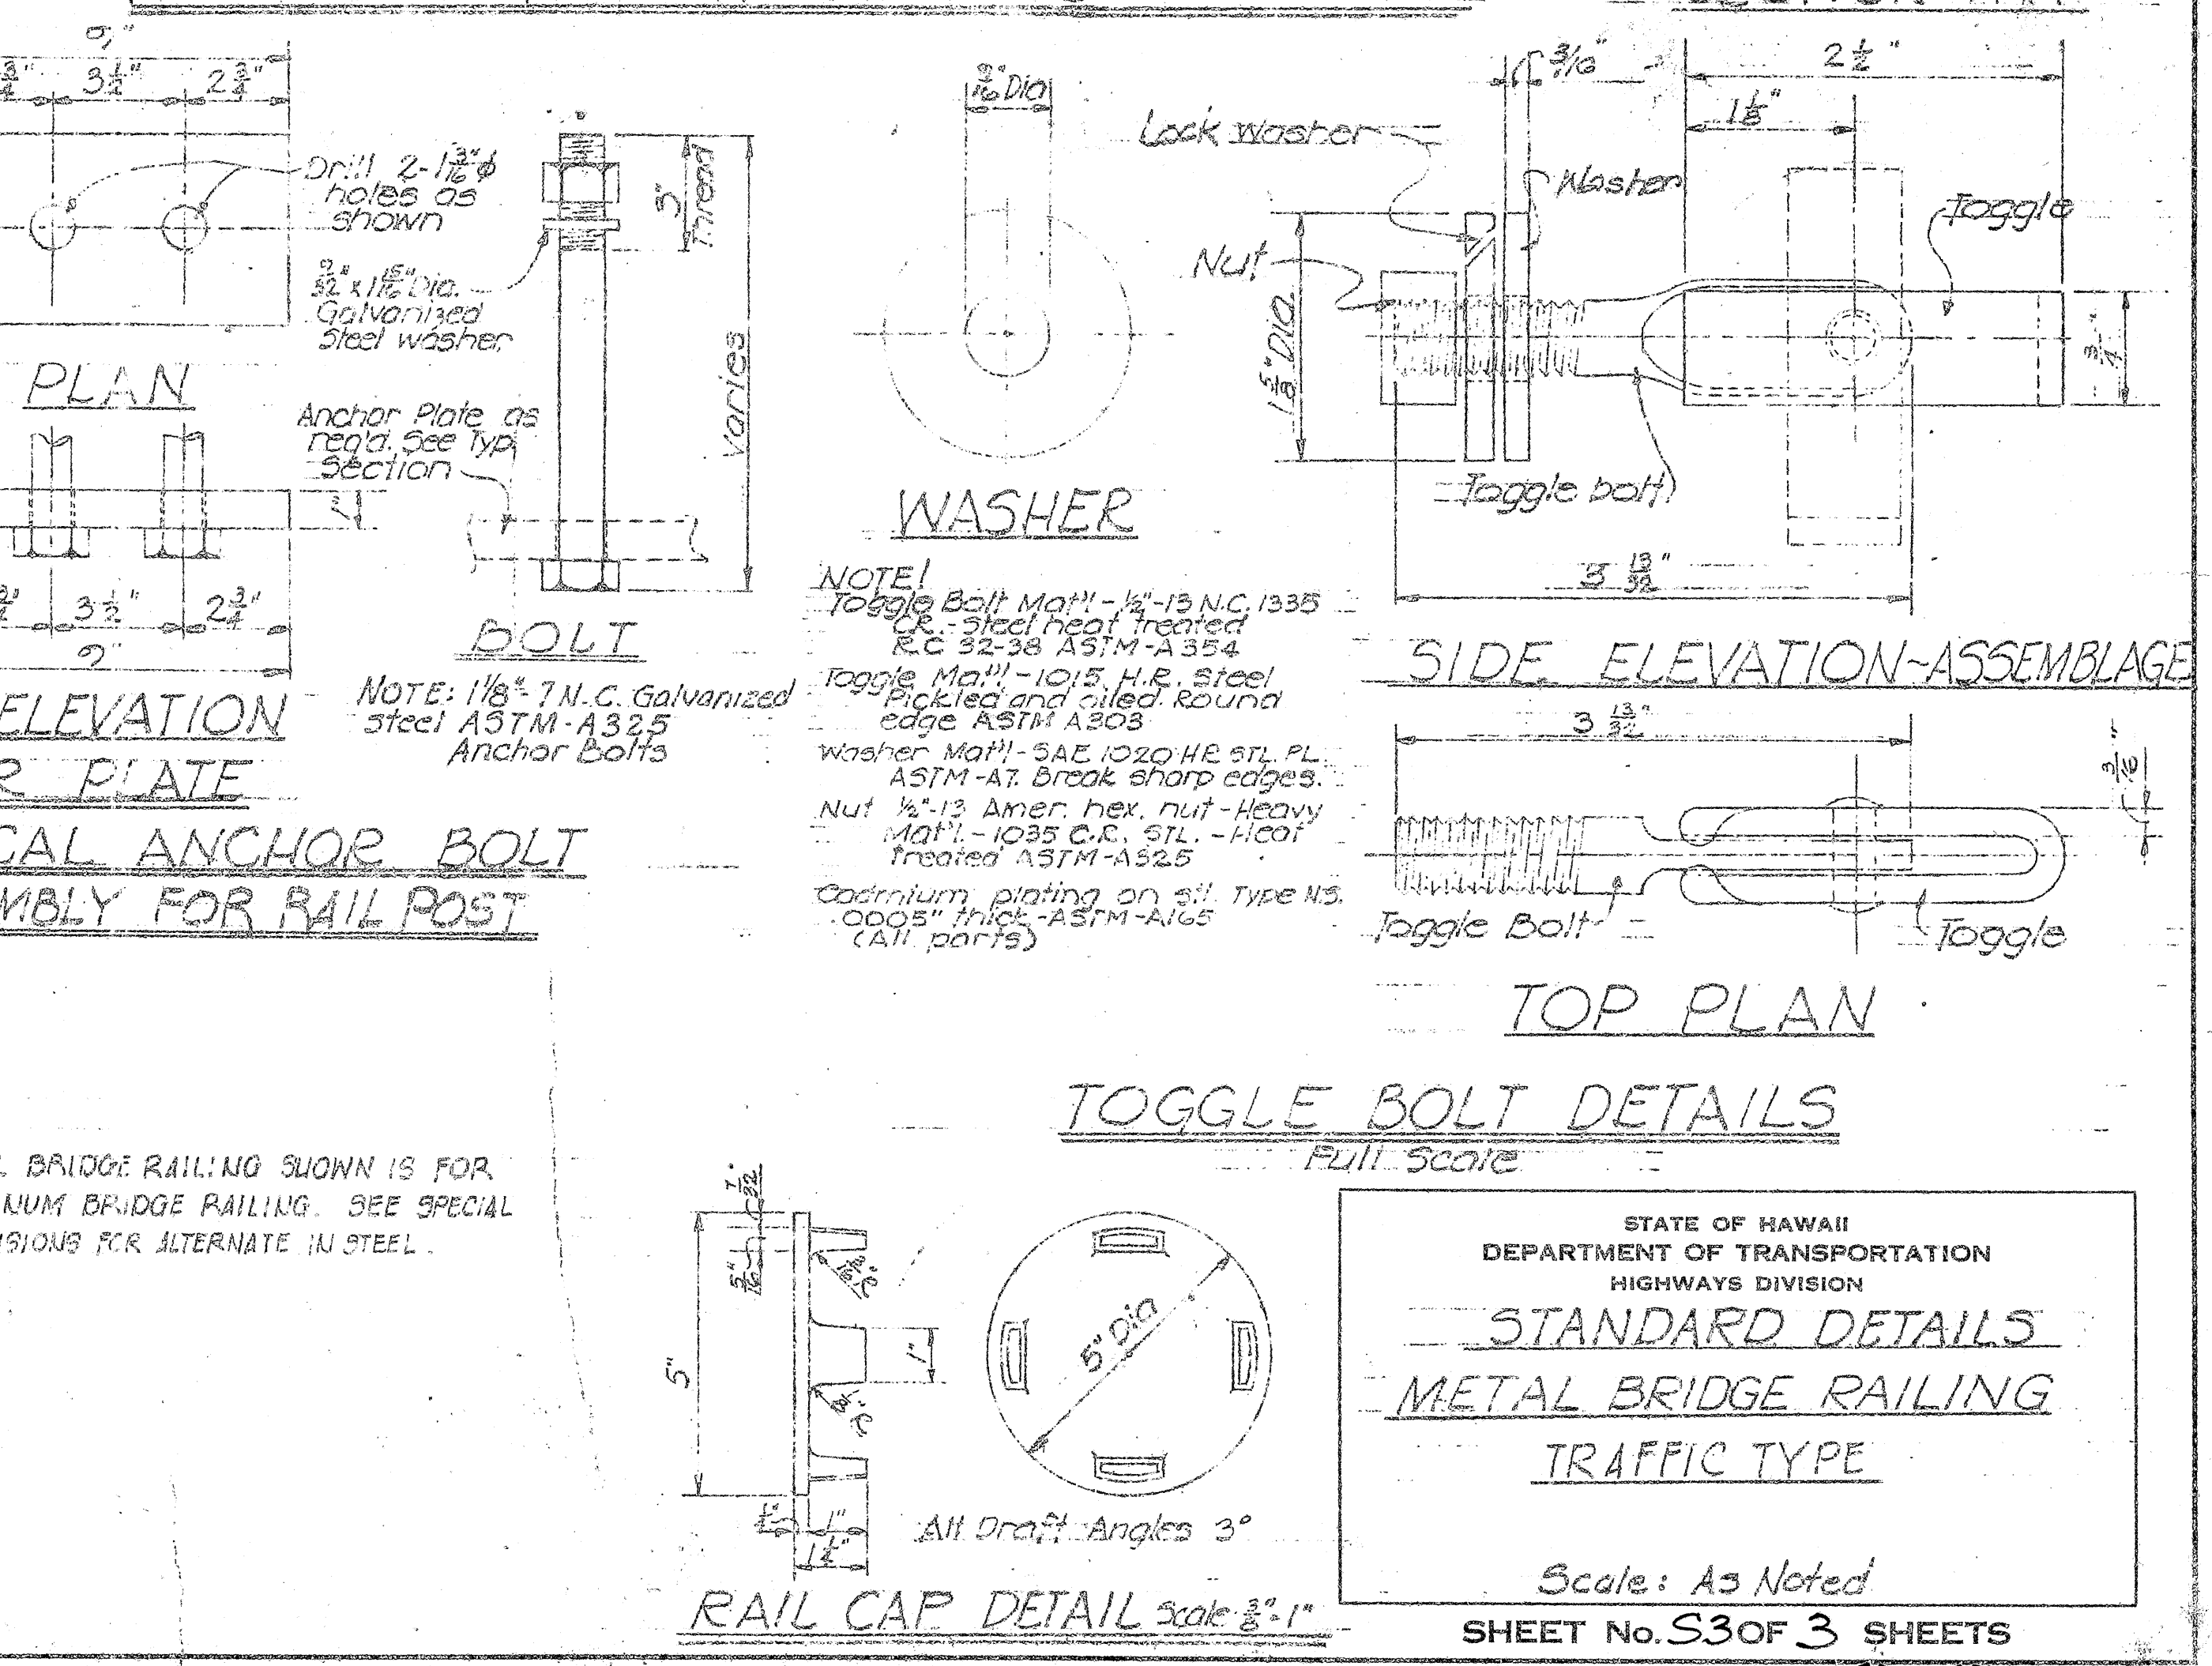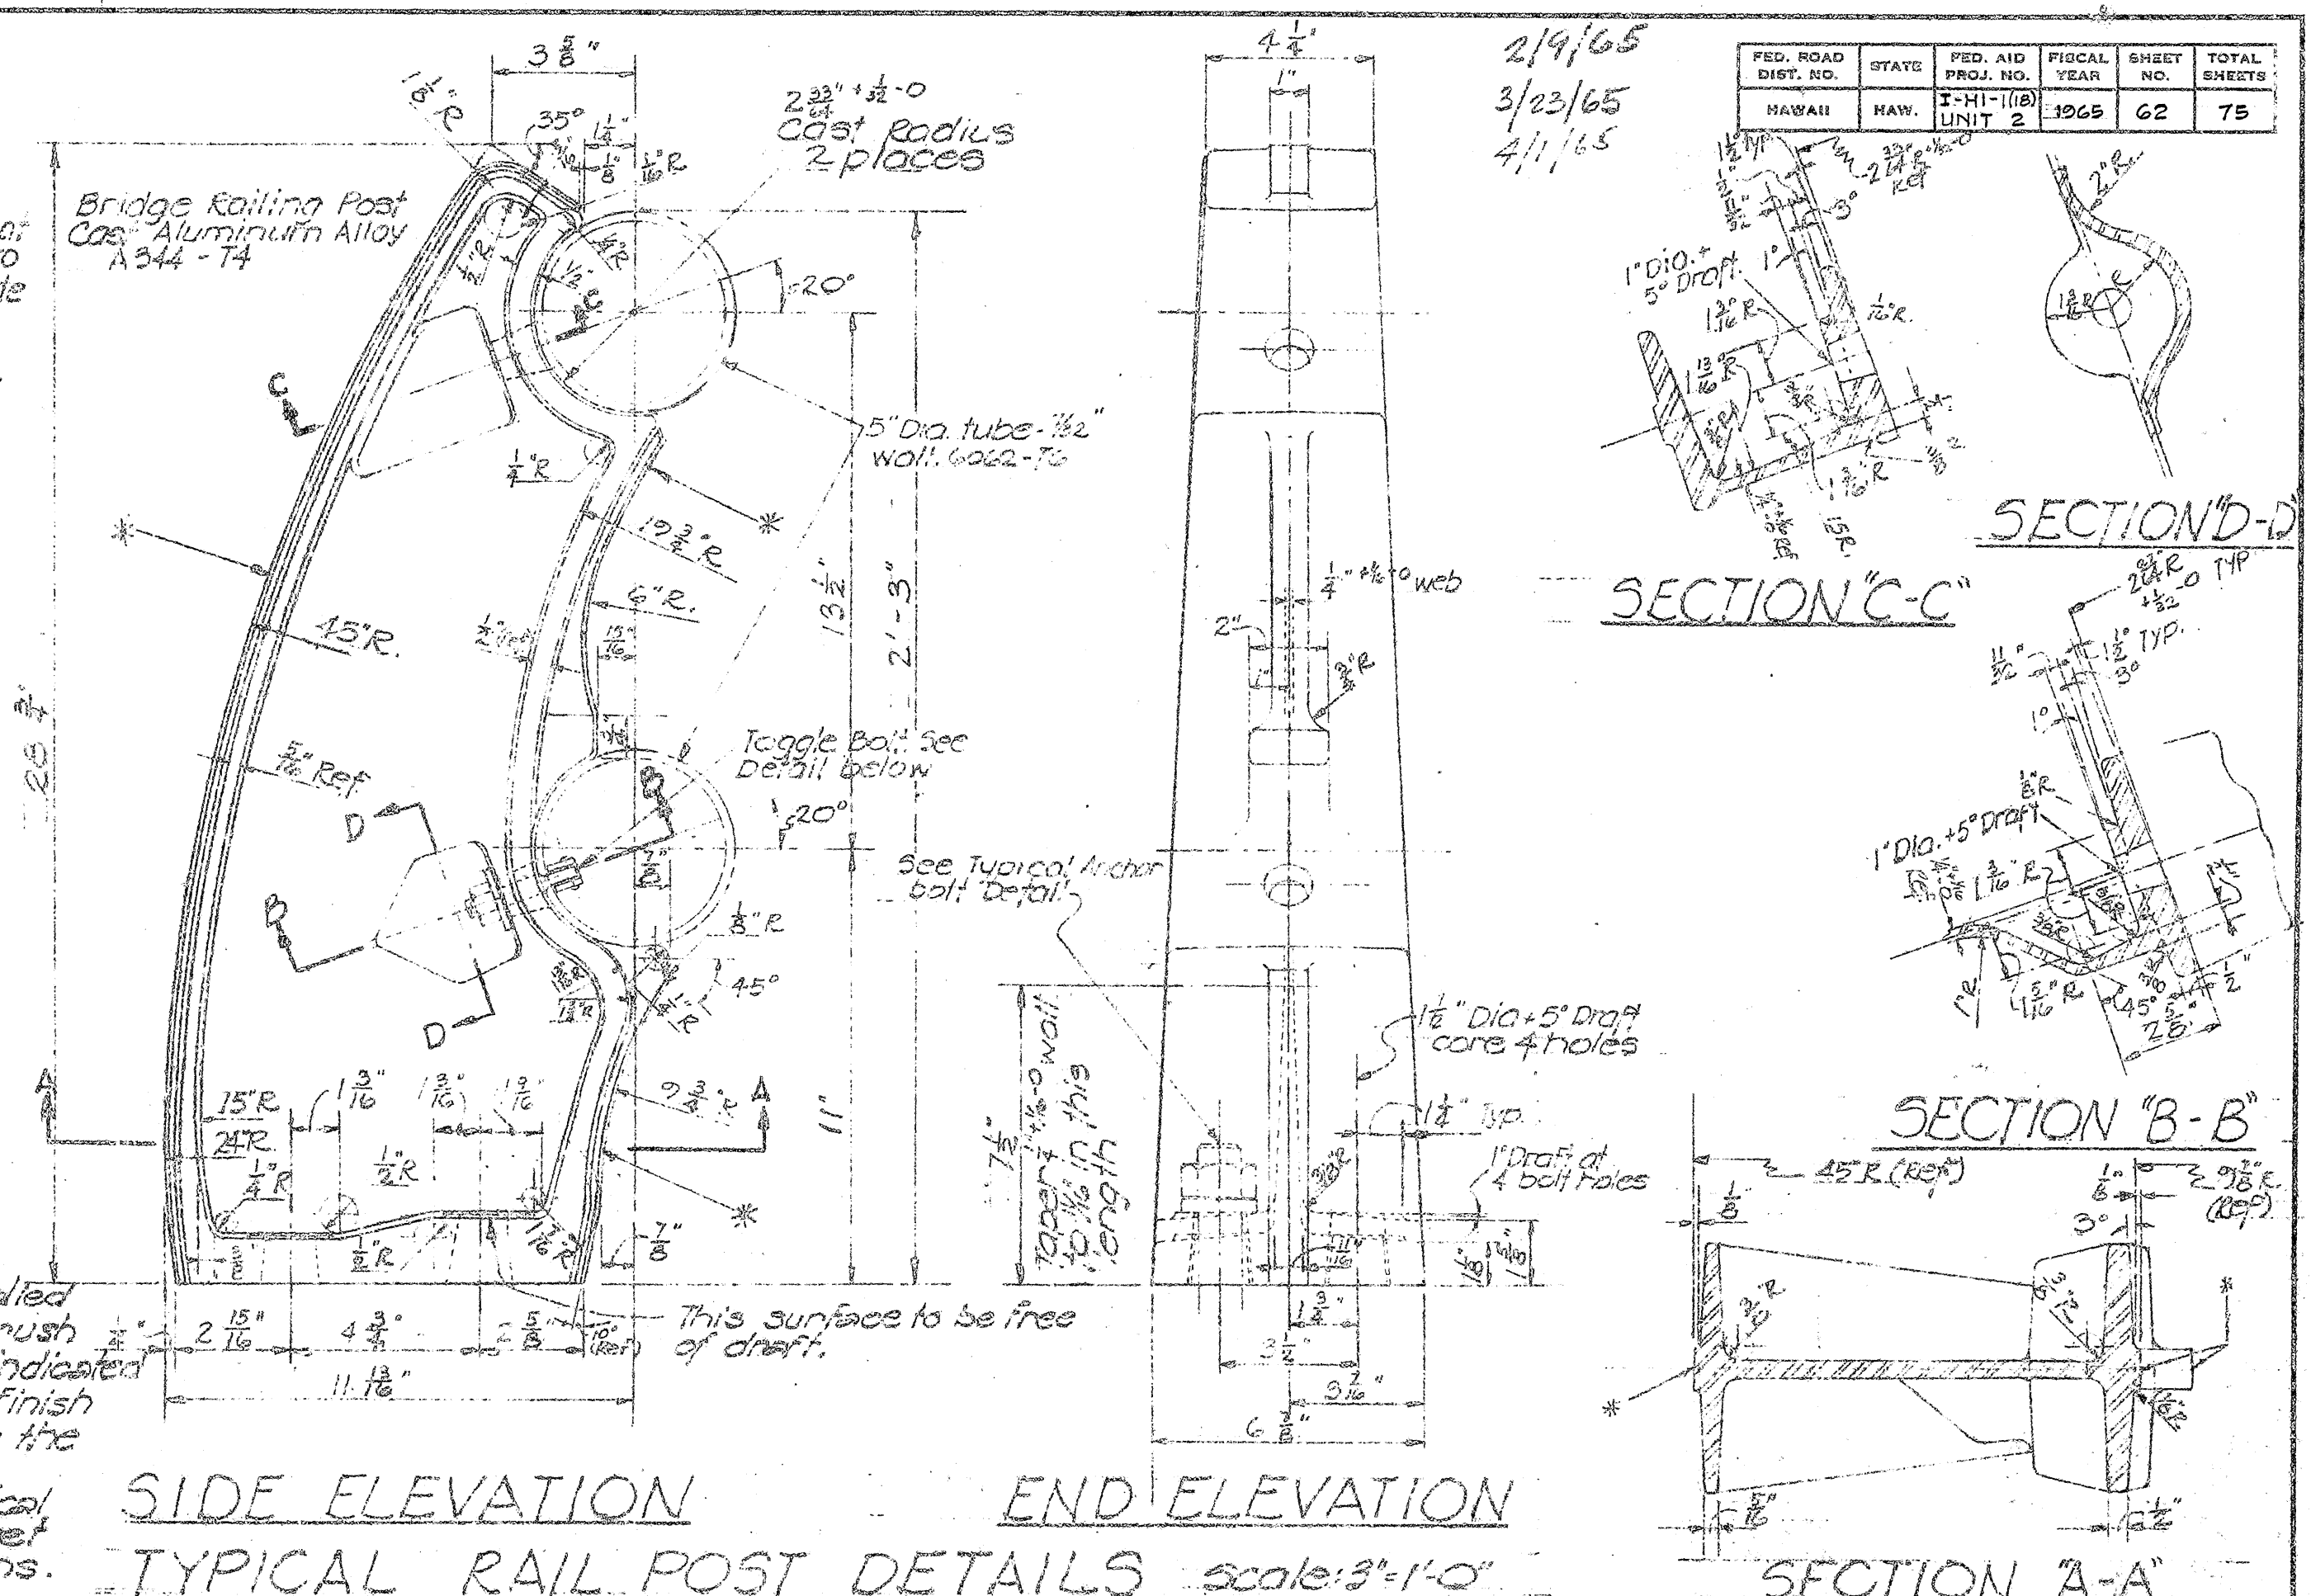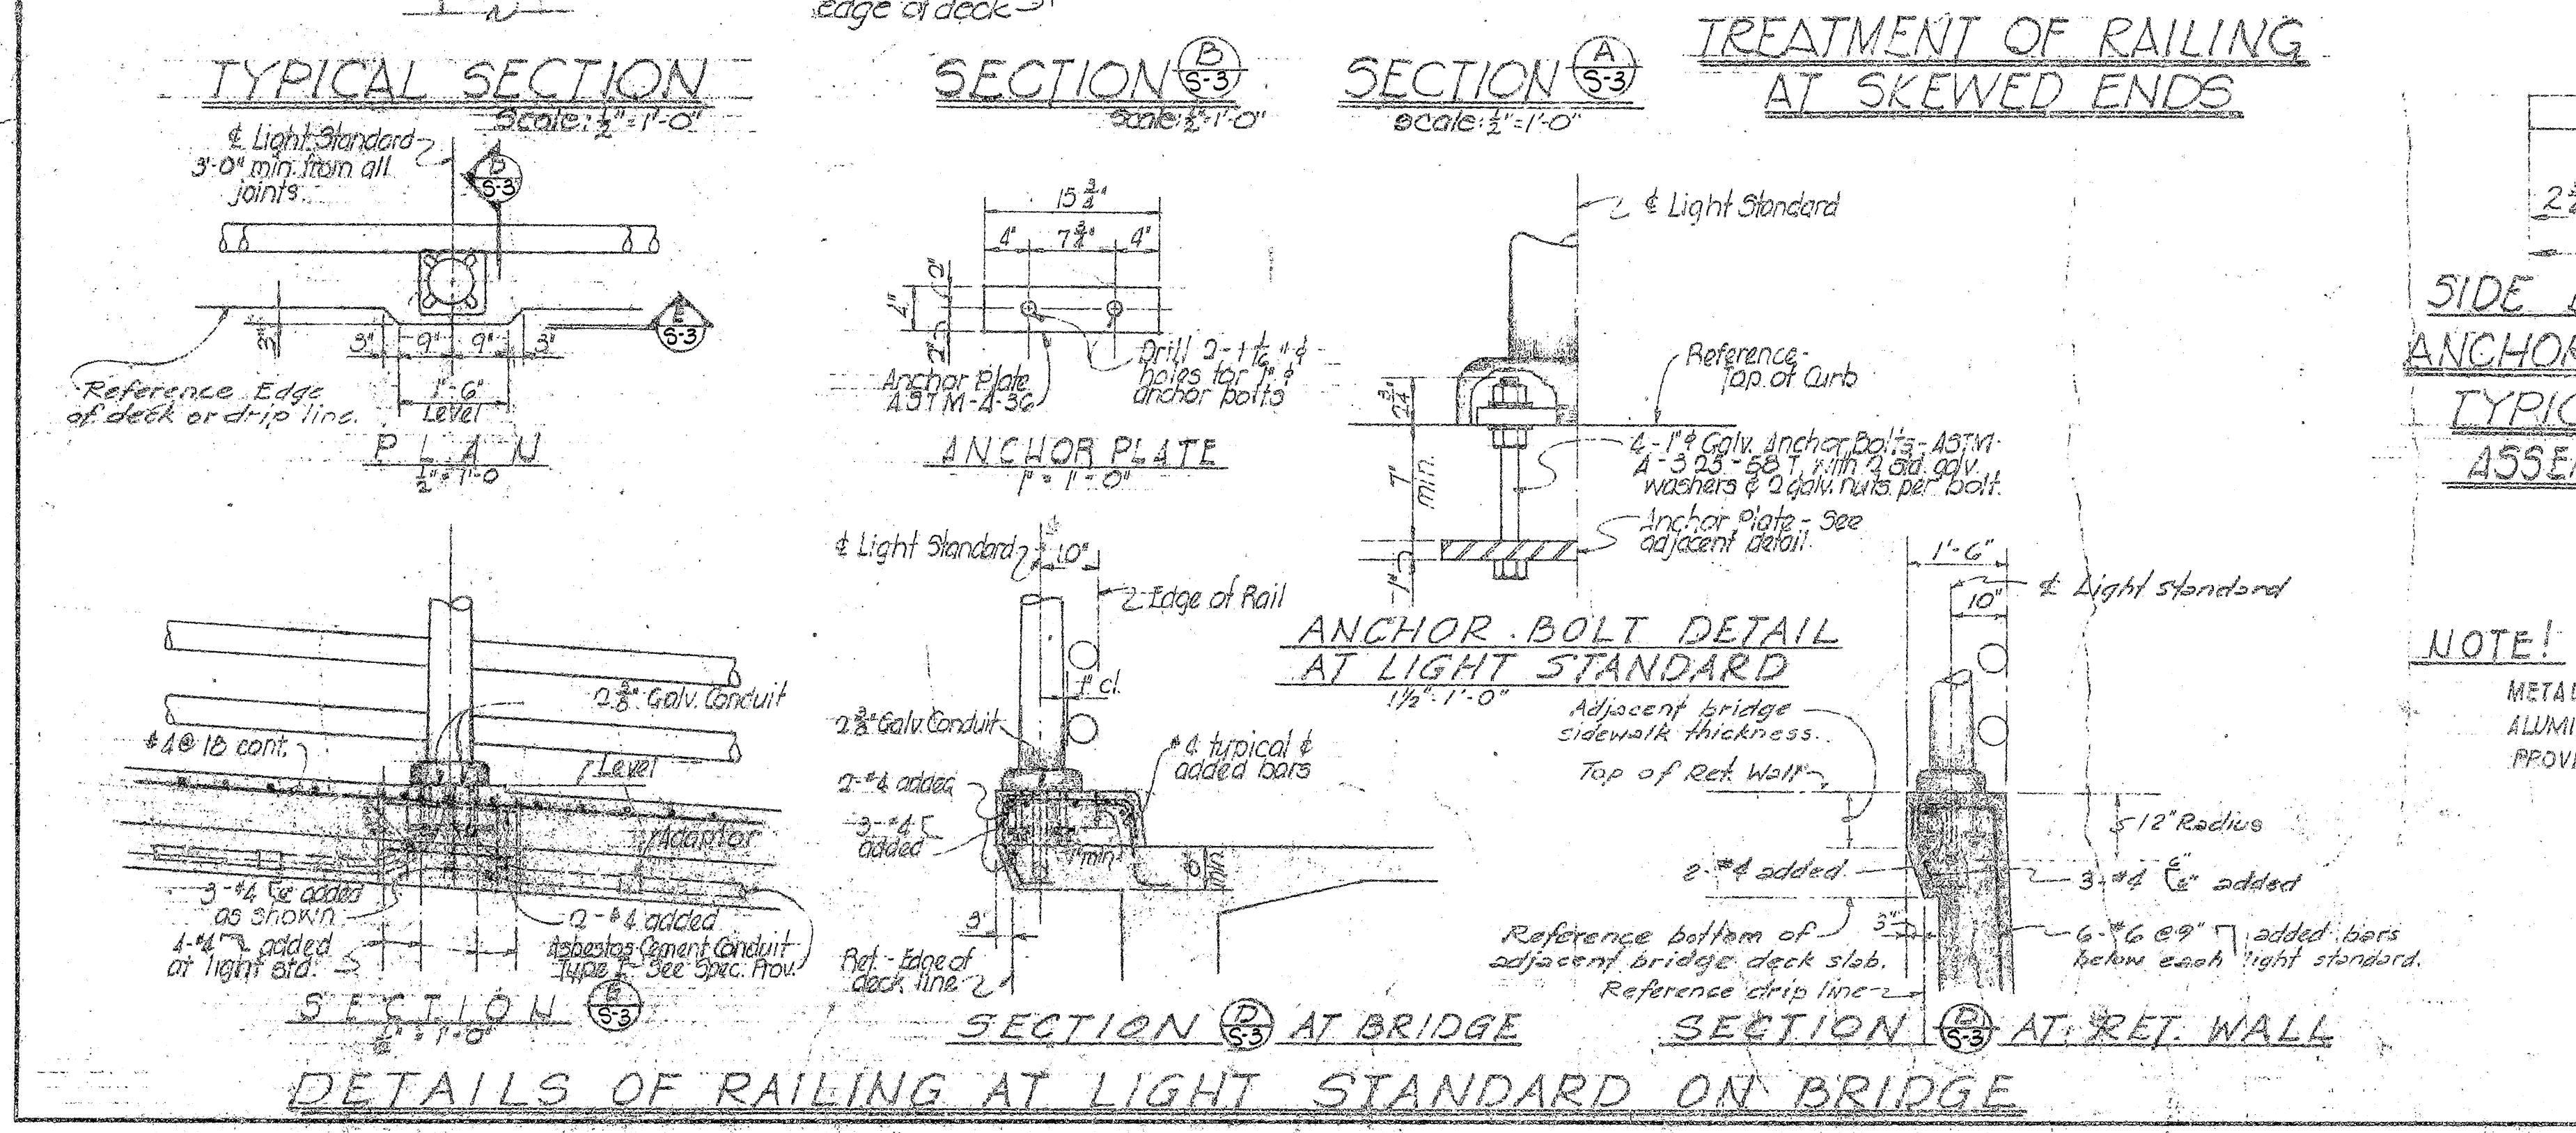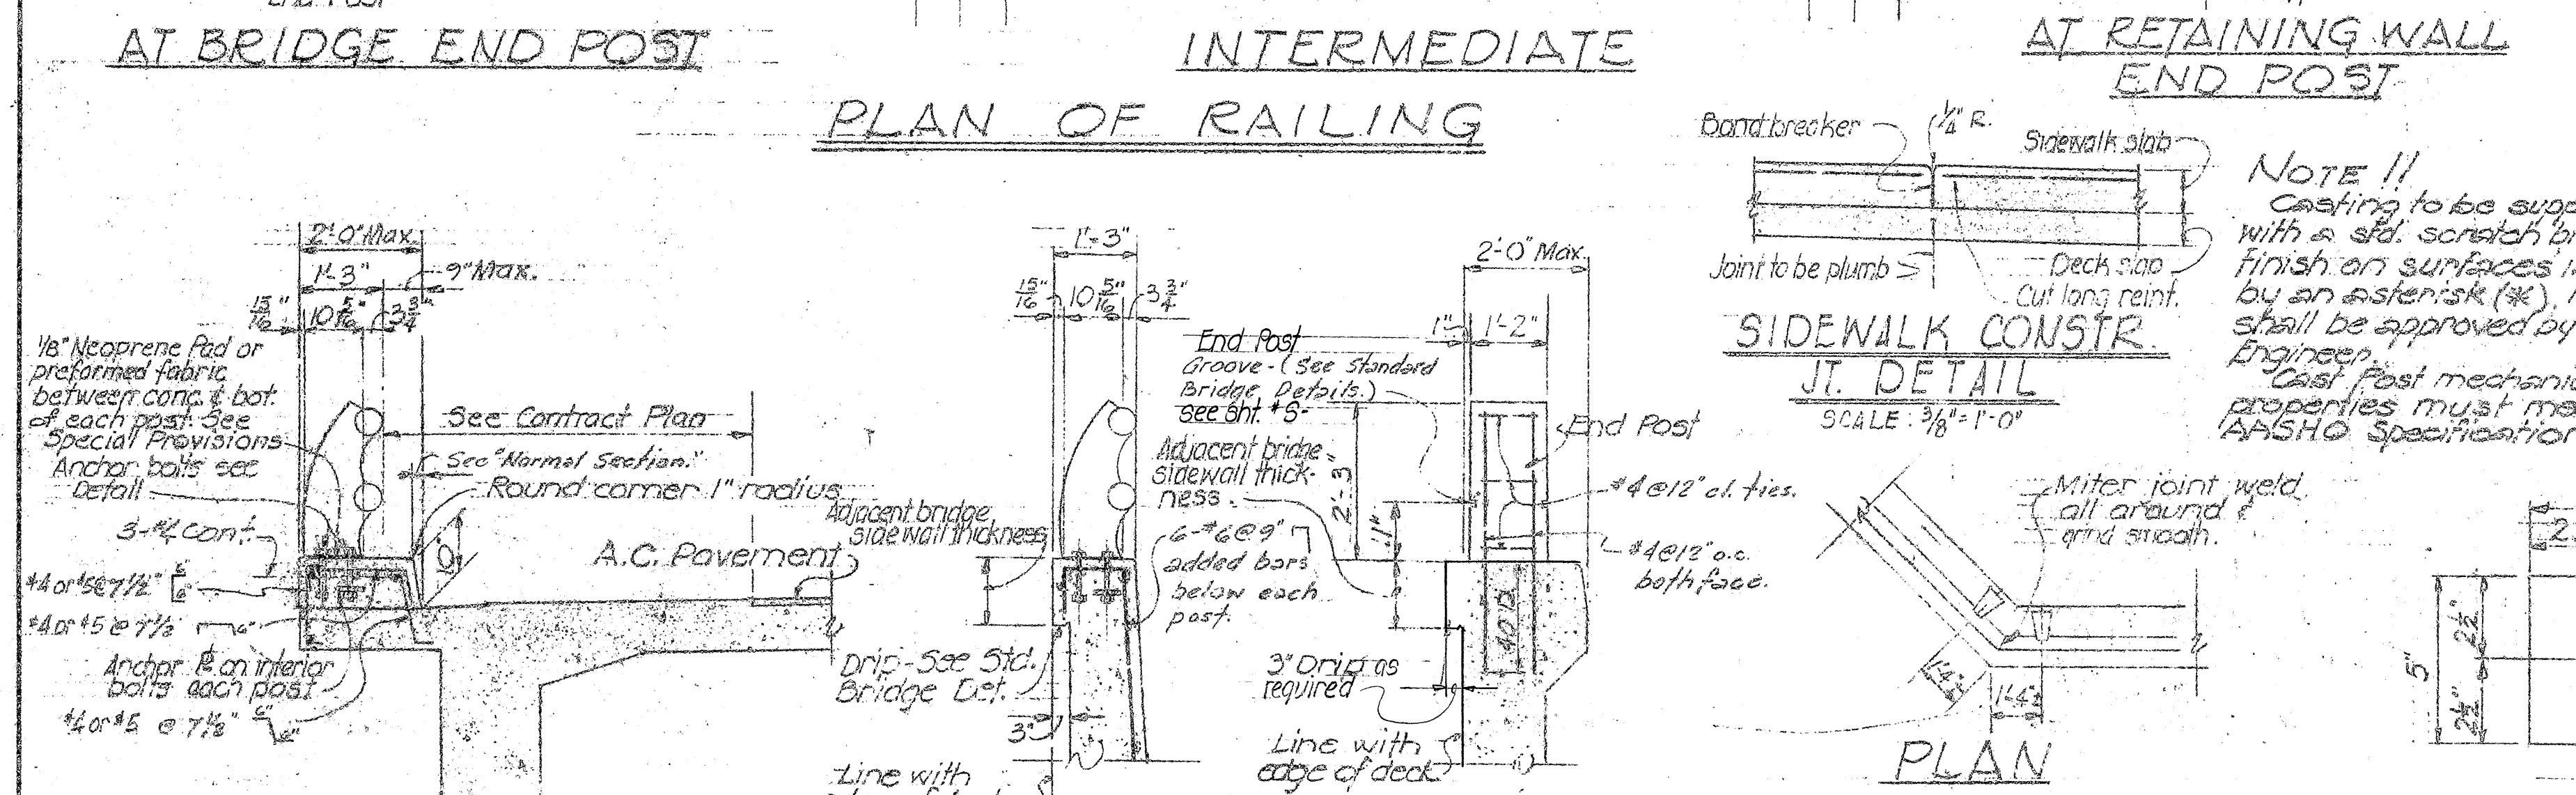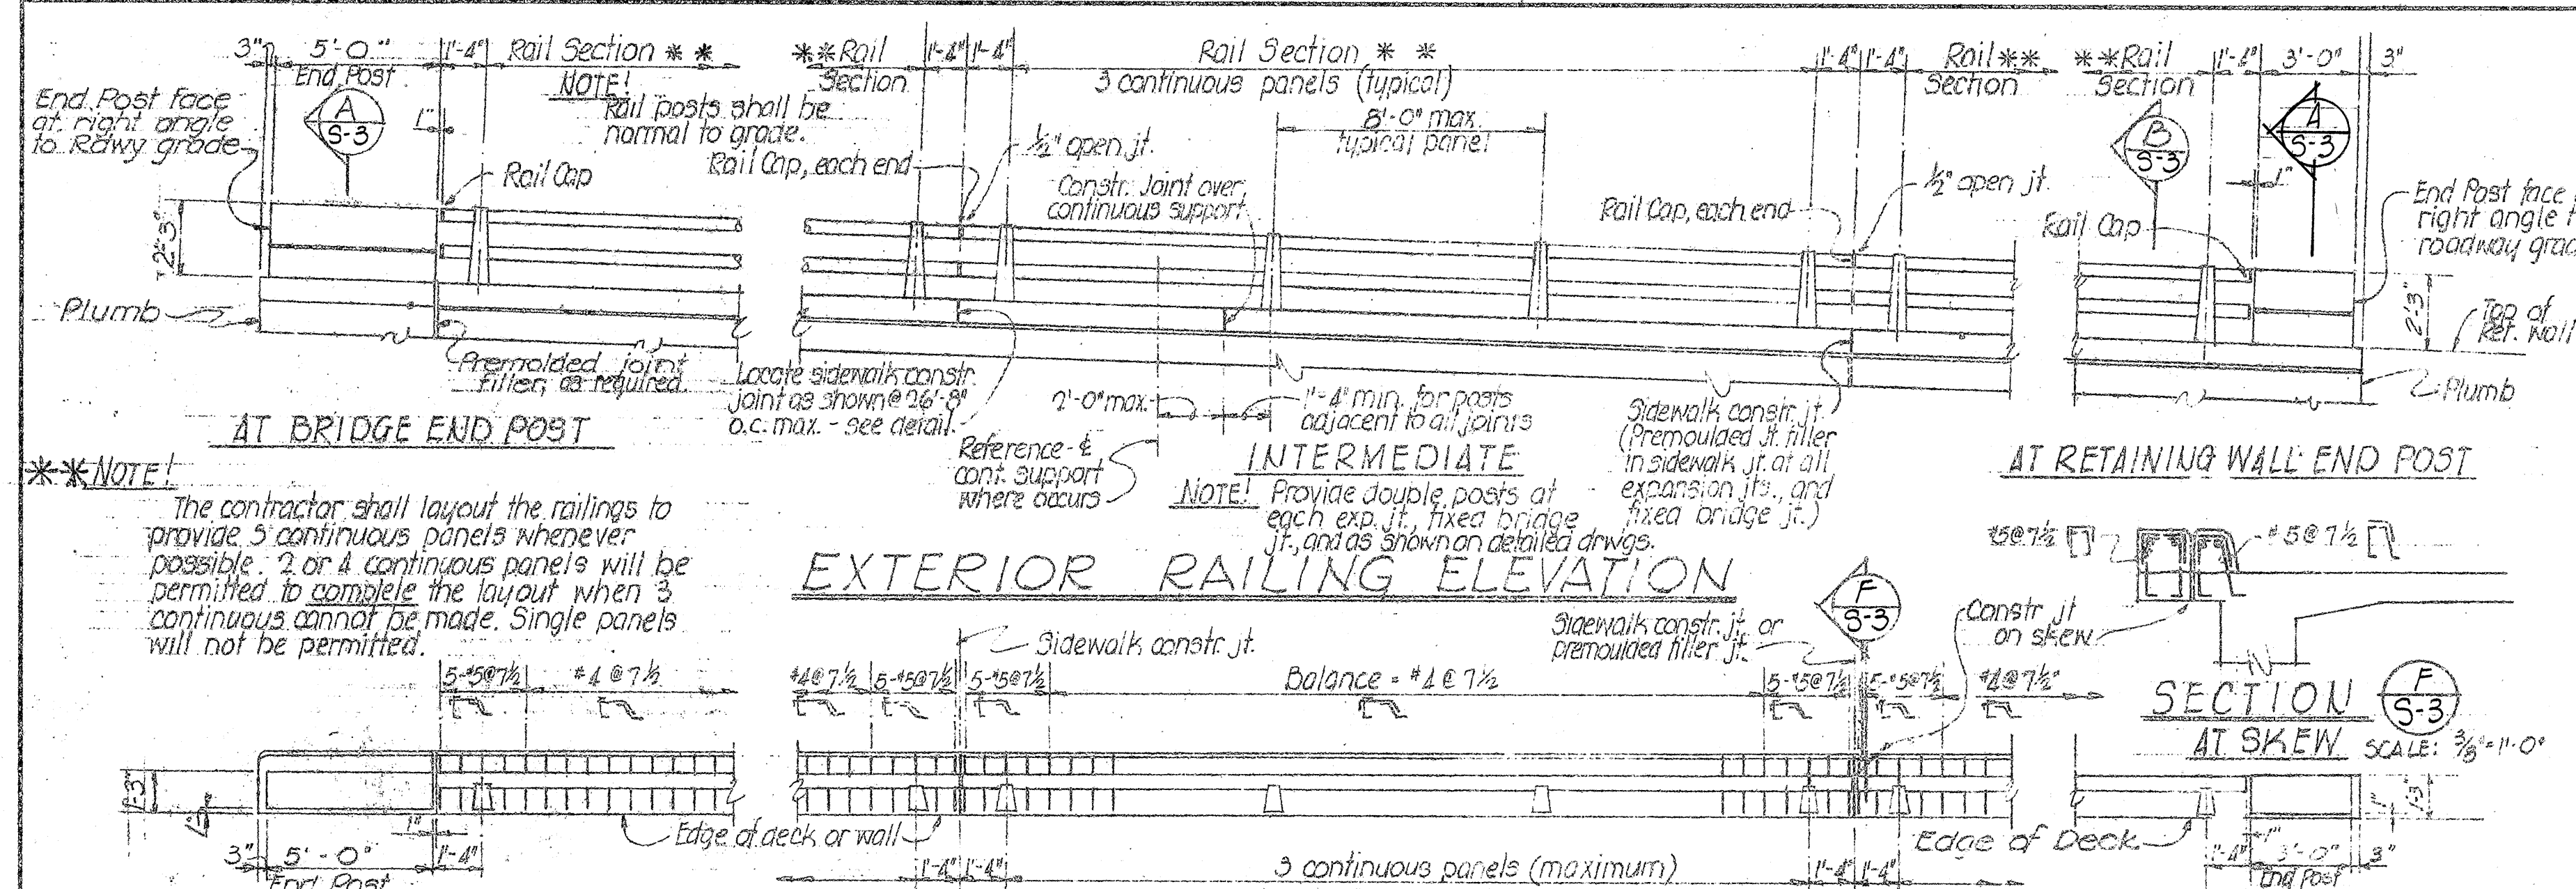

FED. ROAD DIST. NO.	STATE	FED. AID PROJ. NO.	FISCAL YEAR	SHEET NO.	TOTAL SHEETS
HAWAII	HAW.	I-HI-1118 UNIT 2	1965	62	75