
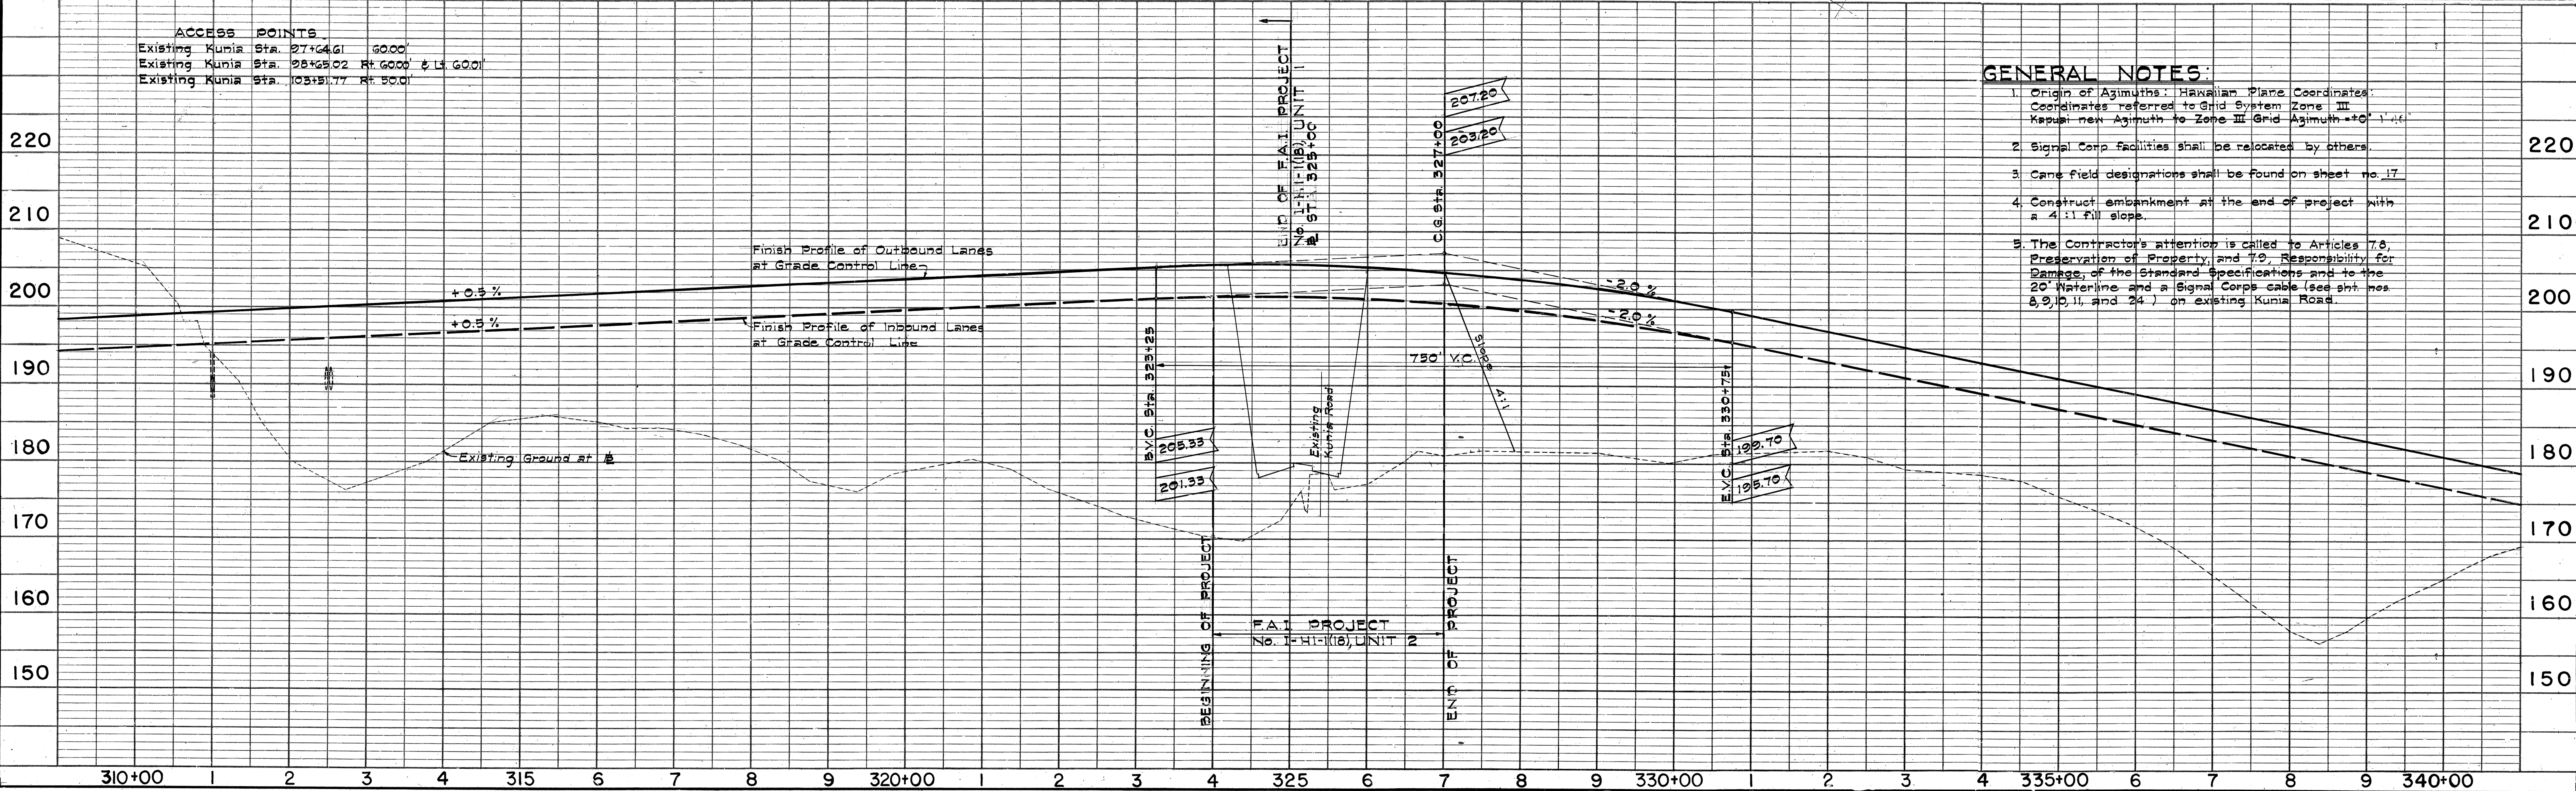


PLAN	DATE	BY
	SURVEYED	PLOTTED
	NOTE BOOK	ALIGNMENT CHECKED
	NO.	RT. OF WAY CHECKED

PROFILE	DATE	BY
	SURVEYED	PLOTTED
	NOTE BOOK	GRADES CHECKED
	NO.	STRUCTURE NOTATIONS CHKO.

FED. AID DIST. NO.	STATE	FED. AID PROJ. NO.	FISCAL YEAR	SHEET NO.	TOTAL SHEETS
HAWAII	HAWAII	I-HI-1(16) UNIT 2	1965	6	75

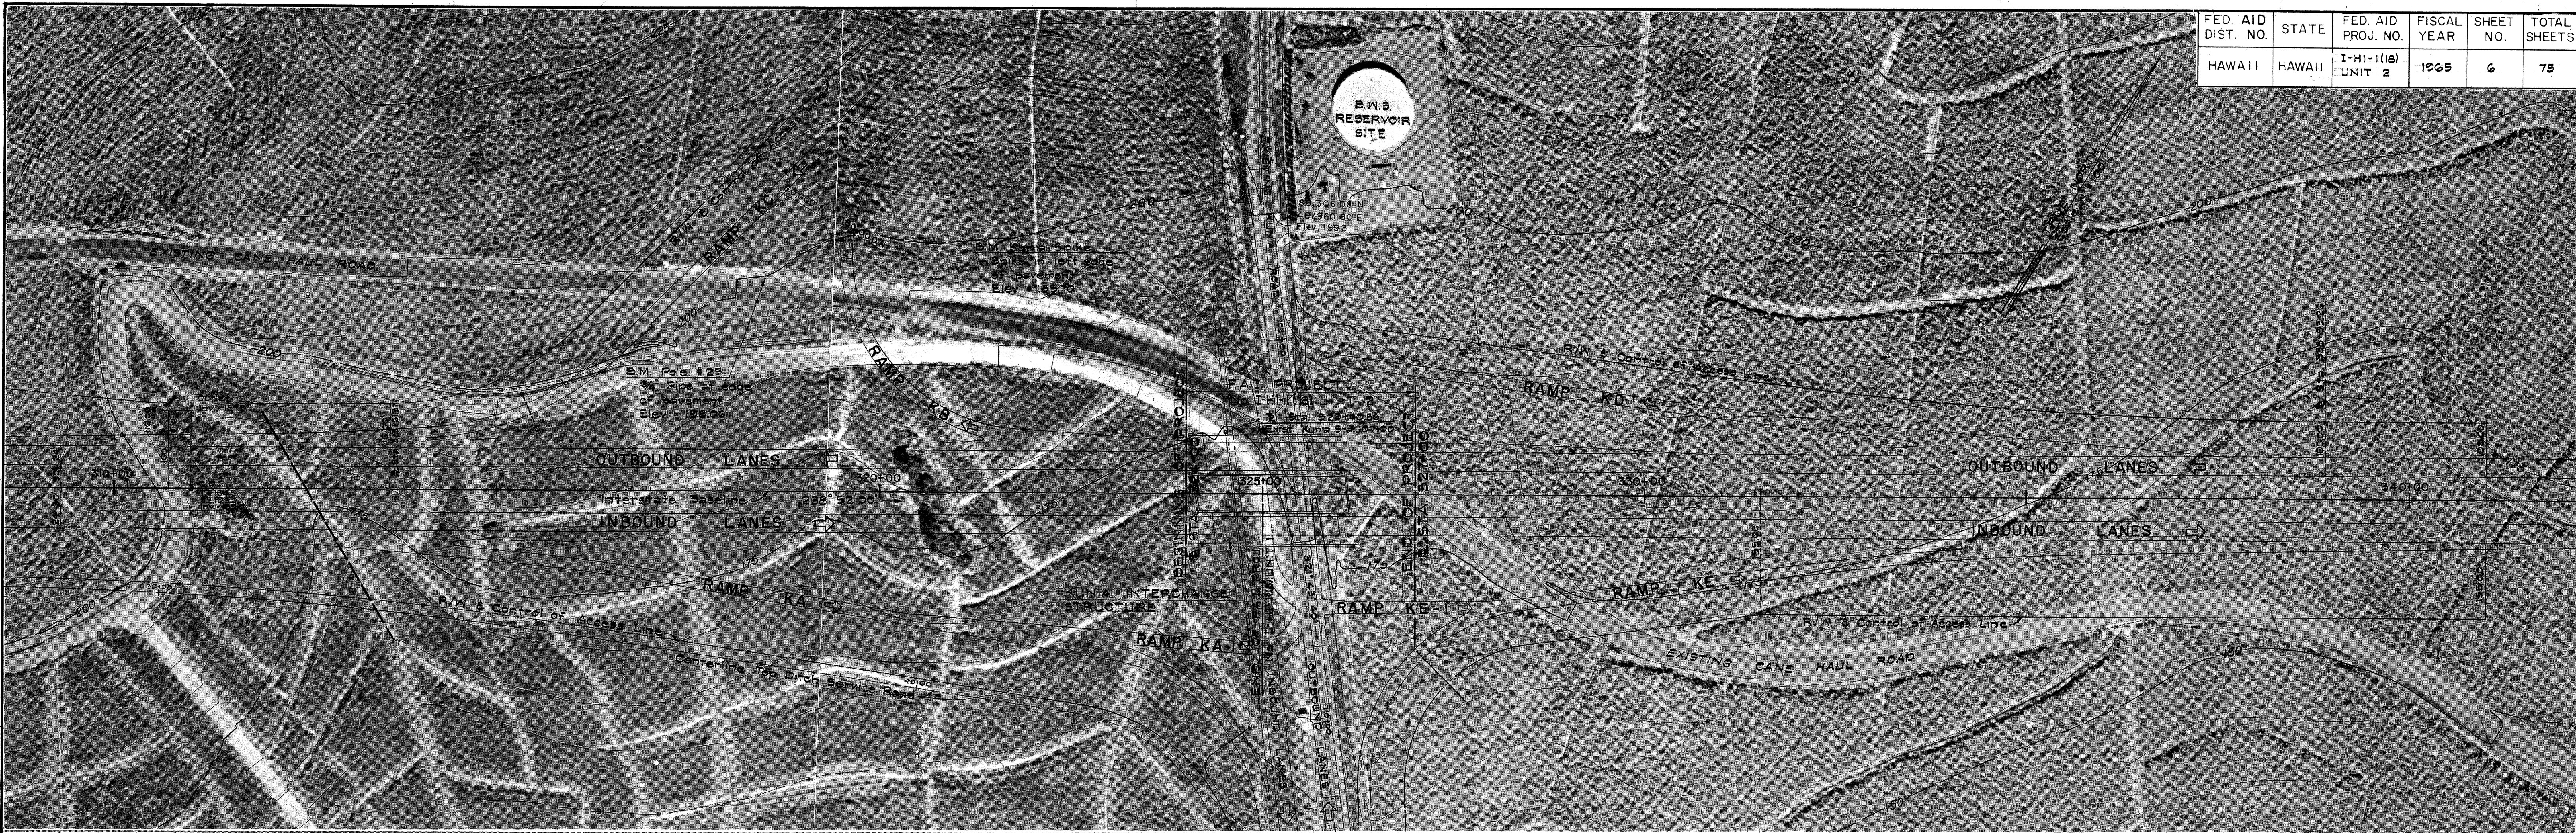

- GENERAL NOTES:**
1. Origin of Azimuths: Hawaiian Plane Coordinates. Coordinates referred to Grid System Zone III. Kapua new Azimuth to Zone III Grid Azimuth +6° 1' 44".
 2. Signal Corp facilities shall be relocated by others.
 3. Cane field designations shall be found on sheet no. 17.
 4. Construct embankment at the end of project with a 4:1 fill slope.
 5. The Contractor's attention is called to Articles 7.6, Preservation of Property, and 7.9, Responsibility for Damage, of the Standard Specifications and to the 20' Waterline and a Signal Corps cable (see sht. nos. 8, 9, 10, 11, and 24) on existing Kunia Road.

on 10-11-5

DS-1-28

FED. AID DIST. NO.	STATE	FED. AID PROJ. NO.	FISCAL YEAR	SHEET NO.	TOTAL SHEETS
HAWAII	HAWAII	I-HI-1(18) UNIT 2	1965	7	75

PLAN	SURVEYED	BY	DATE
NOTE BOOK NO.	PLOTTED		
	ALIGNMENT CHECKED		
	RT. OF WAY CHECKED		



PROFILE	SURVEYED	BY	DATE
NOTE BOOK NO.	PLOTTED		
	CHECKED		
	STRUCTURE NOTATIONS CHKD.		

