



FED. ROAD DIST. NO.	STATE	FED. AID PROJ. NO.	FISCAL YEAR	SHEET NO.	TOTAL SHEETS
HAWAII	HAW.	F-078-1(3)	1966	37	42

FINAL
SURVEY
PLAT
NO. 15
AREA
CHECKED

DATE
NO.
AREA
CHECKED

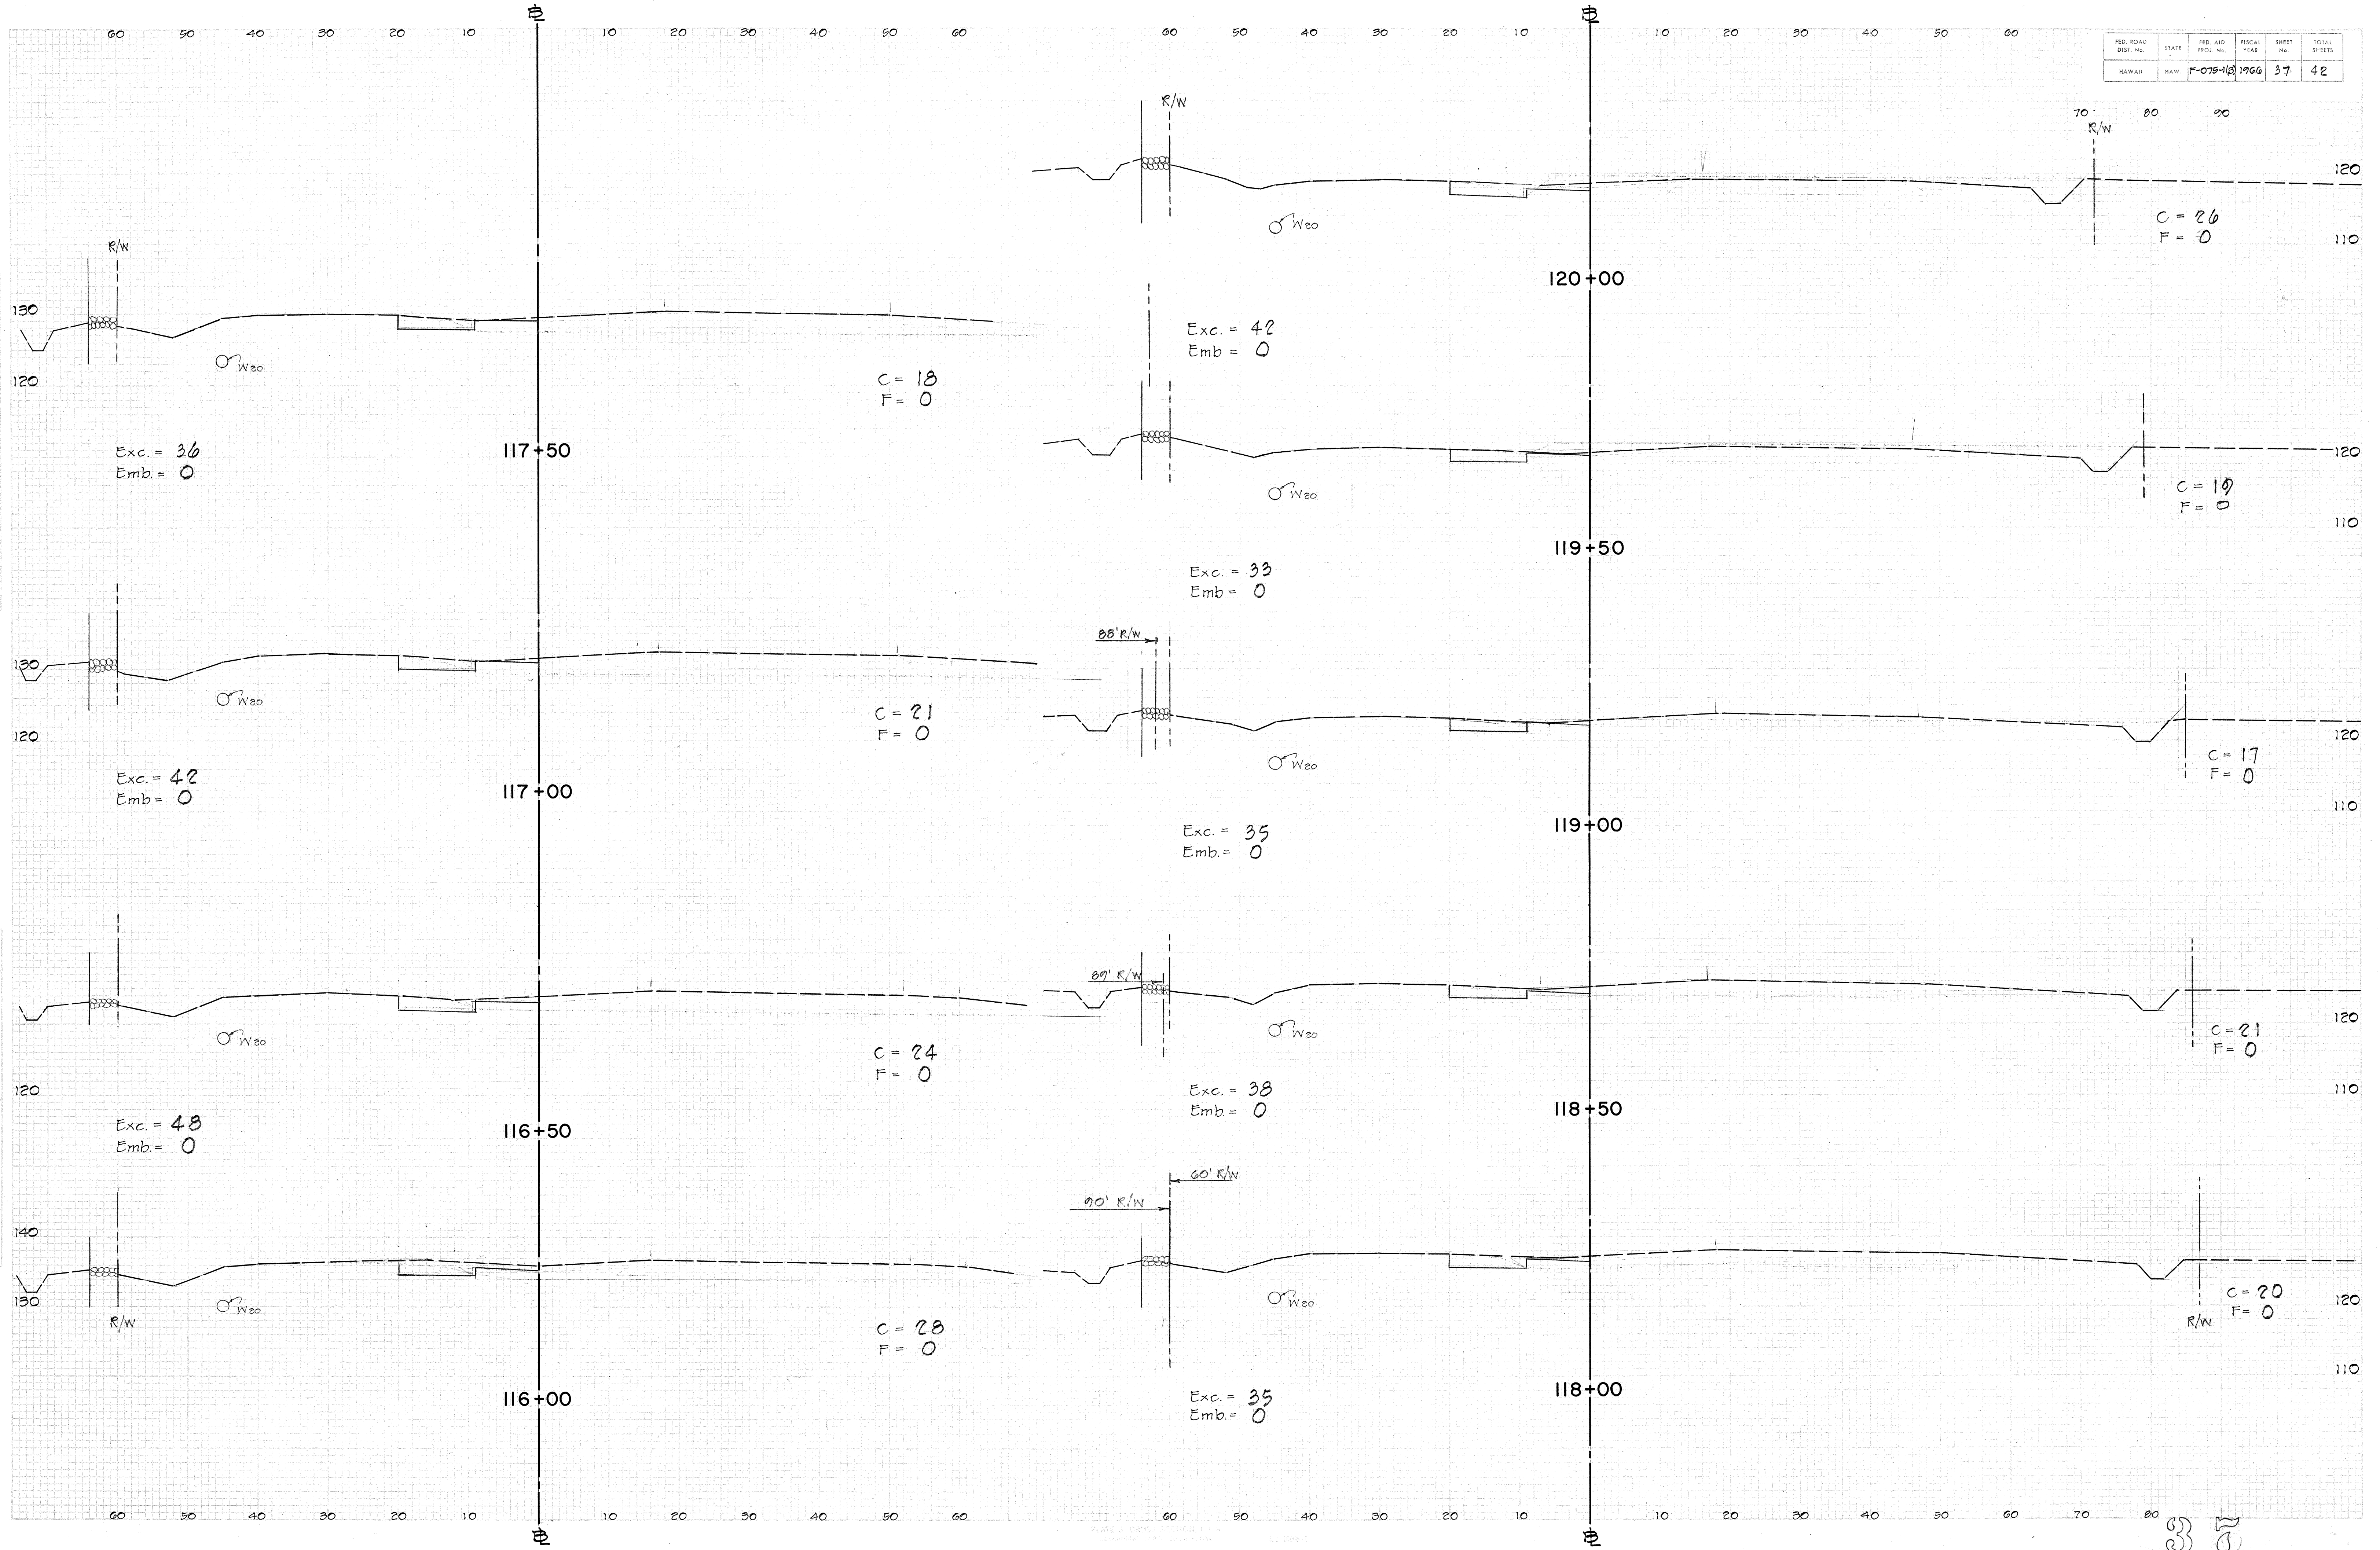


FED. ROAD DIST. No.	STATE	FED. AID PROJ. No.	FISCAL YEAR	SHEET No.	TOTAL SHEETS
HAWAII	HAW.	F-078-1(3)	1966	38	42

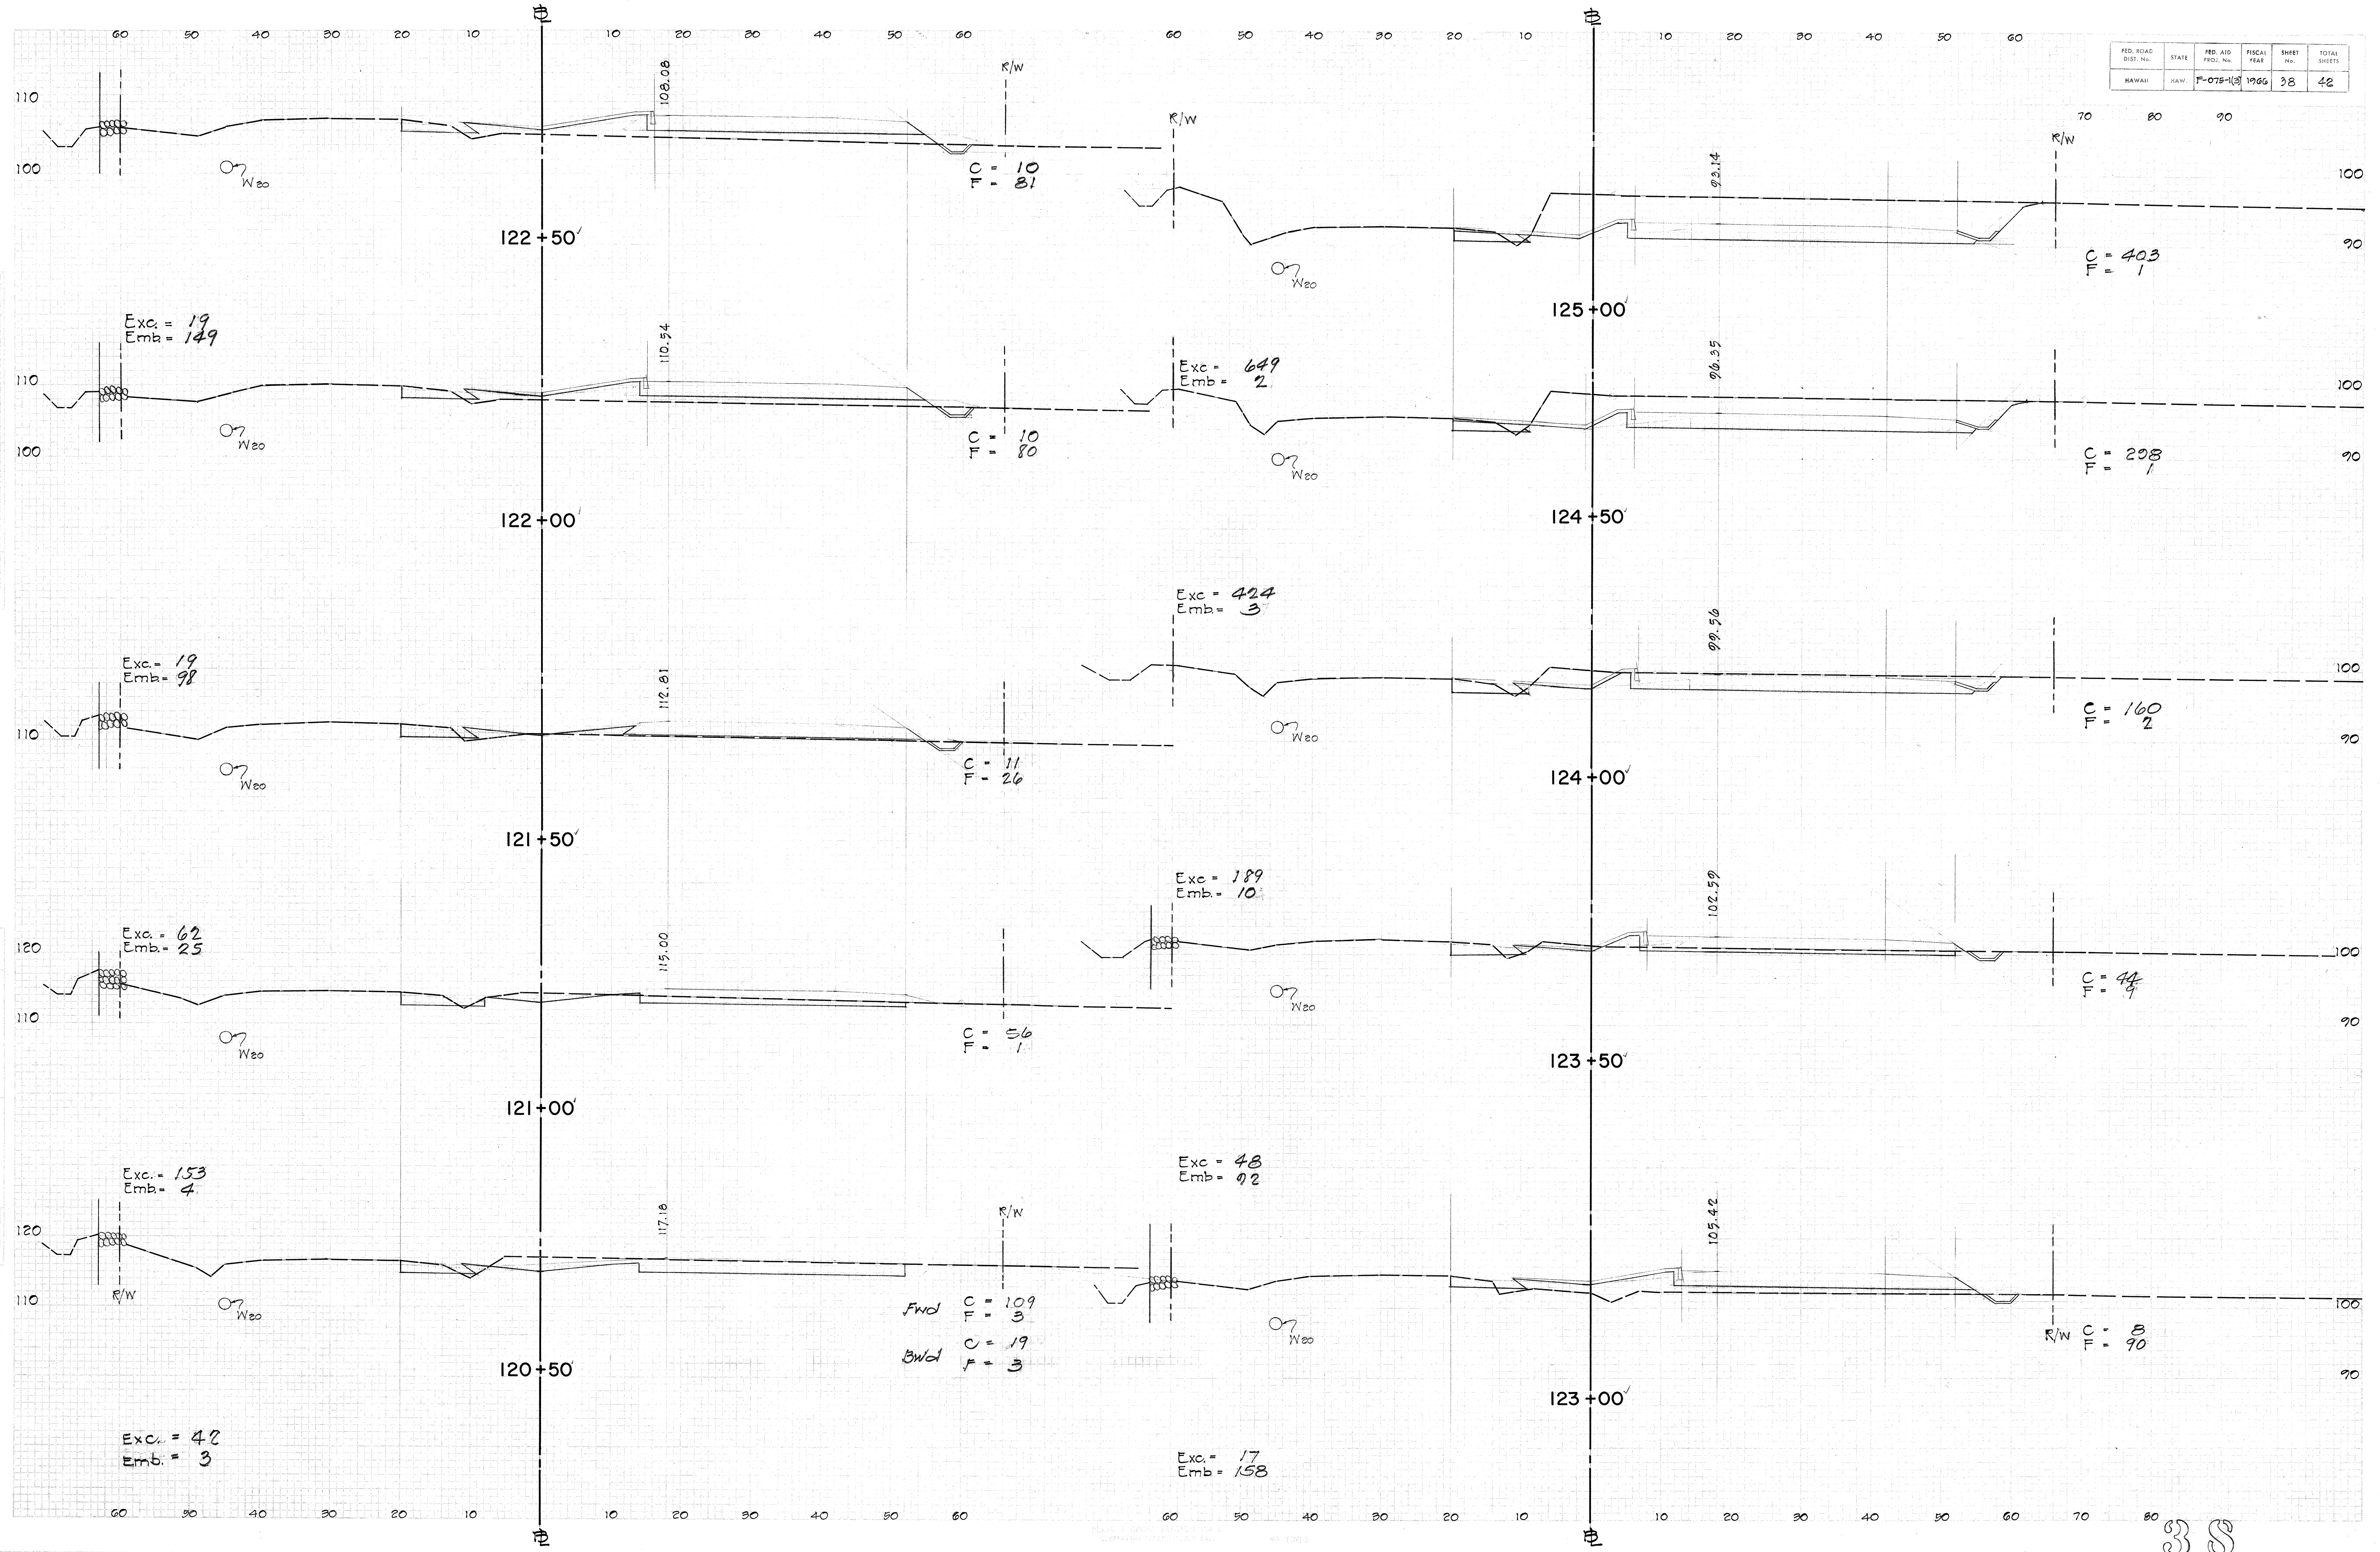


FINAL SURVEY
NOTES
DATE: 10/1/66
BY: [Signature]

ORIGINAL SURVEY
NOTES
DATE: 10/1/66
BY: [Signature]

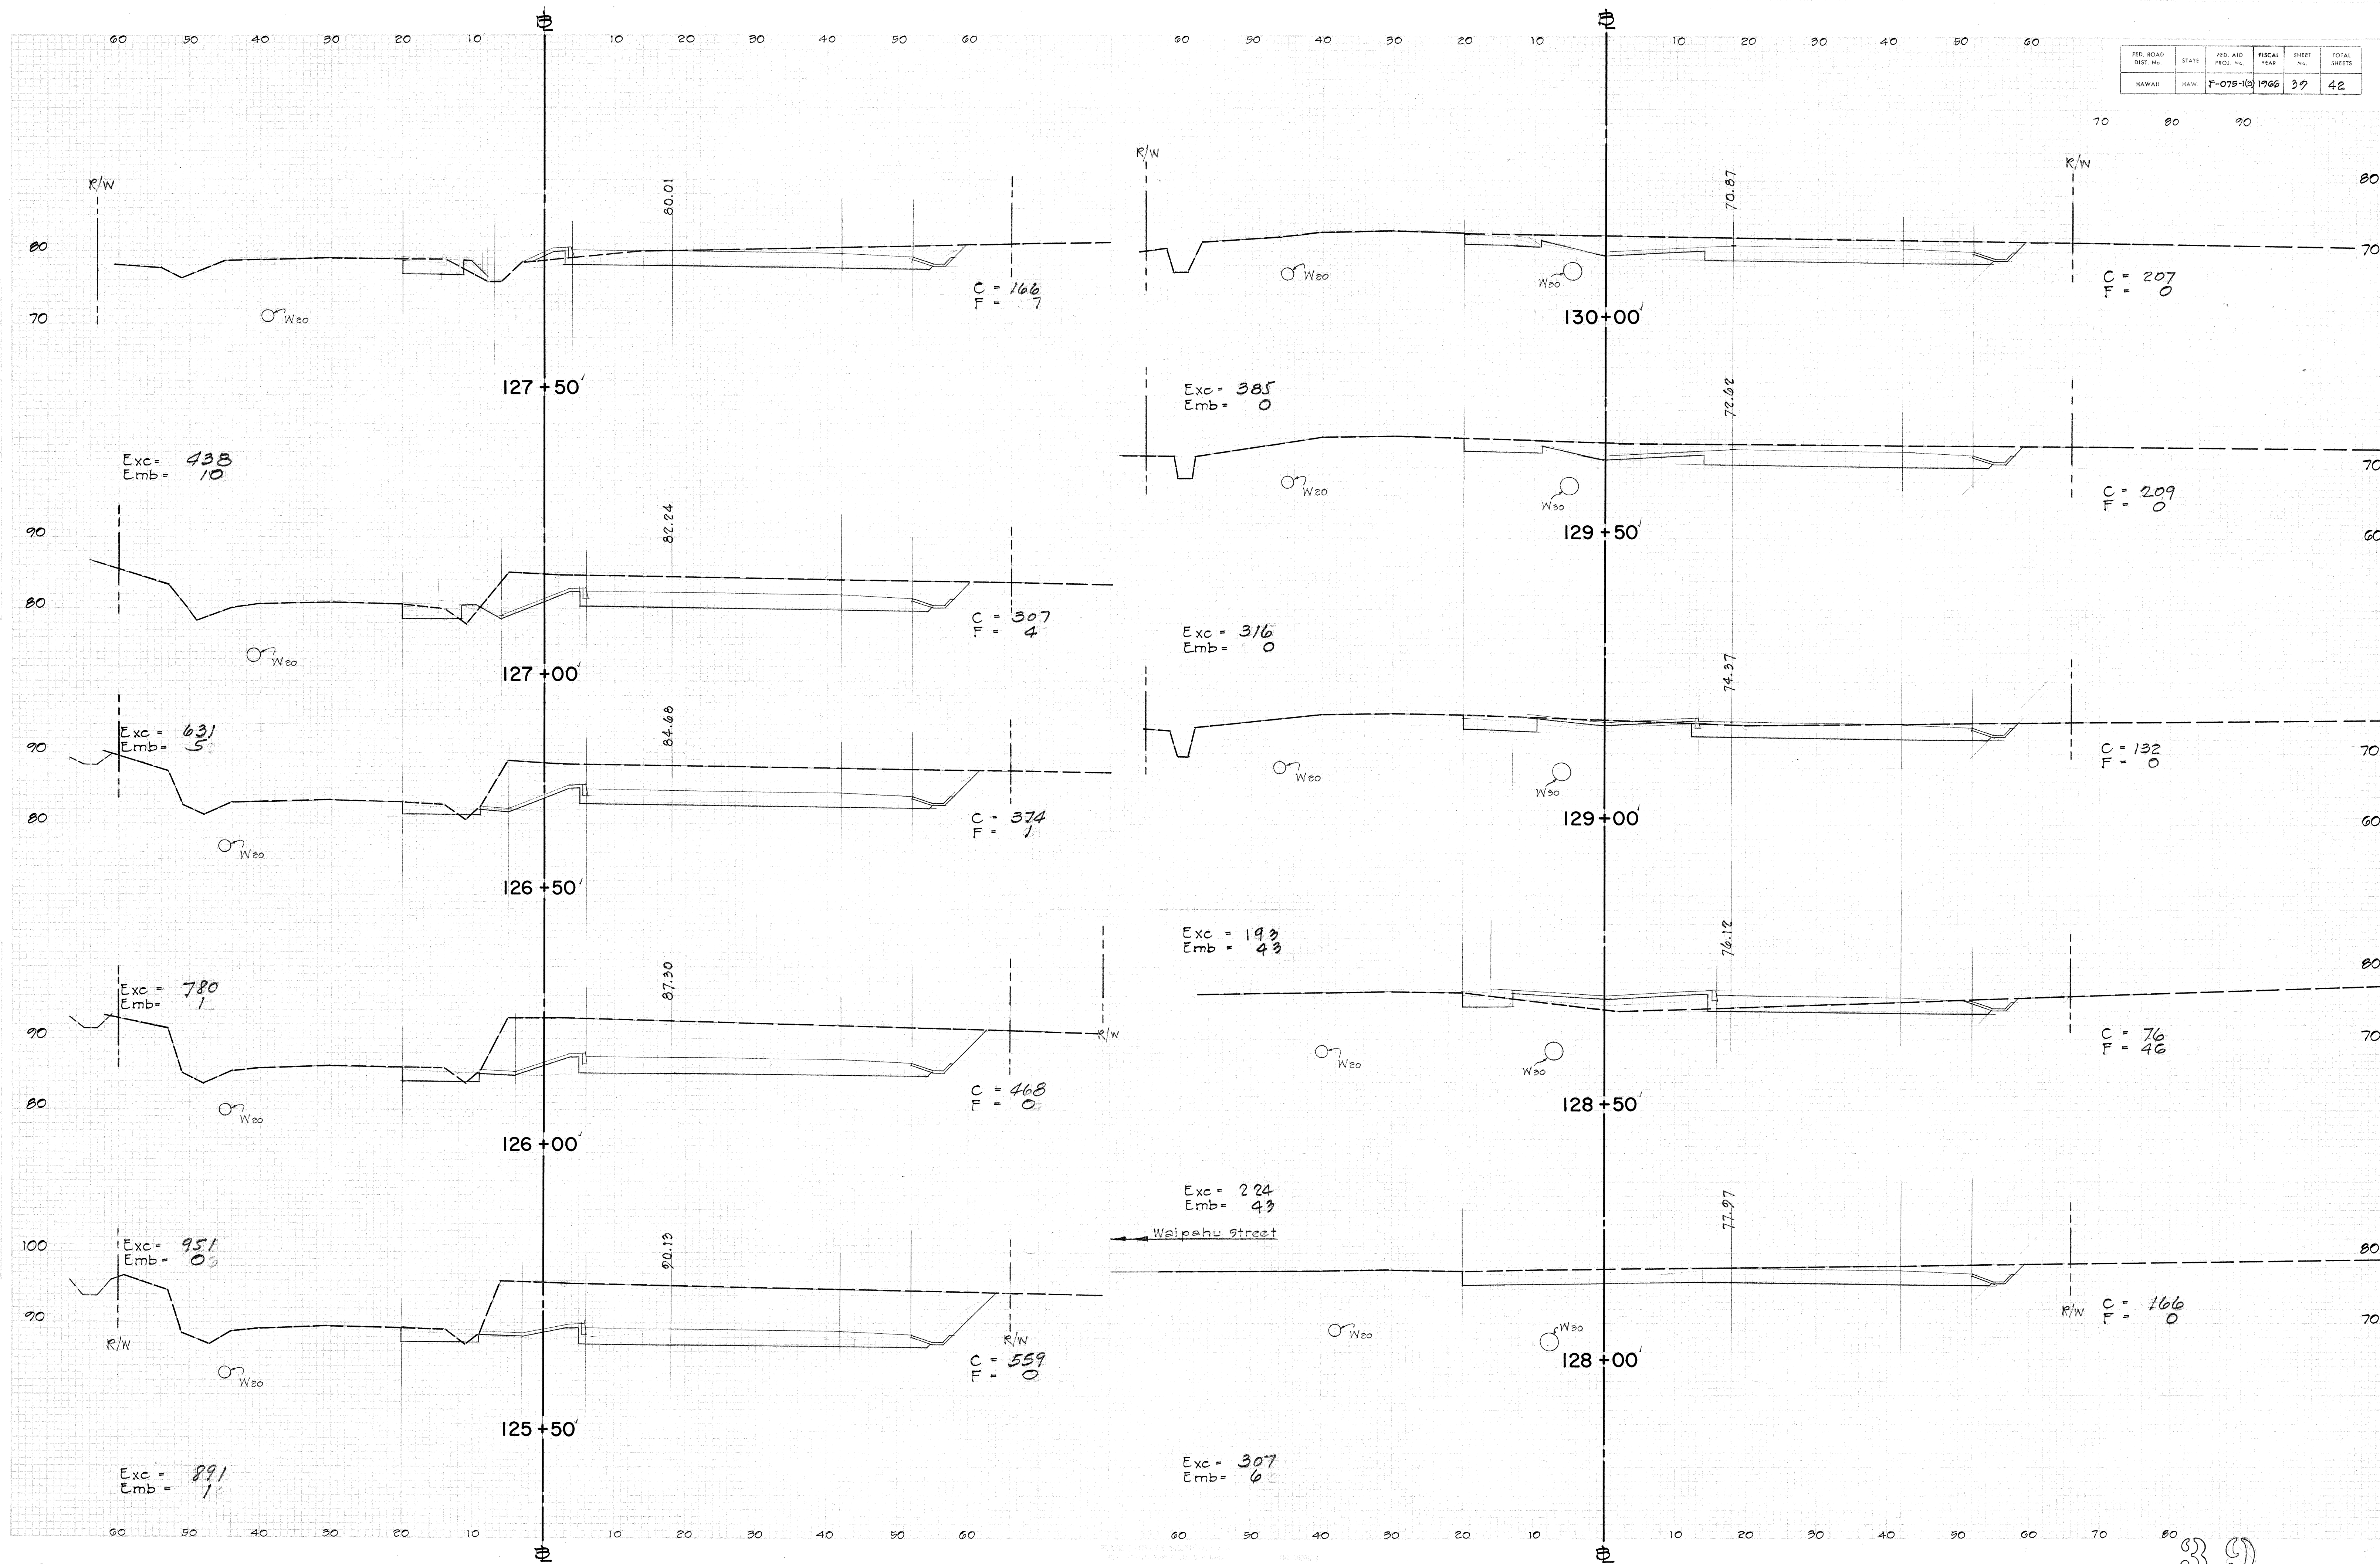


FED. ROAD DIST. NO.	STATE	FED. AID PROJ. NO.	FISCAL YEAR	SHEET NO.	TOTAL SHEETS
HAWAII	HAW.	7-075-1(2)	1966	40	42

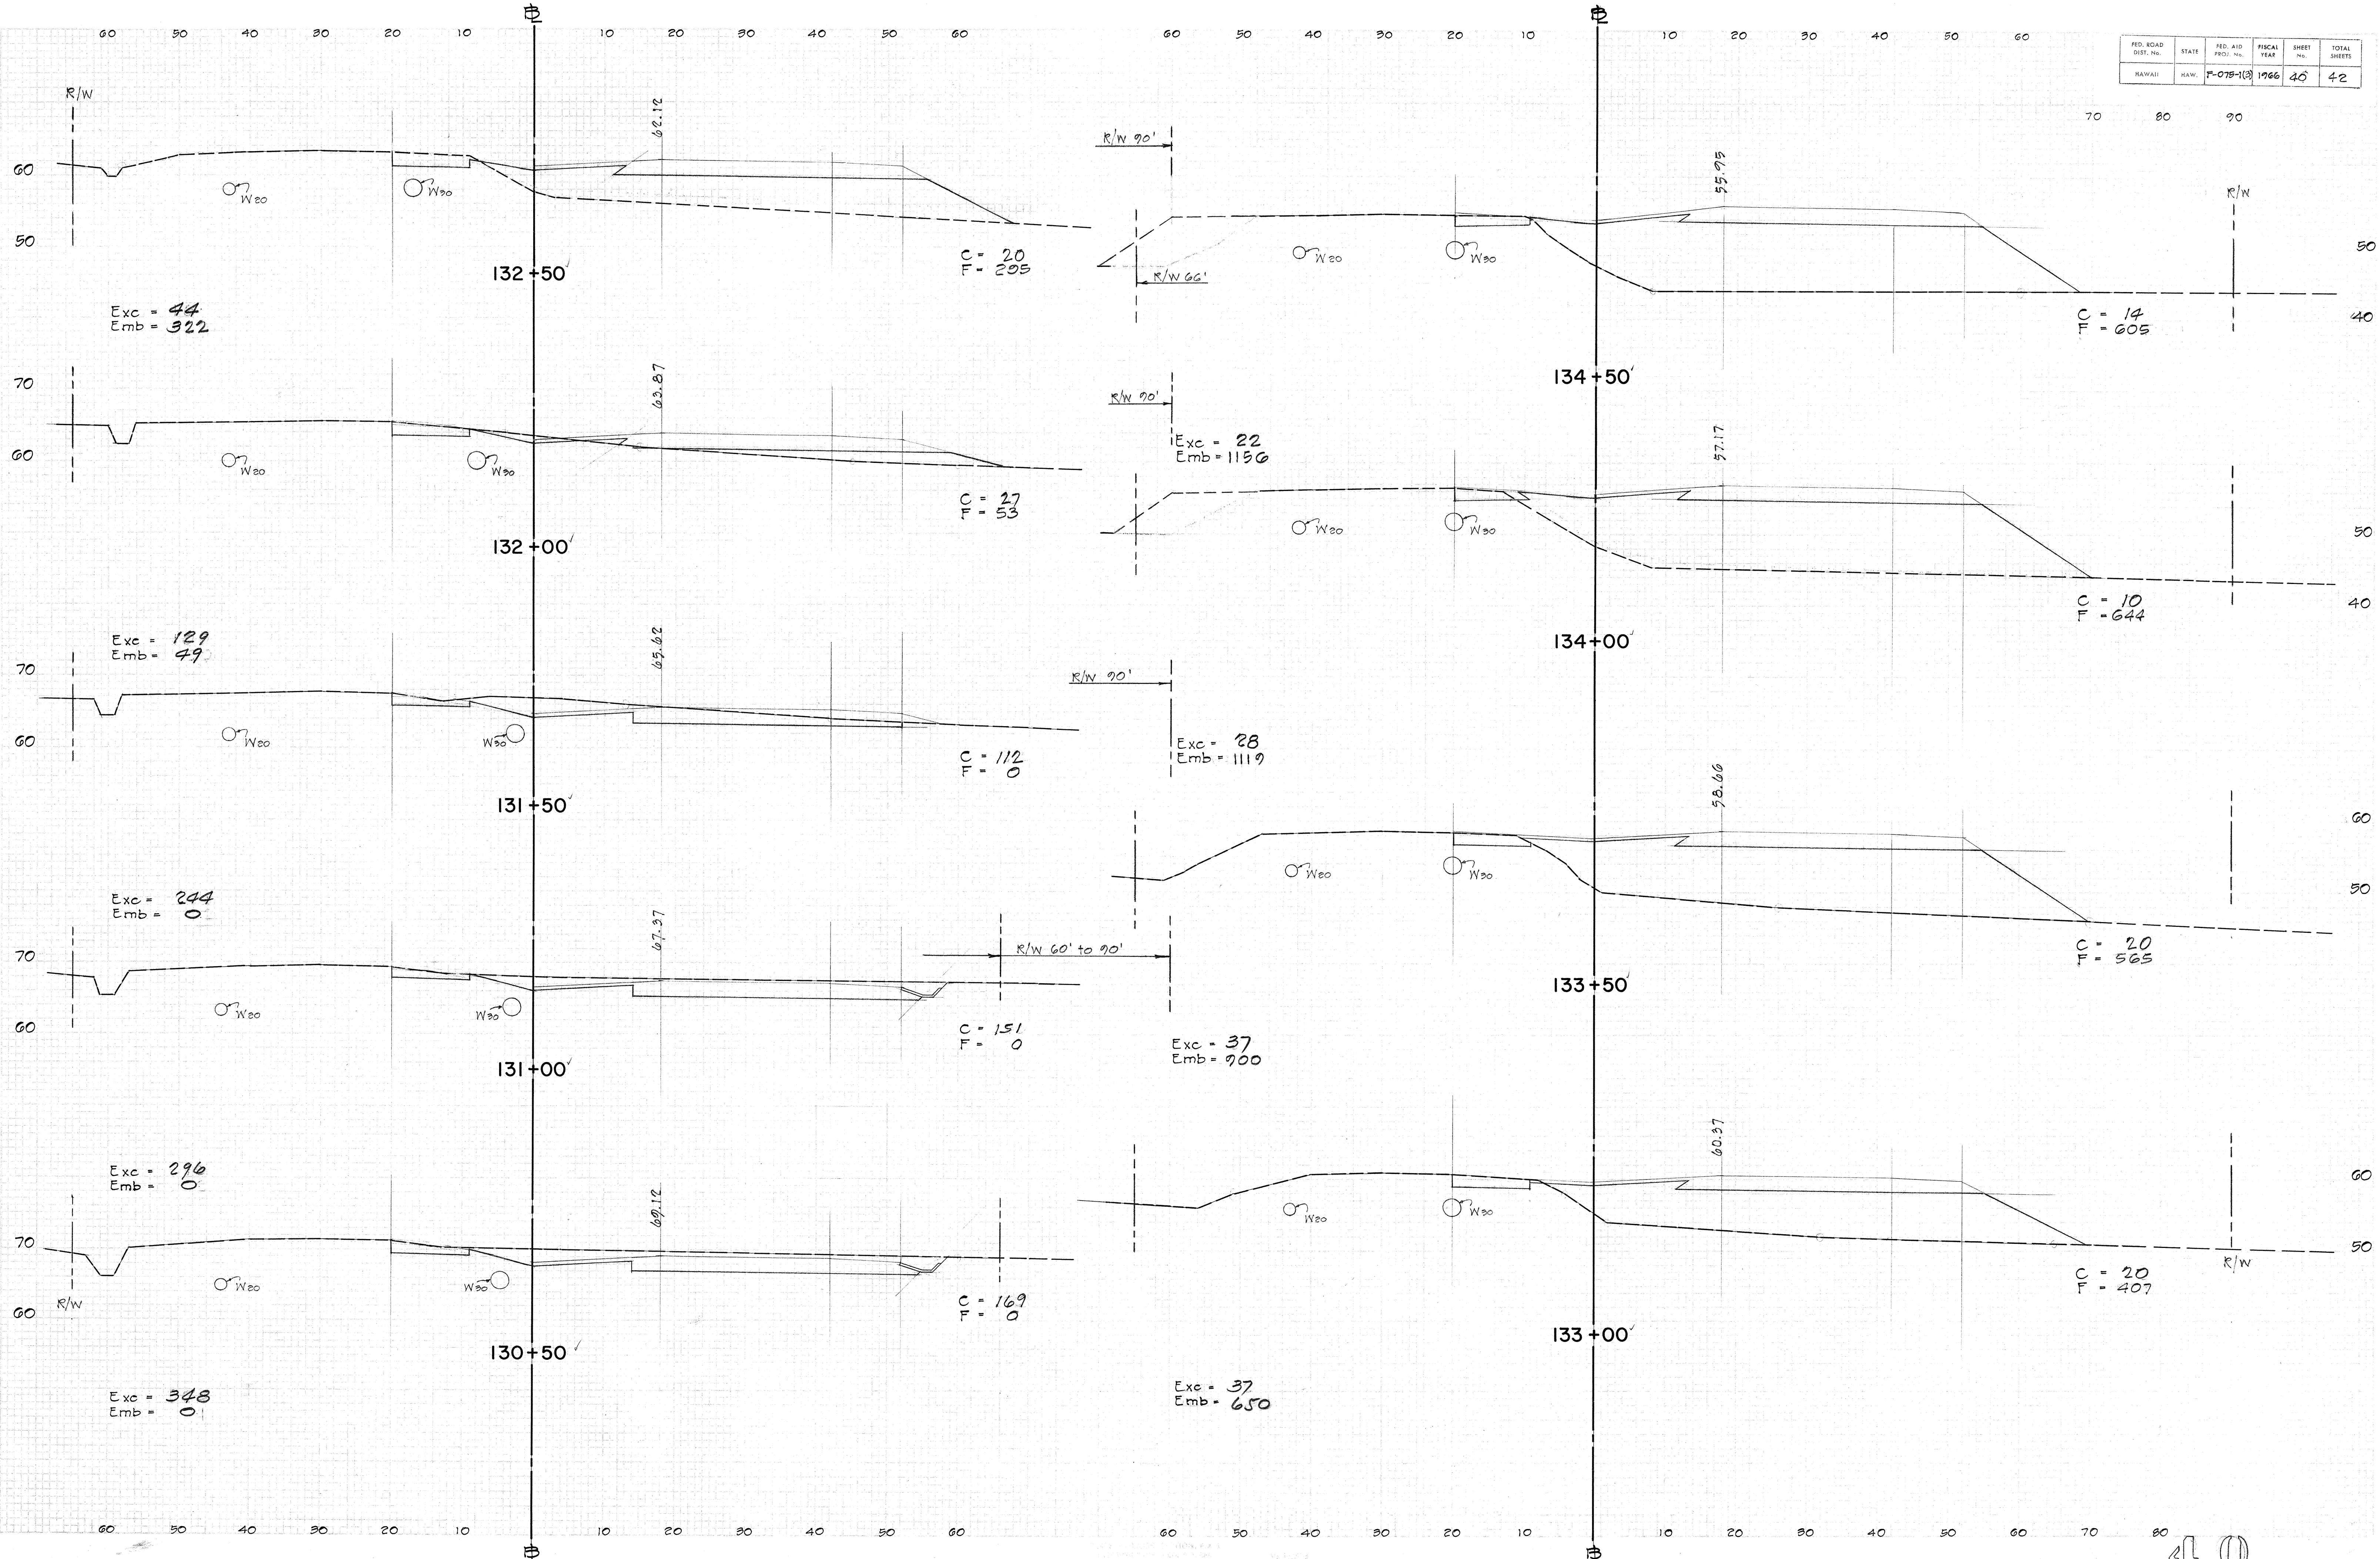

FED. ROAD DIST. NO.	STATE	FED. AID PROJ. NO.	FISCAL YEAR	SHEET NO.	TOTAL SHEETS
HAWAII	HAW	F-075-1(3)	1966	41	42

70 80 90

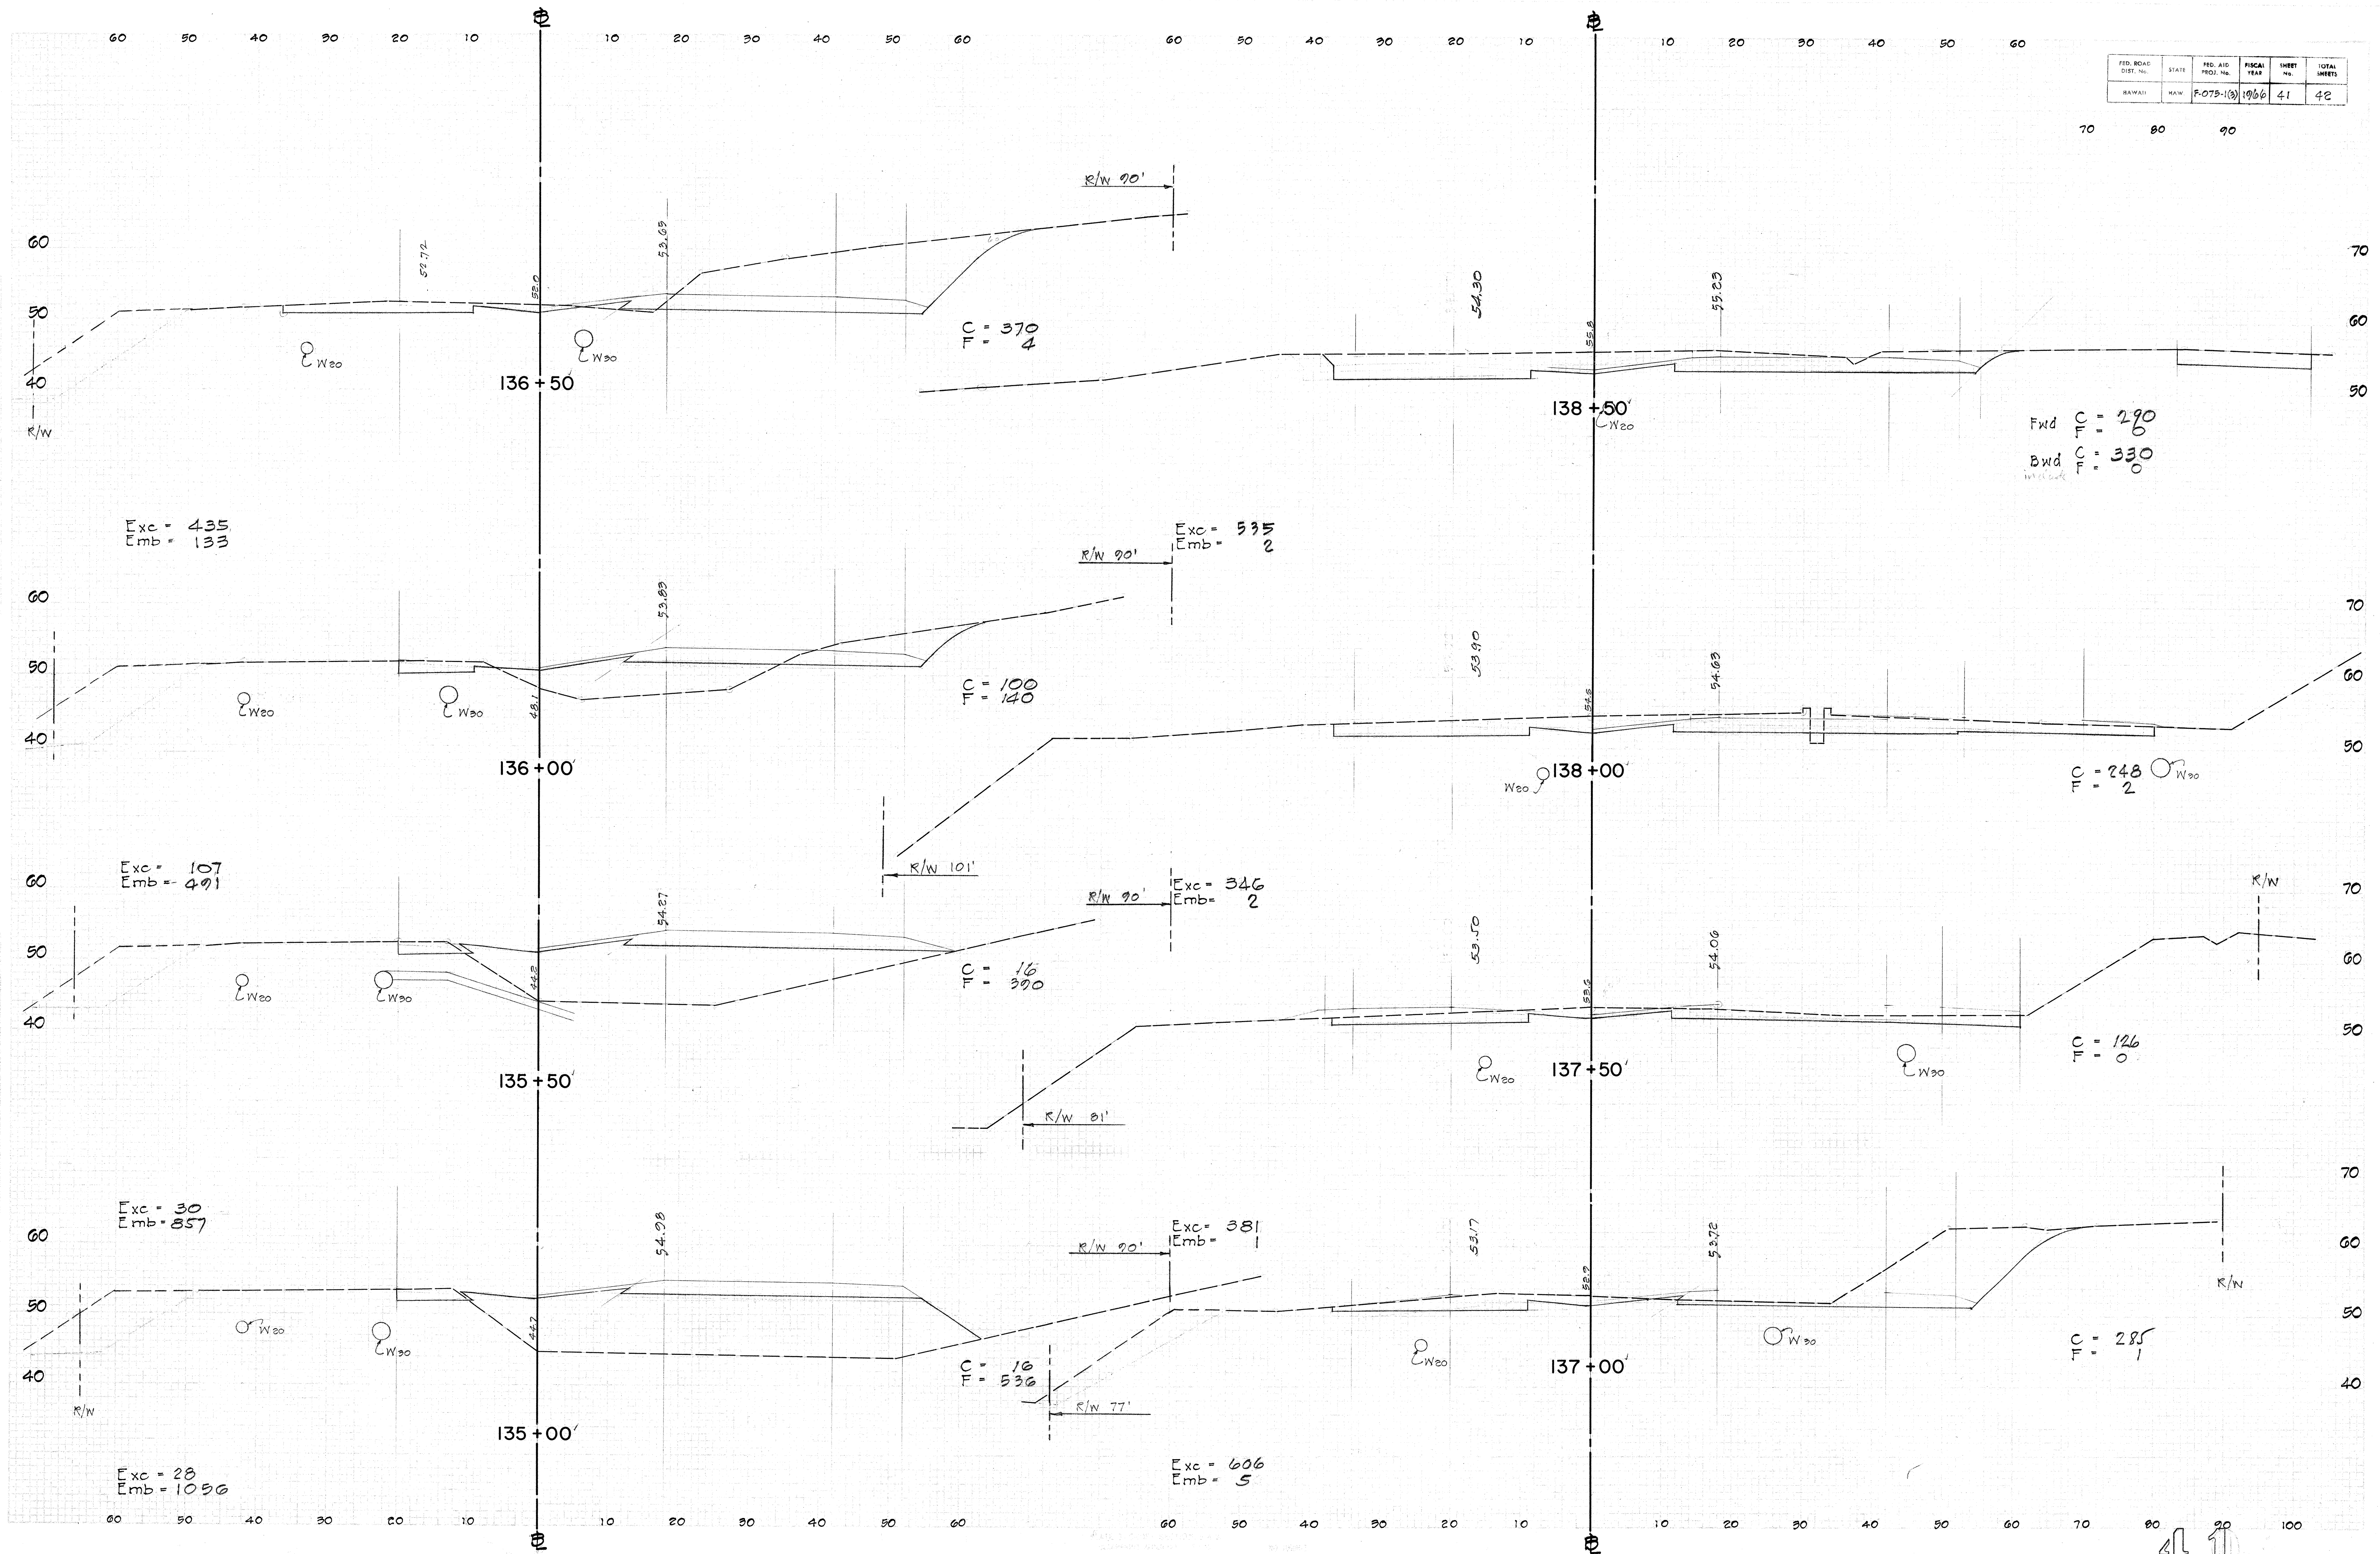

FED. ROAD DIST. No.	STATE	FED. AID PROJ. No.	FISCAL YEAR	SHEET No.	TOTAL SHEETS
KAWAII	HAW.	F-073-19	1966	42	42

