

GENERAL NOTES

1. Azimuths & Coordinates are referred to Hawaiian Plane Coordinate Grid System Zone III
2. Bench Mark referred to Mean Sea Level Datum.
3. Removing of existing guard rails, curbs, and curb & gutters and scarifying of pavement shall be incidental to roadway excavation.
4. Removing and demolishing of existing pipe culverts shall be incidental to roadway excavation.

BEG. OF PROJ. NO. F-075-1(3)
OUTB. LANES @ STA. 116+00

Sta 116+00 to 127+25 1/2 Left 50.5'
Construct Concrete ditch for details see sht. no. 14
ESTIMATED QUANTITIES
Class B-1 Conc. 2006 C.Y.
Reinf. Steel 25,400 Lbs.
Struct. Exc. 815 C.Y.


Sta 116+00 to 127+75
Install 1,175 Lin. Ft. of Metal Guard Rail with Posts.

FED. ROAD DIST. NO.	STATE	FED. AID PROJ. NO.	FISCAL YEAR	SHEET NO.	TOTAL SHEETS
HAWAII	HAW.	F-075-1(3)	1966	4	42

True North
Scale: 1" = 50'


PLAN	SURVEYED	DATE
NOTE BOOK	PLOTTED	BY
NO.	ALIGNMENT CHECKED	
	RT. OF WAY CHECKED	

PROFILE	SURVEYED	DATE
NOTE BOOK	GRADES CHECKED	BY
NO.	B. M. S. NOTED	
	STRUCTURE NOTATIONS CH'KD.	

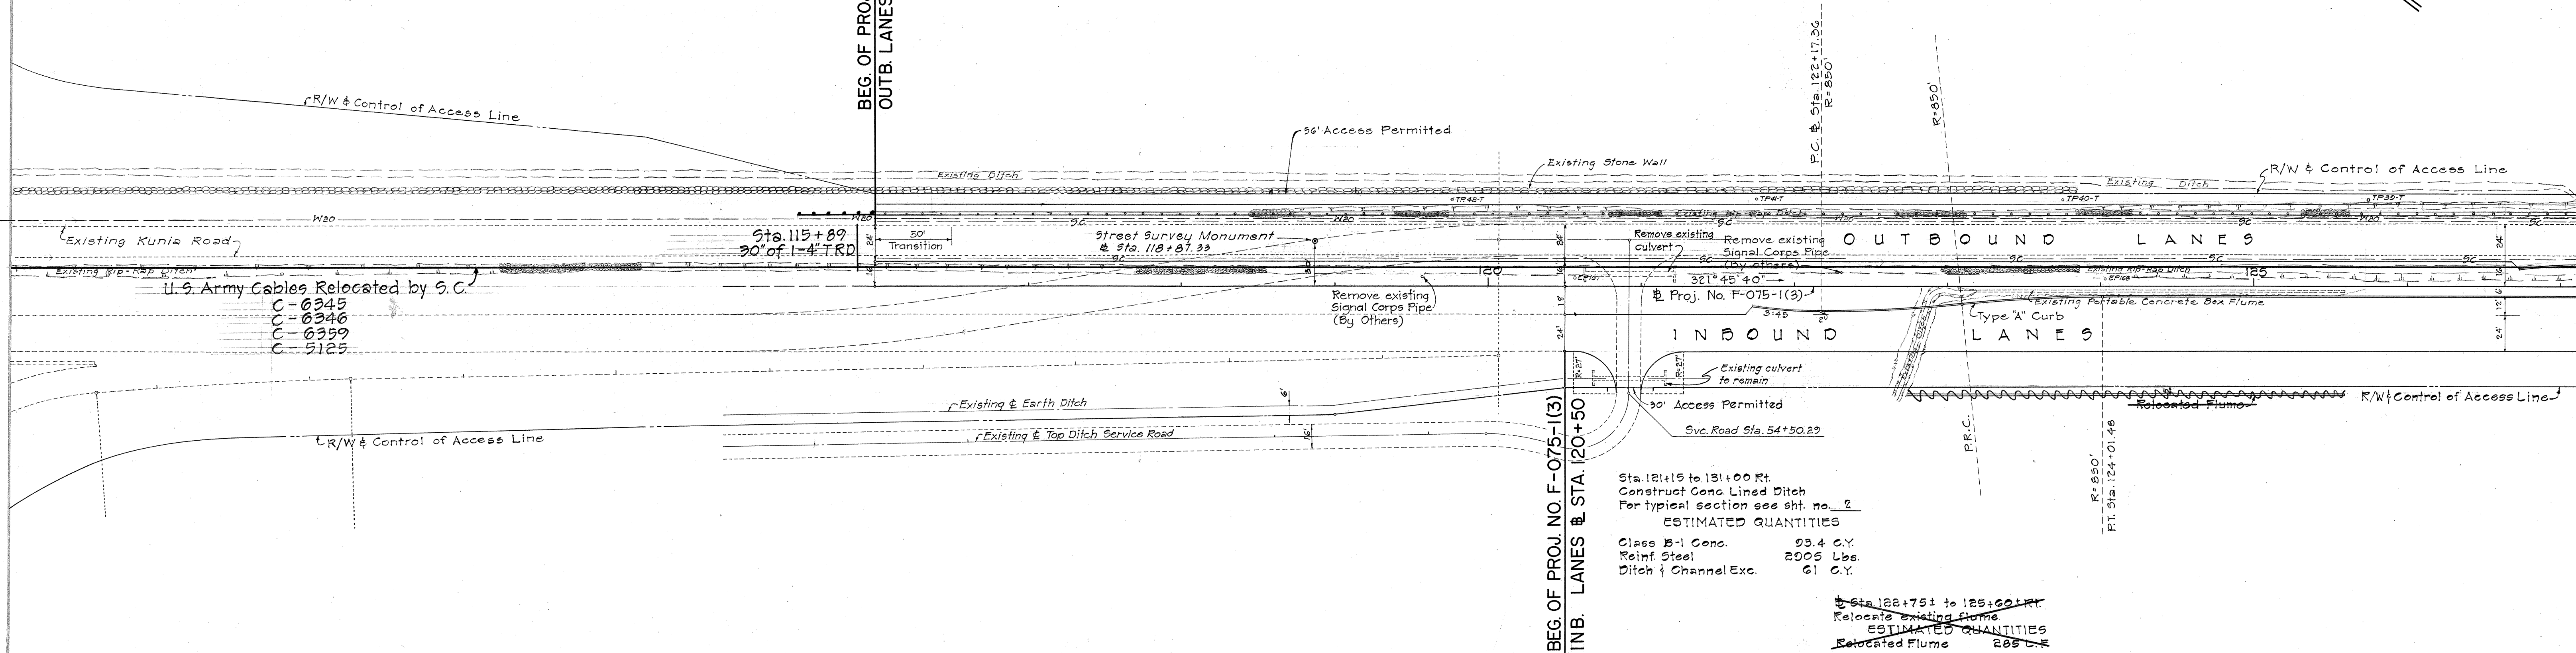

Sta. 121+15 to 131+00 Rt.
Construct Conc. Lined Ditch
For typical section see sht. no. 2
ESTIMATED QUANTITIES
Class B-1 Conc. 93.4 C.Y.
Reinf. Steel 2005 Lbs.
Ditch & Channel Exc. 61 C.Y.

Sta. 128+75 to 125+00 Rt.
Relocate existing Flume
ESTIMATED QUANTITIES
Relocated Flume 285 L.F.

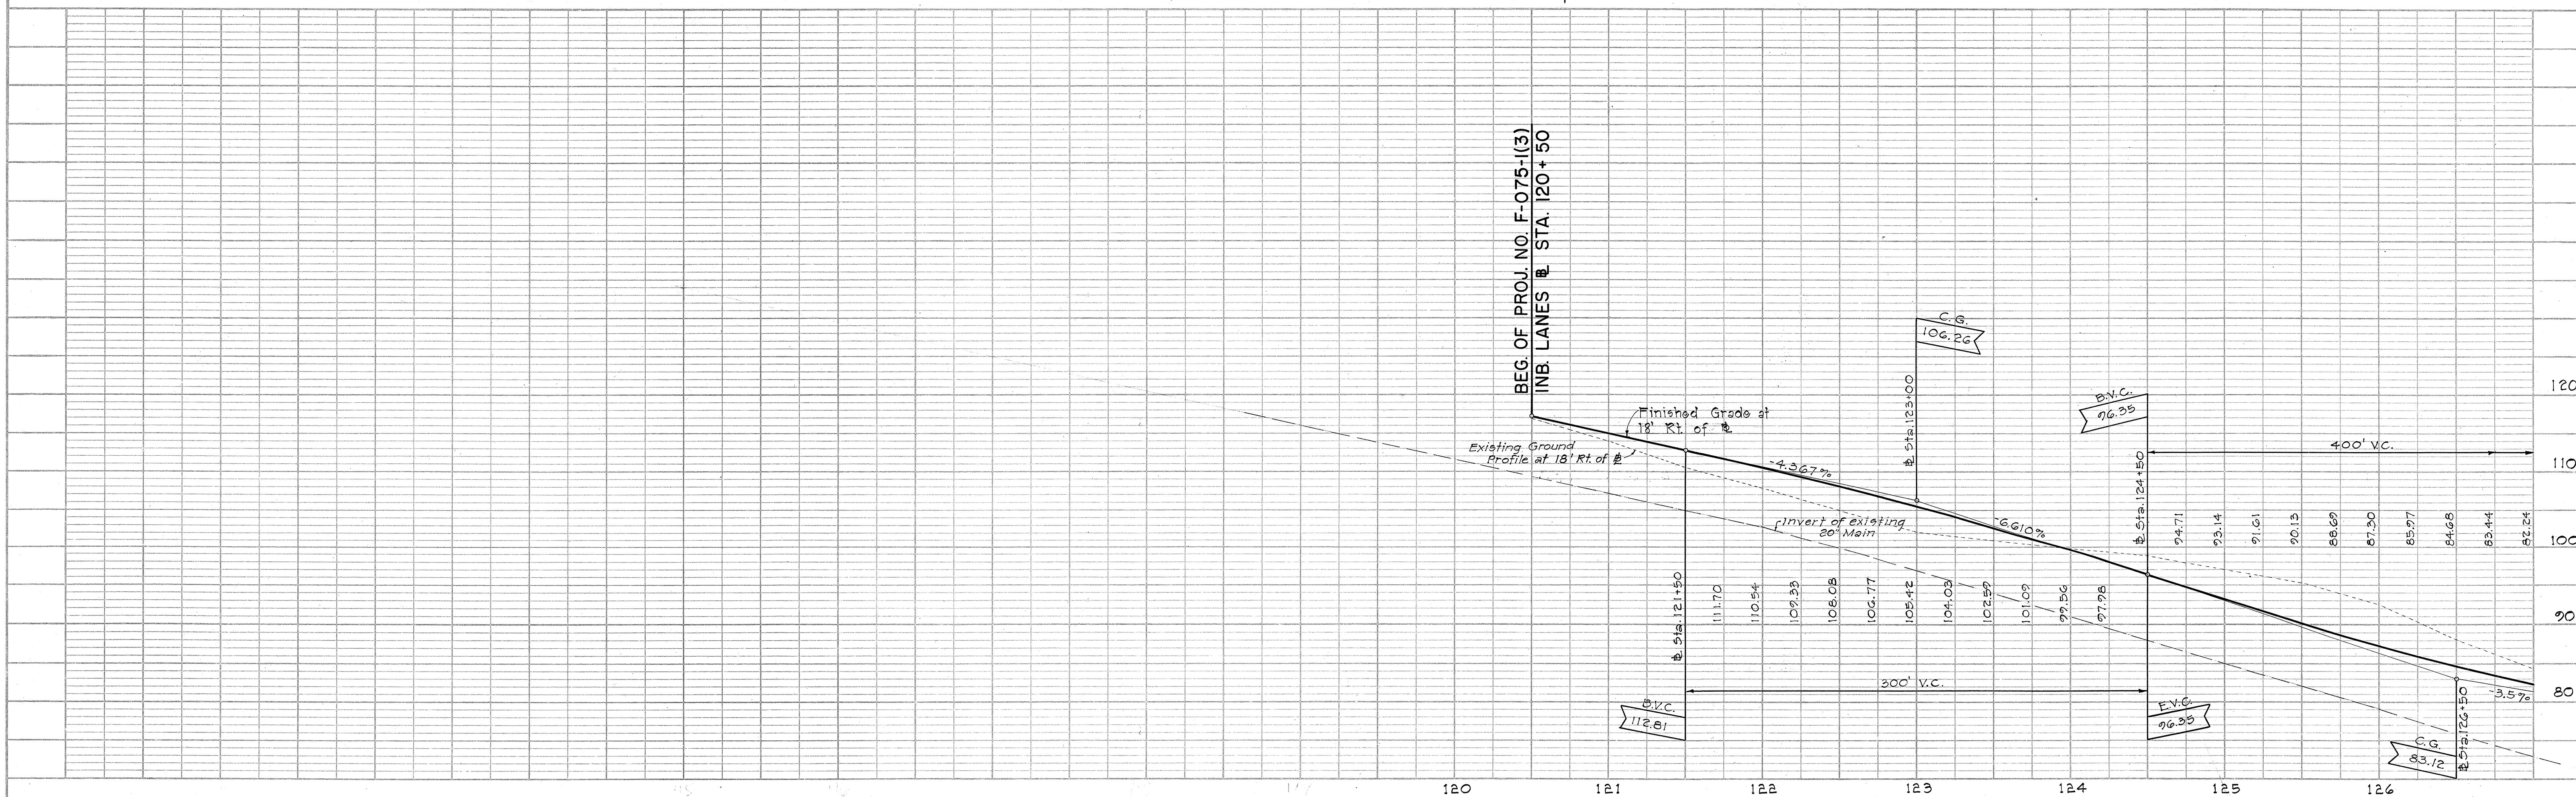

FED. ROAD DIST. NO.	STATE	FED. AID PROJ. NO.	FISCAL YEAR	SHEET NO.	TOTAL SHEETS
HAWAII	HAW.	F-075-1(3)	1966	5	42

PLAN	DATE	BY	CHECKED	DATE	BY
NOTED					
NOTED					
NOTED					

PROFILE	DATE	BY	CHECKED	DATE	BY
NOTED					
NOTED					
NOTED					

